



PARALLEL-TYPE ENTRANCE WITH ADDED LANE

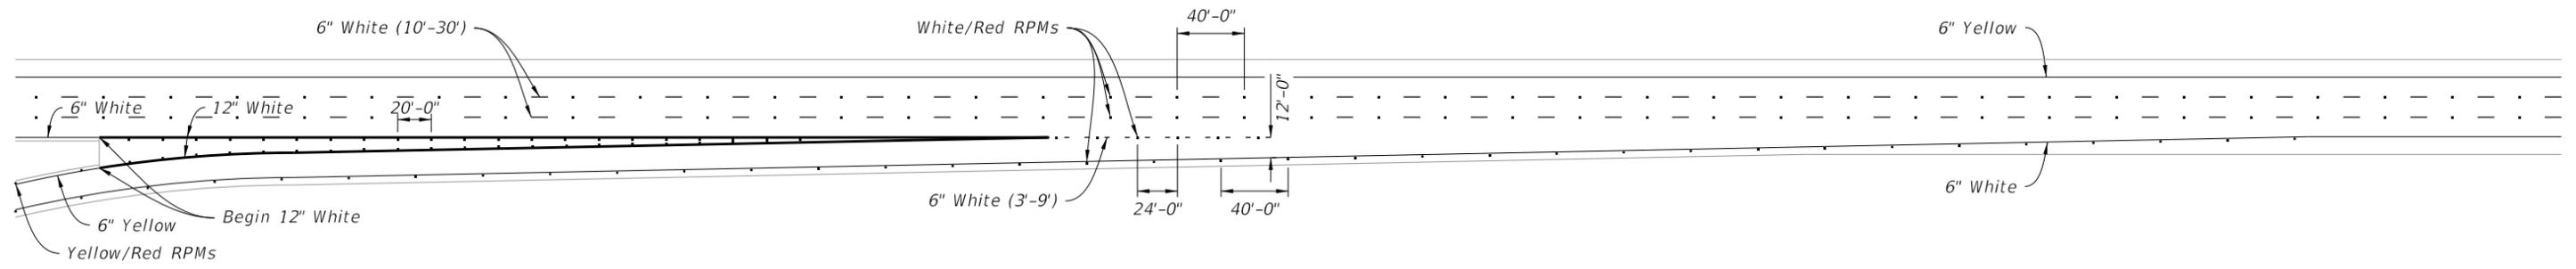

TAPER-TYPE ENTRANCE

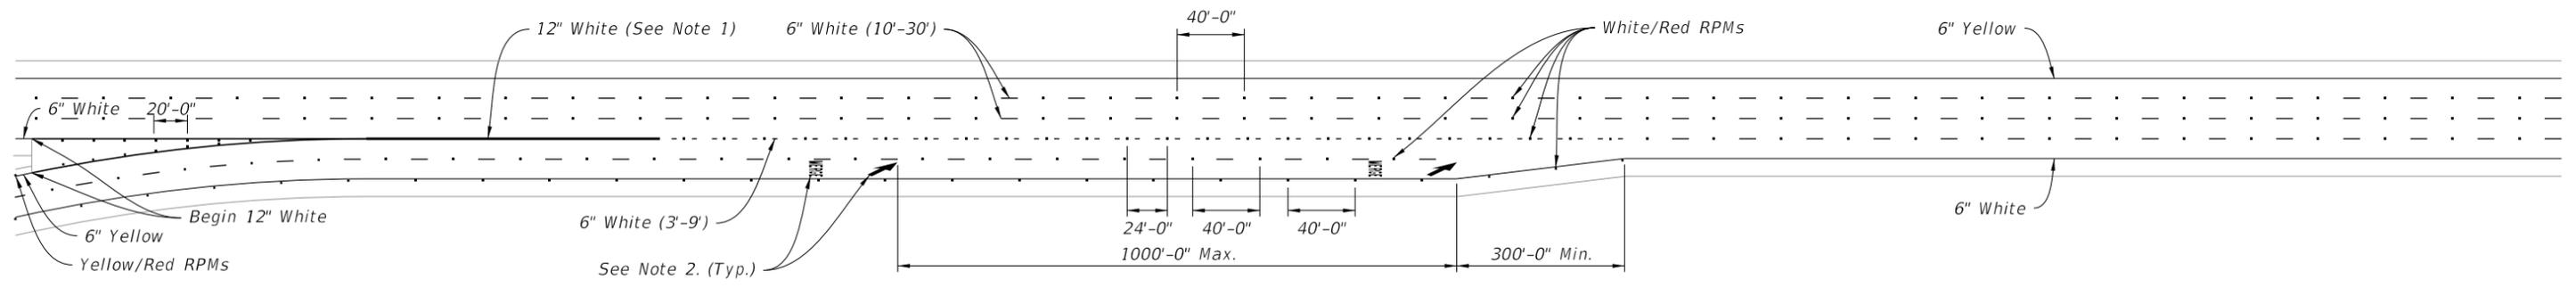

TWO-LANE PARALLEL-TYPE ENTRANCE WITH ADDED LANE
 Added Subtitle for clarification.

NOTES:

- 1. Extend this 12" white Pavement Marker one-fourth the length of the acceleration lane from the gore markings.
- 2. See Index 711-001 for pavement message dimensions and details.

← Added Note 3, for clarification.

TYPICAL PAVEMENT MARKINGS AT ENTRANCE RAMPS

10/12/2020 9:11:23 AM

LAST REVISION 11/01/20	REVISION	DESCRIPTION:	 FY 2021-22 STANDARD PLANS	INTERCHANGE MARKINGS	INDEX 711-003	SHEET 2 of 8
---------------------------	----------	--------------	--	----------------------	------------------	-----------------