




THREE THRU LANES - APPROACH AUXILIARY LANE
(Shown Without Shoulder Gutter)

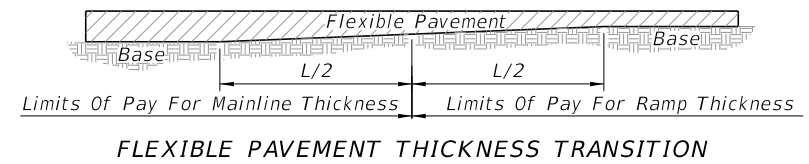


DETAIL "A"

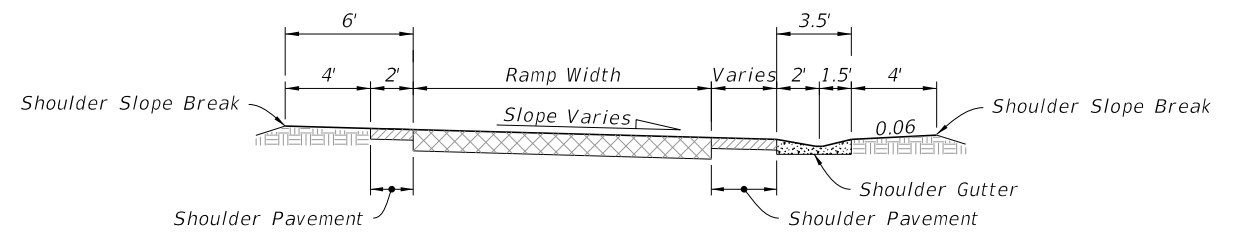

SECTION A-A

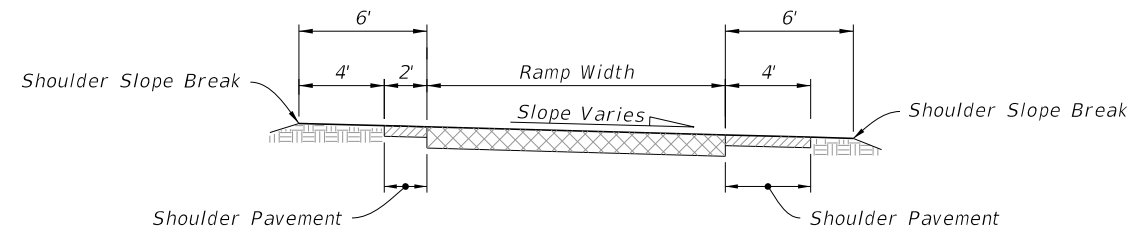

SECTION B-B

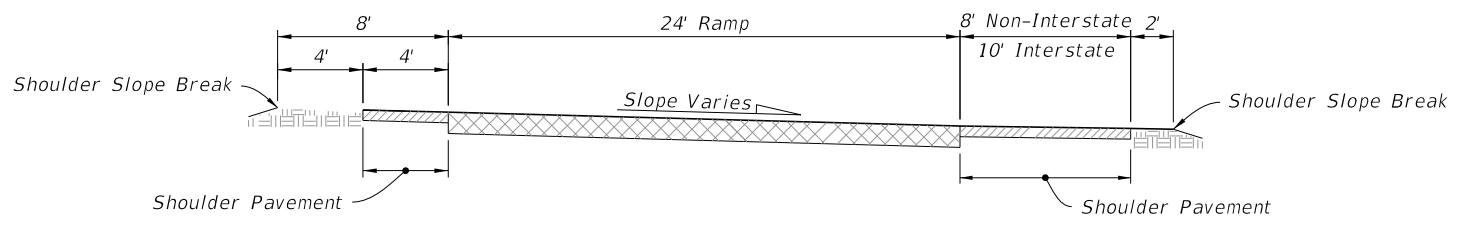

SECTION C-C

TWO LANE RAMPS - EXIT TERMINALS

10/28/2021 8:14:24 AM

LAST REVISION 11/01/17	DESCRIPTION:		FY 2022-23 STANDARD PLANS	RAMP TERMINALS	INDEX	SHEET
					000-525	2 of 5