
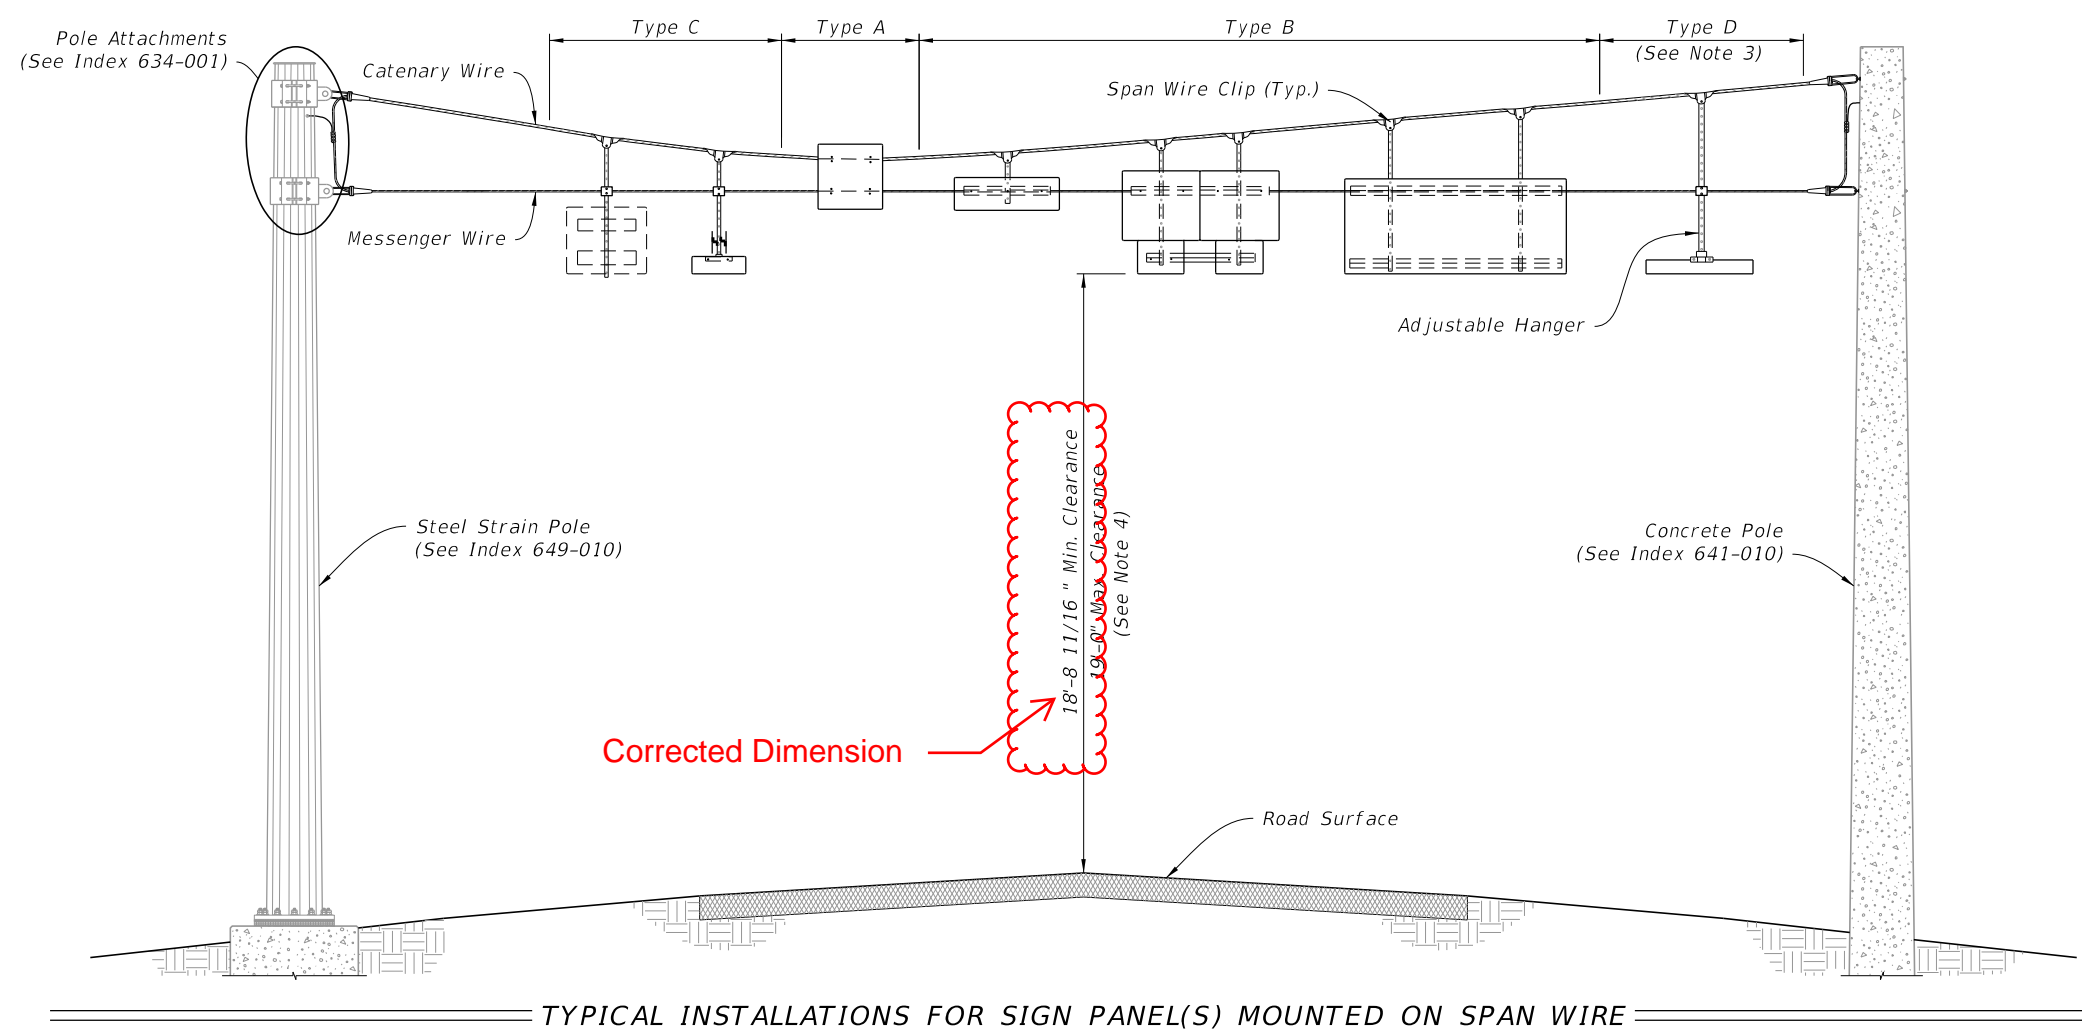
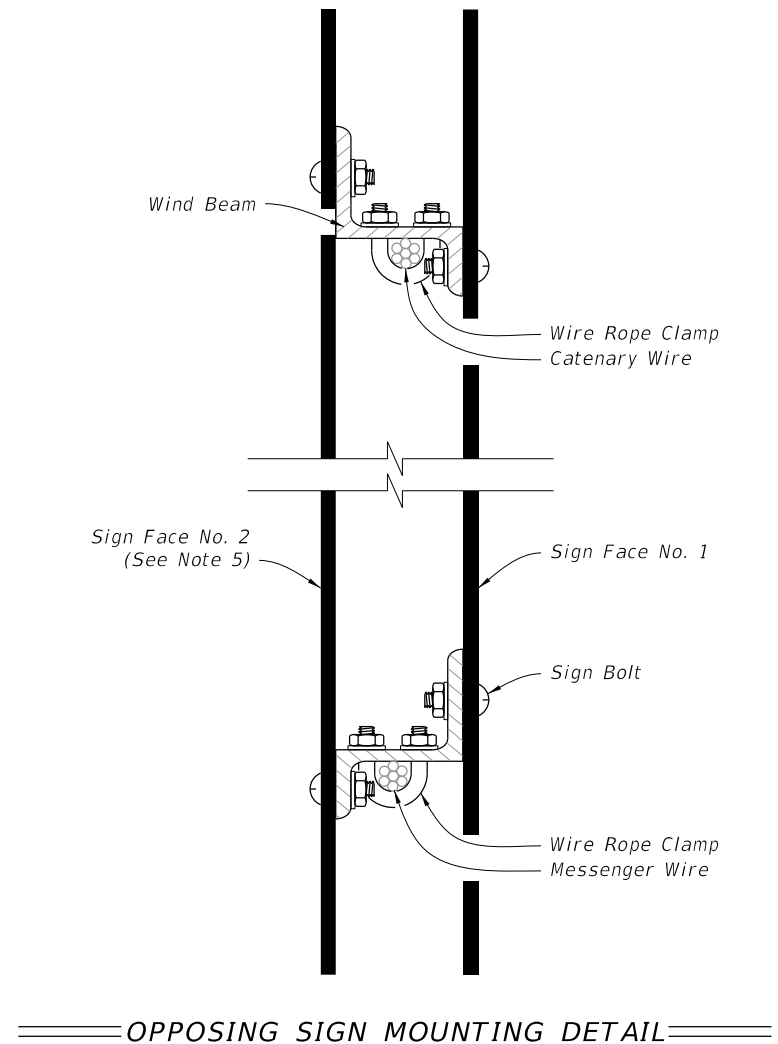


**NOTES:**

1. **Materials:**
  - A. Sign panels, wind beams and associated hardware: See Index 700-020
  - B. Sign adjustable hangers, wire rope clamps and associated hardware: See APL
  - C. Wire and additional hardware requirements: See Specification 634
2. **Type B and C Attachments:**
  - A. Extend wind beams to within 6" of the sign edge.
  - B. Number of sign hangers required based on sign width:
    - a. Sign width < 4'-0": One
    - b. 4'-0" ≤ sign width ≤ 8'-0" : Two
  - C. Number of wind beams required based on sign depth:
    - a. Sign depth < 3'-6": One
    - b. 3'-6" ≤ Sign depth ≤ 7'-0": Two
3. **Type D Attachments:**  
Maximum sign width = 3'-0"
4. Align the bottom edges of signs to approximately the same elevation.
5. Use a minimum of 2 bolts with a minimum spacing of 2" for overlapped connection of the adjustable hangers.

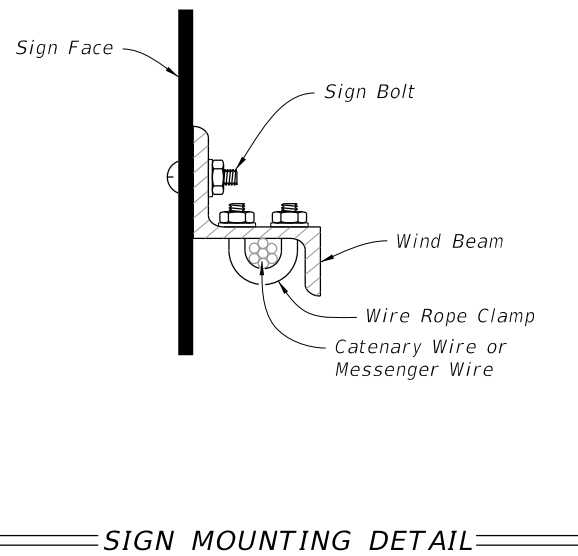

9/22/2021 12:32:19 PM

|                           |          |              |                                  |                                |                  |                 |
|---------------------------|----------|--------------|----------------------------------|--------------------------------|------------------|-----------------|
| LAST REVISION<br>11/01/21 | REVISION | DESCRIPTION: | <br>FY 2022-23<br>STANDARD PLANS | SPAN WIRE MOUNTED SIGN DETAILS | INDEX<br>659-010 | SHEET<br>1 of 1 |
|---------------------------|----------|--------------|----------------------------------|--------------------------------|------------------|-----------------|