



LEGEND:

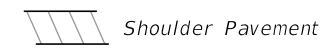


Corrected Dimension

THREE THRU LANES - APPROACH AUXILIARY LANE  
(Shown Without Shoulder Gutter)

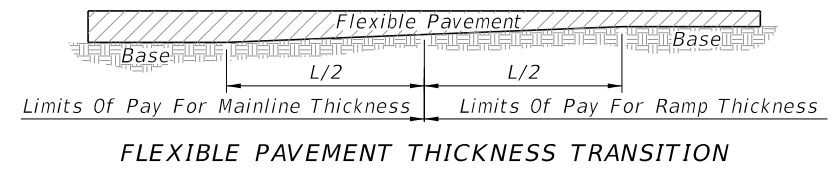


FLEXIBLE PAVEMENT THICKNESS TRANSITION


DETAIL "A"

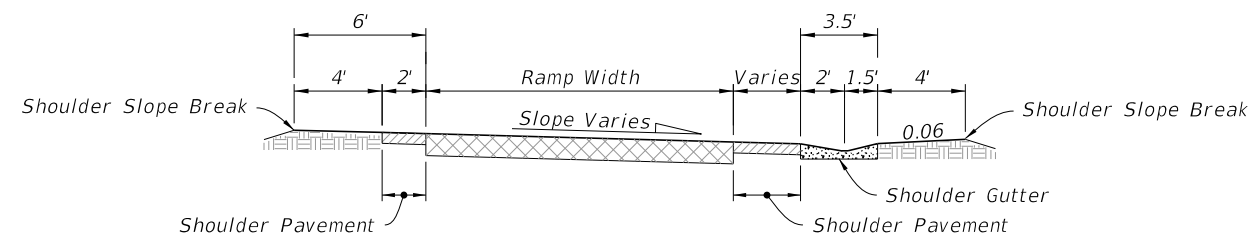

SECTION A-A

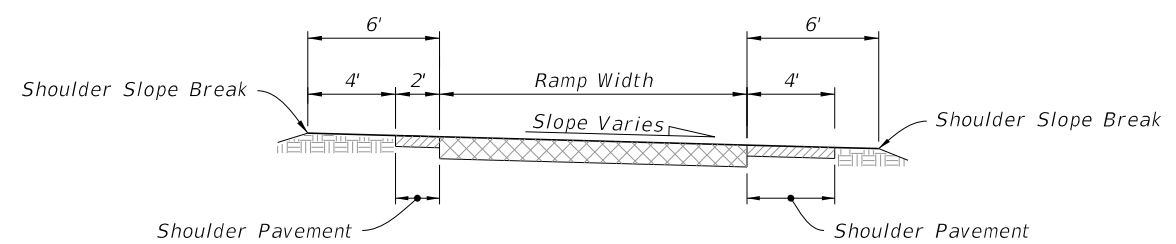

SECTION B-B

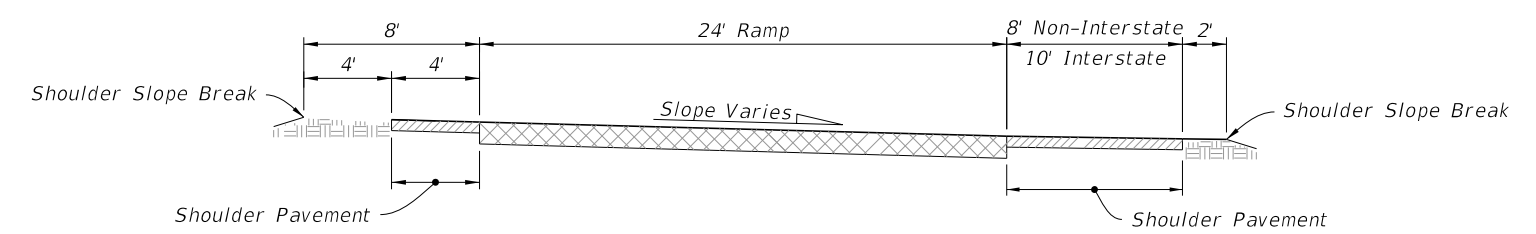

SECTION C-C

TWO LANE RAMPS - EXIT TERMINALS

10/6/2022 1:20:41 PM

LAST REVISION 11/01/17	REVISION	DESCRIPTION:		FY 2023-24 STANDARD PLANS	RAMP TERMINALS	INDEX 000-525	SHEET 2 of 5
---------------------------	----------	--------------	--	------------------------------	----------------	------------------	-----------------