NOTES:

1. Confine work operations to the following lane or lane combinations:

   a. Outside travel lane
   b. Outside auxiliary lane
   c. Outside travel lane and adjoining auxiliary lane
   d. Inside travel lane
   e. Inside auxiliary lane
   f. Inside travel lane and adjoining auxiliary lane

   If the work area is confined to an auxiliary lane, see Index 102-600, "AUXILIARY LANE CLOSURE"

2. Provide sufficient Queue Length so that left-turning vehicles do not block through lanes.

Reverted to previous Note.

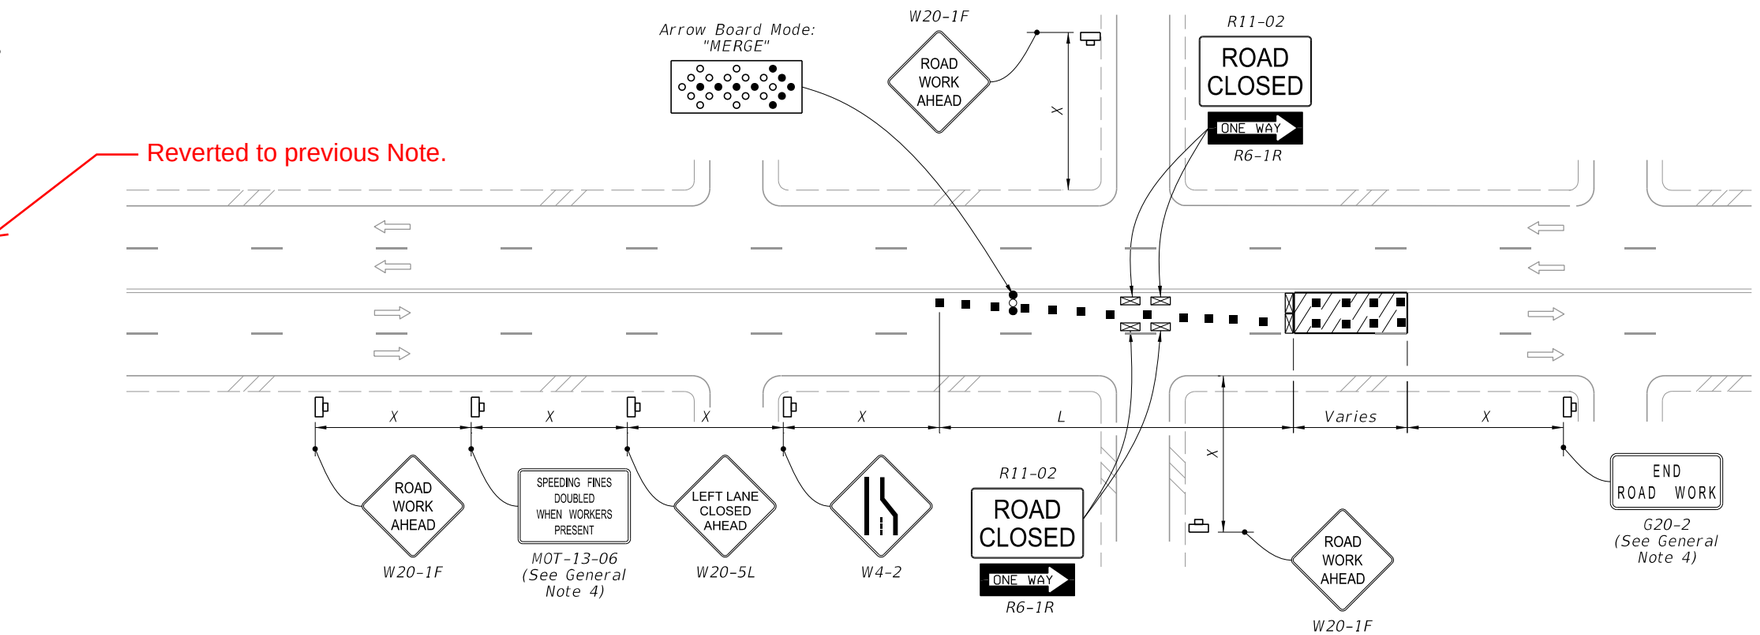

LEFT LANE CLOSED ON FAR SIDE OF MINOR SIDE STREET - RESTRICTED TURNING MOVEMENTS

SYMBOLS:

- Work Area
- Channelizing Device (See Index 102-600)
- Work Zone Sign
- Type III Barricade
- Arrow Board
- Stop Bar
- Lane Identification and Direction of Traffic

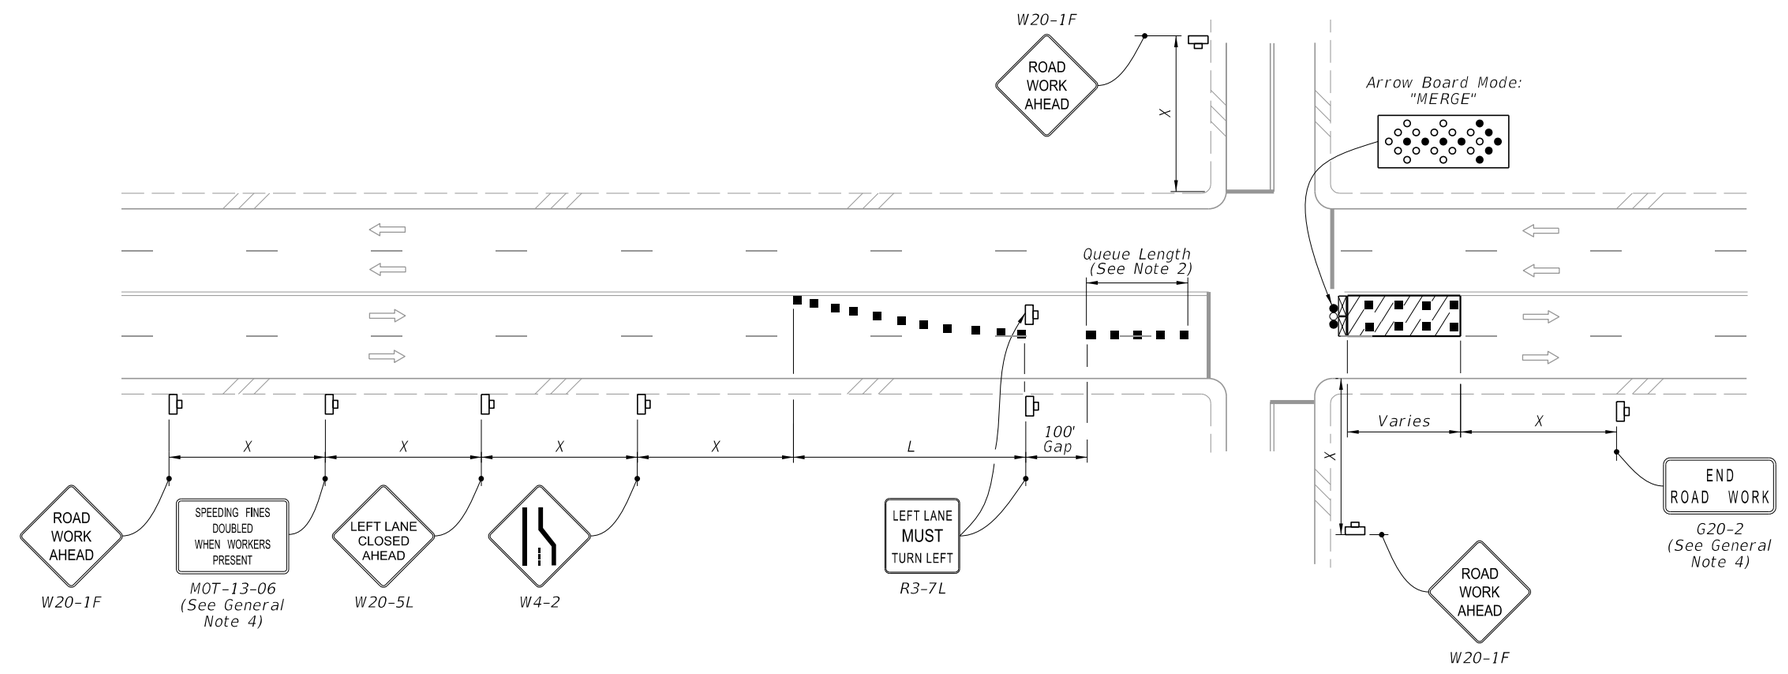

LEFT LANE CLOSED ON FAR SIDE OF INTERSECTION TURNING MOVEMENTS ALLOWED

10/7/2022 2:45:55 PM

LAST REVISION	REVISION	DESCRIPTION:				
11/01/22			FDOT FY 2023-24 STANDARD PLANS	MULTILANE ROADWAY, INTERSECTION WORK	INDEX 102-615	SHEET 3 of 5