GENERAL NOTES:

1. L = Taper Length
   B = Buffer Length
   X = Work Zone Sign Distance
   See Index 102-600 for "L", "B", "X", and channelizing device spacing values.

2. If vehicles in a parking zone block the line of sight to TCZ signs, locate and post mount signs in accordance with Index 700-101.

3. Use temporary "STOP" sign (R1-1) where the existing stop bar is more than 30' from the taper, remove or cover existing sign.

4. The "Speeding Fines Doubled When Workers Present" sign (MOT-13-06) and "End Road Work" Sign (G20-2), along with associated Work Zone Sign Distances, may be omitted when the work operation will be in place for 24 hours or less. Additionally, arrow boards may be omitted when the work operation will be in place for 60 minutes or less and the speed limit is 45 mph or less.

5. If the work area extends across a crosswalk, close the crosswalk in accordance with Index 102-660.

6. Dual signs are required for divided roadways.

SYMBOLS:

- Work Area
- Channelizing Device (See Index 102-600)
- Work Zone Sign
- Type III Barricade
- Arrow Board
- Stop Bar
- Lane Identification and Direction of Traffic

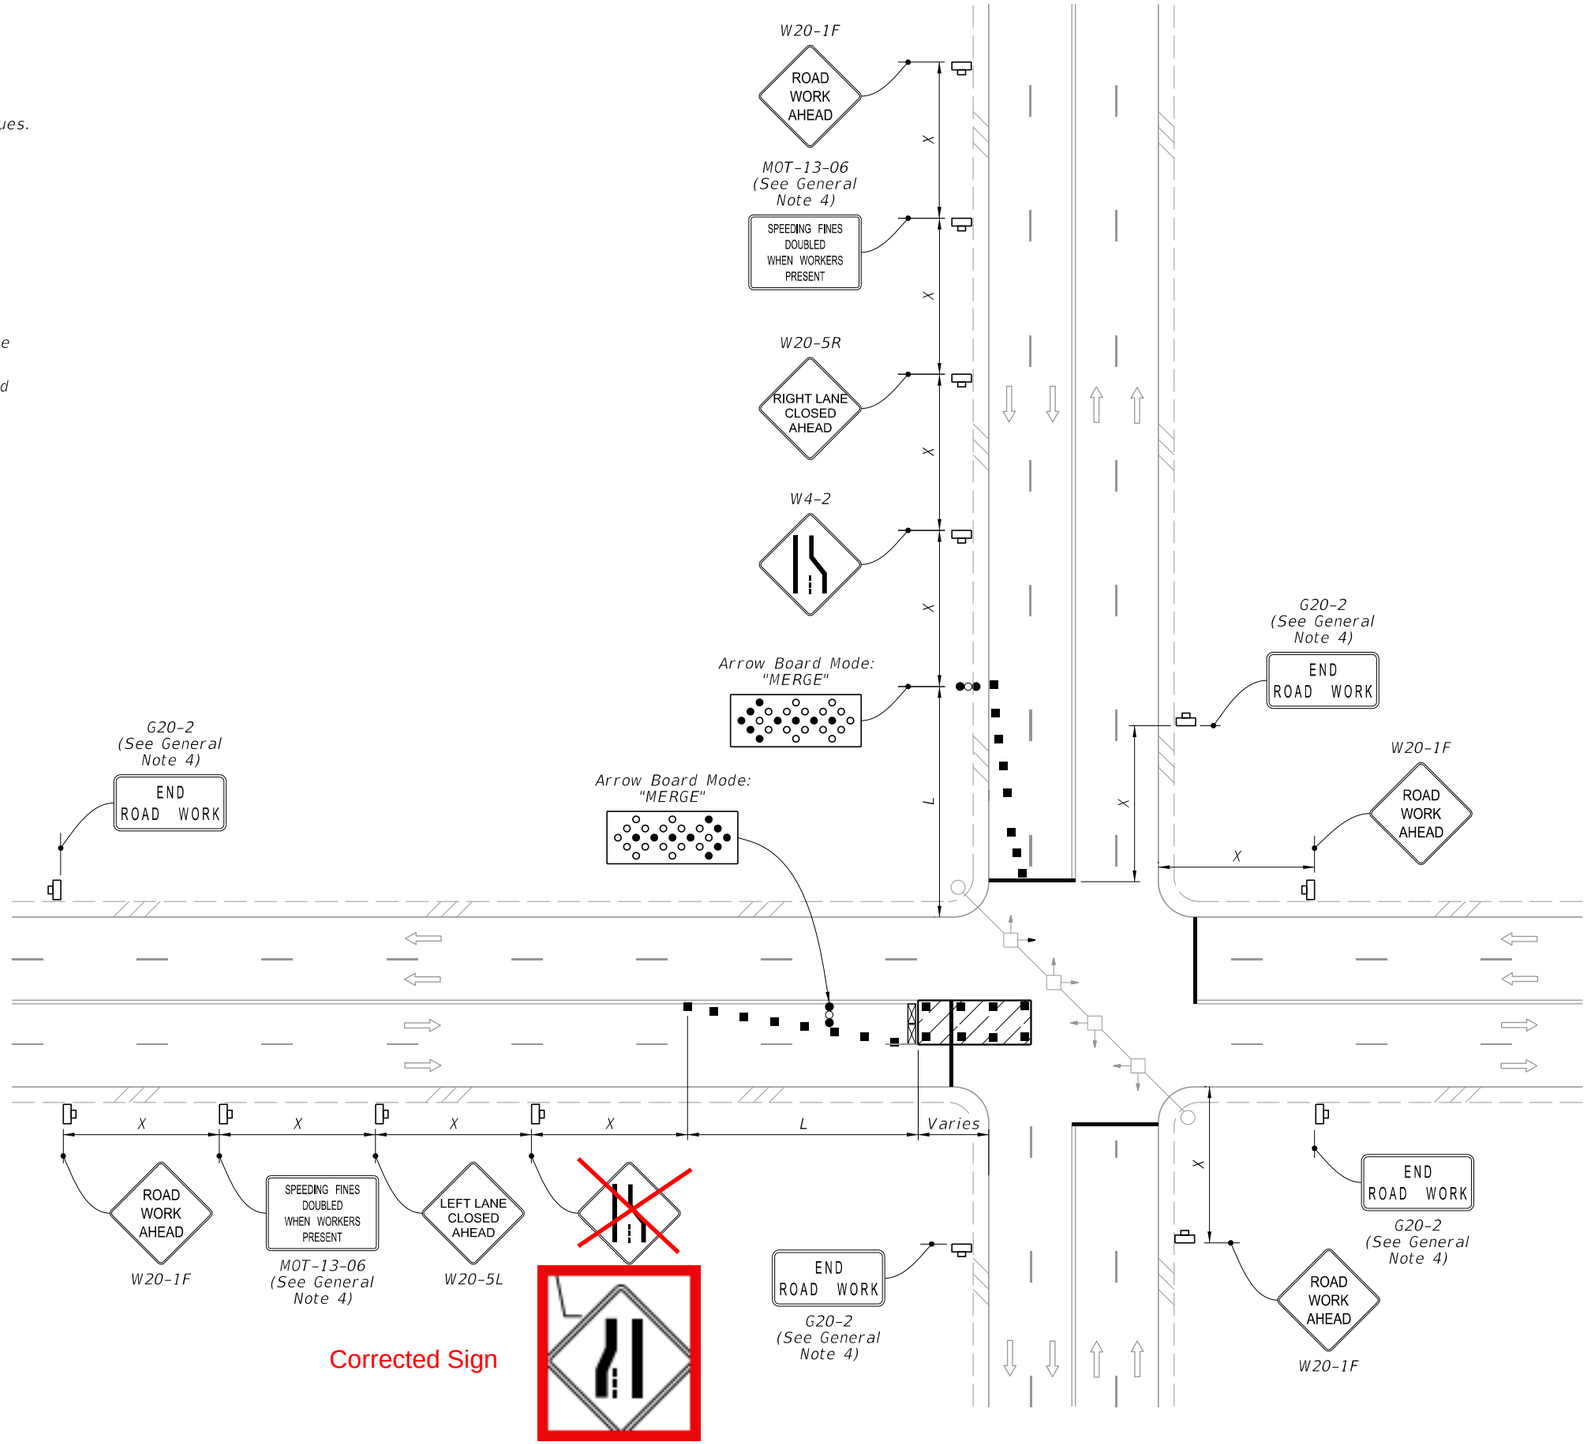

WORK IN INTERSECTION OF MULTILANE ROADWAY

10/7/2022 2:45:52 PM

LAST REVISION	REVISION	DESCRIPTION:				
11/01/22			FDOT FY 2023-24 STANDARD PLANS	MULTILANE ROADWAY, INTERSECTION WORK	INDEX 102-615	SHEET 1 of 5

NOTES:

1. Confine work operations to the following lane or lane combinations:

   a. Outside travel lane
   b. Outside auxiliary lane
   c. Outside travel lane and adjoining auxiliary lane
   d. Inside travel lane
   e. Inside auxiliary lane
   f. Inside travel lane and adjoining auxiliary lane

   If the work area is confined to an auxiliary lane, see Index 102-600, "AUXILIARY LANE CLOSURE"

2. Provide sufficient Queue Length so that left-turning vehicles do not block through lanes.

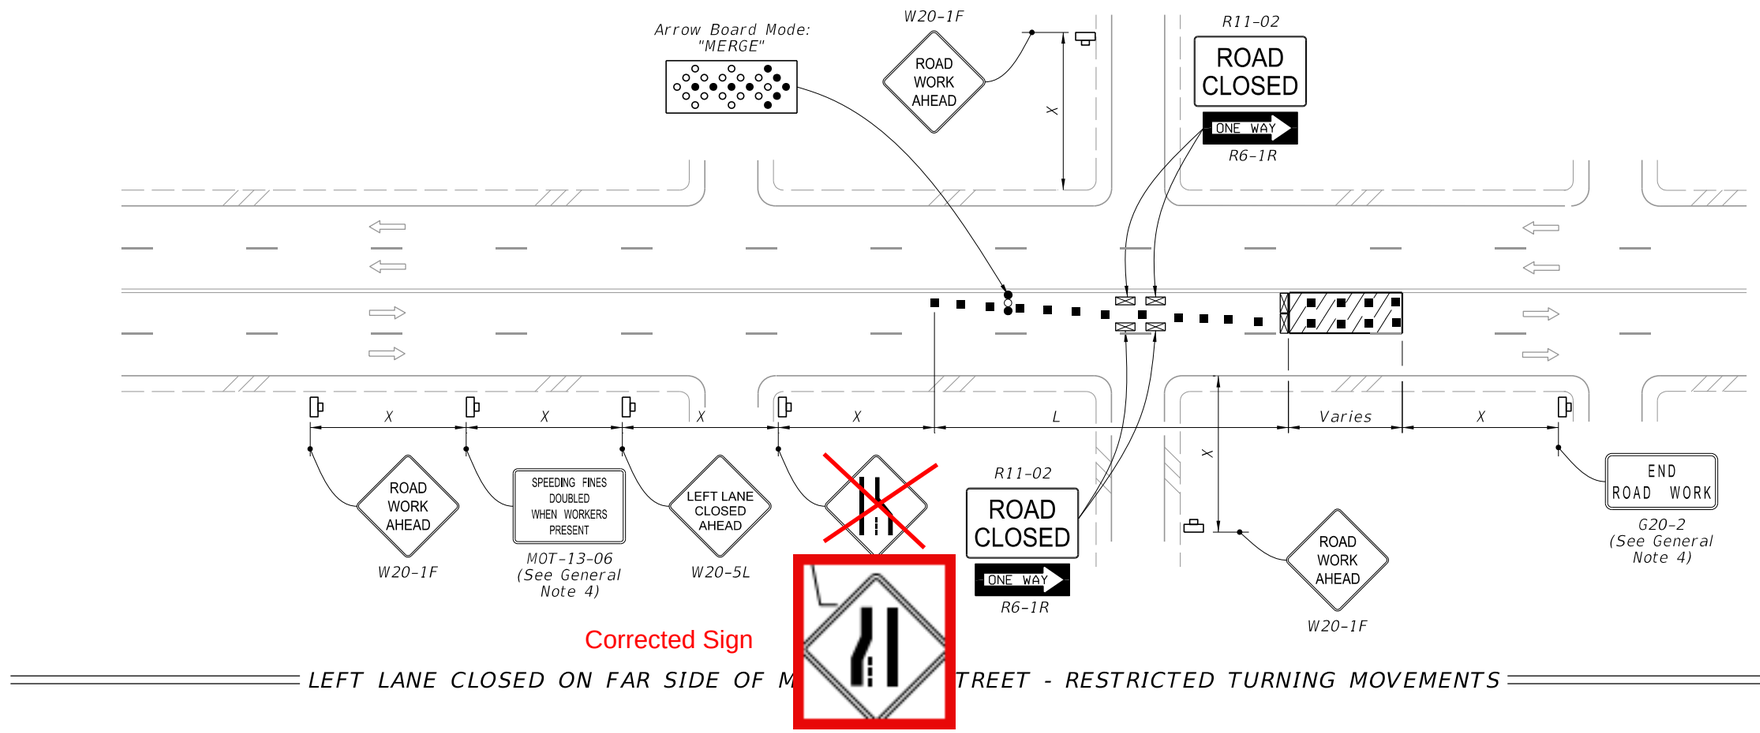

LEFT LANE CLOSED ON FAR SIDE OF M[illegible] STREET - RESTRICTED TURNING MOVEMENTS

SYMBOLS:

- Work Area
- Channelizing Device (See Index 102-600)
- Work Zone Sign
- Type III Barricade
- Arrow Board
- Stop Bar
- Lane Identification and Direction of Traffic

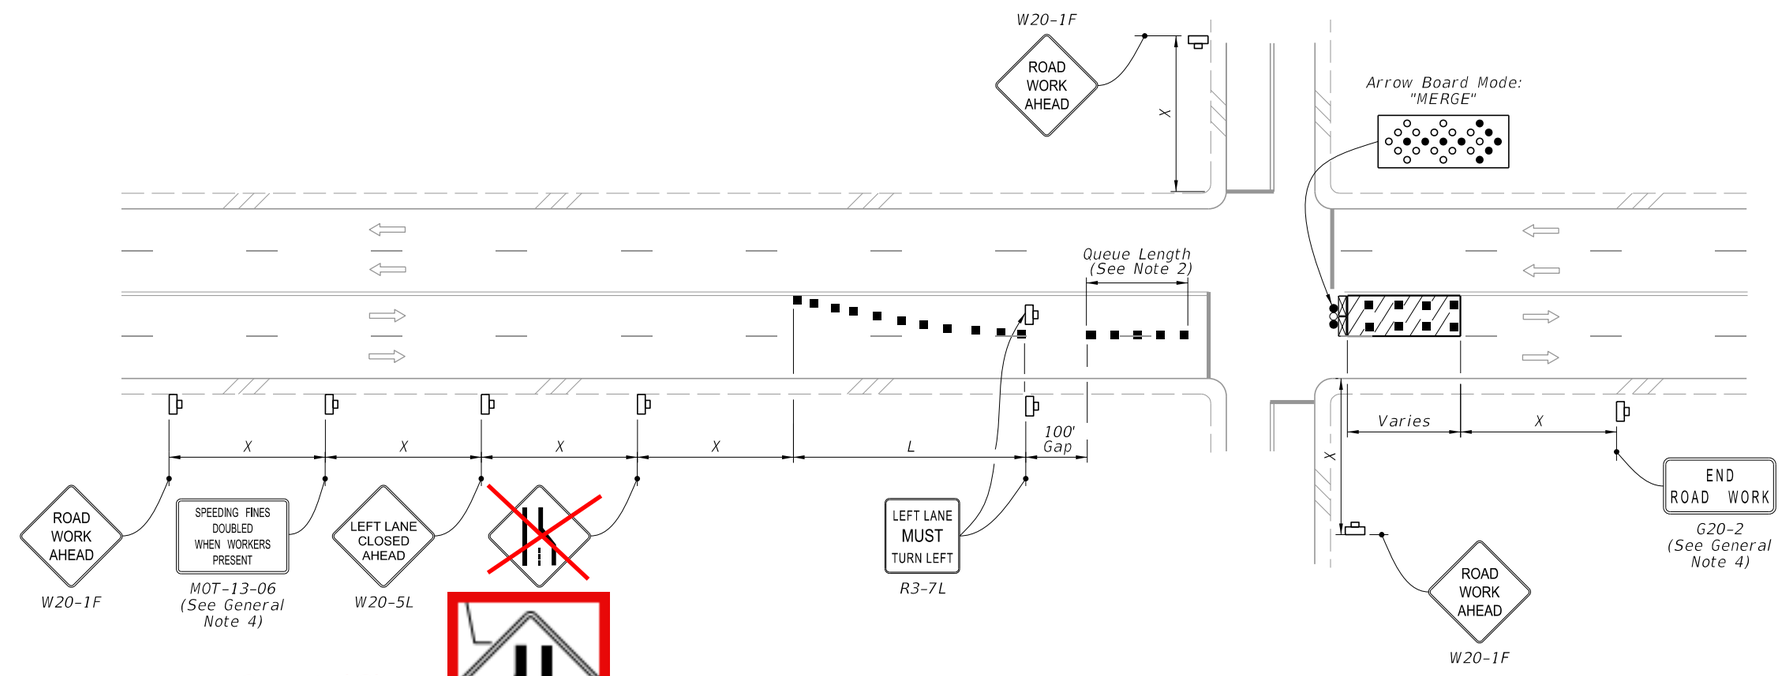

LEFT [illegible] ON FAR SIDE OF INTERSECTION TURNING MOVEMENTS ALLOWED

10/7/2022 2:45:55 PM

LAST REVISION	REVISION	DESCRIPTION:	FDOT	FY 2023-24 STANDARD PLANS	MULTILANE ROADWAY, INTERSECTION WORK	INDEX	SHEET
11/01/22						102-615	3 of 5