NOTES:

1. L = Taper Length
   B = Buffer Length
   X = Work Zone Sign Distance
   See Index 102-600 for "L", "B", "X", channelizing device spacing values.

2. Provide a 5' wide temporary pedestrian way with a maximum cross-slope of 0.02, except where space restrictions warrant a minimum width of 4'. Provide a 5' x 5' passing space for temporary pedestrian ways less than 5' in width at intervals not to exceed 200'.

3. When temporary pedestrian ways require curb ramps, meet the requirements of Index 522-002. Detectable warnings are not required for curb ramps diverting pedestrian traffic into a closed lane.

4. The "Speeding Fines Doubled When Workers Present" signs (MOT-13-06) and "End Road Work" signs (G20-2), along with associated work zone sign distances, may be omitted when the work operation will be in place for 24 hours or less.

5. Pedestrian Diversion Option 2 may only be used when called for in the Plans or as approved by an Engineer.

SYMBOLS:

- Work Area
- Temporary Pedestrian Way
- Channelizing Device (See Index 102-600)
- Pedestrian Longitudinal Channelizing Device (LCD)
- Work Zone Sign
- Arrow Board
- Crash Cushion
- Lane Identification and Direction of Traffic

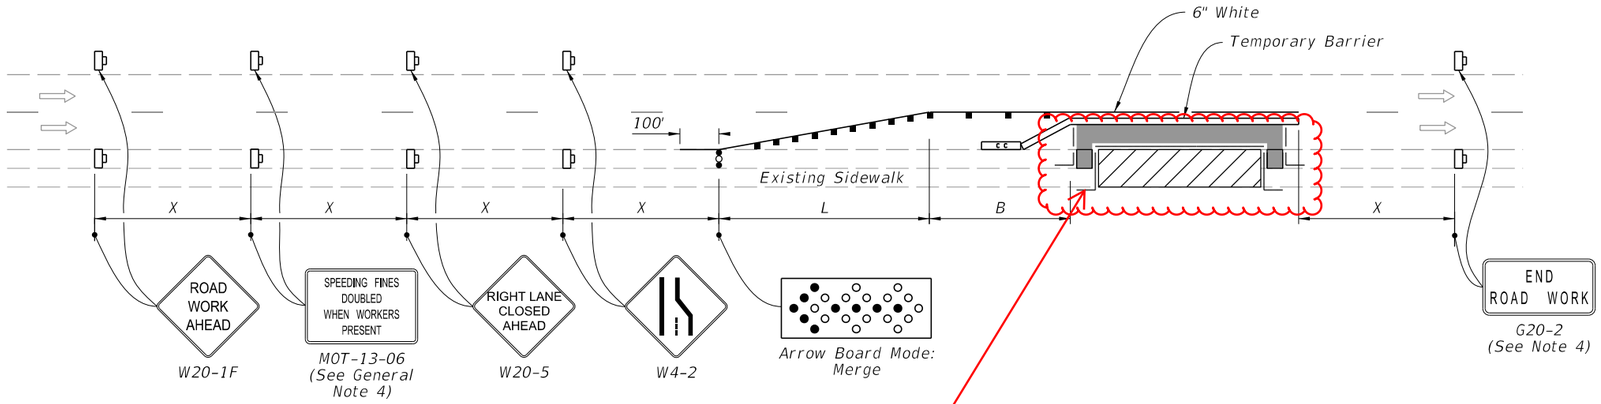

PEDESTRIAN DIVERSION - OPTION 1

(Temporary Barrier Shown, Low Profile Barrier Similar)

Corrected Printing Error
(Pedestrian Longitudinal Channelizing Device

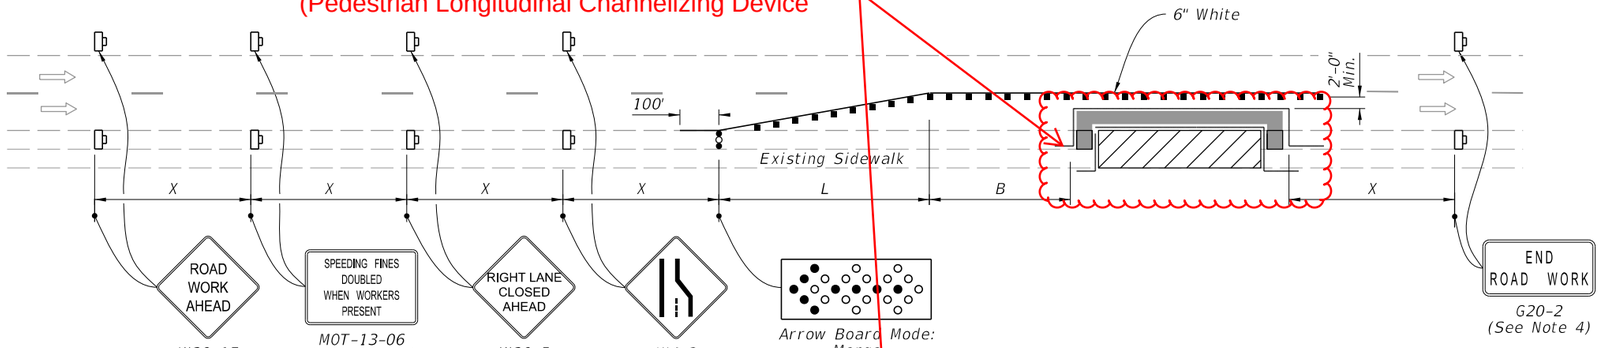

PEDESTRIAN DIVERSION - OPTION 2

(Work Zone Speed 35 mph or Less)

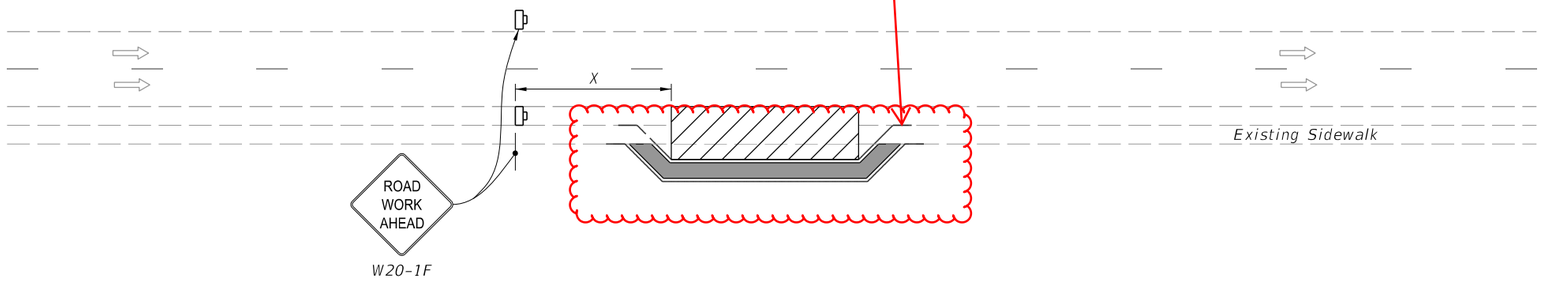

PEDESTRIAN SPECIAL DETOUR

10/6/2022 1:28:35 PM

LAST REVISION	REVISION	DESCRIPTION:			INDEX	SHEET
11/01/21			FY 2023-24 STANDARD PLANS	SIDEWALK CLOSURE	102-660	2 of 2