



**PARTIAL PLAN VIEW (TYPICAL FLARE)**  
 (FLARE AT CONTROL POINT B SHOWN, CONTROL POINTS A, C & D SIMILAR)  
 (HANDRAIL NOT SHOWN FOR CLARITY)

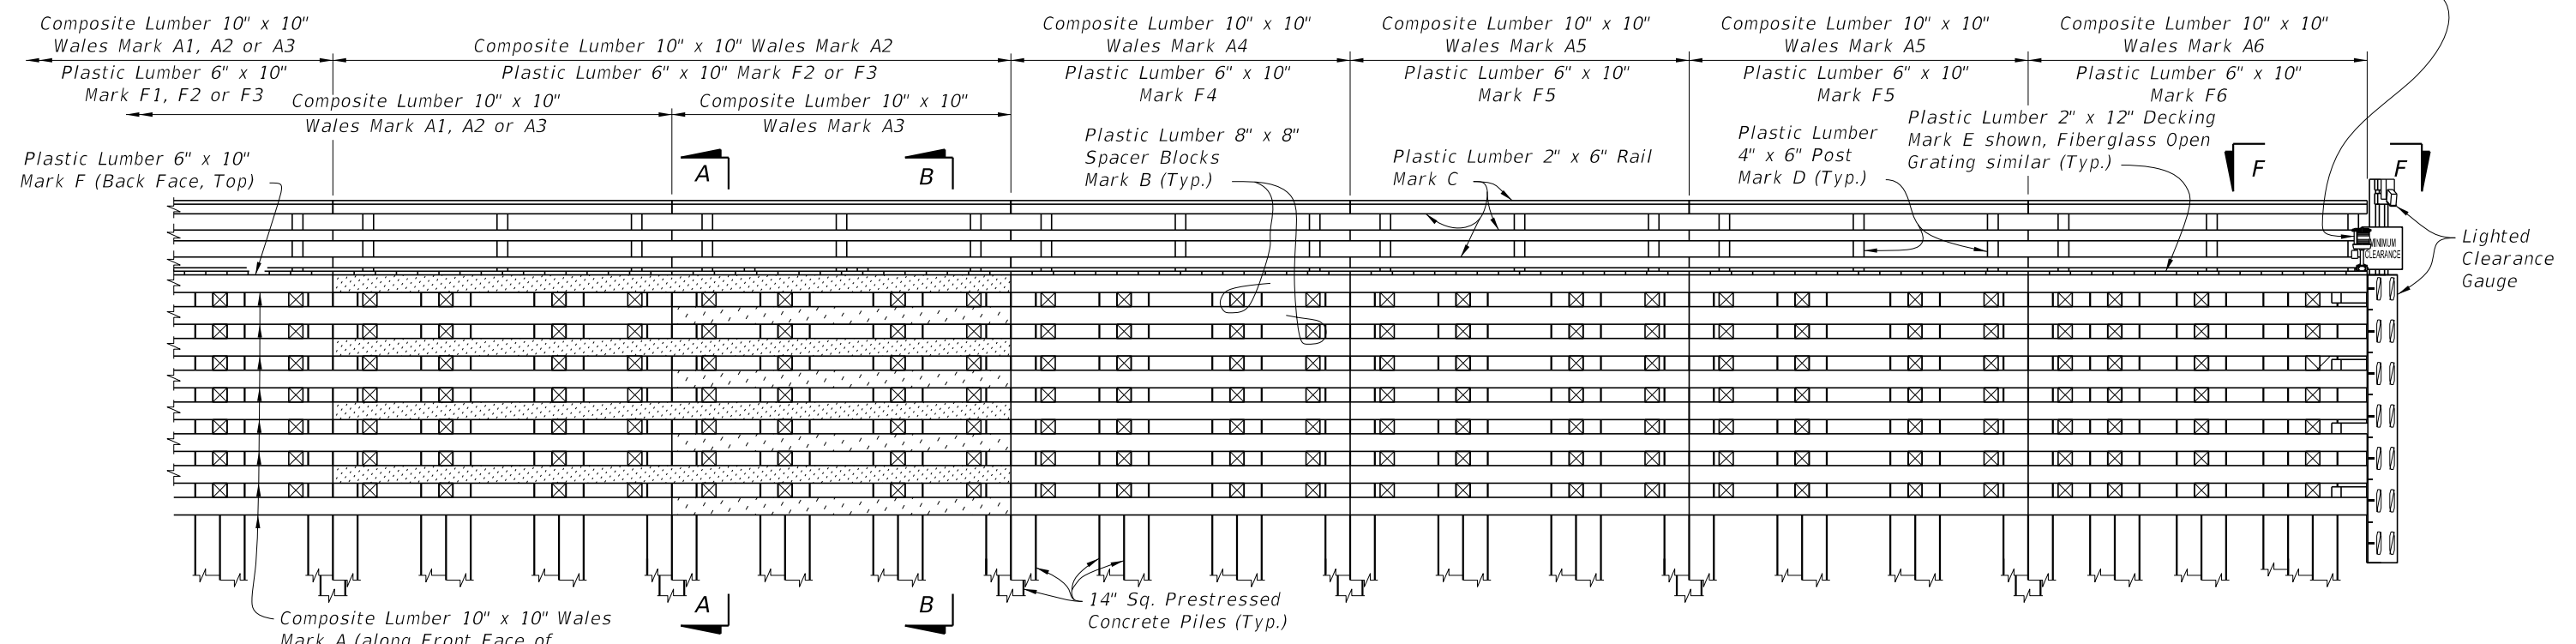

**EXPANDED PARTIAL ELEVATION VIEW**

10/6/2022 11:19:18 AM

LAST REVISION 01/11/17	DESCRIPTION:	 <b>FY 2023-24 STANDARD PLANS</b>	<b>FENDER SYSTEM - PRESTRESSED CONCRETE PILES &amp; FRP WALES</b>	INDEX 471-030	SHEET 3 of 7
---------------------------	--------------	--	---	------------------	-----------------