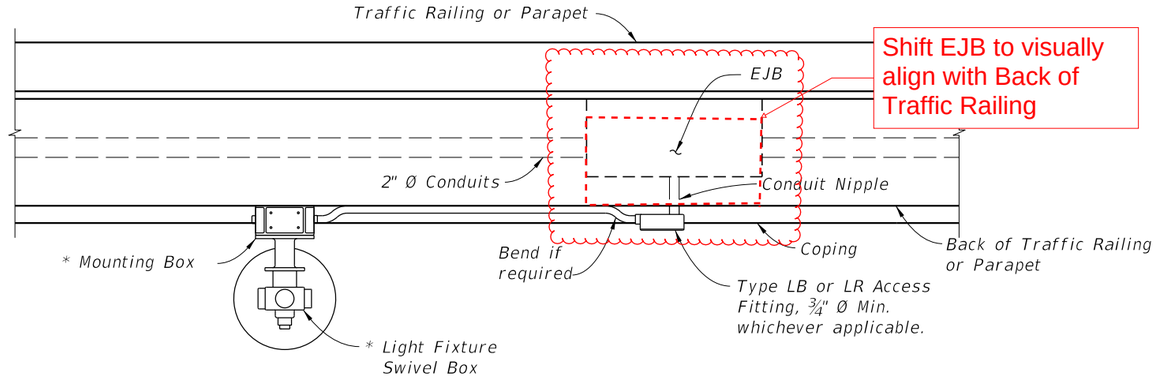

CROSS REFERENCES:
1. For Navigation Light System notes and legend, see Sheet 1.
2. See Utility Conduit Detail sheets for Embedded Junction Box (EJB) dimensions & locations.

* Supplied by Light Fixture Manufacturer

GCL OR RCL MOUNTING DETAILS (SCHEMATIC)
VIEW A-A

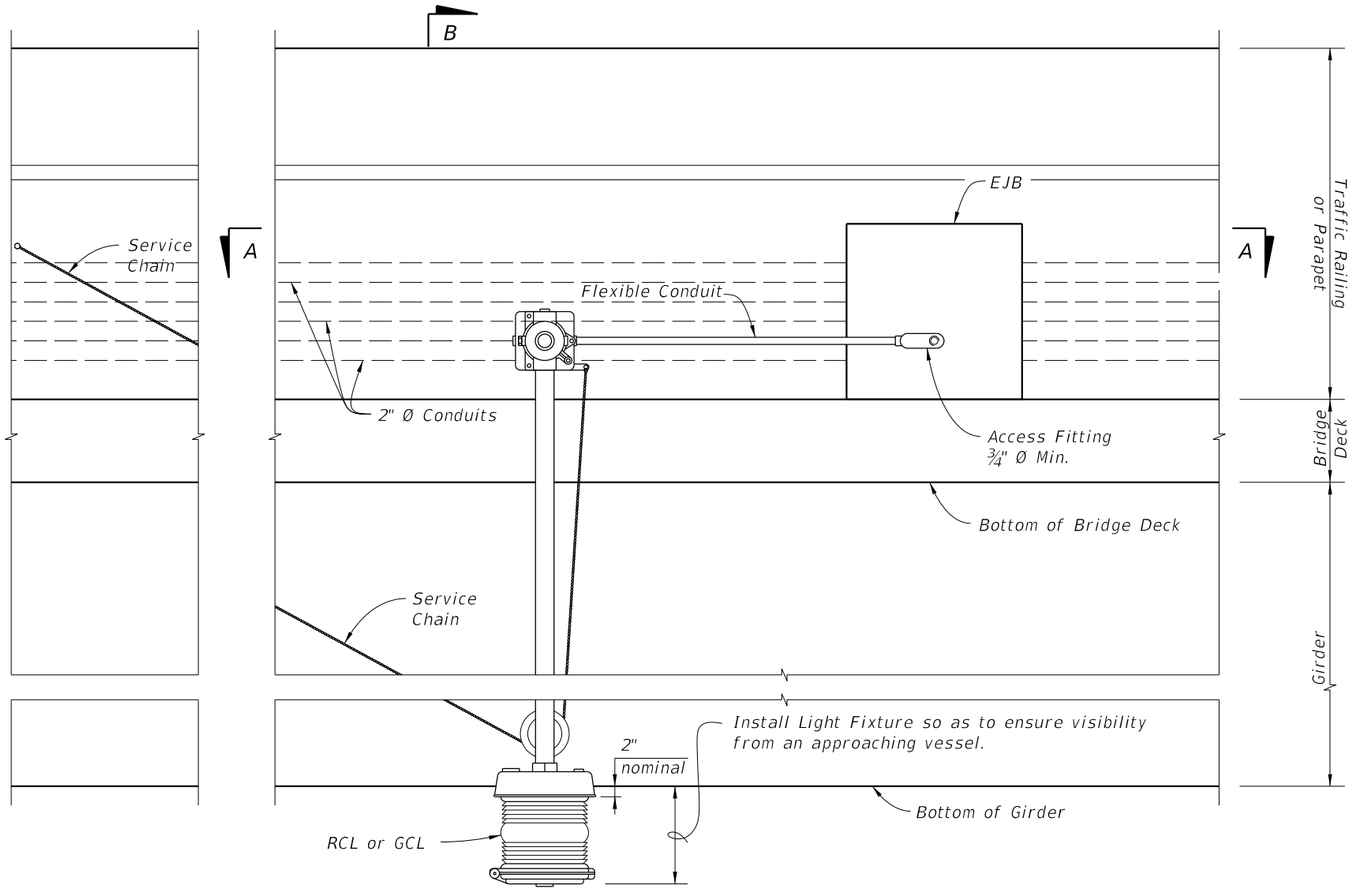

GCL OR RCL MOUNTING DETAILS (SCHEMATIC)
ELEVATION VIEW
(Traffic Railing (36" Single-Slope) shown, other railings similar)

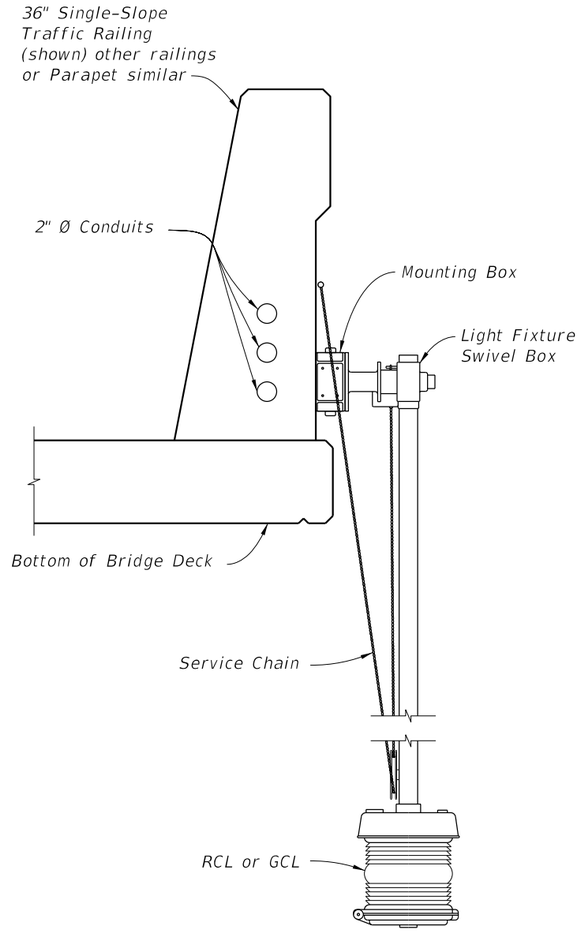

SECTION B-B
TYPICAL POSITION OF RCL OR GCL
RELATIVE TO SUPERSTRUCTURES

10/6/2022 11:20:10 AM

LAST REVISION	REVISION	DESCRIPTION:	FY 2023-24 STANDARD PLANS	NAVIGATION LIGHT SYSTEM DETAILS (FIXED BRIDGES)	INDEX	SHEET
11/01/17					510-001	2 of 2