



ISOMETRIC VIEW

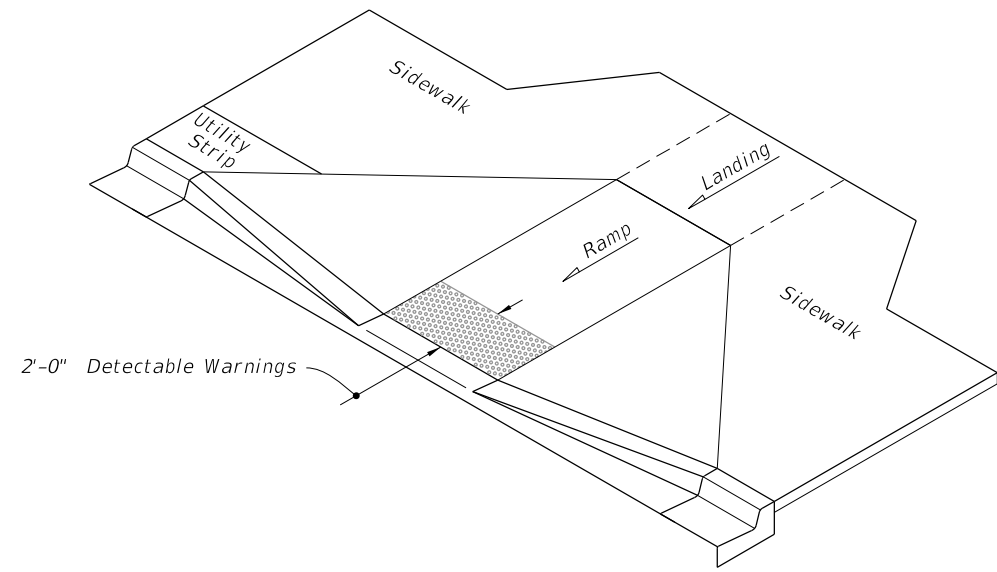


ISOMETRIC VIEW

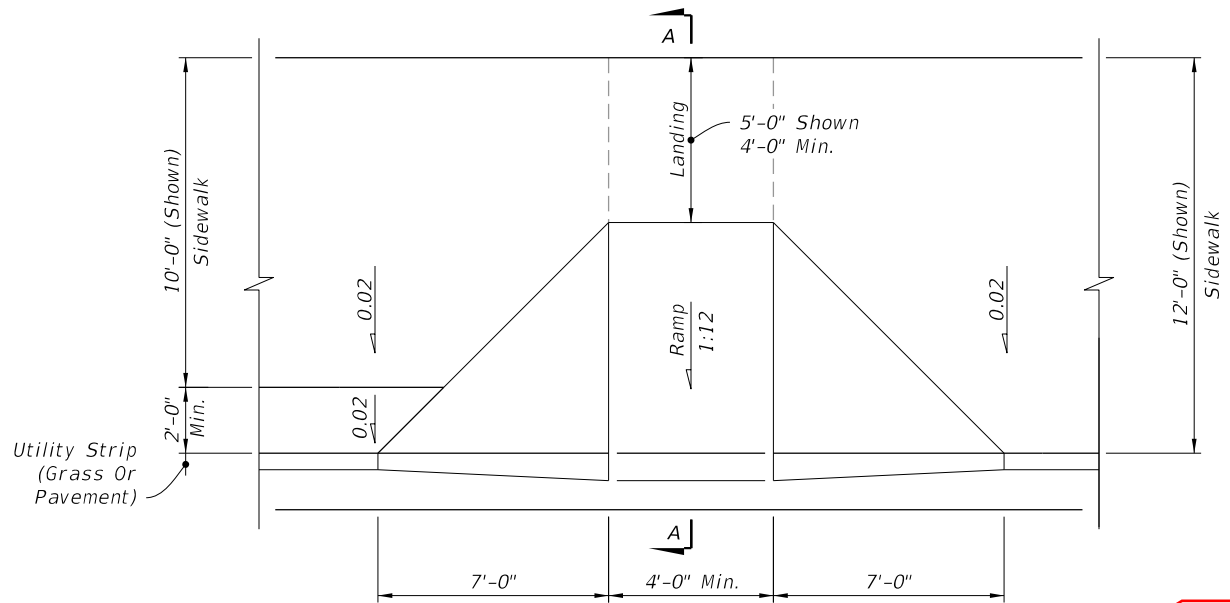

PLAN VIEW

CR-A

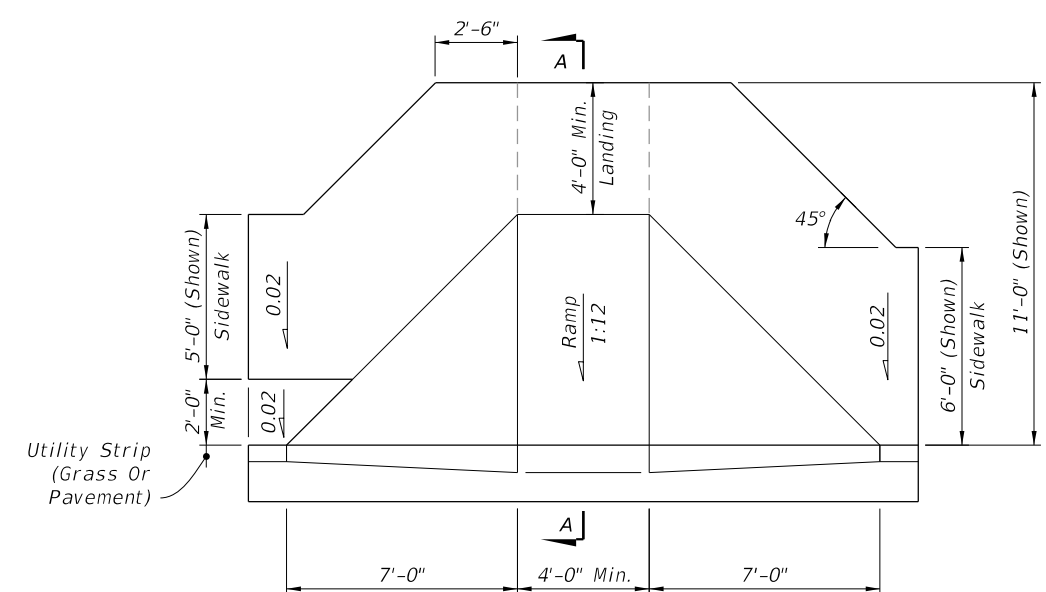


PLAN VIEW

CR-B

NOTE: For Example of CR-A used in Radial Curb Returns, See Sheet 8.

Corrected: See Sheet 7.

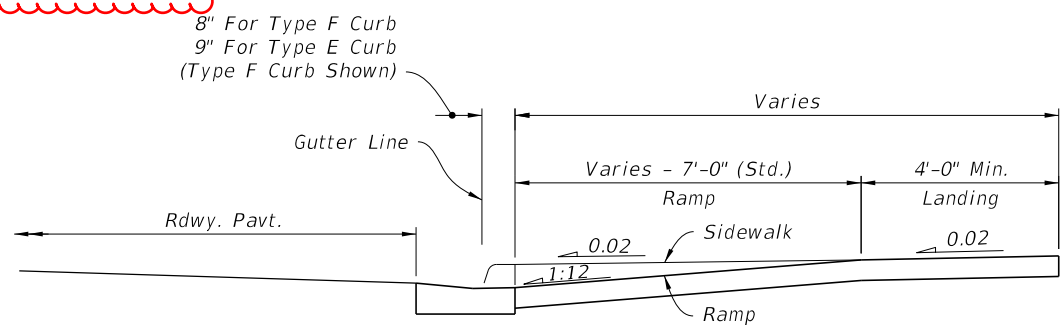

SECTION A-A

SIDEWALK CURB RAMPS CR-A AND CR-B

10/6/2022 2:15:09 PM

LAST REVISION 11/01/20	REVISION	DESCRIPTION:		FY 2023-24 STANDARD PLANS	DETECTABLE WARNINGS AND SIDEWALK CURB RAMPS	INDEX 522-002	SHEET 2 of 7
---------------------------	----------	--------------	--	------------------------------	---	------------------	-----------------