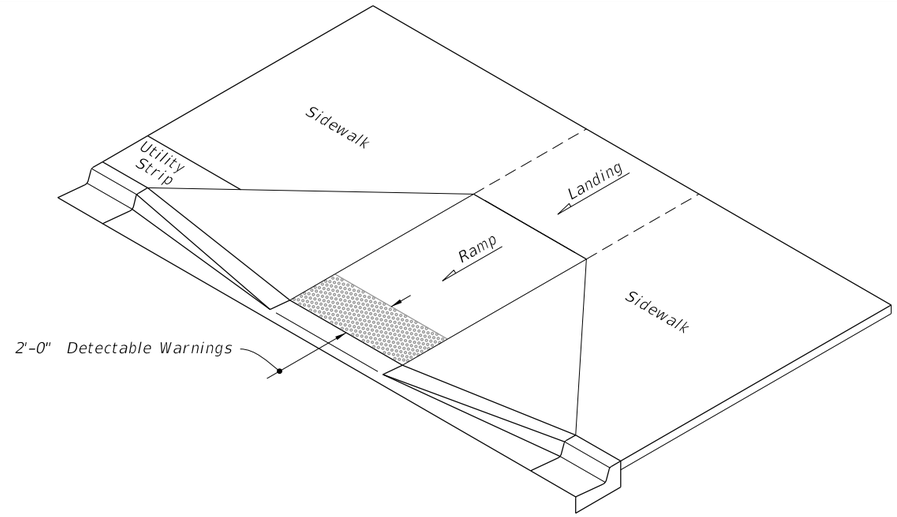

ISOMETRIC VIEW

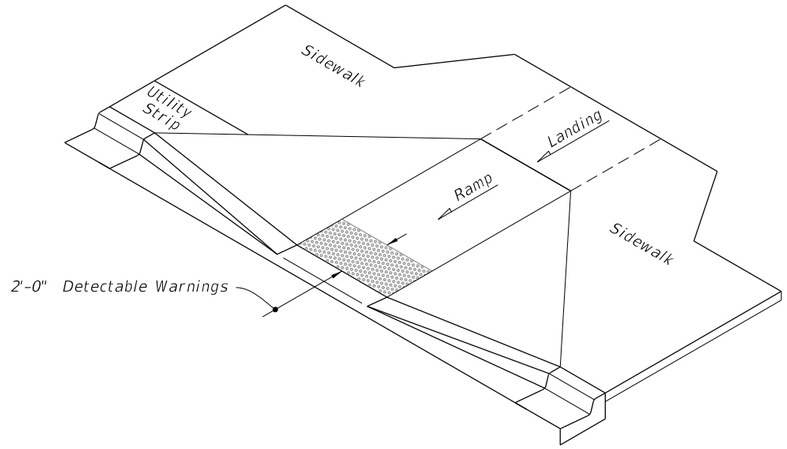

ISOMETRIC VIEW

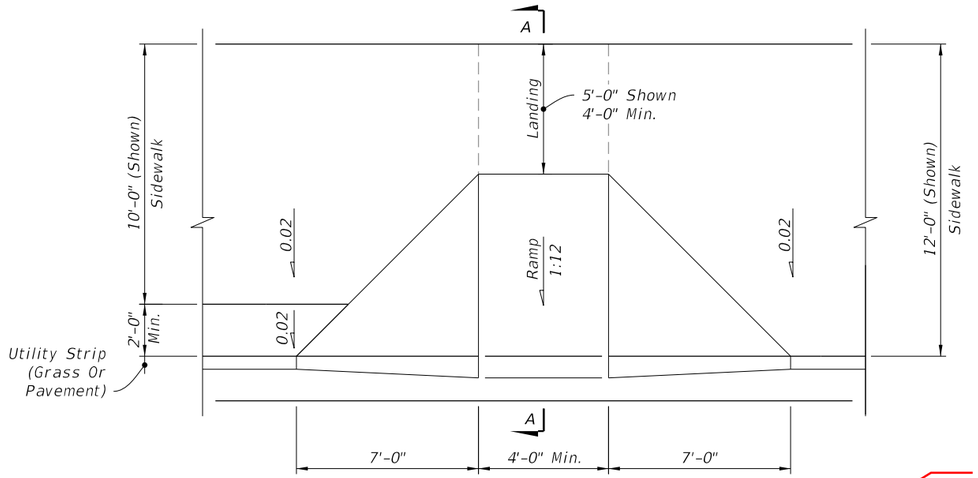

PLAN VIEW

NOTE: For Example of CR-A used in Radial Curb Returns, ~~See Sheet 8~~.

CR-A

Corrected: See Sheet 7.

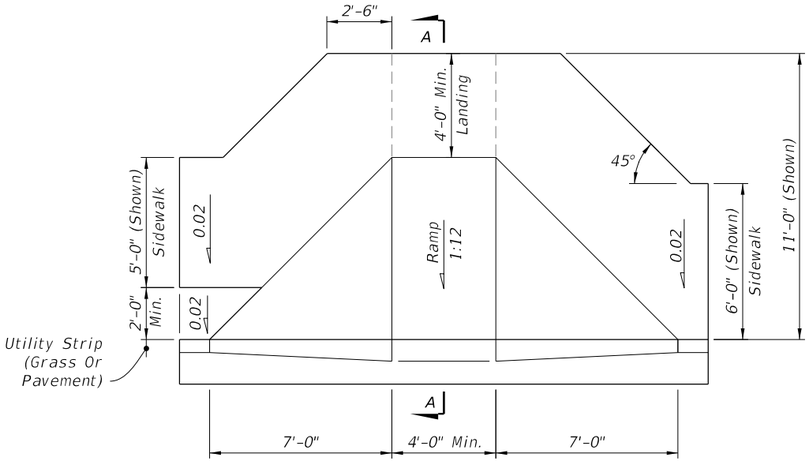

PLAN VIEW

CR-B

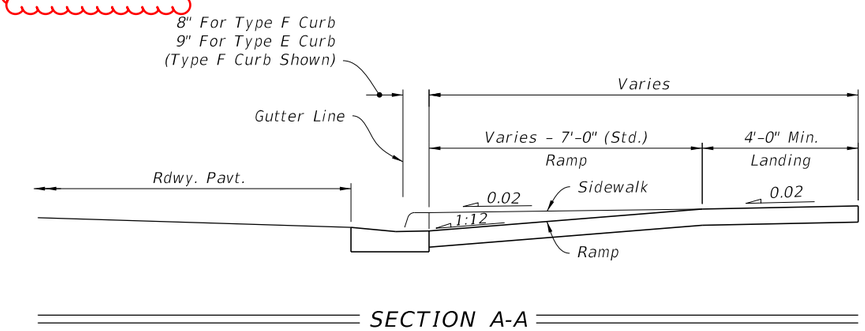

SECTION A-A

SIDEWALK CURB RAMPS CR-A AND CR-B

10/6/2022 2:15:09 PM

LAST REVISION	REVISION	DESCRIPTION:	FDOT	FY 2023-24 STANDARD PLANS	DETECTABLE WARNINGS AND SIDEWALK CURB RAMPS	INDEX	SHEET
11/01/20						522-002	2 of 7