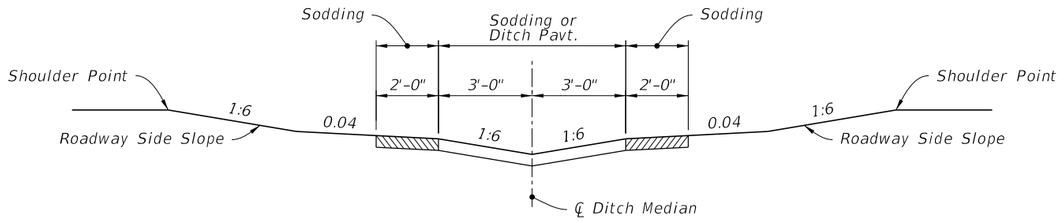

SWALED MEDIAN
(No Weep Holes)

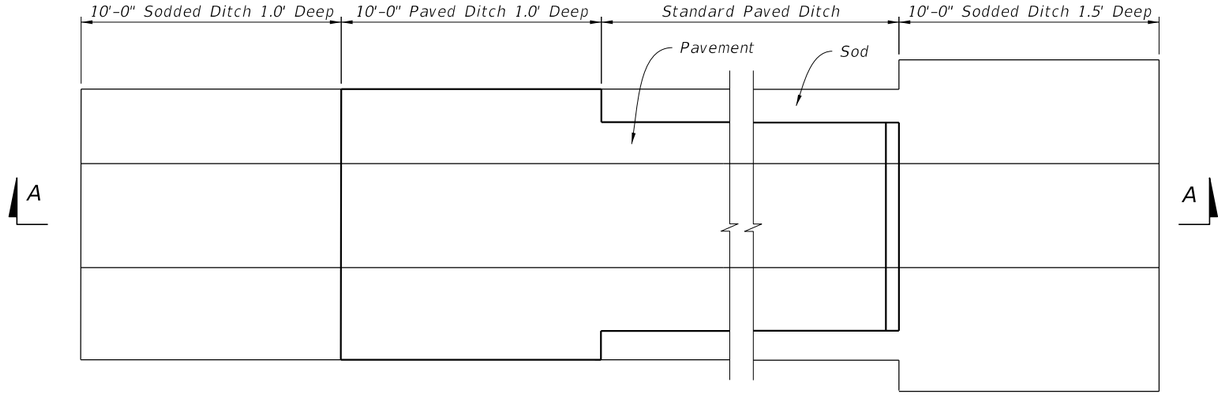

PLAN

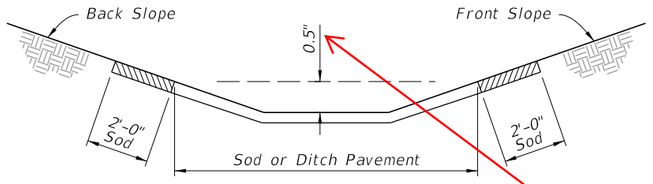

ROADWAY SIDE DITCH

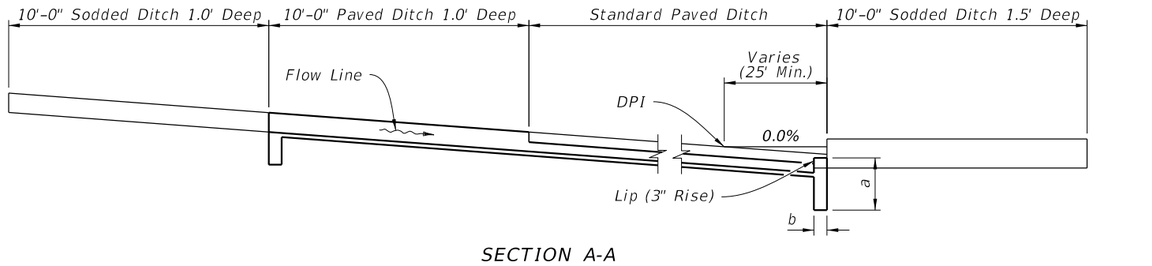

SECTION A-A

PAVED DITCH END TREATMENT

Corrected Dimension

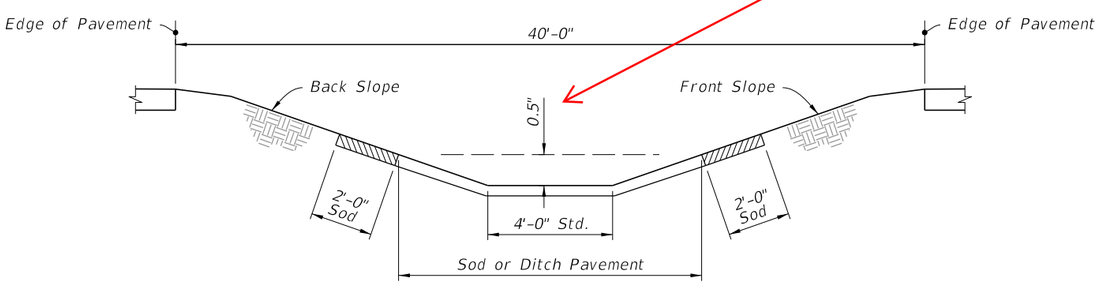

40' MEDIAN

GENERAL NOTES:

1. Install type of ditch pavement shown on Plans.
2. Construct lip at the end of ditch pavement downstream of DPI or on flatter grades where there is a decrease in ditch velocity.
3. Use toewalls with all ditch paving, except adjacent to drainage structures.
4. Construct sides of paving with 1' minimum height for junction of R/W ditch spillway and lateral ditch.
5. Install filter fabric under all ditch pavement except for miscellaneous asphalt.
6. Install ditch pavement requiring reinforcement as detailed in Plans.

10/6/2022 2:15:52 PM

LAST REVISION	REVISION	DESCRIPTION:	FY 2023-24 STANDARD PLANS	DITCH PAVEMENT AND SODDING	INDEX	SHEET
11/01/22					524-001	1 of 3