NOTES:

1. Materials:
   A. Sign panels, wind beams and associated hardware: See Index 700-020
   B. Sign adjustable hangers, wire rope clamps and associated hardware: See APL
   C. Wire and additional hardware requirements: See Specification 634

2. Type B and C Attachments:
   A. Extend wind beams to within 6" of the sign edge.
   B. Number of sign hangers required based on sign width:
      a. Sign width < 4'-0": One
      b. 4'-0" ≤ sign width ≤ 8'-0" : Two
   C. Number of wind beams required based on sign depth:
      a. Sign depth < 3'-6": One
      b. 3'-6" ≤ Sign depth ≤ 7'-0": Two

3. Type D Attachments:
   Maximum sign width = 3'-0"

4. Align the bottom edges of signs to approximately the same elevation.

5. Use a minimum of 2 bolts with a minimum spacing of 2" for overlapped connection of the adjustable hangers.

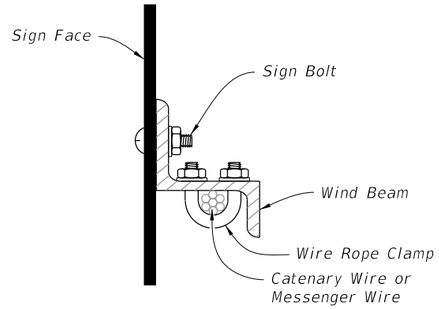

SIGN MOUNTING DETAIL

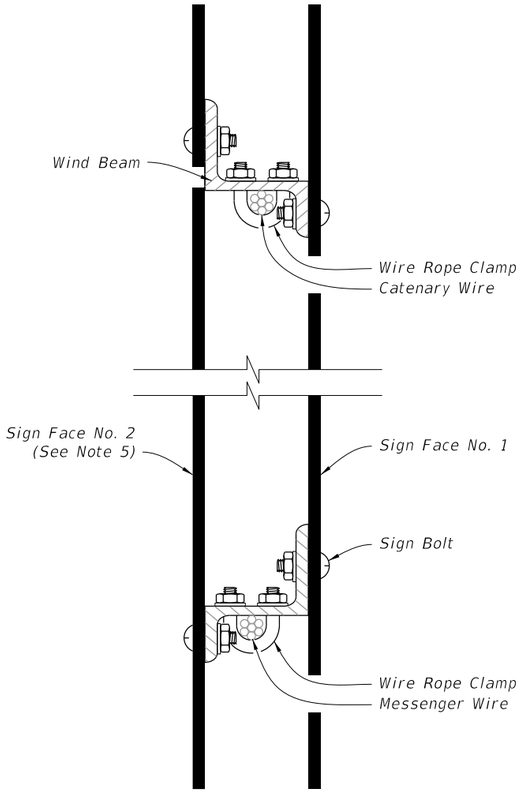

OPPOSING SIGN MOUNTING DETAIL

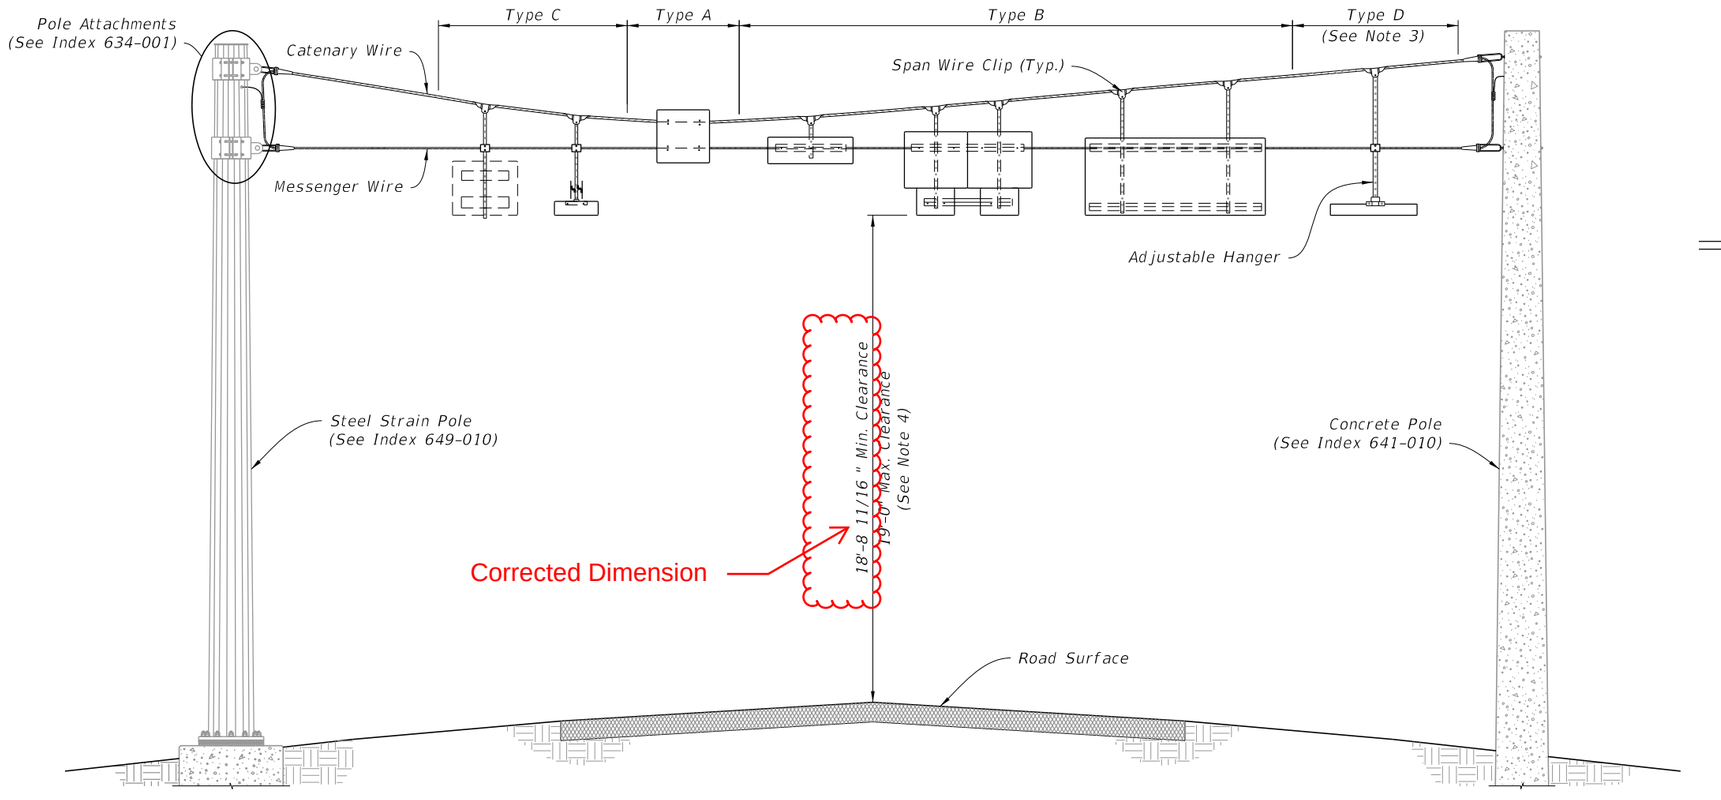

TYPICAL INSTALLATIONS FOR SIGN PANEL(S) MOUNTED ON SPAN WIRE

12/19/2022 7:42:15 AM

LAST REVISION	REVISION	DESCRIPTION:				
11/01/21			FDOT FY 2023-24 STANDARD PLANS	SPAN WIRE MOUNTED SIGN DETAILS	INDEX 659-010	SHEET 1 of 1