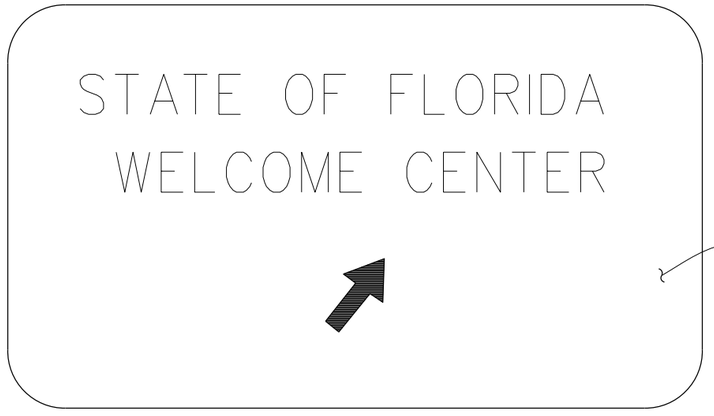

FRONT ELEVATION

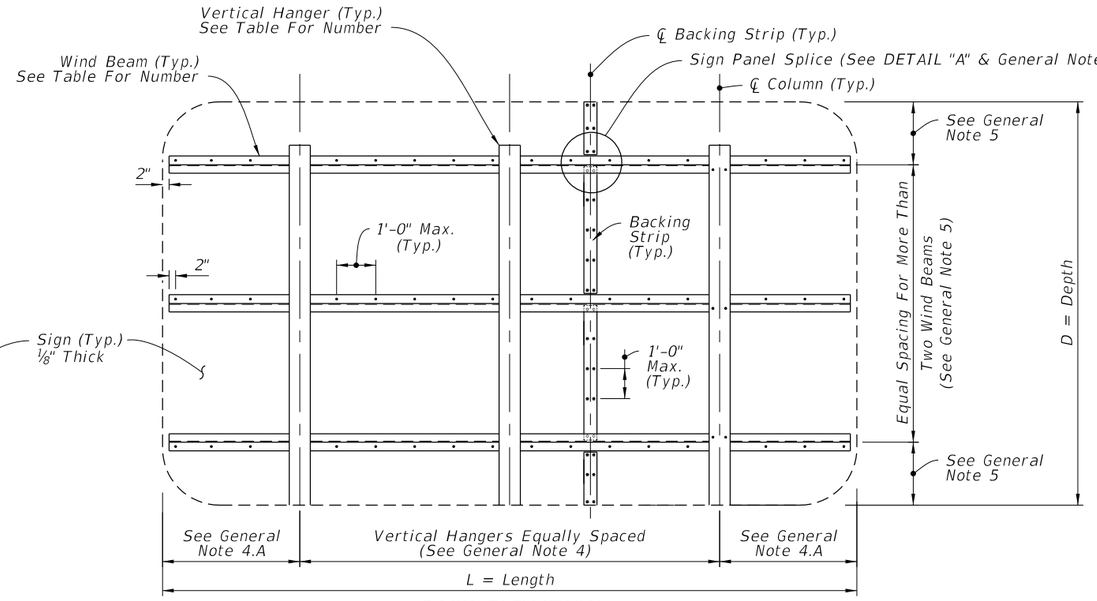

BACK ELEVATION

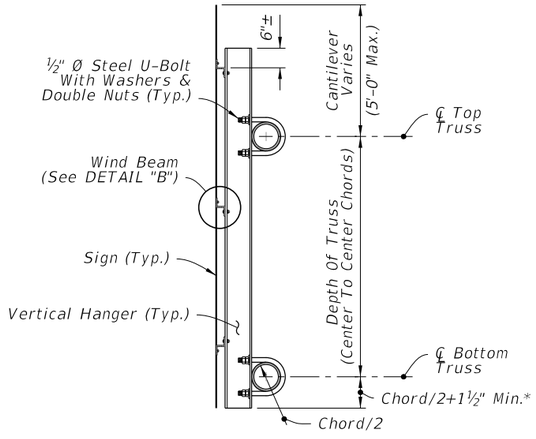

*Bottom Justified Shown, Center Justified Similar.

SIDE ELEVATION

TYPICAL SIGN FOR OVERHEAD TRUSS

WIND BEAM TABLE (Z 3 x 2 11/16 x 2.33)				
Number of Horizontal Wind Beams Based on Sign Depth (D)				
2 Beams	3 Beams	4 Beams	5 Beams	6 Beams
D ≤ 5'	5' < D ≤ 9'	9' < D ≤ 12'	12' < D ≤ 15'	15' < D ≤ 18'

HANGER TABLE (I 6 X 4 x 4.69 or Z 5 x 3¼ x 4.01)					
Number of Vertical Hanger Beams Based on Wind Speed and Sign Length (L)					
	2 Hangers	3 Hangers	4 Hangers	5 Hangers	6 Hangers
130 mph	L ≤ 20'	20' < L ≤ 30'	30' < L ≤ 40'	40' < L ≤ 50'	--
150 mph	L ≤ 18'	18' < L ≤ 27'	27' < L ≤ 35'	35' < L ≤ 45'	45' < L ≤ 50'
170 mph	L ≤ 15'	15' < L ≤ 20'	20' < L ≤ 28'	28' < L ≤ 35'	35' < L ≤ 43'

NOTE: For Monroe County designs, use 170 mph values but with Z 5 x 3-¼ x 6.19 vertical hanger beams only.

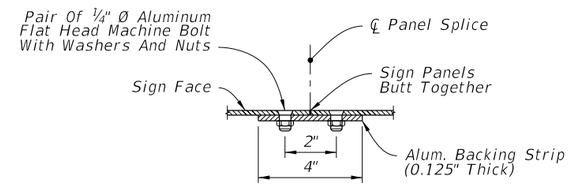

PLAN VIEW

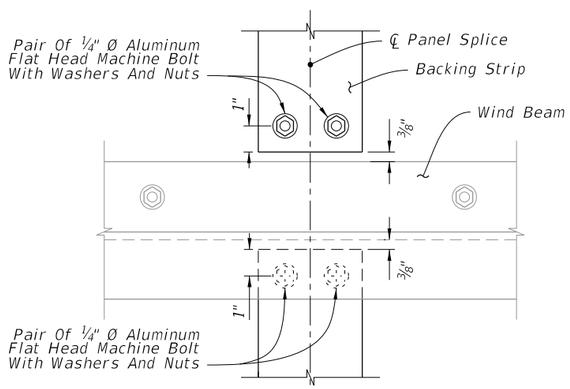

ELEVATION

SIGN PANEL SPLICE

DETAIL "A"

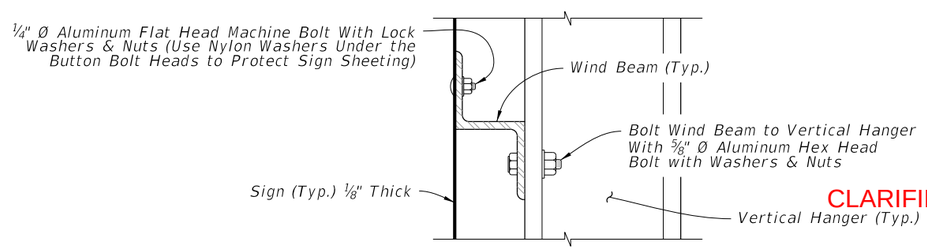

DETAIL "B"

GENERAL NOTES

1. Meet the requirements of Specification 700.
2. Work this Index with Index 700-040 and 700-041.
3. The number and location of the Panel Splices are determined by the Sign Face supplier.
4. Spacing of Vertical Hangers:
   A. Two Vertical Hanger = 21.0% L
      Three Vertical Hanger = 15.0% L
      Four Vertical Hanger = 11.0% L
      Five Vertical Hanger = 9.0% L
      Six Vertical Hanger = 7.0% L
   B. Spacing of vertical hangers may be varied slightly as necessary to clear the truss struts and diagonals at panel points
5. Spacing of Wind Beams:
   Two Wind Beams = 21.0% D
   Three Wind Beams = 15.0% D
   Four Wind Beams = 11.0% D
   Five Wind Beams = 9.0% D
   Six Wind Beams = 7.0% D
6. Shop Drawings:
   A. Required for Sign Panels deeper than 10'-0" with a horizontal panel splice.
   B. Splice must be located in between interior Zee Supports and only allowed on signs greater than 10'-0".
7. Wind Speed by county: see Index 715-010.

CLARIFIED NOTES

8 Materials:
A. Aluminum:
a. Bars, and Extruded Shapes: ASTM B221, Alloy 6061-T6 or Alloy 6351-T5
b. Structural Shapes: ASTM B221, Alloy 6061-T6
c. Flat Head and Hex Head Machine Bolts: ASTM F468, Alloy 2024-T4
d. Hex Nuts: ASTM F467, Alloy 6061-T6 or Alloy 6262-T9
e. Washers: ASTM B221, Alclad 2024-T4
B. Steel:
a. U-Bolts: ASTM A449 or ASTM A193 B7
b. Nuts: ASTM A563, 2 per leg
c. Washers: ASTM F436, (Flat Washers)

10/6/2022 2:36:47 PM

LAST REVISION	REVISION	DESCRIPTION:	FDOT	FY 2023-24 STANDARD PLANS	WIND AND HANGER BEAMS FOR O...	SHEET
11/01/22					700-030	1 of 1