## GENERAL NOTES:

1. Meet the requirements of Specification 700.

2. Shop Drawings are required:

   A. Provide length as shown in the Plans
   B. Design in accordance with AISC, AASHTO, and OSHA requirements
   B. Do not start fabrication until the shop drawings are approved

3. Catwalk hangers must be positioned to avoid conflicts with the sign structure truss and gusset plates. Place walkway close to the sign with a maximum open distance from walkway grate to DMS sign of ½".

4. Maximum spacing of Catwalk hanger supports is 5'–0". Cantilever ends of grating is 8".

5. Galvanized steel catwalk grating meeting the requirements of Specification 504–2.3. Must Support a 90 psf load and have a 3½" minimum toe kick. Attach grating in accordance with the manufacturer's instructions using stainless steel or galvanized fasteners.

6. Supply and install an OSHA 1910 compliant, self closing, hot dip galvanized safety gate. Install per manufactures instructions.

7. Chain link fabric options (2" mesh with knuckled selvage top and bottom for all options):

   A. AASHTO M181 Type I – Zinc Coated Steel, No. 9 gage (coated wire diameter), coated at the rate of 1.8 oz/ft². (M181 Class D 2.0 oz./ft². modified to 1.8 oz./ft².).
   B. AASHTO M181 Type II – Aluminum Coated Steel, No. 9 gage (coated wire diameter), coated at the rate of 0.40 oz./ft².

8. Install 2" NPS (Sch. 40) guiderail and posts: ASTM A53 Grade B for standard weight pipe.

9 ~~10~~. Materials:

   A. Steel Plates ASTM A 36 or A709 Grade 36.
   B. W– Sections: ASTM A572 Grade 36 or 50.

CLARIFIED NOTES

| TABLE OF CONTENTS: | |
|---|---|
| Sheet | Description |
| 1 | General Notes and Content |
| 2 | General Assembly and Fixed Base Details |
| 3 | Walkway Support Details |

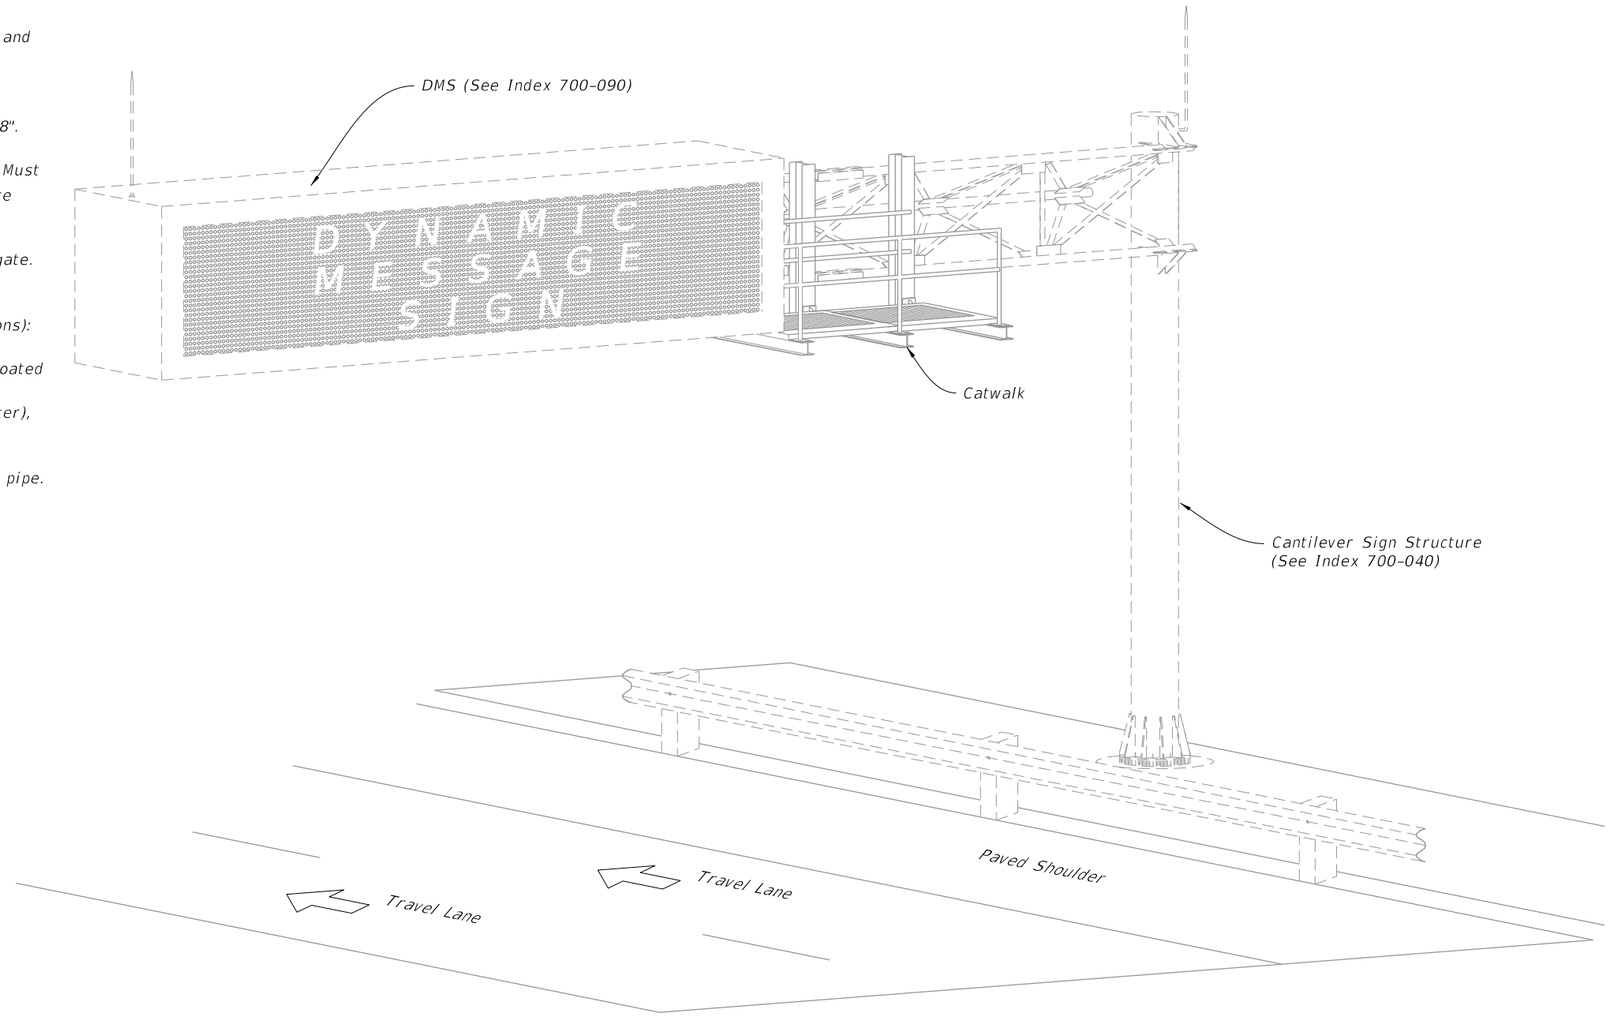


CATWALK ASSEMBLY
(Cantilever Shown, Span Similar)

12/13/2022 8:40:20 AM

| LAST REVISION | REVISION | DESCRIPTION: | FY 2023-24 STANDARD PLANS | CATWALK DETAILS | INDEX | SHEET |
|---|---|---|---|---|---|---|
| 11/01/22 | | | | | 700-091 | 1 of 3 |