8.1 S.F.

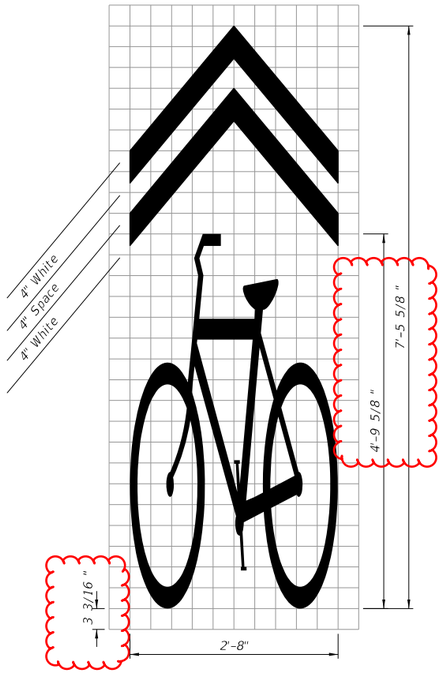

SHARED LANE MARKING (SLM)

6.3 S.F.

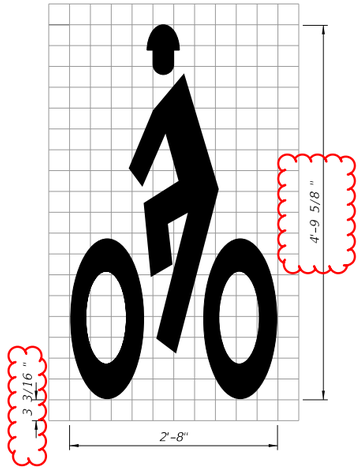

HELMETED BICYCLIST SYMBOL

4.2 S.F.

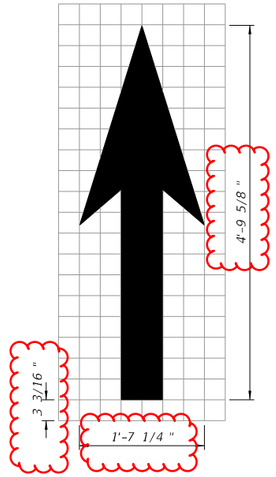

BIKE LANE ARROW

9.0 S.F.

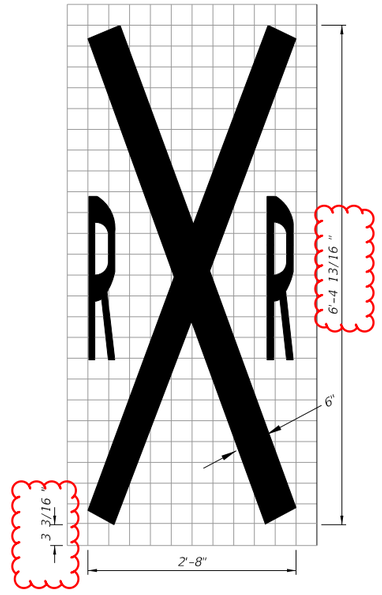

RAILROAD CROSSING

NOTES:

1. All bicycle markings and pavement messages shall be White.
2. All bicycle markings shall be preformed thermoplastic.
3. All grids are 4" x 4".

Corrected dimensions due to printing error.

STANDARD PAVEMENT MARKING MESSAGE LAYOUTS

10/6/2022 2:41:28 PM

LAST REVISION	REVISION	DESCRIPTION:	FDOT	FY 2023-24 STANDARD PLANS	BICYCLE MARKINGS	INDEX	SHEET
11/01/17						711-002	1 of 2