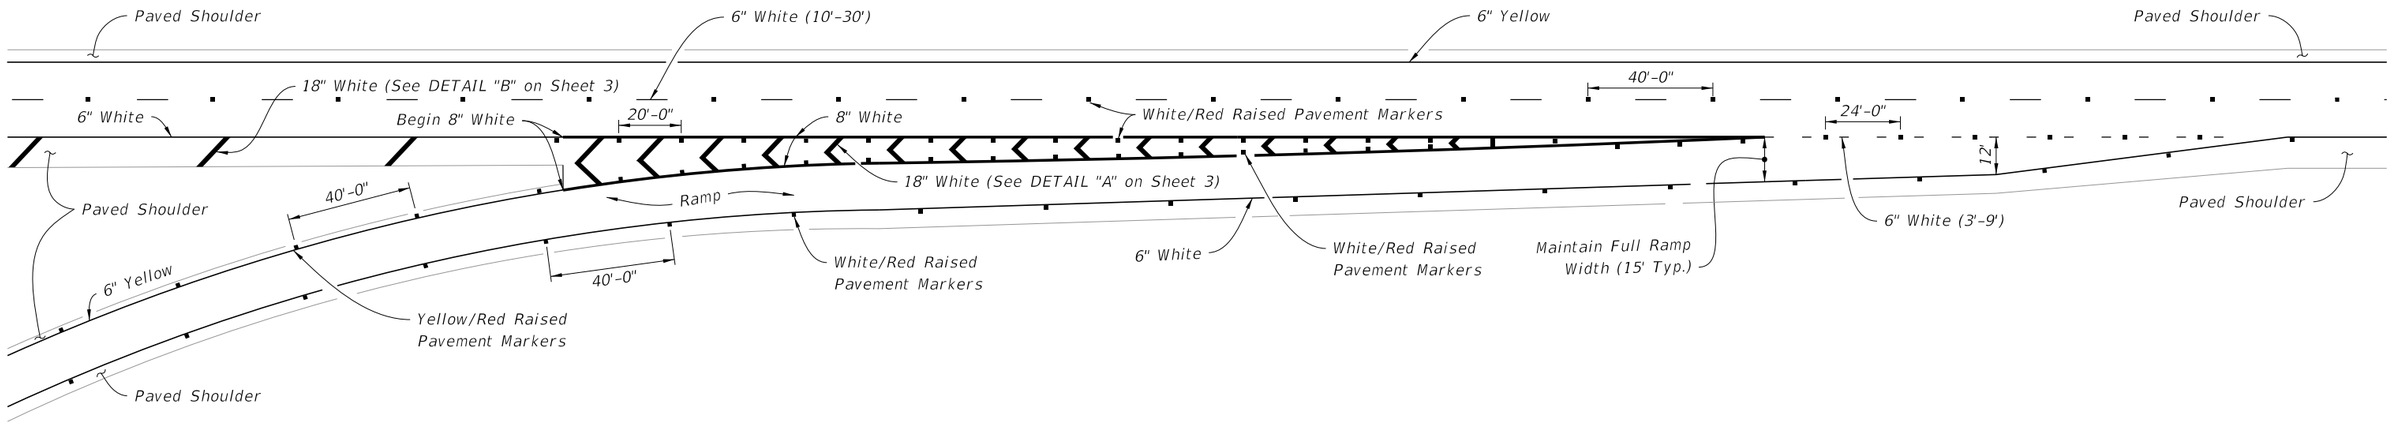

TAPER - TYPE ENTRANCE

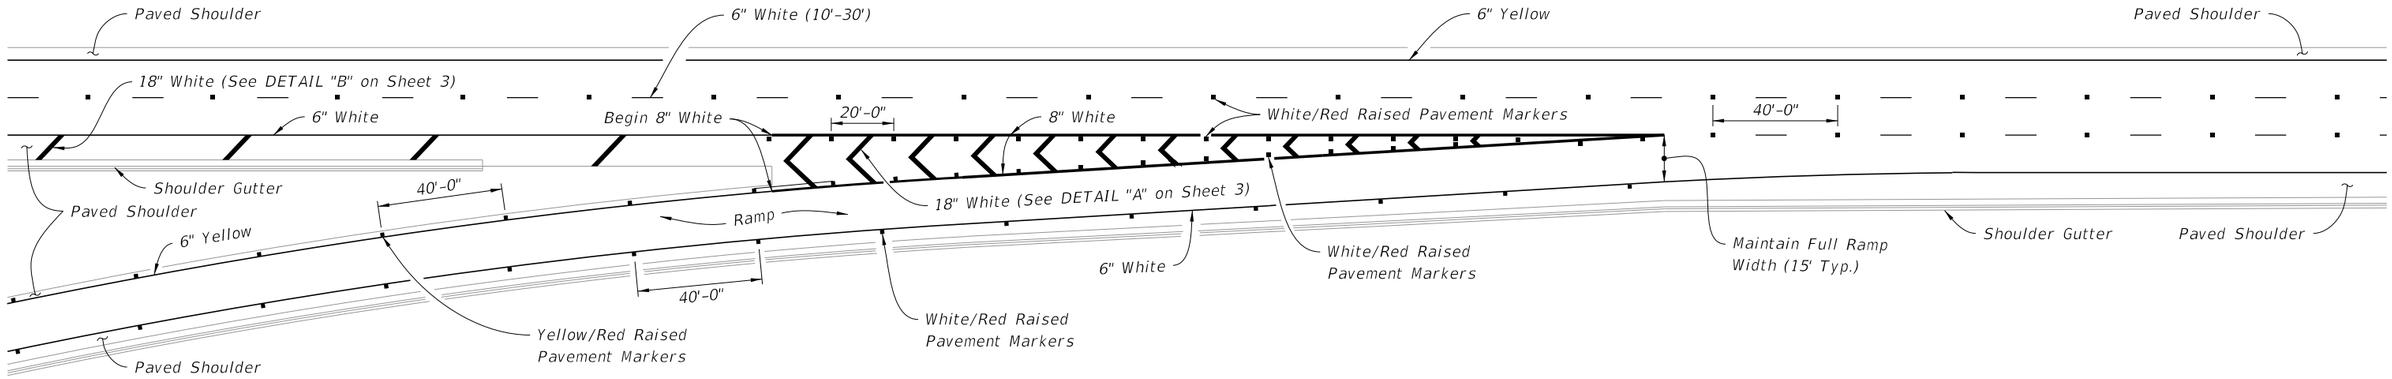

PARALLEL - TYPE ENTRANCE

Added General Note due to Printing Error

SINGLE LANE RAMPS - ENTRANCE TERMINALS

LAST REVISION	REVISION	DESCRIPTION:	FDOT	FY 2023-24 STANDARD PLANS	INTERCHANGE MARKINGS	INDEX	SHEET
11/01/21						711-003	1 of 8

10/6/2022 2:41:44 PM