


TAPER - TYPE ENTRANCE

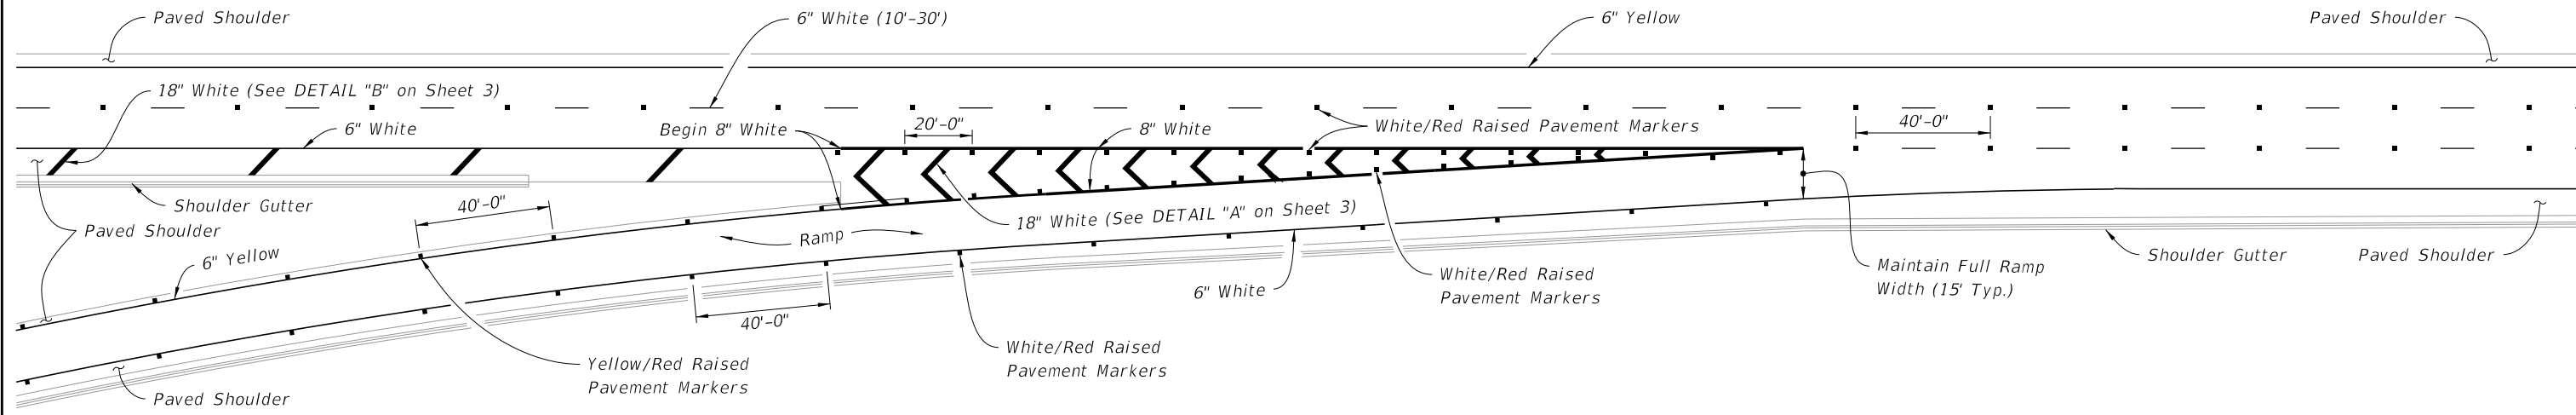

PARALLEL - TYPE ENTRANCE

Added General Note due to Printing Error

10/6/2022 2:41:44 PM

SINGLE LANE RAMPS - ENTRANCE TERMINALS

LAST REVISION 11/01/21	REVISION	DESCRIPTION:	 FY 2023-24 STANDARD PLANS	INTERCHANGE MARKINGS	INDEX 711-003	SHEET 1 of 8
---------------------------	----------	--------------	--	----------------------	------------------	-----------------