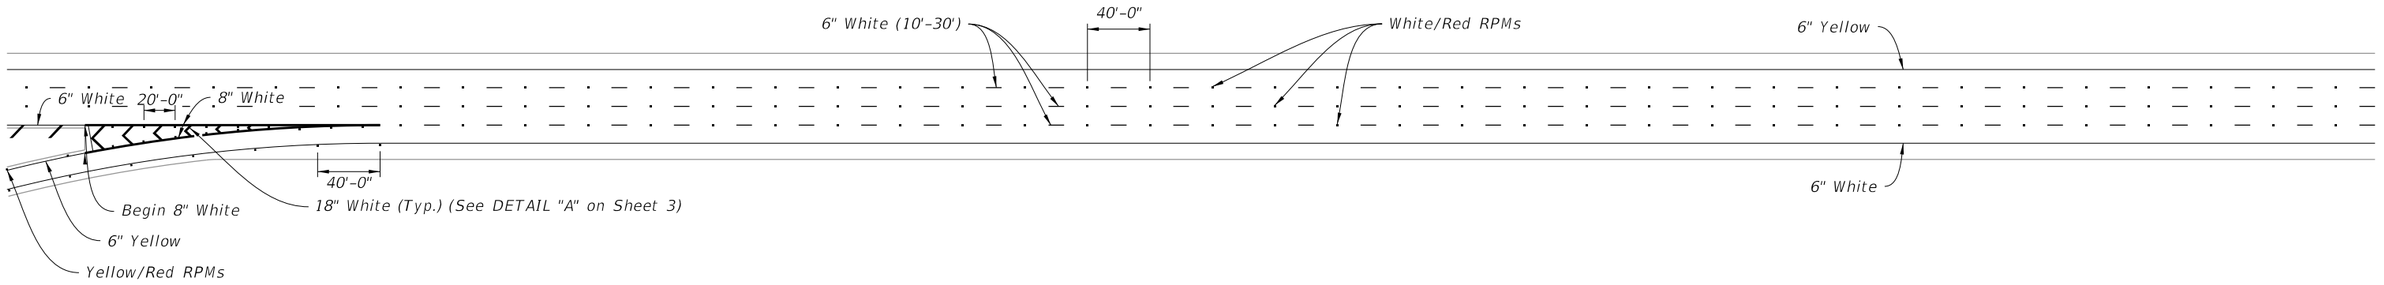

PARALLEL-TYPE ENTRANCE WITH ADDED LANE

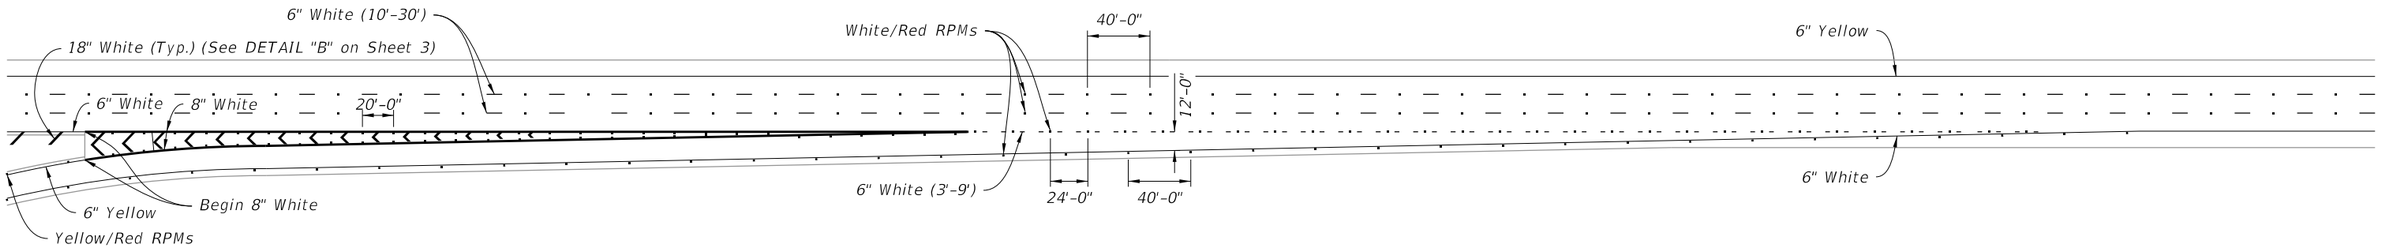

TAPER-TYPE ENTRANCE

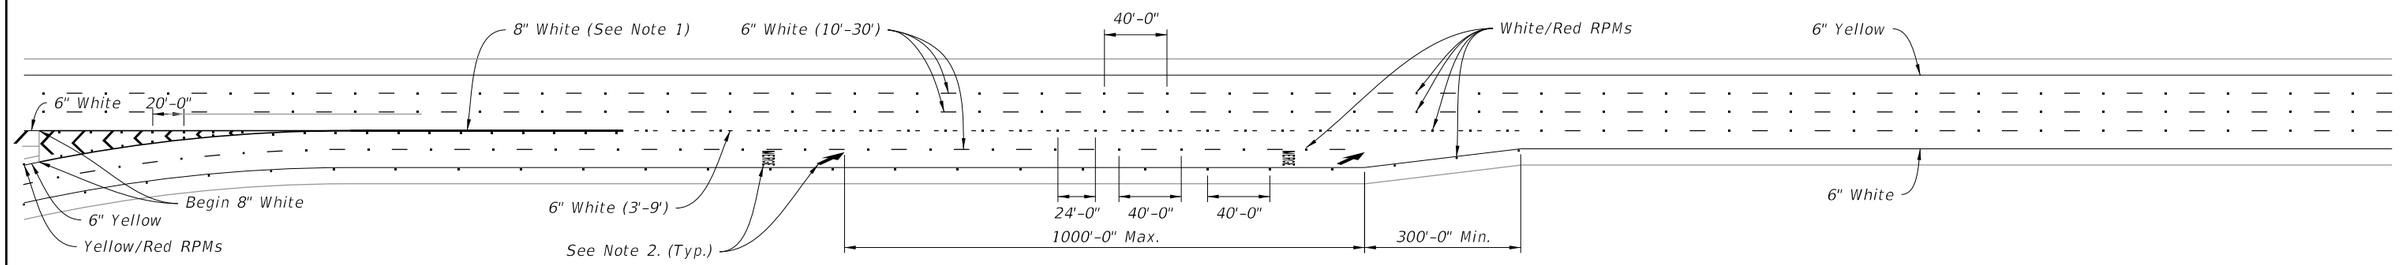

TWO-LANE PARALLEL-TYPE ENTRANCE WITH ADDED LANE
(Single-Lane Parallel-Type Entrance Without Added Lane Similar, See Note 3)

NOTES:

1. Extend this 8" white Pavement Marker one-fourth the length of the acceleration lane from the gore markings.
2. See Index 711-001 for pavement message dimensions and details.
3. Discontinue the 6" White (3'–9') Dotted Interchange Line where the merging taper begins for a Single-Lane Parallel-Type Entrance Without Added Lane. Merge Pavement Message and Arrow only used for Two-Lane Entrances.

Revised Note to clarify use of dotted interchange line.

TYPICAL PAVEMENT MARKINGS AT ENTRANCE RAMPS

LAST REVISION	REVISION	DESCRIPTION:	FY 2023-24 STANDARD PLANS	INTERCHANGE MARKINGS	INDEX	SHEET
11/01/21					711-003	2 of 8

10/6/2022 2:41:44 PM