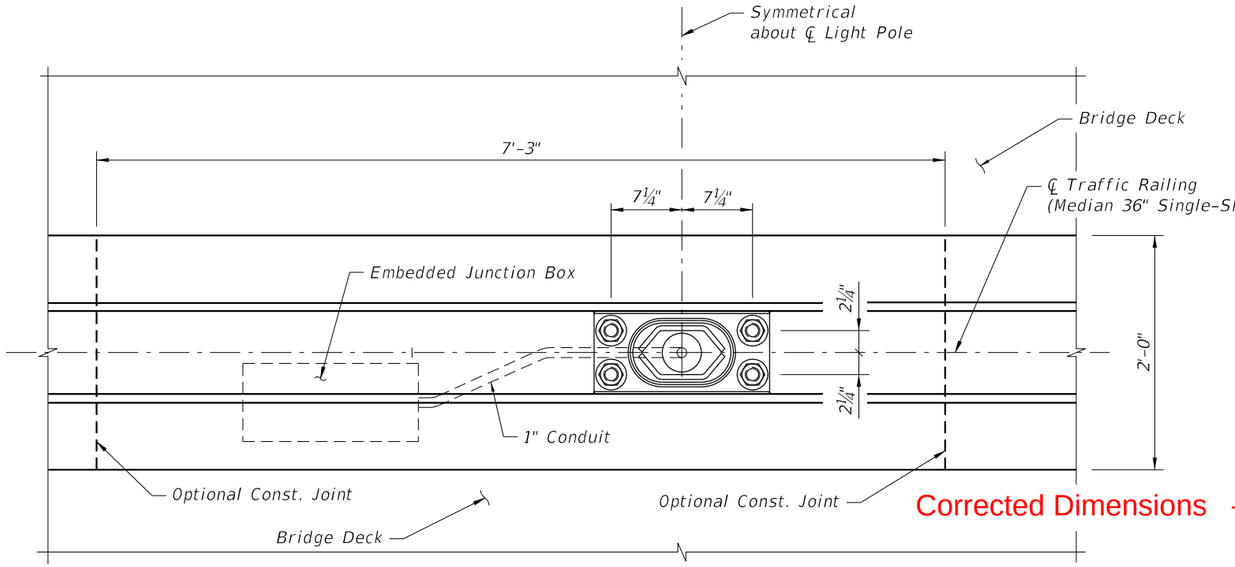

PLAN

(Reinforcing steel and 2" Ø Conduit not shown)

Corrected Dimensions

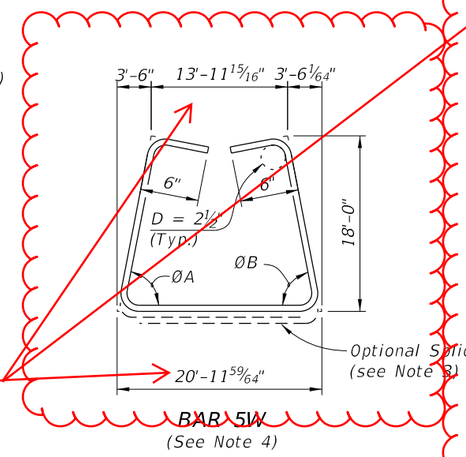

BAR 5W

(See Note 4)

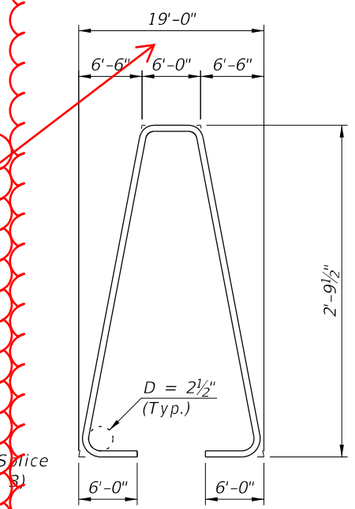

BAR 5R

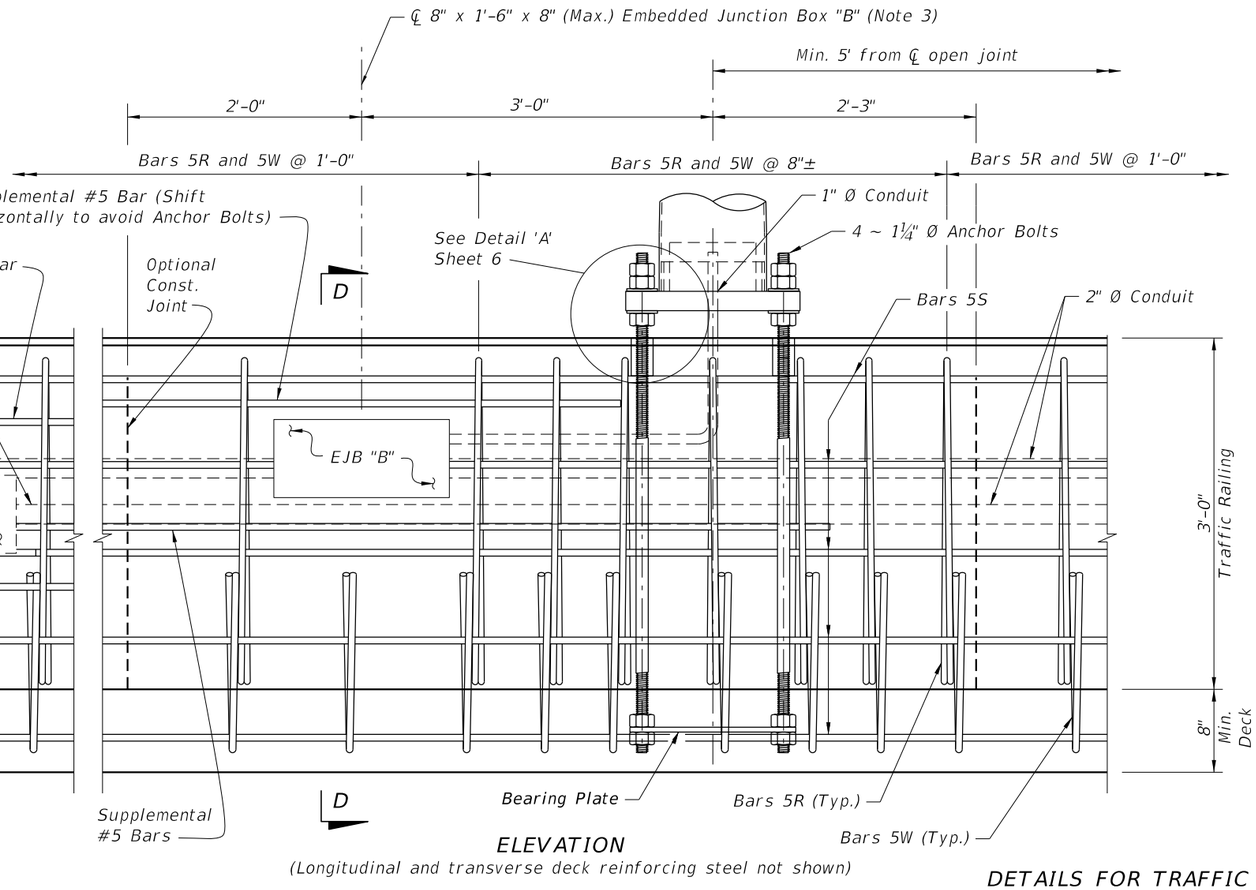

ELEVATION

(Longitudinal and transverse deck reinforcing steel not shown)

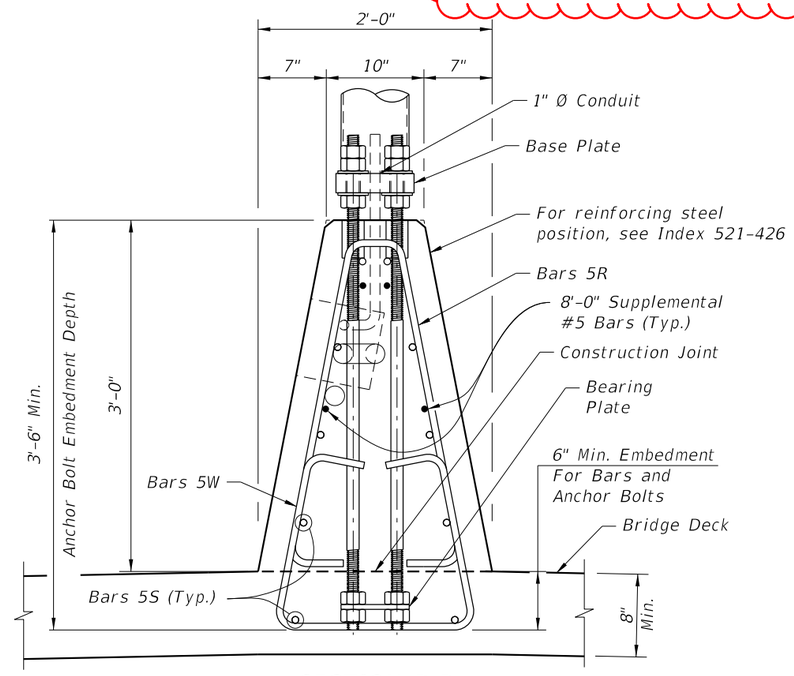

SECTION D-D

(Longitudinal and transverse deck reinforcing steel not shown)

NOTES:

1. For Base Plate Details, Bearing Plate Details, and Detail 'A', see Sheet 6.
2. See Index 521-426 for details of adjacent Traffic Railing (Median 36" Single-Slope) and for angles ∅A and ∅B.
3. See Index 630-010 for Conduit, EJB and supplemental reinforcing details.
4. At the Contractor's option, Bars 5W may be fabricated as a two piece bar with a 1'-2" lap splice at the bottom legs.

DETAILS FOR TRAFFIC RAILING (MEDIAN 36" SINGLE-SLOPE) MOUNTED ALUMINUM LIGHT POLE