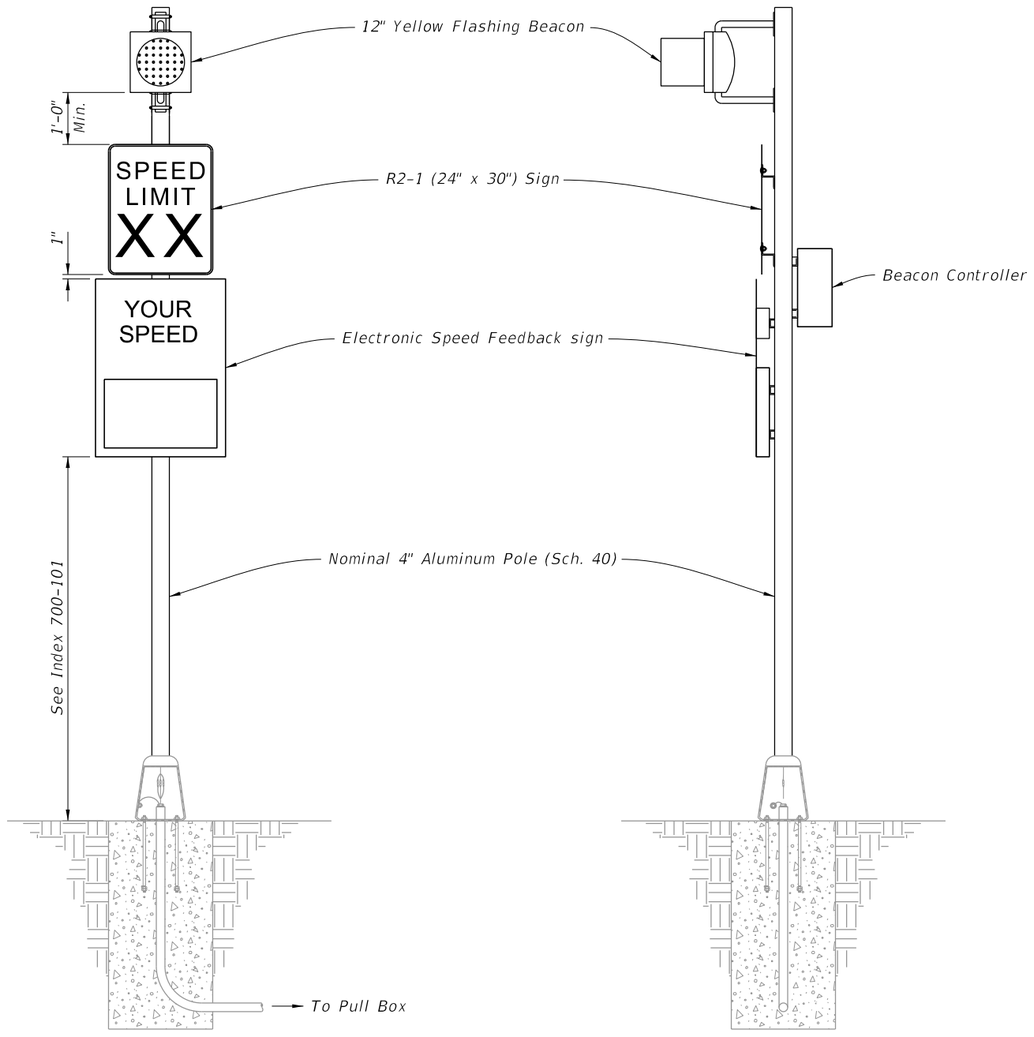

FRONT ELEVATION

SIDE ELEVATION

Update Note to match Roadside Sign Assembly number (A4 and B4)

NOTES:

1. Type A6 Assembly (conventionally powered) is shown. Type B6 Assemblies (solar powered) similar.

2. Use electronic speed feedback sign with 15" high numerals for posted speed of 45 mph or less, and 18" high numerals for posted speeds greater than 45 mph.

3. Foundation reinforcement not shown.

ROADSIDE SIGN ASSEMBLY-4

9/29/2025 8:08:21 AM

LAST REVISION	REVISION	DESCRIPTION:	FDOT FY 2026-27 STANDARD PLANS	ENHANCED HIGHWAY SIGNING ASSEMBLIES	INDEX	SHEET
11/01/24					700-120	7 of 13

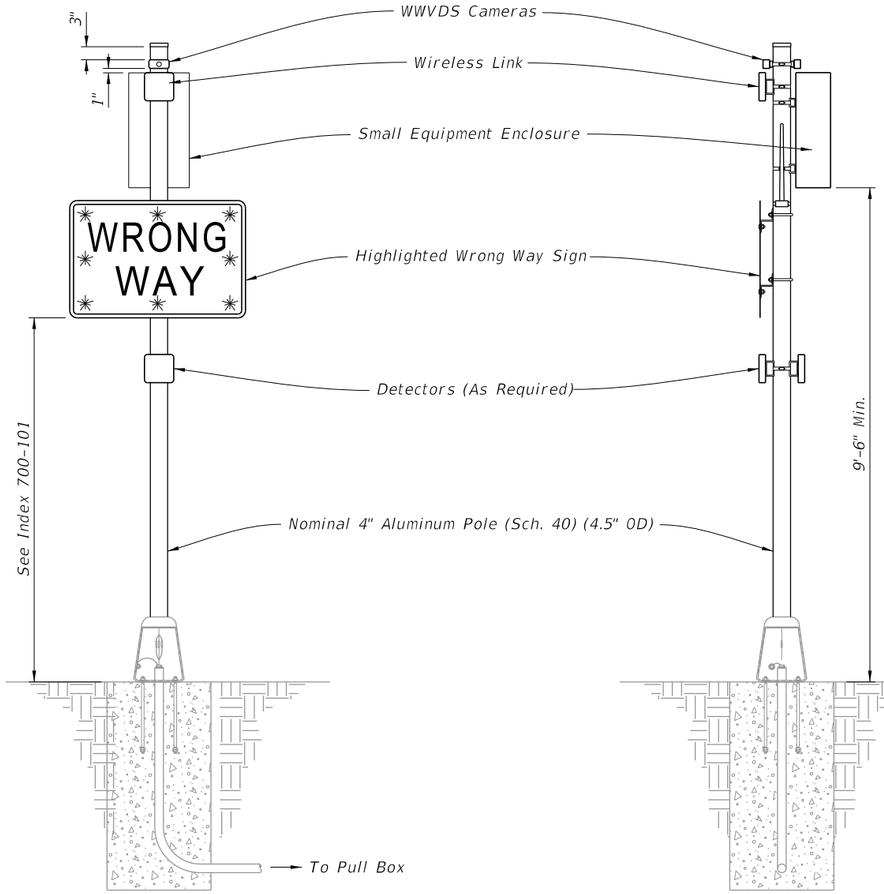

FRONT ELEVATION

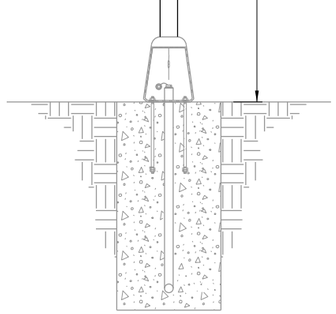

SIDE ELEVATION

WRONG WAY HIGHLIGHTED SIGN ASSEMBLY

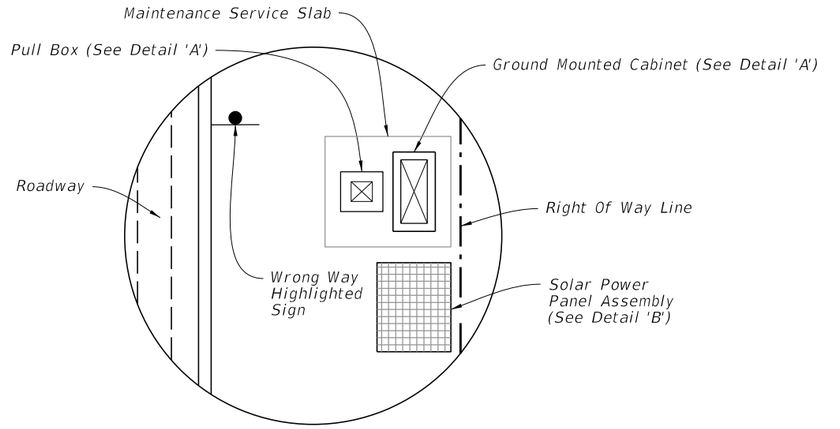

PLAN VIEW

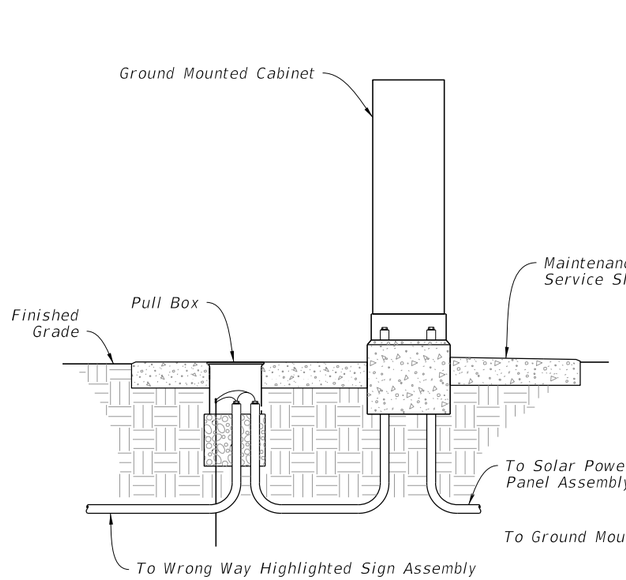

DETAIL 'A'

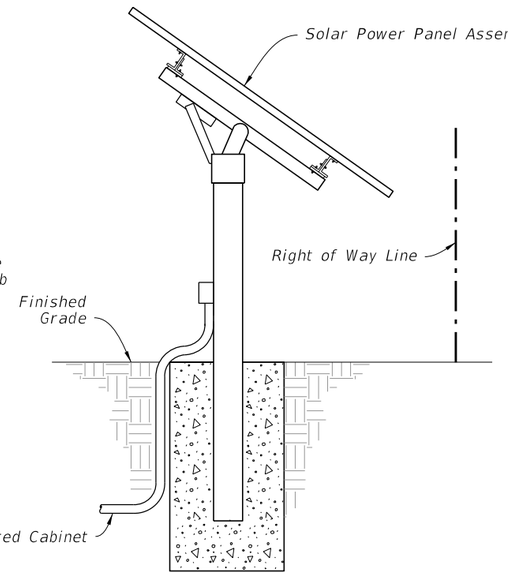

DETAIL 'B'

SOLAR POWER ASSEMBLY

NOTES:

1. Install Wrong Way Vehicle Detection System (WWVDS) devices including cameras, detectors, wireless links, antennas, enclosures, and electronics in accordance with the manufacturer's instructions.

2. When a solar powered configuration (Type B2) is called for in the Plans, install a ground mounted cabinet and solar power panel assembly. Install the solar charge controller and batteries in the same ground mounted cabinet. Provide a separate pole for mounting the solar panel (DETAIL 'B' shown for illustration purposes only) and install in accordance with manufacturer's instructions. Locate the Solar Power Assembly as close to the right of way as possible. Orient the solar panel to face South.

3. Foundation reinforcement not shown.

4. Install cabinets in accordance with Index 676-010.

Update Note to match Roadside Sign Assembly number (B5)

ROADSIDE SIGN ASSEMBLY-5

9/29/2025 8:08:27 AM

LAST REVISION	REVISION	DESCRIPTION:	FY 2026-27 STANDARD PLANS	ENHANCED HIGHWAY SIGNING ASSEMBLIES	INDEX	SHEET
11/01/24					700-120	8 of 13

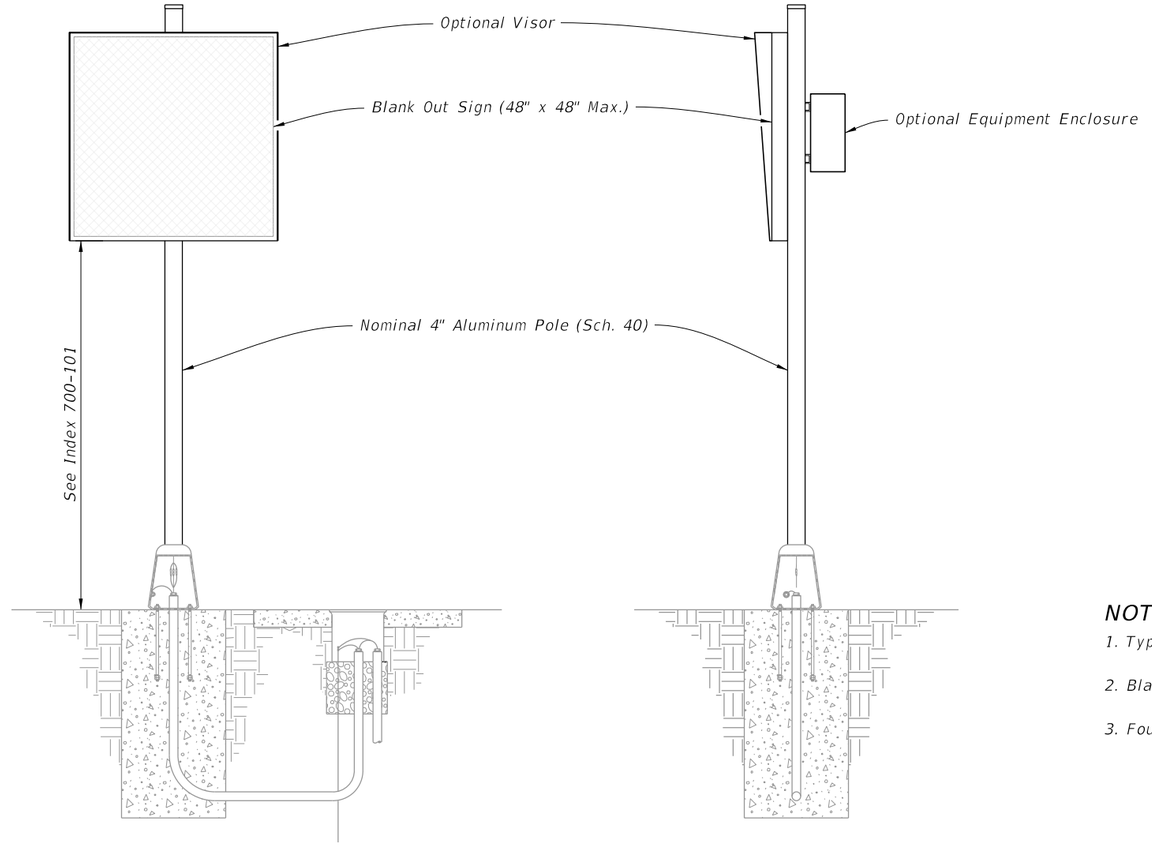

FRONT ELEVATION

SIDE ELEVATION

Update Note to match Roadside Sign Assembly number (A6)

NOTES:

1. Type A8 Assembly (conventionally powered) is shown.
2. Blank Out Sign visors are optional.
3. Foundation reinforcement not shown.

9/29/2025 8:08:34 AM

ROADSIDE SIGN ASSEMBLY-6

LAST REVISION	REVISION	DESCRIPTION:	FDOT FY 2026-27 STANDARD PLANS	ENHANCED HIGHWAY SIGNING ASSEMBLIES	INDEX	SHEET
11/01/24					700-120	9 of 13

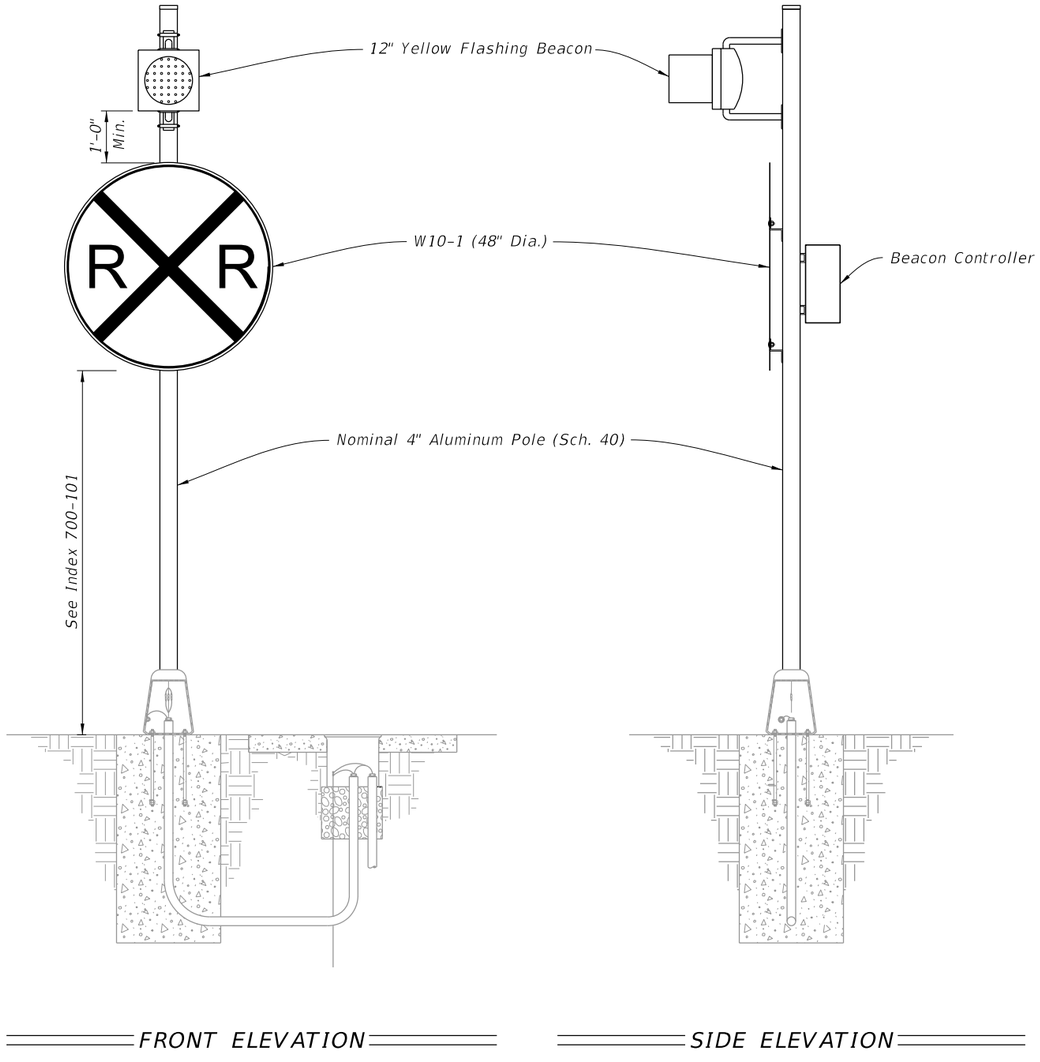

FRONT ELEVATION

SIDE ELEVATION

Update Note to match Roadside Sign Assembly number (A7 and B7)

NOTES:

1. Type A9 Assembly (conventionally powered) is shown. Type B9 Assemblies (solar powered) similar.

2. Foundation reinforcement not shown.

ROADSIDE SIGN ASSEMBLY-7

9/29/2025 8:08:40 AM

LAST REVISION	REVISION	DESCRIPTION:	FDOT	FY 2026-27 STANDARD PLANS	ENHANCED HIGHWAY SIGNING ASSEMBLIES	INDEX	SHEET
11/01/24						700-120	10 of 13

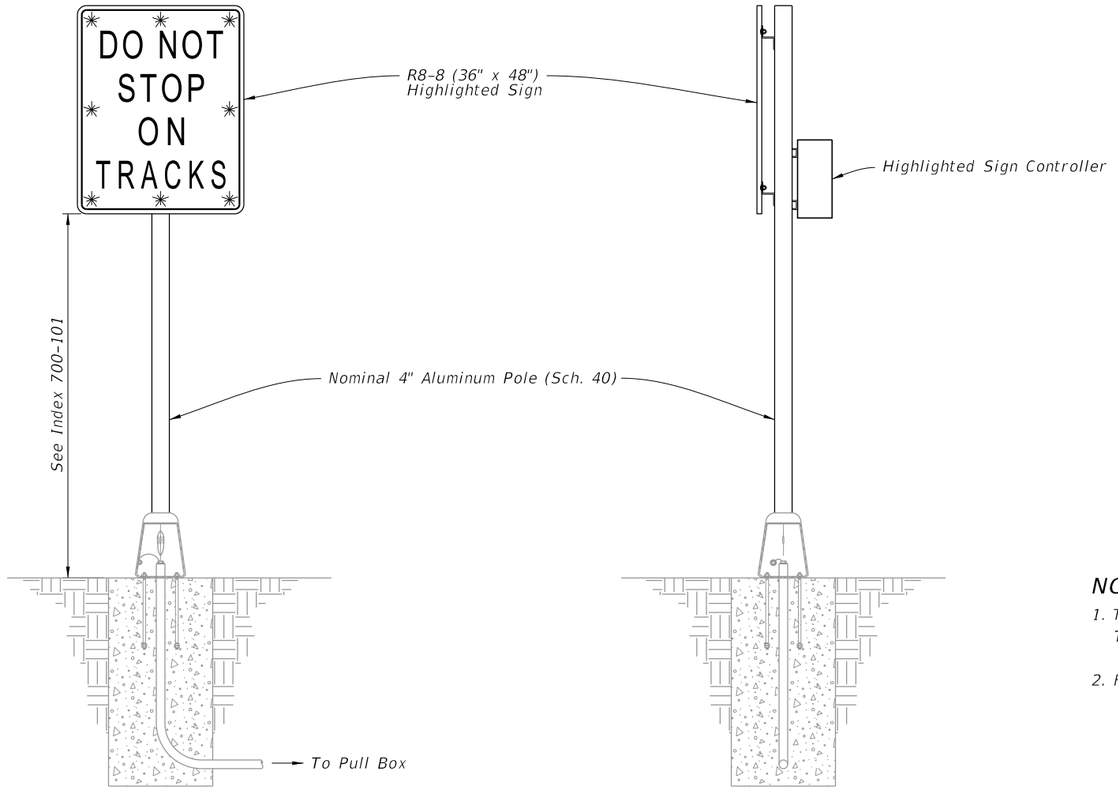

FRONT ELEVATION

SIDE ELEVATION

Update Note to match Roadside Sign Assembly number (A8 and B8)

NOTES:

1. Type A10 Assembly (conventionally powered) is shown. Type B10 Assemblies (solar powered) similar.

2. Foundation reinforcement not shown.

ROADSIDE SIGN ASSEMBLY-8

9/29/2025 8:08:46 AM

LAST REVISION	REVISION	DESCRIPTION:			INDEX	SHEET
11/01/24			FY 2026-27 STANDARD PLANS	ENHANCED HIGHWAY SIGNING ASSEMBLIES	700-120	11 of 13

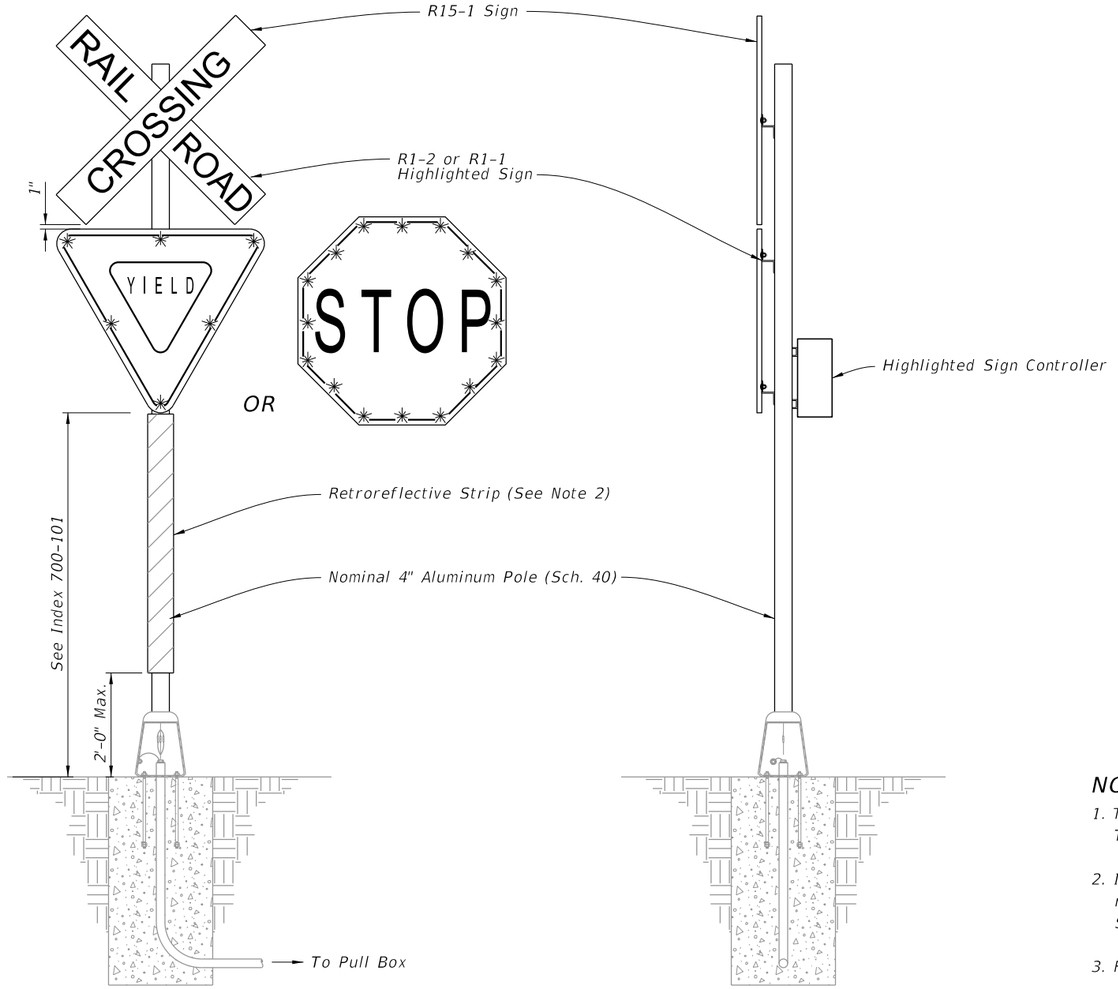

FRONT ELEVATION

SIDE ELEVATION

Update Note to match Roadside Sign Assembly number (A9 and B9)

NOTES:

1. Type A11 Assembly (conventionally powered) is shown. Type B11 Assemblies (solar powered) similar.
2. Install red retroreflective strip on front and white retroreflective strip on back in accordance with Specification 700.
3. Foundation reinforcement not shown.

9/29/2025 8:08:53 AM

ROADSIDE SIGN ASSEMBLY-9

LAST REVISION	REVISION	DESCRIPTION:	FDOT	FY 2026-27 STANDARD PLANS	ENHANCED HIGHWAY SIGNING ASSEMBLIES	INDEX	SHEET
11/01/24						700-120	12 of 13