

---

## Index 659-010 Span Wire Mounted Sign Details

### ORIGINATION

**Date:** 6/28/18

**Name:** Andre Pavlov

**Phone:** (850) 414-4293

**Email:** andre.pavlov@dot.state.fl.us

### COMMENTARY

Notes are part of the continuing effort for consistency. Other changes relate to changes for Overhead signs (consistency).

### COMMENTS AND RESPONSES

**BLACK** = Industry Review Comments    **RED** = Standard Plans Response

**Name:** Derek Vollmer


**Date:** 8/31/18

#### **COMMENT:**





In the redline drawings, change "wend" to "wind".

#### **RESPONSE:**

Change made.

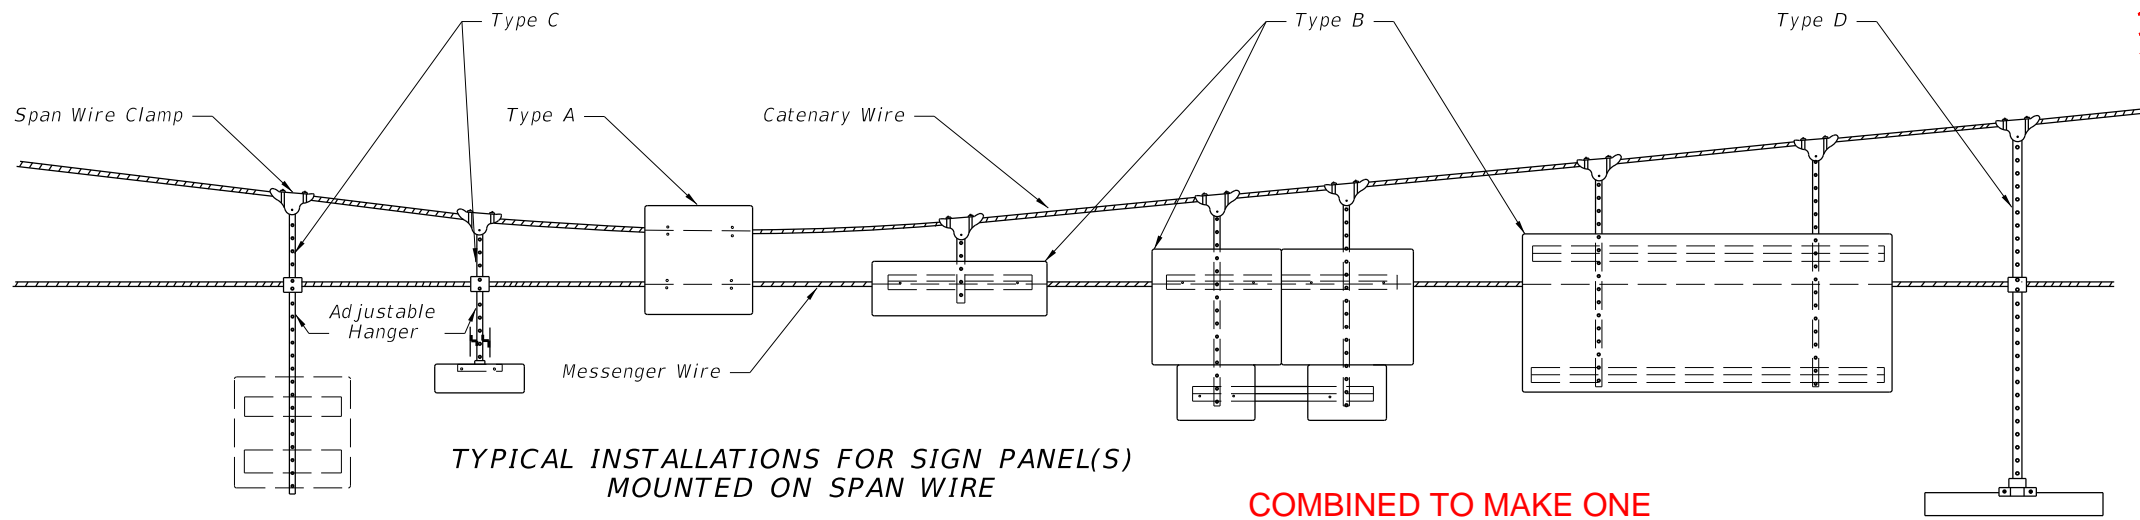

- Notes:
1. Bottom edge of signs shall be approximately at the same elevation.
  2. Type B & C attachments with one hanger shall have wind beams for signs wider than 3½'. The beams shall extend to within 6" of the sign edge.
  3. Type B & C attachments for signs 4' and wider shall have 2 hangers. Signs 7' and wider shall have wind beams that extend to within 6" of the sign edge.
  4. Type D attachments shall be for signs 3½' wide or less.
  5. Sign panels shall meet the requirements of Index 700-020.
  6. Refer to section 634 of the Standard Specifications For Road And Bridge Construction.
  7. All bolts, nuts, and washers shall be passivated stainless steel, AISI 300 series, commercial grade, type 316.
- UPDATED NOTES**

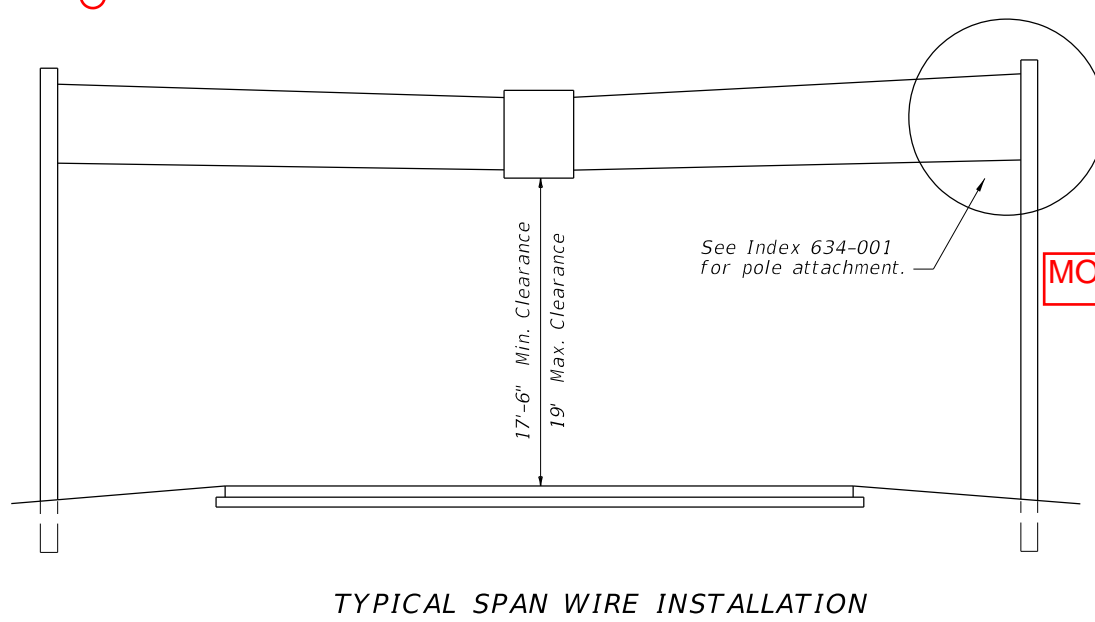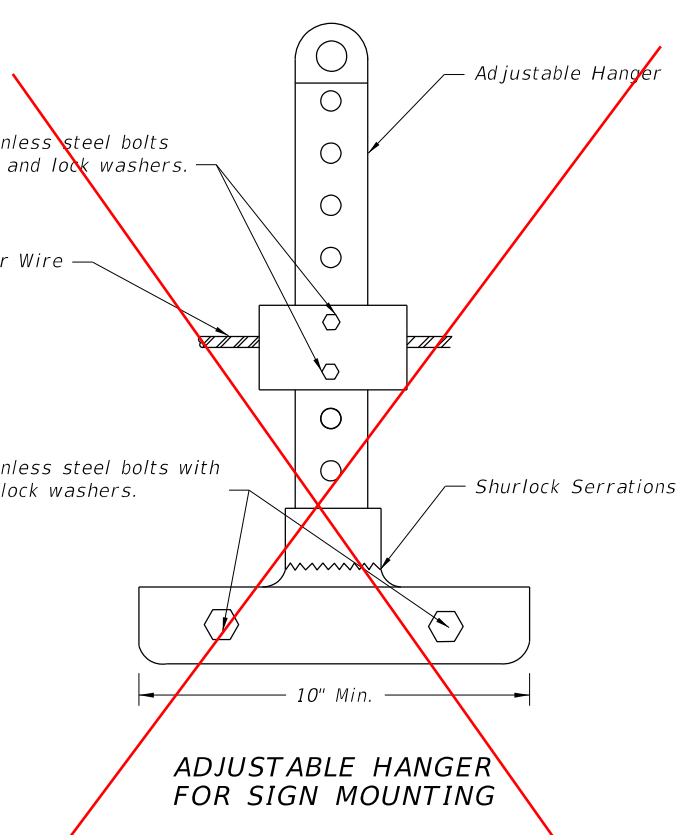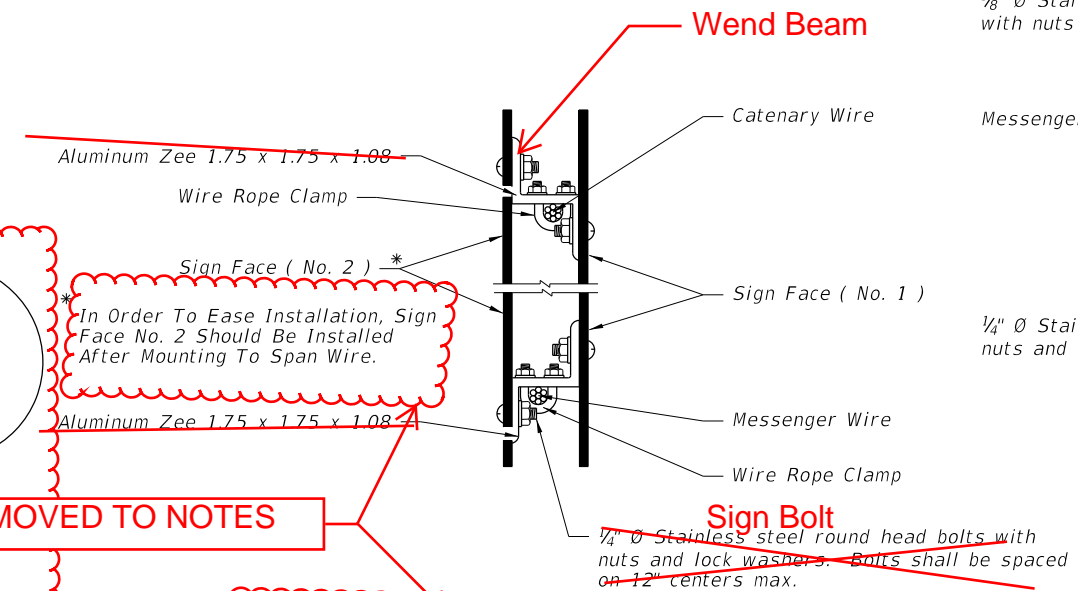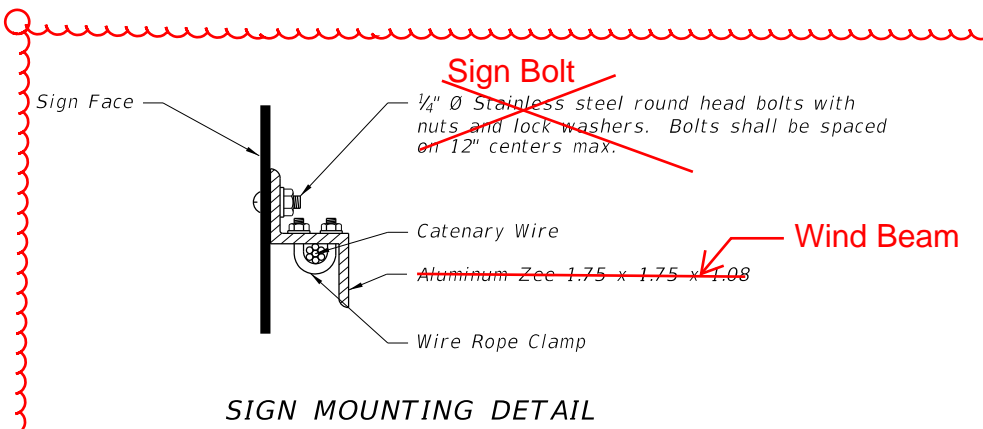

**MOVED TO NOTES**

\* In Order To Ease Installation, Sign Face No. 2 Should Be Installed After Mounting To Span Wire.

The overlapped connection of adjustable hangers shall use a minimum of 2 bolts with a minimum spacing between bolts of 2".

**UPDATED**

**TWO POINT ATTACHMENT**

10/16/2017 10:33:53 AM

LAST REVISION	DESCRIPTION:
11/01/17	11/01/18