

# ORIGINATION FORM

Proposed Revisions to a Standard Plans Index  
(Please provide all information – Incomplete forms will be returned)

## Contact Information:

Date: July 16, 2018  
Originator: **Ed Cashman**  
Phone: (850) 414-4314  
Email: edward.cashman@dot.state.fl.us

## Standard Plans:

Index Number: **700-102**  
Sheet Number (s): 8, 10-11  
Index Title: Special Sign Details

## Summary of the changes:

Sheet 8: Corrected text positioning. Sheet 10: Deleted MOT-2-06 and MOT-3-06. Repositioned signs. Sheet 11: Repositioned signs.

## Commentary / Background:

MOT-2-06 and MOT-3-06 showed signs that are fully detailed in "Standard Highway Signs and Markings".

## Other Affected Offices / Documents: (Provide name of responsible personnel)

Yes	No	
<input checked="" type="checkbox"/>	<input type="checkbox"/>	Other Standard Plans – Ed Cashman
<input type="checkbox"/>	<input checked="" type="checkbox"/>	FDOT Design Manual –
<input type="checkbox"/>	<input checked="" type="checkbox"/>	Basis of Estimates Manual –
<input type="checkbox"/>	<input checked="" type="checkbox"/>	Standard Specifications –
<input type="checkbox"/>	<input checked="" type="checkbox"/>	Approved Product List –
<input type="checkbox"/>	<input checked="" type="checkbox"/>	Construction –
<input type="checkbox"/>	<input checked="" type="checkbox"/>	Maintenance –


## Origination Package Includes: (Email or hand deliver package to Derwood Sheppard)

Yes	N/A	
<input checked="" type="checkbox"/>	<input type="checkbox"/>	Redline Mark-ups
<input type="checkbox"/>	<input checked="" type="checkbox"/>	Proposed Standard Plan Instructions (SPI)
<input type="checkbox"/>	<input checked="" type="checkbox"/>	Revised SPI
<input type="checkbox"/>	<input checked="" type="checkbox"/>	Other Support Documents

## Implementation:


Design Bulletin (Interim)    DCE Memo    Program Mgmt. Bulletin    FY-Standard Plans (Next Release)

————— **Contact the Roadway Design Office for assistance in completing this form** —————

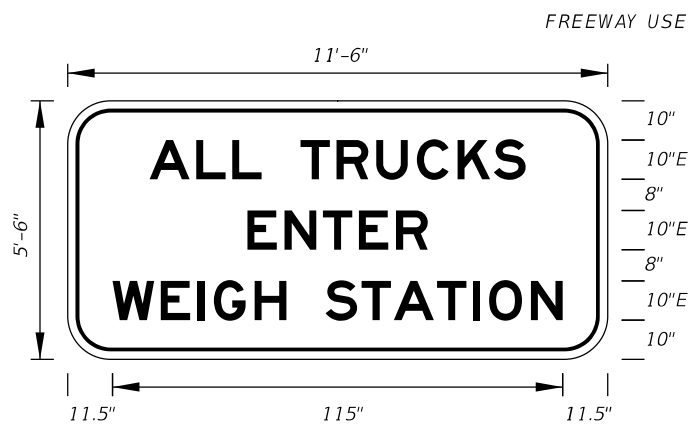


**FTP-1-06**  
11'-6" X 5'-6"  
9" Radii 2" Border

10" Series E Legend  
White Background  
Black Legend and Border

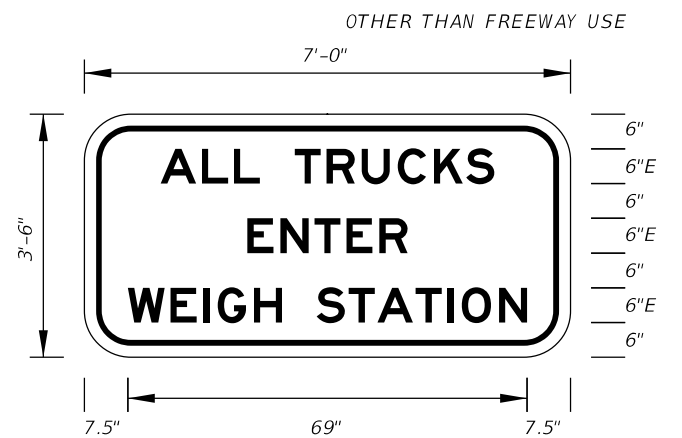


**FTP-2-06**  
7' X 3'-6"  
6" Radii 2" Border

6" Series E Legend  
White Background  
Black Legend and Border

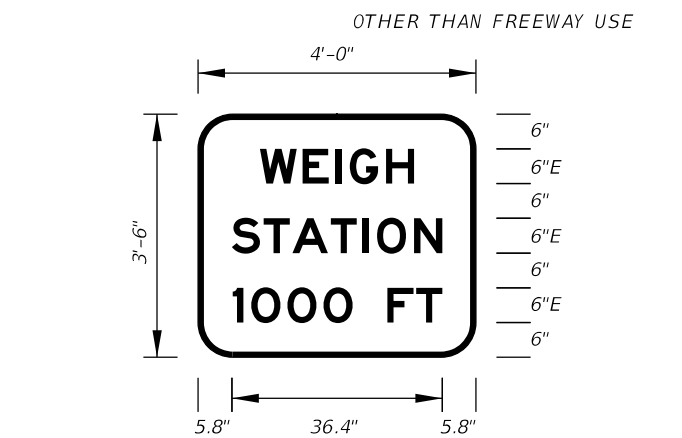

**FTP-3-06**  
4' X 3'-6"  
6" Radii 2" Border


6" Series E Legend  
Green Background  
White Legend and Border

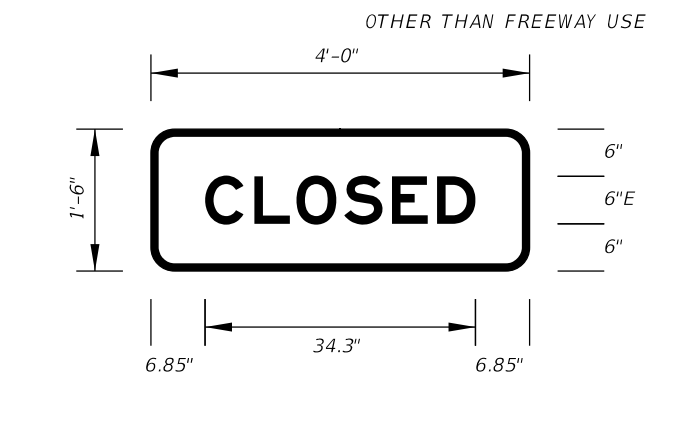

**FTP-4-06**  
4' X 1'-6"  
3" Radii 2" Border


6" Series E Legend  
Green Background  
White Legend and Border

Note:  
FTP-4-06 to be  
used with FTP-3-06

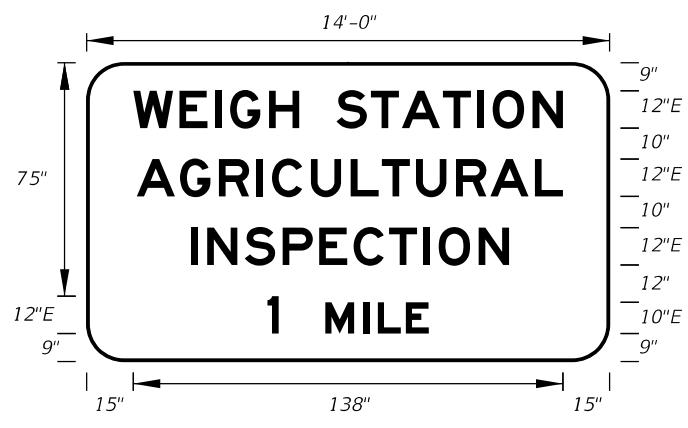

**FTP-5-06**  
14' X 8'  
12" Radii 2" Border


12" and 10" Series E Legend  
Green Background  
White Legend and Border

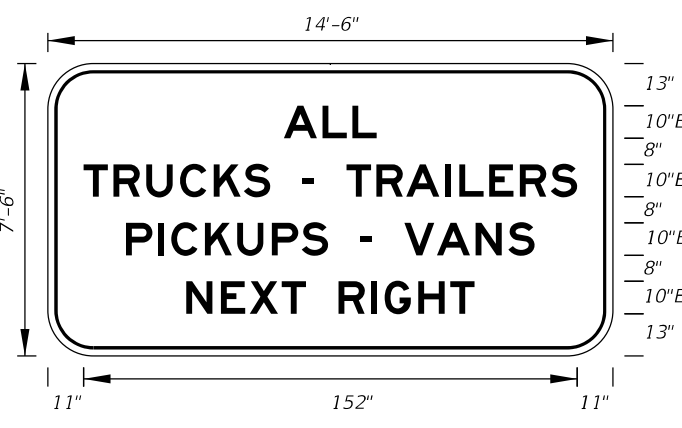

**FTP-6A-06**  
14'-6" X 7'-6"  
12" Radii 2" Border

10" Series E Legend  
White Background  
Black Legend and Border

On Interstate Station  
Delete Pickups-Vans,  
and reduce Sign height  
accordingly.

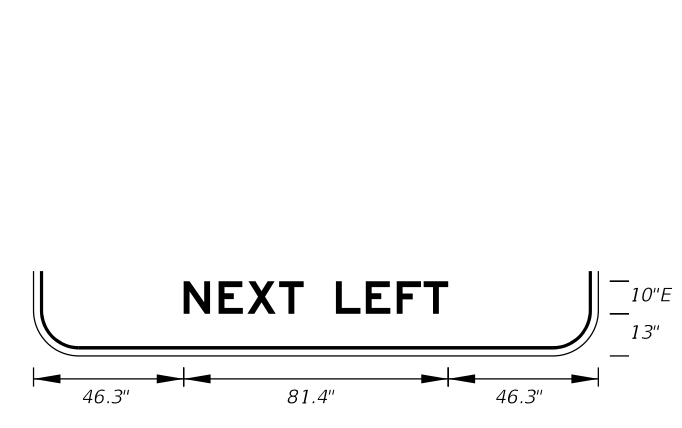


**FTP-6B-06**  
14'-6" X 7'-6"  
12" Radii 2" Border

10" Series E Legend  
White Background  
Black Legend and Border




**FTP-7A-06**  
12' X 7'  
11" Radii 2" Border

10" Series E Legend  
Green Background  
White Legend and Border

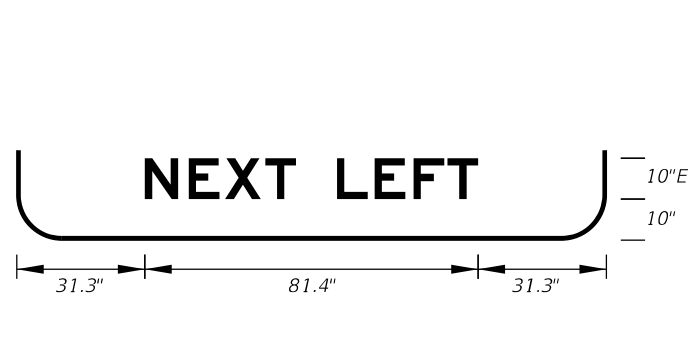

**FTP-7B-06**  
12' X 7'  
11" Radii 2" Border


10" Series E Legend  
Green Background  
White Legend and Border

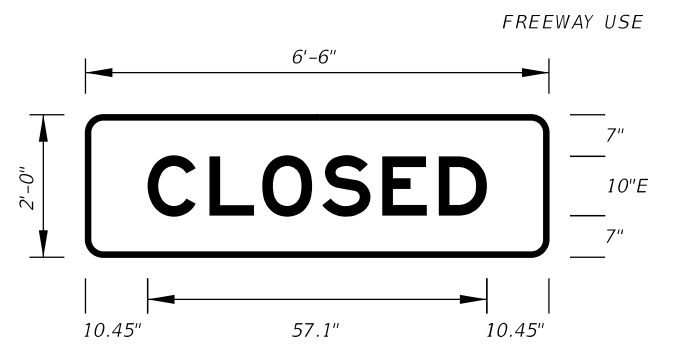

**FTP-8-06**  
6'-6" X 2'  
3" Radii 2" Border


10" Series E Legend  
Green Background  
White Legend and Border

Note:  
FTP-8-06 to be  
used with FTP-7A-06  
& FTP-7B-06.

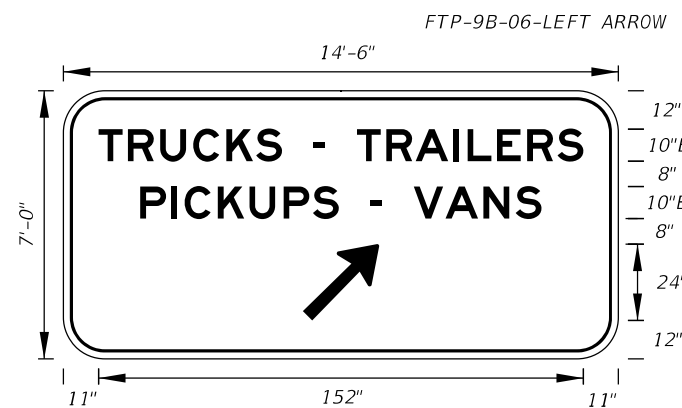

**FTP-9A-06**  
14'-6" X 7'  
11" Radii 2" Border

10" Series E Legend  
Green Background  
White Legend and Border

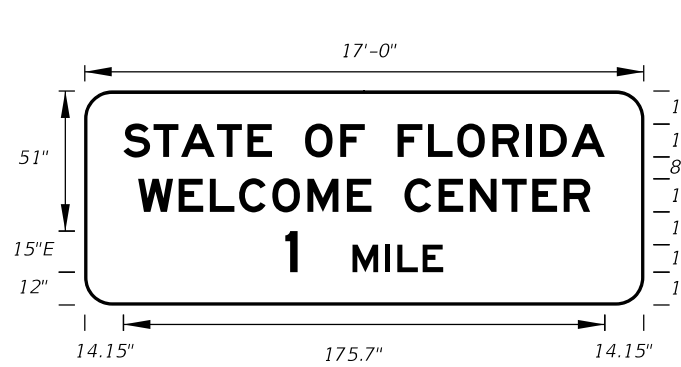


**FTP-10-06**  
17' X 6'-6"  
10" Radii 2" Border


12", 10" and 15" Series E Legend  
Blue Background  
White Legend and Border

10/16/2017 2:45:29 PM


LAST REVISION	DESCRIPTION:
11/01/17	← 11/01/18

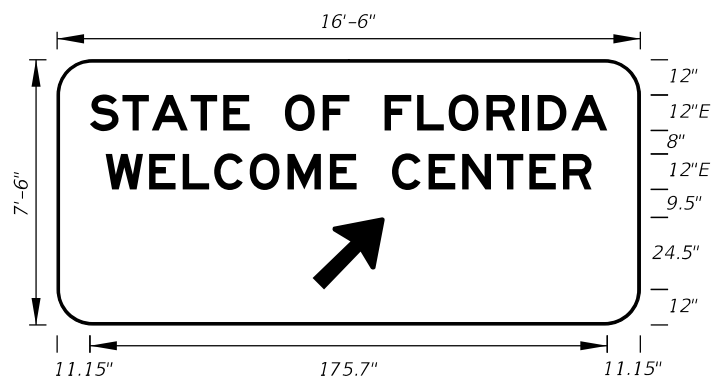


**FTP-11-06**  
 16'-6" X 7'-6"  
 12" Radii 2" Border  
 12" Series E Legend  
 Blue Background  
 White Legend and Border

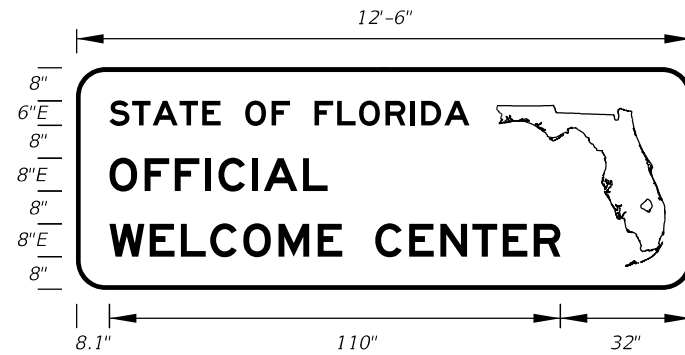


**FTP-12-06**  
 12'-6" X 4'-6"  
 7" Radii 2" Border  
 6" and 8" Series E Legend  
 Blue Background  
 White Legend and Border

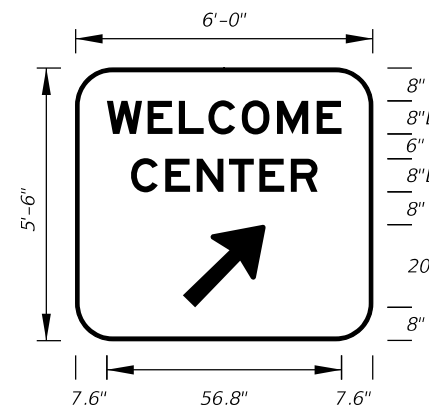


**FTP-13-06**  
 6' 0" X 5'-6"  
 9" Radii 2" Border  
 8" Series E Legend  
 Blue Background  
 White Legend and Border

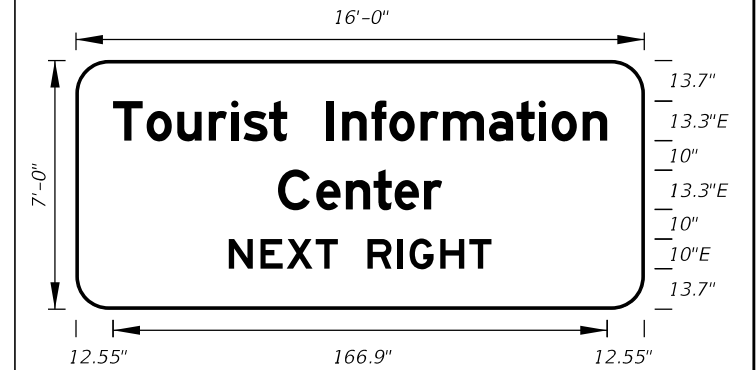


**FTP-14-06**  
 16'-0" X 7'-0"  
 11" Radii 2" Border  
 13.3 and 10" Series E Legend  
 Blue Background  
 White Legend and Border

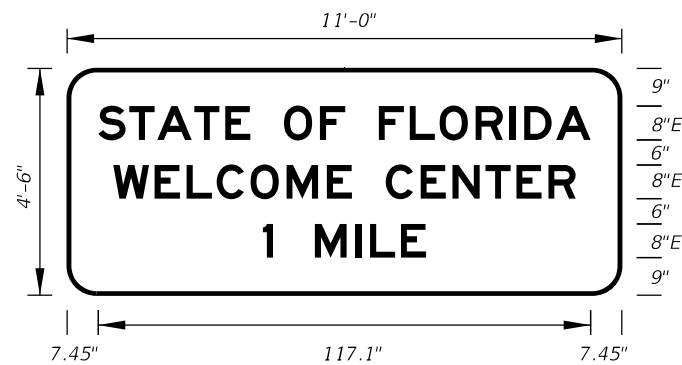

**FTP-15A-06**  
 11'-0" X 4'-6"  
 7" Radii 2" Border  
 8" Series E Legend  
 Blue Background  
 White Legend and Border

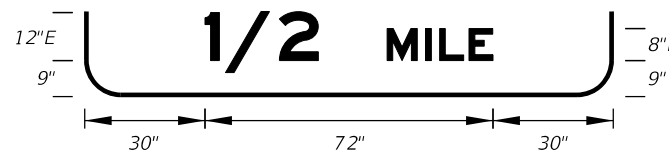

**FTP-15B-06**  
 11'-0" X 5'-6"  
 8" Radii 2" Border  
 8" and 12" Series E Legend  
 Blue Background  
 White Legend and Border

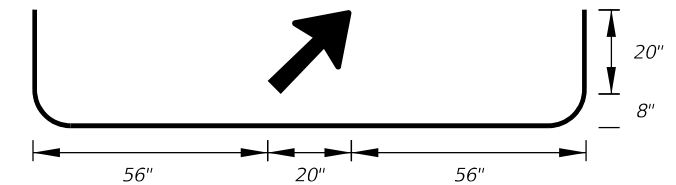

**FTP-15C-06**  
 11'-0" X 5'-6"  
 9" Radii 2" Border  
 8" Series E Legend  
 Blue Background  
 White Legend and Border



**FTP-16-10**  
 2'-6" X 3'-0"  
 1.5" Radii 3/4" Border  
 5" Series B Legend  
 Green Background  
 White Legend, Border,  
 and Florida Symbol



**FTP-17-10**  
 3'-0" X 4'-0"  
 1.5" Radii 3/4" Border  
 7" Series B Legend  
 Green Background  
 White Legend, Border,  
 and Florida Symbol



**FTP-18-10**  
 4'-0" X 5'-0"  
 3" Radii 1 1/4" Border  
 8" Series B Legend  
 Green Background  
 White Legend, Border,  
 and Florida Symbol

10/16/2017 2:45:30 PM

LAST REVISION	DESCRIPTION:
11/01/17	11/01/18




FY 2018-19  
 STANDARD PLANS

SPECIAL SIGN DETAILS

INDEX  
 700-102

SHEET  
 2 of 11

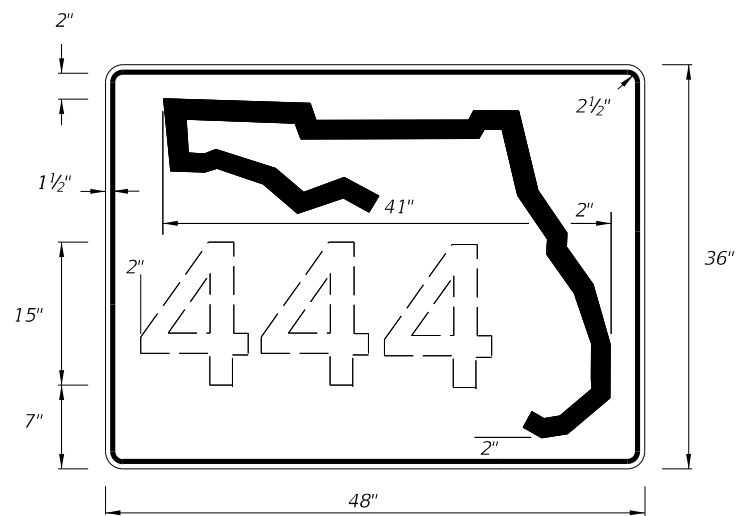


DIGITS	NUMERAL SIZE	SERIES LEGEND	PANEL SIZE
1-3	15"	C	48" x 36"
4	12"	C	48" x 36"


**NOTES:**

- Stroke width of State Outline shall be 1".
- 2 1/2" Radii

INDEPENDENT USE FOR FREEWAY

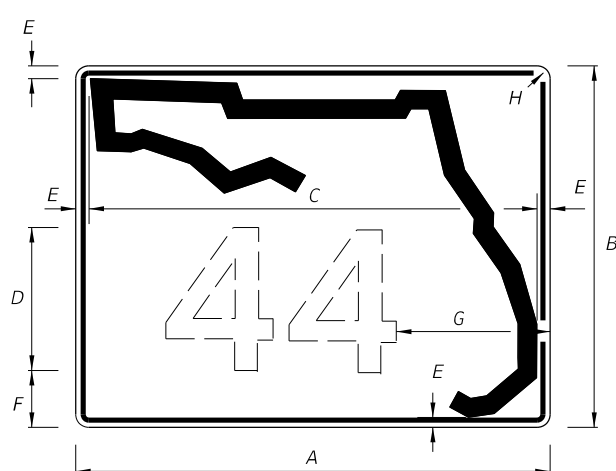

1 OR 2 DIGITS

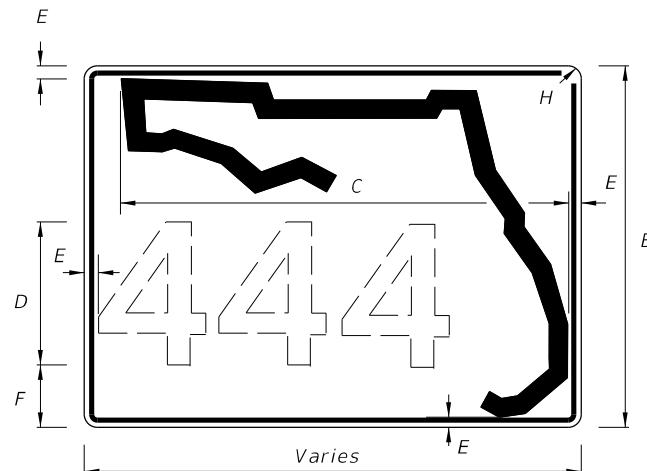

3 OR MORE DIGITS


**NOTES:**

- Florida marker shall have Black Legend with White Background.
- Stroke width of State outline shall be 1 3/4" for Guide Sign.
- Series D Legend.
- 5/8" Border

A	B	C	D	E	F	G	H
30"	24"	26"	12"	1 1/4"	2 3/4"	8 1/4"	1 1/4"
36"	30"	32"	15"	1 1/4"	3 1/4"	8 3/4"	1 1/4"
42"	36"	38"	15"	1 1/4"	6 1/4"	11"	1 1/4"


GUIDE SIGN USE

FTP-17-06 - FLORIDA ROUTE MARKER

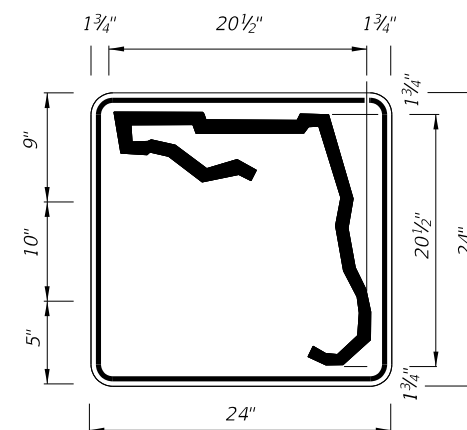

1 or 2 DIGITS

DIGITS	NUMERAL SIZE	SERIES LEGEND	PANEL SIZE
1-2	10"	D	24" x 24"

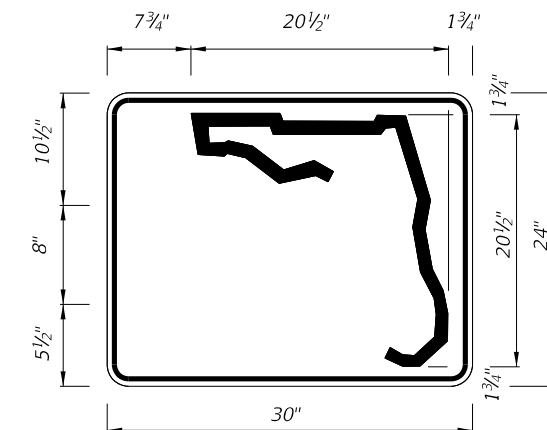

3 or 4 DIGITS

DIGITS	NUMERAL SIZE	SERIES LEGEND	PANEL SIZE
3	8"	D	30" x 24"
4	8"	C	30" x 24"


**NOTES:**

- Stroke width of State Outline shall be 1".
- The 24" X 24" panel shall only be used for a 3 digit route when the panel is to be used on a sign cluster with other 24" X 24" panels.
- 1 1/2" Radii

INDEPENDENT USE OTHER THAN FREEWAY

**NOTES:**

- Series D Legend.
- Color: Yellow Legend and Border on Blue Background.
- When used on a guide sign, marker must be overlaid on a rectangular Yellow Background as shown in chart.
- When two or more County Route Markers are mounted together, use the dimensions of the largest marker for all other markers.

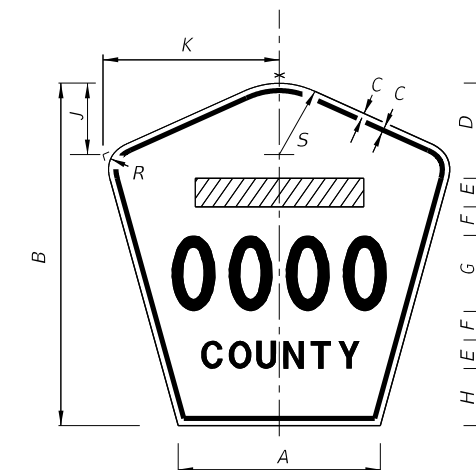

SIGN	DIMENSIONS													Rectangular Yellow Background Dimensions (See Note 3)
	A	B	C	D	E	F	G	H	J	K	R	S		
4 DIGIT POST MOUNTED	25 1/8"	42"	3/4"	10"	4"	4"	8"	8"	8 3/8"	22"	5"	8 3/4"		
2 DIGIT OVERHEAD	21 1/2"	36"	1/2"	7 1/2"	3"	3"	12"	4 1/2"	7 1/8"	18 1/8"	4 1/4"	7 1/2"	42" x 42"	
3 DIGIT OVERHEAD	25 1/8"	42"	3/4"	8"	4"	4"	12"	6"	8 3/8"	22"	5"	8 3/4"	48" x 48"	
4 DIGIT OVERHEAD	29 7/8"	48"	3/4"	8"	5"	5"	12"	8"	9 3/4"	25 5/8"	5 3/4"	10 1/4"	52" x 52"	

FTP-18-06 - COUNTY ROUTE MARKER (M1-6)

10/16/2017 2:45:30 PM

LAST REVISION	DESCRIPTION:
11/01/17	11/01/18




FY 2018-19  
STANDARD PLANS

SPECIAL SIGN DETAILS

INDEX  
700-102

SHEET  
3 of 11

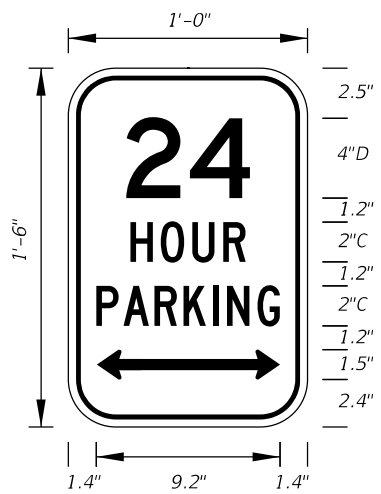


**FTP-19-06**  
 1' X 1'-6"  
 4" Radii  $\frac{3}{8}$ " Border  
 Top 4" Series D  
 Bottom 2" Series C  
 White Background  
 Green Legend and Border

All Letters  
 1" Series C  
 1" Spacing  
 Between Lines  
 of Text

**FTP-20-06**  
 1' X 1'-6"  
 2" Radii  $\frac{3}{8}$ " Border  
 1" Series C Legend  
 Color  
 Background  
 Legend and Border



Top Blue  
 Bottom White  
 White Black

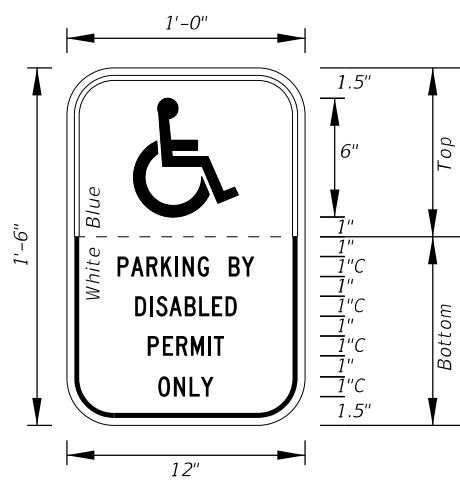

All Letters  
 1.5" Series C  
 1" Spacing  
 Between Lines  
 of Text


**FTP-21-06**  
 1'-6" X 2'-6"  
 2" Radii  $\frac{3}{8}$ " Border  
 1.5" Series C Legend  
 Color  
 Background  
 Legend and Border

Top Blue  
 Bottom White  
 White Black

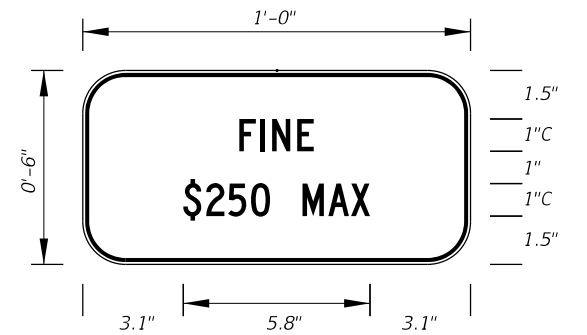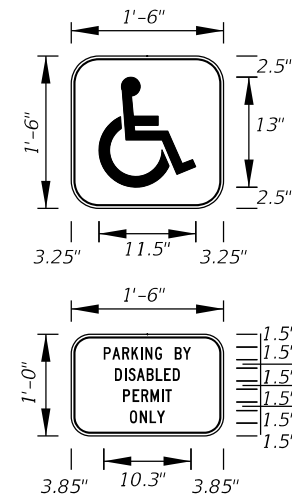


**FTP-22-06**  
 1' X 6"  
 1" Radii  $\frac{3}{8}$ " Border  
 1" Series C Legend  
 White Background  
 Black Legend and Border

Supplemental Panel  
 for the FTP-20-06  
 and FTP-21-06 signs

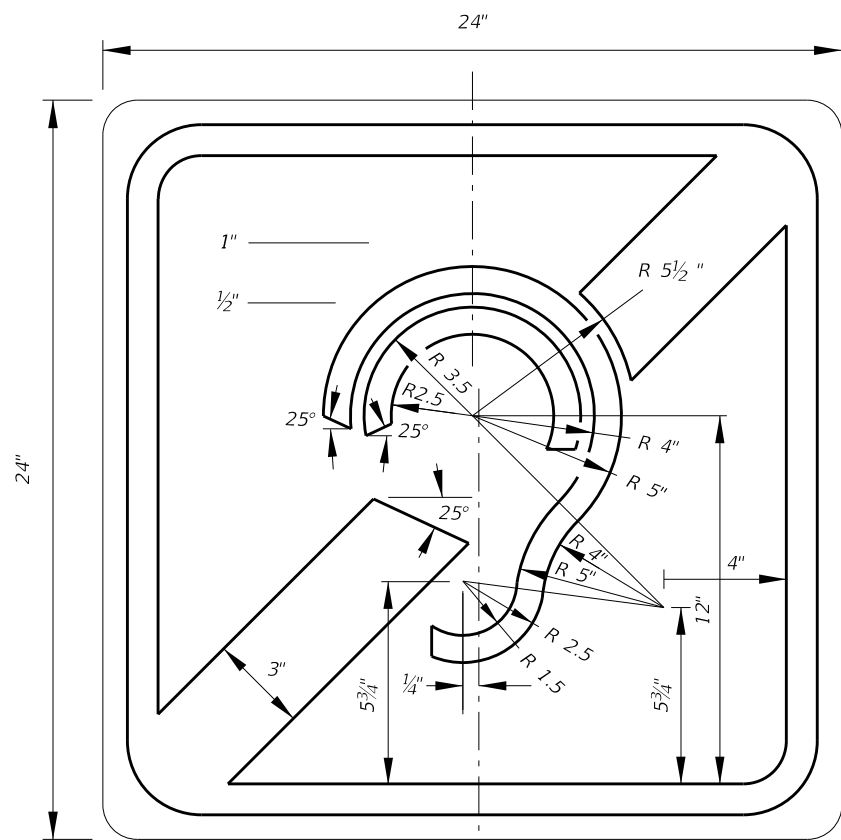

**FTP-23-06**  
 2' X 2'  
 1.5" Radii  $\frac{5}{8}$ " Border  
 Blue Background  
 White Legend and Border

INTERNATIONAL SYMBOL OF  
 ACCESS FOR HEARING LOSS

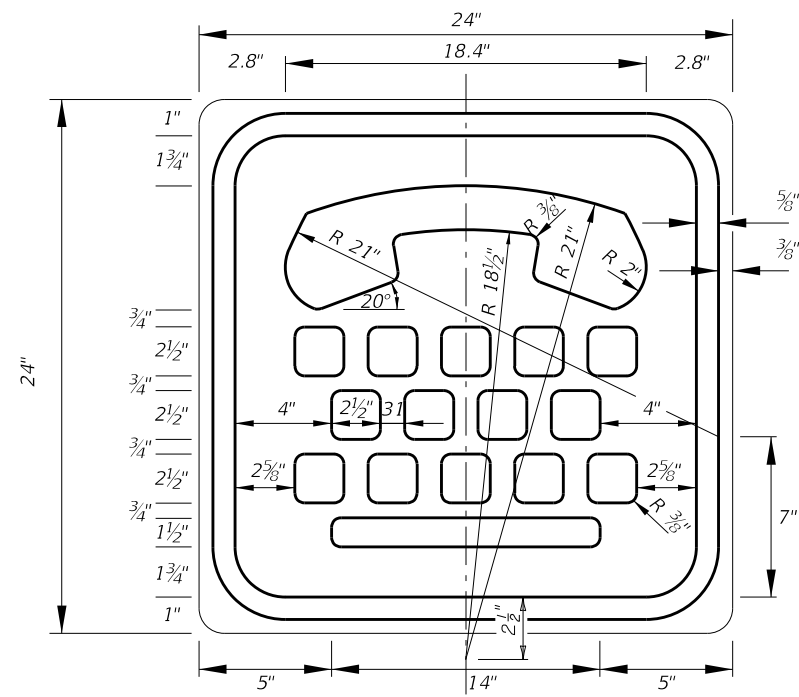

**FTP-24-06**  
 2' X 2'  
 1.5" Radii  $\frac{5}{8}$ " Border  
 Blue Background  
 White Legend and Border

INTERNATIONAL TDD SYMBOL

10/16/2017 2:45:31 PM

LAST REVISION	DESCRIPTION:
11/01/17	11/01/18




FY 2018-19  
 STANDARD PLANS


SPECIAL SIGN DETAILS

INDEX  
 700-102


SHEET  
 4 of 11

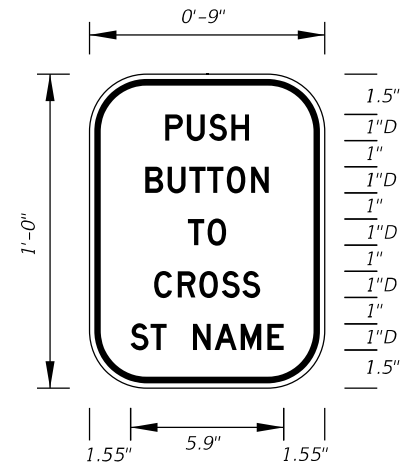


**FTP-25-06**  
 9' X 9'  
 2" Radii 3/8" Border  
 1" Series D Legend  
 White Background  
 Black Legend and Border

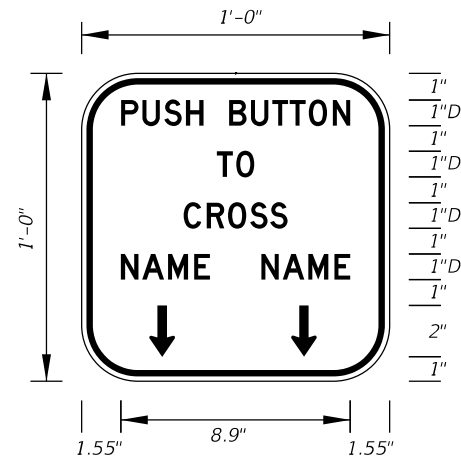

**FTP-26-06**  
 1' X 1'  
 2" Radii 3/8" Border  
 1" Series D Legend  
 White Background  
 Black Legend and Border

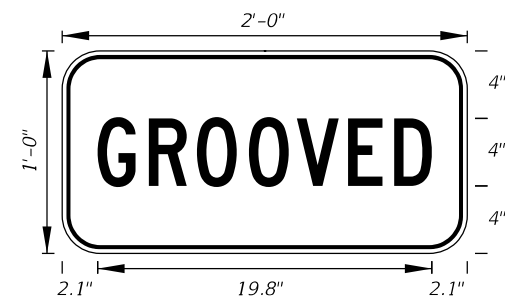


**FTP-29-06**  
 2'-0" X 1'-0"  
 2" Radii 5/8" Border  
 4" Series C Legend  
 Yellow Background  
 Black Legend and Border

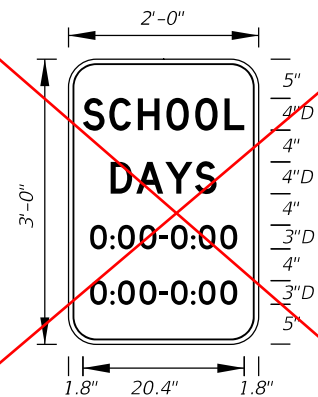


**FTP-30-06**  
 2'-0" X 3'-0"  
 3" Radii 5/8" Border  
 White Background  
 Black Legend and Border

DELETED

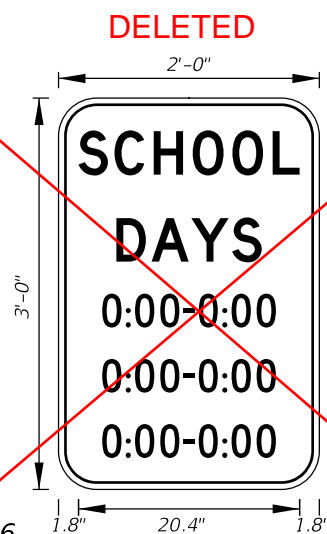


**FTP-30A-06**  
 2' X 3'  
 3" Radii 5/8" Border  
 Top 4" Series D Legend  
 Bottom 3" Series C Legend  
 White Background  
 Black Legend and Border


DELETED

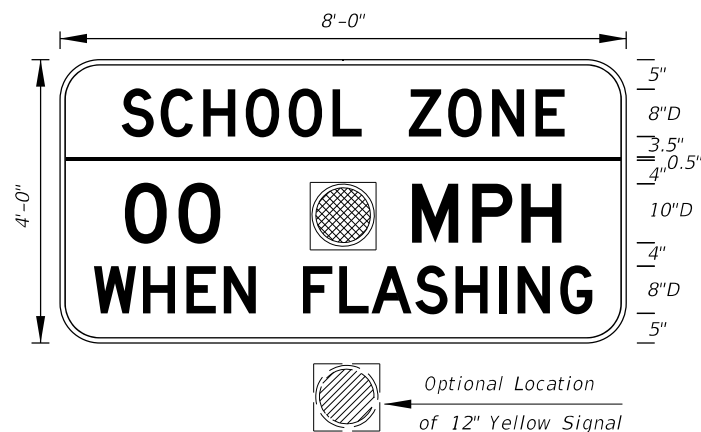


**FTP-31-06**  
 8' X 4'  
 6" Radii 3/4" Border  
 Series D Legend  
 Fluorescent Yellow-Green Background Top  
 White Background Bottom  
 Black Legend and Border

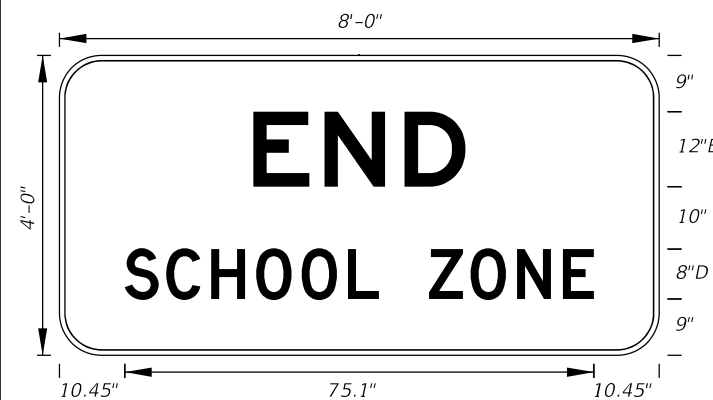


**FTP-32-06**  
 8' X 4'  
 6" Radii 3/4" Border  
 12" Series E and 8" Series D Legend  
 White Background  
 Black Legend and Border

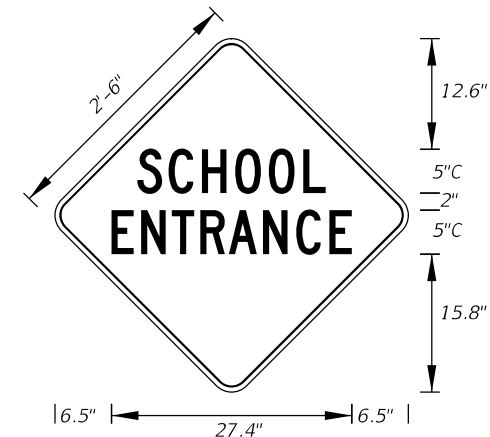


**FTP-33-06**  
 2'-6" X 2'-6"  
 2" Radii 3/4" Border  
 5" Series C Legend  
 Fluorescent Yellow-Green Background  
 Black Legend and Border

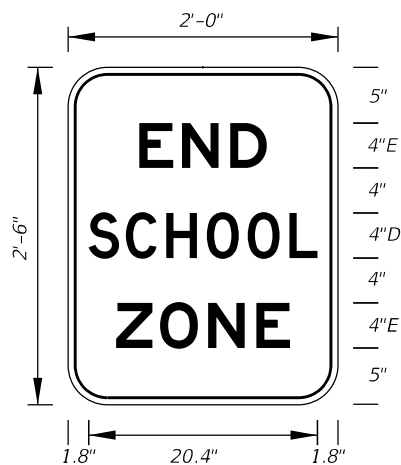


**FTP-34-06**  
 2' X 2'-6"  
 3" Radii 5/8" Border  
 4" Series D and E Legend  
 White Background  
 Black Legend and Border

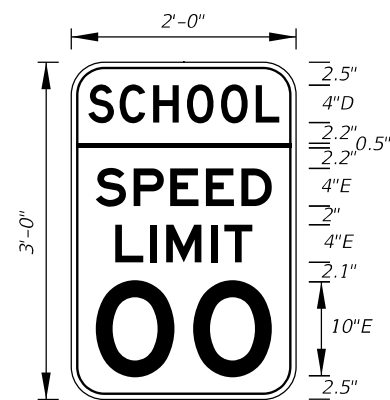

**FTP-35-06**  
 2' X 3'  
 3" Radii 5/8" Border  
 Top 4" Series D Legend  
 Bottom 4" and 10" Series E Legend  
 Fluorescent Yellow-Green Background Top  
 White Background Bottom  
 Black Legend and Border

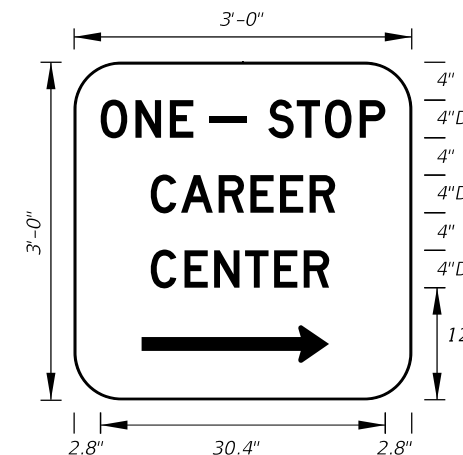


**FTP-36-06**  
 3' X 3'  
 5" Radii  
 4" Series D Legend  
 Green Background  
 White Legend and Border

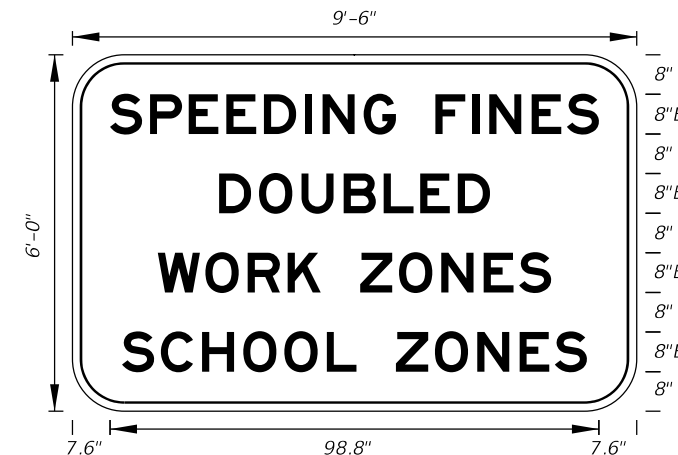












**FTP-37-06**  
 9'-6" X 6'  
 9" Radii 2" Border  
 8" Series E Legend  
 White Background  
 Black Legend and Border  
 State Line Sign

10/16/2017 2:45:31 PM

LAST REVISION	DESCRIPTION:
11/01/17	11/01/18

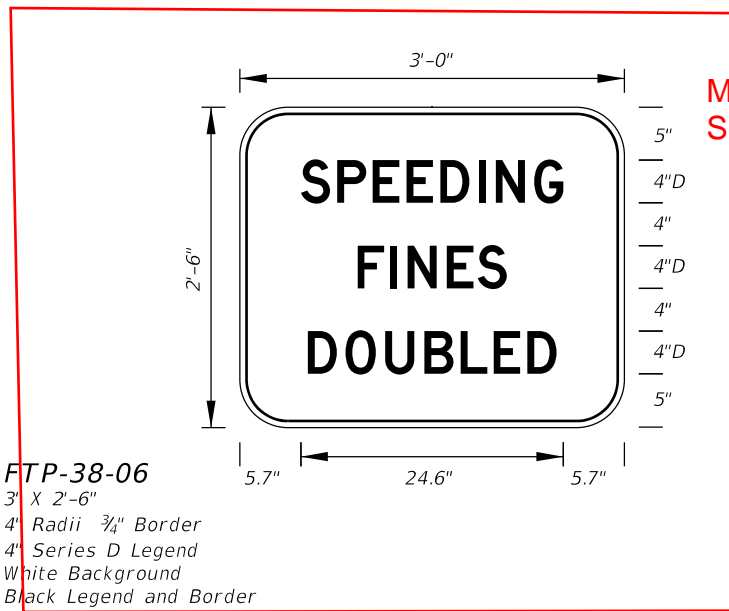

MOVED TO SHEET 5

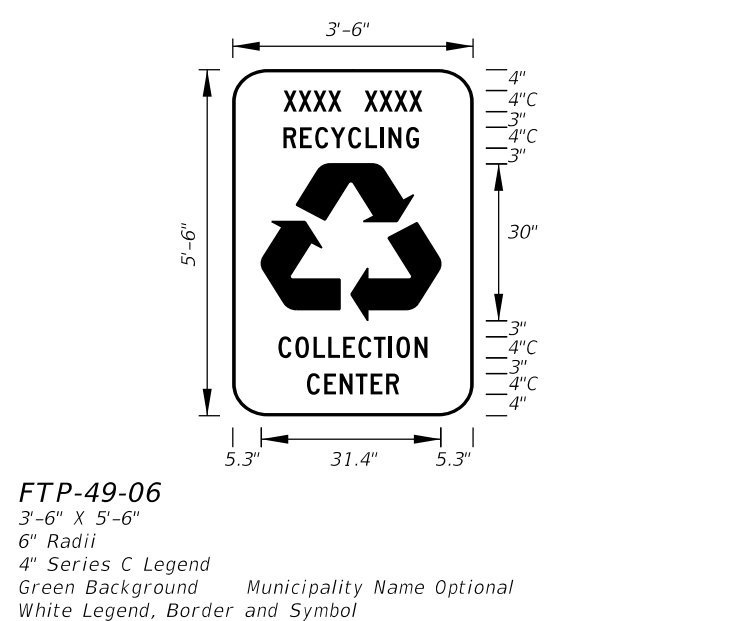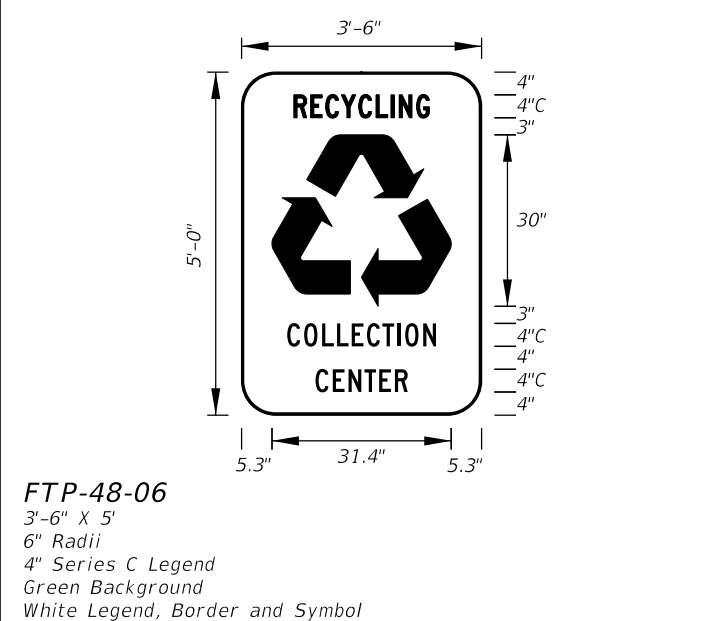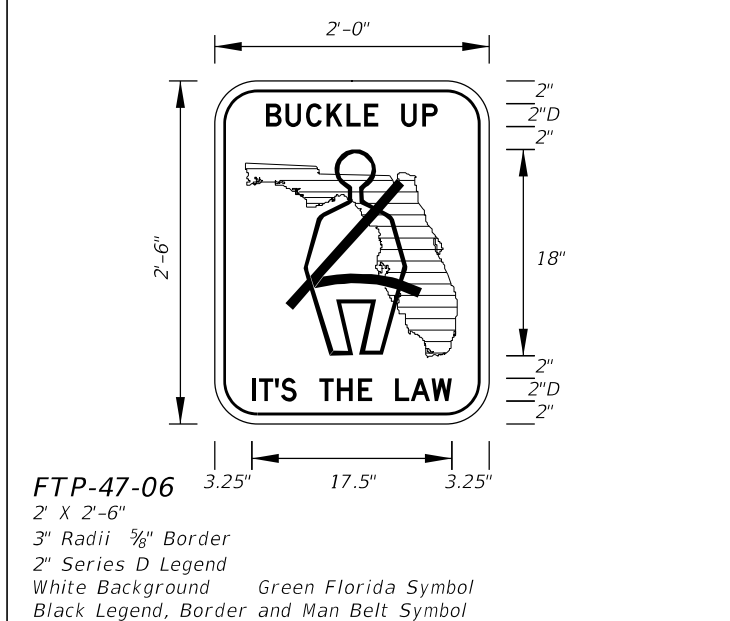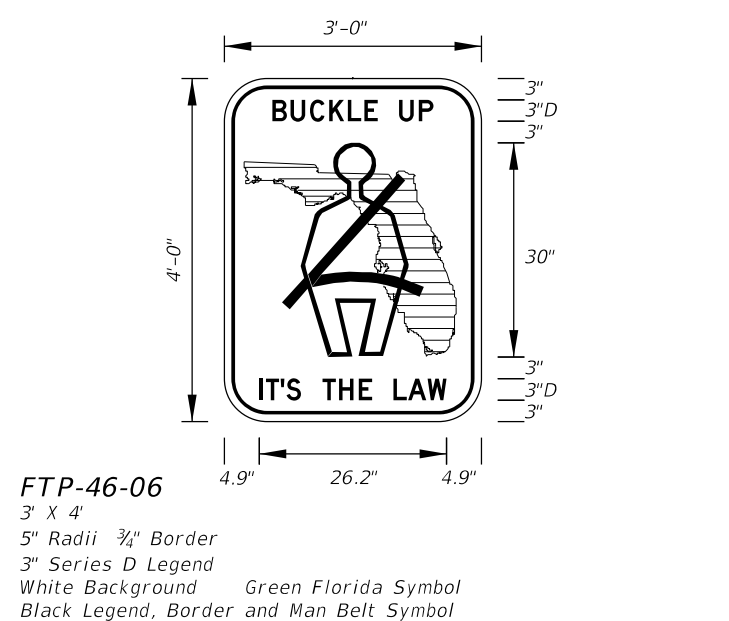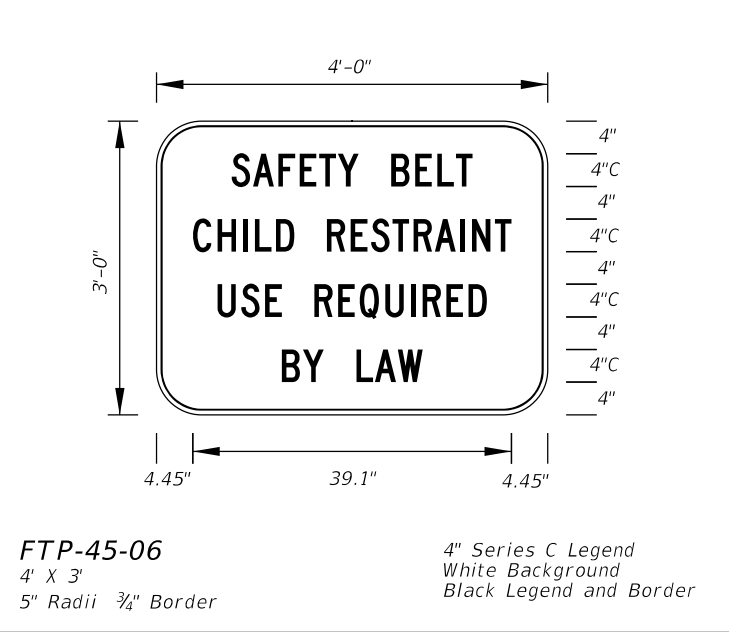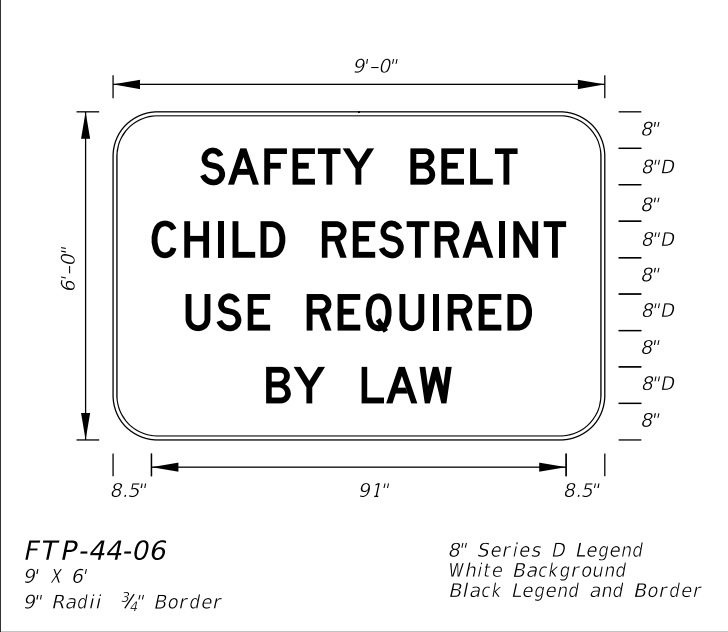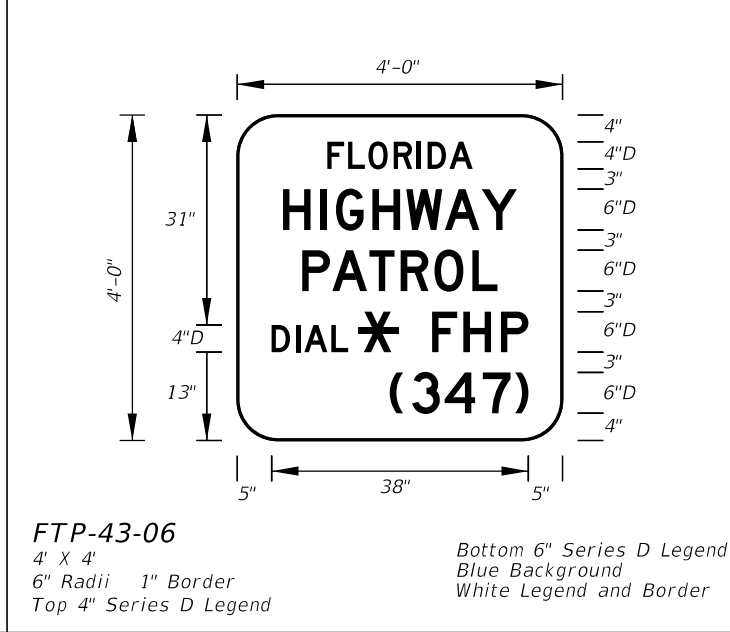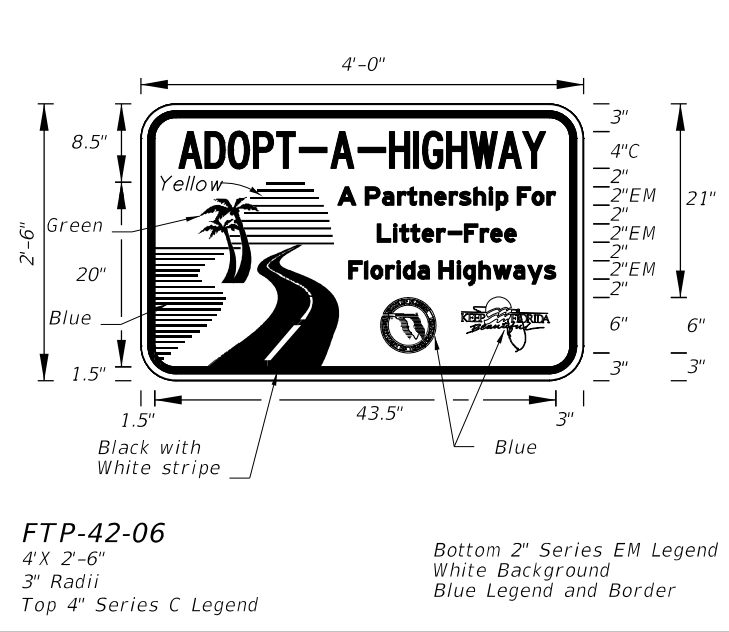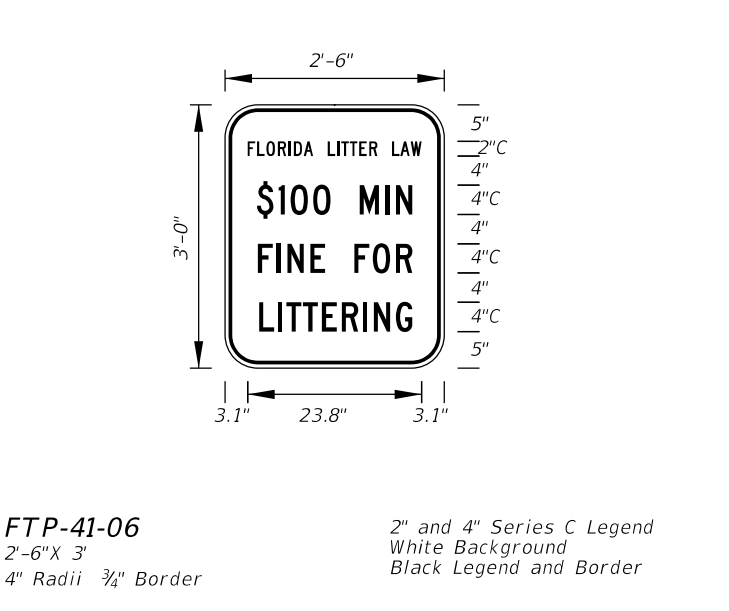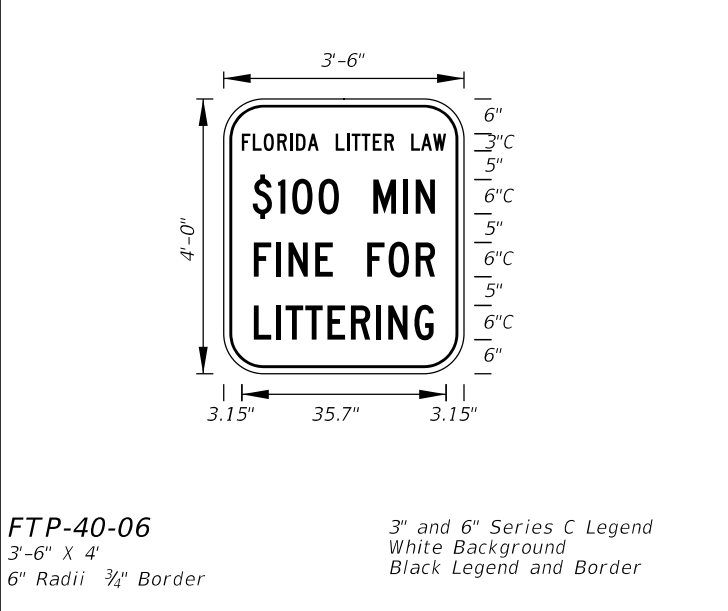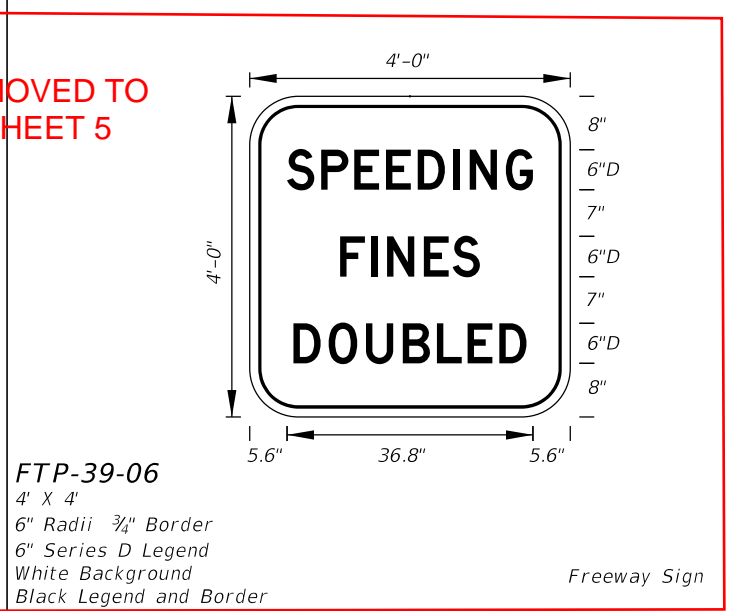


10/16/2017 2:45:32 PM


LAST REVISION	DESCRIPTION:
11/01/17	11/01/18




**MOVED TO SHEET 6**

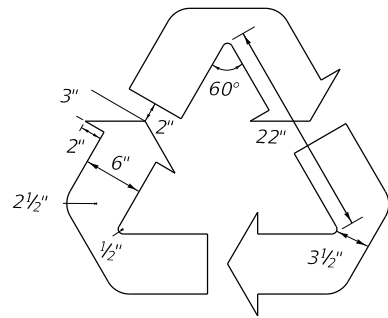


Detail for **FTP-48-06** and **FTP-49-06**

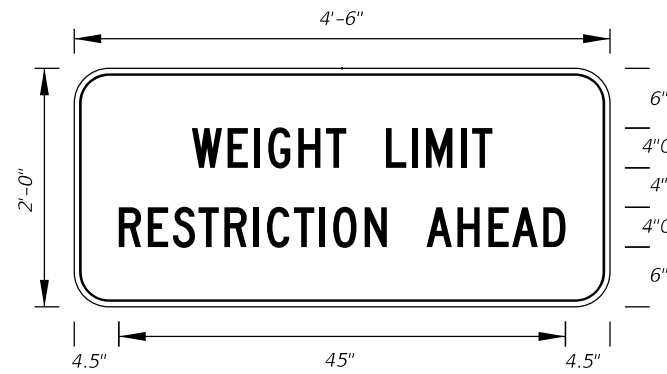


**FTP-50-06**  
4'-6" X 2'  
3" Radii 3/4" Border  
4" Series C Legend  
Yellow Background  
Black Legend and Border

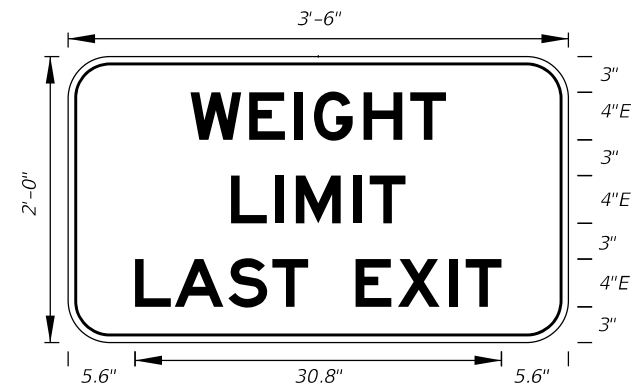


**FTP-51-06**  
3' X 2'  
3" Radii 3/4" Border  
4" Series E Legend  
White Background  
Black Legend and Border

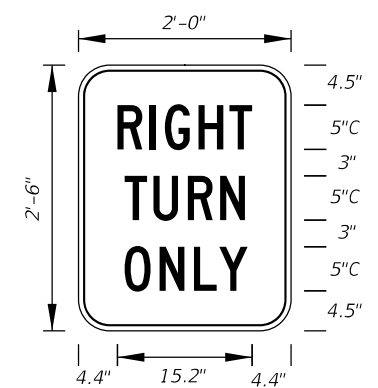

**FTP-52-06**  
2' X 2'-6"  
3" Radii 5/8" Border  
5" Series C Legend  
White Background  
Black Legend and Border

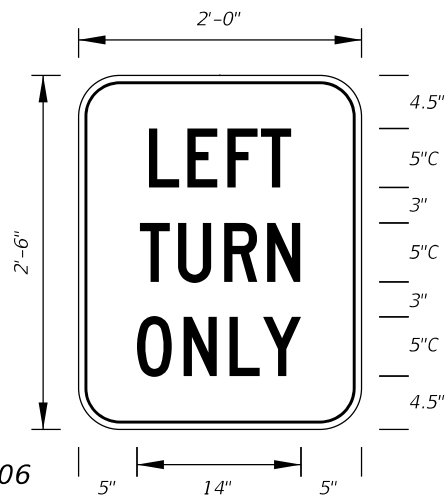


**FTP-53-06**  
2' X 2'-6"  
3" Radii 5/8" Border  
5" Series C Legend  
White Background  
Black Legend and Border

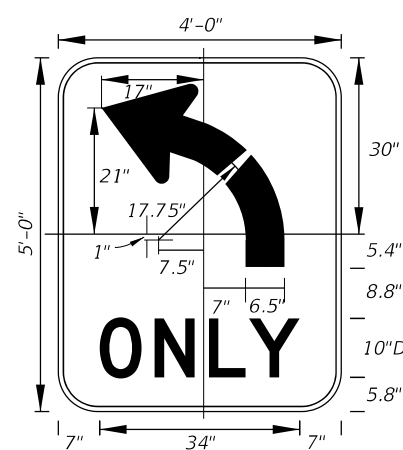


**FTP-54L-06**  
4' X 5'  
6" Radii 3/4" Border  
10" Series D Legend  
White Background  
Black Legend and Border

*FTP-54R-06 for (Right Turn Arrow)*

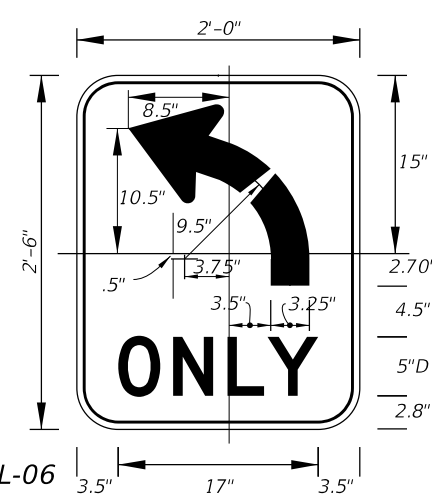


**FTP-55L-06**  
2' X 2'-6"  
3" Radii 5/8" Border  
5" Series D Legend  
White Background  
Black Legend and Border

*FTP-55R-06 for (Right Turn Arrow)*

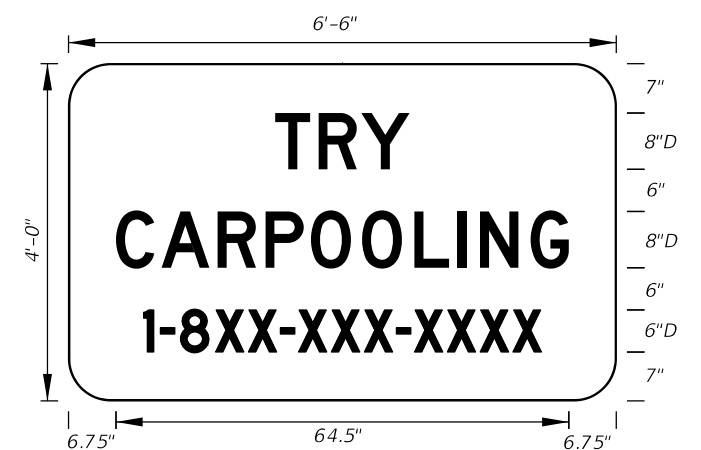


**FTP-56-06**  
6'-6" X 4'  
6" Radii 3/4" Border  
8" and 6" Series D Legend  
Blue Background  
White Legend and Border

*Design Project Manager or Transit Administrator will supply correct 1-8XX number.*

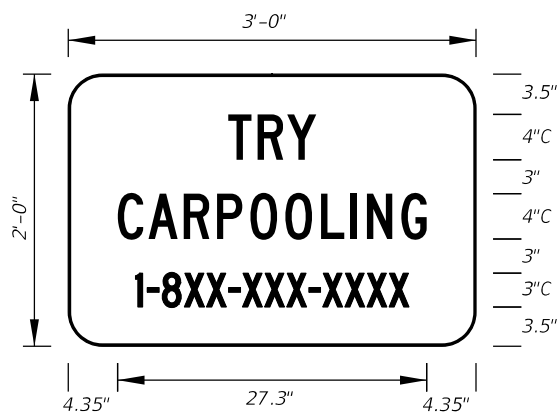


**FTP-56A-06**  
3' X 2'  
3" Radii  
4" and 3" Series C Legend  
Blue Background  
White Legend and Border

*Design Project Manager or Transit Administrator will supply correct 1-8XX number.*

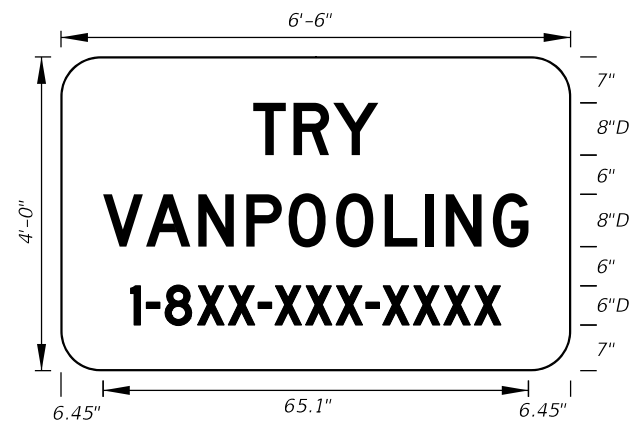


**FTP-57-06**  
6'-6" X 4'  
6" Radii  
8" and 6" Series D Legend  
Blue Background  
White Legend and Border

*Design Project Manager or Transit Administrator will supply correct 1-8XX number.*

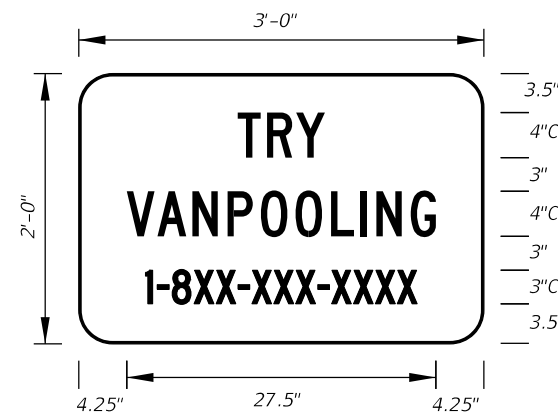

**FTP-58-06**  
3' X 2'  
3" Radii  
4" and 3" Series C Legend  
Blue Background  
White Legend and Border

*Design Project Manager or Transit Administrator will supply correct 1-8XX number.*

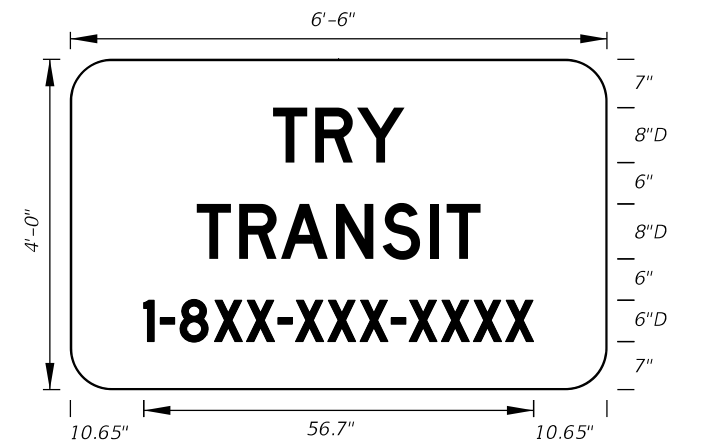

**FTP-59-06**  
6'-6" X 4'  
6" Radii  
8" and 6" Series D Legend  
Blue Background  
White Legend and Border

*Design Project Manager or Transit Administrator will supply correct 1-8XX number.*

10/16/2017 2:45:32 PM

LAST REVISION	DESCRIPTION:
11/01/17	11/01/18




FY 2018-19  
STANDARD PLANS

SPECIAL SIGN DETAILS


INDEX  
700-102

SHEET  
7 of 11



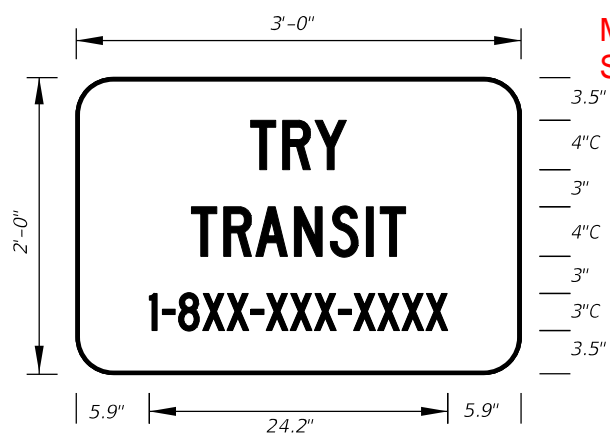

MOVED TO SHEET 7

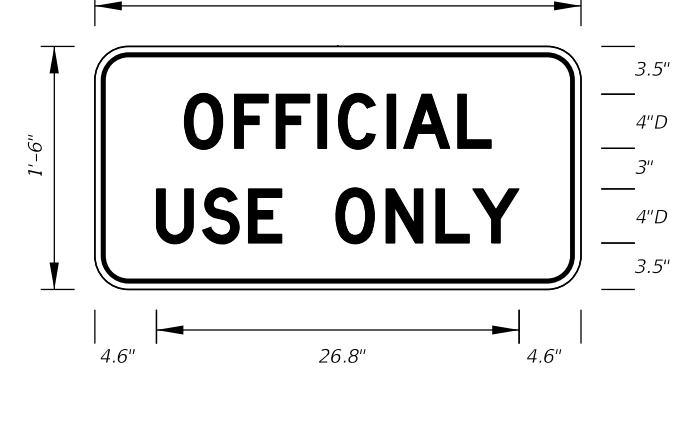

**FTP-60-06**  
3' X 2'  
3" Radii  
4" and 3" Series C Legend  
Blue Background  
White Legend and Border



Design Project Manager or Transit Administrator will supply correct 1-8XX number.

**FTP-61-06**  
3' X 2'  
3" Radii 3/4" Border  
4" and 3" Series C Legend  
Yellow Background  
Black Legend and Border

**FTP-62-06**  
3' X 3'  
2" Radii 3/4" Border 4" and 5" Series C Legend  
Yellow Background Black Legend and Border

**FTP-65-06**  
3' X 1'-6"  
2" Radii 3/4" Border  
4" Series D Legend  
White Background  
Black Legend and Border

Sign Mounting Holes Can Be Punched Or Field Drilled With No Obstruction To Text Or Symbols From Holes Or Bolts.

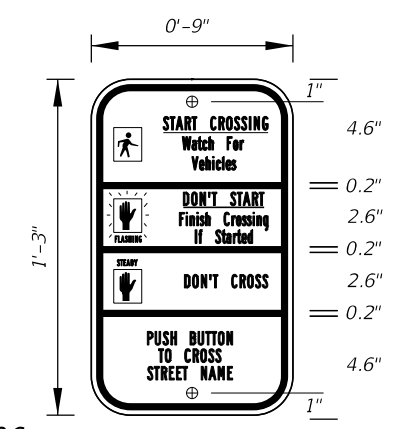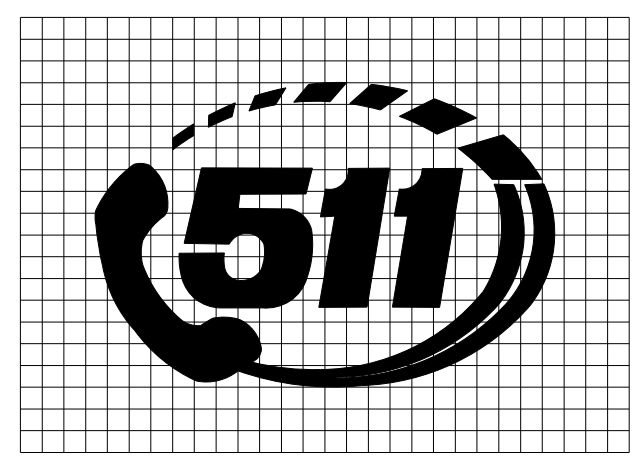

**FTP-66-06**  
4' X 5'  
2" Radii 3/4" Border  
7" Series D Legend  
Blue Background  
White Legend and Border




**FTP-67-06**  
3' X 4'  
2" Radii 3/4" Border  
5" Series D Legend  
Blue Background  
White Legend and Border

DETAIL for FTP-66 AND FTP-67

**FTP-68A-06**  
9" X 1'-3"  
1.5" Radii 3/4" Border  
Series B Legend  
White Background  
Black Legend and Border

See Standard Highway Signs Manual, Sign R10-3b For Letter Size Spacing And Symbol Sizes.

Sign Mounting Holes Can Be Punched Or Field Drilled With No Obstruction To Text Or Symbols From Holes Or Bolts.

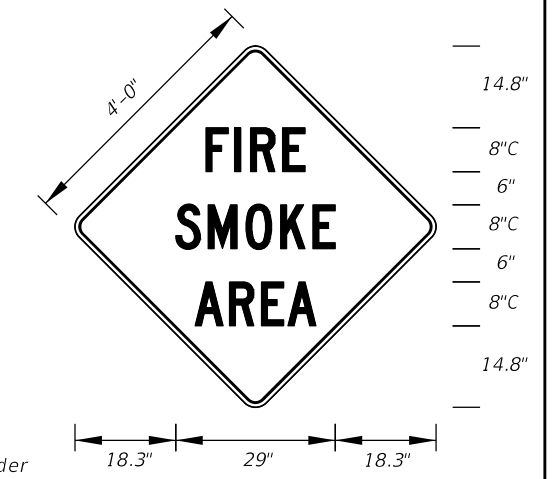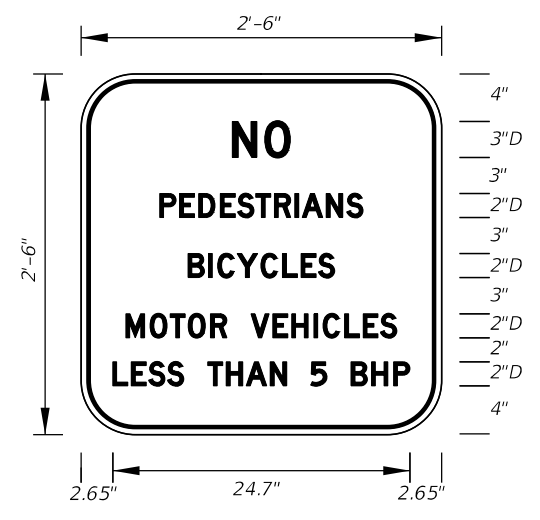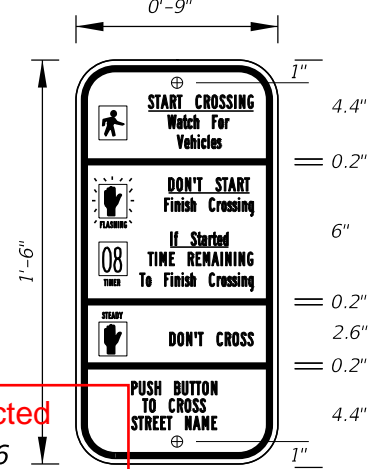

**FTP-68B-06**  
9" X 1'-6"  
1.5" Radii 3/4" Border  
Series B Legend  
White Background

Corrected

See Standard Highway Signs Manual, Sign R10-3b For Letter Size Spacing And Symbol Sizes.


**FTP-69-06**  
2'-6" X 2'-6"  
2" and 3" Series D Legend  
White Background  
Black Legend and Border  
4" Radii 3/4" Border

**FTP-70-06**  
3'-6" X 2'-6"  
2.25" Radii 3/4" Border  
5" Series C and 7" Series C Legend  
Blue Background  
White Legend and Border


**FTP-71-06**  
4' X 4'  
2" Radii 3/4" Border  
8" Series C Legend  
Yellow Background  
Black Legend and Border

10/16/2017 2:45:33 PM

LAST REVISION	DESCRIPTION:
11/01/17	11/01/18

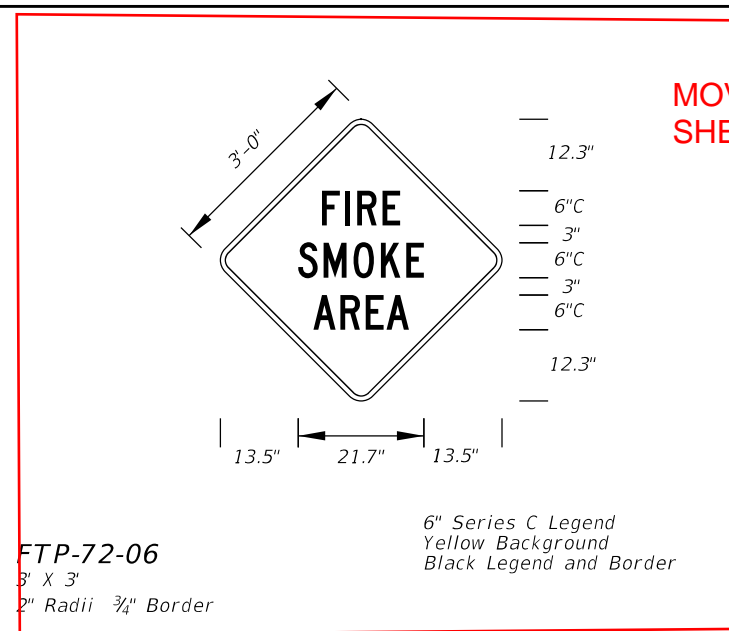


**FTP-72-06**  
3' X 3'  
2" Radii 3/4" Border  
6" Series C Legend  
Yellow Background  
Black Legend and Border

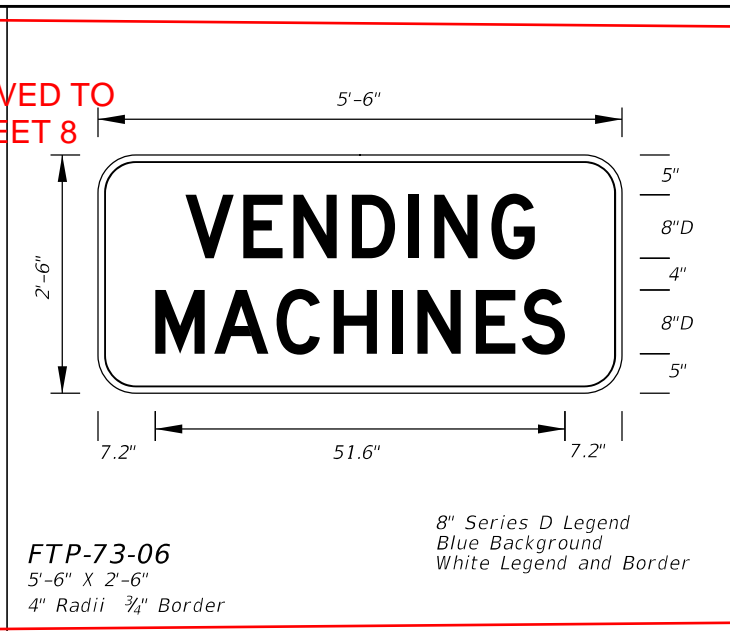


MOVED TO SHEET 8


**FTP-73-06**  
5'-6" X 2'-6"  
4" Radii 3/4" Border  
8" Series D Legend  
Blue Background  
White Legend and Border

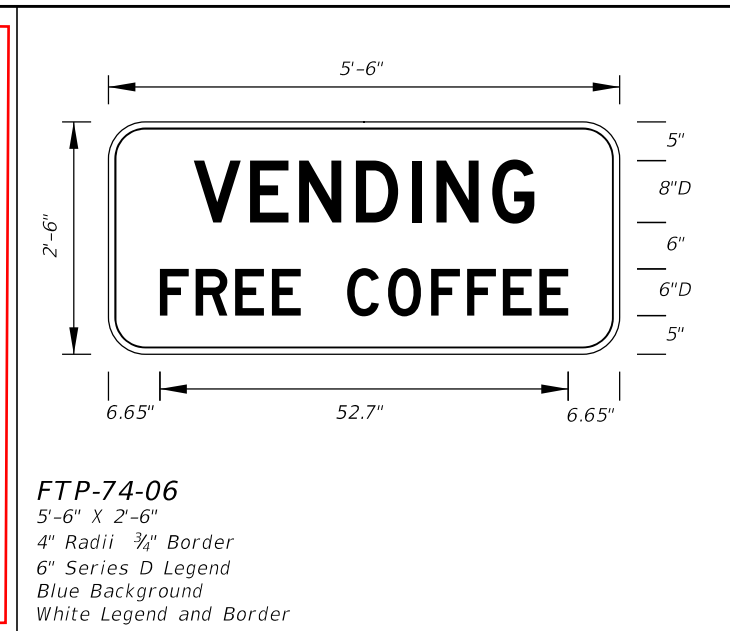


**FTP-74-06**  
5'-6" X 2'-6"  
4" Radii 3/4" Border  
6" Series D Legend  
Blue Background  
White Legend and Border

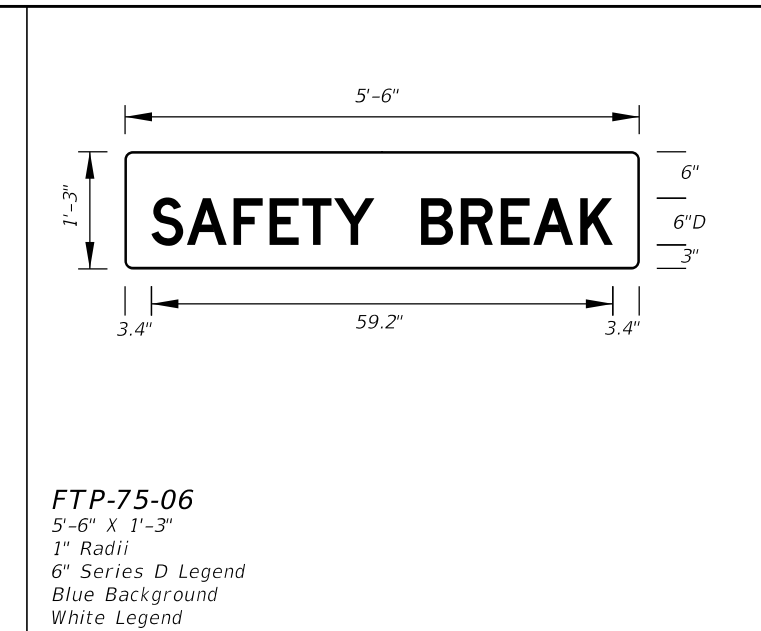


**FTP-75-06**  
5'-6" X 1'-3"  
1" Radii  
6" Series D Legend  
Blue Background  
White Legend

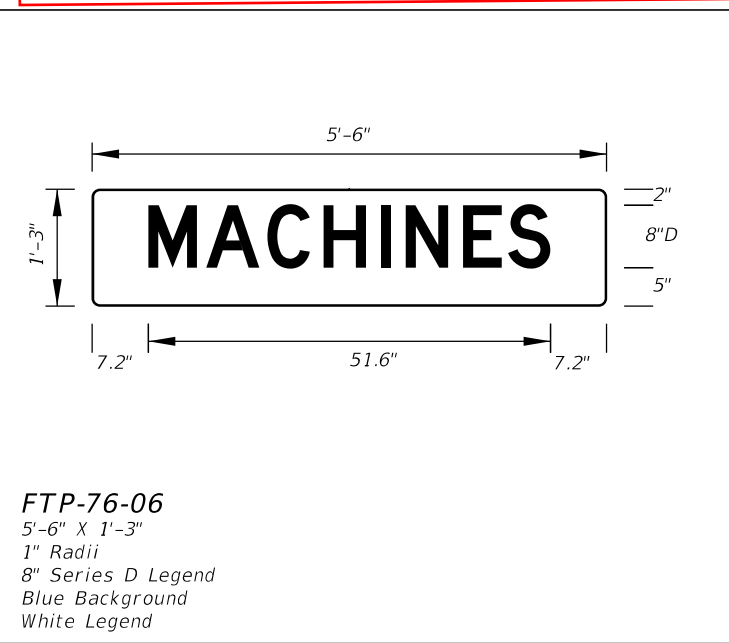


**FTP-76-06**  
5'-6" X 1'-3"  
1" Radii  
8" Series D Legend  
Blue Background  
White Legend

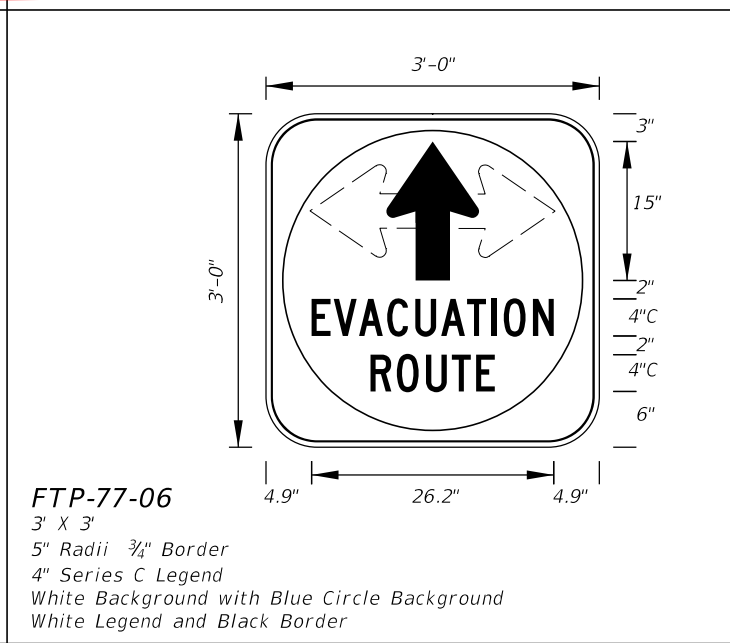


**FTP-77-06**  
3' X 3'  
5" Radii 3/4" Border  
4" Series C Legend  
White Background with Blue Circle Background  
White Legend and Black Border

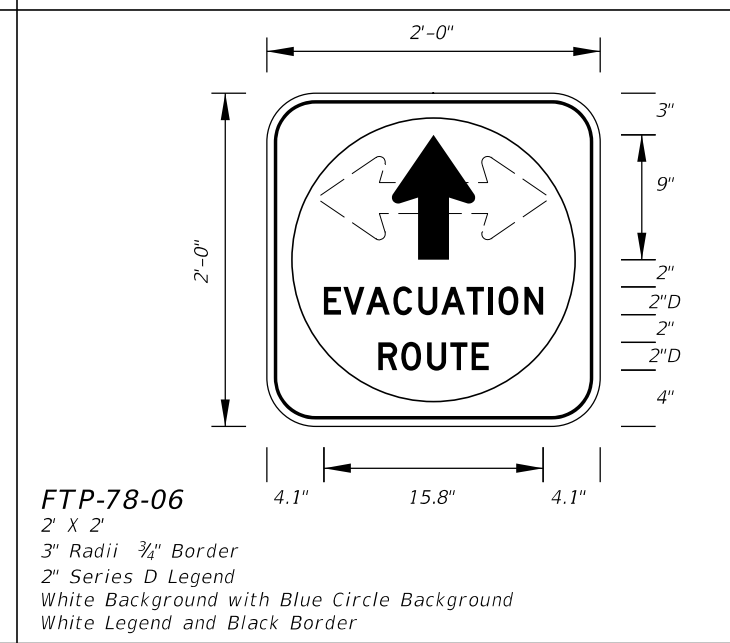


**FTP-78-06**  
2' X 2'  
3" Radii 3/4" Border  
2" Series D Legend  
White Background with Blue Circle Background  
White Legend and Black Border

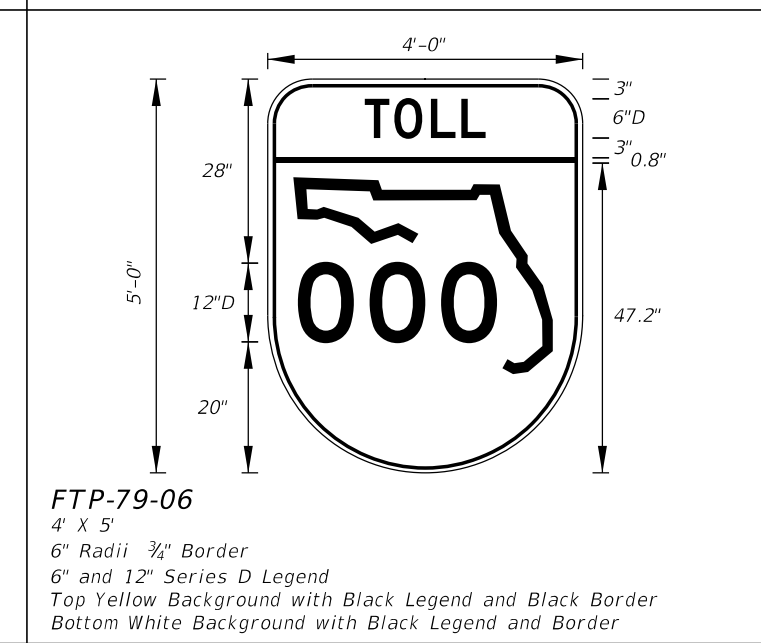


**FTP-79-06**  
4' X 5'  
6" Radii 3/4" Border  
6" and 12" Series D Legend  
Top Yellow Background with Black Legend and Black Border  
Bottom White Background with Black Legend and Border

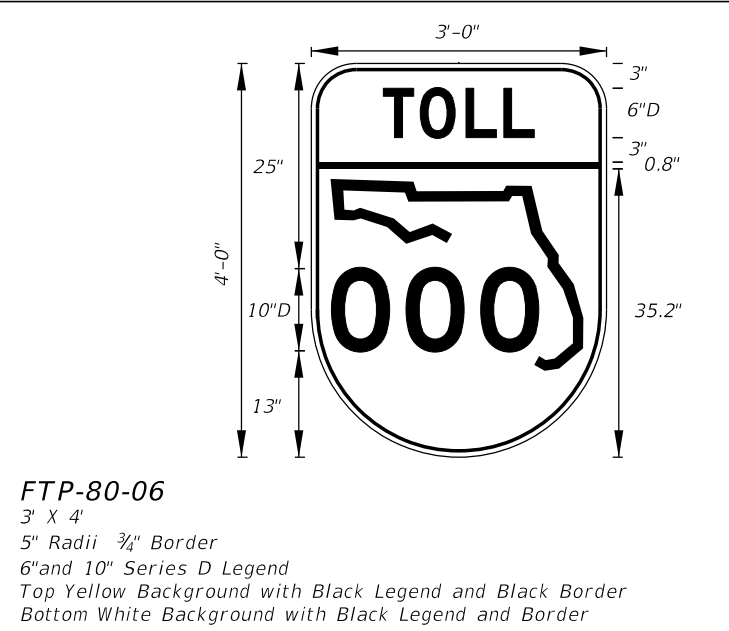


**FTP-80-06**  
3' X 4'  
5" Radii 3/4" Border  
6" and 10" Series D Legend  
Top Yellow Background with Black Legend and Black Border  
Bottom White Background with Black Legend and Border

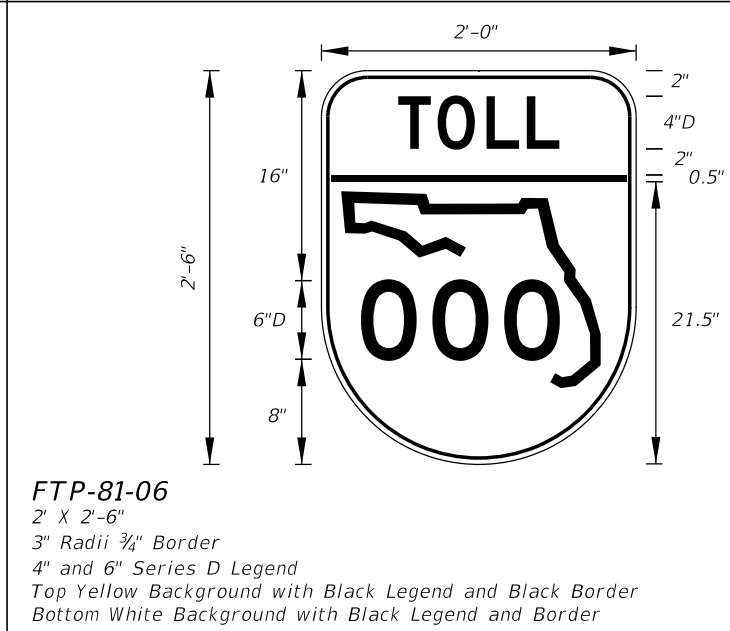

**FTP-81-06**  
2' X 2'-6"  
3" Radii 3/4" Border  
4" and 6" Series D Legend  
Top Yellow Background with Black Legend and Black Border  
Bottom White Background with Black Legend and Border

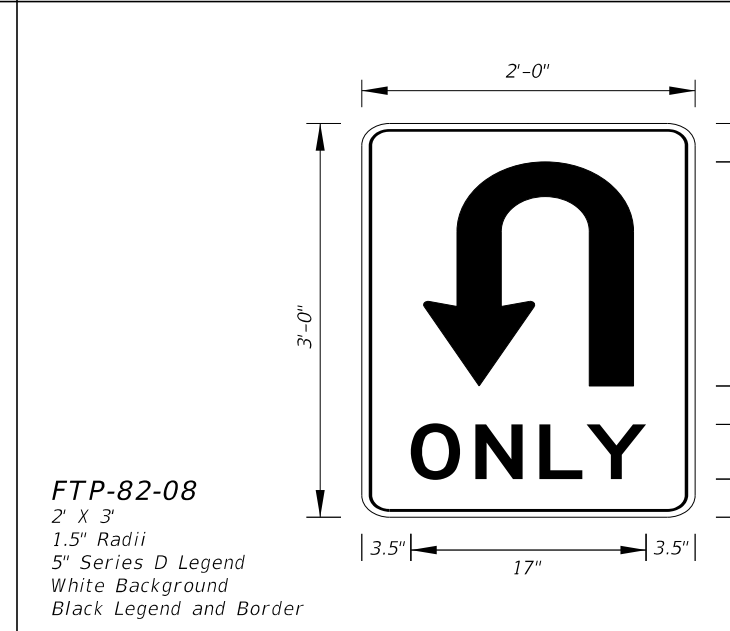


**FTP-82-08**  
2' X 3'  
1.5" Radii  
5" Series D Legend  
White Background  
Black Legend and Border

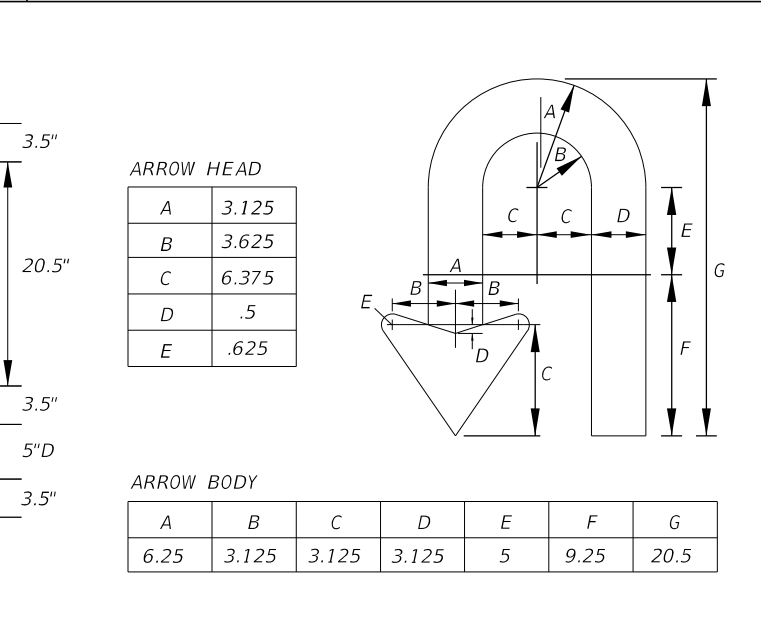


10/16/2017 2:45:35 PM


LAST REVISION	DESCRIPTION:
11/01/17	11/01/18

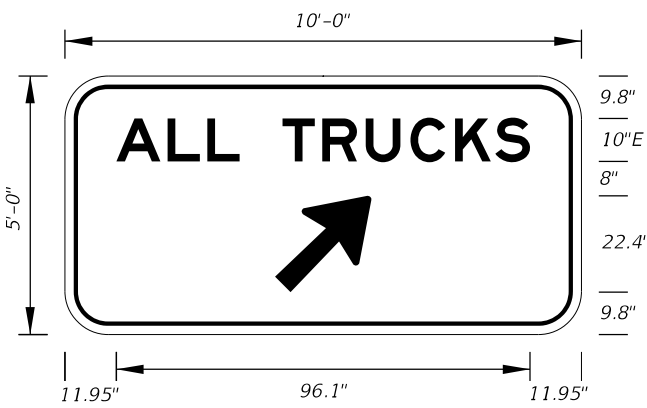


**FTP-83-08**  
10'-0" X 5'-0"  
8" Radii  
10" Series E Legend  
Green Background  
White Legend

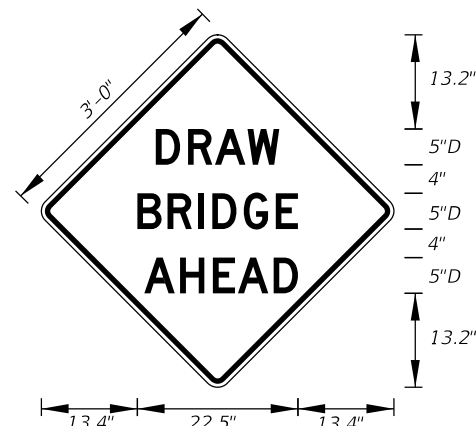


**FTP-84-09**  
3' X 3'  
1.5" Radii  
5" Series D Legend  
Yellow Background  
Black Legend

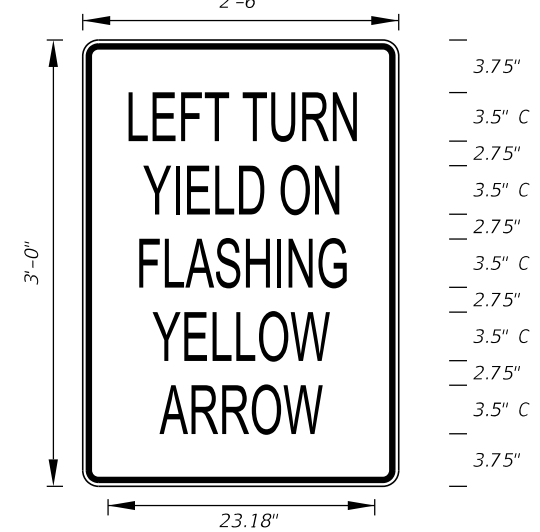


**FTP-85-13**  
3' X 2'-6"  
1.875" Radii 3/4" Border  
3.5" Series C Legend  
White Background  
Black Legend and Border

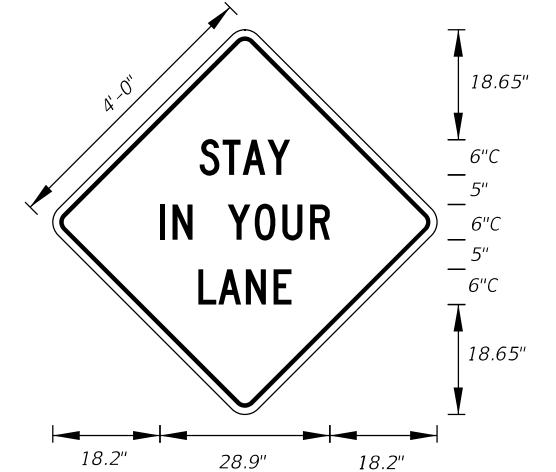


**MOT-1-06**  
4' X 4'  
2" Radii 3/4" Border  
6" Series C Legend  
Orange Background  
Black Legend and Border

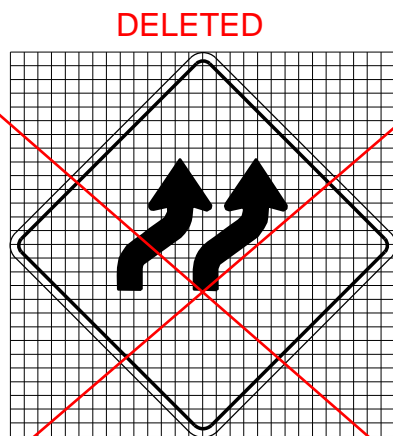


**MOT-2-06**  
4' X 4'  
2" Radii 3/4" Border  
Orange Background  
Black Arrows and Border

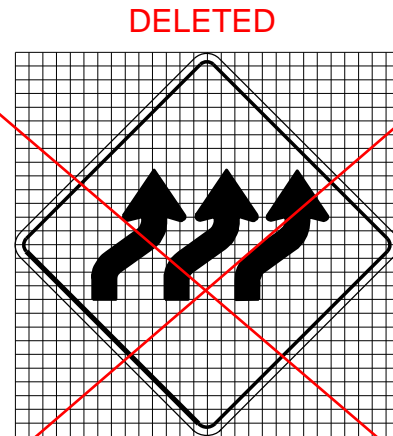


**MOT-3-06**  
4' X 4'  
2" Radii 3/4" Border  
Orange Background  
Black Arrows and Border

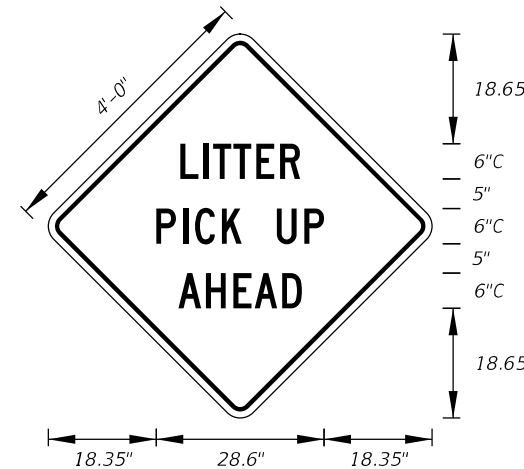


**MOT-4-06**  
4' X 4'  
2" Radii 3/4" Border  
6" Series C Legend  
Orange Background  
Black Legend and Border

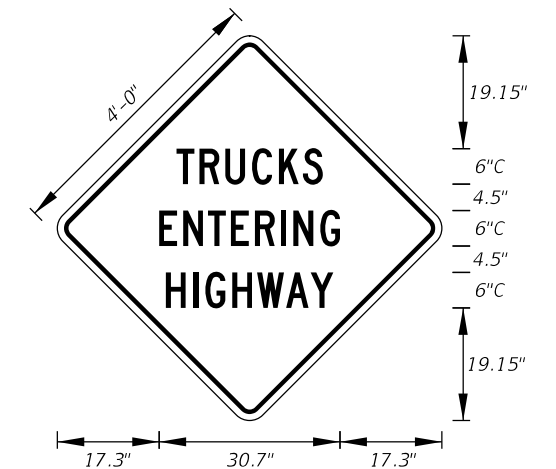


**MOT-5-06**  
4' X 4'  
2" Radii 3/4" Border  
6" Series C Legend  
Orange Background  
Black Legend and Border

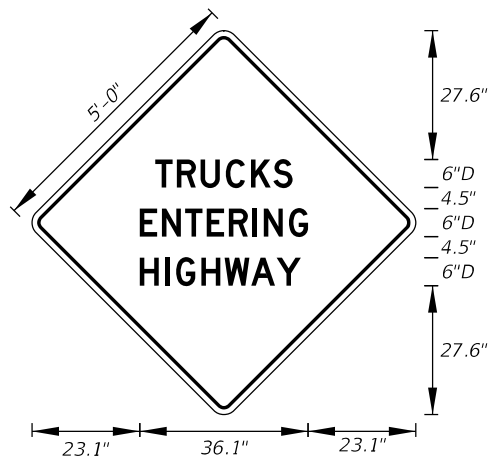


**MOT-6-06**  
5' X 5'  
2" Radii 3/4" Border  
6" Series D Legend  
Orange Background  
Black Legend and Border

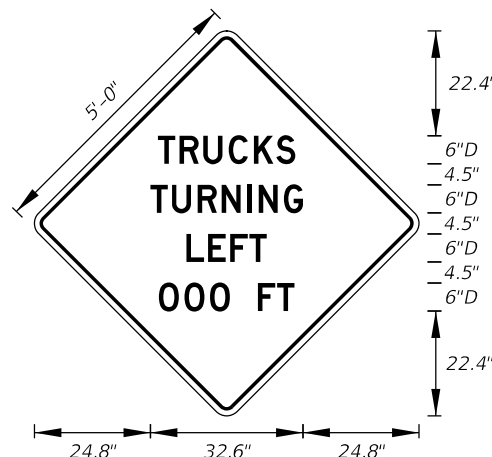

**MOT-7-06**  
5' X 5'  
2" Radii 3/4" Border  
6" Series D Legend  
Orange Background  
Black Legend and Border

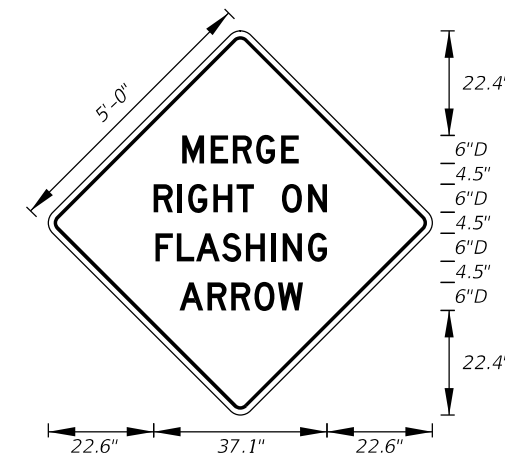

**MOT-8-06**  
5' X 5'  
2" Radii 3/4" Border  
6" Series D Legend  
Orange Background  
Black Legend and Border

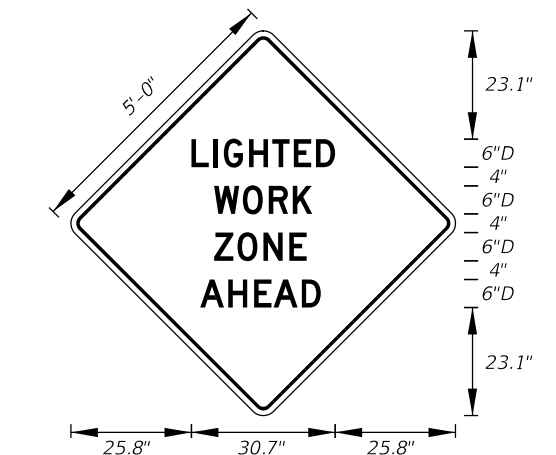


**MOT-9-06**  
5' X 5'  
2" Radii 3/4" Border  
6" Series D Legend  
Orange Background  
Black Legend and Border


10/16/2017 2:45:37 PM

LAST REVISION	DESCRIPTION:
11/01/17	
11/01/18	


Moved to Sheet 10

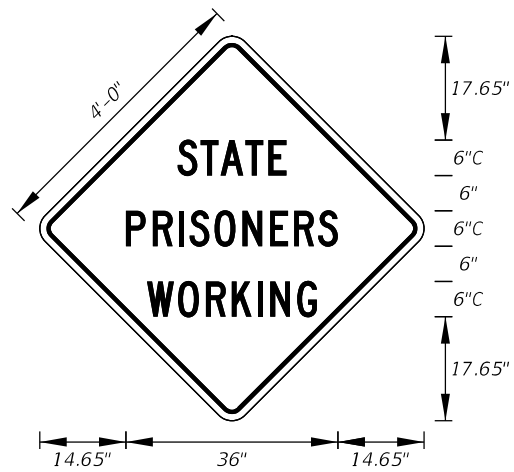

**MOT-10-06**  
4' X 4'  
2" Radii 3/4" Border  
6" Series C Legend  
Orange Background  
Black Legend and Border

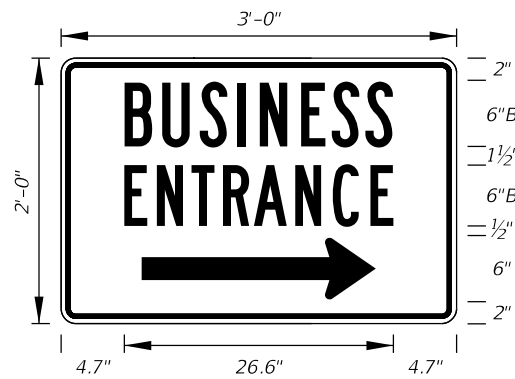


**MOT-11-06**  
3' X 2'  
2" Radii 3/4" Border  
6" Series B Legend  
Blue Background  
White Legend and Border

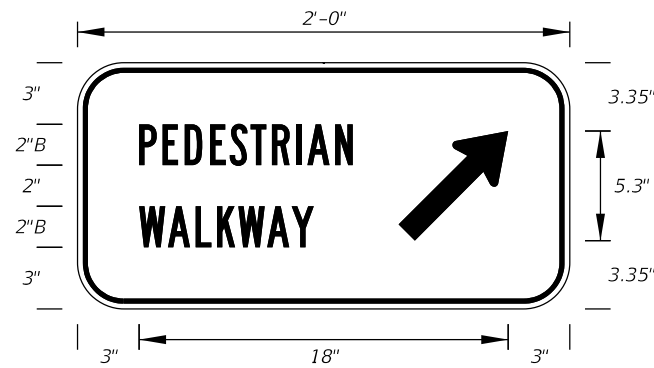


**MOT-12R-06**  
2' X 1'  
2" Radii 3/4" Border  
2" Series B Legend  
White Background  
Black Legend and Border


**MOT-12L-06**  
For Diversion  
to the left

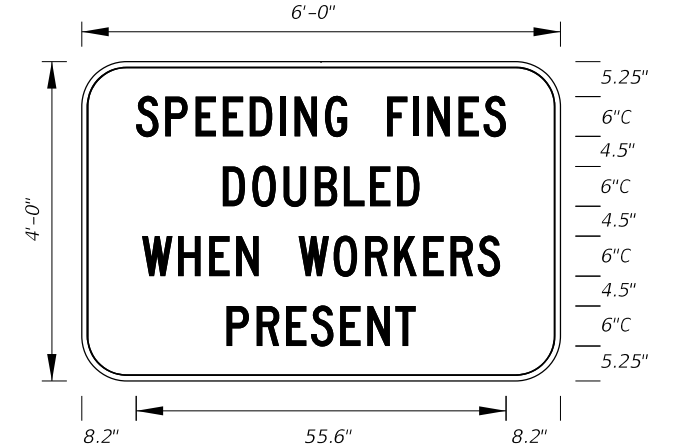


**MOT-13-06**  
Freeway Sign  
6' X 4'  
6" Radii 3/4" Border  
6" Series C Legend  
White Background  
Black Legend and Border

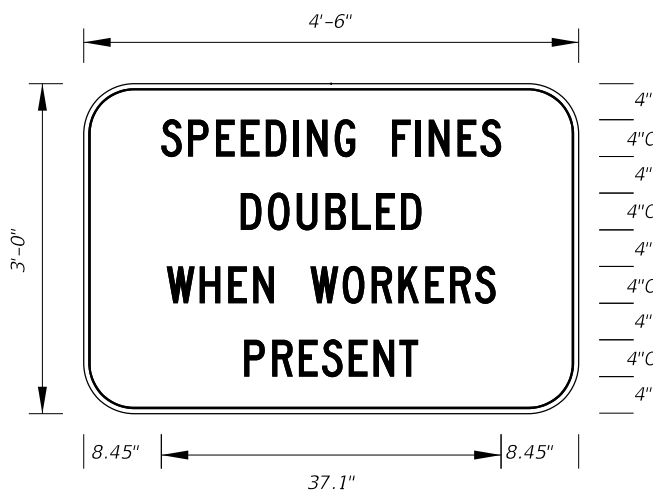


**MOT-14-06**  
Arterial Sign  
4'-6" X 3'  
5" Radii 3/4" Border  
4" Series C Legend  
White Background  
Black Legend and Border

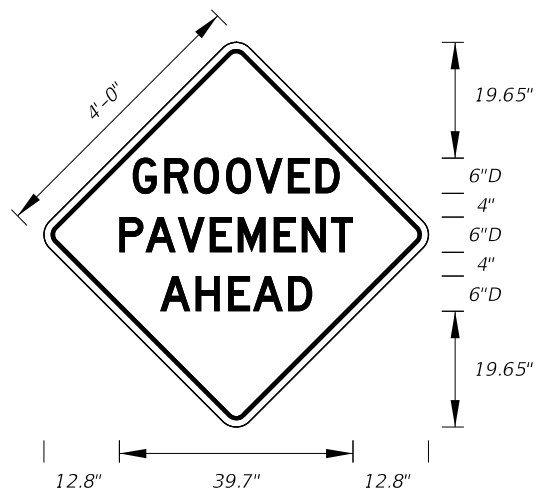


**MOT-15-06**  
4' X 4'  
2" Radii 3/4" Border  
6" Series D Legend  
Orange Background  
Black Legend and Border

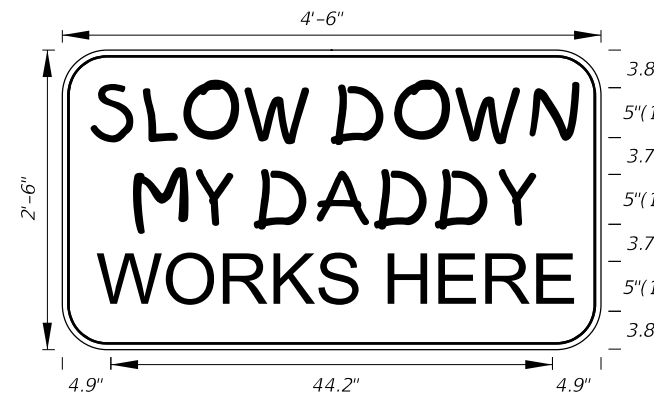


**MOT-16-06**  
4'-6" X 2'-6"  
4" Radii 3/4" Border  
5" Kids Series Legend  
Orange Background  
Black Legend and Border

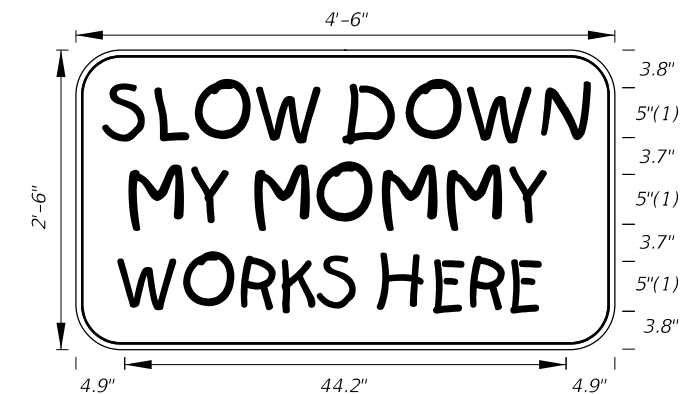


**MOT-17-06**  
4'-6" X 2'-6"  
4" Radii 3/4" Border  
5" Kids Series Legend  
Orange Background  
Black Legend and Border

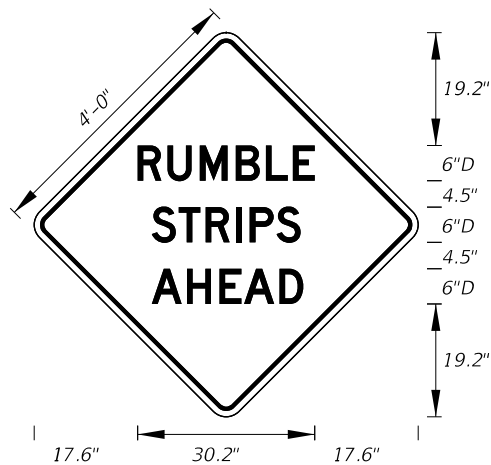


**MOT-18-10**  
4' X 4'  
2" Radii 3/4" Border  
6" Series D Legend  
Orange Background  
Black Legend and Border

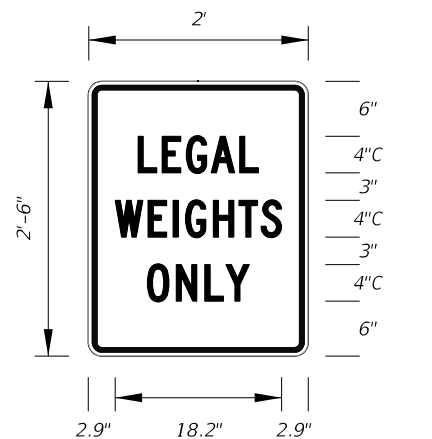

**MOT-19-11**  
2' X 2'-6"  
1.13" Radii 3/4" Border  
4" Series C Legend  
White Background  
Red Legend and Border

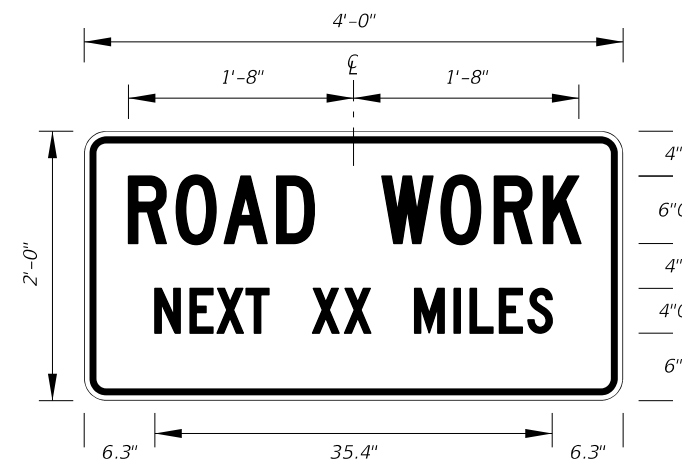

**G20-1**  
2' X 4'  
1.5" Radii 3/4" Border  
Orange Background  
Black Legend and Border

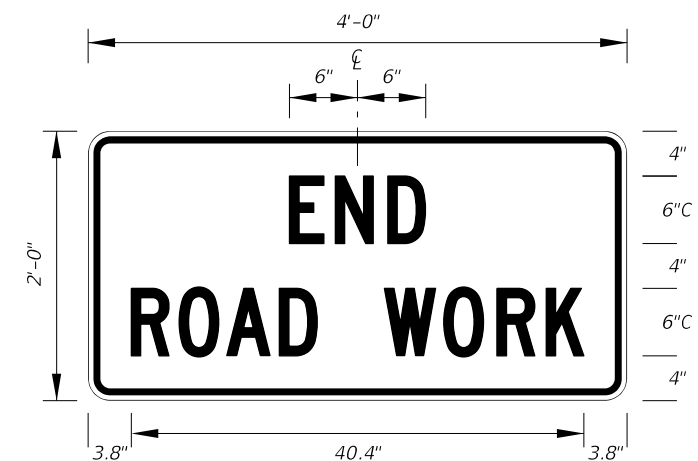

**G20-2**  
2' X 4'  
1.5" Radii 3/4" Border  
Orange Background  
Black Legend and Border

10/16/2017 2:45:37 PM


LAST REVISION	DESCRIPTION:
11/01/17	11/01/18




FY 2018-19  
STANDARD PLANS

SPECIAL SIGN DETAILS


INDEX  
700-102  
SHEET  
11 of 11

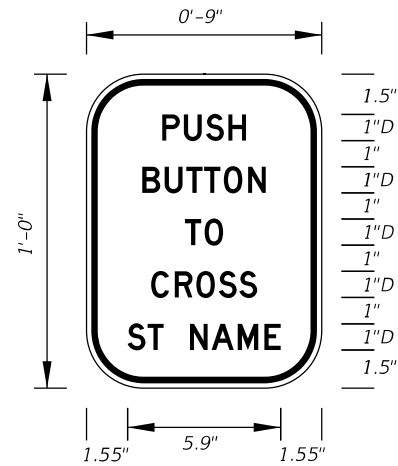


**FTP-25-06**  
 9" X 1'-0"  
 2" Radii 3/8" Border  
 1" Series D Legend  
 White Background  
 Black Legend and Border

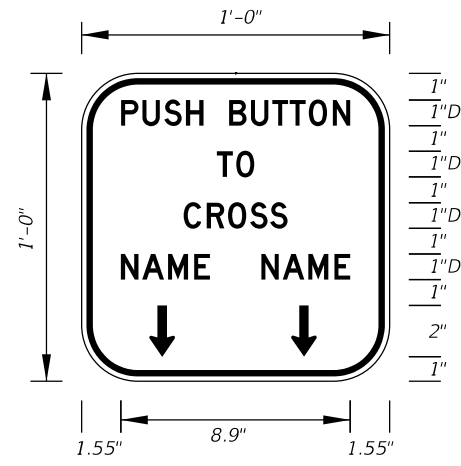


**FTP-26-06**  
 1' X 1'  
 2" Radii 3/8" Border  
 1" Series D Legend  
 White Background  
 Black Legend and Border

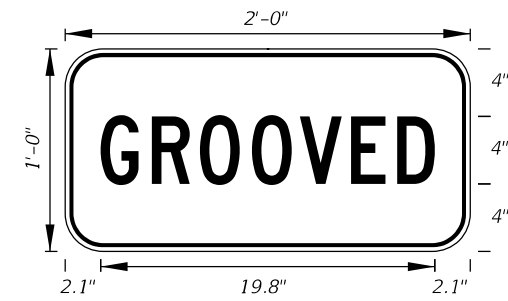


**FTP-29-06**  
 2'-0" X 1'-0"  
 2" Radii 5/8" Border  
 4" Series C Legend  
 Yellow Background  
 Black Legend and Border

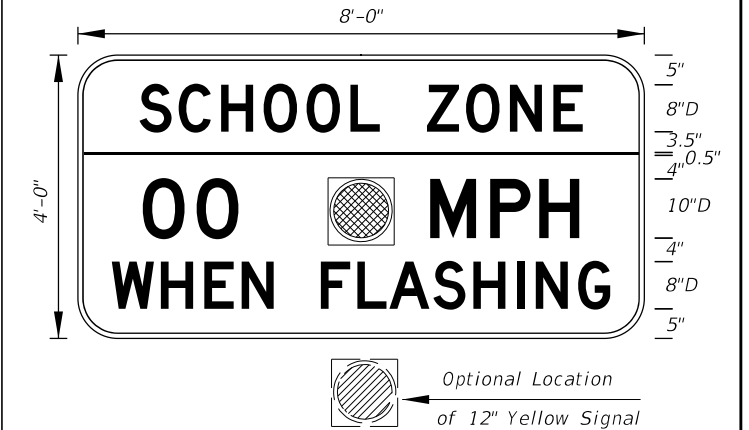

**FTP-31-06**  
 8' X 4'  
 6" Radii 3/4" Border  
 Series D Legend  
 Fluorescent Yellow-Green Background Top  
 White Background Bottom  
 Black Legend and Border

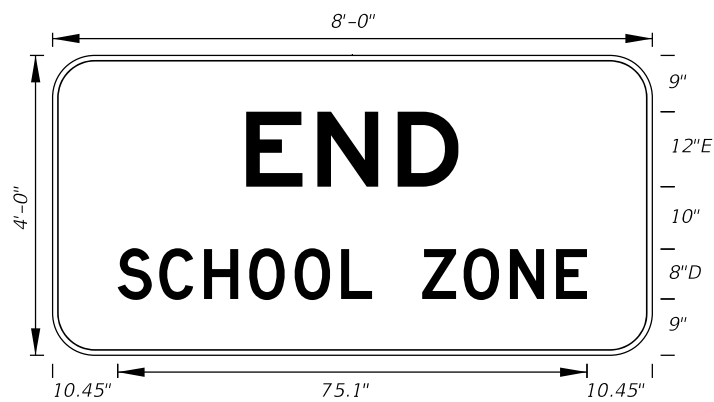


**FTP-32-06**  
 8' X 4'  
 6" Radii 3/4" Border  
 12" Series E and 8" Series D Legend  
 White Background  
 Black Legend and Border

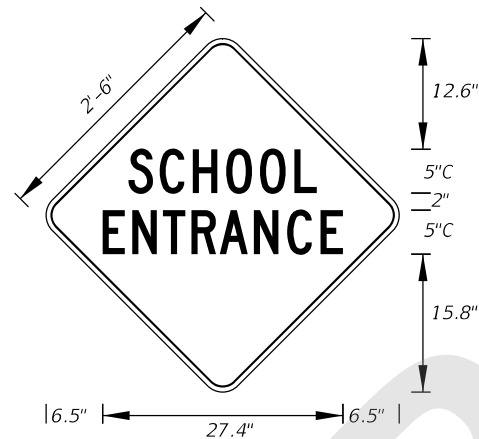


**FTP-33-06**  
 2'-6" X 2'-6"  
 2" Radii 3/4" Border  
 5" Series C Legend  
 Fluorescent Yellow-Green Background  
 Black Legend and Border




**FTP-34-06**  
 2' X 2'-6"  
 3" Radii 5/8" Border  
 4" Series D and E Legend  
 White Background  
 Black Legend and Border

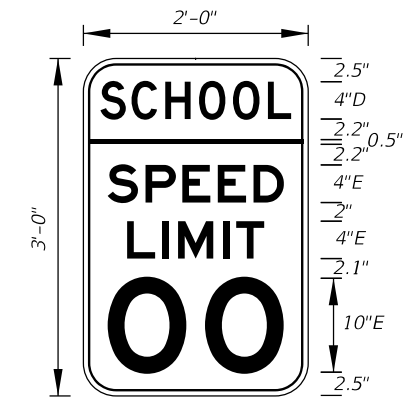


**FTP-35-06**  
 2' X 3'  
 3" Radii 5/8" Border  
 Top 4" Series D Legend  
 Bottom 4" and 10" Series E Legend  
 Fluorescent Yellow-Green Background Top  
 White Background Bottom  
 Black Legend and Border

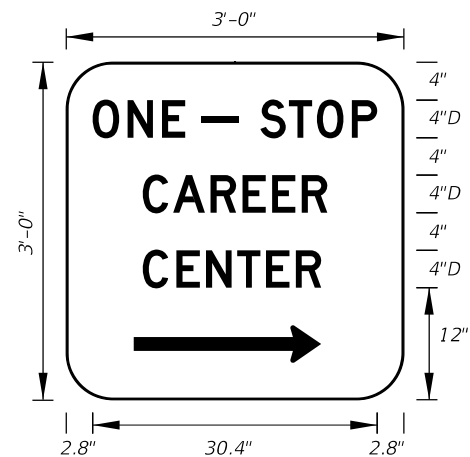


**FTP-36-06**  
 3' X 3'  
 5" Radii  
 4" Series D Legend  
 Green Background  
 White Legend and Border

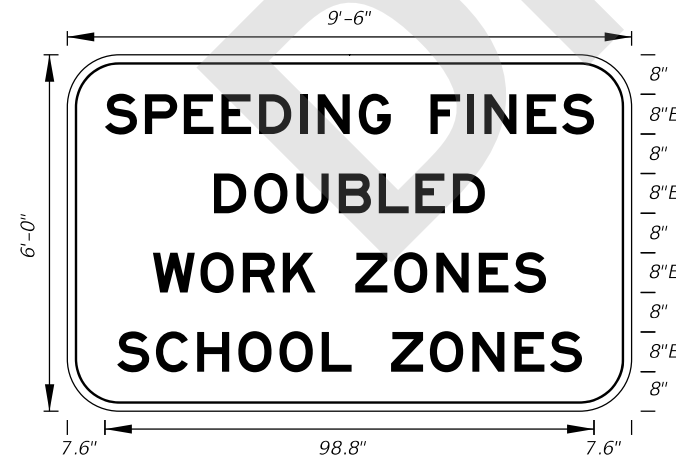

**FTP-37-06**  
 9'-6" X 6'  
 9" Radii 2" Border  
 8" Series E Legend  
 White Background  
 Black Legend and Border  
 State Line Sign

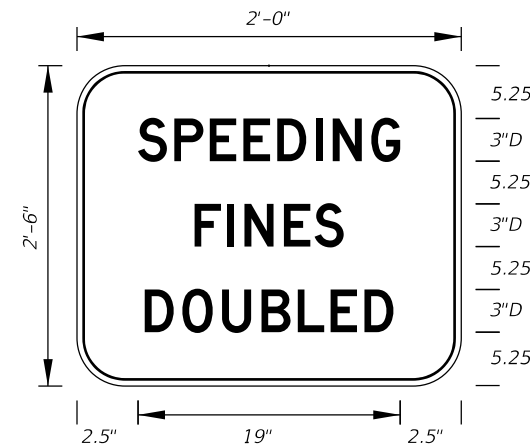

**FTP-38-06**  
 2' X 2'-6"  
 4" Radii 3/4" Border  
 3" Series D Legend  
 White Background  
 Black Legend and Border

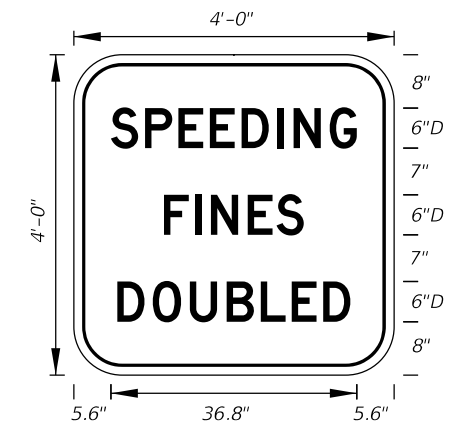

**FTP-39-06**  
 4' X 4'  
 6" Radii 3/4" Border  
 6" Series D Legend  
 White Background  
 Black Legend and Border  
 Freeway Sign

8/13/2018 8:26:44 AM

LAST REVISION	DESCRIPTION:
11/01/18	



FY 2019-20  
 STANDARD PLANS

SPECIAL SIGN DETAILS

INDEX  
 700-102


SHEET  
 5 of 11




**FTP-40-06**  
3'-6" X 4"  
6" Radii 3/4" Border  
3" and 6" Series C Legend  
White Background  
Black Legend and Border




**FTP-41-06**  
2'-6" X 3"  
4" Radii 3/4" Border  
2" and 4" Series C Legend  
White Background  
Black Legend and Border

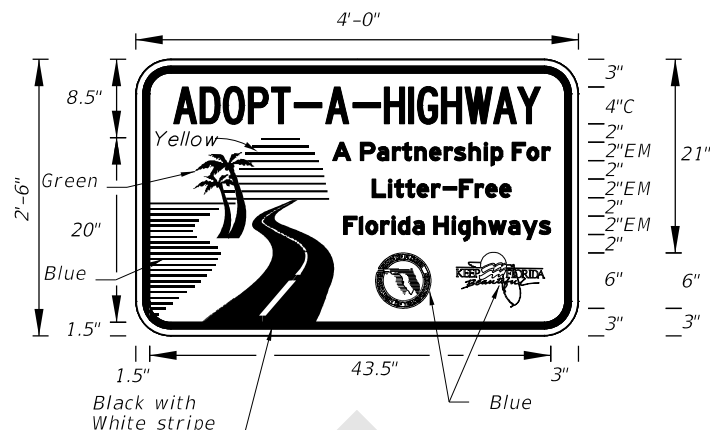


**FTP-42-06**  
4' X 2'-6"  
3" Radii  
Top 4" Series C Legend  
Bottom 2" Series EM Legend  
White Background  
Blue Legend and Border

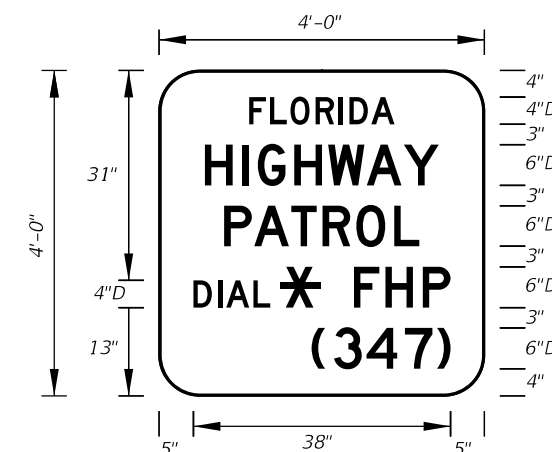


**FTP-43-06**  
4' X 4"  
6" Radii 1" Border  
Top 4" Series D Legend  
Bottom 6" Series D Legend  
Blue Background  
White Legend and Border

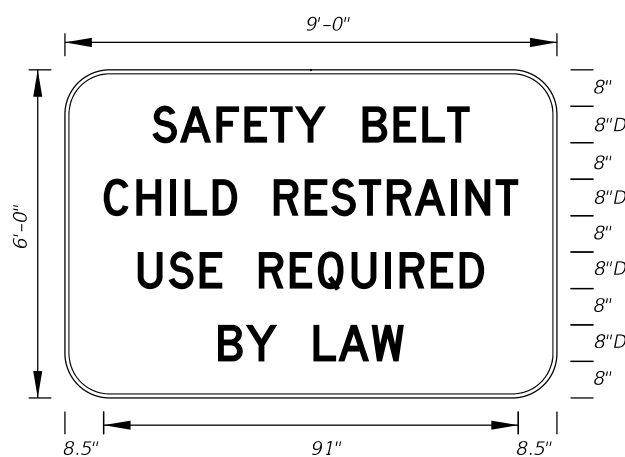


**FTP-44-06**  
9' X 6'  
9" Radii 3/4" Border  
8" Series D Legend  
White Background  
Black Legend and Border

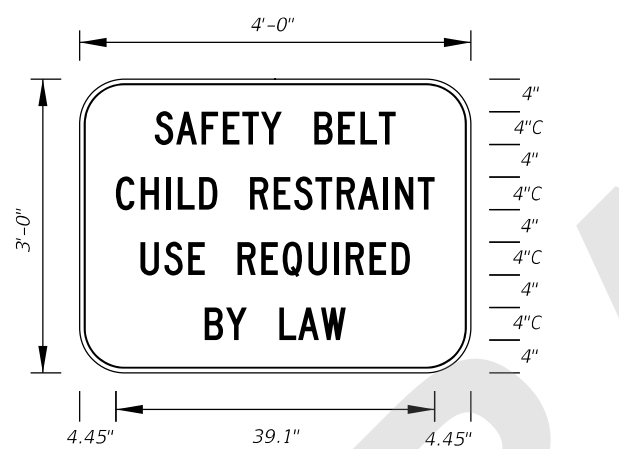


**FTP-45-06**  
4' X 3"  
5" Radii 3/4" Border  
4" Series C Legend  
White Background  
Black Legend and Border

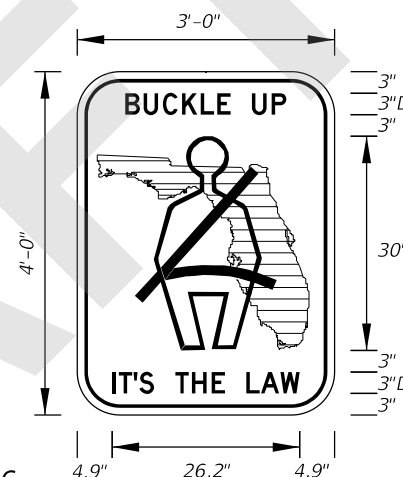


**FTP-46-06**  
3' X 4"  
5" Radii 3/4" Border  
3" Series D Legend  
White Background  
Green Florida Symbol  
Black Legend, Border and Man Belt Symbol

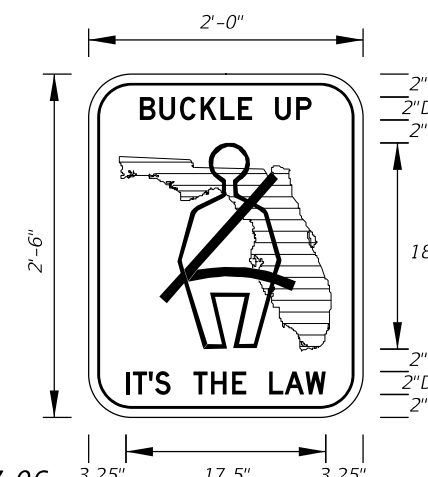


**FTP-47-06**  
2' X 2'-6"  
3" Radii 5/8" Border  
2" Series D Legend  
White Background  
Green Florida Symbol  
Black Legend, Border and Man Belt Symbol

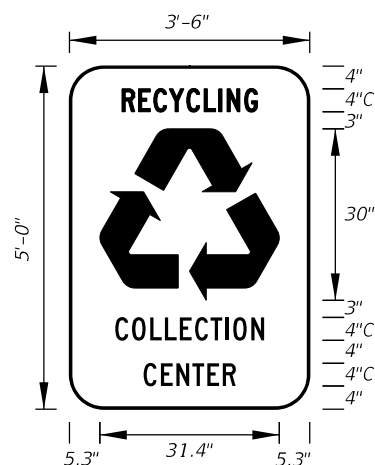


**FTP-48-06**  
3'-6" X 5"  
6" Radii  
4" Series C Legend  
Green Background  
White Legend, Border and Symbol

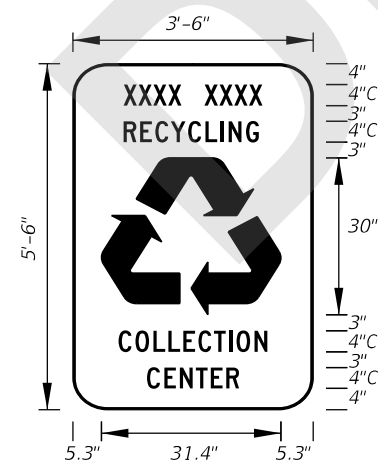

**FTP-49-06**  
3'-6" X 5'-6"  
6" Radii  
4" Series C Legend  
Green Background  
White Legend, Border and Symbol  
Municipality Name Optional

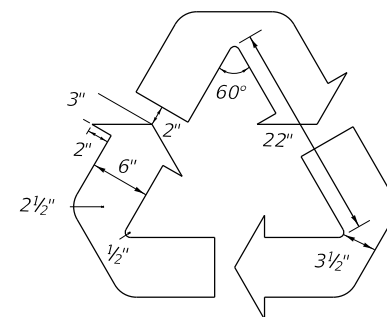

Detail for **FTP-48-06** and **FTP-49-06**

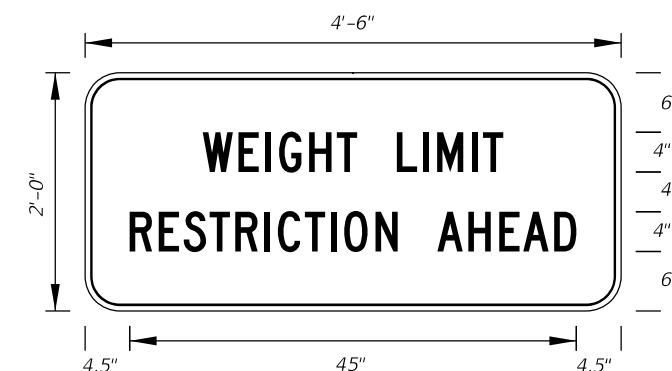


**FTP-50-06**  
4'-6" X 2'  
3" Radii 3/4" Border  
4" Series C Legend  
Yellow Background  
Black Legend and Border


8/13/2018 8:26:45 AM

LAST REVISION	DESCRIPTION:
11/01/18	




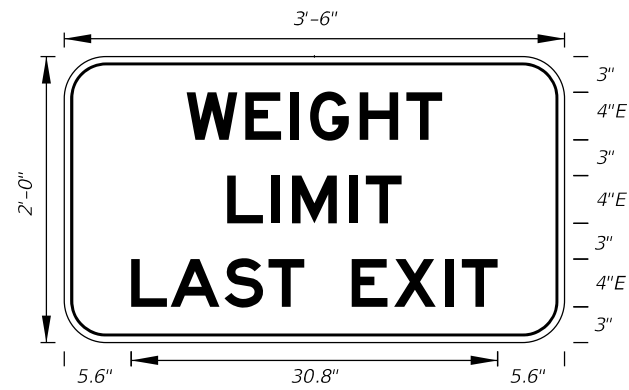


**FTP-51-06**  
3' X 2'  
3" Radii 3/4" Border  
4" Series E Legend  
White Background  
Black Legend and Border

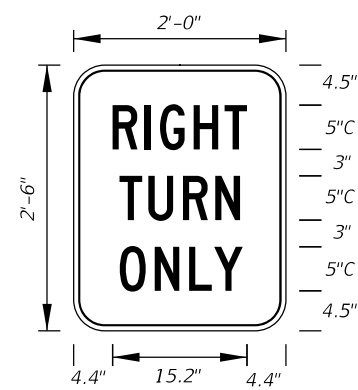


**FTP-52-06**  
2' X 2'-6"  
3" Radii 5/8" Border  
5" Series C Legend  
White Background  
Black Legend and Border

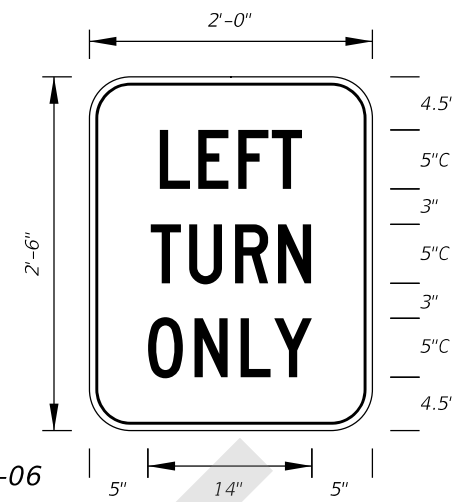

**FTP-53-06**  
2' X 2'-6"  
3" Radii 5/8" Border  
5" Series C Legend  
White Background  
Black Legend and Border

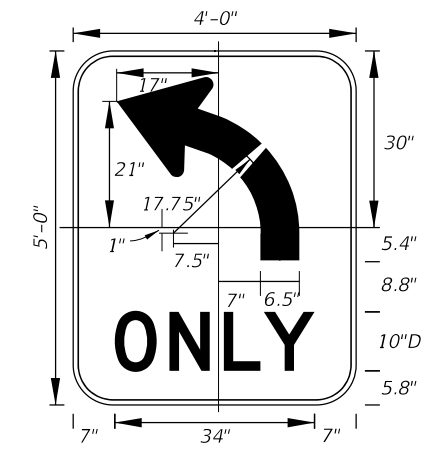


**FTP-54L-06**  
4' X 5'  
6" Radii 3/4" Border  
10" Series D Legend  
White Background  
Black Legend and Border  
*FTP-54R-06 for (Right Turn Arrow)*

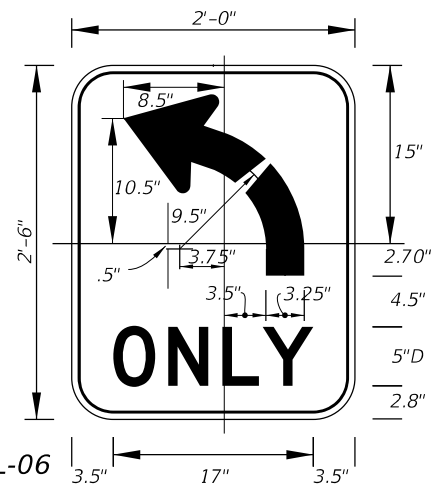


**FTP-55L-06**  
2' X 2'-6"  
3" Radii 3/8" Border  
5" Series D Legend  
White Background  
Black Legend and Border  
*FTP-55R-06 for (Right Turn Arrow)*




**FTP-56-06**  
6'-6" X 4'  
6" Radii 3/4" Border  
8" and 6" Series D Legend  
Blue Background  
White Legend and Border  
*Design Project Manager or Transit Administrator will supply correct 1-8XX number.*

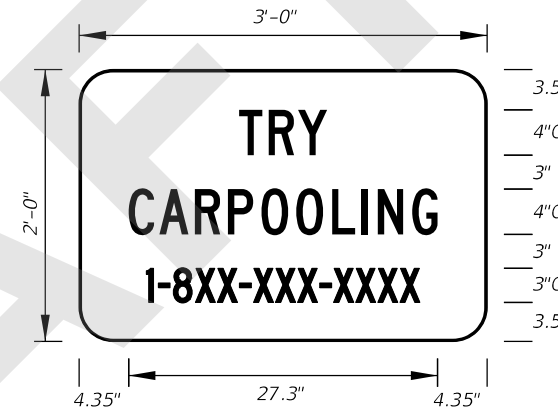


**FTP-56A-06**  
3' X 2'  
3" Radii  
4" and 3" Series C Legend  
Blue Background  
White Legend and Border  
*Design Project Manager or Transit Administrator will supply correct 1-8XX number.*

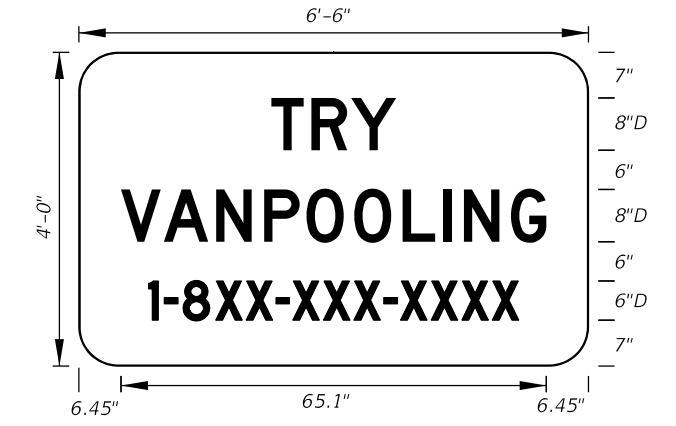


**FTP-57-06**  
6'-6" X 4'  
6" Radii  
8" and 6" Series D Legend  
Blue Background  
White Legend and Border  
*Design Project Manager or Transit Administrator will supply correct 1-8XX number.*

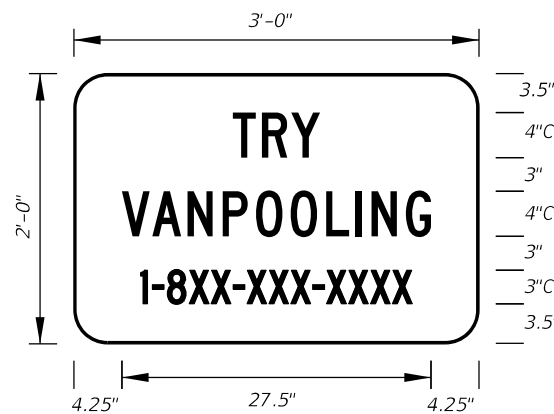

**FTP-58-06**  
3' X 2'  
3" Radii  
4" and 3" Series C Legend  
Blue Background  
White Legend and Border  
*Design Project Manager or Transit Administrator will supply correct 1-8XX number.*

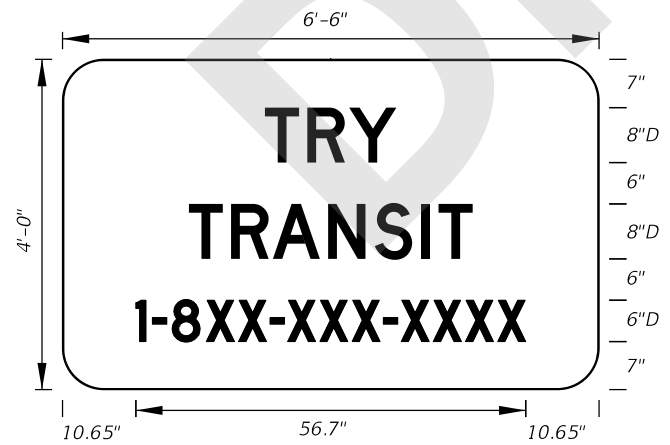

**FTP-59-06**  
6'-6" X 4'  
6" Radii  
8" and 6" Series D Legend  
Blue Background  
White Legend and Border  
*Design Project Manager or Transit Administrator will supply correct 1-8XX number.*

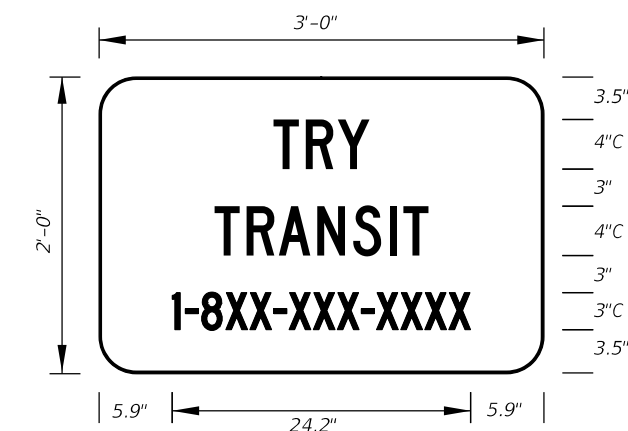


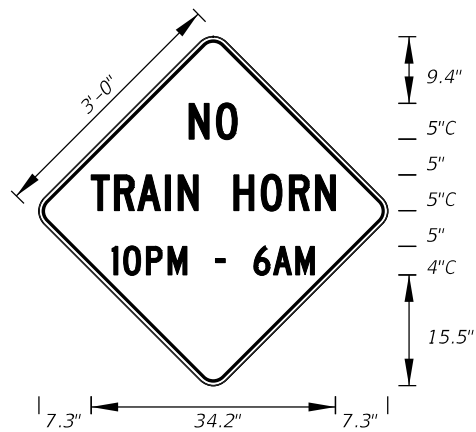
**FTP-60-06**  
3' X 2'  
3" Radii  
4" and 3" Series C Legend  
Blue Background  
White Legend and Border  
*Design Project Manager or Transit Administrator will supply correct 1-8XX number.*




**FTP-61-06**  
3' X 2'  
3" Radii 3/4" Border  
4" and 3" Series C Legend  
Yellow Background  
Black Legend and Border

8/13/2018 8:26:46 AM

LAST REVISION 11/01/18	DESCRIPTION:	 FY 2019-20 STANDARD PLANS	SPECIAL SIGN DETAILS	INDEX 700-102	SHEET 7 of 11
---------------------------	--------------	--	----------------------	------------------	------------------



**FTP-62-06**  
3' X 3'  
2" Radii 3/4" Border 4" and 5" Series C Legend  
Yellow Background Black Legend and Border

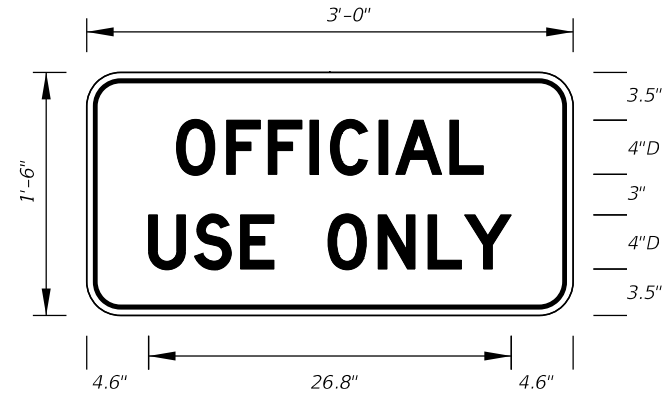


**FTP-65-06**  
3' X 1'-6"  
2" Radii 3/4" Border  
4" Series D Legend  
White Background  
Black Legend and Border



**FTP-66-06**  
4' X 5'  
2" Radii 3/4" Border  
7" Series D Legend  
Blue Background  
White Legend and Border




**FTP-67-06**  
3' X 4'  
2" Radii 3/4" Border  
5" Series D Legend  
Blue Background  
White Legend and Border

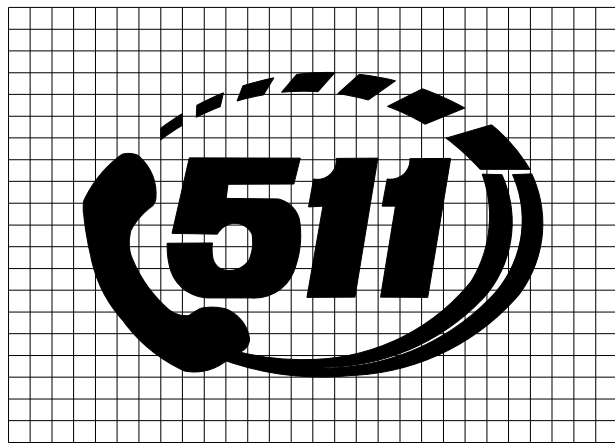

DETAIL for FTP-66 AND FTP-67


Sign Mounting Holes Can Be Punched Or Field Drilled With No Obstruction To Text Or Symbols From Holes Or Bolts.

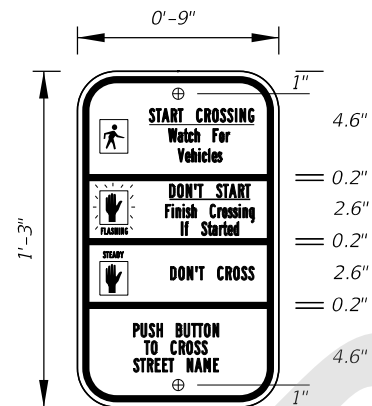

**FTP-68A-06**  
9" X 1'-3"  
1.5" Radii 3/4" Border  
Series B Legend  
White Background  
Black Legend and Border


See Standard Highway Signs Manual, Sign R10-3b For Letter Size Spacing And Symbol Sizes.

Sign Mounting Holes Can Be Punched Or Field Drilled With No Obstruction To Text Or Symbols From Holes Or Bolts.

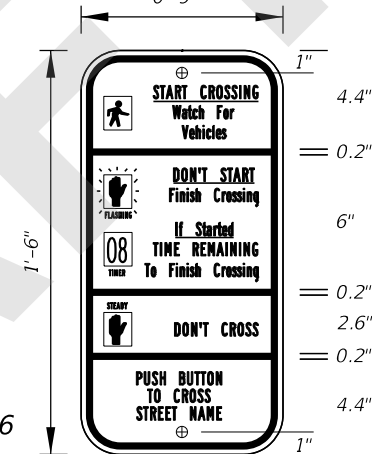

**FTP-68B-06**  
9" X 1'-6"  
1.5" Radii 3/4" Border  
Series B Legend  
White Background  
Black Legend and Border

See Standard Highway Signs Manual, Sign R10-3b For Letter Size Spacing And Symbol Sizes.

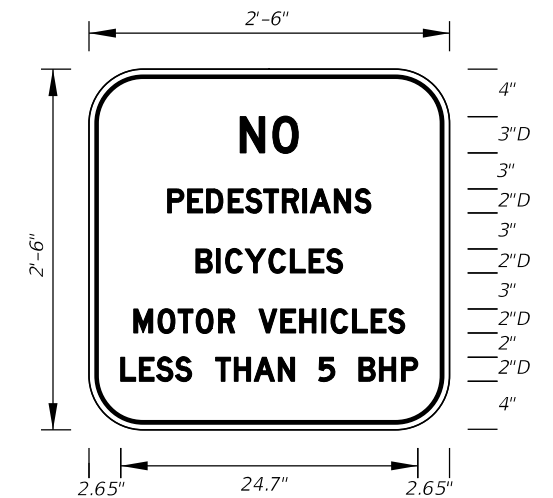

**FTP-69-06**  
2'-6" X 2'-6"  
4" Radii 3/4" Border  
2" and 3" Series D Legend  
White Background  
Black Legend and Border



**FTP-70-06**  
3'-6" X 2'-6"  
2.25" Radii 3/4" Border  
5" Series C and 7" Series C Legend  
Blue Background  
White Legend and Border




**FTP-71-06**  
4' X 4'  
2" Radii 3/4" Border  
8" Series C Legend  
Yellow Background  
Black Legend and Border



**FTP-72-06**  
3' X 3'  
2" Radii 3/4" Border

6" Series C Legend  
Yellow Background  
Black Legend and Border

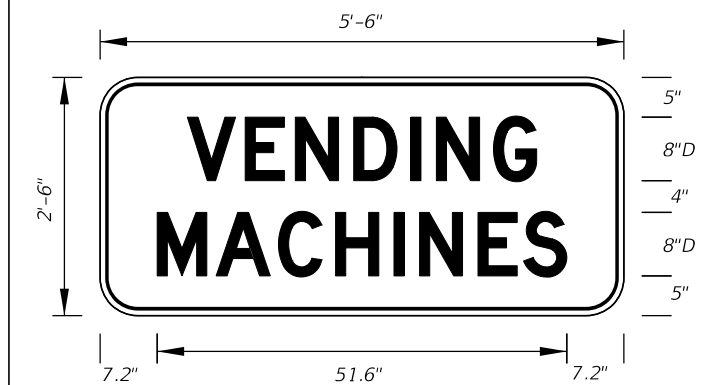


**FTP-73-06**  
5'-6" X 2'-6"  
4" Radii 3/4" Border  
8" Series D Legend  
Blue Background  
White Legend and Border

8/13/2018 8:26:47 AM


LAST REVISION	DESCRIPTION:
11/01/17	




**FTP-74-06**  
 5'-6" X 2'-6"  
 4" Radii 3/4" Border  
 6" Series D Legend  
 Blue Background  
 White Legend and Border

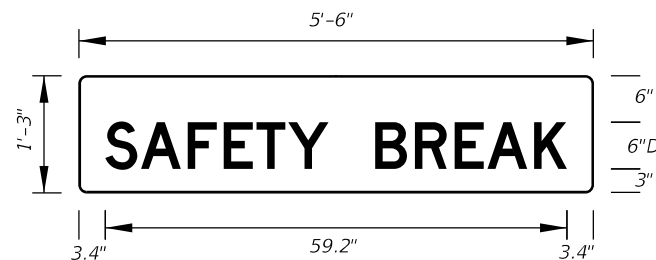


**FTP-75-06**  
 5'-6" X 1'-3"  
 1" Radii  
 6" Series D Legend  
 Blue Background  
 White Legend

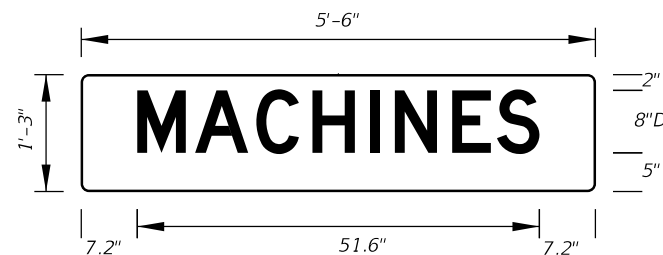


**FTP-76-06**  
 5'-6" X 1'-3"  
 1" Radii  
 8" Series D Legend  
 Blue Background  
 White Legend

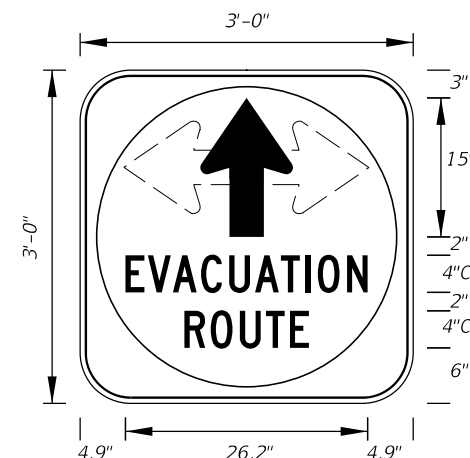


**FTP-77-06**  
 3' X 3'  
 5" Radii 3/4" Border  
 4" Series C Legend  
 White Background with Blue Circle Background  
 White Legend and Black Border

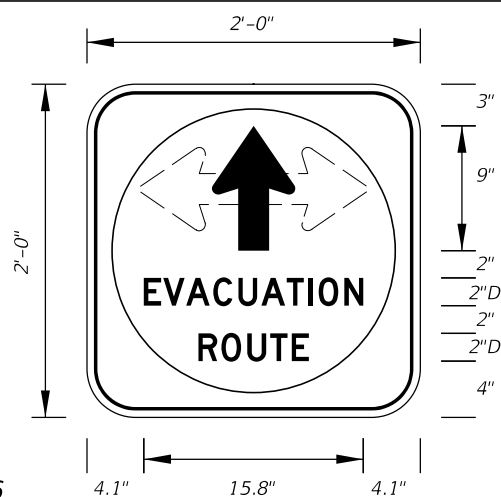


**FTP-78-06**  
 2' X 2'  
 3" Radii 3/4" Border  
 2" Series D Legend  
 White Background with Blue Circle Background  
 White Legend and Black Border

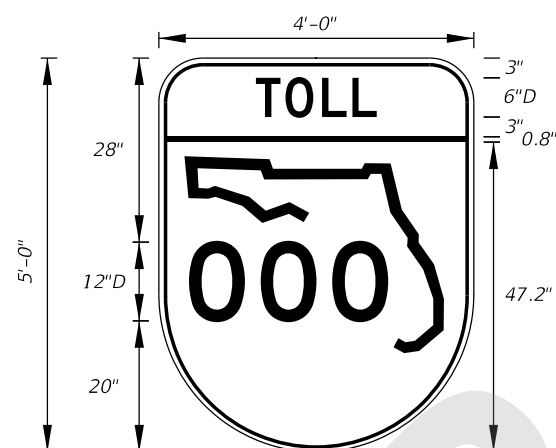


**FTP-79-06**  
 4' X 5'  
 6" Radii 3/4" Border  
 6" and 12" Series D Legend  
 Top Yellow Background with Black Legend and Black Border  
 Bottom White Background with Black Legend and Border

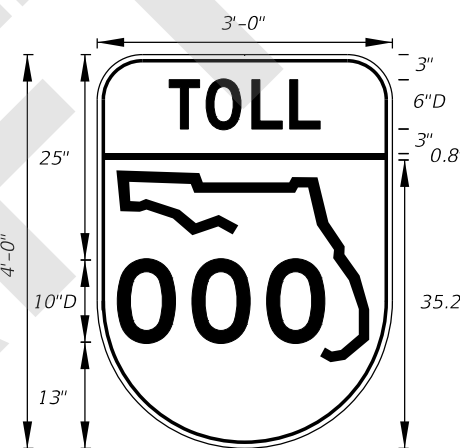




**FTP-80-06**  
 3' X 4'  
 5" Radii 3/4" Border  
 6" and 10" Series D Legend  
 Top Yellow Background with Black Legend and Black Border  
 Bottom White Background with Black Legend and Border

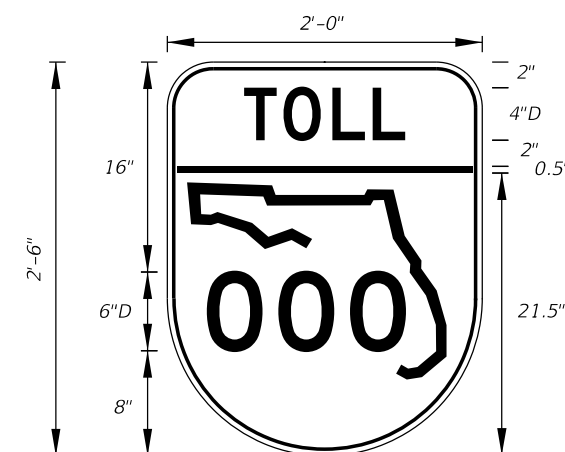


**FTP-81-06**  
 2' X 2'-6"  
 3" Radii 3/4" Border  
 4" and 6" Series D Legend  
 Top Yellow Background with Black Legend and Black Border  
 Bottom White Background with Black Legend and Border

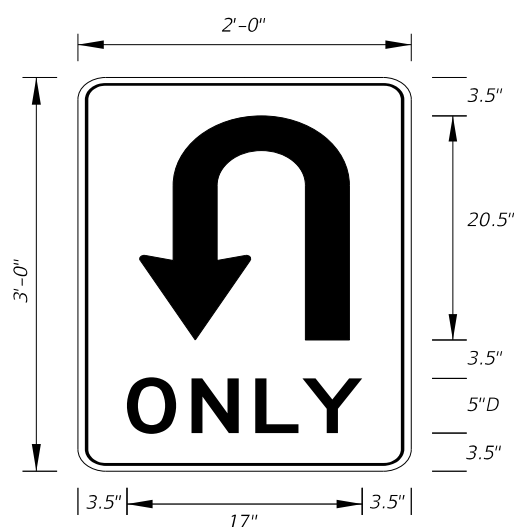

**FTP-82-08**  
 2' X 3'  
 1.5" Radii  
 5" Series D Legend  
 White Background  
 Black Legend and Border

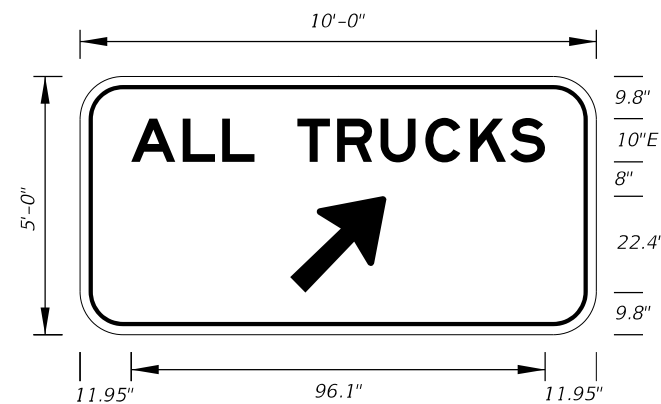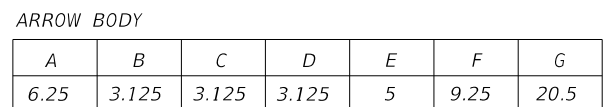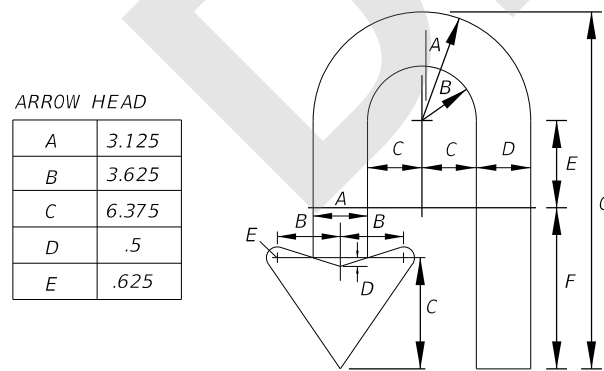

**FTP-83-08**  
 10'-0" X 5'-0"  
 8" Radii  
 10" Series E Legend  
 Green Background  
 White Legend

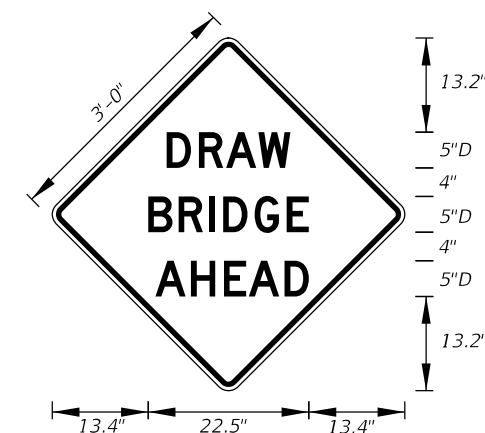

**FTP-84-09**  
 3' X 3'  
 1.5" Radii  
 5" Series D Legend  
 Yellow Background  
 Black Legend and Border

8/13/2018 8:26:54 AM




FY 2019-20  
 STANDARD PLANS

SPECIAL SIGN DETAILS


INDEX  
 700-102

SHEET  
 9 of 11


LAST REVISION	DESCRIPTION:
11/01/17	

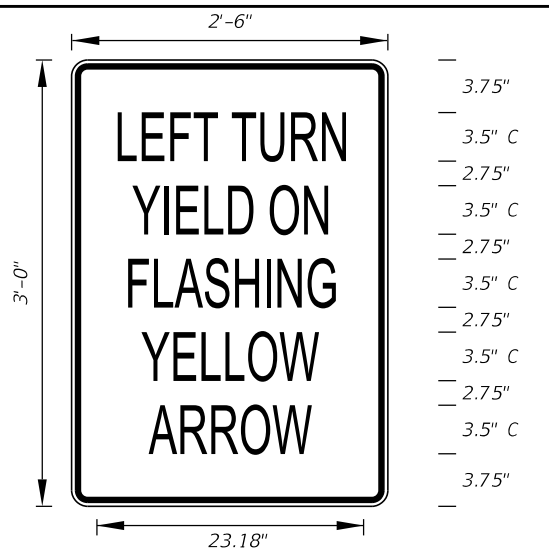


**FTP-85-13**  
3' X 2'-6"  
1.875" Radii 3/4" Border  
3.5" Series C Legend  
White Background  
Black Legend and Border

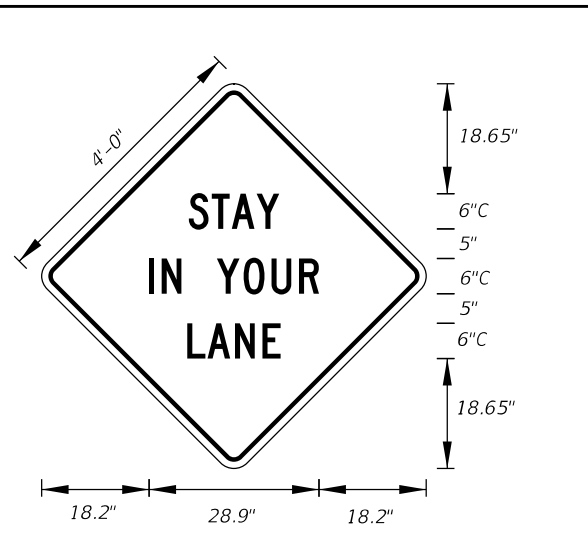


**MOT-1-06**  
4' X 4'  
2" Radii 3/4" Border  
6" Series C Legend  
Orange Background  
Black Legend and Border

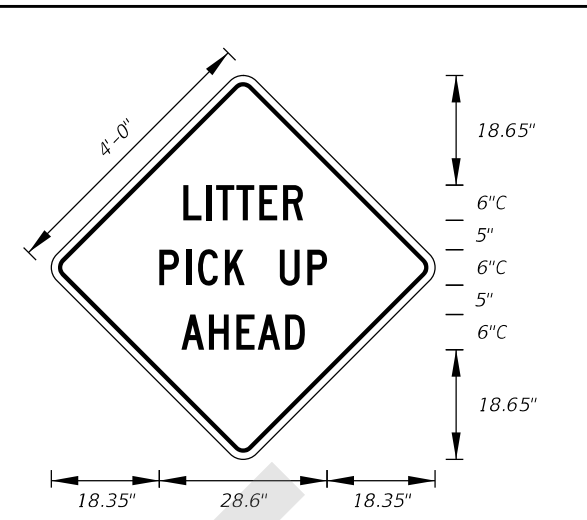


**MOT-4-06**  
4' X 4'  
2" Radii 3/4" Border  
6" Series C Legend  
Orange Background  
Black Legend and Border

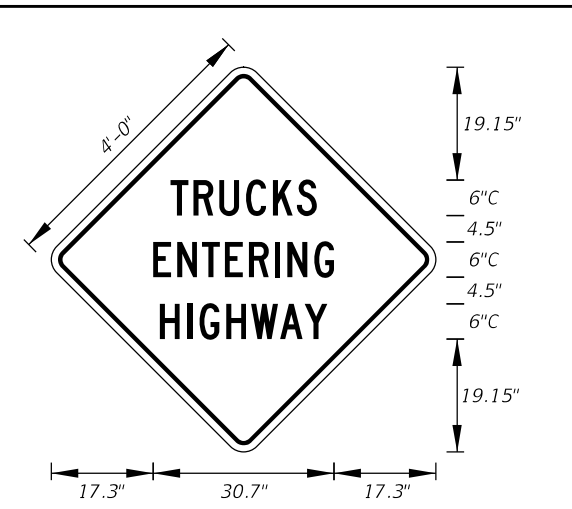


**MOT-5-06**  
4' X 4'  
2" Radii 3/4" Border  
6" Series C Legend  
Orange Background  
Black Legend and Border

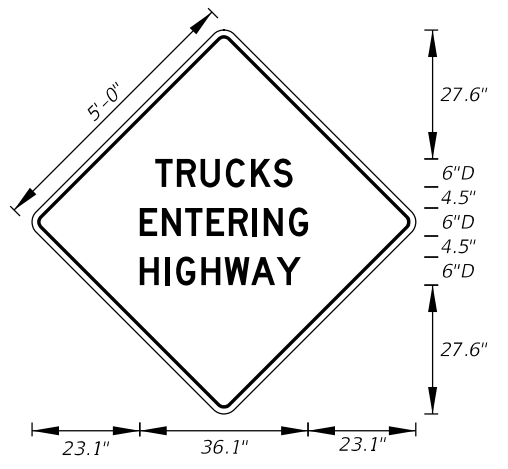


**MOT-6-06**  
5' X 5'  
2" Radii 3/4" Border  
6" Series D Legend  
Orange Background  
Black Legend and Border

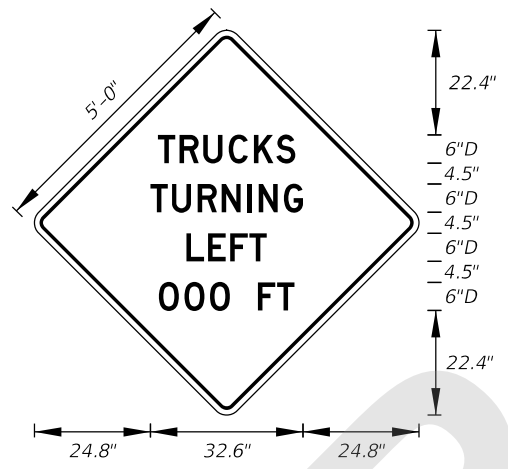


**MOT-7-06**  
5' X 5'  
2" Radii 3/4" Border  
6" Series D Legend  
Orange Background  
Black Legend and Border

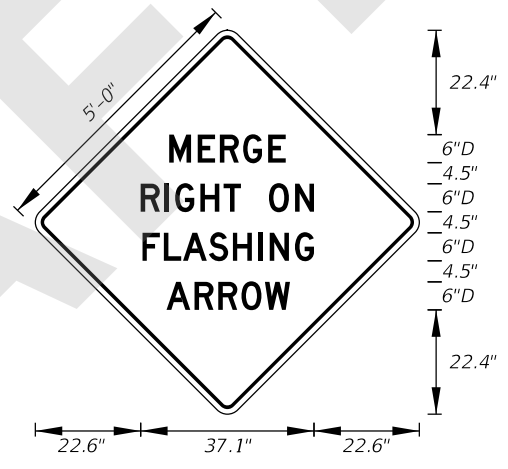


**MOT-8-06**  
5' X 5'  
2" Radii 3/4" Border  
6" Series D Legend  
Orange Background  
Black Legend and Border

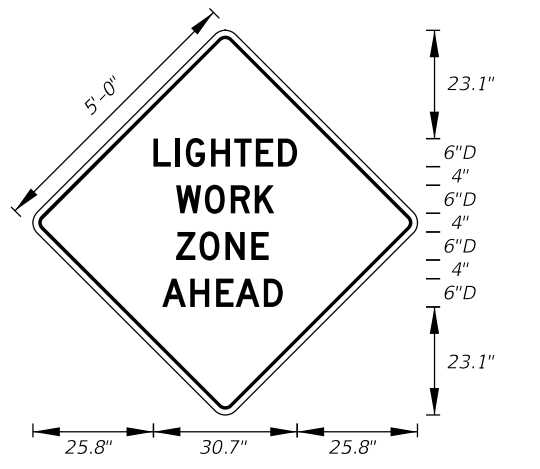


**MOT-9-06**  
5' X 5'  
2" Radii 3/4" Border  
6" Series D Legend  
Orange Background  
Black Legend and Border

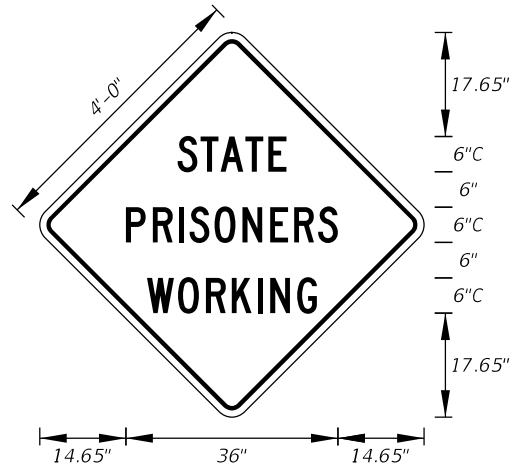


**MOT-10-06**  
4' X 4'  
2" Radii 3/4" Border  
6" Series C Legend  
Orange Background  
Black Legend and Border

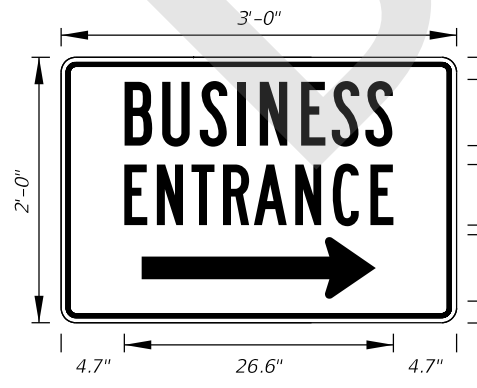

**MOT-11-06**  
3' X 2'  
2" Radii 3/4" Border  
6" Series B Legend  
Blue Background  
White Legend and Border

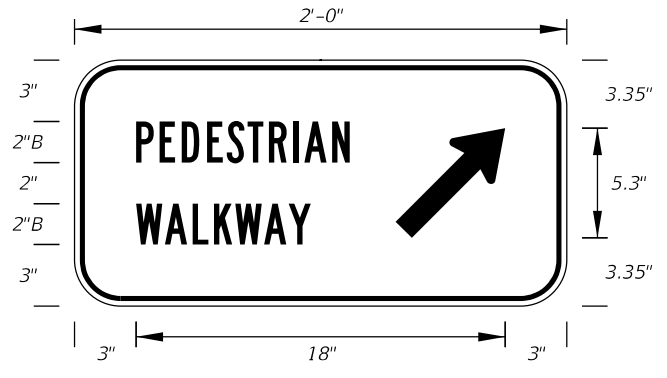


**MOT-12R-06**  
2' X 1'  
2" Radii 3/4" Border  
**MOT-12L-06**  
For Diversion to the left  
2" Series B Legend  
White Background  
Black Legend and Border

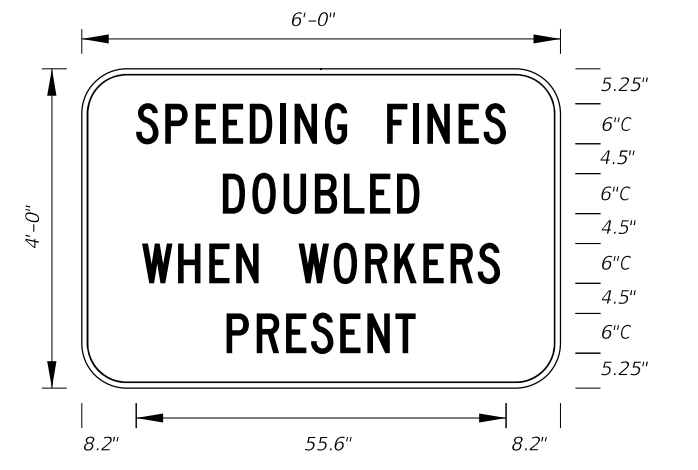


**MOT-13-06**  
Freeway Sign  
6' X 4'  
6" Radii 3/4" Border  
6" Series C Legend  
White Background  
Black Legend and Border

8/13/2018 8:27:00 AM

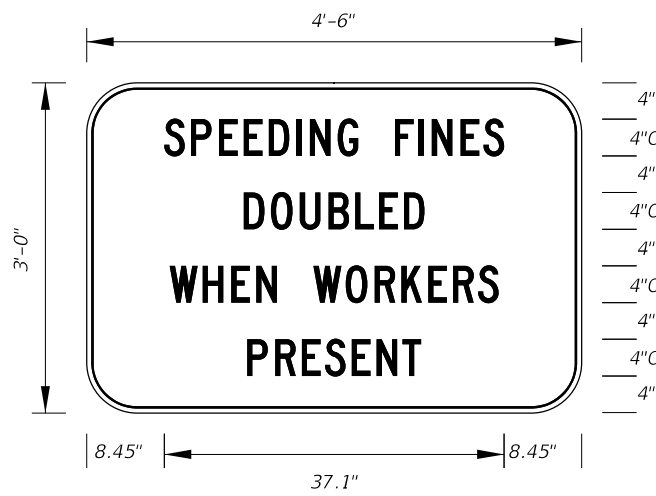


**MOT-14-06**  
Arterial Sign  
4'-6" X 3'  
5" Radii 3/4" Border

4" Series C Legend  
White Background  
Black Legend and Border

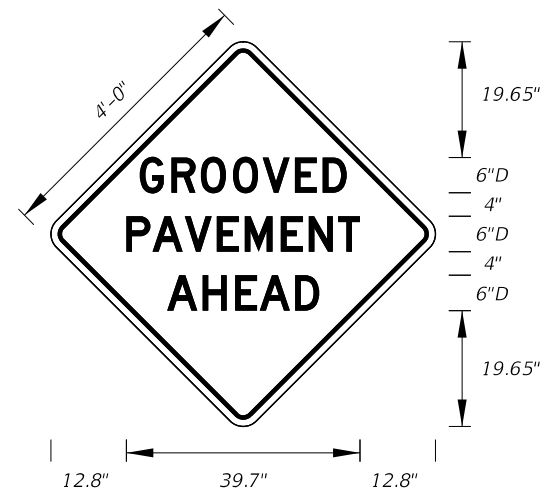


**MOT-15-06**  
4' X 4'  
2" Radii 3/4" Border

6" Series D Legend  
Orange Background  
Black Legend and Border

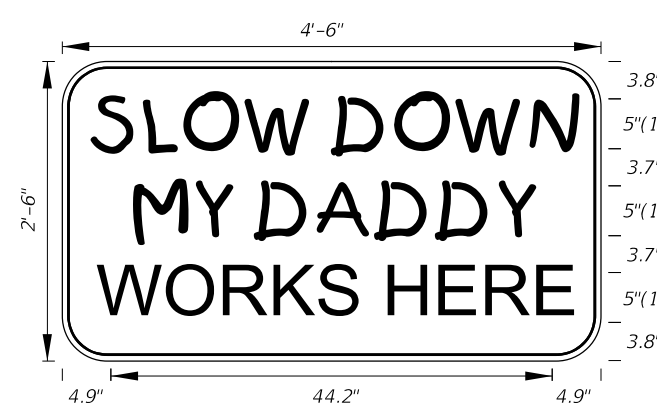


**MOT-16-06**  
4'-6" X 2'-6"  
4" Radii 3/4" Border

5" Kids Series Legend  
Orange Background  
Black Legend and Border

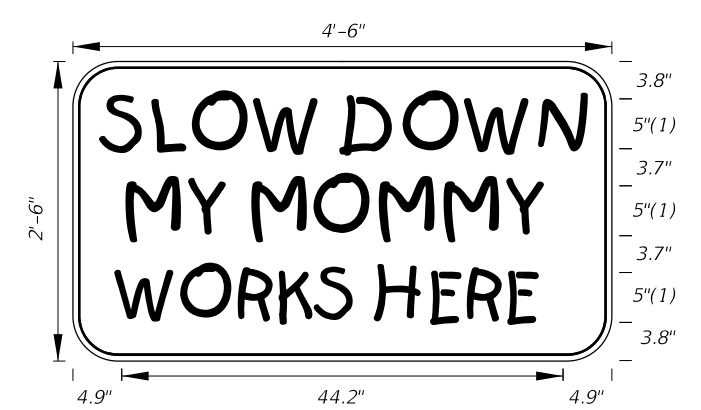


**MOT-17-06**  
4'-6" X 2'-6"  
4" Radii 3/4" Border

5" Kids Series Legend  
Orange Background  
Black Legend and Border

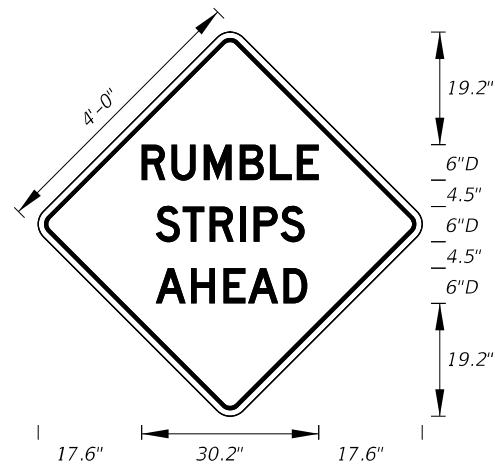


**MOT-18-10**  
4' X 4'  
2" Radii 3/4" Border

6" Series D Legend  
Orange Background  
Black Legend and Border

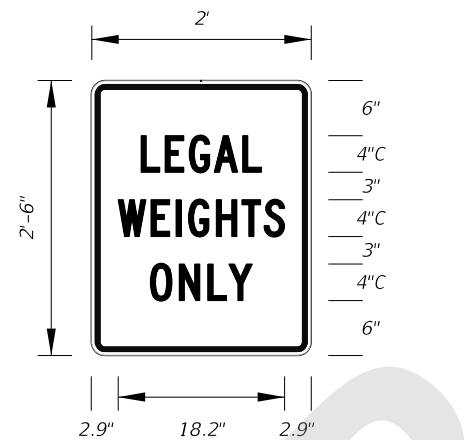


**MOT-19-11**  
2' X 2'-6"  
1.13" Radii 3/4" Border

4" Series C Legend  
White Background  
Red Legend and Border

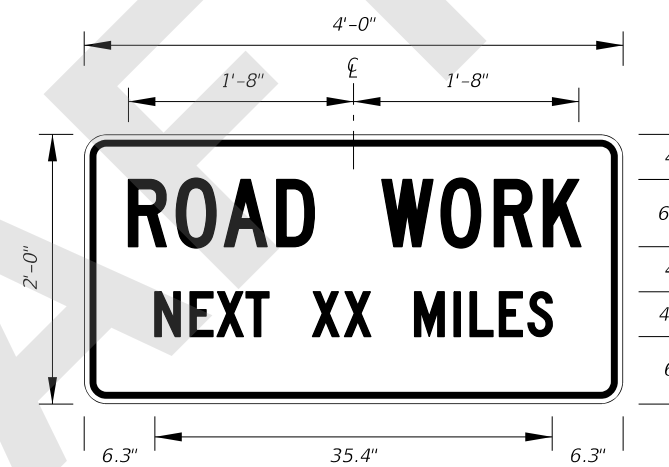

**G20-1**  
2' X 4'  
1.5" Radii 3/4" Border

Orange Background  
Black Legend and Border

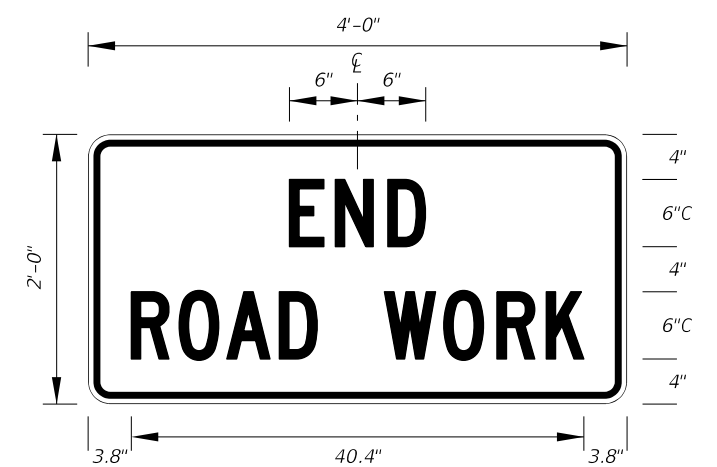

**G20-2**  
2' X 4'  
1.5" Radii 3/4" Border

Orange Background  
Black Legend and Border

8/13/2018 8:27:00 AM

LAST REVISION 11/01/18	REVISION	DESCRIPTION:
---------------------------	----------	--------------