
Index 425-050 Ditch Bottom Inlet Type A

ORIGINATION

Date: 11-1-19

Name: Tim Holley

Phone: 850 414-4117

Email: tim.holley@dot.state.fl.us

COMMENTARY

Reorganized Details and Sheets to declutter Index. Moved information from detail callouts to Notes in order to decrease clutter of the drawing. Moved design information to SPI.

COMMENTS AND RESPONSES

BLACK = Internal Review Comments **RED** = Standard Plans Response

Name: Missy Hollis

Date: 8-10-20

COMMENT: The term used in the Ditch Bottom Inlet indexes referring to either ditch pavement or inlet pavement around the inlet could be confusing, since Specification 524 pertains to ditch pavement. As the concrete surrounding the inlet is to be included in the cost of the inlet, it is recommended to change the term to “concrete apron” in order to differentiate that concrete from the pavement outlined in Specification 524.

RESPONSE: Agreed

Change made to Index: The index was revised to include concrete apron in the place of concrete ditch pavement.

Date: 8-24-2020

Name: Jeffrey Cicerello

Date: 8-21-20

COMMENT: Sheet 3, Detail C: Detail incomplete; Sloped portion of ditch pavement not given. Is this to follow plans or should this be detailed in Standard Plans?

RESPONSE: A depth dimension of 0.1' is shown in Section C-C on Sheet 3.


Change made to Index: Another dimension was added to the other side of Section C-C for clarity.

Date: 8-24-20

GENERAL NOTES:

1. Work this Index with Index 425-001 and Index 425-010.
2. All reinforcing is Grade 60 bars with 2" minimum cover unless otherwise noted. Cut or bend bars out of way of pipe to clear pipe by 1½". See Index 425-001 for equivalent area of welded wire fabric.
2. Chamfer all exposed edges and corners ¾" or tooled to ¼" radius.
4. All dimensions are for both precast and cast-in-place inlets unless otherwise noted.
5. Quantities are for informational and estimating purposes only.





TABLE OF CONTENTS:	
Sheet	Description
1	General Notes and Contents
2	Dimensional, Reinforcement, and Steel Grate Details
3	Concrete Apron and Sodded Area Details
4	Alternate A Structure Bottom - Top Slab Details

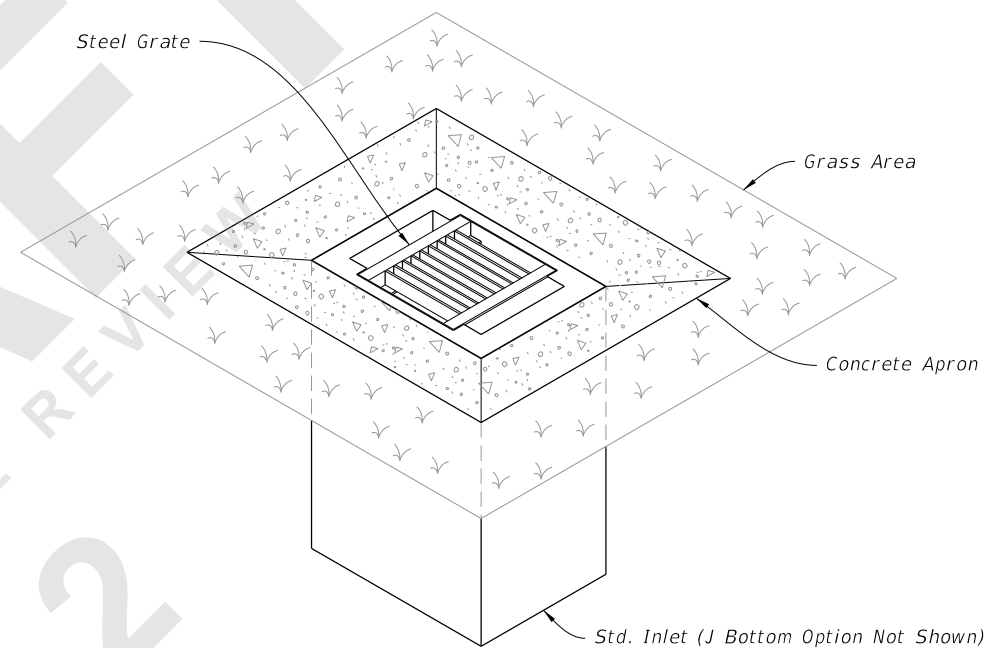

DITCH BOTTOM INLET TYPE A

(Pipe Opening Not Shown)

8/27/2020 2:04:33 PM

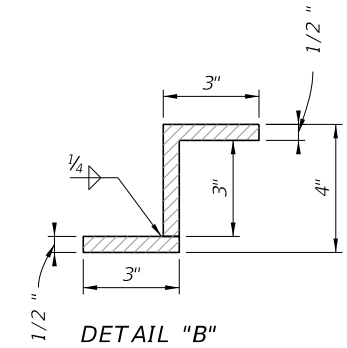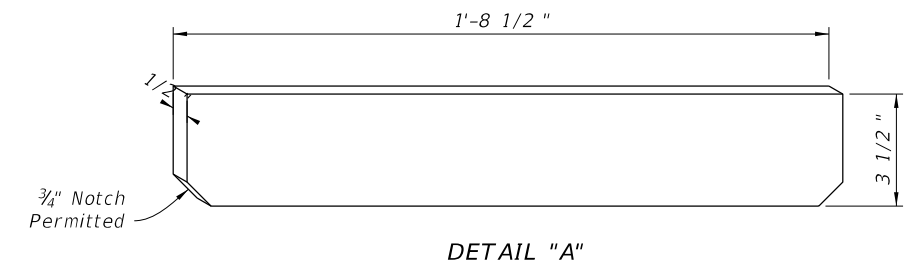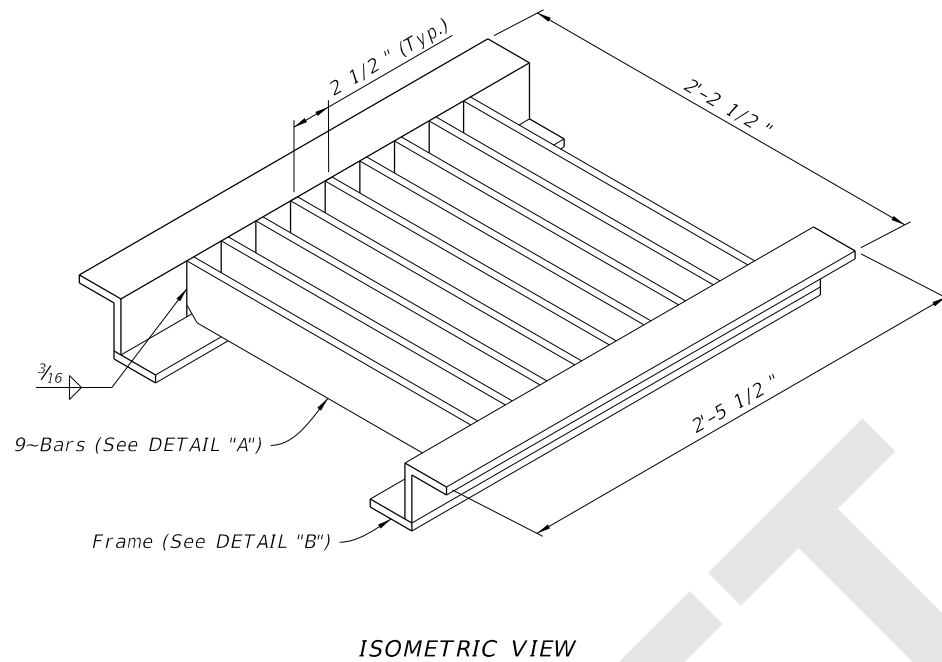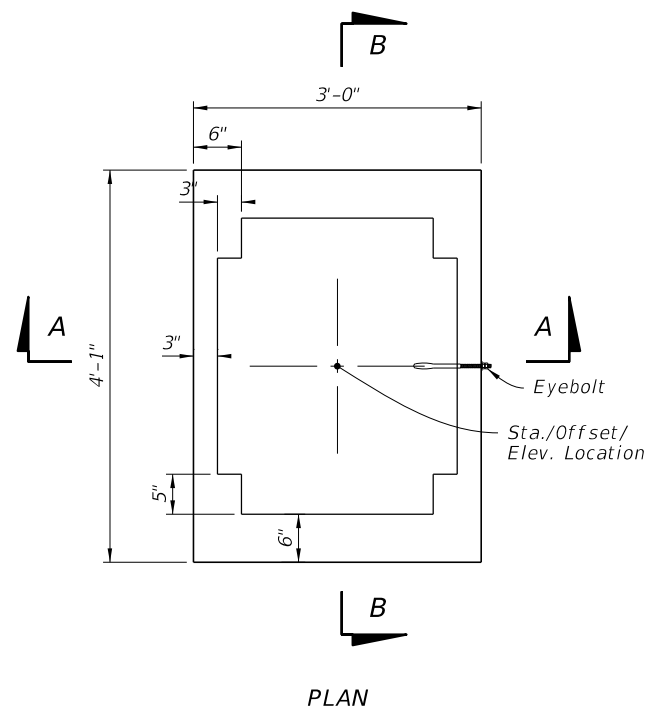

STEEL GRATE DETAILS

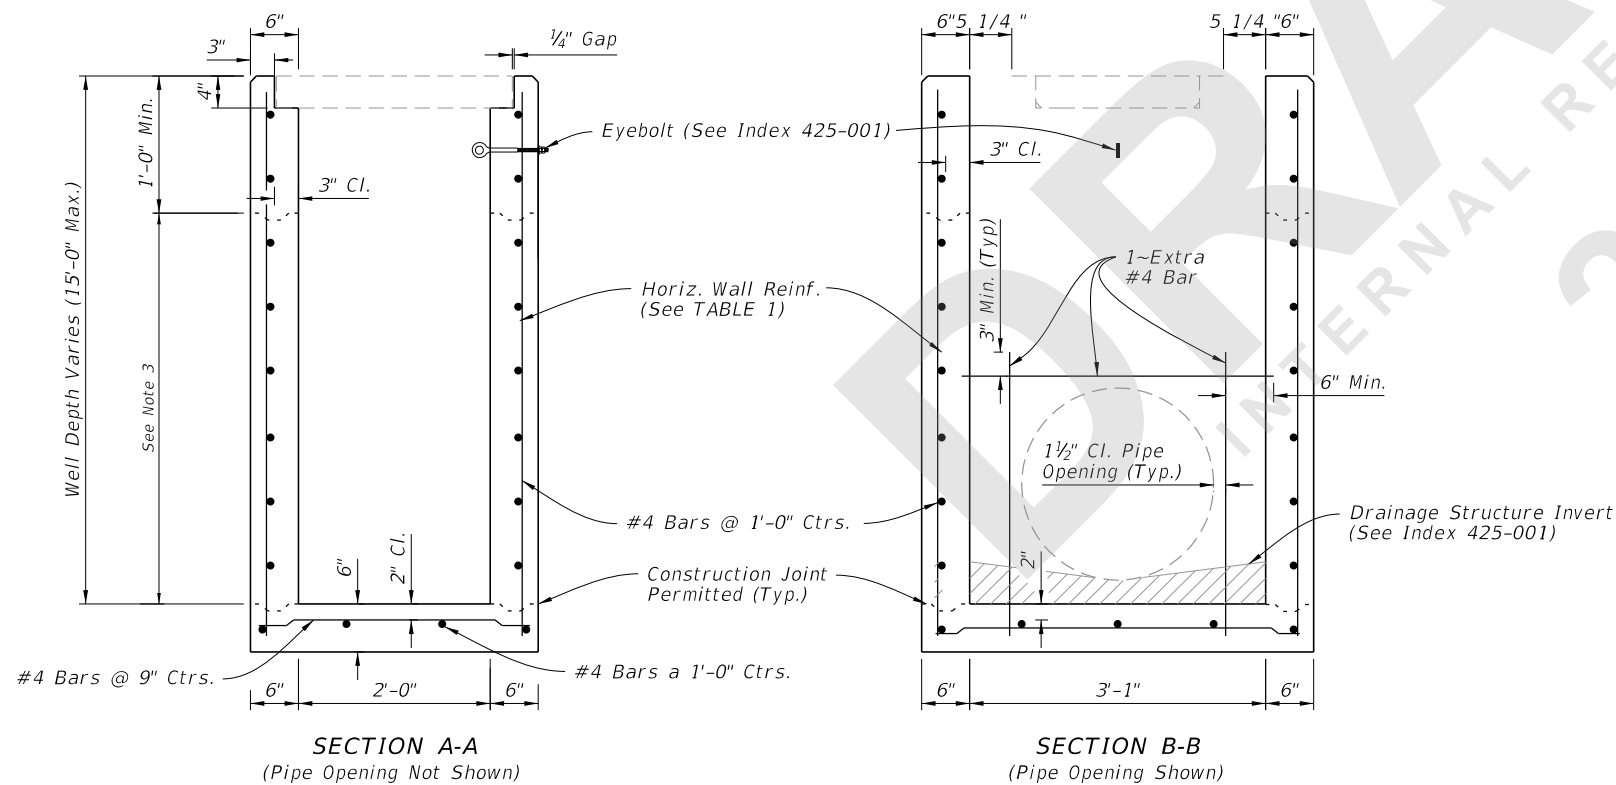


TABLE 1
HORIZONTAL WALL REINFORCING SCHEDULE

WALL DEPTH	SCHEDULE	AREA (in. ² /ft.)	MAX. SPACING	
			BARS	WWR
0' - 10'	A12	0.20	12"	8"
10' - 15'	A6	0.20	6"	5"

NOTES:

1. Plan View: The Steel Grate, Concrete Ditch Pavement, and Sod are not shown.
2. See Sheet 3 for Concrete Ditch Pavement and Sodded Area details.
3. Construction joints permitted between these limits. See Index 425-001 for minimum dimensions.

DIMENSIONAL AND REINFORCEMENT DETAILS

DIMENSIONAL, REINFORCEMENT, AND STEEL GRATE DETAILS

8/27/2020 2:04:35 PM

LAST REVISION 11/01/20	DESCRIPTION:
---------------------------	--------------







FY 2021-22
STANDARD PLANS

DITCH BOTTOM INLET TYPE A

INDEX
425-050

SHEET
2 of 4

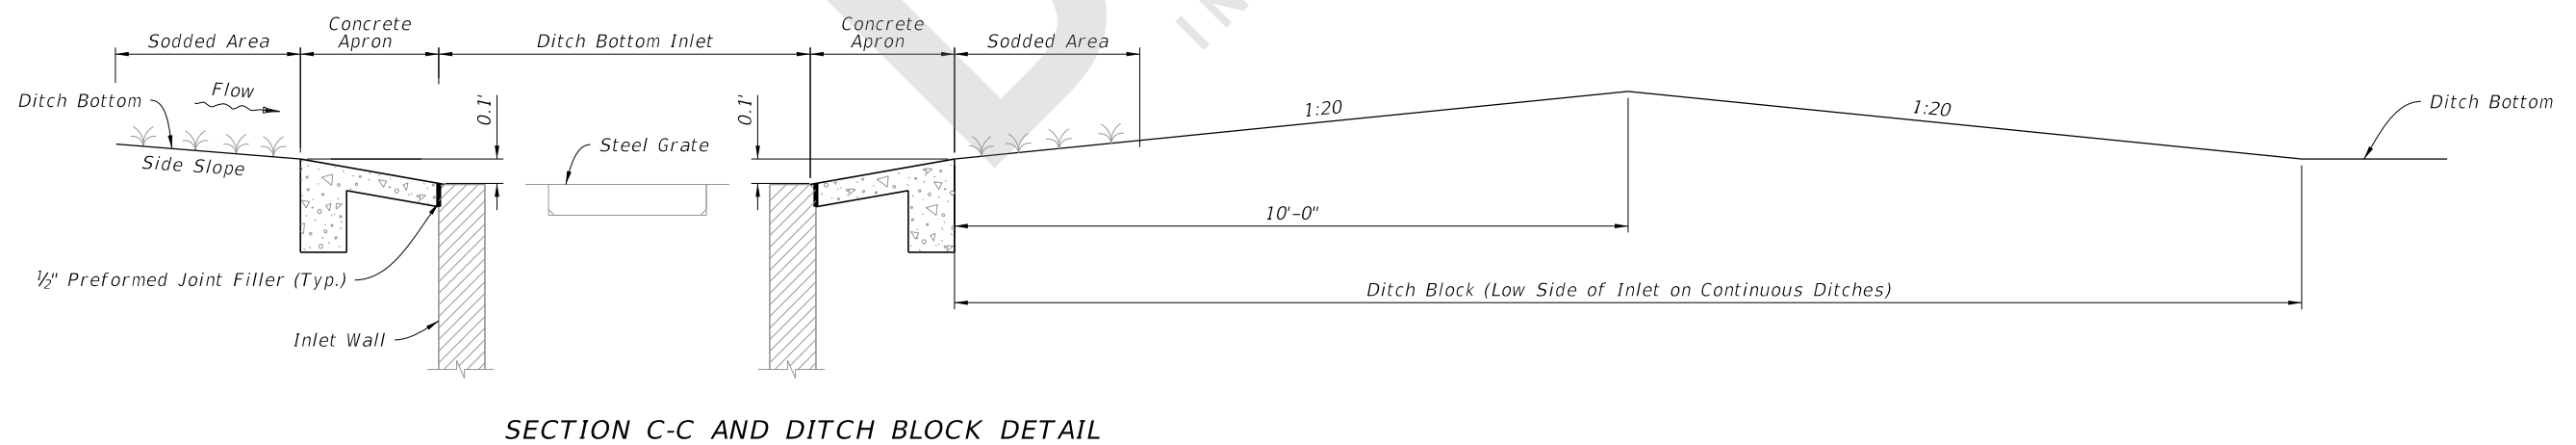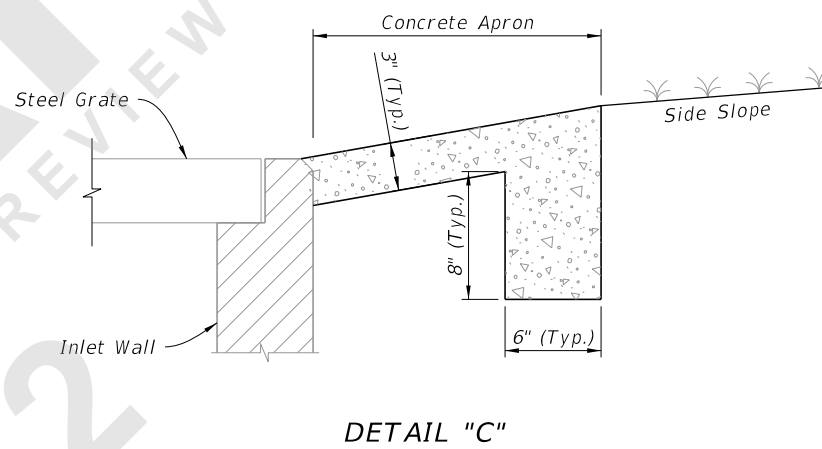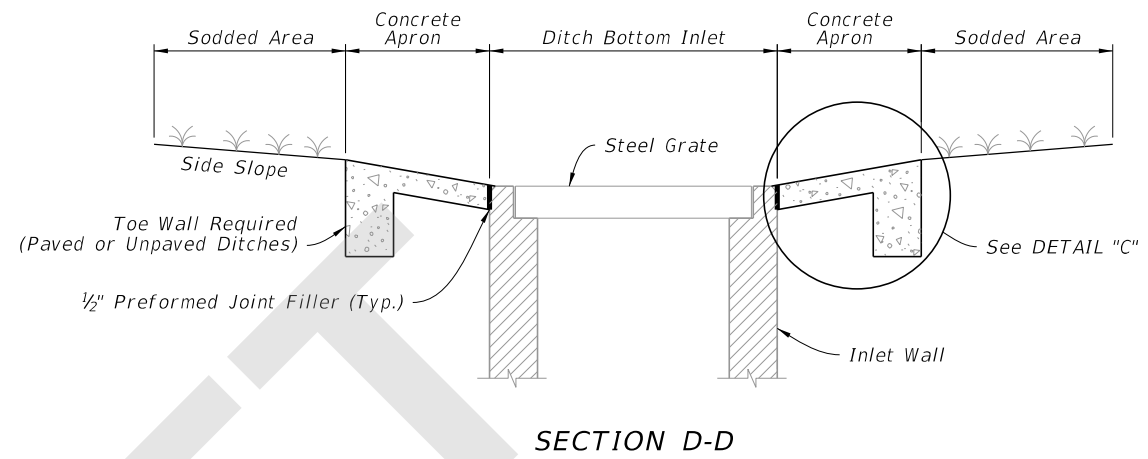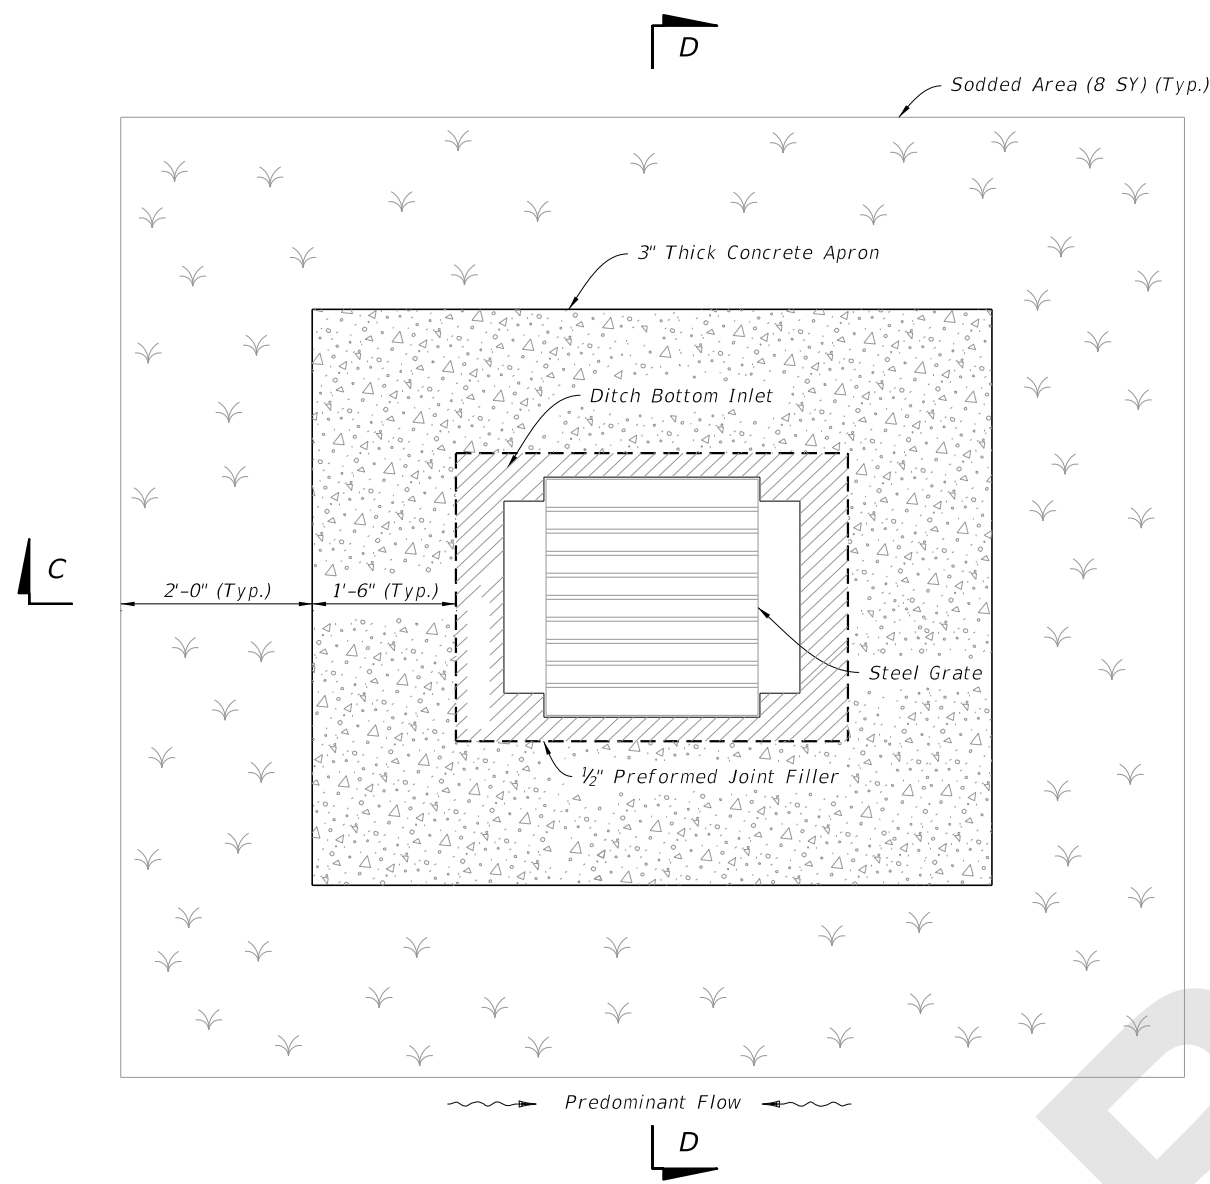

CONCRETE APRON AND SODDED AREA DETAILS

8/27/2020 2:04:41 PM

LAST REVISION 11/01/20

REVISION

DESCRIPTION:




FY 2021-22
STANDARD PLANS

DITCH BOTTOM INLET TYPE A

INDEX
425-050

SHEET
3 of 4

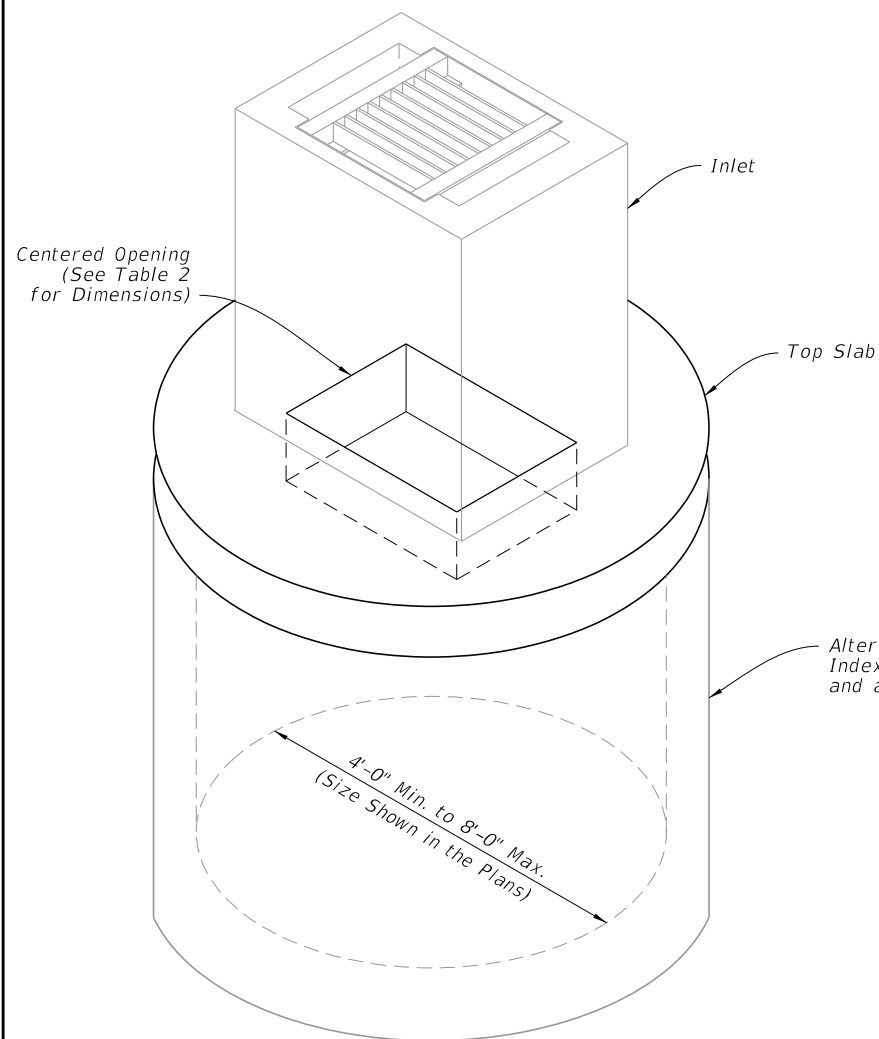

Centered Opening
(See Table 2
for Dimensions)

Inlet

Top Slab

Alternate A Structure Bottom (See
Index 425-010 for Alternate B
and additional details)

4'-0" Min. to 8'-0" Max.
(Size Shown in the Plans)

BOTTOM STRUCTURE DIAMETER	OPENING SIZE	
	Min.	Max.
4'-0" to 8'-0"	2'-0" x 3'-1"	--

2 Way Reinforcement
(See Tables 3 & 4)

E

E


Centered Opening
(See Table 2
for Dimensions)

#4 Bar Each Corner
(2'-0" Min. Length)

#8 Bars

#5 Hoop Bar
(Peripheral Reinforcement)

PLAN

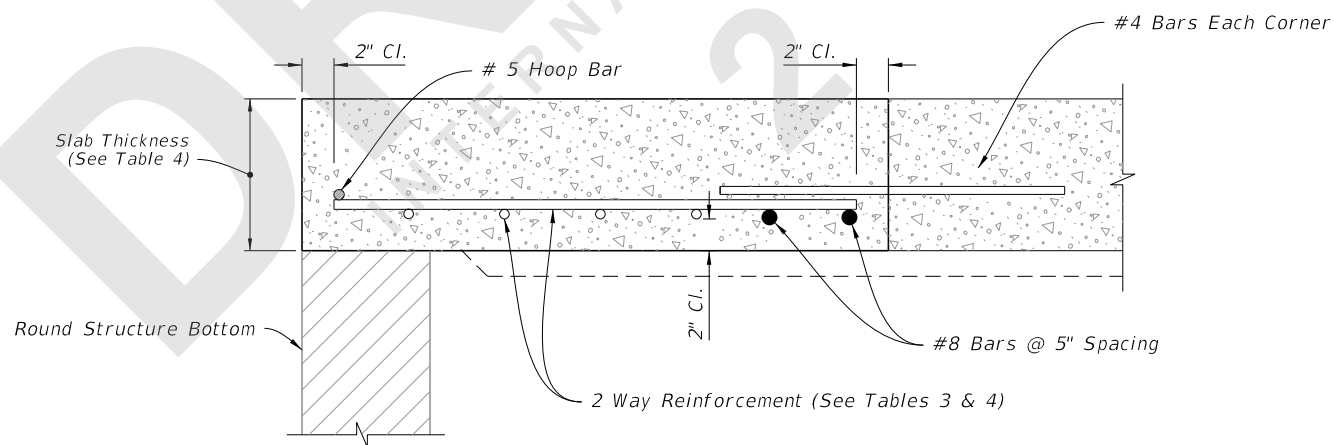

SECTION E-E

Round Structure Bottom

Slab Thickness
(See Table 4)

2" Cl.

5 Hoop Bar

2" Cl.

#4 Bars Each Corner

#8 Bars @ 5" Spacing

2 Way Reinforcement (See Tables 3 & 4)

SCHEDULE	GRADE 60 (BAR) OR 65 KSI & 70 KSI (WIRE FABRIC) In. ² /ft.
A	0.20
B	0.24
C	0.37
D	0.53
E	0.73
F	1.06
G	1.45

STRUCTURE DEPTH	SLAB THICKNESS	REINFORCING (2 WAY) SCHEDULE
SIZE: 4'-0"		
≥0.5'-40'	9½"	C
SIZE: 5'-0"		
≥0.5'<30'	9½"	C
30'-40'	9½"	D
SIZE: 6'-0"		
0.5'<8'	9½"	B
8'<18'	9½"	C
18'<30'	9½"	D
30'<37'	9½"	E
37'-40'	9½"	G
SIZE: 8'-0"		
≥0.5'<9'	11½"	C
9'<15'	11½"	D
15'<23'	11½"	E
23'<33'	11½"	E
33'-40'	11½"	G

ISOMETRIC VIEW

TOP SLAB REINFORCEMENT DETAILS

ALTERNATE A STRUCTURE BOTTOM - TOP SLAB DETAILS

8/27/2020 2:04:43 PM

LAST REVISION	DESCRIPTION:
11/01/20	



FY 2021-22
STANDARD PLANS

DITCH BOTTOM INLET TYPE A

INDEX
425-050

SHEET
4 of 4