

---

---

## Index 700-110 Mounting Exit Number Panels To Signs

### **ORIGINATION**

**Date:** March 23, 2023

**Name:** Joshua Turley

**Phone:** (850) 414-4475

**Email:** Joshua.Turley@dot.state.fl.us

### **COMMENTARY**

This Standard was modified around 2018 and a callout was not copied over as required. We added the missing callout and made some minor callout changes for clarity.

### **COMMENTS AND RESPONSES**

**BLACK** = Industry Review Comments    **BLUE** = Standard Plans Response    **GREEN** = Change Made to Index

**Name:** Keith Krieger

**Date:** 6/19/2023

**COMMENT:** The note that was added for the "Side Elevation" should read "Multi-Column Ground Sign"....the word "Sign" is missing.


**RESPONSE:** Thanks for the comment. This has been fixed.

**CHANGE MADE TO INDEX:** Yes, updated the callout.


*Response Date: 6/19/2023*

**GENERAL NOTES:**

1. Meet the requirements of Specification 700.
2. Work with Indexes 700-020 and 700-030.
3. Fabrication:  
See sign layout sheet for dimension "L" and sign face details in the Plans.
4. For right exits, install the Exit Numbering Panel to the top right side of the Highway Sign.
5. For left exits, install the Exit Numbering Panel to the top left side of the Highway Sign.

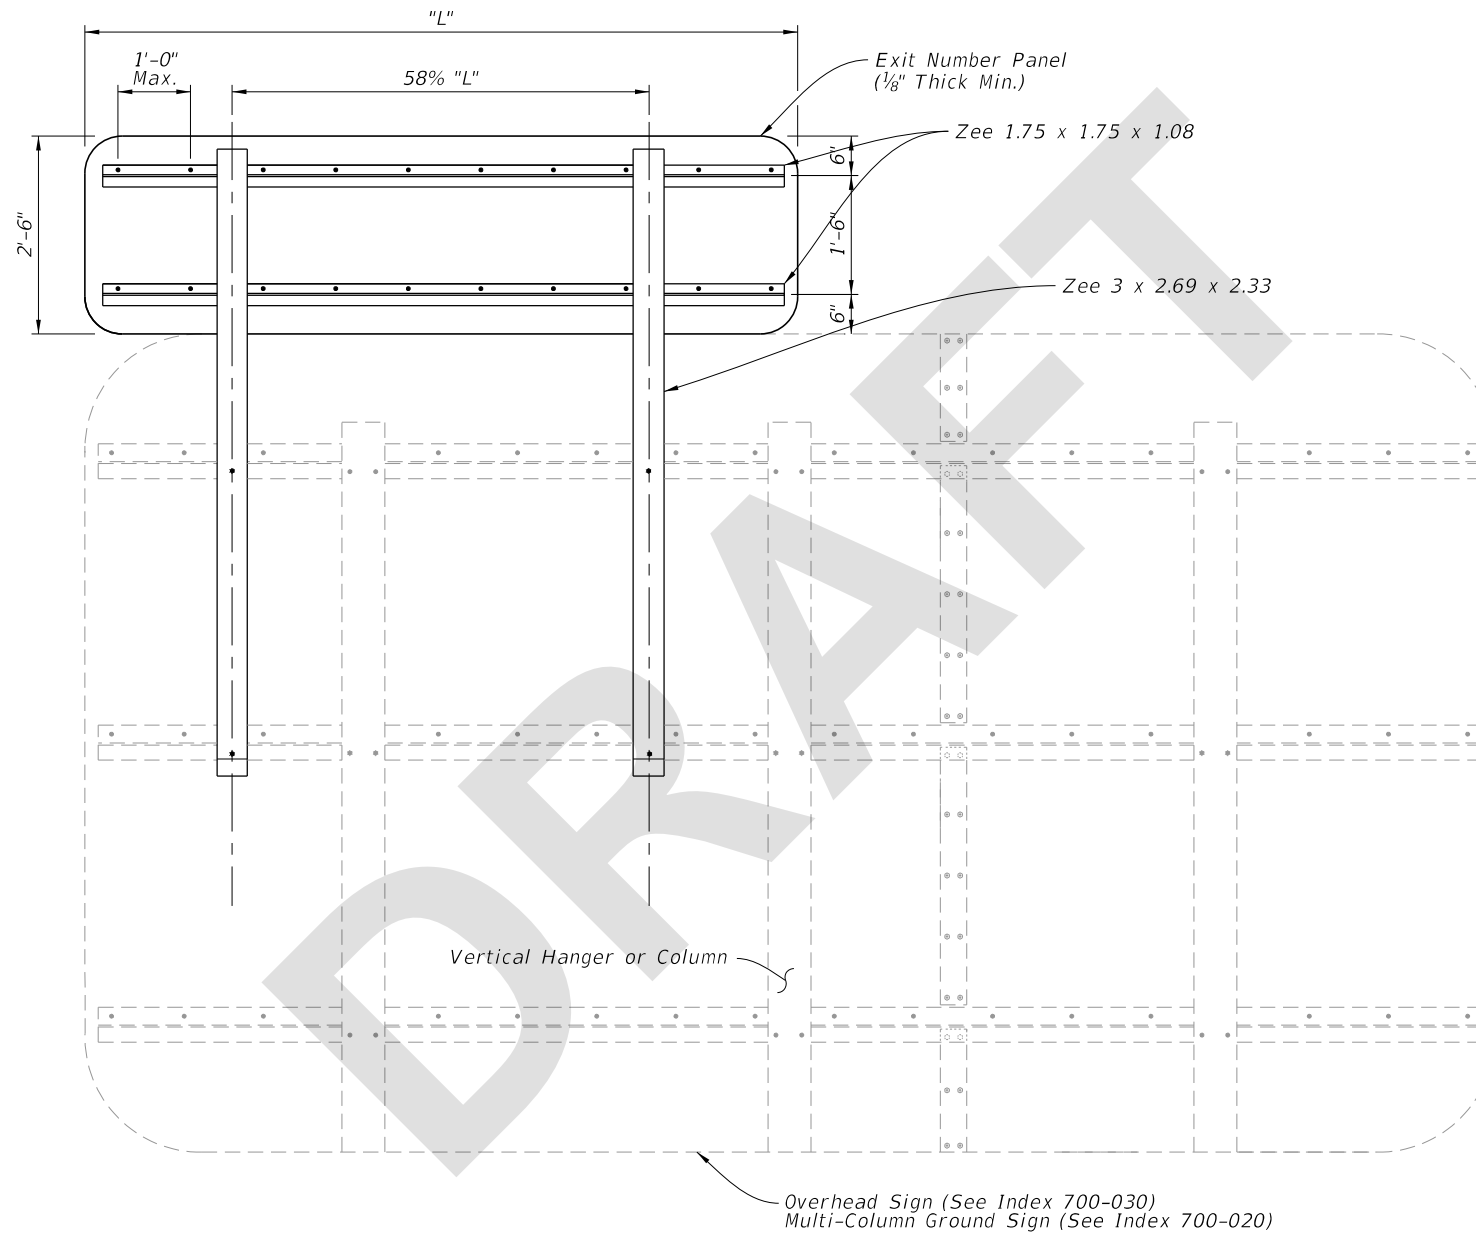

BACK ELEVATION

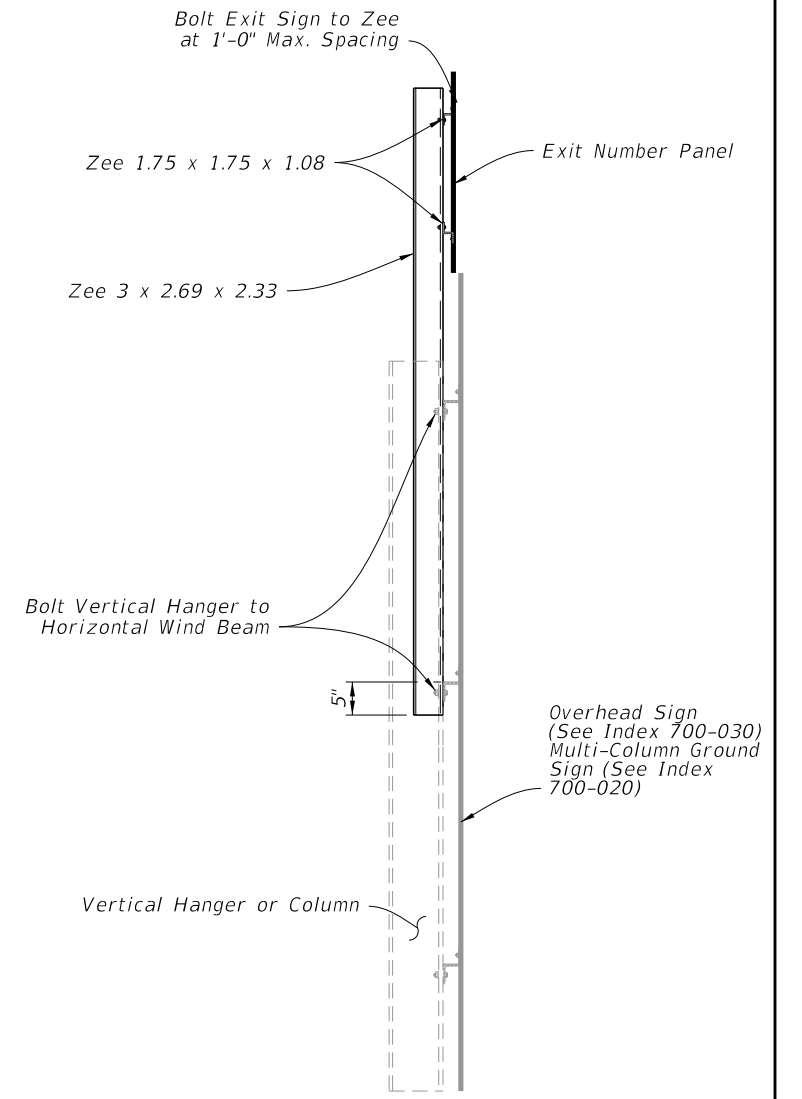

SIDE ELEVATION

6/22/2023 7:10:33 AM

LAST REVISION 11/01/23	REVISION	DESCRIPTION:	 FY 2024-25 STANDARD PLANS	MOUNTING EXIT NUMBER PANELS TO SIGNS	INDEX 700-110	SHEET 1 of 1
---------------------------	----------	--------------	---	--------------------------------------	------------------	-----------------