

Origination Form

Proposed Revisions to a Standard Plans Index

| | | | |
|--------------------|----------------------------|-------------------------|---|
| Originator: | Gibbs, Shae | Index Number: | 546-020 |
| Date: | 6/18/2024 | Sheet Number(s): | 2 |
| E-mail: | Shae.Gibbs@dot.state.fl.us | Index Title: | Groud-In Rumble Strips - Arterials and Collectors |

Summary of the changes:

Sheet 2: Deleted Outside Shoulder with Buffered Bike Lane detail



Commentary/Background:

This is a non standard situation. Buffered Bike Lanes are generally used on roadways 45mph or less and rumble strips are intended for roadways 50mph or greater.


| Other Affected Documents/Offices | Person Contacted | Affected (Yes/No) |
|----------------------------------|------------------|-------------------|
| Other Standard Plans | | No |
| FDOT Design Manual | | No |
| Standard Specifications | | No |
| Basis of Estimates Manual | | No |
| Approved Product List | | No |
| Construction Office | | No |
| Maintenance Office | | No |

Implementation


["FY-Standard Plans (Next Release)"]

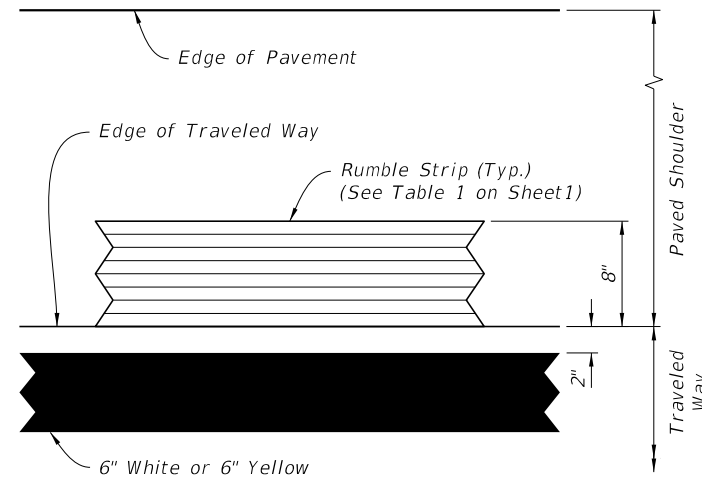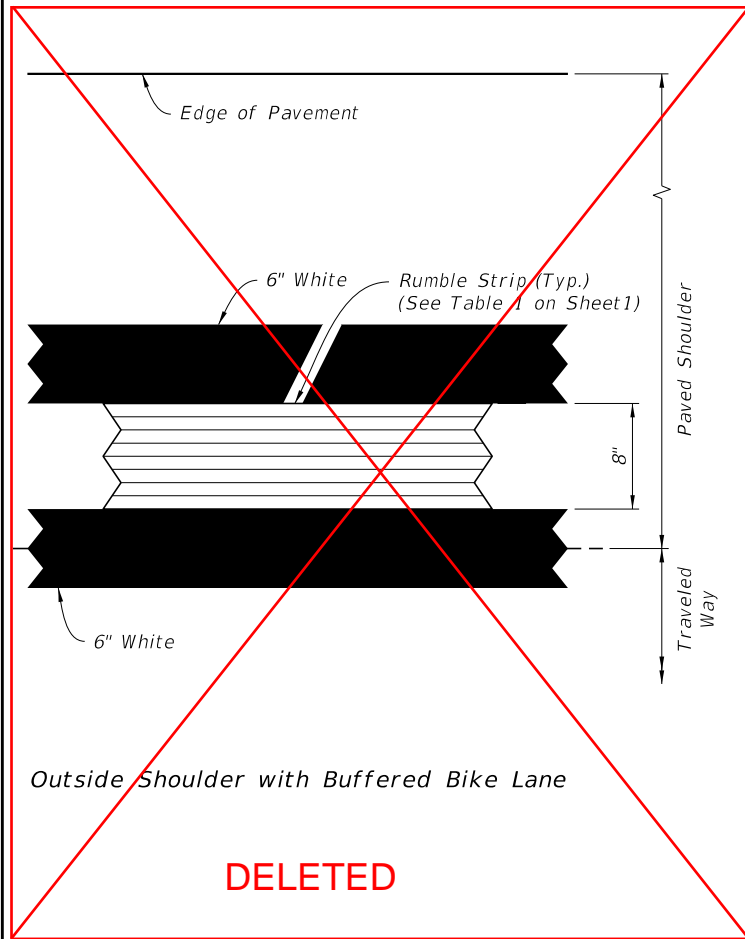

Outside Paved Shoulder Width
Greater Than or Equal to 5'-0"
or
Inside Paved Shoulder Width
Greater Than or Equal to 1'-0"

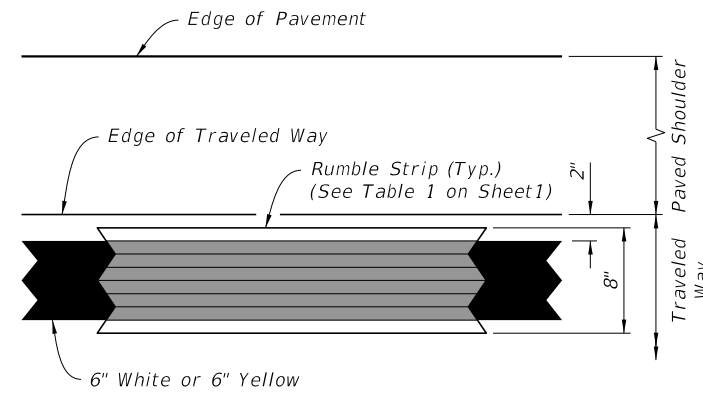


Outside Paved Shoulder Width
Greater Than 0'-0" and Less Than 5'-0"
or
Inside Paved Shoulder Width
Greater Than 0'-0" and Less Than 1'-0"

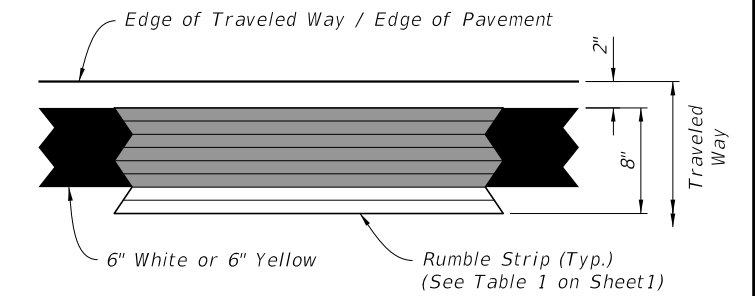


Outside or Inside Paved Shoulder Width Equal to 0'-0"


EDGE LINE AND SHOULDER RUMBLE STRIP PLACEMENT
(Plan View)

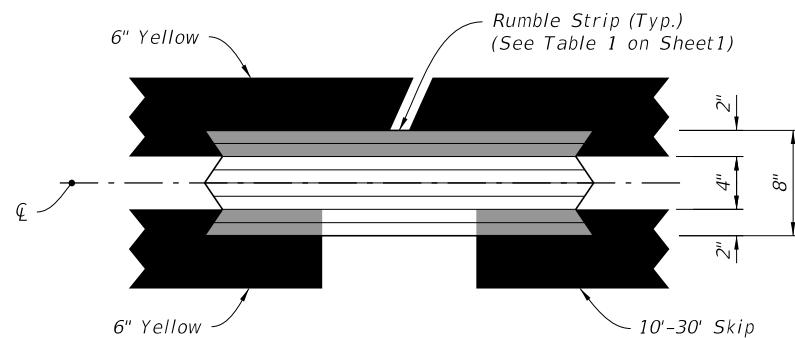

ONE-DIRECTION PASSING CENTERLINE

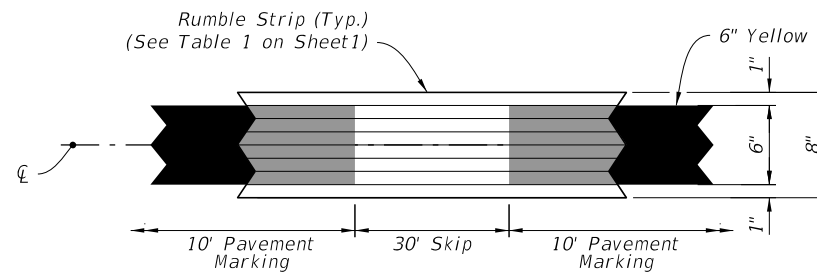

TWO-DIRECTION PASSING CENTERLINE

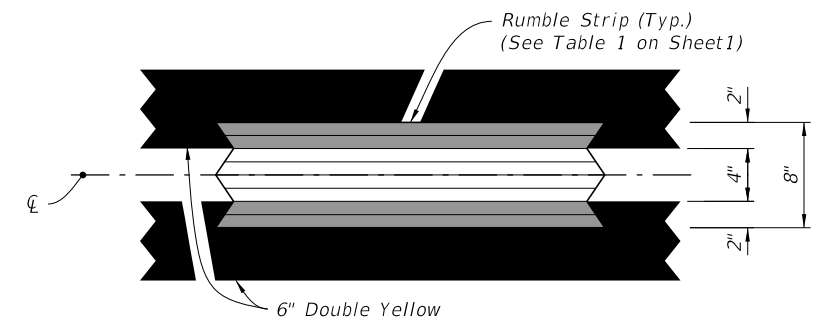

TWO-DIRECTION NO-PASSING CENTERLINE

CENTERLINE RUMBLE STRIP PLACEMENT
(Plan View)

10/3/2023 1:50:32 PM


| | |
|---------------------------------|--------------|
| LAST REVISION | DESCRIPTION: |
| 11/01/22 11/01/24 | |

2025-26


~~FY 2024-25~~
STANDARD PLANS

GROUND-IN RUMBLE STRIPS -
ARTERIALS AND COLLECTORS


| | |
|---------|--------|
| INDEX | SHEET |
| 546-020 | 2 of 2 |

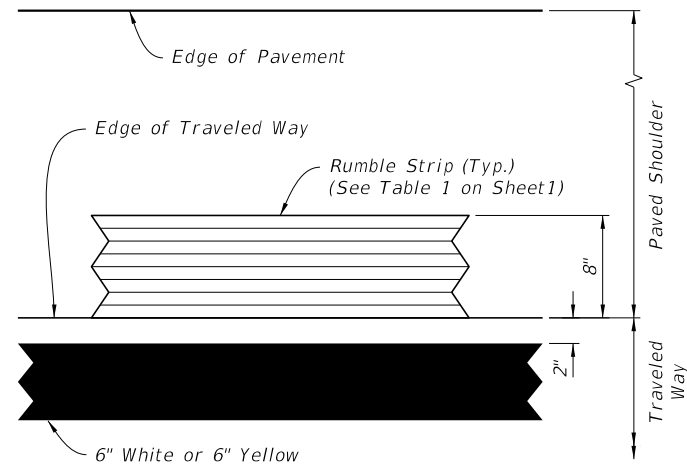

Outside Paved Shoulder Width
Greater Than or Equal to 5'-0"
or
Inside Paved Shoulder Width
Greater Than or Equal to 1'-0"

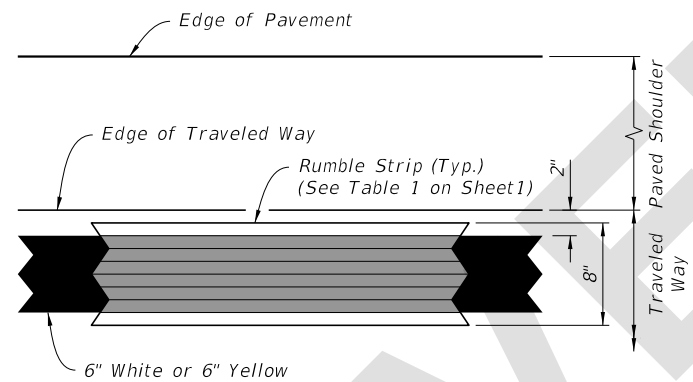


Outside Paved Shoulder Width
Greater Than 0'-0" and Less Than 5'-0"
or
Inside Paved Shoulder Width
Greater Than 0'-0" and Less Than 1'-0"

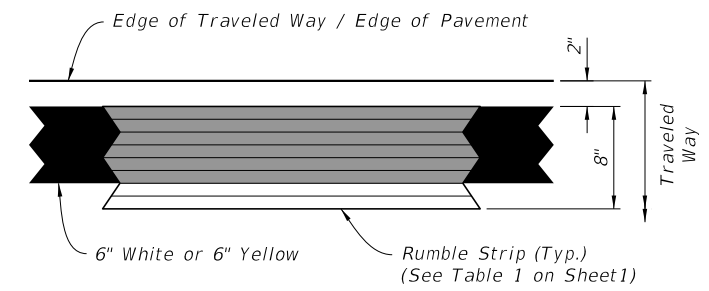


Outside or Inside Paved Shoulder Width Equal to 0'-0"


EDGE LINE AND SHOULDER RUMBLE STRIP PLACEMENT
(Plan View)

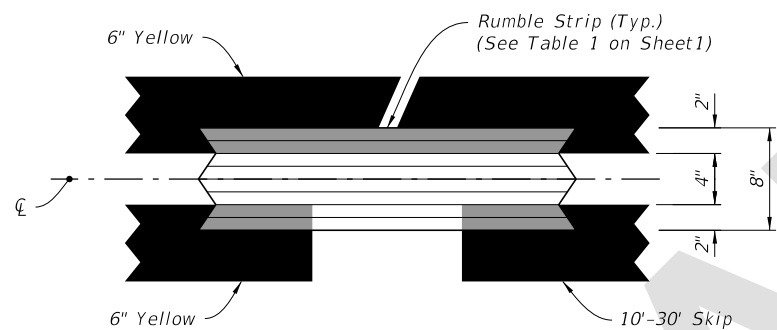

ONE-DIRECTION PASSING CENTERLINE

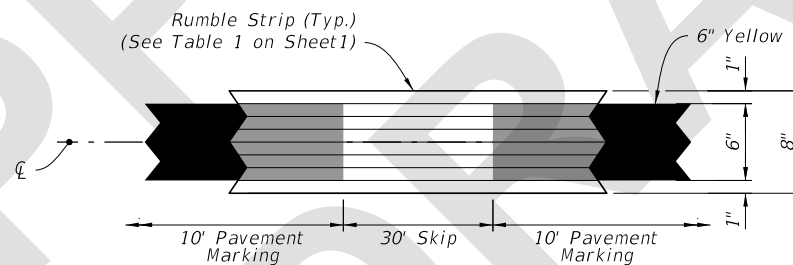

TWO-DIRECTION PASSING CENTERLINE

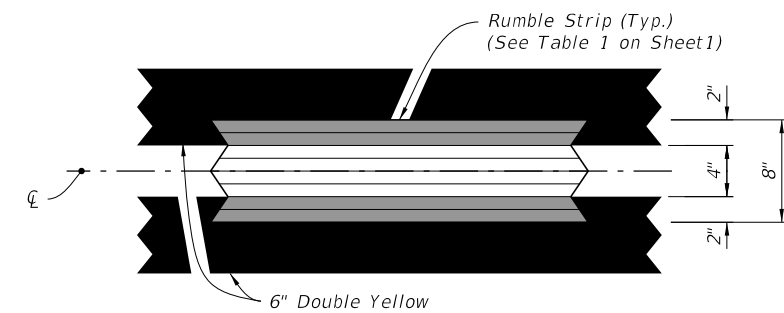

TWO-DIRECTION NO-PASSING CENTERLINE

CENTERLINE RUMBLE STRIP PLACEMENT
(Plan View)

10:53:48 AM
6/18/2024

| | | | | | | | |
|---------------------------|----------|--------------|---|------------------------------|---|------------------|-----------------|
| LAST REVISION 11/01/24 | REVISION | DESCRIPTION: |  | FY 2025-26 STANDARD PLANS | GROUND-IN RUMBLE STRIPS - ARTERIALS AND COLLECTORS | INDEX 546-020 | SHEET 2 of 2 |
|---------------------------|----------|--------------|---|------------------------------|---|------------------|-----------------|