

# Origination Form

## Proposed Revisions to a Standard Plans Index

<b>Originator:</b>	Portal, Benazir	<b>Index Number:</b>	700-102
<b>Date:</b>	7/22/2024	<b>Sheet Number(s):</b>	6, 8, 9, 10, and 12
<b>E-mail:</b>	Benazir.Portal@dot.state.fl.us	<b>Index Title:</b>	SPECIAL SIGN DETAILS

### Summary of the changes:

Sheet 6: Added FTP-45-25

Sheet 8: Updated the width of FTP-73-06 to 6'-6"; Updated FTP-68A-06 and FTP-68B-06 symbology, spacing, and MUTCD reference

Sheet 9: Updated the width of FTP-74-06, FTP-75-06, and FTP 76-06 to 6'-6"

Sheet 10: Added FTP-100-25

Sheet 12: Deleted MOT-20-21, MOT-22-21, MOT-24-21, MOT-25-21, MOT-26A-22, and MOT-26B-22; Added MOT-27-25

Sheet 6-12: Shifted Signs to accommodate new signs

### Commentary/Background:

The 11th edition of the MUTCD now includes Work Zone Bike Warning Signs, which means some MOT signs shown in Index 700-102 can be deleted. Additionally, the 11th edition of the MUTCD includes Temporary Traffic Control Typical Applications for Work in the Vicinity of Bicycle Lanes and Shared Use Paths, which specify what warning signs need to be used and where they should be placed. Consequently, the "BIKE LANE CLOSED AHEAD" plaques (MOT-24-21, MOT-25-21) will no longer be used.

The depictions of FTP-68A-06 and FTP-68B-06 are being updated to more closely depict R10-3f and R10-3i in the MUTCD 11th Edition.

Other Affected Documents/Offices	Person Contacted	Affected (Yes/No)
Other Standard Plans		No
FDOT Design Manual		No
Standard Specifications		No
Basis of Estimates Manual		No
Approved Product List		No
Construction Office		No
Maintenance Office		No


---

## Implementation


["FY-Standard Plans (Next Release)"]




**FTP-41-21**  
2'-6" X 3'  
4" Radii 3/4" Border  
2" and 4" Series C Legend  
White Background  
Black Legend and Border

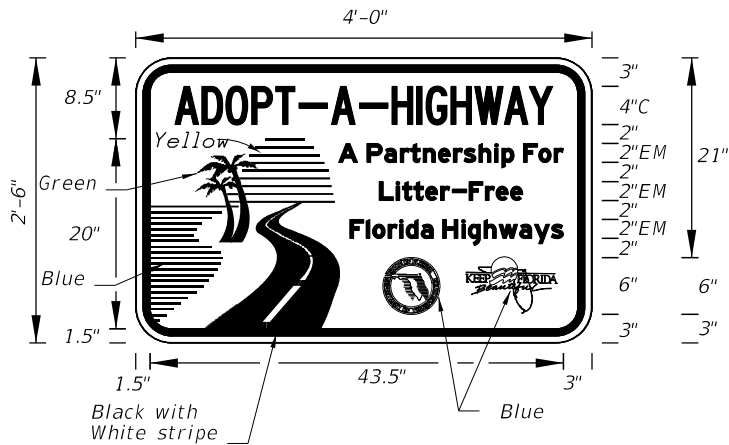

**FTP-42-06**  
4' X 2'-6"  
3" Radii  
Top 4" Series C Legend  
Bottom 2" Series EM Legend  
White Background  
Blue Legend and Border

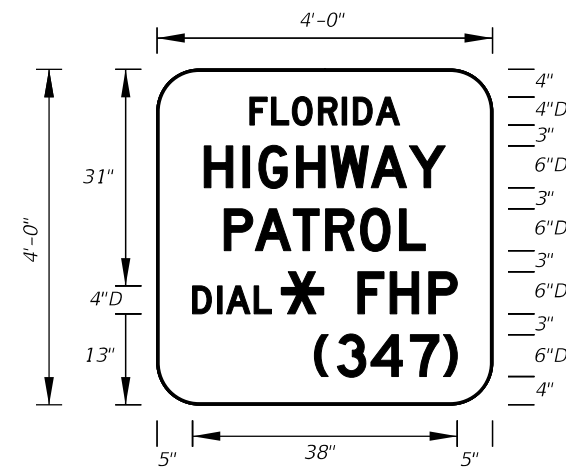


**FTP-43-06**  
4' X 4'  
6" Radii 1" Border  
Top 4" Series D Legend  
Bottom 6" Series D Legend  
Blue Background  
White Legend and Border

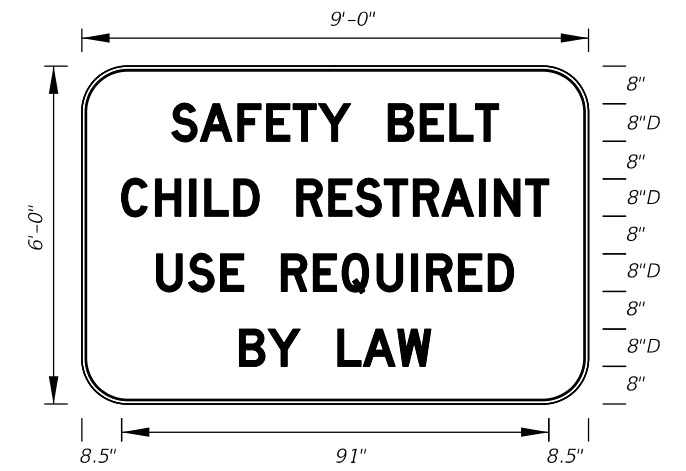



**FTP-44-06**  
9' X 6'  
9" Radii 3/4" Border  
8" Series D Legend  
White Background  
Black Legend and Border




**FTP-44A-25**  
~~FTP-45-06~~  
4' X 3'  
5" Radii 3/4" Border  
4" Series C Legend  
White Background  
Black Legend and Border

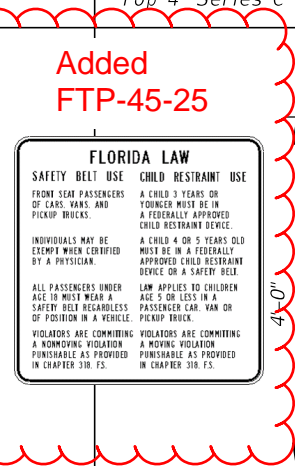


**FTP-45-25**  
3' X 4'  
5" Radii 3/4" Border  
3" Series D Legend  
White Background  
Green Florida Symbol  
Black Legend, Border and Man Belt Symbol

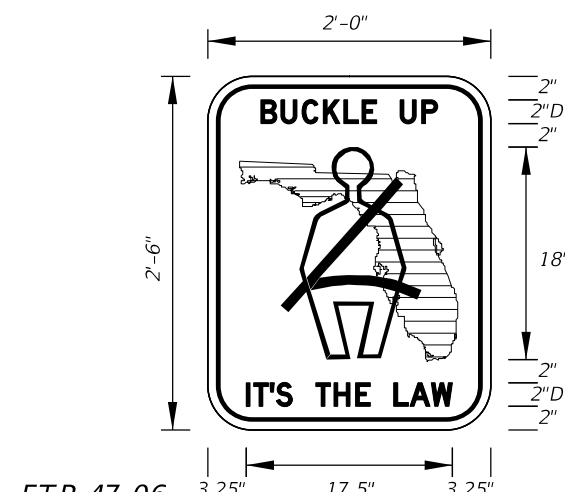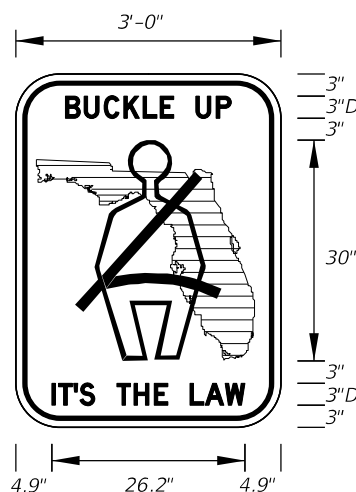


**FTP-47-06**  
2' X 2'-6"  
3" Radii 5/8" Border  
2" Series D Legend  
White Background  
Green Florida Symbol  
Black Legend, Border and Man Belt Symbol

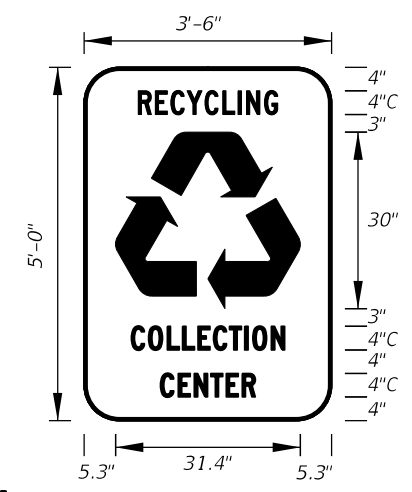

**FTP-48-06**  
3'-6" X 5'  
6" Radii  
4" Series C Legend  
Green Background  
White Legend, Border and Symbol  
**MOVED to Sheet 7**

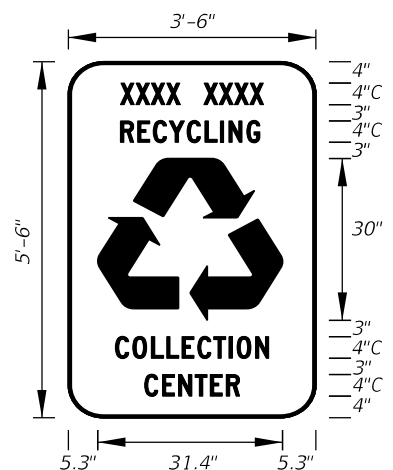


**FTP-49-06**  
3'-6" X 5'-6"  
6" Radii  
4" Series C Legend  
Green Background  
Municipality Name Optional  
White Legend, Border and Symbol

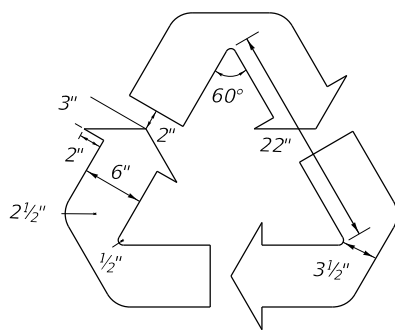

Detail for **FTP-48-06** and **FTP-49-06**




**FTP-50-06**  
4'-6" X 2'  
3" Radii 3/4" Border  
4" Series C Legend  
Yellow Background  
Black Legend and Border

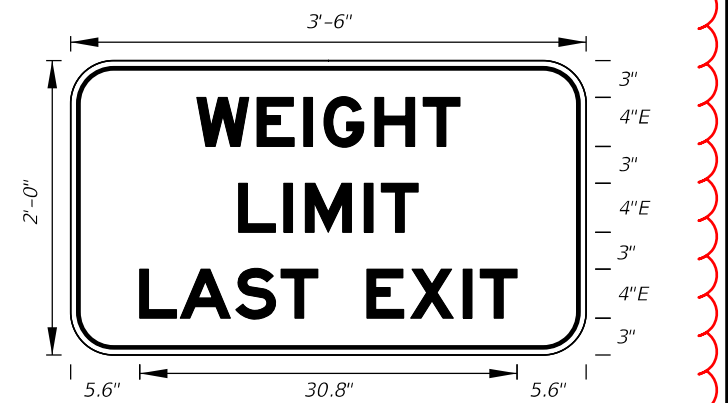


**FTP-51-06**  
3' X 2'  
3" Radii 3/4" Border  
4" Series E Legend  
White Background  
Black Legend and Border

10/3/2023 3:09:30 PM


LAST REVISION	DESCRIPTION:
11/01/21	
11/01/24	

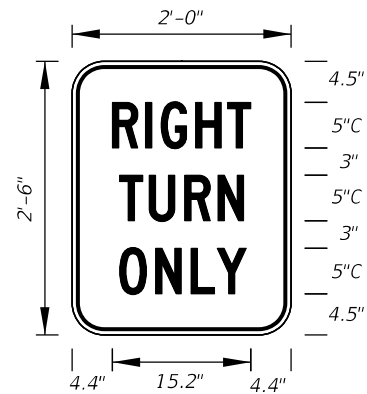


**FTP-52-06**  
2' X 2'-6"  
3" Radii 5/8" Border  
5" Series C Legend  
White Background  
Black Legend and Border

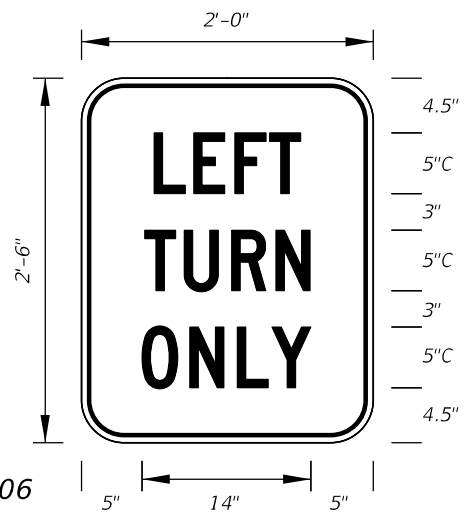


**FTP-53-06**  
2' X 2'-6"  
3" Radii 5/8" Border  
5" Series C Legend  
White Background  
Black Legend and Border

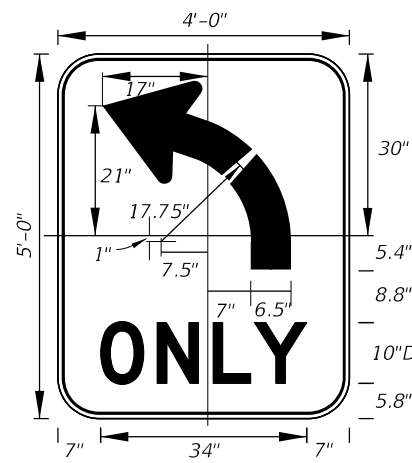


**FTP-54L-06**  
4' X 5'  
6" Radii 3/4" Border  
10" Series D Legend  
White Background  
Black Legend and Border  
FTP-54R-06 for  
(Right Turn Arrow)

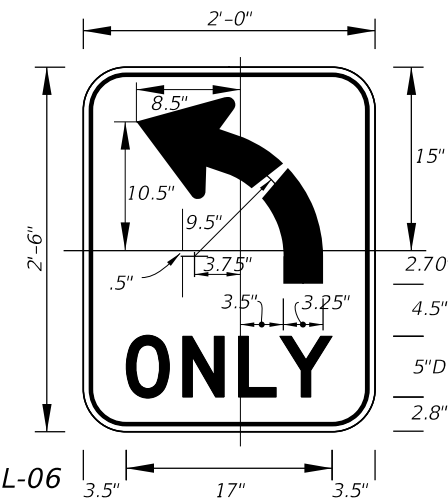


**FTP-55L-06**  
2' X 2'-6"  
3.5" Radii 3/8" Border  
5" Series D Legend  
White Background  
Black Legend and Border  
FTP-55R-06 for  
(Right Turn Arrow)

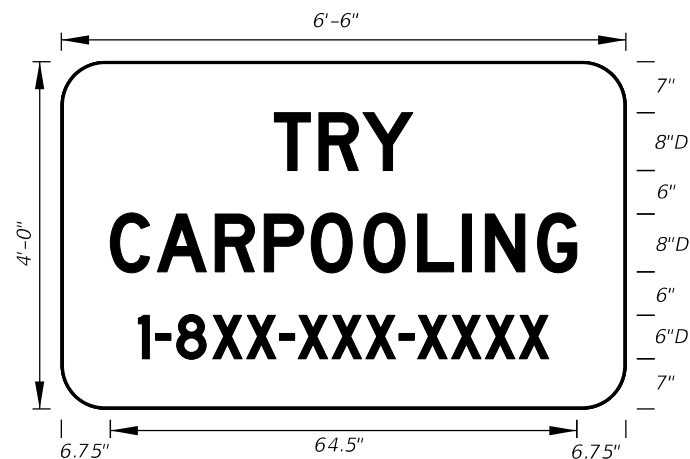


**FTP-56-06**  
6'-6" X 4'  
6" Radii 3/4" Border  
8" and 6" Series D Legend  
Blue Background  
White Legend and Border  
Design Project Manager  
or Transit Administrator  
will supply correct 1-8XX  
number.

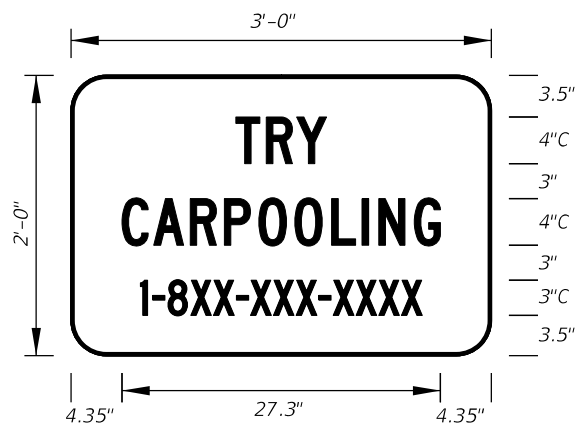


**FTP-56A-06**  
3' X 2'  
3" Radii  
4" and 3" Series C Legend  
Blue Background  
White Legend and Border  
Design Project Manager  
or Transit Administrator  
will supply correct 1-8XX  
number.

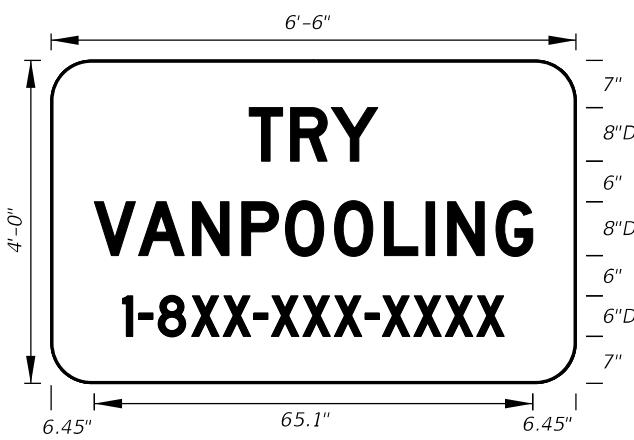


**FTP-57-06**  
6'-6" X 4'  
6" Radii  
8" and 6" Series D Legend  
Blue Background  
White Legend and Border  
Design Project Manager  
or Transit Administrator  
will supply correct 1-8XX  
number.

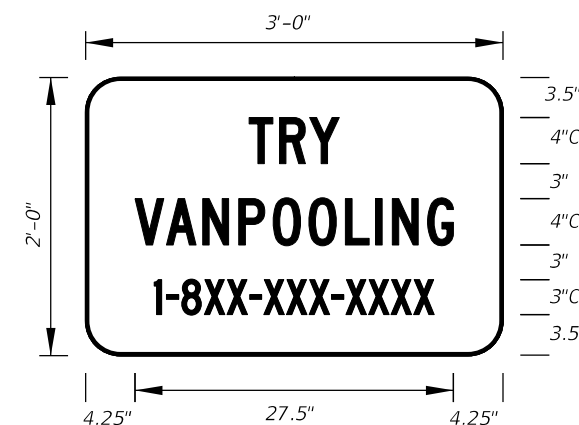


**FTP-58-06**  
3' X 2'  
3" Radii  
4" and 3" Series C Legend  
Blue Background  
White Legend and Border  
Design Project Manager  
or Transit Administrator  
will supply correct 1-8XX  
number.

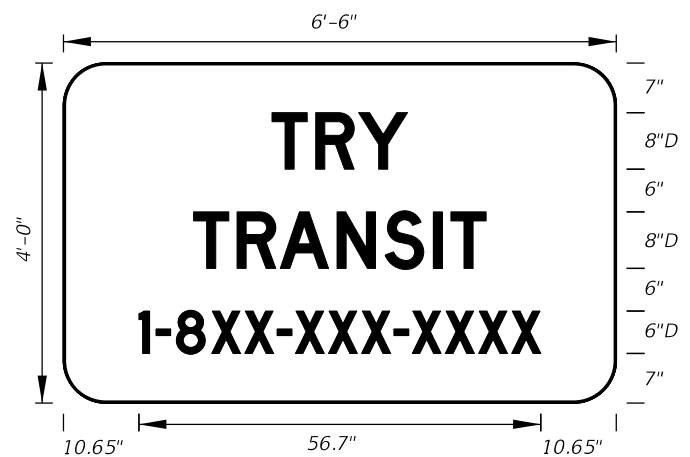

**FTP-59-06**  
6'-6" X 4'  
6" Radii  
8" and 6" Series D Legend  
Blue Background  
White Legend and Border  
Design Project Manager  
or Transit Administrator  
will supply correct 1-8XX  
number.

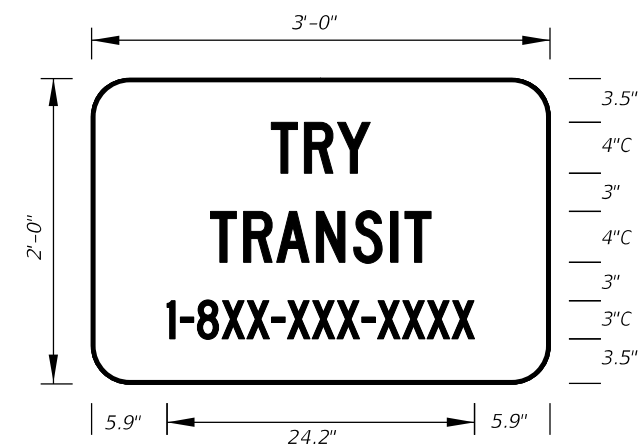

**FTP-60-06**  
3' X 2'  
3" Radii  
4" and 3" Series C Legend  
Blue Background  
White Legend and Border  
Design Project Manager  
or Transit Administrator  
will supply correct 1-8XX  
number.

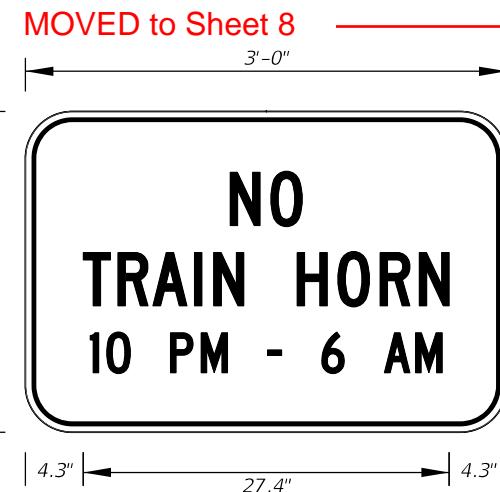

**FTP-61-06**  
3' X 2'  
3" Radii 3/4" Border  
4" and 3" Series C Legend  
Yellow Background  
Black Legend and Border



**FTP-62-06**  
3' X 3'  
2" Radii 3/4" Border 4" and 5" Series C Legend  
Yellow Background Black Legend and Border

10/3/2023 3:09:38 PM

LAST REVISION	DESCRIPTION:
11/01/20	
11/01/24	




FY ~~2024-25~~ 2025-26  
STANDARD PLANS

SPECIAL SIGN DETAILS

INDEX  
700-102

SHEET  
7 of 12

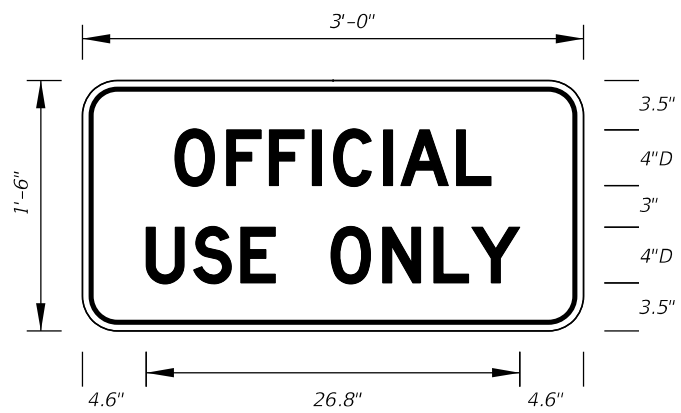

**FTP-65-06**  
3' X 1'-6"  
2" Radii 3/4" Border  
4" Series D Legend  
White Background  
Black Legend and Border



**FTP-66-21**  
4' X 5'  
3" Radii 1" Border  
6" Series D Legend  
Blue Background  
White Legend and Border




**FTP-67-21**  
5.5' X 6'  
3" Radii 1" Border  
8" Series D Legend  
Blue Background  
White Legend and Border



DETAIL for **FTP-66** AND **FTP-67**

Sign Mounting Holes Can Be Punched Or Field Drilled With No Obstruction To Text Or Symbols From Holes Or Bolts.

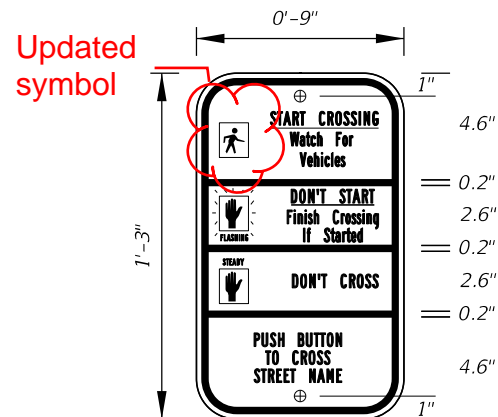


**FTP-68A-06**  
9" X 1'-3"  
1.5" Radii 3/4" Border  
Series B Legend  
White Background  
Black Legend and Border

~~See Standard Highway Signs Manual, Sign R10-3b For Letter Size Spacing And Symbol Sizes.~~

See MUTCD R10-3f For Letter Size, Spacing, and Symbol Sizing and Color.


Sign Mounting Holes Can Be Punched Or Field Drilled With No Obstruction To Text Or Symbols From Holes Or Bolts.

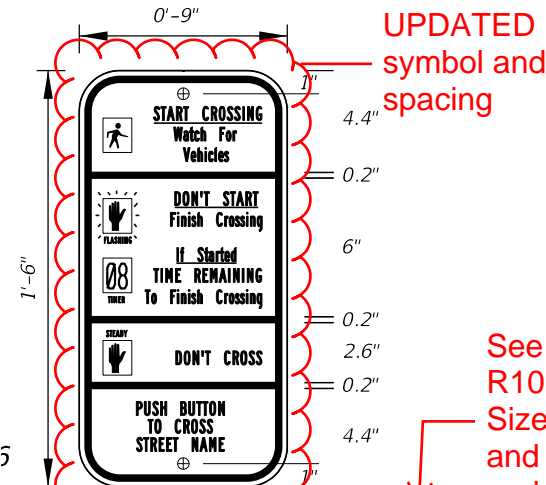

**FTP-68B-06**  
9" X 1'-6"  
1.5" Radii 3/4" Border  
Series B Legend  
White Background  
Black Legend and Border


~~See Standard Highway Signs Manual, Sign R10-3b For Letter Size Spacing And Symbol Sizes.~~

See MUTCD R10-3i For Letter Size, Spacing, and Symbol Sizing and Color.

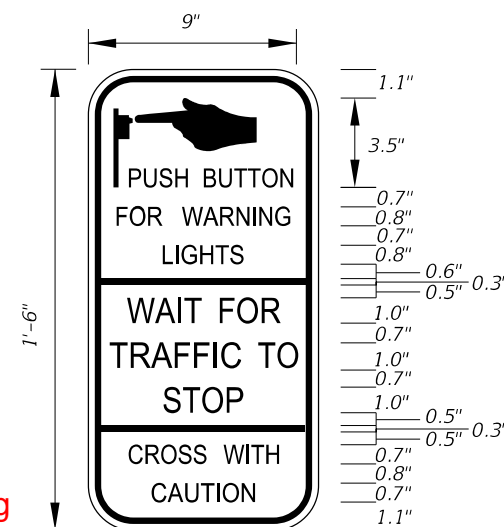

**FTP-68C-06**  
9" X 1'-6"  
1.5" Radii 1/4" Border

Series D Legend  
White Background  
Black Legend and Border

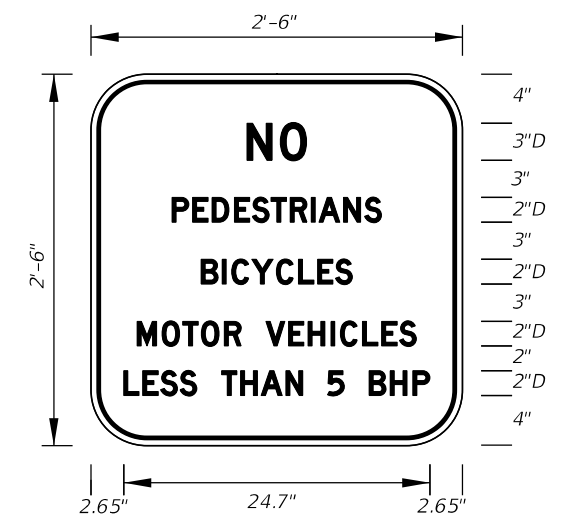

**FTP-69-06**  
2'-6" X 2'-6"  
4" Radii 3/4" Border


2" and 3" Series D Legend  
White Background  
Black Legend and Border



**FTP-70-06**  
3'-6" X 2'-6"  
2.25" Radii 3/4" Border  
5" Series C and 7" Series C Legend  
Blue Background  
White Legend and Border




**FTP-71-06**  
4' X 4'  
2" Radii 3/4" Border  
8" Series C Legend  
Yellow Background  
Black Legend and Border

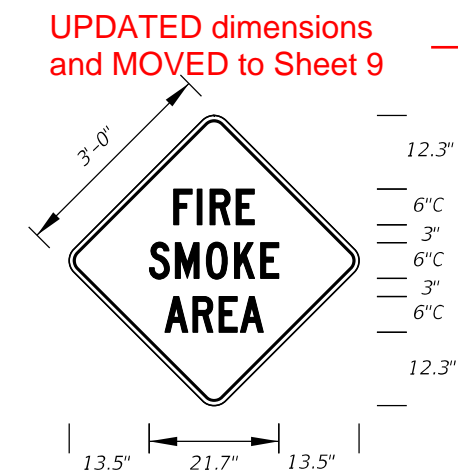

**FTP-72-06**  
3' X 3'  
2" Radii 3/4" Border

6" Series C Legend  
Yellow Background  
Black Legend and Border

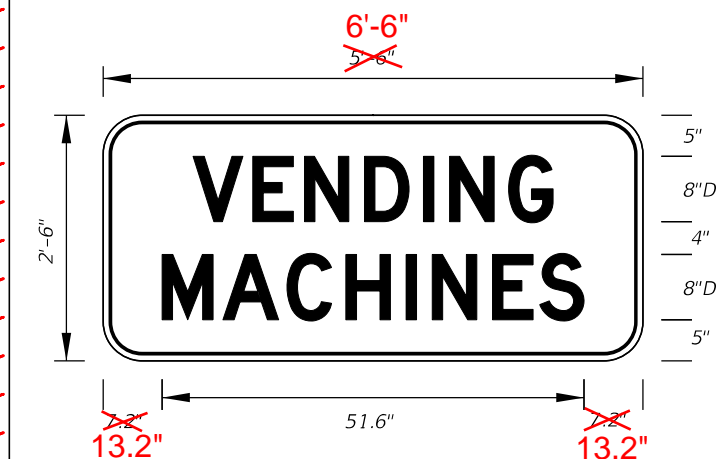

**FTP-73-06**  
5'-6" X 2'-6"  
2" Radii 3/4" Border

8" Series D Legend  
Blue Background  
White Legend and Border

6'-6" x 2'-6" to match above change

10/3/2023 3:09:45 PM

LAST REVISION	DESCRIPTION:
11/01/20	
11/01/24	




FY ~~2024-25~~ 2025-26  
STANDARD PLANS

SPECIAL SIGN DETAILS


INDEX	SHEET
700-102	8 of 12




**FTP-74-06**  
 5'-6" X 2'-6"  
 4" Radii 3/4" Border  
 6" Series D Legend  
 Blue Background  
 White Legend and Border

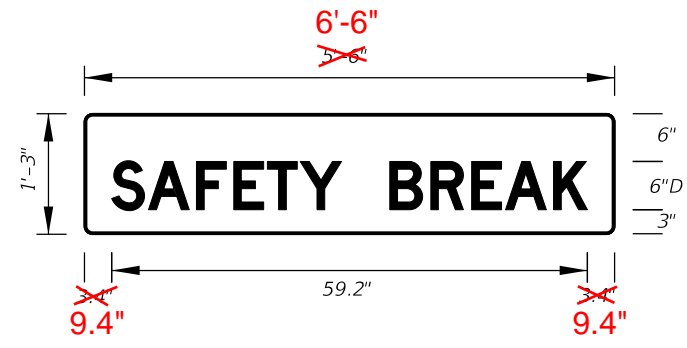


**FTP-75-06**  
 5'-6" X 1'-3"  
 1" Radii  
 6" Series D Legend  
 Blue Background  
 White Legend

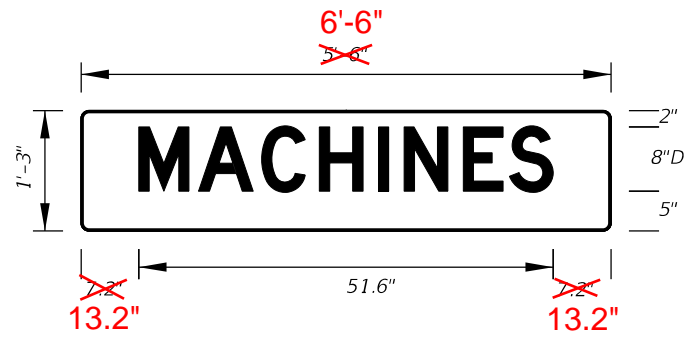


**FTP-76-06**  
 5'-6" X 1'-3"  
 1" Radii  
 8" Series D Legend  
 Blue Background  
 White Legend

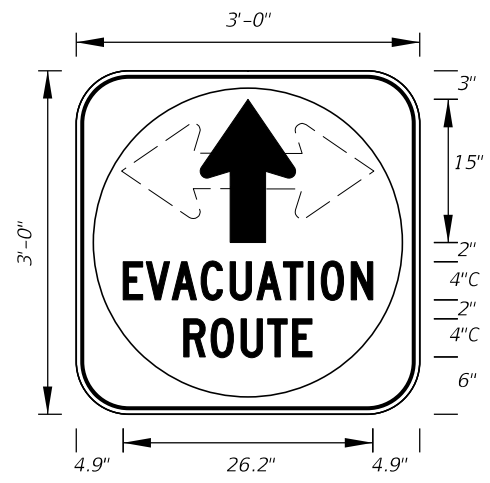

**FTP-77-06**  
 3' X 3'  
 5" Radii 3/4" Border  
 4" Series C Legend  
 White Background with Blue Circle Background  
 White Legend and Black Border

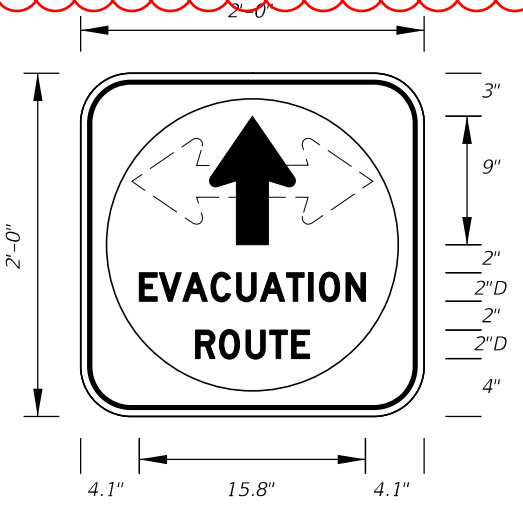


**FTP-78-06**  
 2' X 2'  
 3" Radii 3/4" Border  
 2" Series D Legend  
 White Background with Blue Circle Background  
 White Legend and Black Border

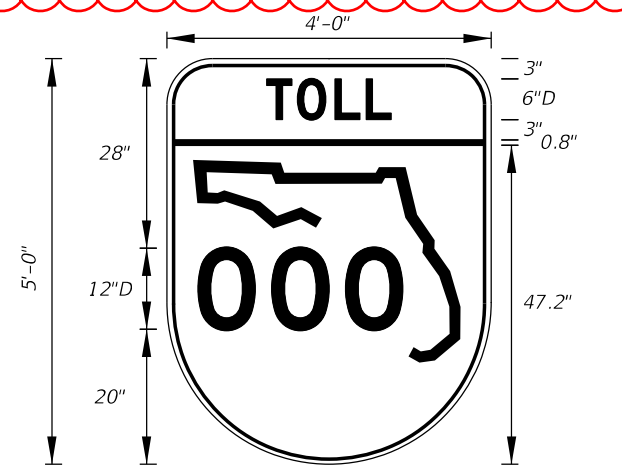


**FTP-79-06**  
 4' X 5'  
 6" Radii 3/4" Border  
 6" and 12" Series D Legend  
 Top Yellow Background with Black Legend and Black Border  
 Bottom White Background with Black Legend and Border


UPDATED dimensions

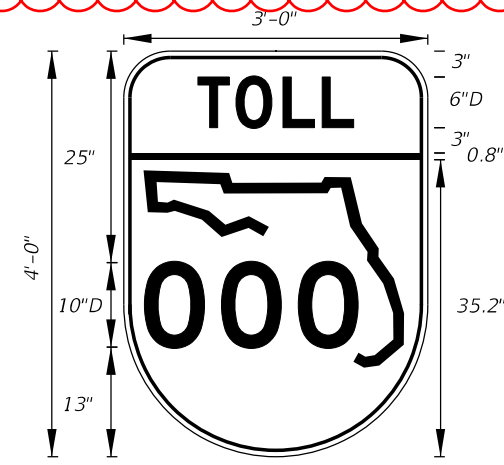


**FTP-80-06**  
 3' X 4'  
 5" Radii 3/4" Border  
 6" and 10" Series D Legend  
 Top Yellow Background with Black Legend and Black Border  
 Bottom White Background with Black Legend and Border

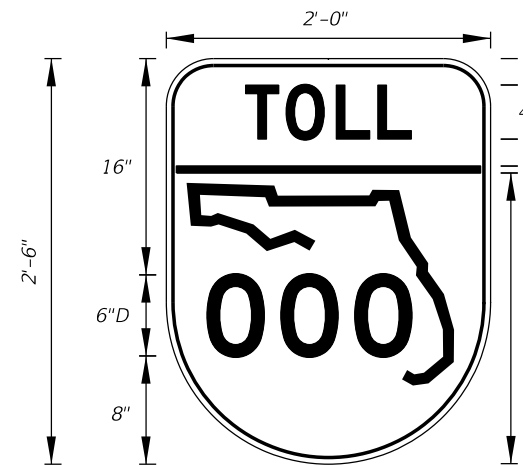

**FTP-81-06**  
 2' X 2'-6"  
 3" Radii 3/4" Border  
 4" and 6" Series D Legend  
 Top Yellow Background with Black Legend and Black Border  
 Bottom White Background with Black Legend and Border

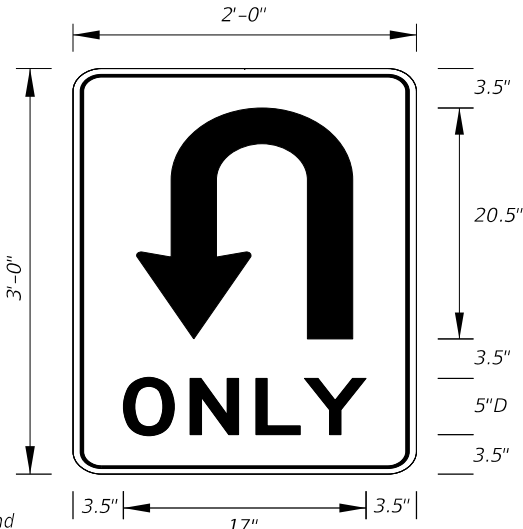


**FTP-82-08**  
 2' X 3'  
 1.5" Radii  
 5" Series D Legend  
 White Background  
 Black Legend and Border

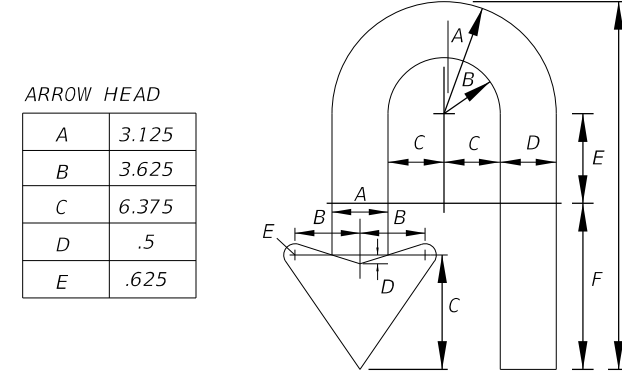


ARROW HEAD						
A	B	C	D	E	F	G
3.125	3.625	6.375	.5	.625		

**FTP-82-08**  
 Details

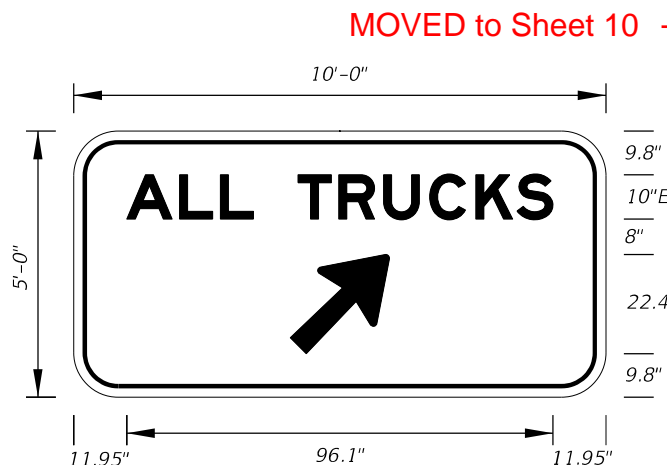

**FTP-83-08**  
 10'-0" X 5'-0"  
 8" Radii  
 10" Series E Legend  
 Green Background  
 White Legend

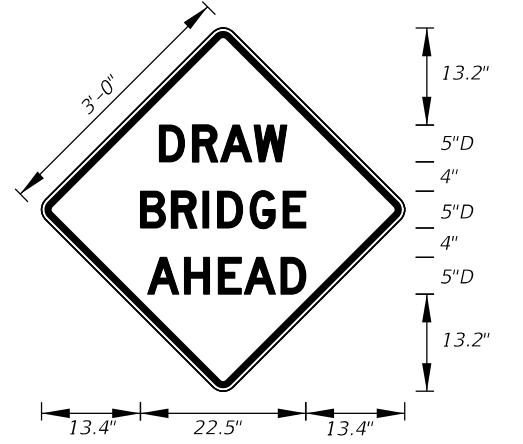

**FTP-84-09**  
 3' X 3'  
 1.5" Radii  
 5" Series D Legend  
 Yellow Background  
 Black Legend and Border

10/3/2023 3:09:52 PM


LAST REVISION	DESCRIPTION:
11/01/20	
11/01/24	




FY ~~2024-25~~ 2025-26  
 STANDARD PLANS

SPECIAL SIGN DETAILS


INDEX	SHEET
700-102	9 of 12

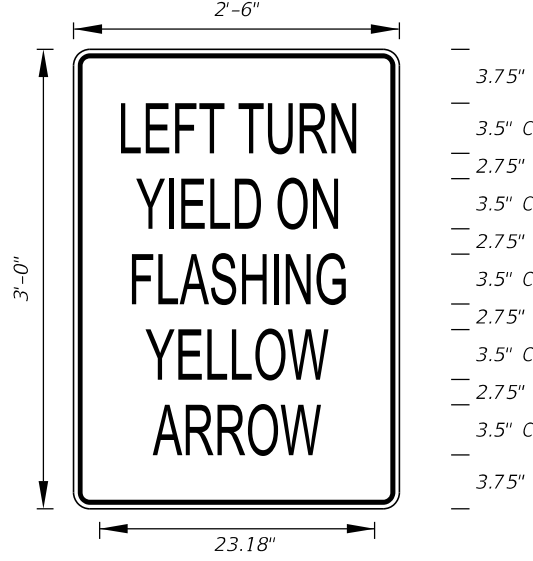


**FTP-85-13**  
2'-6" X 3'  
1.875" Radii 3/4" Border  
3.5" Series C Legend  
White Background  
Black Legend and Border

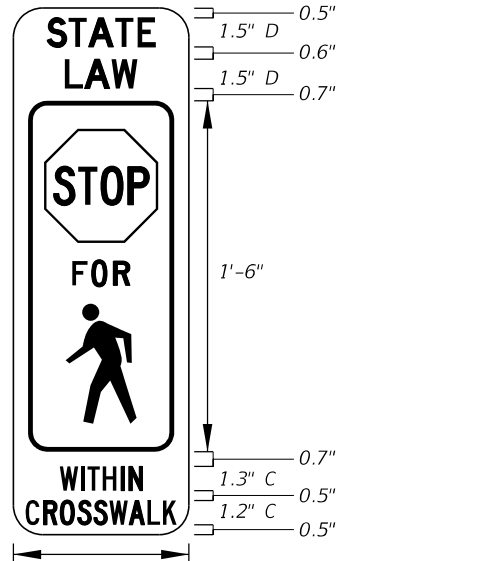


**FTP-86-21**  
9" X 2'-3"  
1.5" Radii No Border  
Series C Legend and Series D Legend  
White on Yellow  
Black Legend and Border

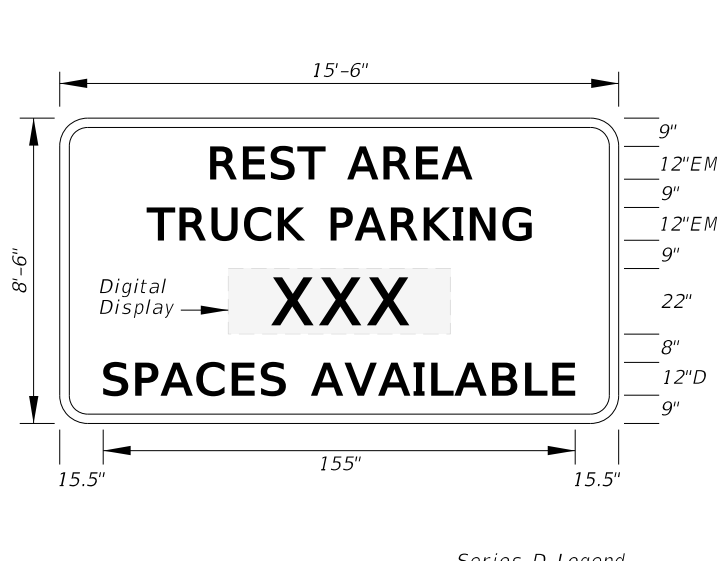


**FTP-87-21**  
15'-6" X 8'-6"  
12" Radii 2" Border  
Series D Legend  
Series EM Legend  
Blue Background  
White Legend and Border

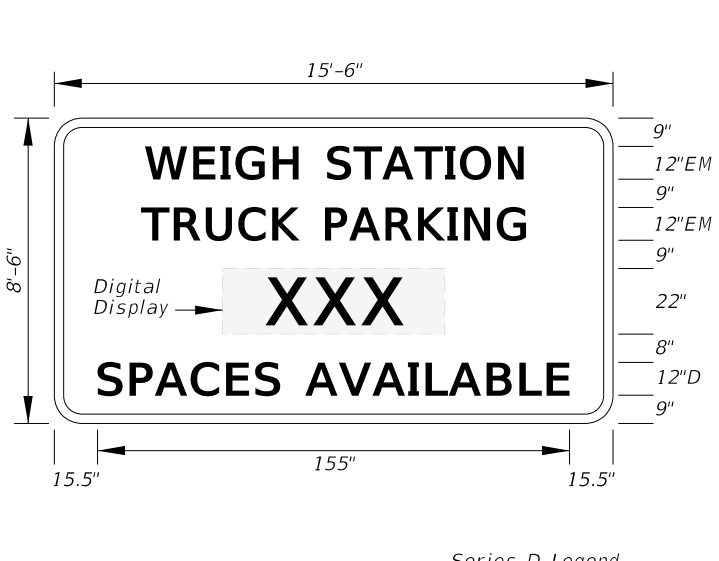


**FTP-88-21**  
15'-6" X 8'-6"  
12" Radii 2" Border  
Series D Legend  
Series EM Legend  
Blue Background  
White Legend and Border

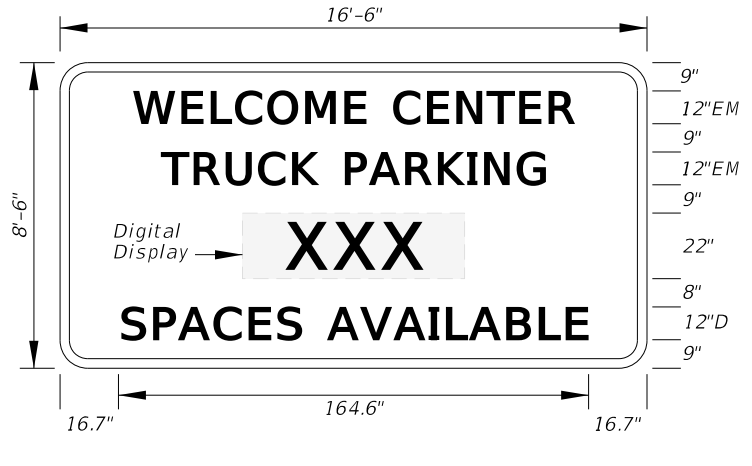

**FTP-89-21**  
16'-6" X 8'-6"  
12" Radii 2" Border  
Series D Legend  
Series EM Legend  
Blue Background  
White Legend and Border

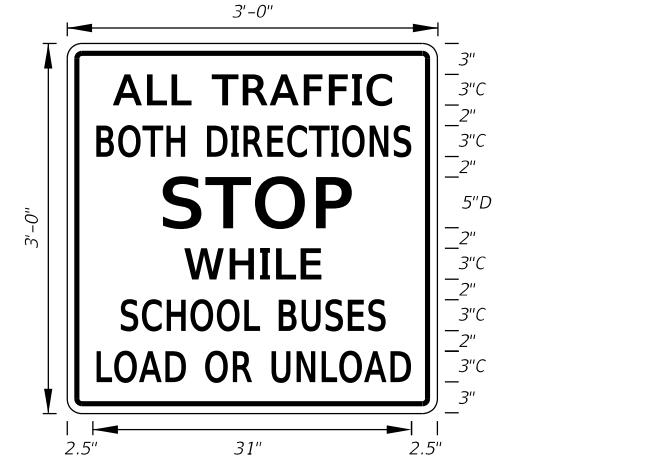


**FTP-90-22**  
3'-0" X 3'-0"  
1.5" Radii 3/4" Border  
3" Series C Legend and 5" Series D Legend  
White Background  
Black Legend and Border

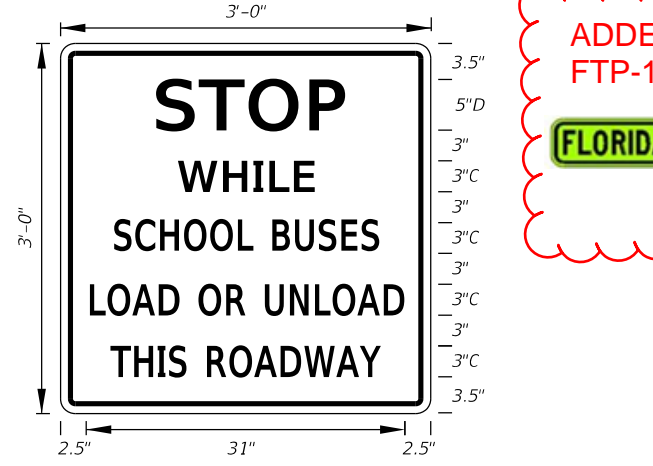


**FTP-91-22**  
3'-0" X 3'-0"  
1.5" Radii 3/4" Border  
3" Series C Legend and 5" Series D Legend  
White Background  
Black Legend and Border


ADDED  
FTP-100-25  
FLORIDA LAW

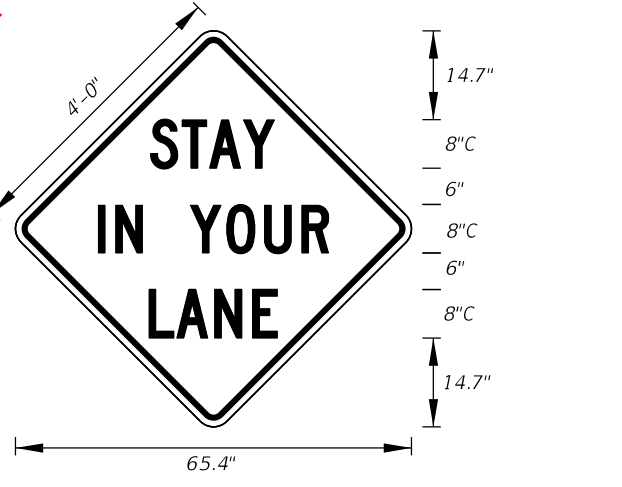


**MOT-1-22**  
4' X 4'  
3" Radii 3/4" Border  
8" Series C Legend  
Orange Background  
Black Legend and Border

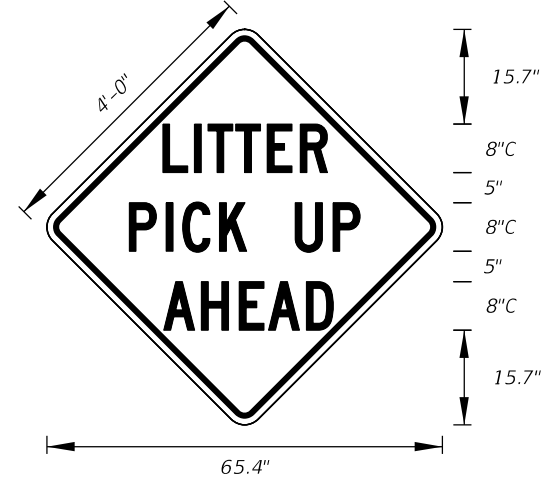

**MOT-4-22**  
4' X 4'  
3" Radii 3/4" Border  
8" Series C Legend  
Orange Background  
Black Legend and Border

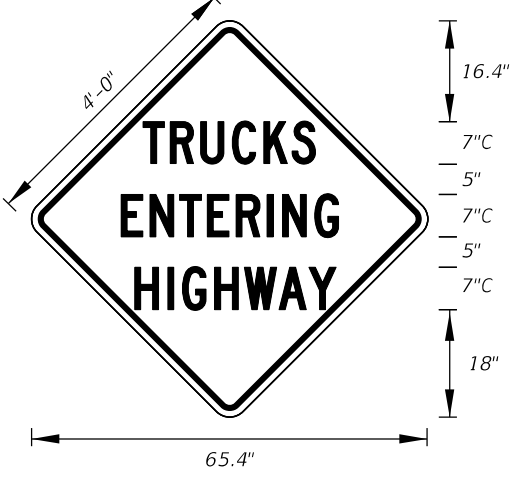


**MOT-5-22**  
4' X 4'  
3" Radii 3/4" Border  
7" Series C Legend  
Orange Background  
Black Legend and Border

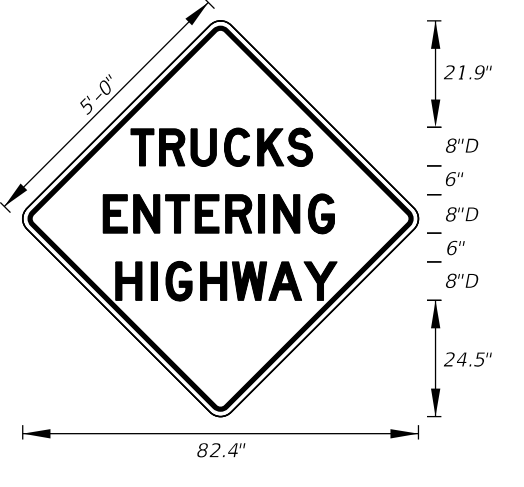

**MOT-6-22**  
5' X 5'  
3" Radii 3/4" Border  
8" Series C Legend  
Orange Background  
Black Legend and Border


MOVED "MOT" to Sheet 11

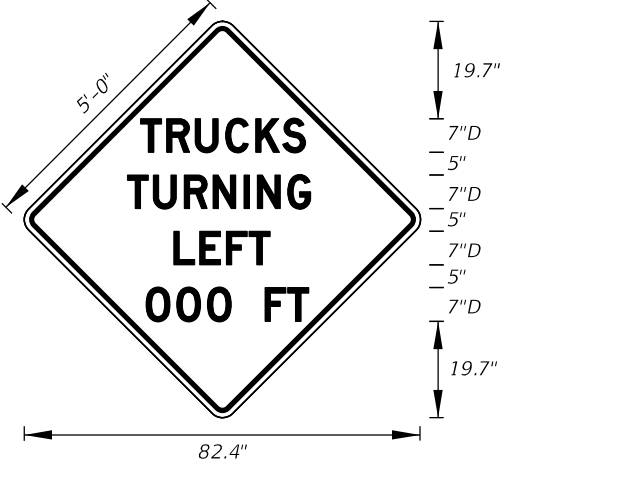


**MOT-7-22**  
5' X 5'  
3" Radii 3/4" Border  
7" Series D Legend  
Orange Background  
Black Legend and Border

10/3/2023 3:09:59 PM


LAST REVISION	DESCRIPTION	FY 2024-25 2025-26		SPECIAL SIGN DETAILS		INDEX	SHEET
11/01/21 11/01/24		FDOT STANDARD PLANS				700-102	10 of 12

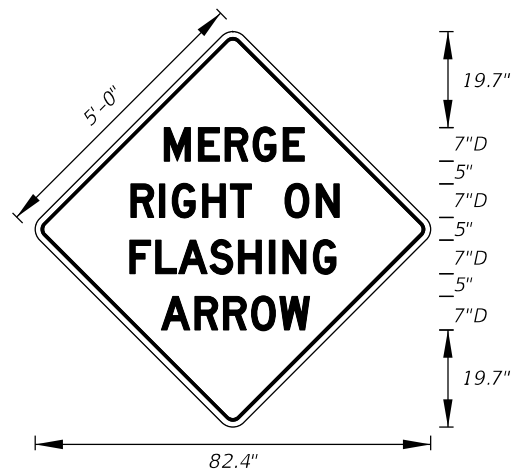


**MOT-8-22**  
5' X 5'  
3" Radii 3/4" Border  
7" Series D Legend  
Orange Background  
Black Legend and Border

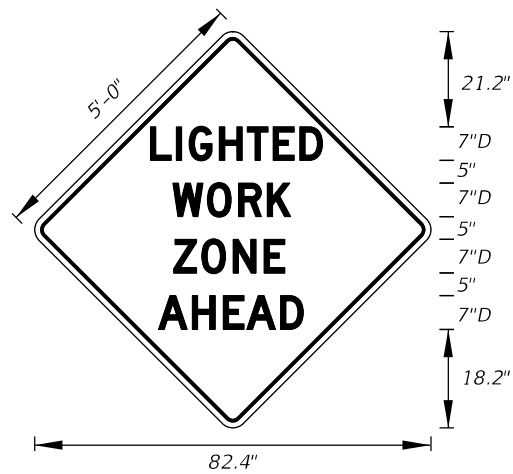


**MOT-9-22**  
5' X 5'  
3" Radii 3/4" Border  
7" Series D Legend  
Orange Background  
Black Legend and Border

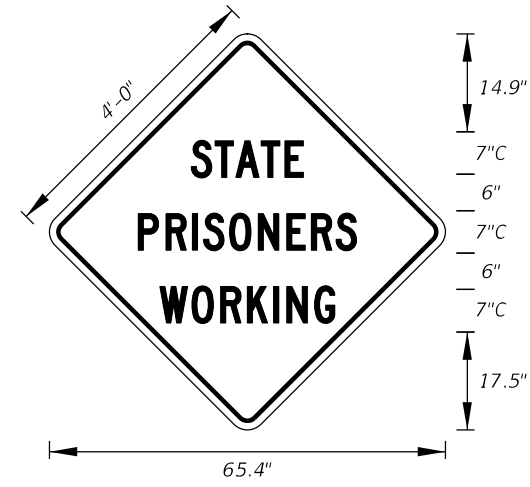

**MOT-10-22**  
4' X 4'  
3" Radii 3/4" Border  
7" Series C Legend  
Orange Background  
Black Legend and Border

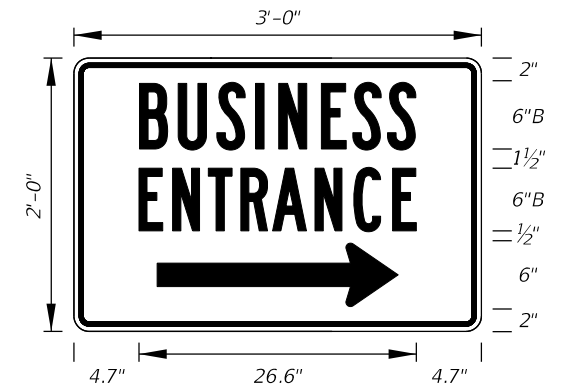


**MOT-11-06**  
3' X 2'  
2" Radii 3/4" Border  
6" Series B Legend  
Blue Background  
White Legend and Border

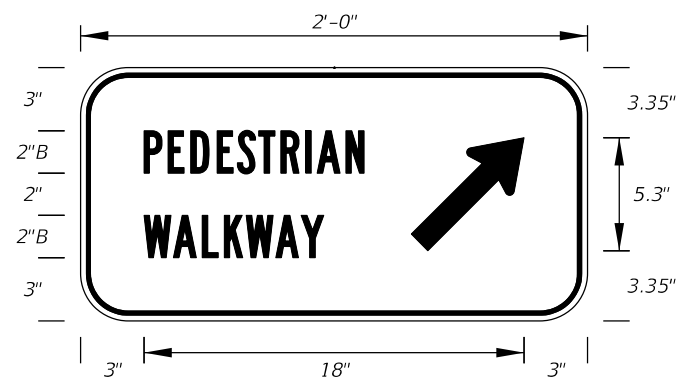


**MOT-12R-06**  
2' X 1'  
2" Radii 3/4" Border  
2" Series B Legend  
White Background  
Black Legend and Border


**MOT-12L-06**  
For Diversion  
to the left

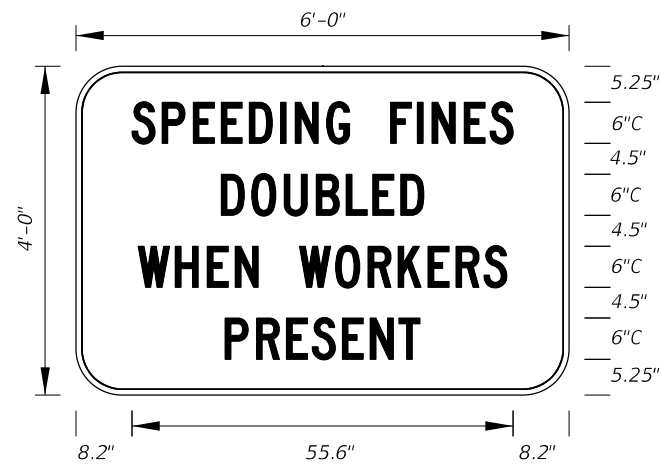


**MOT-13-06**  
Freeway Sign  
6' X 4'  
6" Radii 3/4" Border  
6" Series C Legend  
White Background  
Black Legend and Border

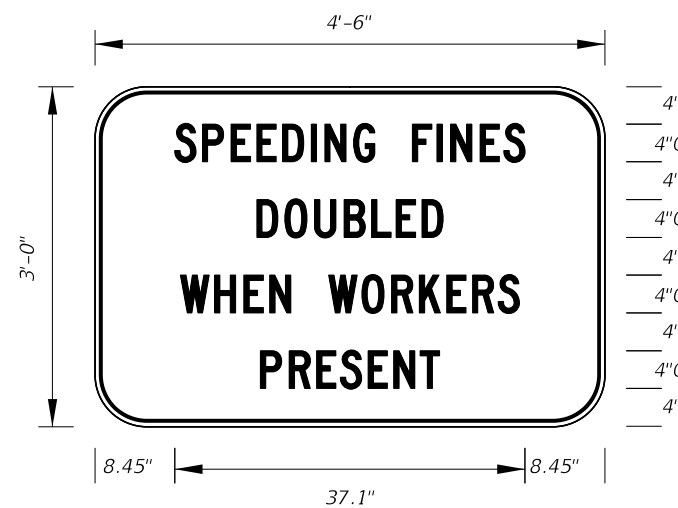


**MOT-14-06**  
Arterial Sign  
4'-6" X 3'  
5" Radii 3/4" Border  
4" Series C Legend  
White Background  
Black Legend and Border

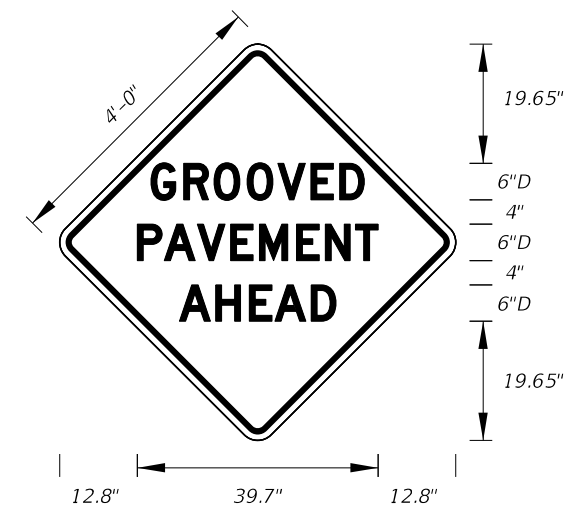


**MOT-15-06**  
4' X 4'  
2" Radii 3/4" Border  
6" Series D Legend  
Orange Background  
Black Legend and Border

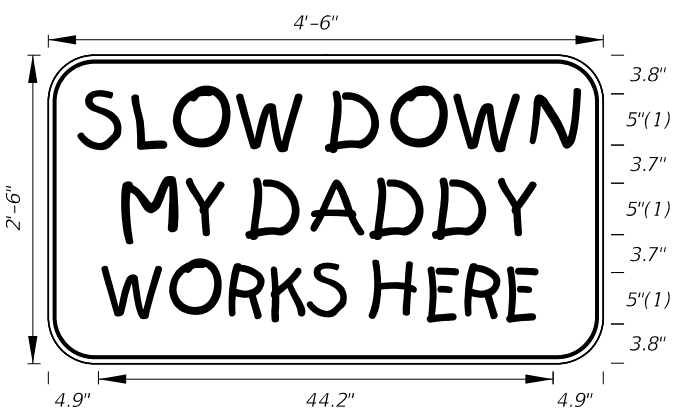

**MOT-16-06**  
4'-6" X 2'-6"  
4" Radii 3/4" Border  
5" Kids Series Legend  
Orange Background  
Black Legend and Border

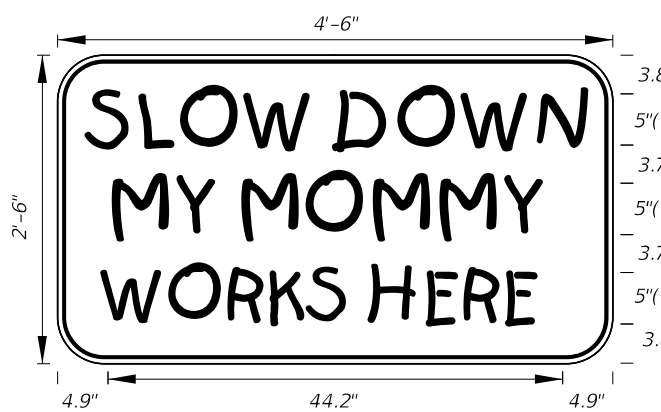


**MOT-17-06**  
4'-6" X 2'-6"  
4" Radii 3/4" Border  
5" Kids Series Legend  
Orange Background  
Black Legend and Border

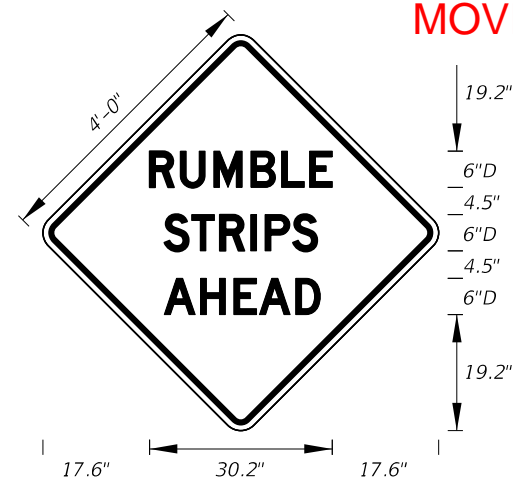

**MOT-18-10**  
4' X 4'  
2" Radii 3/4" Border  
6" Series D Legend  
Orange Background  
Black Legend and Border

**MOVED" to Sheet 12**

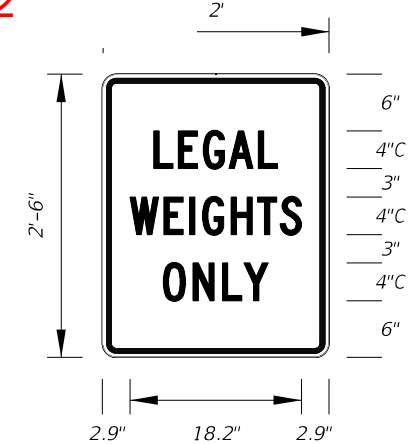


**MOT-19-11**  
2' X 2'-6"  
1.13" Radii 3/4" Border  
4" Series C Legend  
White Background  
Red Legend and Border


10/3/2023 3:10:06 PM

LAST REVISION	DESCRIPTION:
11/01/21	
11/01/24	




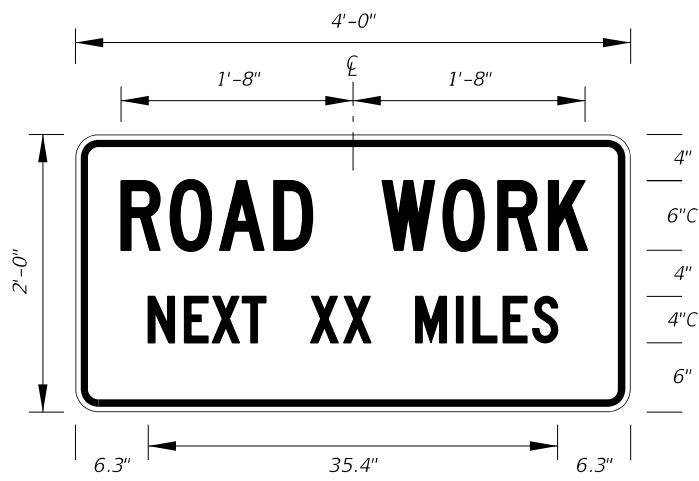


**G20-1**  
4' X 2'  
1.5" Radii 3/4" Border  
Orange Background  
Black Legend and Border

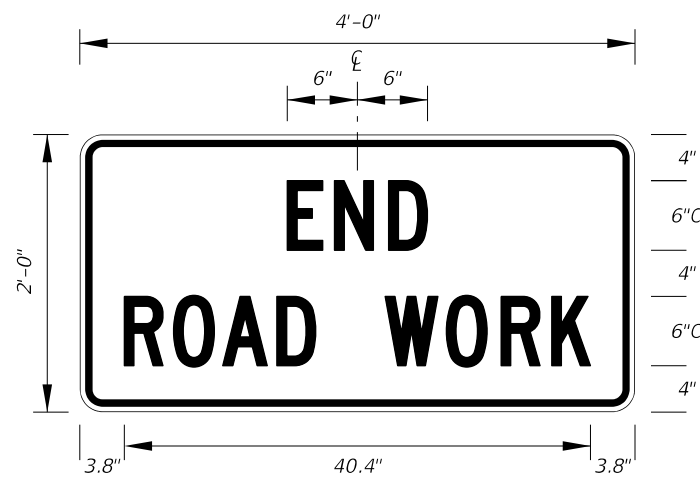


**G20-2**  
4' X 2'  
1.5" Radii 3/4" Border  
Orange Background  
Black Legend and Border

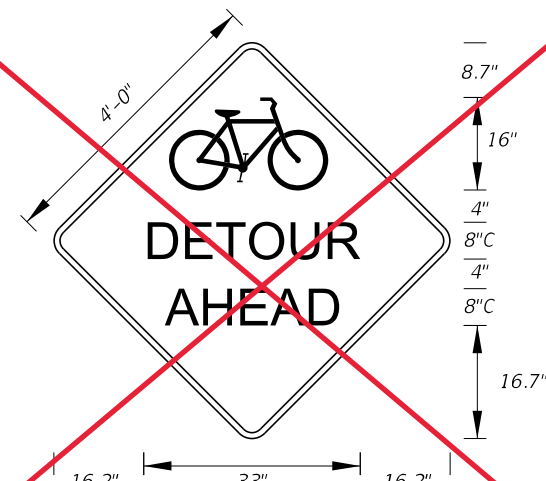


**MOT-20-21**  
4' X 4'  
3" Radii 3/4" Border  
8" Series C Legend  
Orange Background  
Black Legend and Border

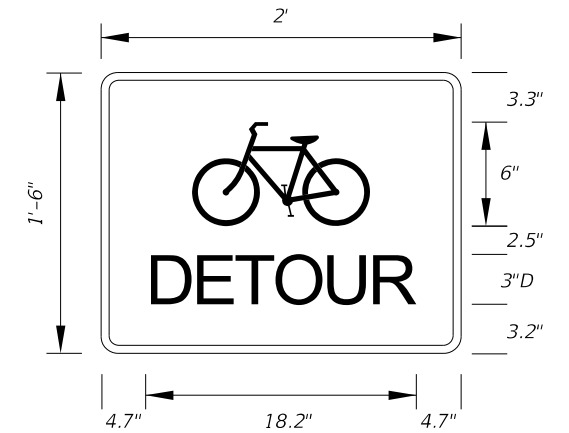

**MOT-21-21**  
2' X 1'-6"  
1.5" Radii 1/2" Border  
3" Series D Legend  
Orange Background  
Black Legend and Border

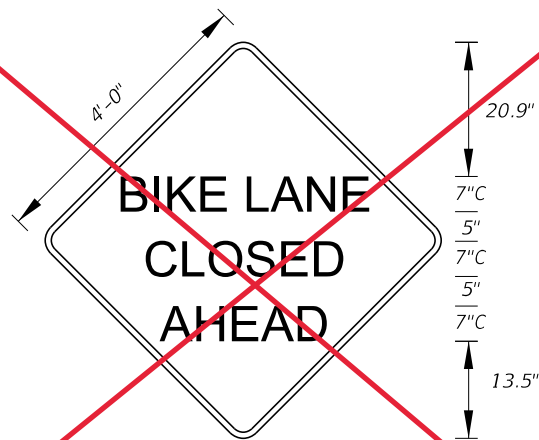

**MOT-22-21**  
4' X 4'  
3" Radii 3/4" Border  
7" Series C Legend  
Orange Background  
Black Legend and Border

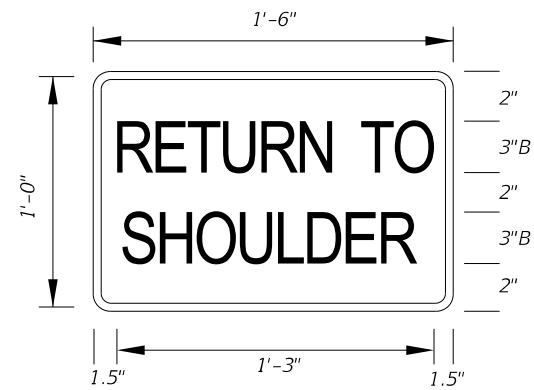


**MOT-23-21**  
1'-6" X 1'-0"  
1.5" Radii 1/4" Border  
3" Series B Legend  
Orange Background  
Black Legend and Border




**MOT-24-21**  
2'-6" X 1'-6"  
1.5" Radii 1/2" Border  
4" Series C Legend  
White Background  
Black Legend and Border




**MOT-25-21**  
2'-0" X 1'-6"  
1.5" Radii 1/2" Border  
4" Series B Legend  
White Background  
Black Legend and Border

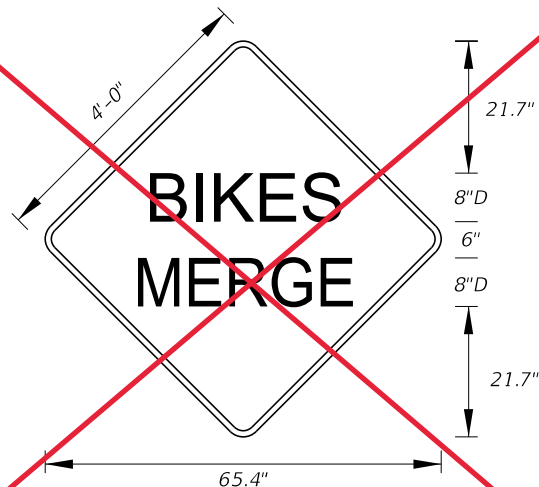

**MOT-26A-22**  
4' X 4'  
3" Radii 3/4" Border  
8" Series D Legend  
Orange Background  
Black Legend and Border

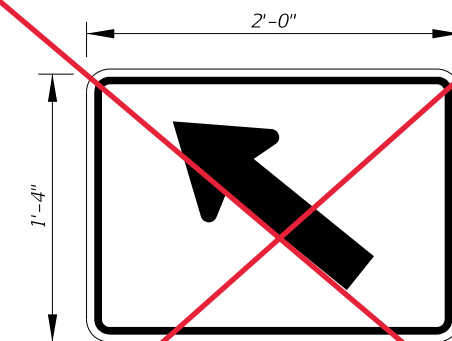

**MOT-26B-22**  
2'-0" X 1'-4"  
1.5" Radii 5/8" Border  
Orange Background  
Black Legend and Border

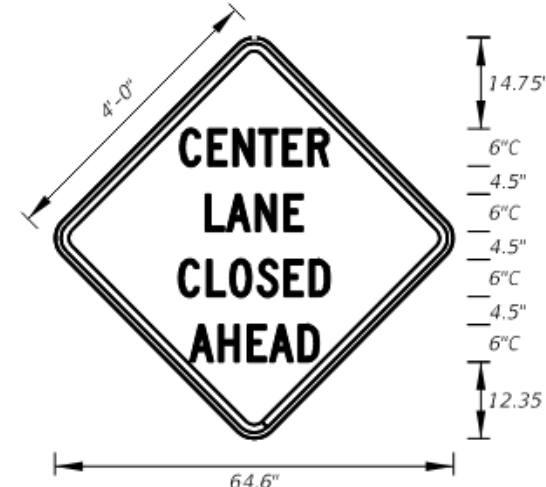

**MOT-27-24**  
4' X 4'  
3" Radii 3/4" Border  
6" Series C Legend  
Orange Background  
Black Legend and Border

Added sign  
MOT-27-25

10/3/2023 3:10:13 PM

LAST REVISION	DESCRIPTION:
11/01/23	
11/01/24	



FY 2024-25  
STANDARD PLANS


2025-26

SPECIAL SIGN DETAILS


INDEX	SHEET
700-102	12 of 12




**FTP-41-21**  
2'-6" X 3'  
4" Radii 3/4" Border  
2" and 4" Series C Legend  
White Background  
Black Legend and Border

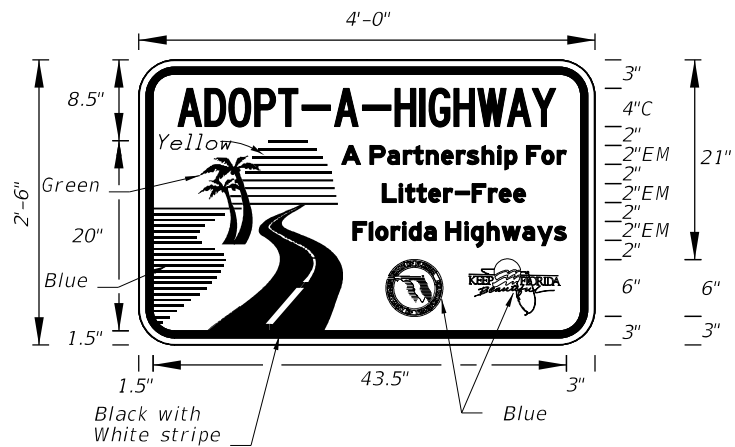

**FTP-42-06**  
4' X 2'-6"  
3" Radii  
Top 4" Series C Legend  
Bottom 2" Series EM Legend  
White Background  
Blue Legend and Border

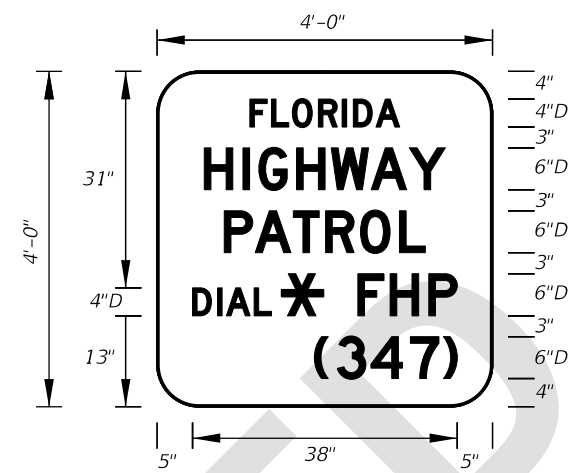


**FTP-43-06**  
4' X 4'  
6" Radii 1" Border  
Top 4" Series D Legend  
Bottom 6" Series D Legend  
Blue Background  
White Legend and Border

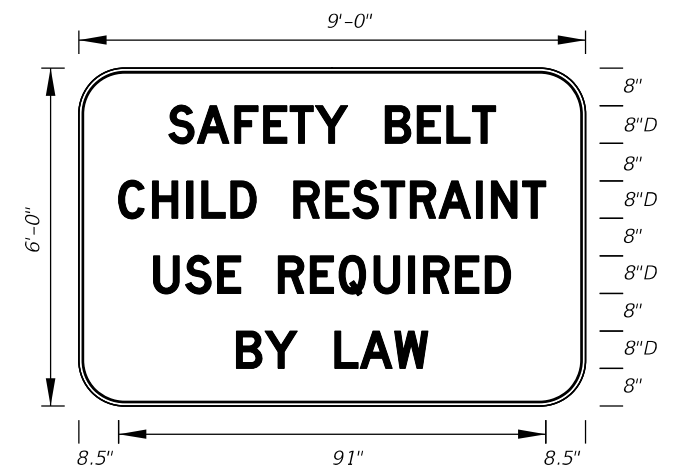


**FTP-44-06**  
9' X 6'  
9" Radii 3/4" Border  
8" Series D Legend  
White Background  
Black Legend and Border




**FTP-44A-25**  
4' X 3'  
5" Radii 3/4" Border  
4" Series C Legend  
White Background  
Black Legend and Border

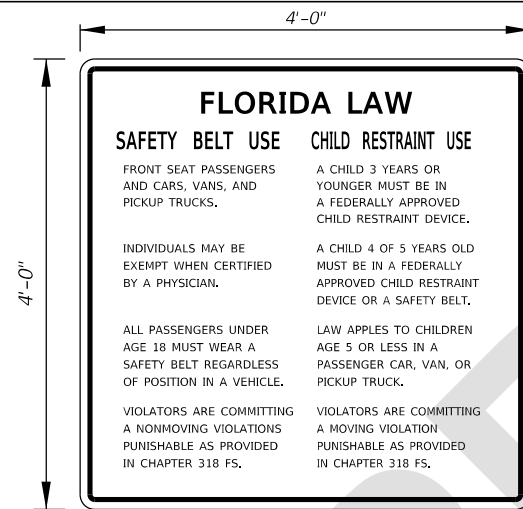


**FTP-45-25**  
4'-0" X 4'-0"  
1.5" Radii  
0.4" Border  
2.5" Series C Legend  
2" Series C Legend  
1.5" Series C Legend and  
White Background  
Black Legend and Border

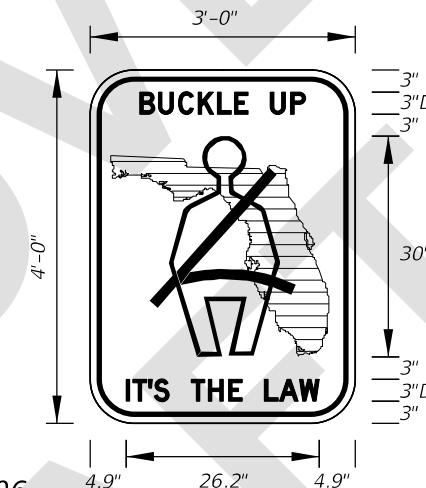


**FTP-46-06**  
3' X 4'  
5" Radii 3/4" Border  
3" Series D Legend  
White Background  
Black Legend, Border and Man Belt Symbol  
Green Florida Symbol

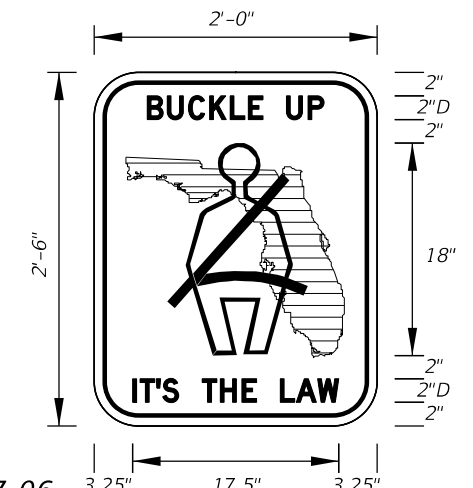


**FTP-47-06**  
2' X 2'-6"  
3" Radii 5/8" Border  
2" Series D Legend  
White Background  
Black Legend, Border and Man Belt Symbol  
Green Florida Symbol

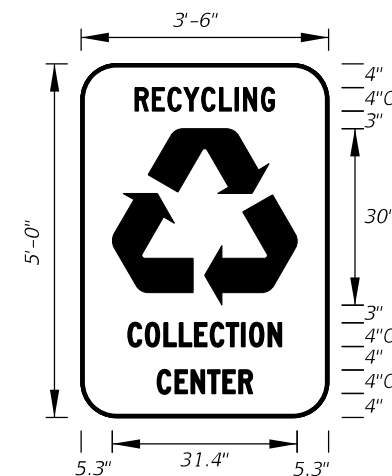


**FTP-48-06**  
3'-6" X 5'  
6" Radii  
4" Series C Legend  
Green Background  
White Legend, Border and Symbol

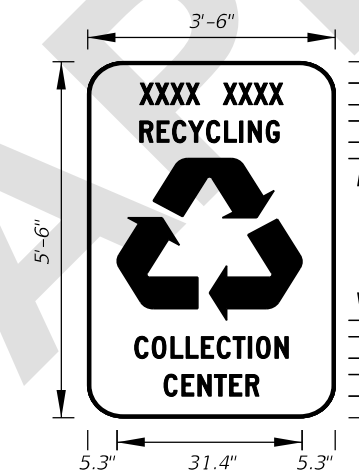

**FTP-49-06**  
3'-6" X 5'-6"  
6" Radii  
4" Series C Legend  
Green Background  
White Legend, Border and Symbol  
Municipality Name Optional

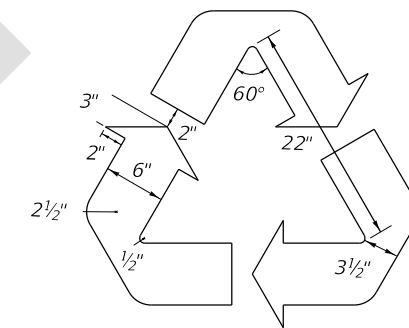


Detail for **FTP-48-06** and **FTP-49-06**

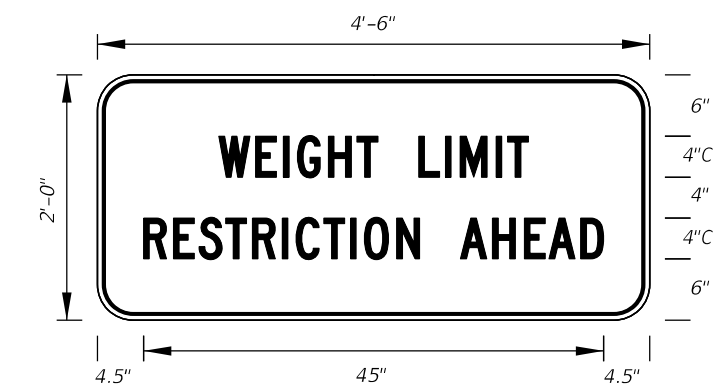


**FTP-50-06**  
4'-6" X 2'  
3" Radii 3/4" Border  
4" Series C Legend  
Yellow Background  
Black Legend and Border

8/15/2024 1:20:36 PM


LAST REVISION	DESCRIPTION:
11/01/24	

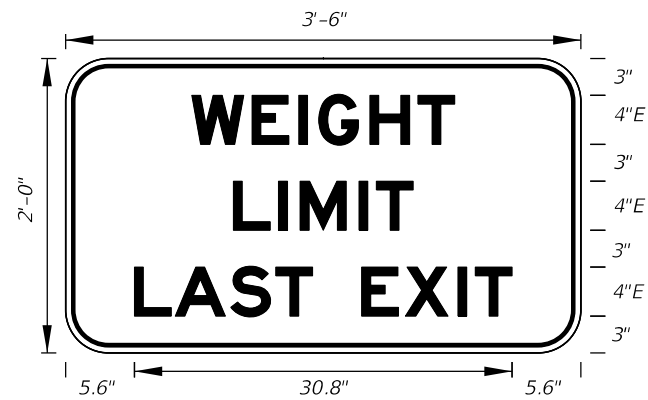


**FTP-51-06**  
3' X 2'  
3" Radii 3/4" Border  
4" Series E Legend  
White Background  
Black Legend and Border

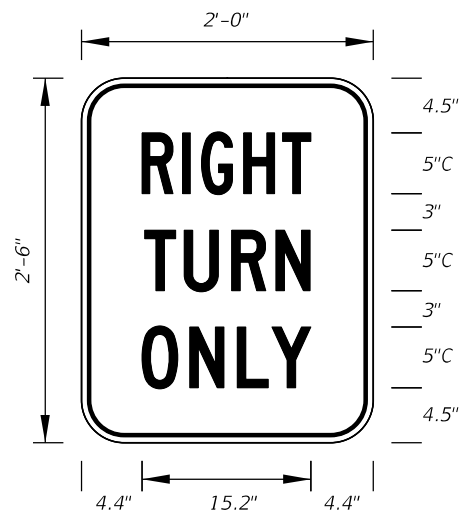


**FTP-52-06**  
2' X 2'-6"  
3" Radii 5/8" Border  
5" Series C Legend  
White Background  
Black Legend and Border

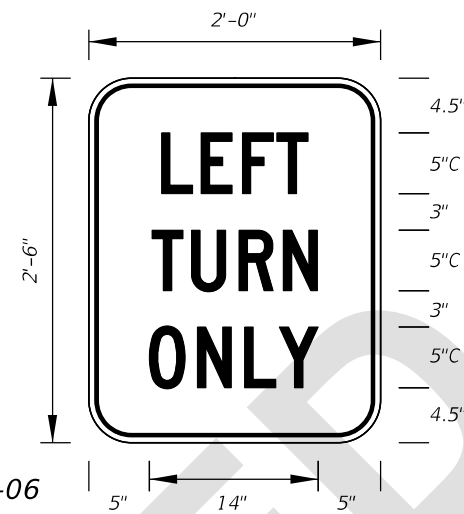

**FTP-53-06**  
2' X 2'-6"  
3" Radii 5/8" Border  
5" Series C Legend  
White Background  
Black Legend and Border

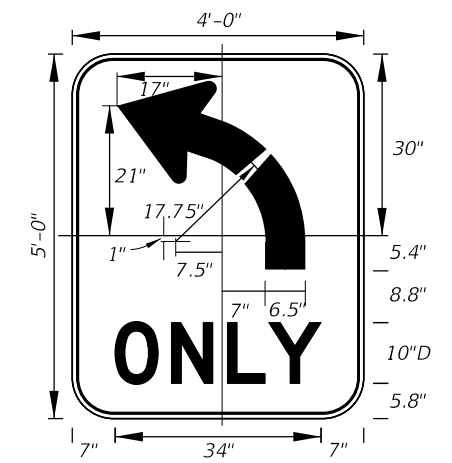

**FTP-54L-06**  
4' X 5'  
6" Radii 3/4" Border  
10" Series D Legend  
White Background  
Black Legend and Border  
FTP-54R-06 for (Right Turn Arrow)

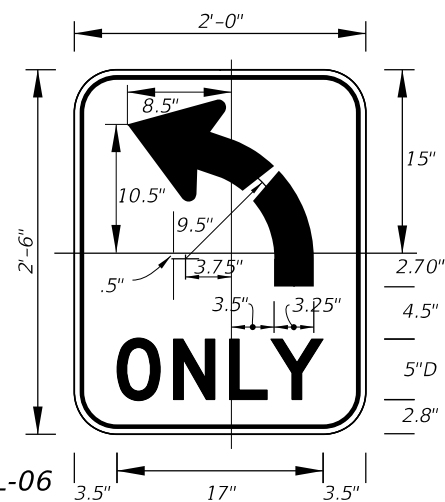


**FTP-55L-06**  
2' X 2'-6"  
3" Radii 3/8" Border  
5" Series D Legend  
White Background  
Black Legend and Border  
FTP-55R-06 for (Right Turn Arrow)




**FTP-56-06**  
6'-6" X 4'  
6" Radii 3/4" Border  
8" and 6" Series D Legend  
Blue Background  
White Legend and Border  
Design Project Manager or Transit Administrator will supply correct 1-8XX number.




**FTP-56A-06**  
3' X 2'  
3" Radii  
4" and 3" Series C Legend  
Blue Background  
White Legend and Border  
Design Project Manager or Transit Administrator will supply correct 1-8XX number.

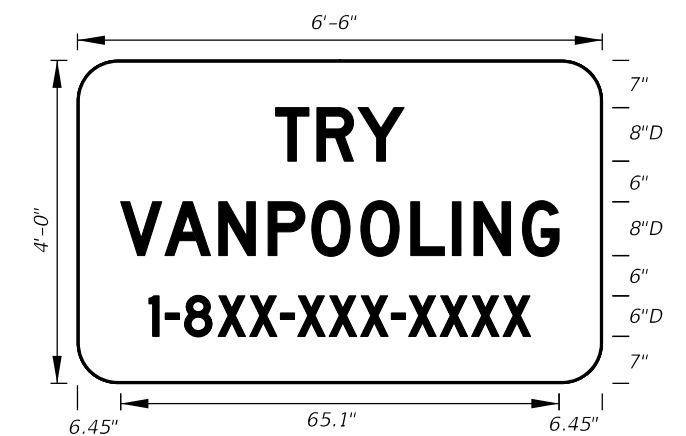


**FTP-57-06**  
6'-6" X 4'  
6" Radii  
8" and 6" Series D Legend  
Blue Background  
White Legend and Border  
Design Project Manager or Transit Administrator will supply correct 1-8XX number.

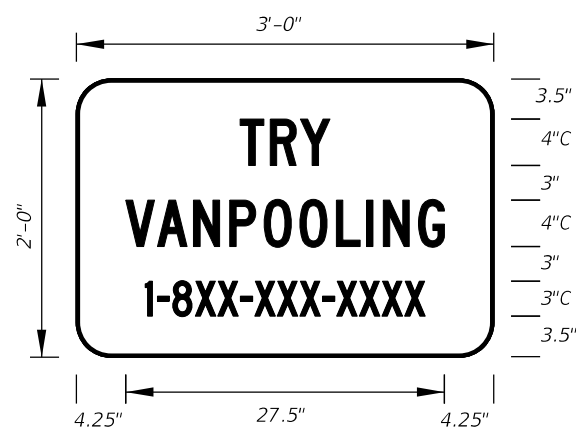

**FTP-58-06**  
3' X 2'  
3" Radii  
4" and 3" Series C Legend  
Blue Background  
White Legend and Border  
Design Project Manager or Transit Administrator will supply correct 1-8XX number.

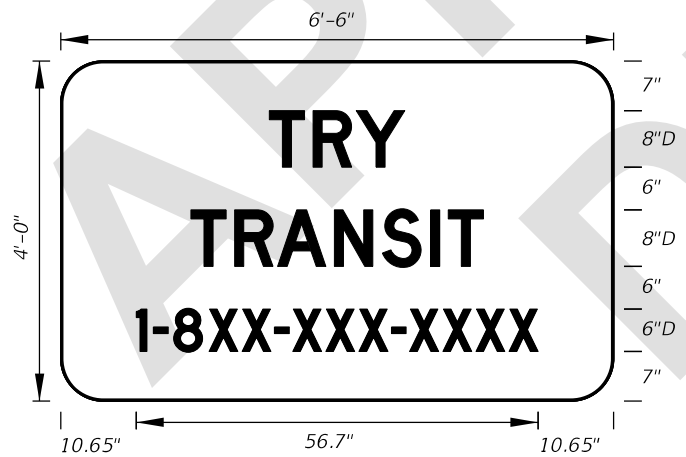

**FTP-59-06**  
6'-6" X 4'  
6" Radii  
8" and 6" Series D Legend  
Blue Background  
White Legend and Border  
Design Project Manager or Transit Administrator will supply correct 1-8XX number.

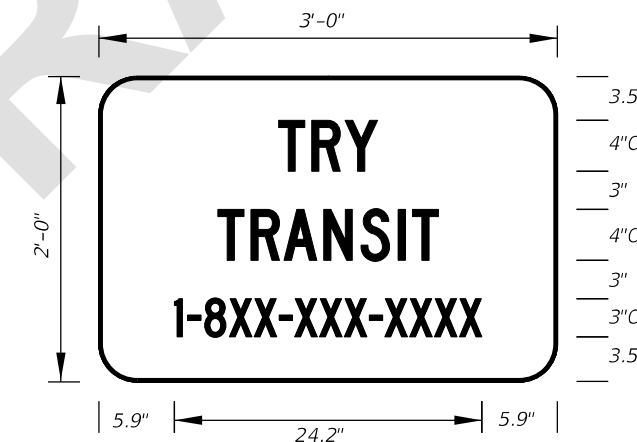


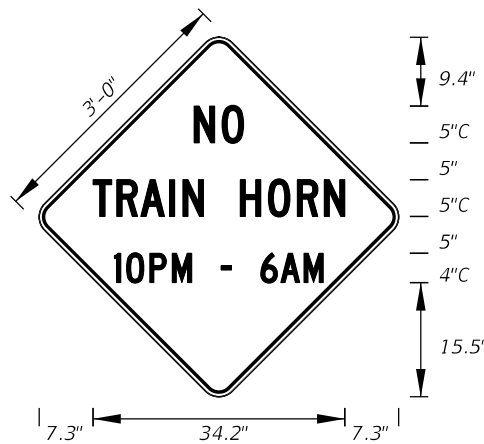
**FTP-60-06**  
3' X 2'  
3" Radii  
4" and 3" Series C Legend  
Blue Background  
White Legend and Border  
Design Project Manager or Transit Administrator will supply correct 1-8XX number.




**FTP-61-06**  
3' X 2'  
3" Radii 3/4" Border  
4" and 3" Series C Legend  
Yellow Background  
Black Legend and Border

8/15/2024 1:20:45 PM

LAST REVISION 11/01/24	REVISION	DESCRIPTION:	 FY 2025-26 STANDARD PLANS	SPECIAL SIGN DETAILS	INDEX 700-102	SHEET 7 of 12
---------------------------	----------	--------------	--	----------------------	------------------	------------------



**FTP-62-06**  
 3' X 3'  
 2" Radii 3/4" Border 4" and 5" Series C Legend  
 Yellow Background Black Legend and Border

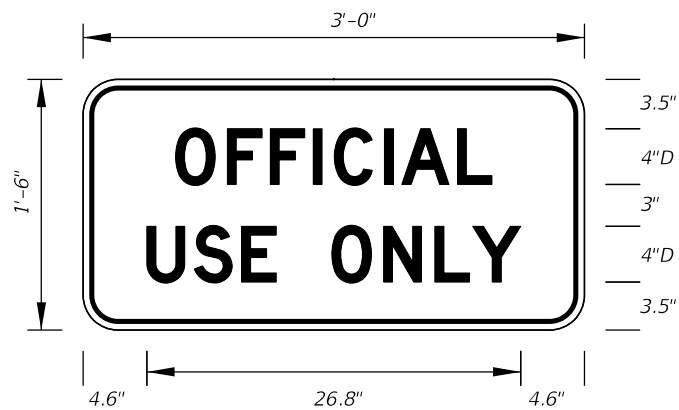

**FTP-65-06**  
 3' X 1'-6"  
 2" Radii 3/4" Border  
 4" Series D Legend  
 White Background  
 Black Legend and Border



**FTP-66-21**  
 4' X 5'  
 3" Radii 1" Border  
 6" Series D Legend  
 Blue Background  
 White Legend and Border




**FTP-67-21**  
 5.5' X 6'  
 3" Radii 1" Border  
 8" Series D Legend  
 Blue Background  
 White Legend and Border




DETAIL for FTP-66 AND FTP-67

Sign Mounting Holes Can Be Punched Or Field Drilled With No Obstruction To Text Or Symbols From Holes Or Bolts.

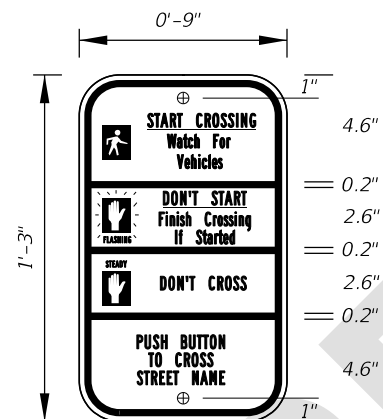


**FTP-68A-06**  
 9" X 1'-3"  
 1.5" Radii 3/4" Border  
 Series B Legend  
 White Background  
 Black Legend and Border  
 See MUTCD R10-3f for Letter Size, Spacing, and Symbol Sizes and Color


Sign Mounting Holes Can Be Punched Or Field Drilled With No Obstruction To Text Or Symbols From Holes Or Bolts.

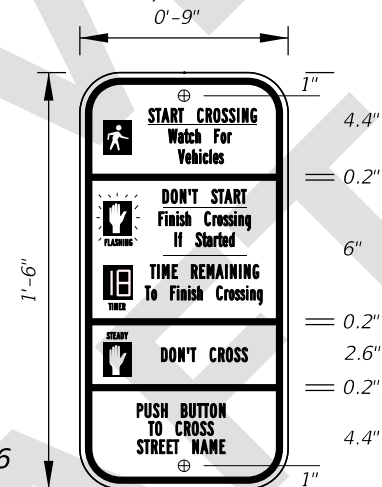


**FTP-68B-06**  
 9" X 1'-6"  
 1.5" Radii 3/4" Border  
 Series B Legend  
 White Background  
 Black Legend and Border  
 See MUTCD R10-3i for Letter Size, Spacing, and Symbol Sizes and Color

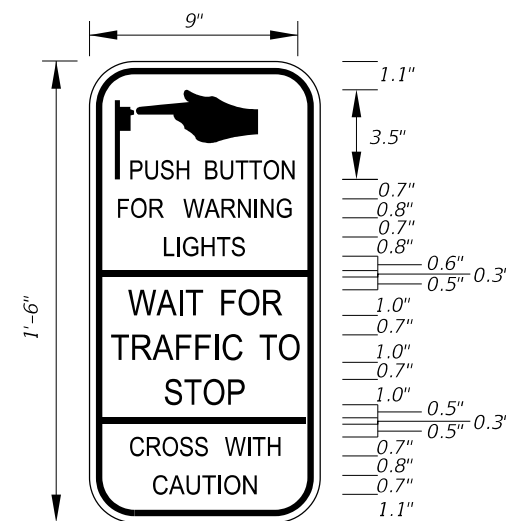

**FTP-68C-21**  
 9" X 1'-6"  
 1.5" Radii 1/4" Border  
 Series D Legend  
 White Background  
 Black Legend and Border

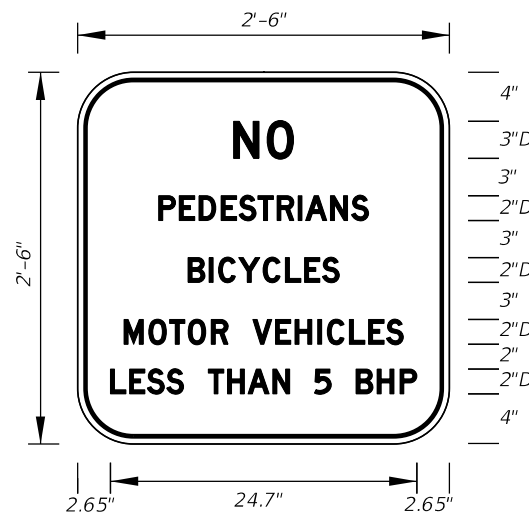

**FTP-69-06**  
 2'-6" X 2'-6"  
 4" Radii 3/4" Border  
 2" and 3" Series D Legend  
 White Background  
 Black Legend and Border

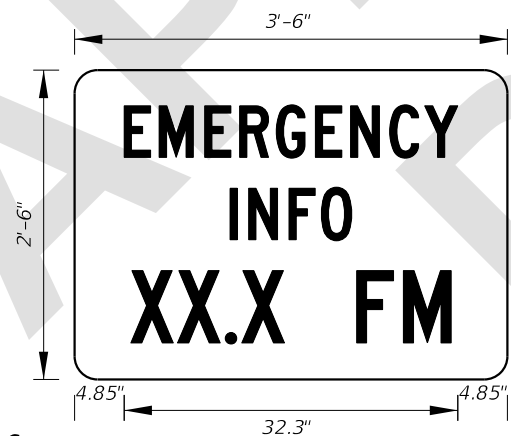

**FTP-70-06**  
 3'-6" X 2'-6"  
 2.25" Radii 3/4" Border  
 5" Series C and 7" Series C Legend  
 Blue Background  
 White Legend and Border



**FTP-71-06**  
 4' X 4'  
 2" Radii 3/4" Border  
 8" Series C Legend  
 Yellow Background  
 Black Legend and Border



**FTP-72-06**  
 3' X 3'  
 2" Radii 3/4" Border  
 6" Series C Legend  
 Yellow Background  
 Black Legend and Border

8/15/2024 2:49:01 PM




FY 2025-26  
 STANDARD PLANS

SPECIAL SIGN DETAILS

INDEX  
 700-102


SHEET  
 8 of 12

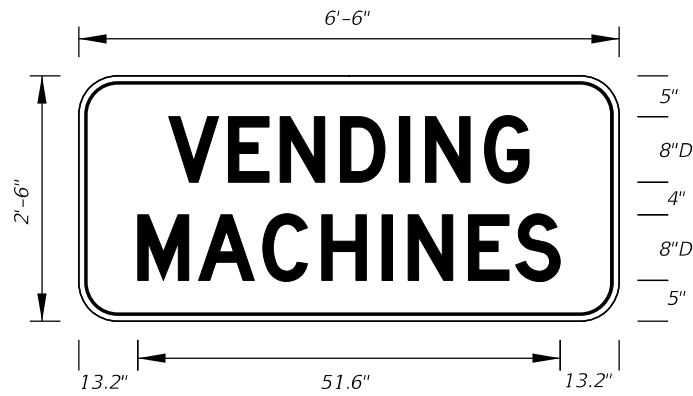


**FTP-73-06**  
6'-6" X 2'-6"  
4" Radii 3/4" Border  
8" Series D Legend  
Blue Background  
White Legend and Border




**FTP-74-06**  
6'-6" X 2'-6"  
4" Radii 3/4" Border  
6" Series D Legend  
Blue Background  
White Legend and Border

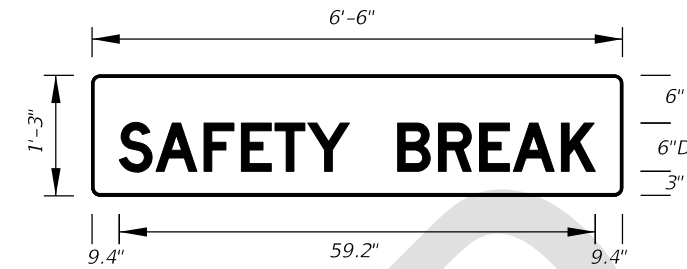


**FTP-75-06**  
6'-6" X 1'-3"  
1" Radii  
6" Series D Legend  
Blue Background  
White Legend

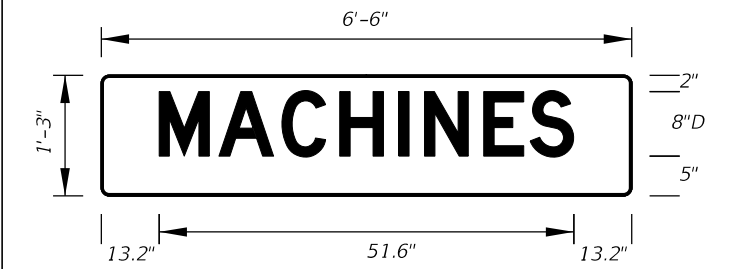


**FTP-76-06**  
6'-6" X 1'-3"  
1" Radii  
8" Series D Legend  
Blue Background  
White Legend

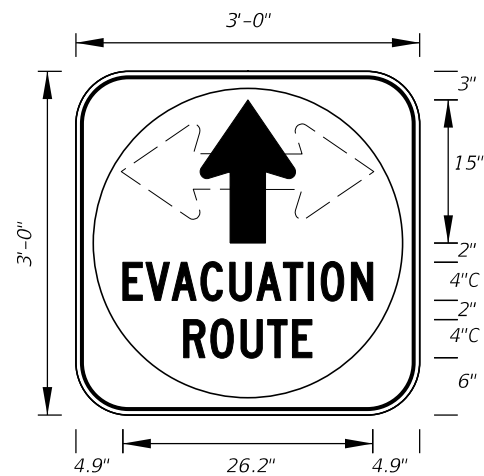


**FTP-77-06**  
3' X 3'  
5" Radii 3/4" Border  
4" Series C Legend  
White Background with Blue Circle Background  
White Legend and Black Border

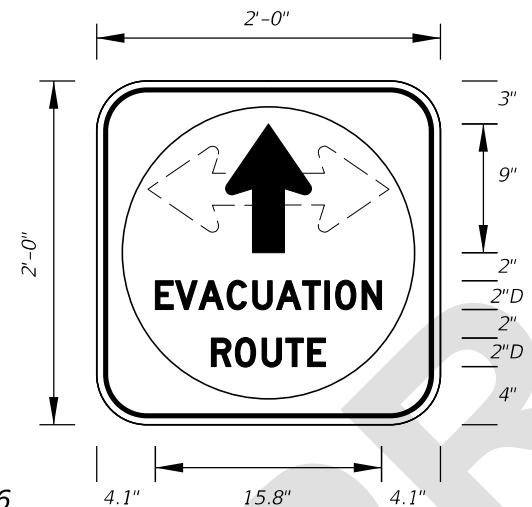


**FTP-78-06**  
2' X 2'  
3" Radii 3/4" Border  
2" Series D Legend  
White Background with Blue Circle Background  
White Legend and Black Border

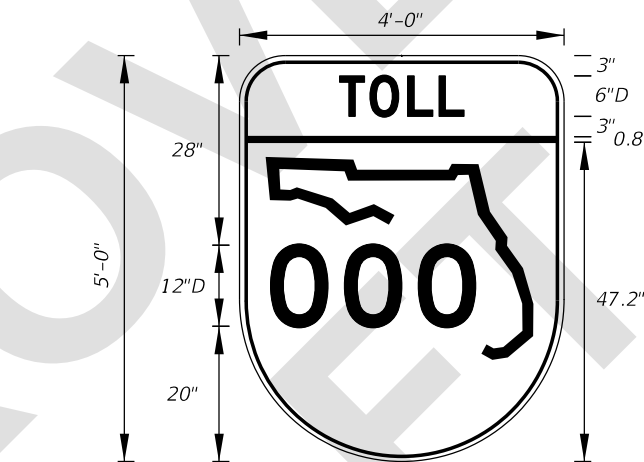


**FTP-79-06**  
4' X 5'  
6" Radii 3/4" Border  
6" and 12" Series D Legend  
Top Yellow Background with Black Legend and Black Border  
Bottom White Background with Black Legend and Border

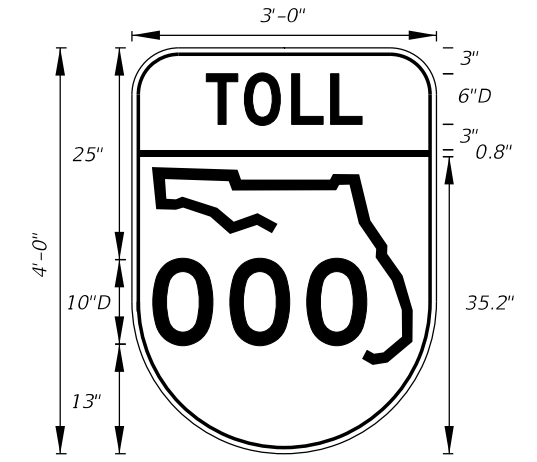

**FTP-80-06**  
3' X 4'  
5" Radii 3/4" Border  
6" and 10" Series D Legend  
Top Yellow Background with Black Legend and Black Border  
Bottom White Background with Black Legend and Border

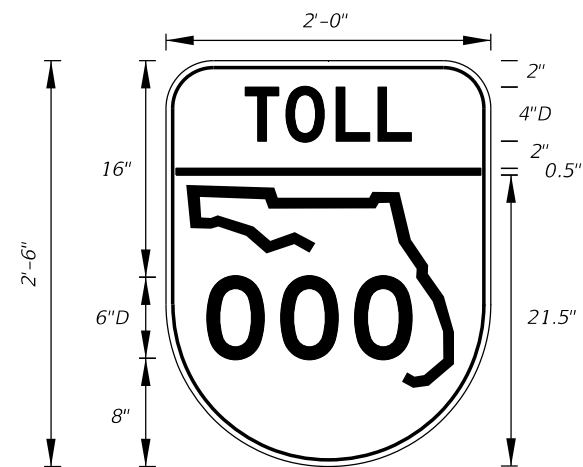

**FTP-81-06**  
2' X 2'-6"  
3" Radii 3/4" Border  
4" and 6" Series D Legend  
Top Yellow Background with Black Legend and Black Border  
Bottom White Background with Black Legend and Border

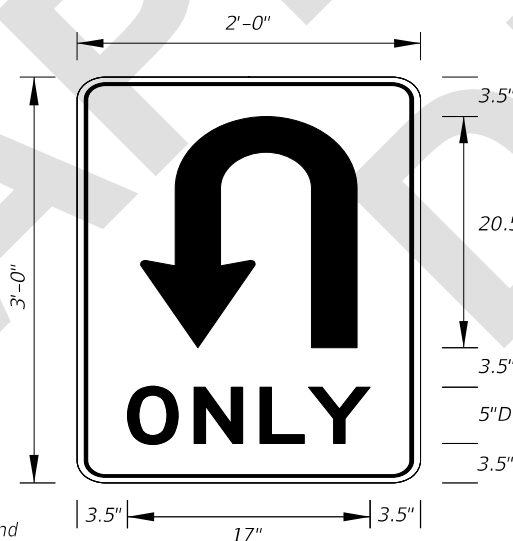

**FTP-82-08**  
2' X 3'  
1.5" Radii  
5" Series D Legend  
White Background  
Black Legend and Border


ARROW HEAD

A	3.125
B	3.625
C	6.375
D	.5
E	.625

ARROW BODY

A	B	C	D	E	F	G
6.25	3.125	3.125	3.125	5	9.25	20.5


**FTP-82-08**  
Details

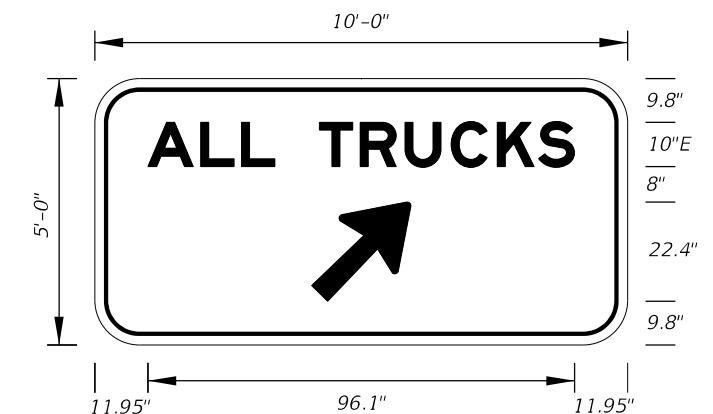


**FTP-83-08**  
10'-0" X 5'-0"  
8" Radii  
10" Series E Legend  
Green Background  
White Legend

8/16/2024 10:42:26 AM


LAST REVISION 11/01/24	DESCRIPTION:
---------------------------	--------------

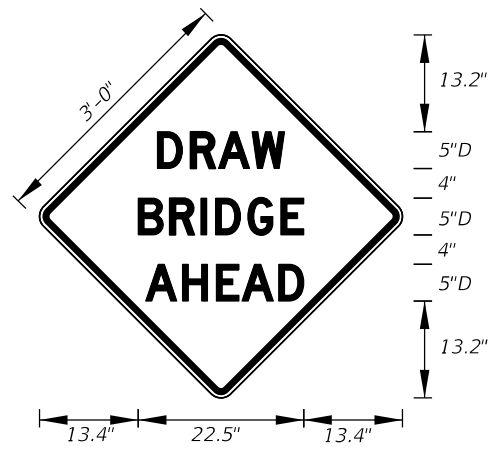

**FTP-84-09**  
3' X 3'  
1.5" Radii  
5" Series D Legend  
Yellow Background  
Black Legend and Border

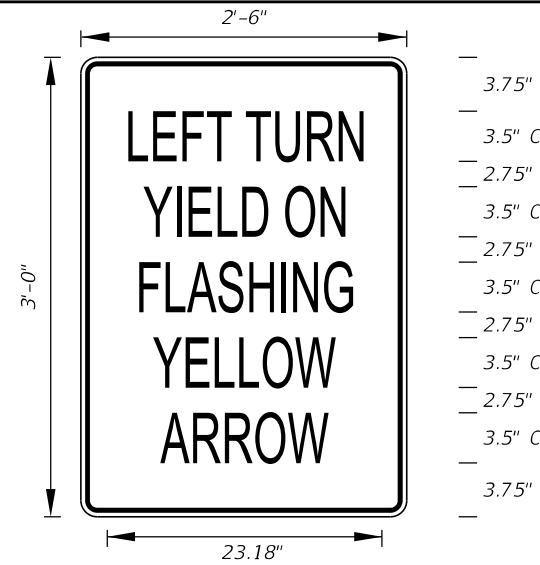


**FTP-85-13**  
2'-6" X 3'  
1.875" Radii 3/4" Border  
3.5" Series C Legend  
White Background  
Black Legend and Border

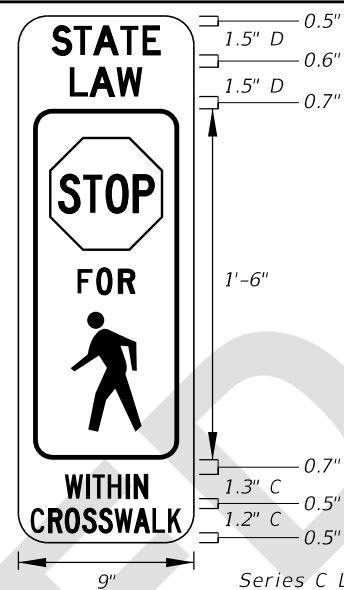

**FTP-86-21**  
9" X 2'-3"  
1.5" Radii No Border  
Series C Legend and Series D Legend  
White on Yellow  
Black Legend and Border



**FTP-87-21**  
15'-6" X 8'-6"  
12" Radii 2" Border  
Series D Legend  
Series EM Legend  
Blue Background  
White Legend and Border

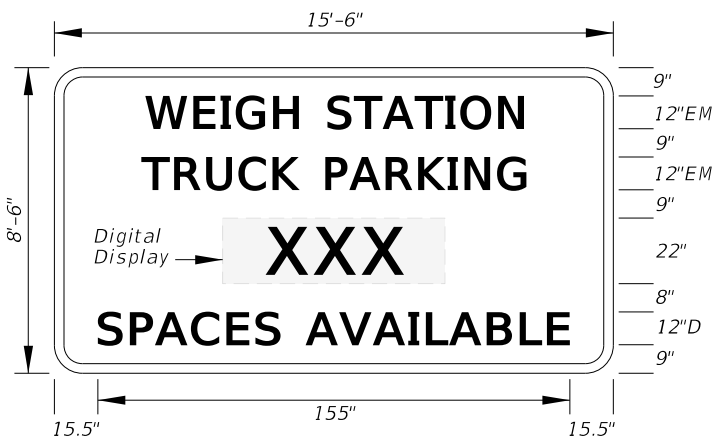


**FTP-88-21**  
15'-6" X 8'-6"  
12" Radii 2" Border  
Series D Legend  
Series EM Legend  
Blue Background  
White Legend and Border




**FTP-89-21**  
16'-6" X 8'-6"  
12" Radii 2" Border  
Series D Legend  
Series EM Legend  
Blue Background  
White Legend and Border



**FTP-90-22**  
3'-0" X 3'-0"  
1.5" Radii 3/4" Border  
3" Series C Legend and 5" Series D Legend  
White Background  
Black Legend and Border

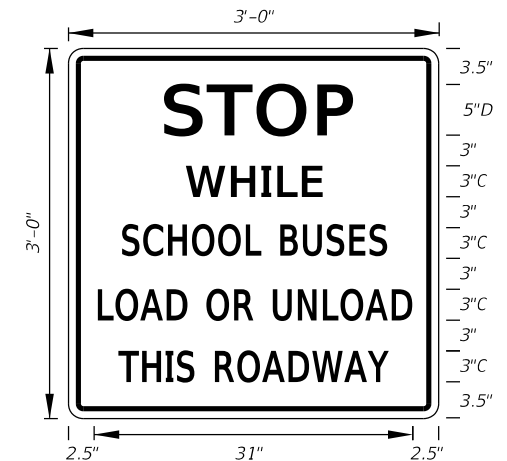


**FTP-91-22**  
3'-0" X 3'-0"  
1.5" Radii 3/4" Border  
3" Series C Legend and 5" Series D Legend  
White Background  
Black Legend and Border

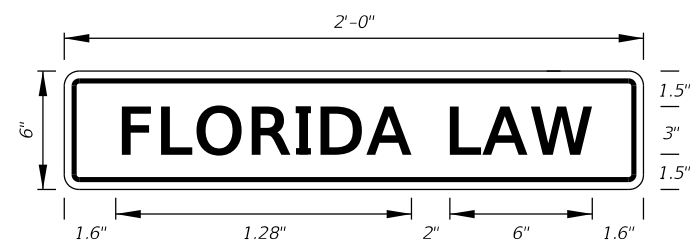


**FTP-100-25**  
2'-0" X 6"  
1.5" Radii  
0.4" Border  
0.4" Indent  
3" Series C Legend and Bright Yellow Green Background  
Black Legend and Border


APPROVED

8/15/2024 1:21:12 PM


LAST REVISION 11/01/24	DESCRIPTION:	 FY 2025-26 STANDARD PLANS	SPECIAL SIGN DETAILS	INDEX 700-102	SHEET 10 of 12
---------------------------	--------------	--	----------------------	------------------	-------------------

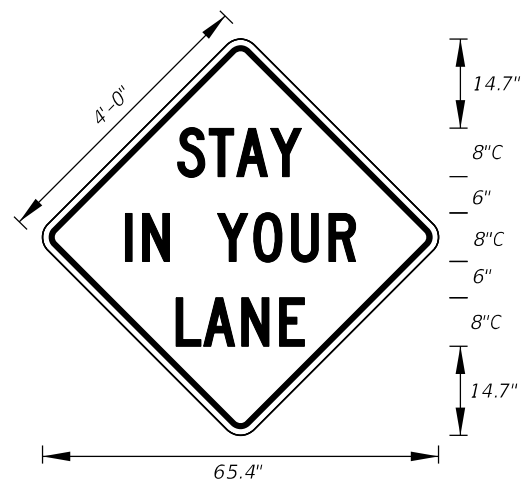


**MOT-1-22**  
4' X 4'  
3" Radii 3/4" Border  
8" Series C Legend  
Orange Background  
Black Legend and Border

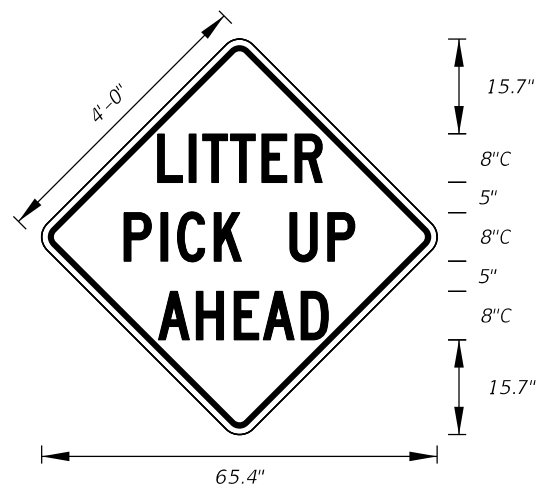


**MOT-4-22**  
4' X 4'  
3" Radii 3/4" Border  
8" Series C Legend  
Orange Background  
Black Legend and Border

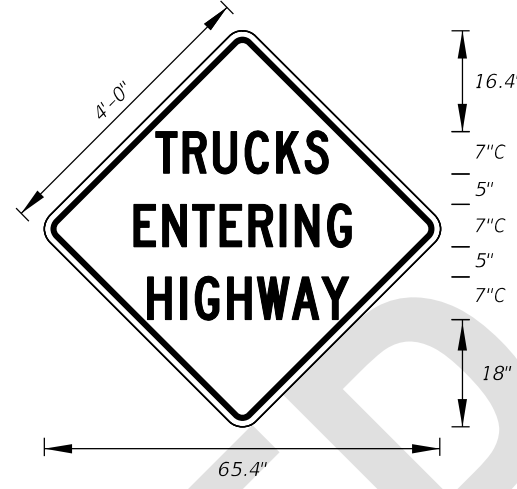


**MOT-5-22**  
4' X 4'  
3" Radii 3/4" Border  
7" Series C Legend  
Orange Background  
Black Legend and Border

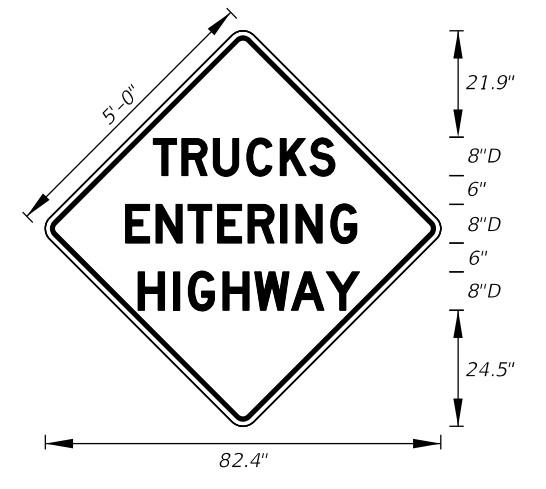


**MOT-6-22**  
5' X 5'  
3" Radii 3/4" Border  
8" Series D Legend  
Orange Background  
Black Legend and Border

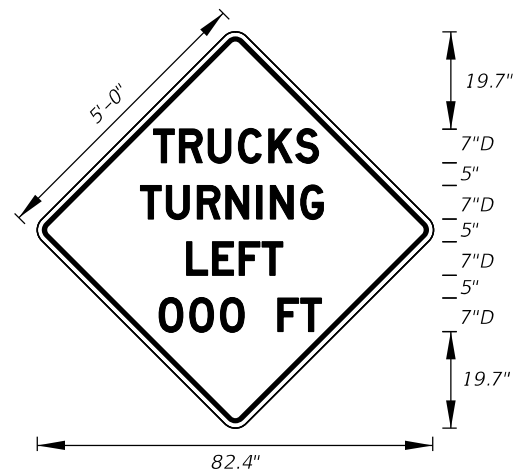


**MOT-7-22**  
5' X 5'  
3" Radii 3/4" Border  
7" Series D Legend  
Orange Background  
Black Legend and Border

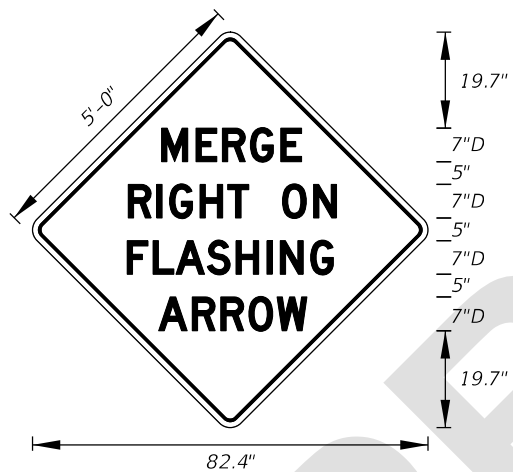


**MOT-8-22**  
5' X 5'  
3" Radii 3/4" Border  
7" Series D Legend  
Orange Background  
Black Legend and Border

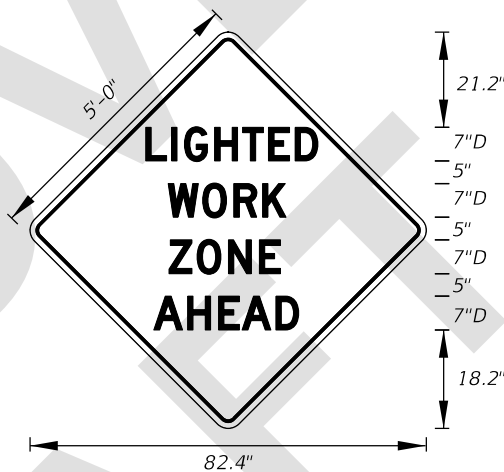

**MOT-9-22**  
5' X 5'  
3" Radii 3/4" Border  
7" Series D Legend  
Orange Background  
Black Legend and Border

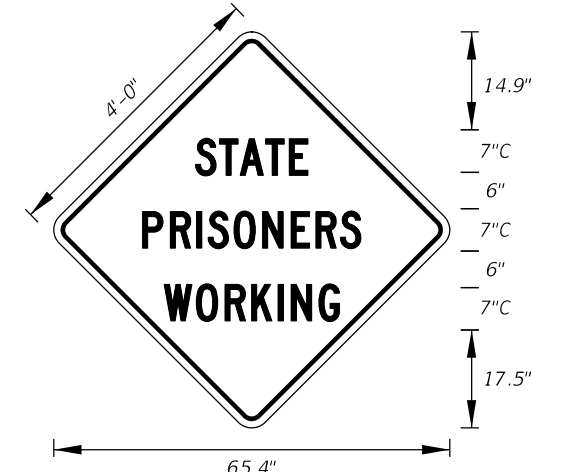

**MOT-10-22**  
4' X 4'  
3" Radii 3/4" Border  
7" Series C Legend  
Orange Background  
Black Legend and Border

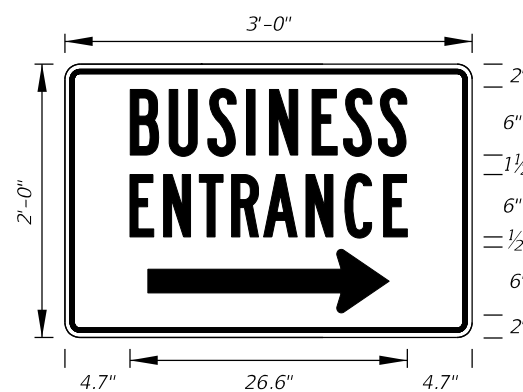


**MOT-11-06**  
3' X 2'  
2" Radii 3/4" Border  
6" Series B Legend  
Blue Background  
White Legend and Border




**MOT-12R-06**  
2' X 1'  
2" Radii 3/4" Border  
2" Series B Legend  
White Background  
Black Legend and Border

**MOT-12L-06**  
For Diversion  
to the left

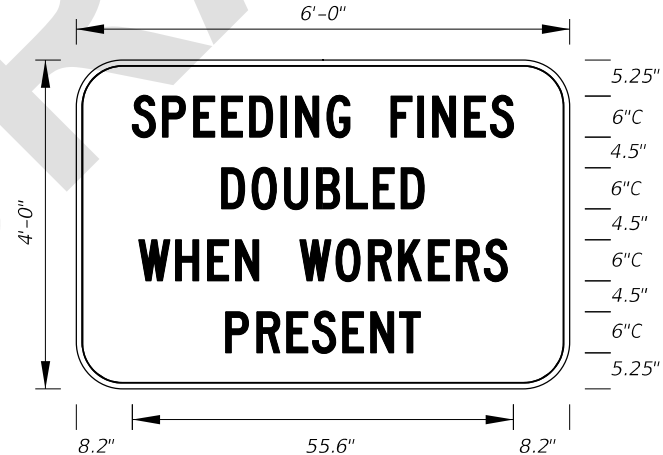


**MOT-13-06**  
Freeway Sign  
6' X 4'  
6" Radii 3/4" Border  
6" Series C Legend  
White Background  
Black Legend and Border

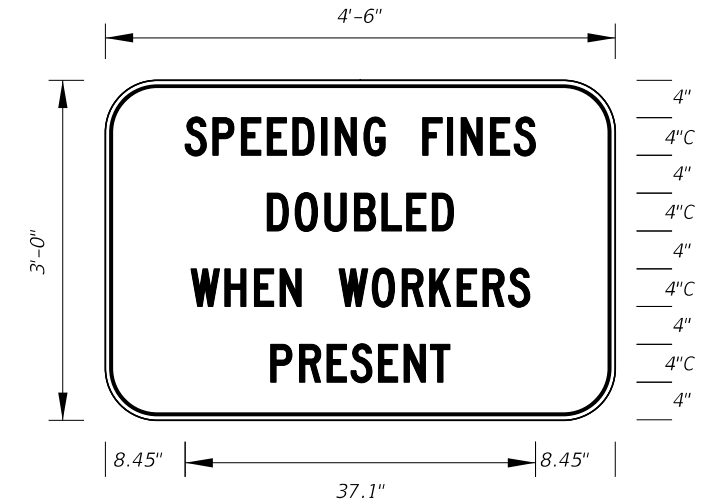


**MOT-14-06**  
Arterial Sign  
4'-6" X 3'  
5" Radii 3/4" Border  
4" Series C Legend  
White Background  
Black Legend and Border

8/15/2024 1:21:20 PM


LAST REVISION	DESCRIPTION:
11/01/24	

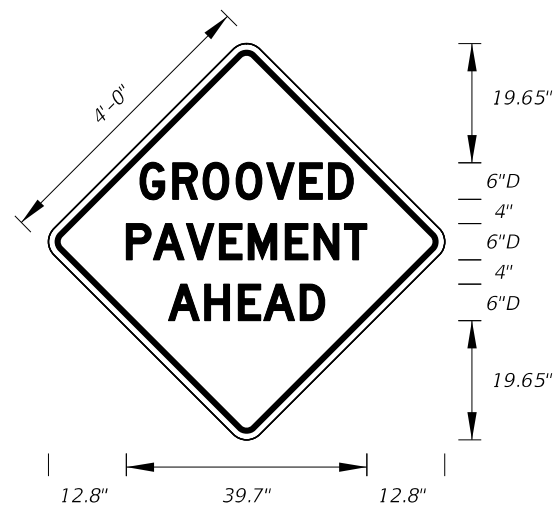


**MOT-15-06**  
4' X 4'  
2" Radii 3/4" Border  
6" Series D Legend  
Orange Background  
Black Legend and Border

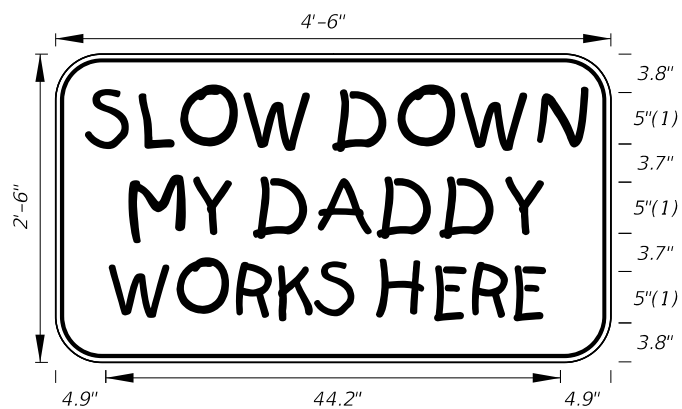


**MOT-16-06**  
4'-6" X 2'-6"  
4" Radii 3/4" Border  
5" Kids Series Legend  
Orange Background  
Black Legend and Border

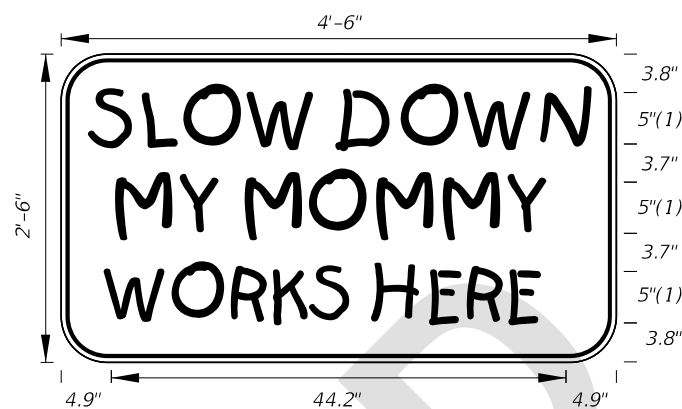


**MOT-17-06**  
4'-6" X 2'-6"  
4" Radii 3/4" Border  
5" Kids Series Legend  
Orange Background  
Black Legend and Border

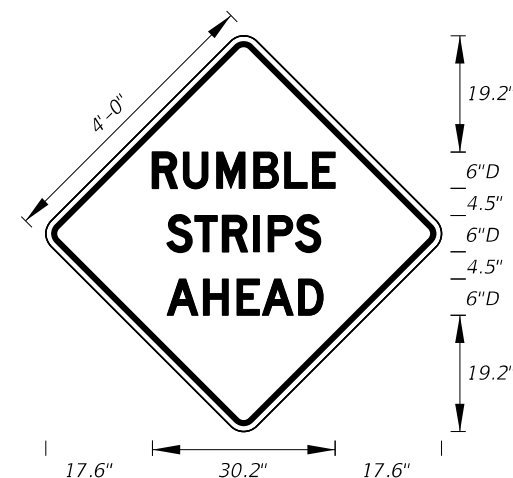


**MOT-18-10**  
4' X 4'  
2" Radii 3/4" Border  
6" Series D Legend  
Orange Background  
Black Legend and Border

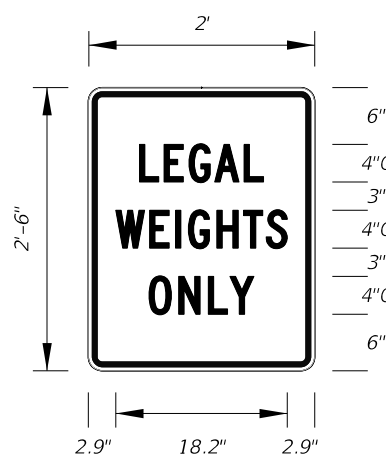


**MOT-19-11**  
2' X 2'-6"  
1.13" Radii 3/4" Border  
4" Series C Legend  
White Background  
Red Legend and Border

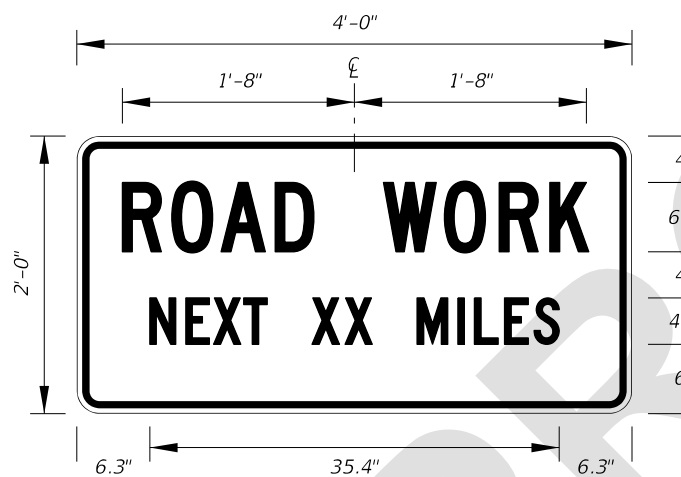


**G20-1**  
4' X 2'  
1.5" Radii 3/4" Border  
Orange Background  
Black Legend and Border

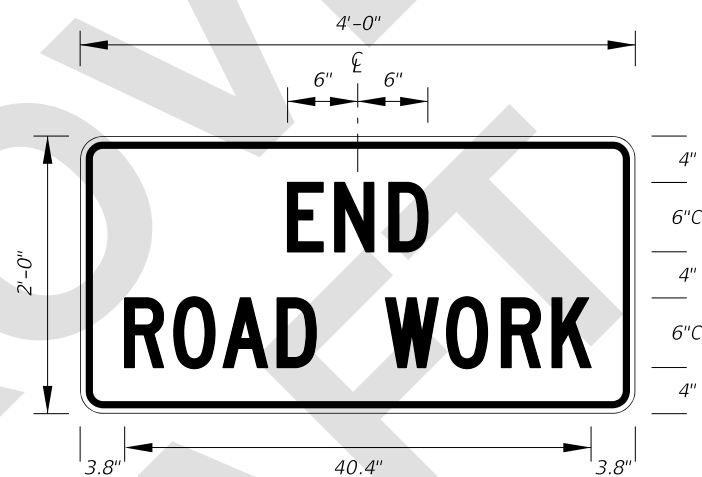


**G20-2**  
4' X 2'  
1.5" Radii 3/4" Border  
Orange Background  
Black Legend and Border

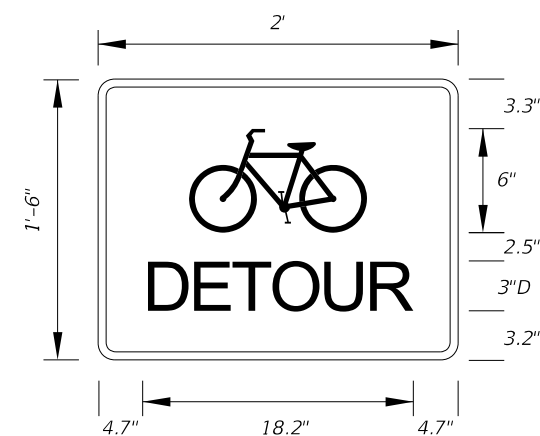

**MOT-21-21**  
2' X 1'-6"  
1.5" Radii 1/2" Border  
3" Series D Legend  
Orange Background  
Black Legend and Border

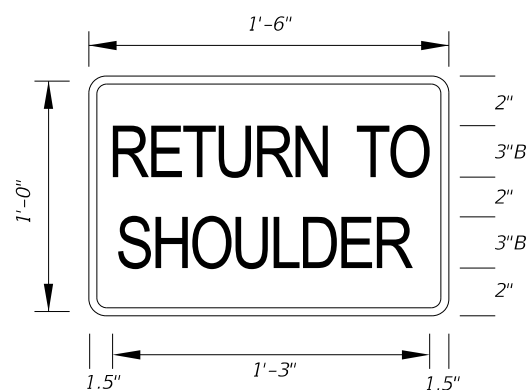

**MOT-23-21**  
1'-6" X 1'-0"  
1.5" Radii 1/4" Border  
3" Series B Legend  
Orange Background  
Black Legend and Border

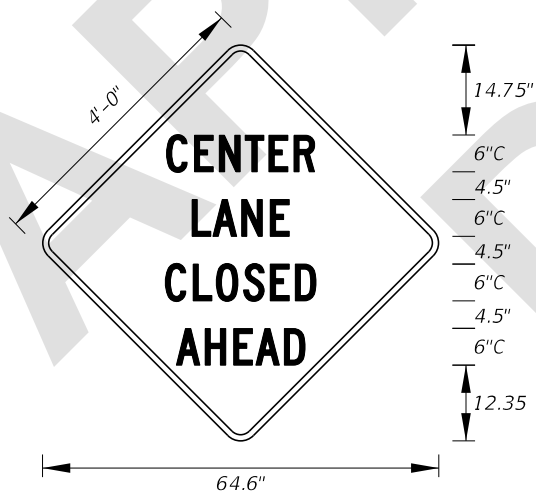

**MOT-27-25**  
4' X 4'  
3" Radii 5/4" Border  
6" Series C Legend  
Orange Background  
Black Legend and Border

8/15/2024 1:21:29 PM

LAST REVISION 11/01/24	DESCRIPTION:
---------------------------	--------------