

Origination Form

Proposed Revisions to a Standard Plans Index

Originator:	Portal, Benazir	Index Number:	700-102
Date:	7/22/2024	Sheet Number(s):	6, 8, 9, 10, and 12
E-mail:	Benazir.Portal@dot.state.fl.us	Index Title:	SPECIAL SIGN DETAILS

Summary of the changes:

Sheet 6: Added FTP-45-25

Sheet 8: Updated the width of FTP-73-06 to 6'-6"; Updated FTP-68A-06 and FTP-68B-06 symbology, spacing, and MUTCD reference

Sheet 9: Updated the width of FTP-74-06, FTP-75-06, and FTP 76-06 to 6'-6"

Sheet 10: Added FTP-100-25

Sheet 12: Deleted MOT-20-21, MOT-22-21, MOT-24-21, MOT-25-21, MOT-26A-22, and MOT-26B-22; Added MOT-27-25

Sheet 6-12: Shifted Signs to accommodate new signs

Commentary/Background:

The 11th edition of the MUTCD now includes Work Zone Bike Warning Signs, which means some MOT signs shown in Index 700-102 can be deleted. Additionally, the 11th edition of the MUTCD includes Temporary Traffic Control Typical Applications for Work in the Vicinity of Bicycle Lanes and Shared Use Paths, which specify what warning signs need to be used and where they should be placed. Consequently, the "BIKE LANE CLOSED AHEAD" plaques (MOT-24-21, MOT-25-21) will no longer be used.

The depictions of FTP-68A-06 and FTP-68B-06 are being updated to more closely depict R10-3f and R10-3i in the MUTCD 11th Edition.


Other Affected Documents/Offices	Person Contacted	Affected (Yes/No)
Other Standard Plans		No
FDOT Design Manual		No
Standard Specifications		No
Basis of Estimates Manual		No
Approved Product List		No
Construction Office		No
Maintenance Office		No

Implementation


["FY-Standard Plans (Next Release)"]




FTP-41-21
2'-6" X 3'
4" Radii 3/4" Border
2" and 4" Series C Legend
White Background
Black Legend and Border

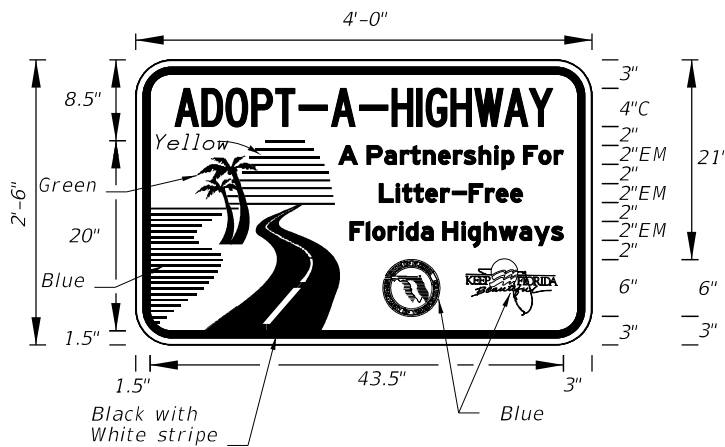


FTP-42-06
4' X 2'-6"
3" Radii
Top 4" Series C Legend
Bottom 2" Series EM Legend
White Background
Blue Legend and Border

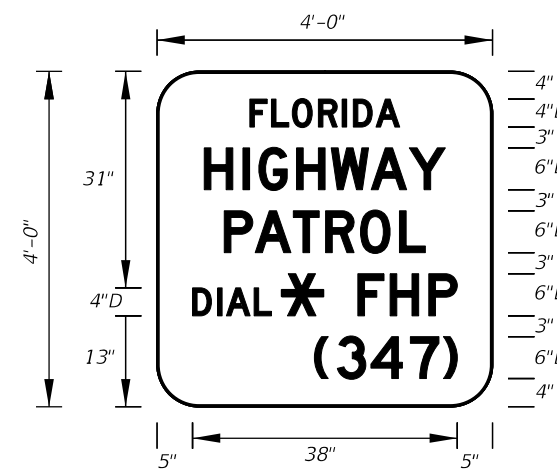


FTP-43-06
4' X 4'
6" Radii 1" Border
Top 4" Series D Legend
Bottom 6" Series D Legend
Blue Background
White Legend and Border

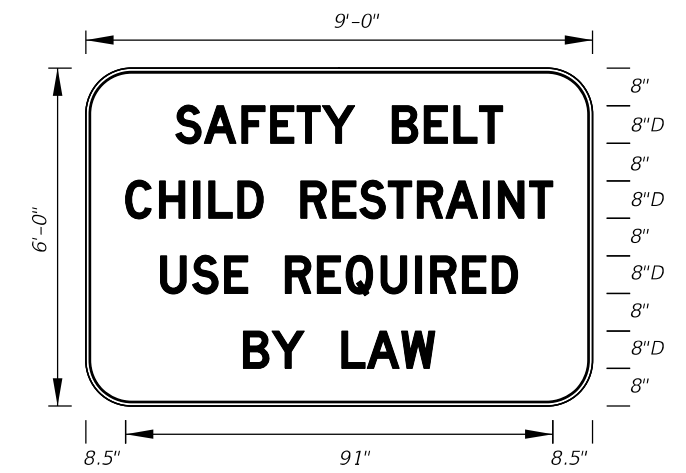



FTP-44-06
9' X 6'
9" Radii 3/4" Border
8" Series D Legend
White Background
Black Legend and Border

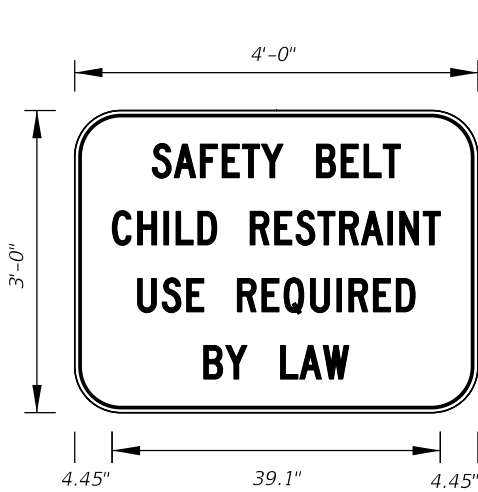


FTP-44A-25
~~FTP-45-06~~
4' X 3'
5" Radii 3/4" Border
4" Series C Legend
White Background
Black Legend and Border

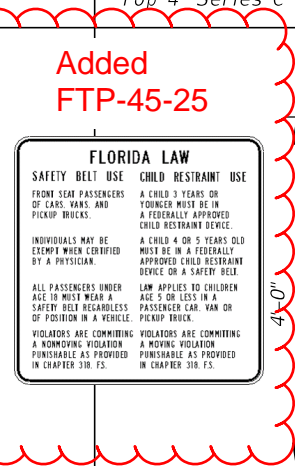


FTP-45-25
3' X 4'
5" Radii 3/4" Border
3" Series D Legend
White Background
Green Florida Symbol
Black Legend, Border and Man Belt Symbol

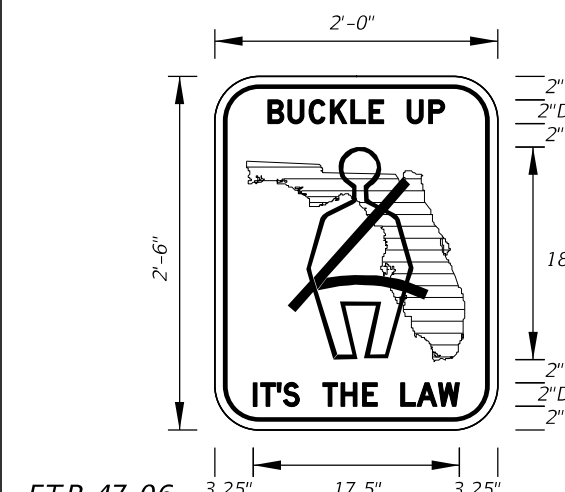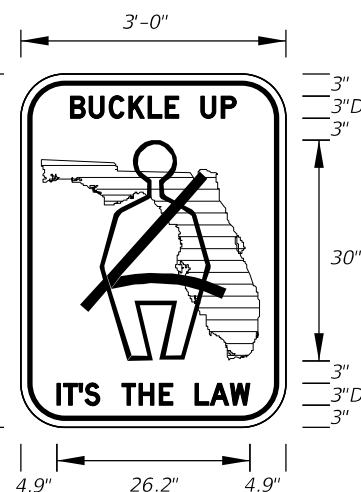


FTP-47-06
2' X 2'-6"
3" Radii 5/8" Border
2" Series D Legend
White Background
Green Florida Symbol
Black Legend, Border and Man Belt Symbol

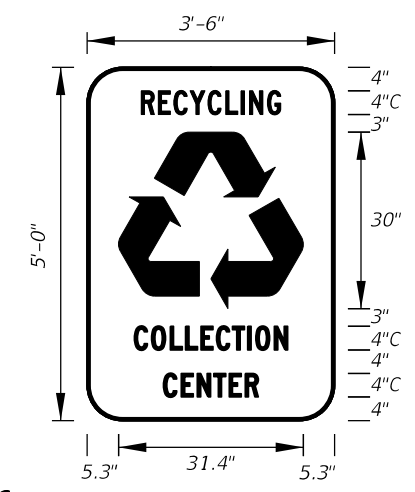


FTP-48-06
3'-6" X 5'
6" Radii
4" Series C Legend
Green Background
White Legend, Border and Symbol
MOVED to Sheet 7

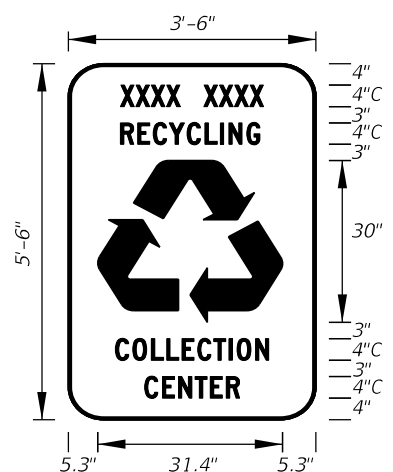


FTP-49-06
3'-6" X 5'-6"
6" Radii
4" Series C Legend
Green Background
Municipality Name Optional
White Legend, Border and Symbol

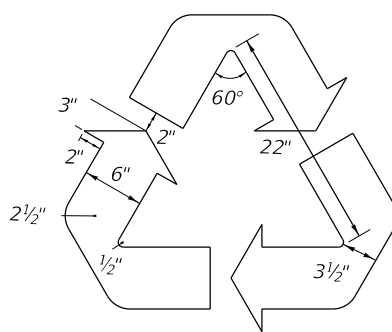

Detail for **FTP-48-06** and **FTP-49-06**

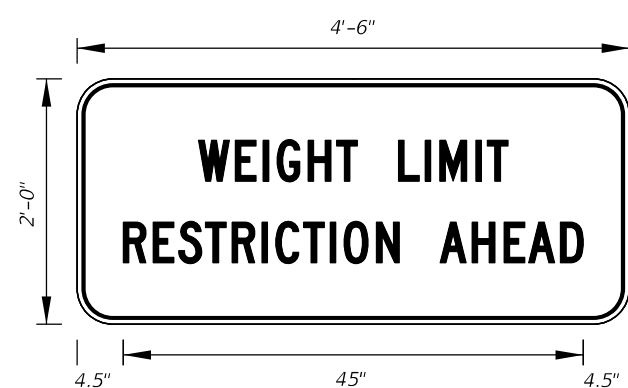


FTP-50-06
4'-6" X 2'
3" Radii 3/4" Border
4" Series C Legend
Yellow Background
Black Legend and Border

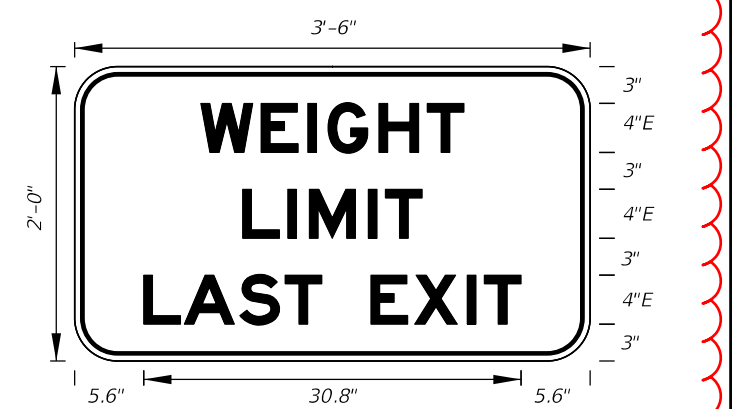


FTP-51-06
3' X 2'
3" Radii 3/4" Border
4" Series E Legend
White Background
Black Legend and Border

10/3/2023 3:09:30 PM


LAST REVISION	DESCRIPTION:
11/01/21	
11/01/24	

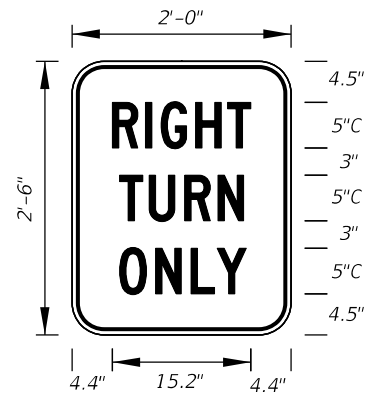


FTP-52-06
2' X 2'-6"
3" Radii 5/8" Border
5" Series C Legend
White Background
Black Legend and Border

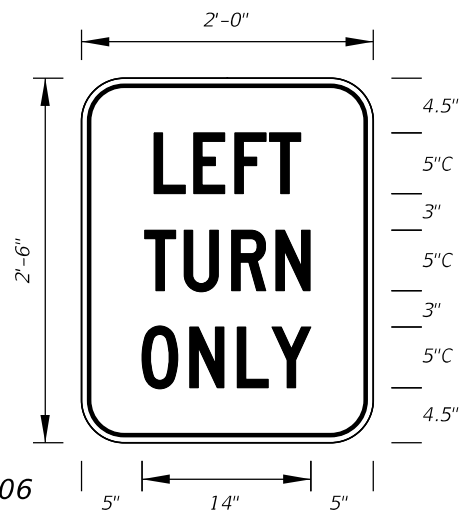


FTP-53-06
2' X 2'-6"
3" Radii 5/8" Border
5" Series C Legend
White Background
Black Legend and Border

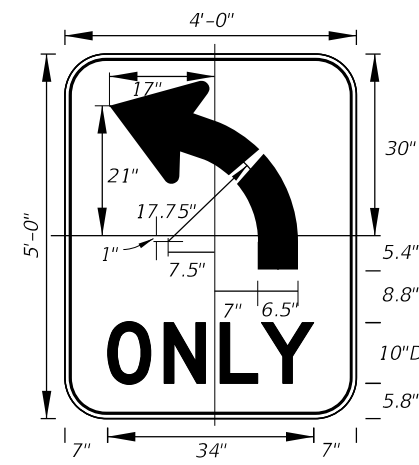


FTP-54L-06
4' X 5'
6" Radii 3/4" Border
10" Series D Legend
White Background
Black Legend and Border
FTP-54R-06 for
(Right Turn Arrow)

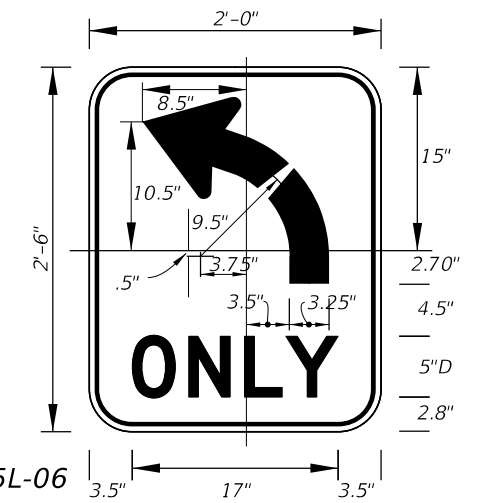


FTP-55L-06
2' X 2'-6"
3" Radii 3/8" Border
5" Series D Legend
White Background
Black Legend and Border
FTP-55R-06 for
(Right Turn Arrow)

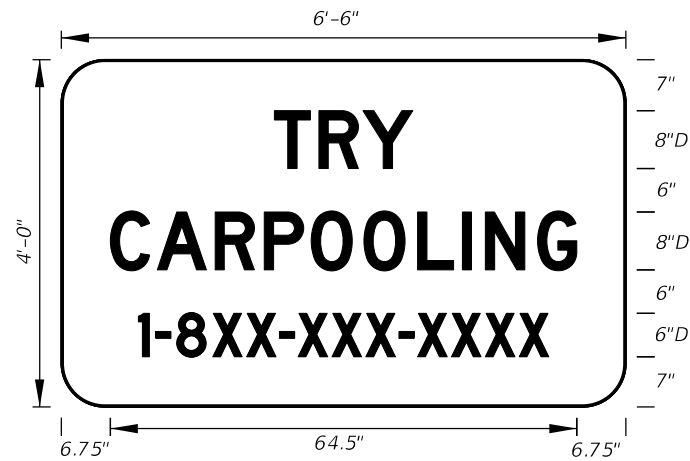


FTP-56-06
6'-6" X 4'
6" Radii 3/4" Border
8" and 6" Series D Legend
Blue Background
White Legend and Border
Design Project Manager
or Transit Administrator
will supply correct 1-8XX
number.

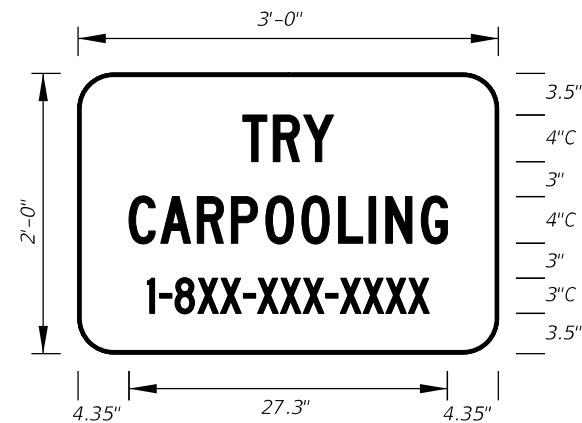


FTP-56A-06
3' X 2'
3" Radii
4" and 3" Series C Legend
Blue Background
White Legend and Border
Design Project Manager
or Transit Administrator
will supply correct 1-8XX
number.

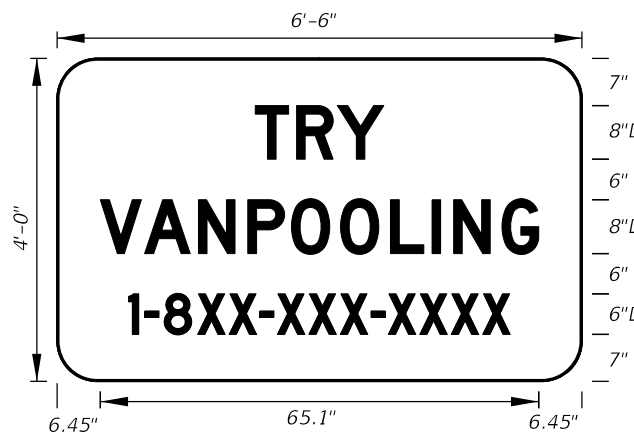


FTP-57-06
6'-6" X 4'
6" Radii
8" and 6" Series D Legend
Blue Background
White Legend and Border
Design Project Manager
or Transit Administrator
will supply correct 1-8XX
number.

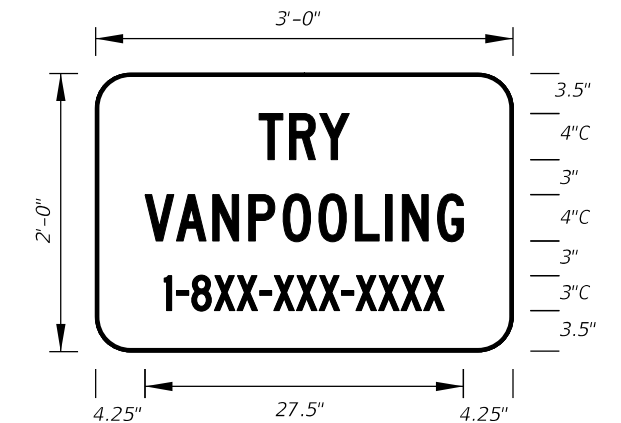


FTP-58-06
3' X 2'
3" Radii
4" and 3" Series C Legend
Blue Background
White Legend and Border
Design Project Manager
or Transit Administrator
will supply correct 1-8XX
number.

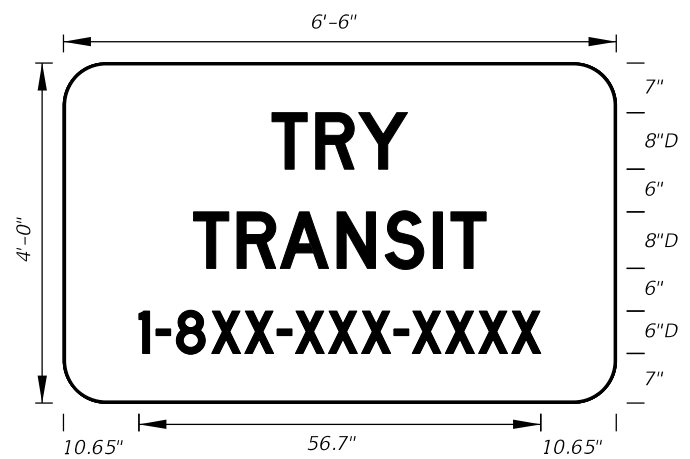

FTP-59-06
6'-6" X 4'
6" Radii
8" and 6" Series D Legend
Blue Background
White Legend and Border
Design Project Manager
or Transit Administrator
will supply correct 1-8XX
number.

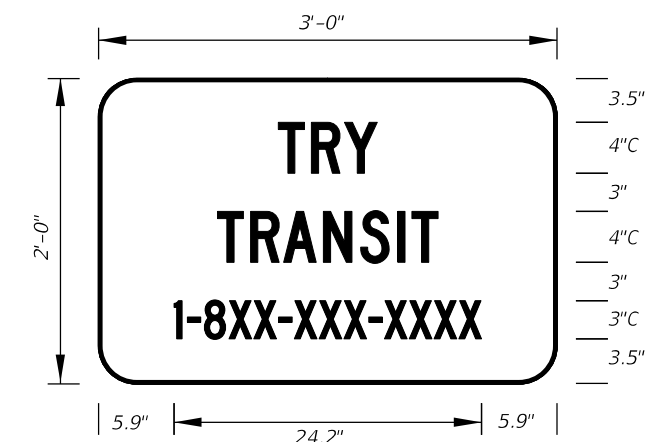


FTP-60-06
3' X 2'
3" Radii
4" and 3" Series C Legend
Blue Background
White Legend and Border
Design Project Manager
or Transit Administrator
will supply correct 1-8XX
number.

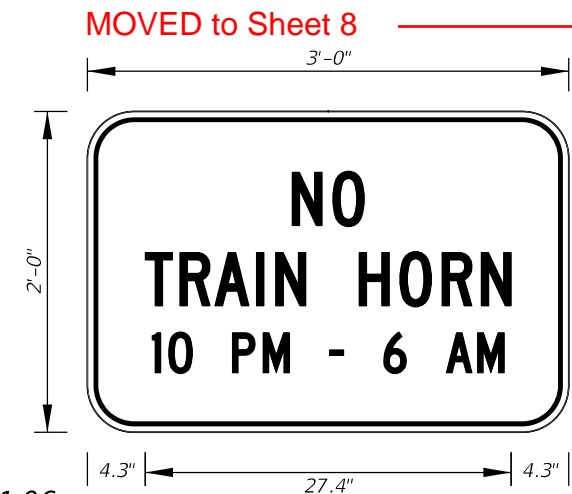

FTP-61-06
3' X 2'
3" Radii 3/4" Border
4" and 3" Series C Legend
Yellow Background
Black Legend and Border

MOVED to Sheet 8

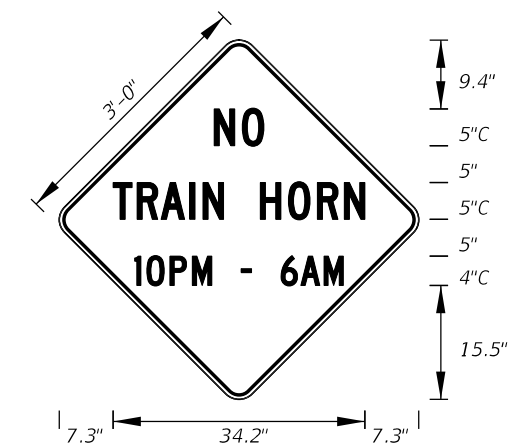

FTP-62-06
3' X 3'
2" Radii 3/4" Border 4" and 5" Series C Legend
Yellow Background Black Legend and Border

10/3/2023 3:09:38 PM


LAST REVISION	DESCRIPTION:
11/01/20	
11/01/24	



FY ~~2024-25~~ 2025-26
STANDARD PLANS

SPECIAL SIGN DETAILS

INDEX	SHEET
700-102	7 of 12

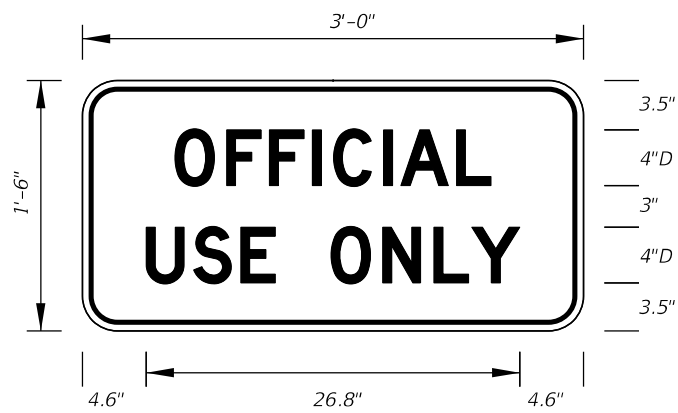

FTP-65-06
3' X 1'-6"
2" Radii 3/4" Border
4" Series D Legend
White Background
Black Legend and Border



FTP-66-21
4' X 5'
3" Radii 1" Border
6" Series D Legend
Blue Background
White Legend and Border




FTP-67-21
5.5' X 6'
3" Radii 1" Border
8" Series D Legend
Blue Background
White Legend and Border



DETAIL for **FTP-66** AND **FTP-67**


Sign Mounting Holes Can Be Punched Or Field Drilled With No Obstruction To Text Or Symbols From Holes Or Bolts.

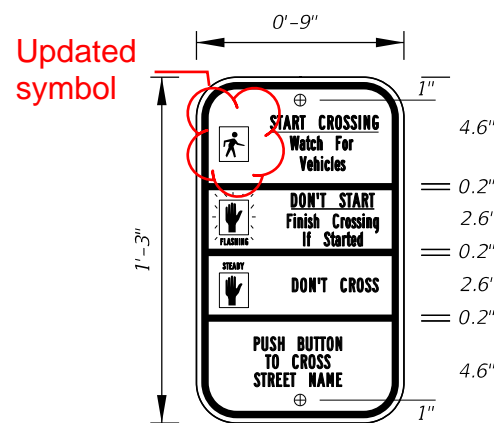

FTP-68A-06
9" X 1'-3"
1.5" Radii 3/4" Border
Series B Legend
White Background
Black Legend and Border

~~See Standard Highway Signs Manual, Sign R10-3b For Letter Size Spacing And Symbol Sizes.~~


See MUTCD R10-3f For Letter Size, Spacing, and Symbol Sizing and Color.

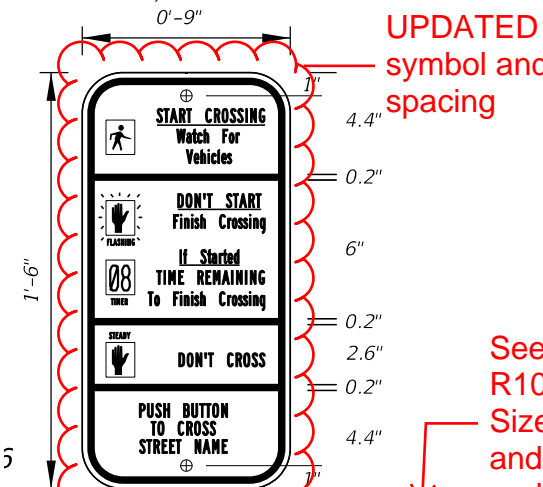

FTP-68B-06
9" X 1'-6"
1.5" Radii 3/4" Border
Series B Legend
White Background
Black Legend and Border


~~See Standard Highway Signs Manual, Sign R10-3b For Letter Size Spacing And Symbol Sizes.~~

See MUTCD R10-3i For Letter Size, Spacing, and Symbol Sizing and Color.

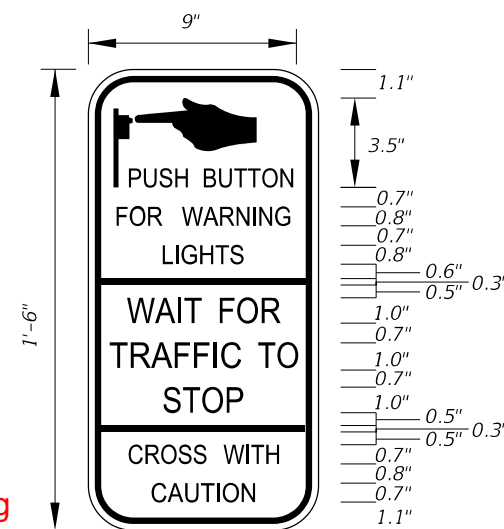

FTP-68C-06
9" X 1'-6"
1.5" Radii 1/4" Border

Series D Legend
White Background
Black Legend and Border

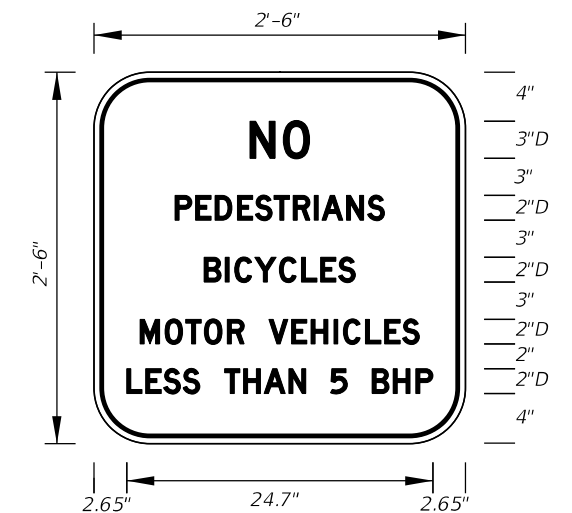

FTP-69-06
2'-6" X 2'-6"
4" Radii 3/4" Border


2" and 3" Series D Legend
White Background
Black Legend and Border



FTP-70-06
3'-6" X 2'-6"
2.25" Radii 3/4" Border
5" Series C and 7" Series C Legend
Blue Background
White Legend and Border




FTP-71-06
4' X 4'
2" Radii 3/4" Border
8" Series C Legend
Yellow Background
Black Legend and Border

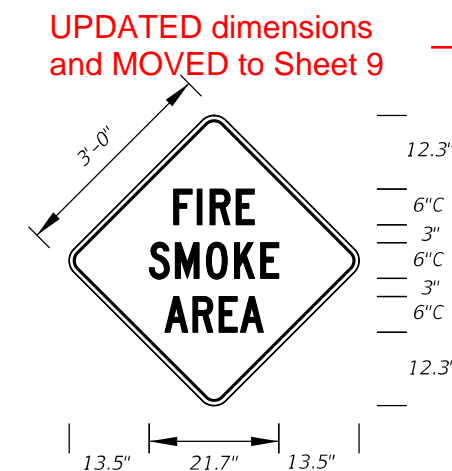

FTP-72-06
3' X 3'
2" Radii 3/4" Border

6" Series C Legend
Yellow Background
Black Legend and Border

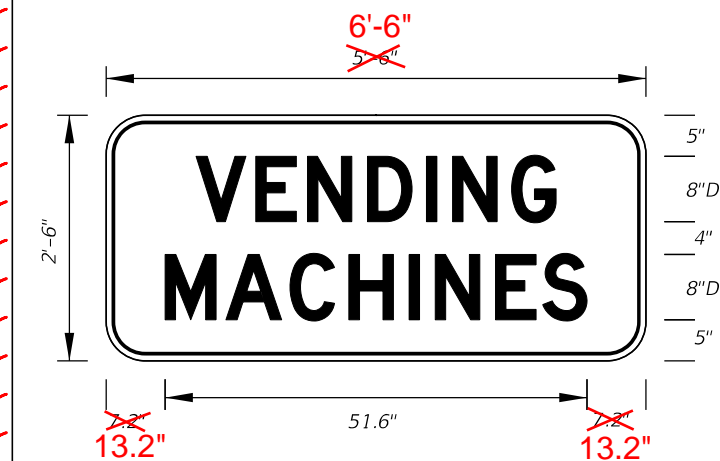

FTP-73-06
5'-6" X 2'-6"
2" Radii 3/4" Border

8" Series D Legend
Blue Background
White Legend and Border

6'-6" x 2'-6" to match above change

10/3/2023 3:09:45 PM

LAST REVISION	DESCRIPTION:
11/01/20	
11/01/24	




FY ~~2024-25~~ 2025-26
STANDARD PLANS

SPECIAL SIGN DETAILS


INDEX	SHEET
700-102	8 of 12




FTP-74-06
 5'-6" X 2'-6"
 4" Radii 3/4" Border
 6" Series D Legend
 Blue Background
 White Legend and Border

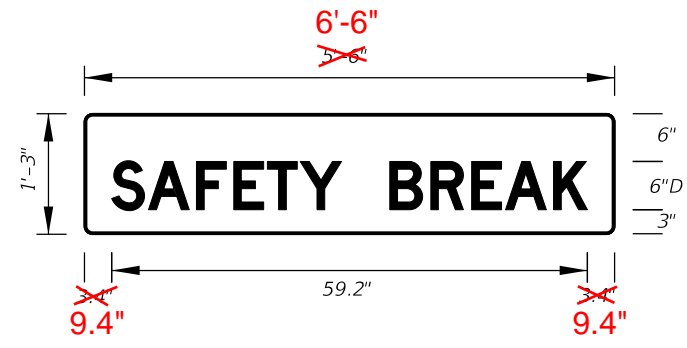


FTP-75-06
 5'-6" X 1'-3"
 1" Radii
 6" Series D Legend
 Blue Background
 White Legend

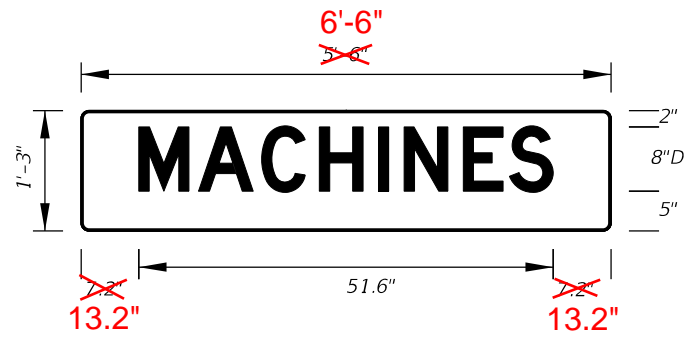


FTP-76-06
 5'-6" X 1'-3"
 1" Radii
 8" Series D Legend
 Blue Background
 White Legend

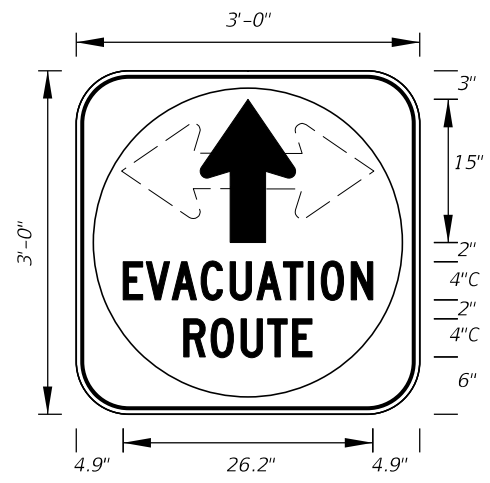

FTP-77-06
 3' X 3'
 5" Radii 3/4" Border
 4" Series C Legend
 White Background with Blue Circle Background
 White Legend and Black Border

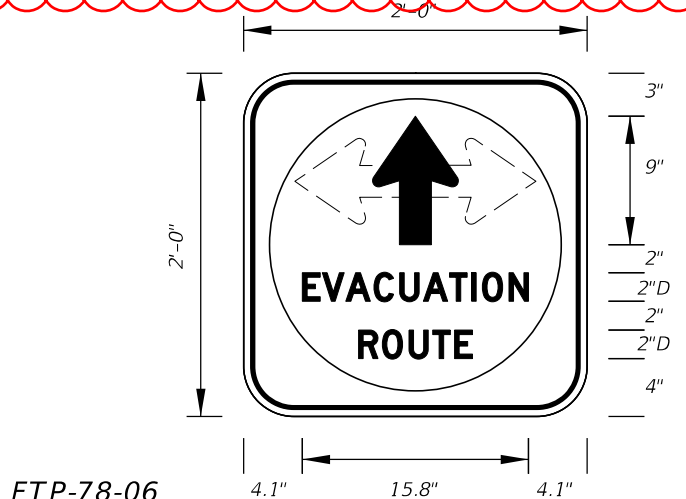


FTP-78-06
 2' X 2'
 3" Radii 3/4" Border
 2" Series D Legend
 White Background with Blue Circle Background
 White Legend and Black Border

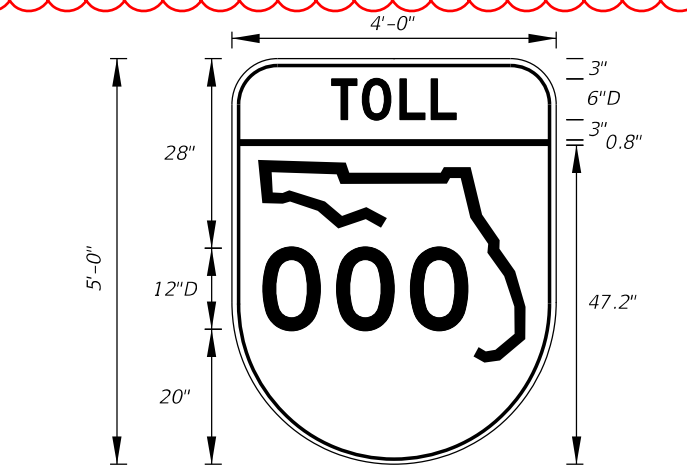


FTP-79-06
 4' X 5'
 6" Radii 3/4" Border
 6" and 12" Series D Legend
 Top Yellow Background with Black Legend and Black Border
 Bottom White Background with Black Legend and Border


UPDATED dimensions

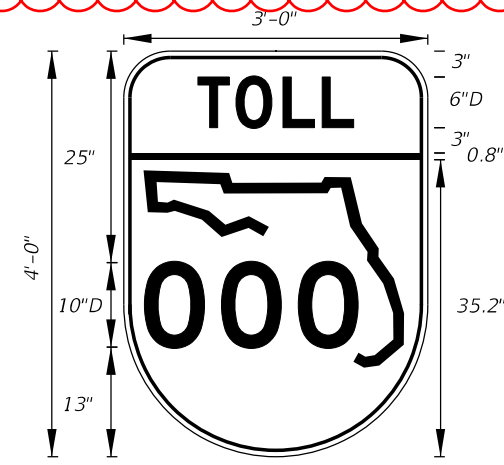


FTP-80-06
 3' X 4'
 5" Radii 3/4" Border
 6" and 10" Series D Legend
 Top Yellow Background with Black Legend and Black Border
 Bottom White Background with Black Legend and Border

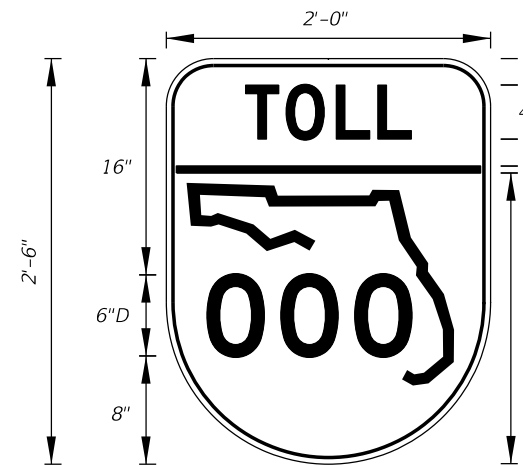

FTP-81-06
 2' X 2'-6"
 3" Radii 3/4" Border
 4" and 6" Series D Legend
 Top Yellow Background with Black Legend and Black Border
 Bottom White Background with Black Legend and Border

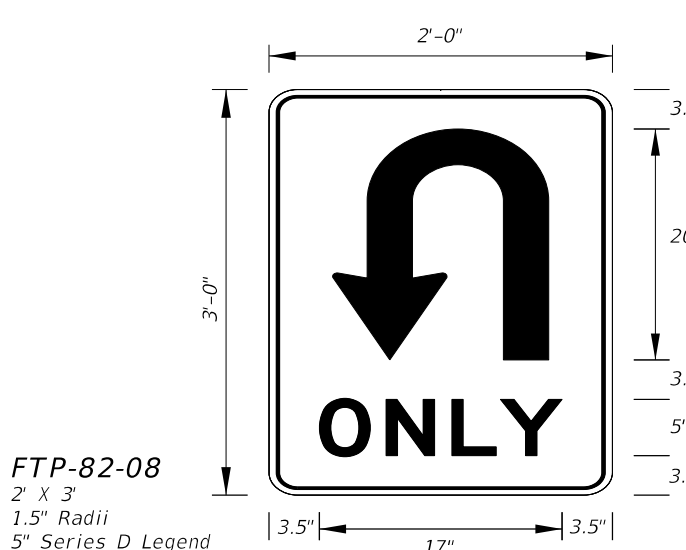

FTP-82-08
 2' X 3'
 1.5" Radii
 5" Series D Legend
 White Background
 Black Legend and Border

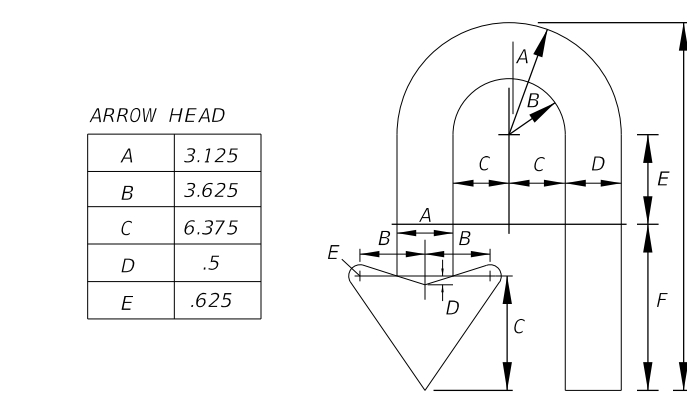


ARROW HEAD

A	3.125
B	3.625
C	6.375
D	.5
E	.625


ARROW BODY

A	B	C	D	E	F	G
6.25	3.125	3.125	3.125	5	9.25	20.5

FTP-82-08
 Details

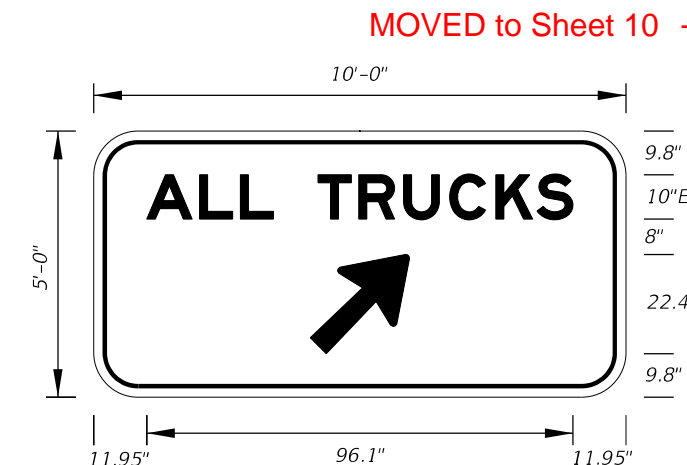

FTP-83-08
 10'-0" X 5'-0"
 8" Radii
 10" Series E Legend
 Green Background
 White Legend

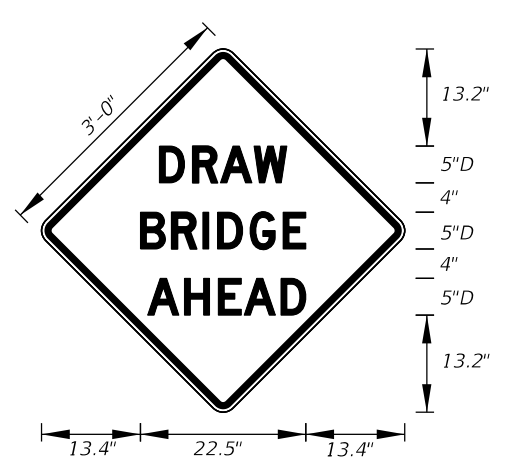

FTP-84-09
 3' X 3'
 1.5" Radii
 5" Series D Legend
 Yellow Background
 Black Legend and Border

10/3/2023 3:09:52 PM


LAST REVISION	DESCRIPTION:
11/01/20 11/01/24	




FY ~~2024-25~~ 2025-26
 STANDARD PLANS

SPECIAL SIGN DETAILS


INDEX	SHEET
700-102	9 of 12

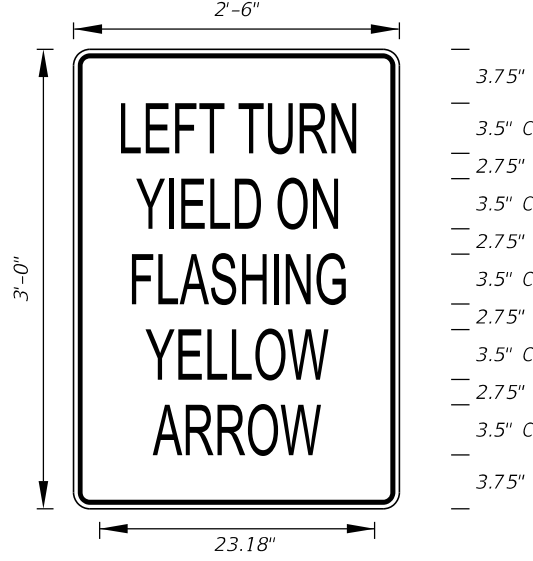


FTP-85-13
2'-6" X 3'
1.875" Radii 3/4" Border
3.5" Series C Legend
White Background
Black Legend and Border

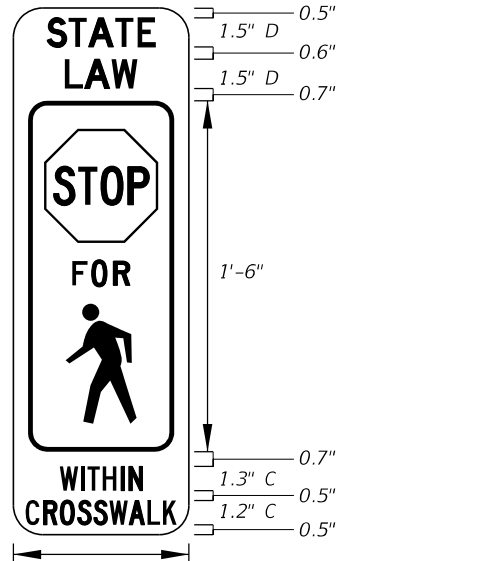


FTP-86-21
9" X 2'-3"
1.5" Radii No Border
Series C Legend and Series D Legend
White on Yellow
Black Legend and Border

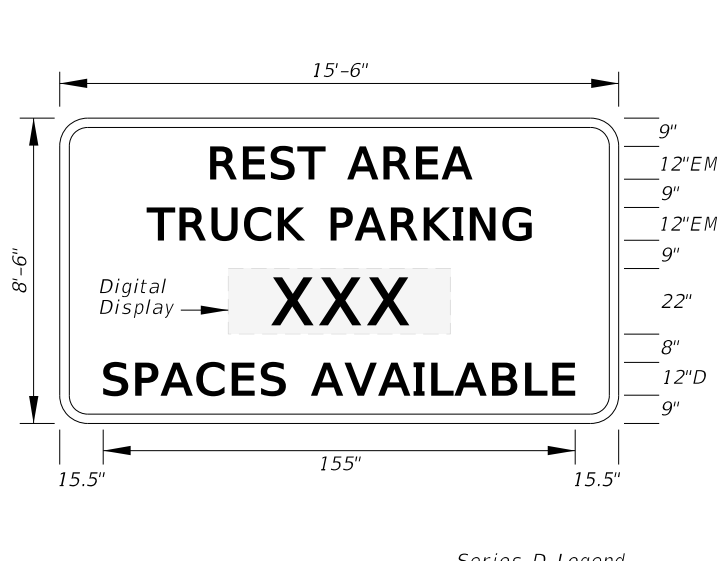


FTP-87-21
15'-6" X 8'-6"
12" Radii 2" Border
Series D Legend
Series EM Legend
Blue Background
White Legend and Border

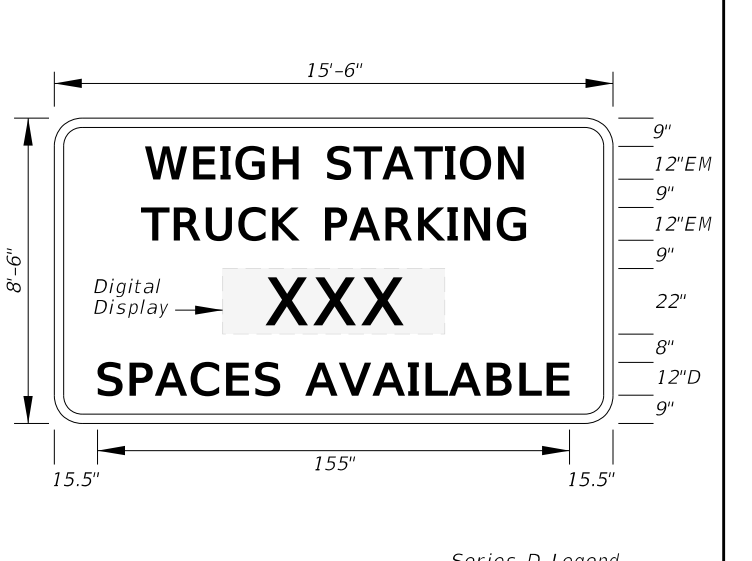


FTP-88-21
15'-6" X 8'-6"
12" Radii 2" Border
Series D Legend
Series EM Legend
Blue Background
White Legend and Border

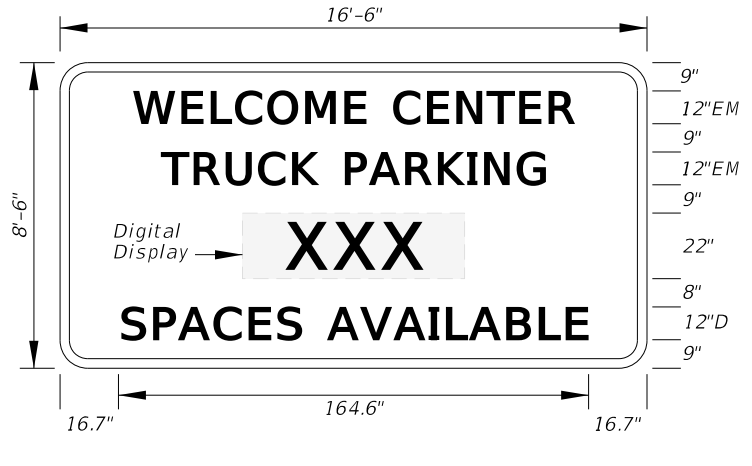

FTP-89-21
16'-6" X 8'-6"
12" Radii 2" Border
Series D Legend
Series EM Legend
Blue Background
White Legend and Border

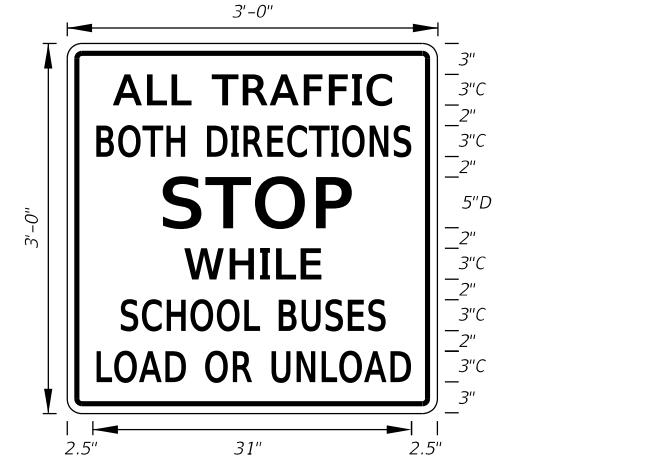


FTP-90-22
3'-0" X 3'-0"
1.5" Radii 3/4" Border
3" Series C Legend and 5" Series D Legend
White Background
Black Legend and Border

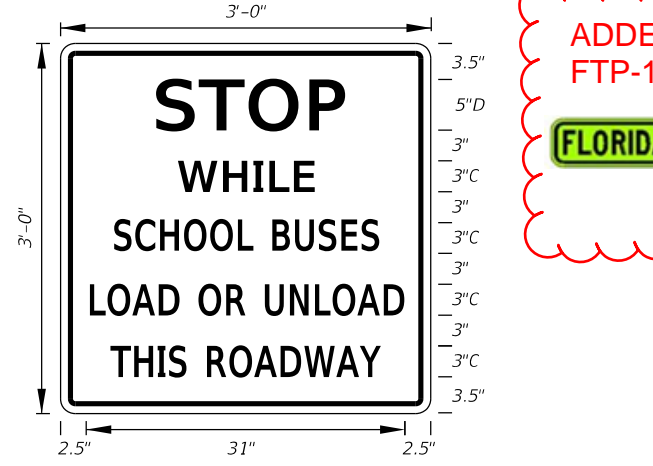


FTP-91-22
3'-0" X 3'-0"
1.5" Radii 3/4" Border
3" Series C Legend and 5" Series D Legend
White Background
Black Legend and Border


ADDED
FTP-100-25
FLORIDA LAW

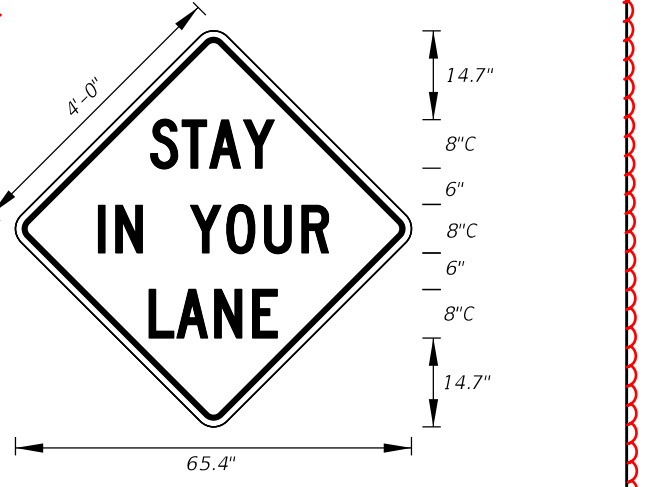


MOT-1-22
4' X 4'
3" Radii 3/4" Border
8" Series C Legend
Orange Background
Black Legend and Border

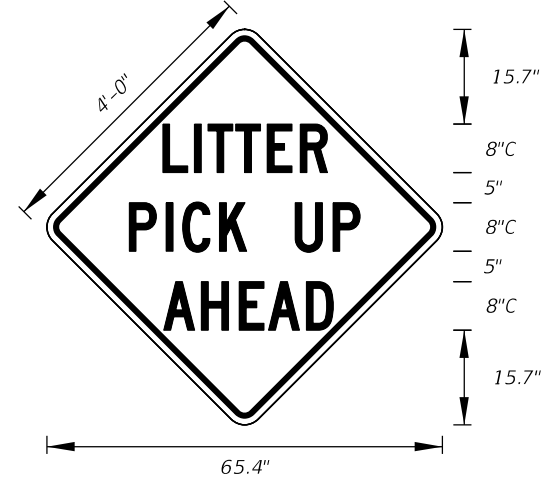

MOT-4-22
4' X 4'
3" Radii 3/4" Border
8" Series C Legend
Orange Background
Black Legend and Border

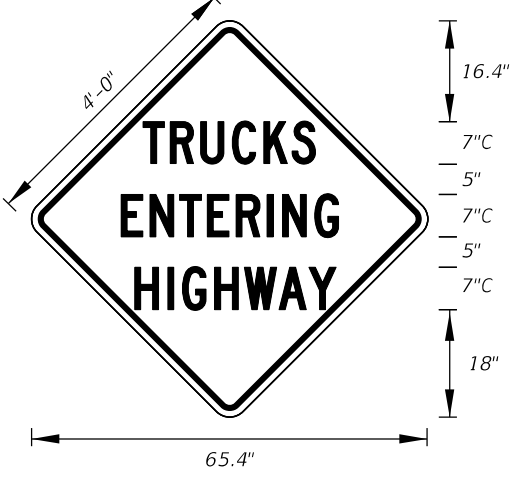


MOT-5-22
4' X 4'
3" Radii 3/4" Border
7" Series C Legend
Orange Background
Black Legend and Border

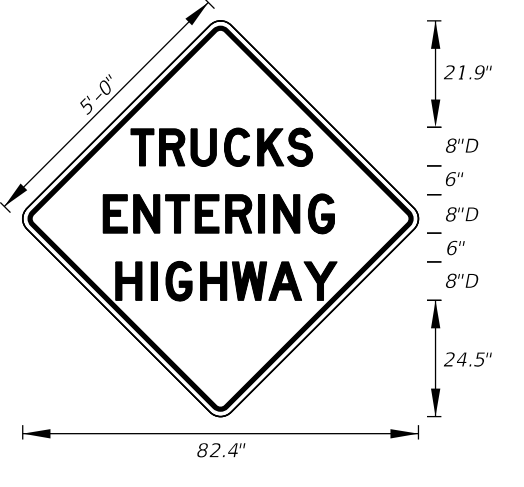

MOT-6-22
5' X 5'
3" Radii 3/4" Border
8" Series C Legend
Orange Background
Black Legend and Border


MOVED "MOT" to Sheet 11

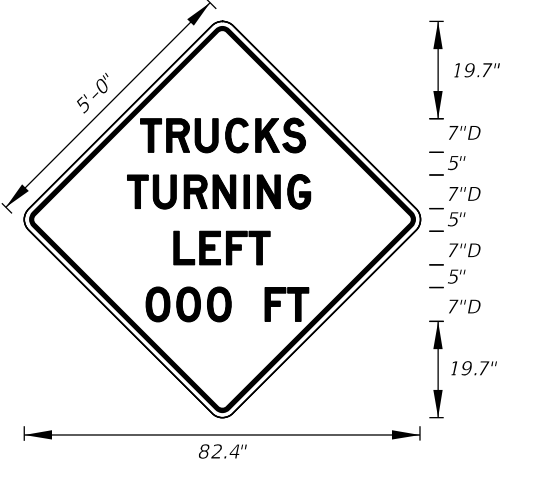


MOT-7-22
5' X 5'
3" Radii 3/4" Border
7" Series D Legend
Orange Background
Black Legend and Border

10/3/2023 3:09:59 PM


LAST REVISION	DESCRIPTION	FY 2024-25 2025-26	SPECIAL SIGN DETAILS	INDEX	SHEET
11/01/21 11/01/24		FDOT STANDARD PLANS		700-102	10 of 12

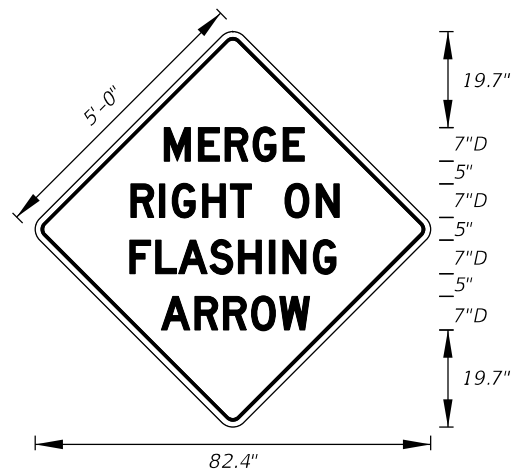


MOT-8-22
5' X 5'
3" Radii 3/4" Border
7" Series D Legend
Orange Background
Black Legend and Border

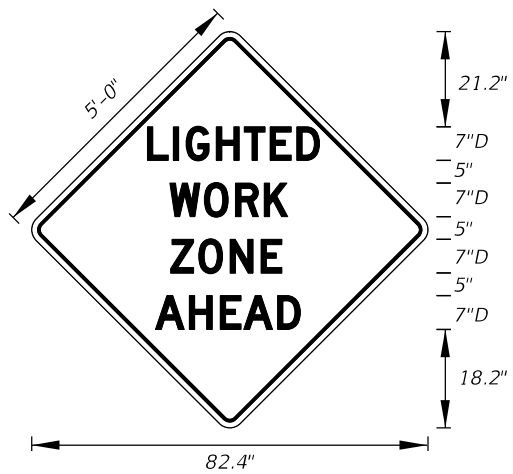


MOT-9-22
5' X 5'
3" Radii 3/4" Border
7" Series D Legend
Orange Background
Black Legend and Border

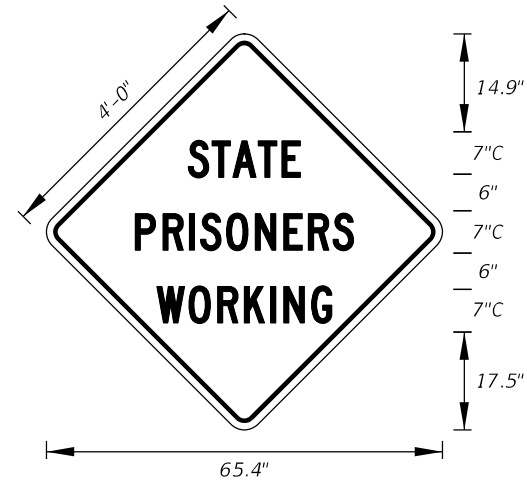

MOT-10-22
4' X 4'
3" Radii 3/4" Border
7" Series C Legend
Orange Background
Black Legend and Border

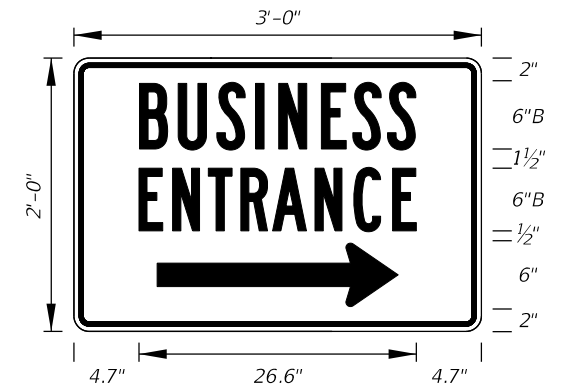


MOT-11-06
3' X 2'
2" Radii 3/4" Border
6" Series B Legend
Blue Background
White Legend and Border

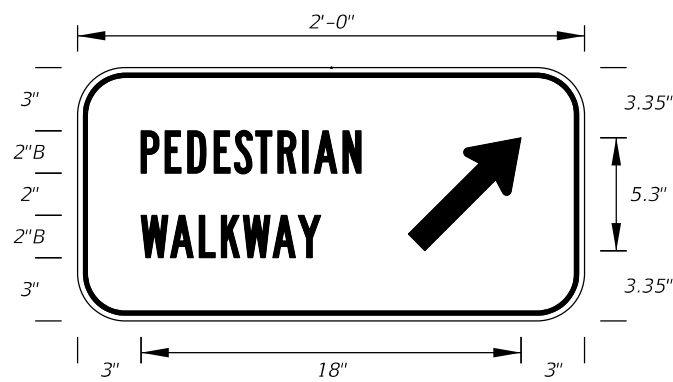


MOT-12R-06
2' X 1'
2" Radii 3/4" Border
2" Series B Legend
White Background
Black Legend and Border


MOT-12L-06
For Diversion
to the left

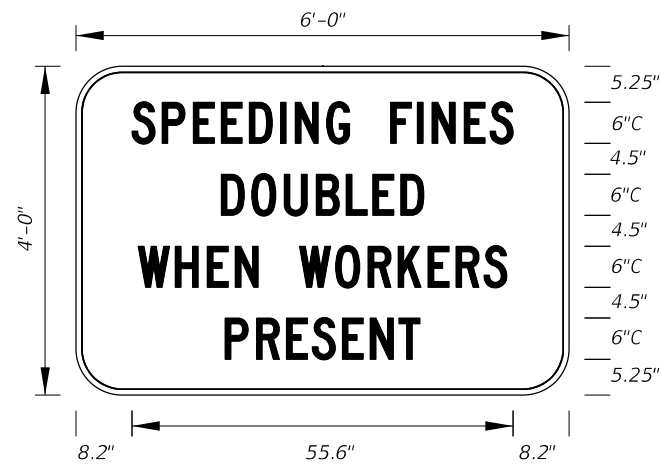


MOT-13-06
Freeway Sign
6' X 4'
6" Radii 3/4" Border
6" Series C Legend
White Background
Black Legend and Border

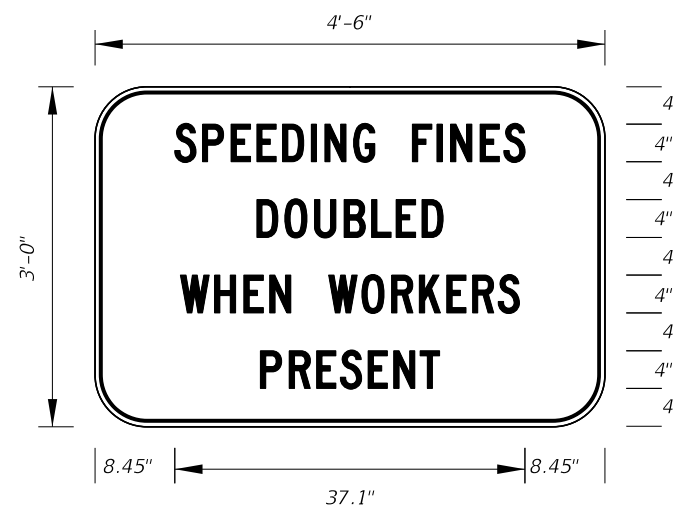


MOT-14-06
Arterial Sign
4'-6" X 3'
5" Radii 3/4" Border
4" Series C Legend
White Background
Black Legend and Border

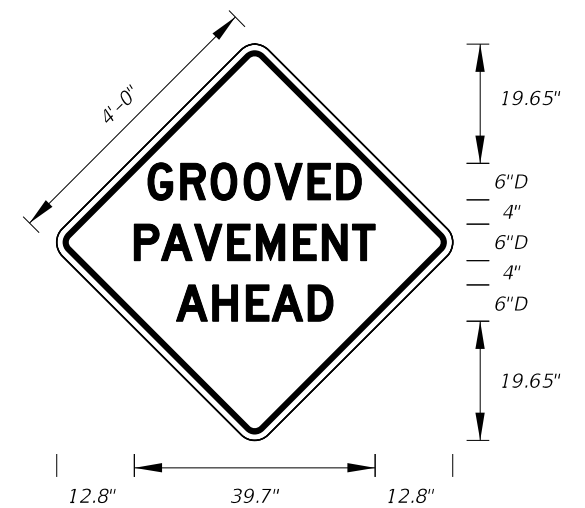


MOT-15-06
4' X 4'
2" Radii 3/4" Border
6" Series D Legend
Orange Background
Black Legend and Border

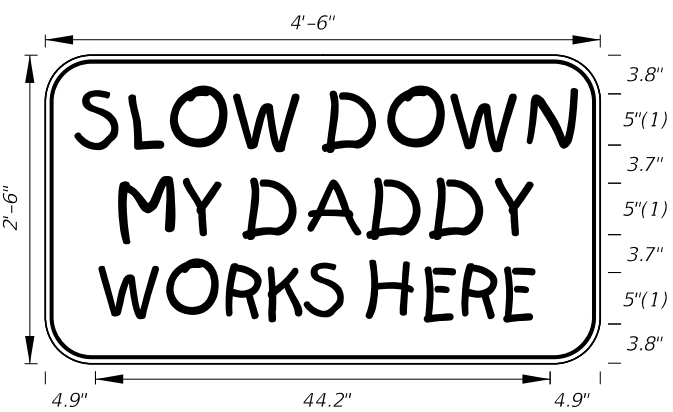

MOT-16-06
4'-6" X 2'-6"
4" Radii 3/4" Border
5" Kids Series Legend
Orange Background
Black Legend and Border

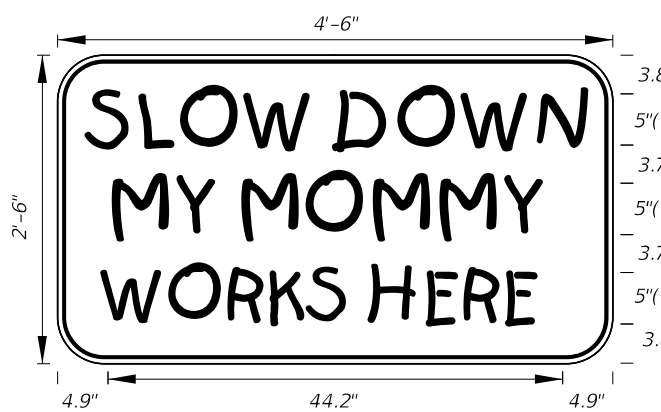


MOT-17-06
4'-6" X 2'-6"
4" Radii 3/4" Border
5" Kids Series Legend
Orange Background
Black Legend and Border

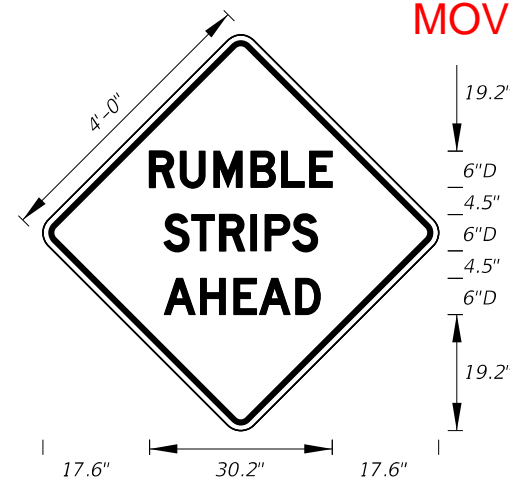

MOT-18-10
4' X 4'
2" Radii 3/4" Border
6" Series D Legend
Orange Background
Black Legend and Border

MOVED" to Sheet 12

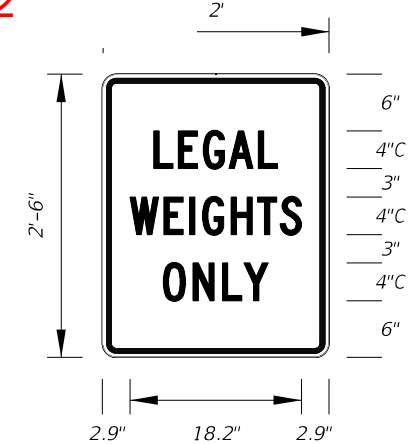

MOT-19-11
2' X 2'-6"
1.13" Radii 3/4" Border
4" Series C Legend
White Background
Red Legend and Border

10/3/2023 3:10:06 PM


LAST REVISION	DESCRIPTION:
11/01/21	
11/01/24	




FY ~~2024-25~~ 2025-26
STANDARD PLANS

SPECIAL SIGN DETAILS


INDEX	SHEET
700-102	11 of 12

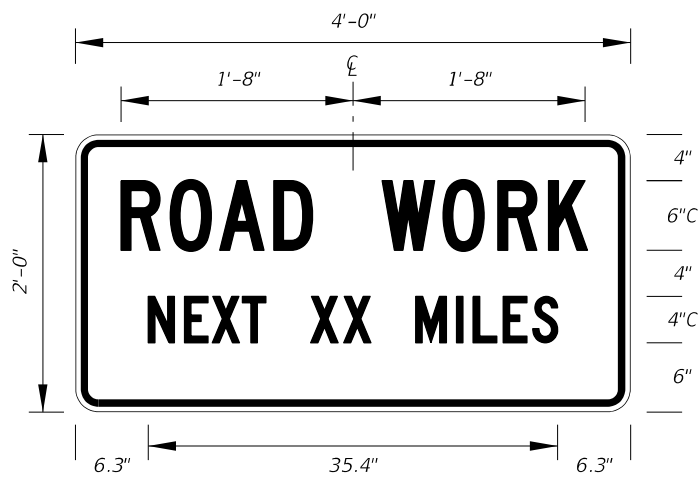


G20-1
4' X 2'
1.5" Radii 3/4" Border
Orange Background
Black Legend and Border

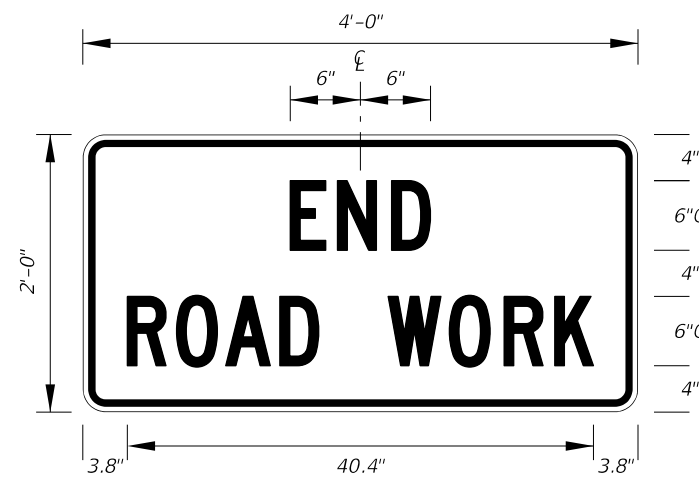


G20-2
4' X 2'
1.5" Radii 3/4" Border
Orange Background
Black Legend and Border

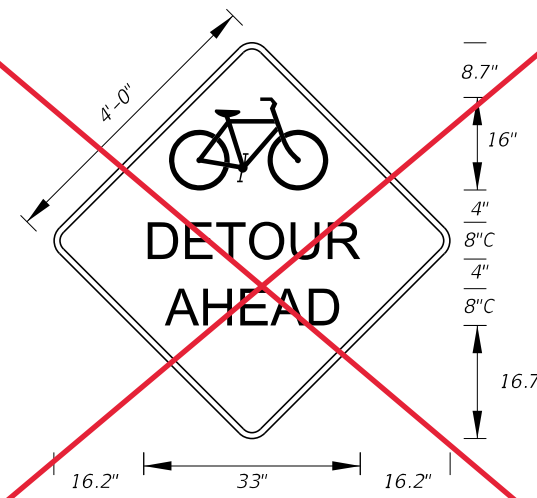


MOT-20-21
4' X 4'
3" Radii 3/4" Border
8" Series C Legend
Orange Background
Black Legend and Border

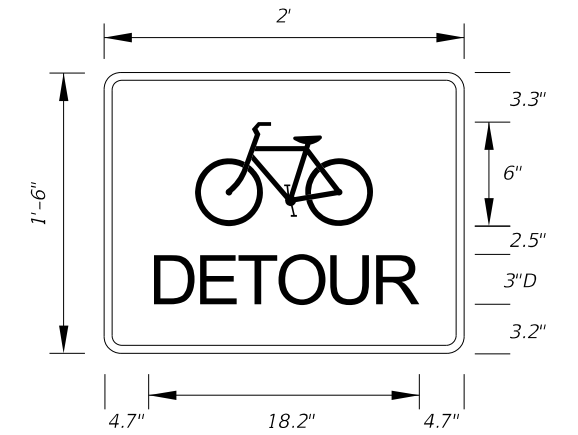


MOT-21-21
2' X 1'-6"
1.5" Radii 1/2" Border
3" Series D Legend
Orange Background
Black Legend and Border

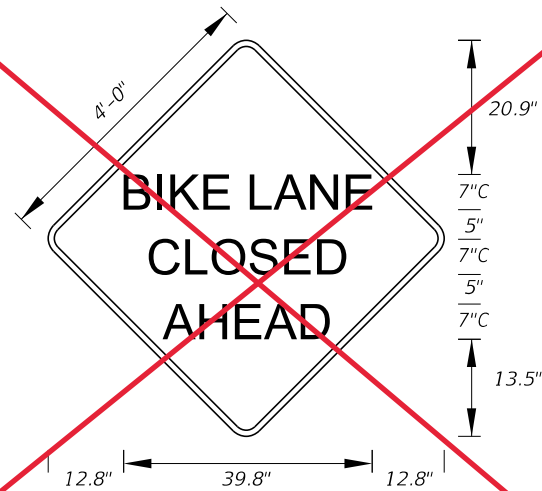

MOT-22-21
4' X 4'
3" Radii 3/4" Border
7" Series C Legend
Orange Background
Black Legend and Border

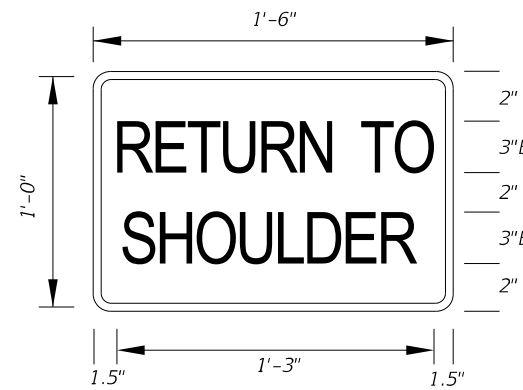


MOT-23-21
1'-6" X 1'-0"
1.5" Radii 1/4" Border
3" Series B Legend
Orange Background
Black Legend and Border

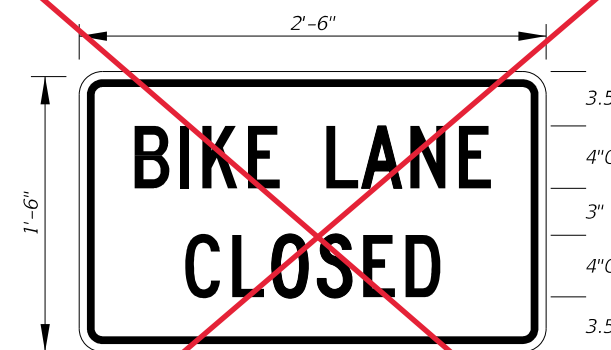


MOT-24-21
2'-6" X 1'-6"
1.5" Radii 1/2" Border
4" Series C Legend
White Background
Black Legend and Border




MOT-25-21
2'-0" X 1'-6"
1.5" Radii 1/2" Border
4" Series B Legend
White Background
Black Legend and Border

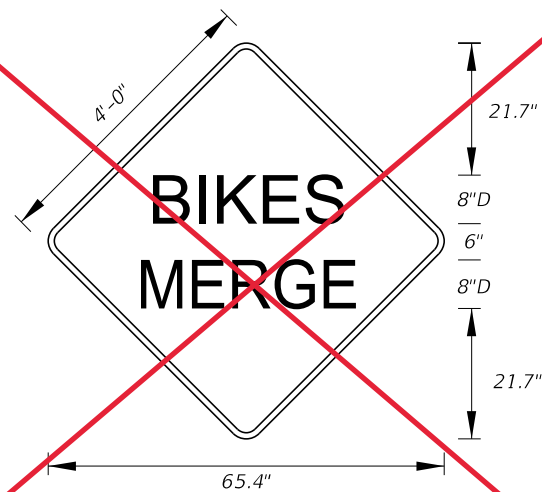

MOT-26A-22
4' X 4'
3" Radii 3/4" Border
8" Series D Legend
Orange Background
Black Legend and Border

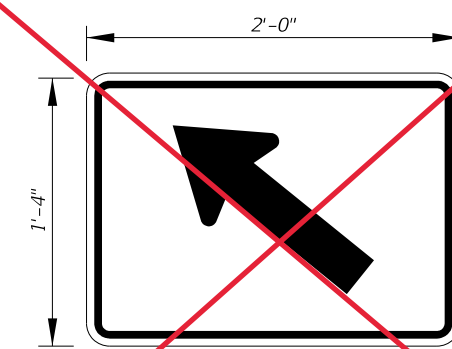

MOT-26B-22
2'-0" X 1'-4"
1.5" Radii 5/8" Border
Orange Background
Black Legend and Border

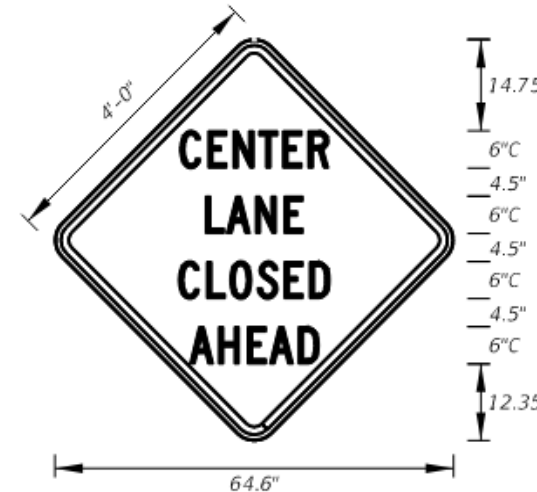

MOT-27-24
4' X 4'
3" Radii 3/4" Border
6" Series C Legend
Orange Background
Black Legend and Border

Added sign
MOT-27-25

10/3/2023 3:10:13 PM


LAST REVISION	DESCRIPTION:
11/01/23	
11/01/24	



FTP-41-21
2'-6" X 3'
4" Radii 3/4" Border
2" and 4" Series C Legend
White Background
Black Legend and Border



FTP-42-06
4' X 2'-6"
3" Radii
Top 4" Series C Legend
Bottom 2" Series EM Legend
White Background
Blue Legend and Border

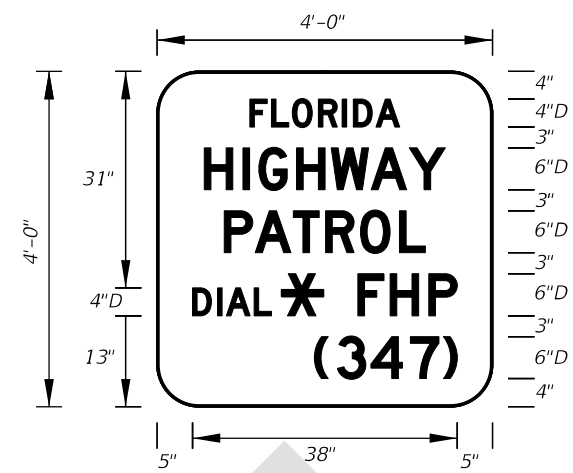


FTP-43-06
4' X 4'
6" Radii 1" Border
Top 4" Series D Legend
Bottom 6" Series D Legend
Blue Background
White Legend and Border




FTP-44-06
9' X 6'
9" Radii 3/4" Border
8" Series D Legend
White Background
Black Legend and Border




FTP-44A-25
4' X 3'
5" Radii 3/4" Border
4" Series C Legend
White Background
Black Legend and Border

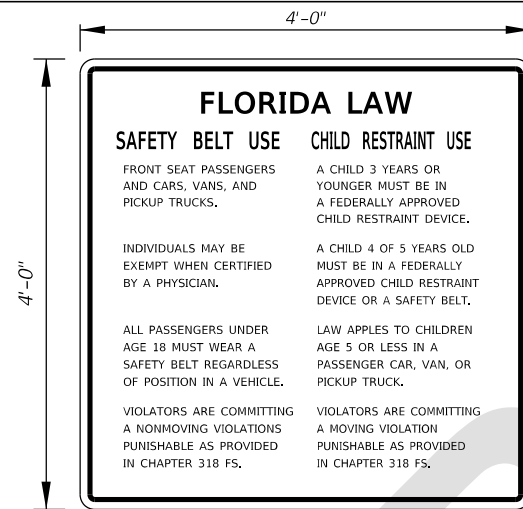


FTP-45-25
4'-0" X 4'-0"
1.5" Radii
0.4" Border
2.5" Series C Legend
2" Series C Legend
1.5" Series C Legend and
White Background
Black Legend and Border

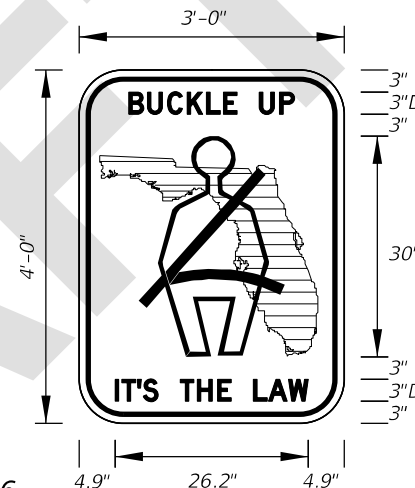

FTP-46-06
3' X 4'
5" Radii 3/4" Border
3" Series D Legend
White Background
Green Florida Symbol
Black Legend, Border and Man Belt Symbol

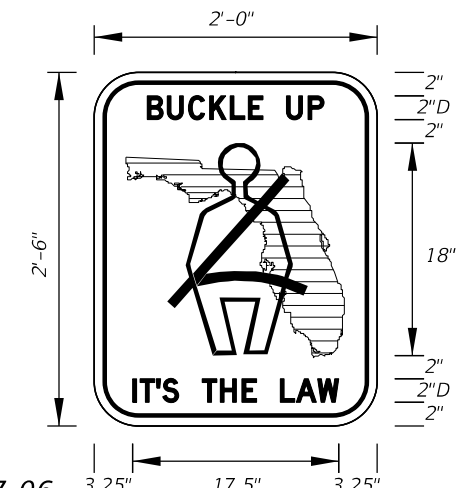


FTP-47-06
2' X 2'-6"
3" Radii 5/8" Border
2" Series D Legend
White Background
Green Florida Symbol
Black Legend, Border and Man Belt Symbol

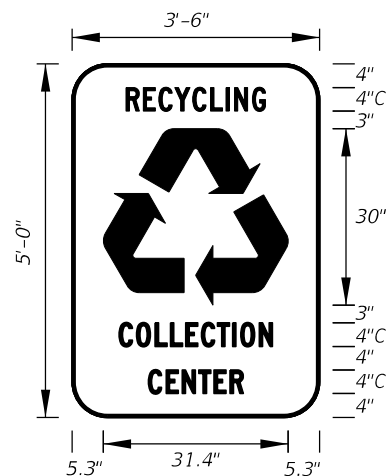


FTP-48-06
3'-6" X 5'
6" Radii
4" Series C Legend
Green Background
White Legend, Border and Symbol



FTP-49-06
3'-6" X 5'-6"
6" Radii
4" Series C Legend
Green Background
White Legend, Border and Symbol
Municipality Name Optional

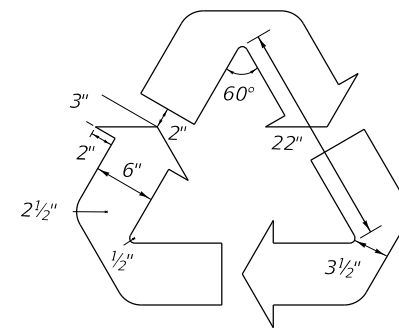


Detail for **FTP-48-06** and **FTP-49-06**

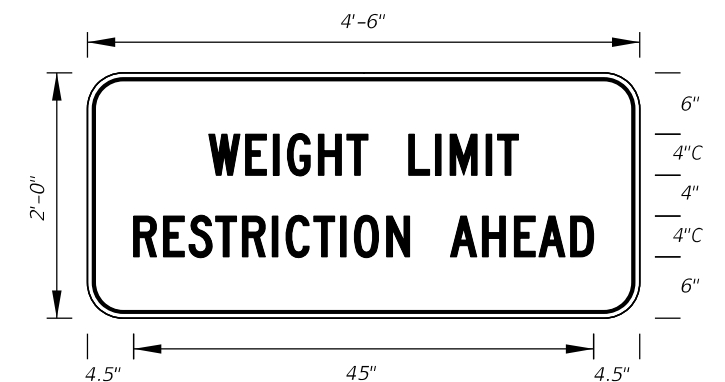


FTP-50-06
4'-6" X 2'
3" Radii 3/4" Border
4" Series C Legend
Yellow Background
Black Legend and Border

8/15/2024 1:20:36 PM


LAST REVISION	DESCRIPTION:
11/01/24	

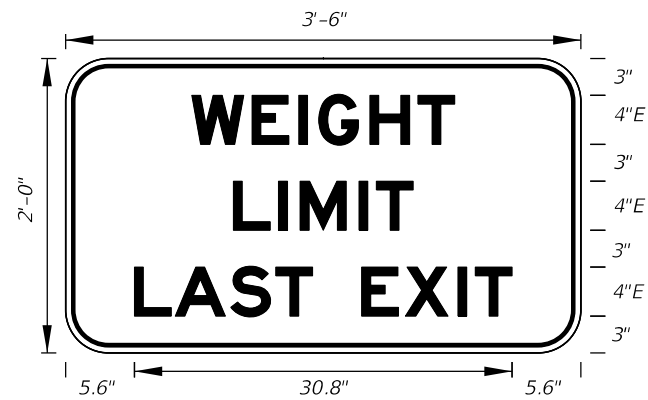


FTP-51-06
3' X 2'
3" Radii 3/4" Border
4" Series E Legend
White Background
Black Legend and Border

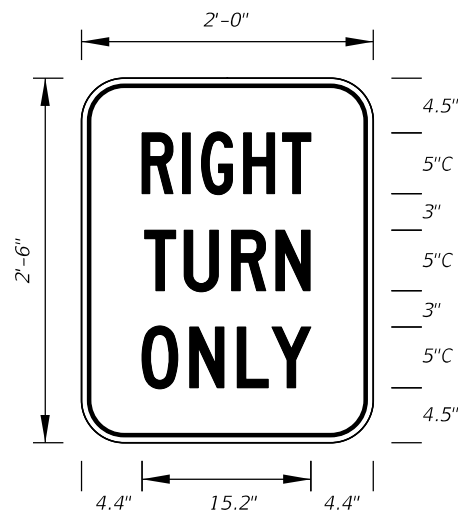


FTP-52-06
2' X 2'-6"
3" Radii 5/8" Border
5" Series C Legend
White Background
Black Legend and Border

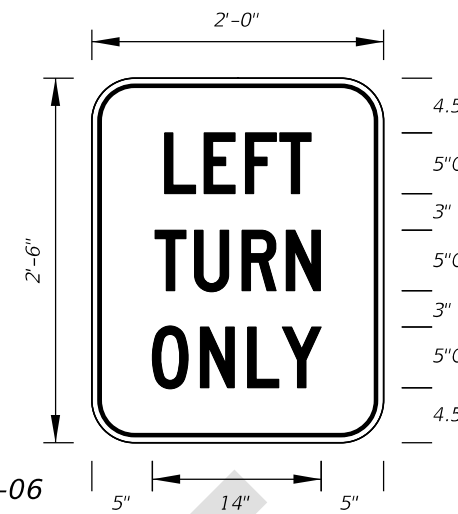


FTP-53-06
2' X 2'-6"
3" Radii 5/8" Border
5" Series C Legend
White Background
Black Legend and Border

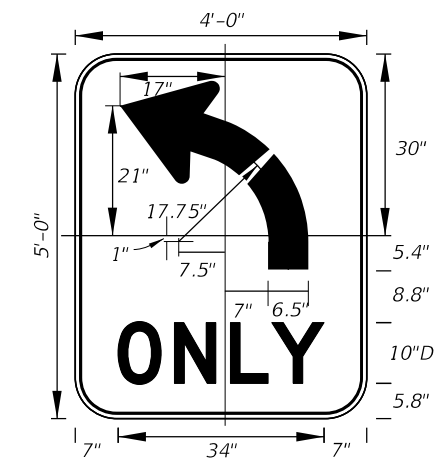


FTP-54L-06
4' X 5'
6" Radii 3/4" Border
10" Series D Legend
White Background
Black Legend and Border
FTP-54R-06 for (Right Turn Arrow)

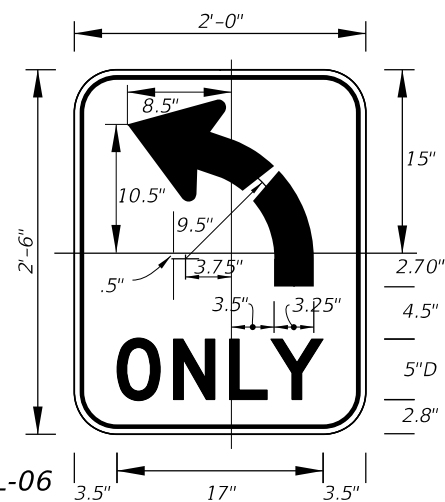


FTP-55L-06
2' X 2'-6"
3" Radii 3/8" Border
5" Series D Legend
White Background
Black Legend and Border
FTP-55R-06 for (Right Turn Arrow)

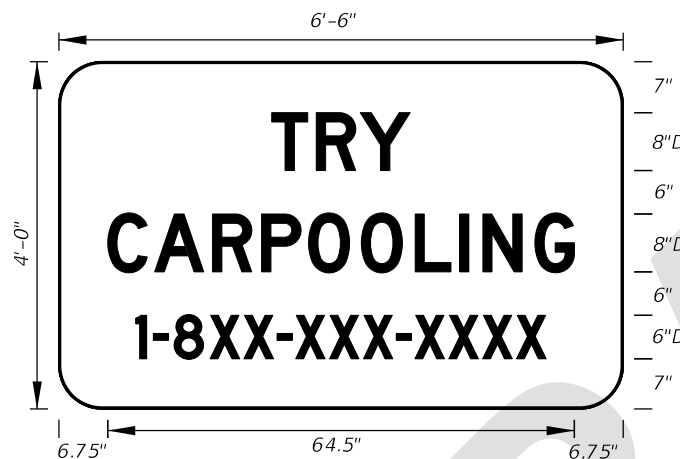


FTP-56-06
6'-6" X 4'
6" Radii 3/4" Border
8" and 6" Series D Legend
Blue Background
White Legend and Border
Design Project Manager or Transit Administrator will supply correct 1-8XX number.

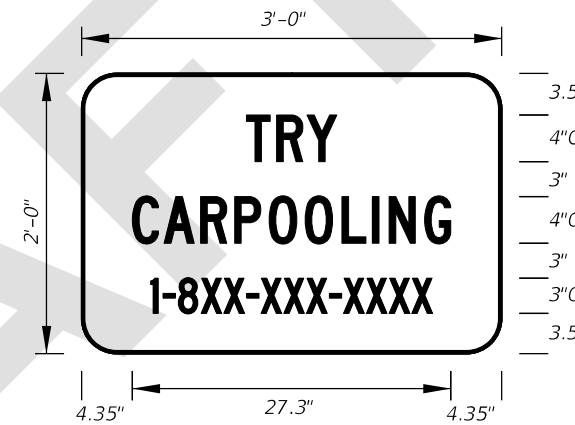


FTP-56A-06
3' X 2'
3" Radii
4" and 3" Series C Legend
Blue Background
White Legend and Border
Design Project Manager or Transit Administrator will supply correct 1-8XX number.

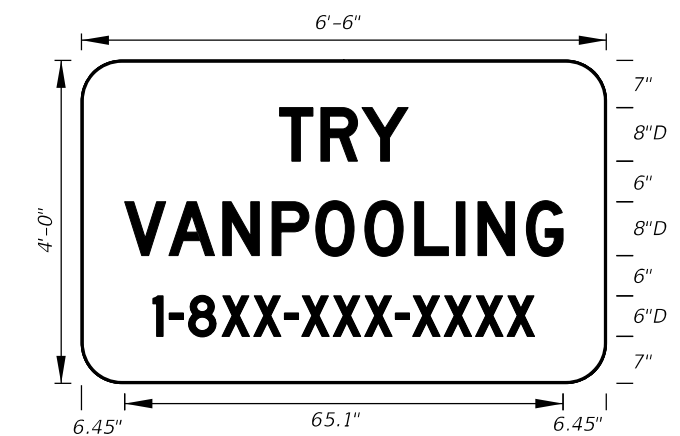


FTP-57-06
6'-6" X 4'
6" Radii
8" and 6" Series D Legend
Blue Background
White Legend and Border
Design Project Manager or Transit Administrator will supply correct 1-8XX number.

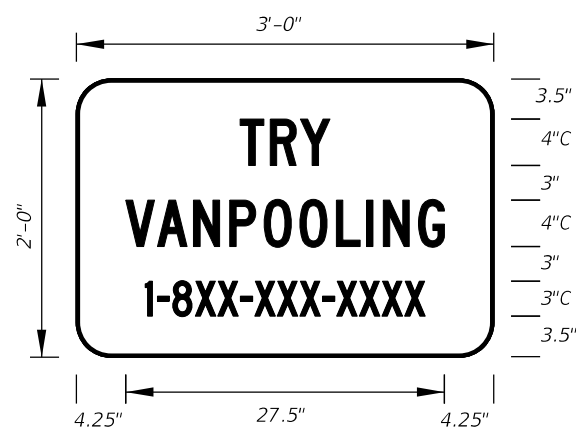

FTP-58-06
3' X 2'
3" Radii
4" and 3" Series C Legend
Blue Background
White Legend and Border
Design Project Manager or Transit Administrator will supply correct 1-8XX number.

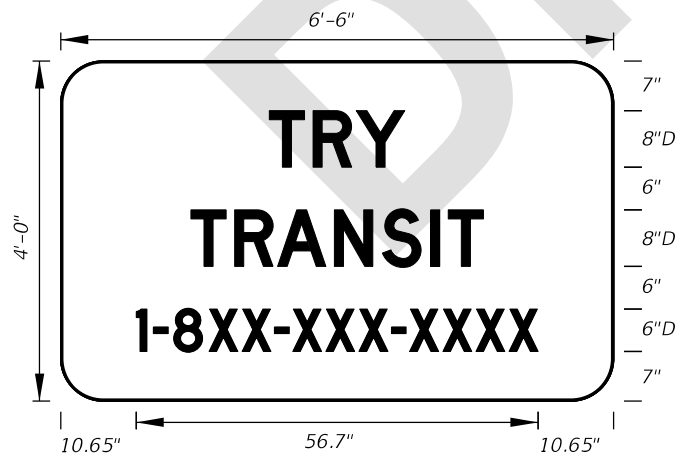

FTP-59-06
6'-6" X 4'
6" Radii
8" and 6" Series D Legend
Blue Background
White Legend and Border
Design Project Manager or Transit Administrator will supply correct 1-8XX number.

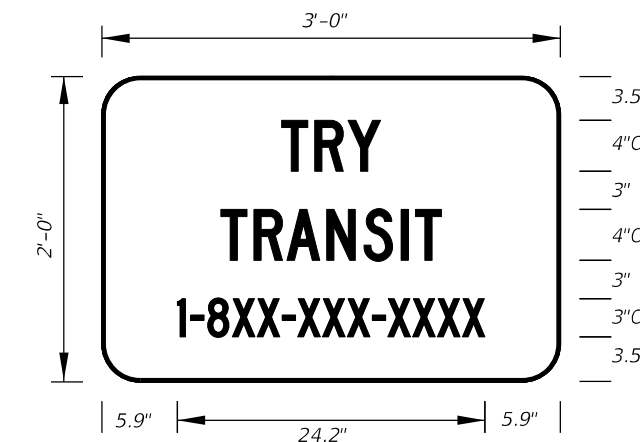


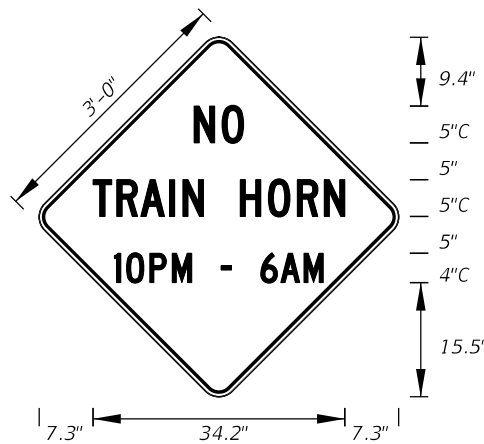
FTP-60-06
3' X 2'
3" Radii
4" and 3" Series C Legend
Blue Background
White Legend and Border
Design Project Manager or Transit Administrator will supply correct 1-8XX number.




FTP-61-06
3' X 2'
3" Radii 3/4" Border
4" and 3" Series C Legend
Yellow Background
Black Legend and Border

8/15/2024 1:20:45 PM

LAST REVISION 11/01/24	DESCRIPTION:	 FY 2025-26 STANDARD PLANS	SPECIAL SIGN DETAILS	INDEX 700-102	SHEET 7 of 12
---------------------------	--------------	---	----------------------	------------------	------------------



FTP-62-06
 3' X 3'
 2" Radii 3/4" Border 4" and 5" Series C Legend
 Yellow Background Black Legend and Border

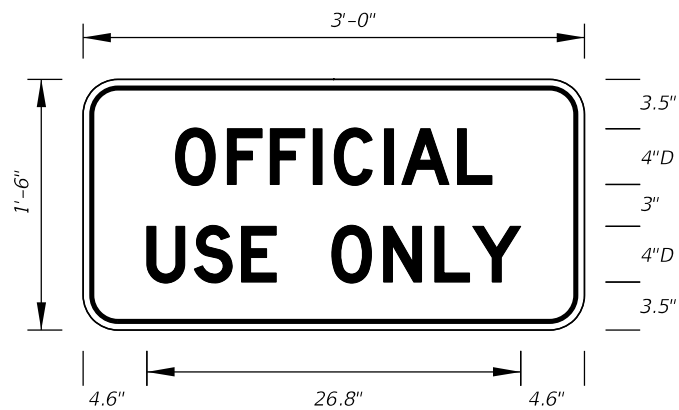

FTP-65-06
 3' X 1'-6"
 2" Radii 3/4" Border 4" Series D Legend
 White Background Black Legend and Border



FTP-66-21
 4' X 5'
 3" Radii 1" Border 6" Series D Legend
 Blue Background White Legend and Border




FTP-67-21
 5.5' X 6'
 3" Radii 1" Border 8" Series D Legend
 Blue Background White Legend and Border




DETAIL for FTP-66 AND FTP-67

Sign Mounting Holes Can Be Punched Or Field Drilled With No Obstruction To Text Or Symbols From Holes Or Bolts.

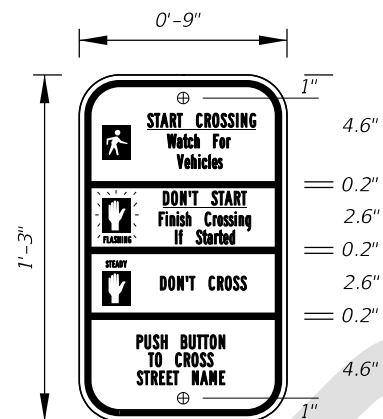


FTP-68A-06
 9" X 1'-3"
 1.5" Radii 3/4" Border Series B Legend
 White Background Black Legend and Border
 See MUTCD R10-3f for Letter Size, Spacing, and Symbol Sizes and Color


Sign Mounting Holes Can Be Punched Or Field Drilled With No Obstruction To Text Or Symbols From Holes Or Bolts.

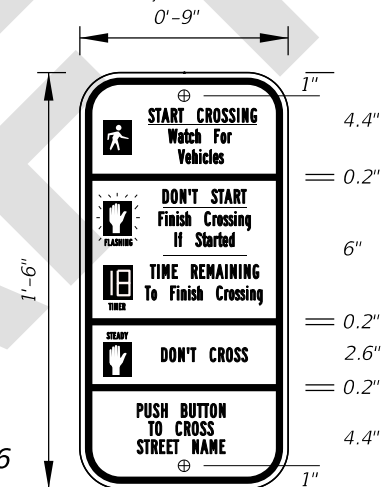

FTP-68B-06
 9" X 1'-6"
 1.5" Radii 3/4" Border Series B Legend
 White Background Black Legend and Border
 See MUTCD R10-3i for Letter Size, Spacing, and Symbol Sizes and Color

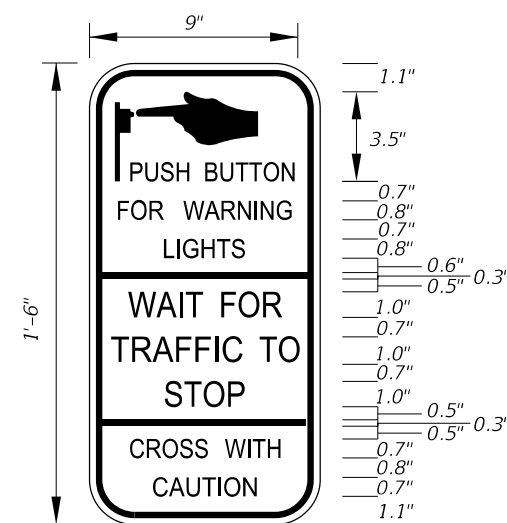

FTP-68C-21
 9" X 1'-6"
 1.5" Radii 1/4" Border Series D Legend
 White Background Black Legend and Border

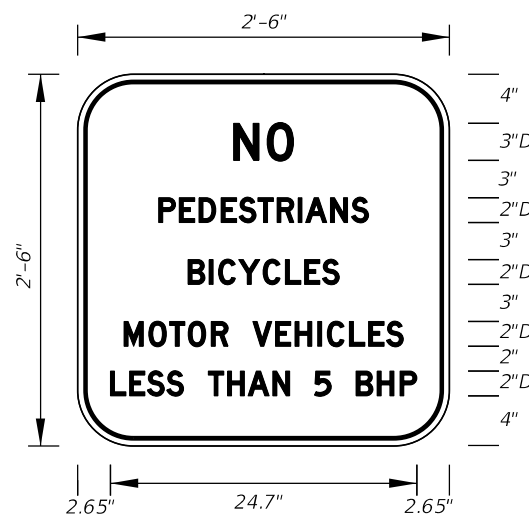

FTP-69-06
 2'-6" X 2'-6"
 4" Radii 3/4" Border 2" and 3" Series D Legend
 White Background Black Legend and Border



FTP-70-06
 3'-6" X 2'-6"
 2.25" Radii 3/4" Border 5" Series C and 7" Series C Legend
 Blue Background White Legend and Border




FTP-71-06
 4' X 4'
 2" Radii 3/4" Border 8" Series C Legend
 Yellow Background Black Legend and Border



FTP-72-06
 3' X 3'
 2" Radii 3/4" Border 6" Series C Legend
 Yellow Background Black Legend and Border

8/15/2024 2:49:01 PM

LAST REVISION 11/01/24	DESCRIPTION:
---------------------------	--------------

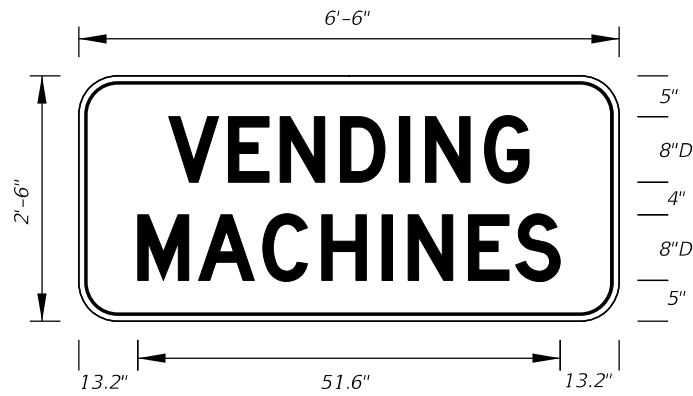


FTP-73-06
6'-6" X 2'-6"
4" Radii 3/4" Border


8" Series D Legend
Blue Background
White Legend and Border




FTP-74-06
6'-6" X 2'-6"
4" Radii 3/4" Border
6" Series D Legend
Blue Background
White Legend and Border

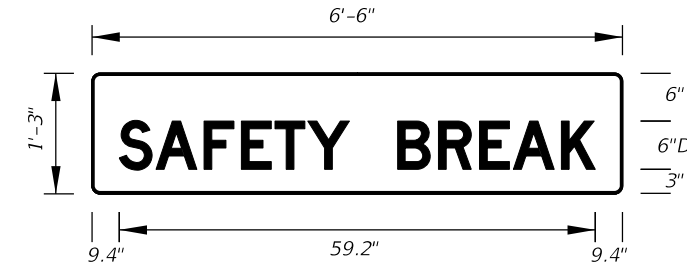


FTP-75-06
6'-6" X 1'-3"
1" Radii
6" Series D Legend
Blue Background
White Legend

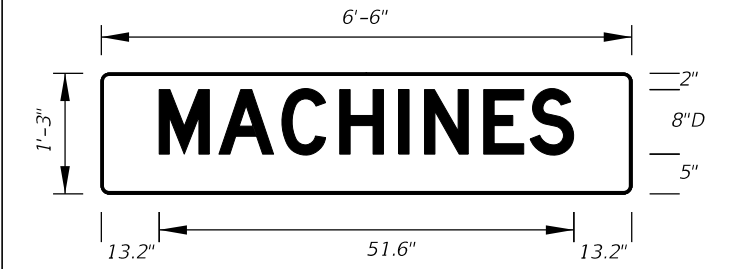


FTP-76-06
6'-6" X 1'-3"
1" Radii
8" Series D Legend
Blue Background
White Legend

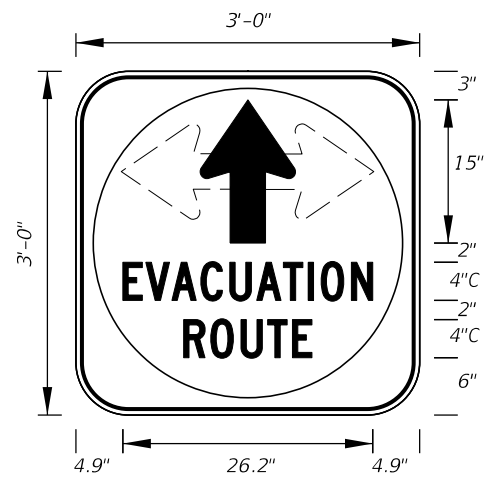


FTP-77-06
3' X 3'
5" Radii 3/4" Border
4" Series C Legend
White Background with Blue Circle Background
White Legend and Black Border

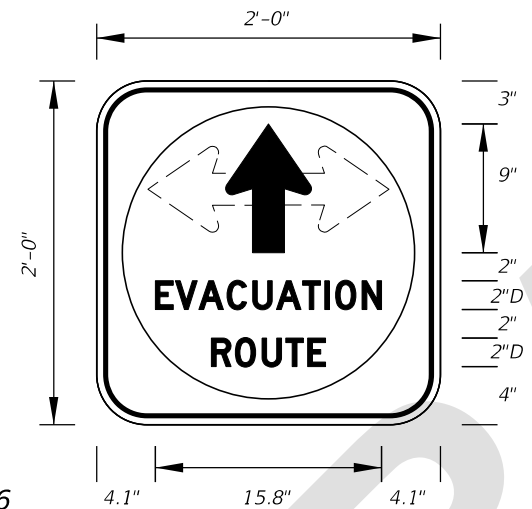


FTP-78-06
2' X 2'
3" Radii 3/4" Border
2" Series D Legend
White Background with Blue Circle Background
White Legend and Black Border

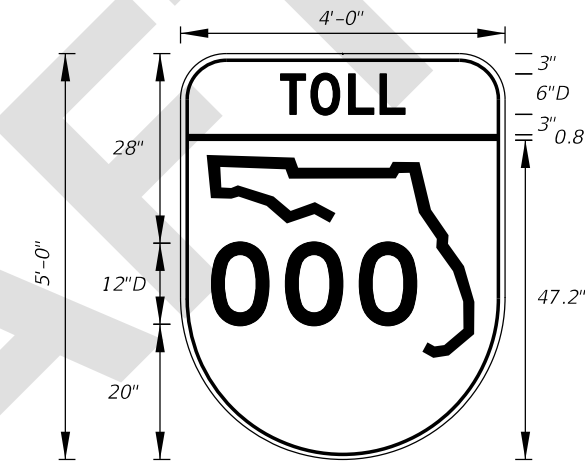


FTP-79-06
4' X 5'
6" Radii 3/4" Border
6" and 12" Series D Legend
Top Yellow Background with Black Legend and Black Border
Bottom White Background with Black Legend and Border

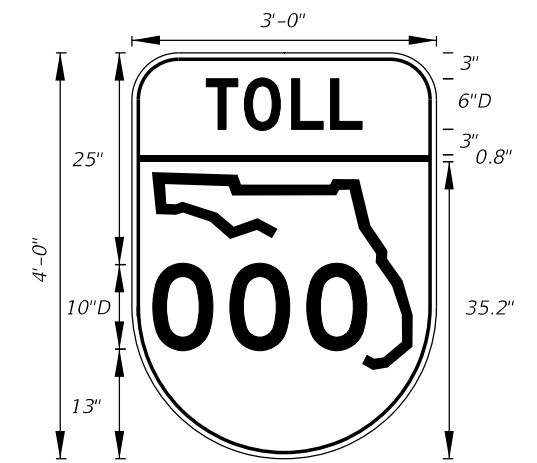

FTP-80-06
3' X 4'
5" Radii 3/4" Border
6" and 10" Series D Legend
Top Yellow Background with Black Legend and Black Border
Bottom White Background with Black Legend and Border

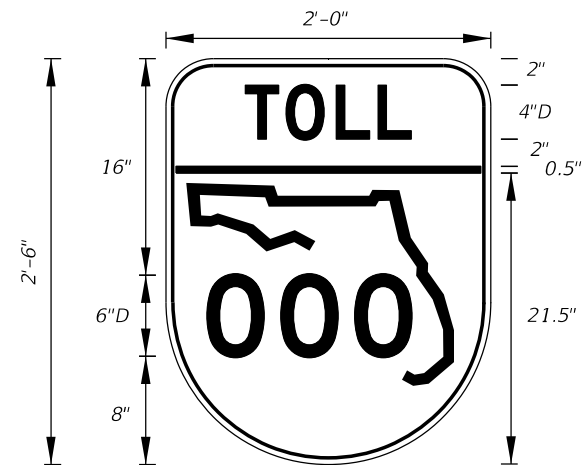

FTP-81-06
2' X 2'-6"
3" Radii 3/4" Border
4" and 6" Series D Legend
Top Yellow Background with Black Legend and Black Border
Bottom White Background with Black Legend and Border

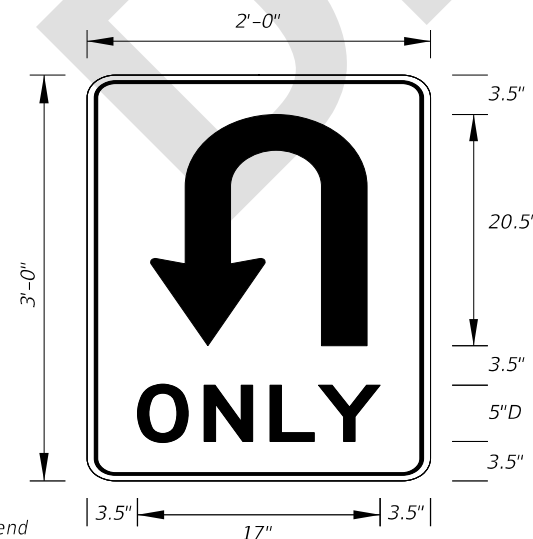

FTP-82-08
2' X 3'
1.5" Radii
5" Series D Legend
White Background
Black Legend and Border


ARROW HEAD

A	3.125
B	3.625
C	6.375
D	.5
E	.625

ARROW BODY

A	B	C	D	E	F	G
6.25	3.125	3.125	3.125	5	9.25	20.5

FTP-82-08
Details

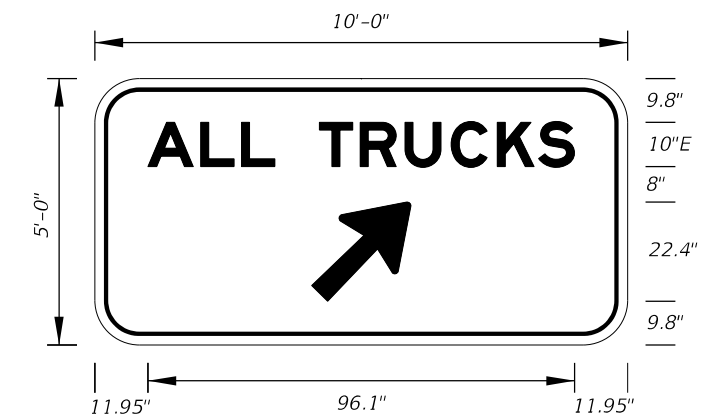

FTP-83-08
10'-0" X 5'-0"
8" Radii
10" Series E Legend
Green Background
White Legend

8/16/2024 10:42:26 AM


LAST REVISION 11/01/24	DESCRIPTION:
---------------------------	--------------




FY 2025-26
STANDARD PLANS

SPECIAL SIGN DETAILS


INDEX 700-102	SHEET 9 of 12
------------------	------------------

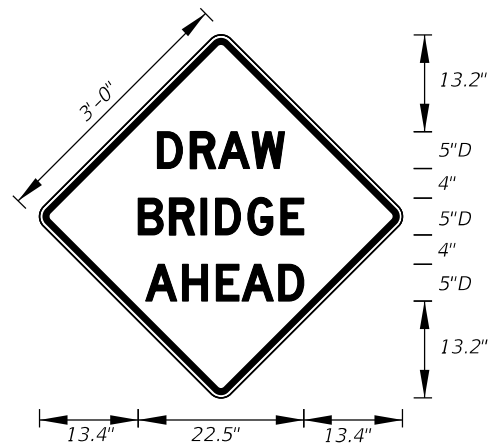

FTP-84-09
3' X 3'
1.5" Radii
5" Series D Legend
Yellow Background
Black Legend and Border

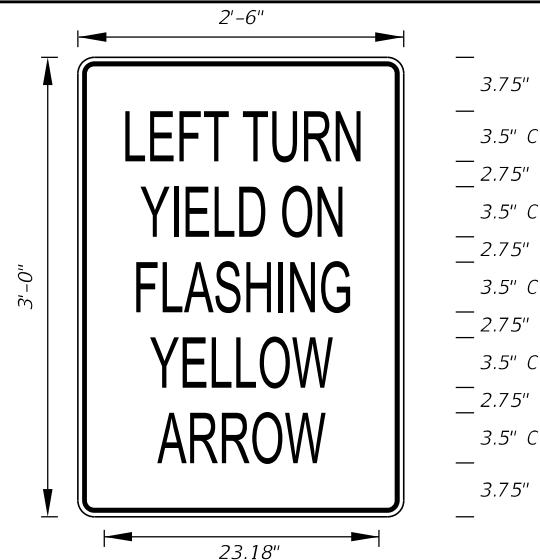


FTP-85-13
2'-6" X 3'
1.875" Radii 3/4" Border
3.5" Series C Legend
White Background
Black Legend and Border

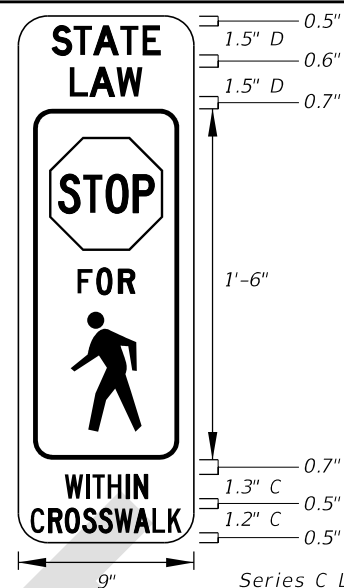

FTP-86-21
9" X 2'-3"
1.5" Radii No Border
Series C Legend and Series D Legend
White on Yellow
Black Legend and Border




FTP-87-21
15'-6" X 8'-6"
12" Radii 2" Border
Series D Legend
Series EM Legend
Blue Background
White Legend and Border

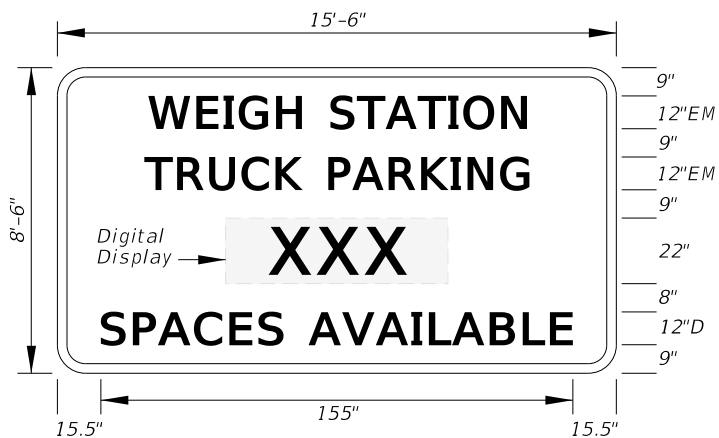


FTP-88-21
15'-6" X 8'-6"
12" Radii 2" Border
Series D Legend
Series EM Legend
Blue Background
White Legend and Border




FTP-89-21
16'-6" X 8'-6"
12" Radii 2" Border
Series D Legend
Series EM Legend
Blue Background
White Legend and Border

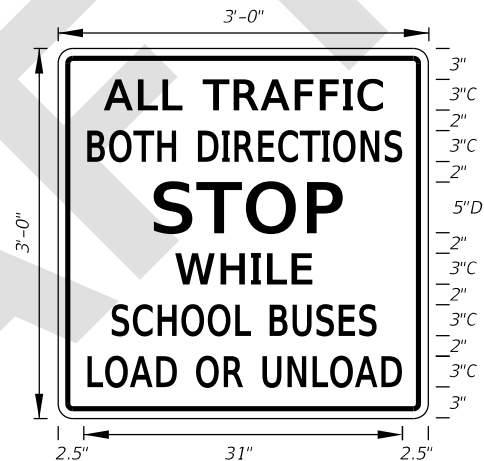

FTP-90-22
3'-0" X 3'-0"
1.5" Radii 3/4" Border
3" Series C Legend and 5" Series D Legend
White Background
Black Legend and Border

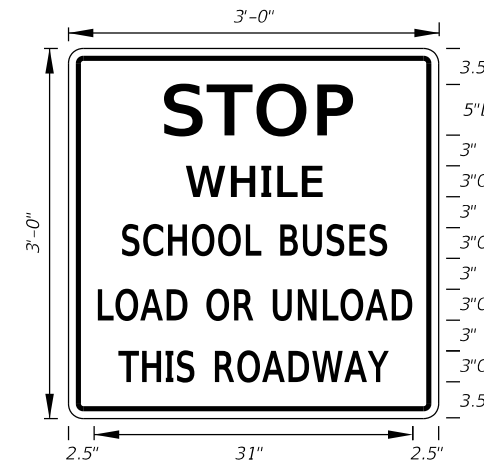


FTP-91-22
3'-0" X 3'-0"
1.5" Radii 3/4" Border
3" Series C Legend and 5" Series D Legend
White Background
Black Legend and Border

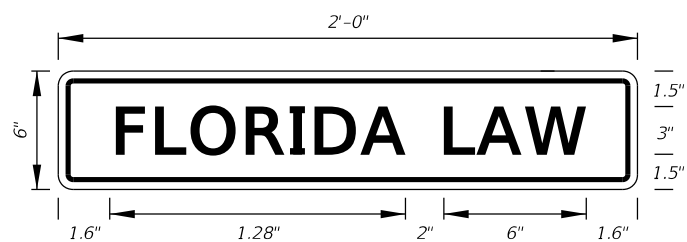


FTP-100-25
2'-0" X 6"
1.5" Radii
0.4" Border
0.4" Indent
3" Series C Legend and Bright Yellow Green Background
Black Legend and Border


8/15/2024 1:21:12 PM

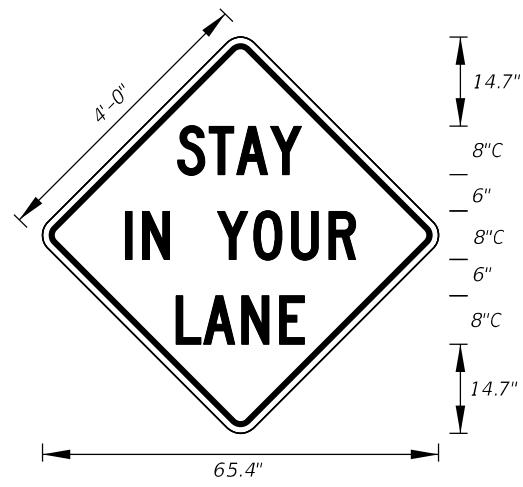


MOT-1-22
4' X 4'
3" Radii 3/4" Border
8" Series C Legend
Orange Background
Black Legend and Border

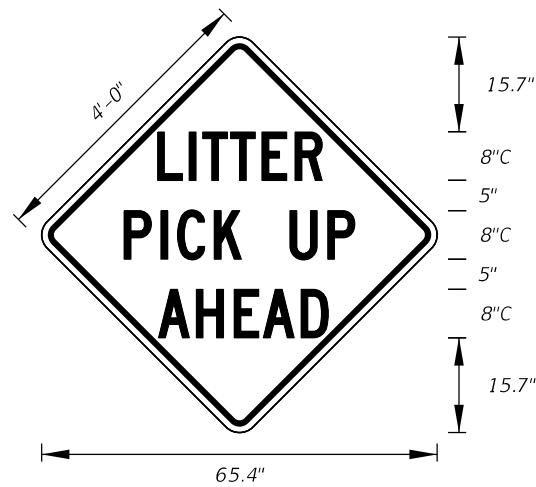


MOT-4-22
4' X 4'
3" Radii 3/4" Border
8" Series C Legend
Orange Background
Black Legend and Border

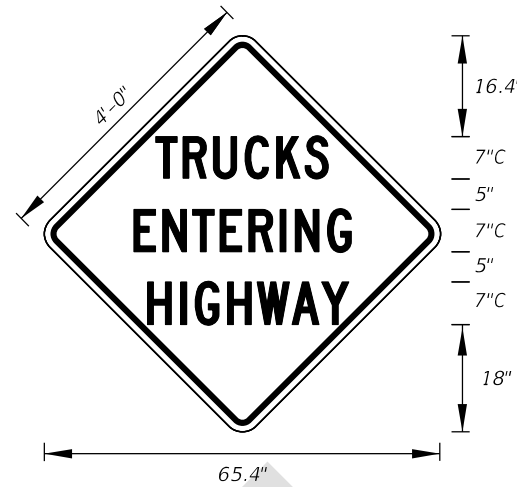


MOT-5-22
4' X 4'
3" Radii 3/4" Border
7" Series C Legend
Orange Background
Black Legend and Border

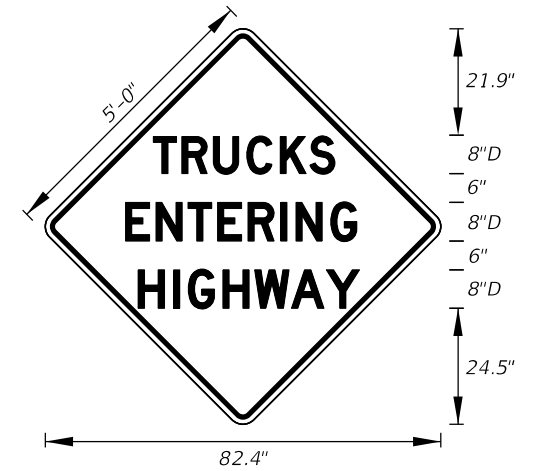


MOT-6-22
5' X 5'
3" Radii 3/4" Border
8" Series D Legend
Orange Background
Black Legend and Border

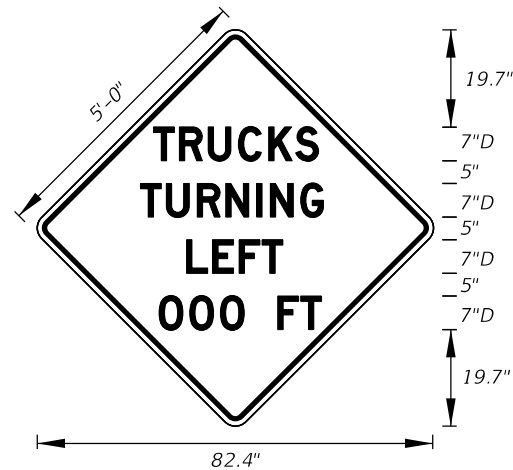


MOT-7-22
5' X 5'
3" Radii 3/4" Border
7" Series D Legend
Orange Background
Black Legend and Border

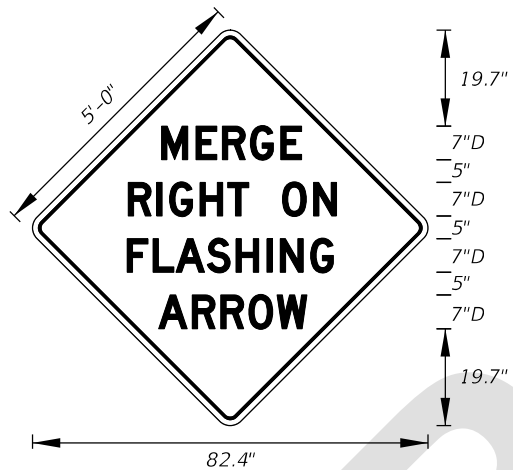


MOT-8-22
5' X 5'
3" Radii 3/4" Border
7" Series D Legend
Orange Background
Black Legend and Border

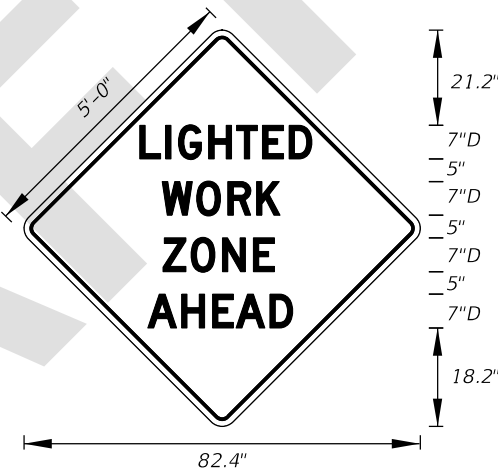


MOT-9-22
5' X 5'
3" Radii 3/4" Border
7" Series D Legend
Orange Background
Black Legend and Border

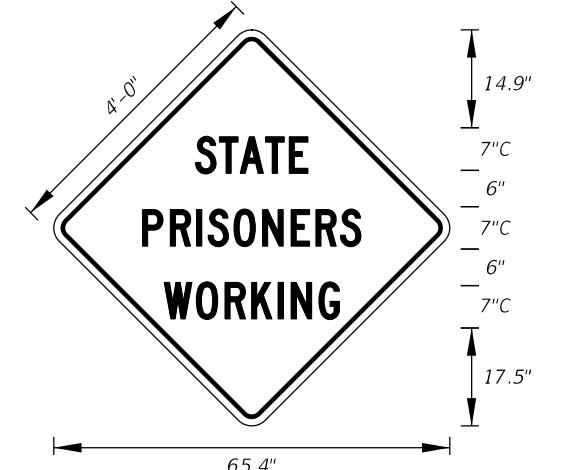


MOT-10-22
4' X 4'
3" Radii 3/4" Border
7" Series C Legend
Orange Background
Black Legend and Border

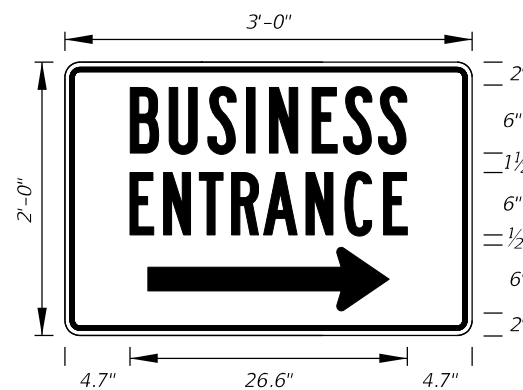


MOT-11-06
3' X 2'
2" Radii 3/4" Border
6" Series B Legend
Blue Background
White Legend and Border

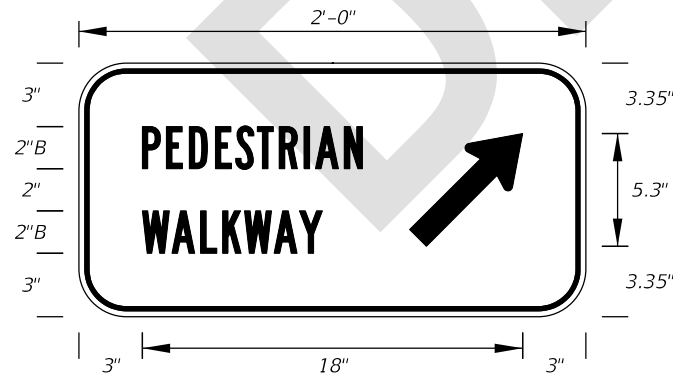

MOT-12R-06
2' X 1'
2" Radii 3/4" Border
2" Series B Legend
White Background
Black Legend and Border
MOT-12L-06
For Diversion
to the left

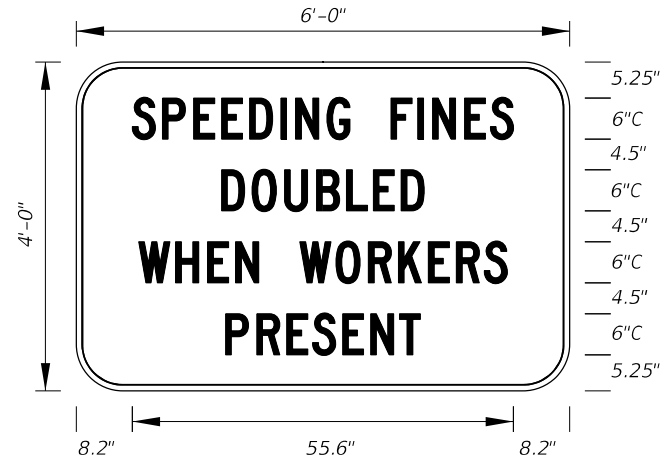


MOT-13-06
Freeway Sign
6' X 4'
6" Radii 3/4" Border
6" Series C Legend
White Background
Black Legend and Border

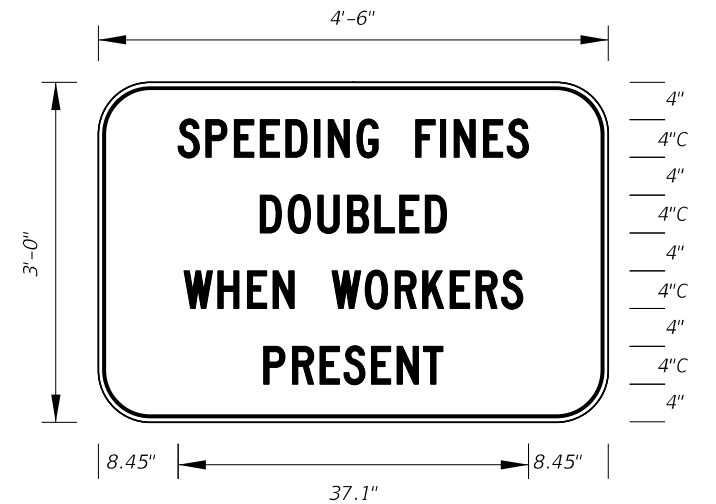


MOT-14-06
Arterial Sign
4'-6" X 3'
5" Radii 3/4" Border
4" Series C Legend
White Background
Black Legend and Border


8/15/2024 1:21:20 PM

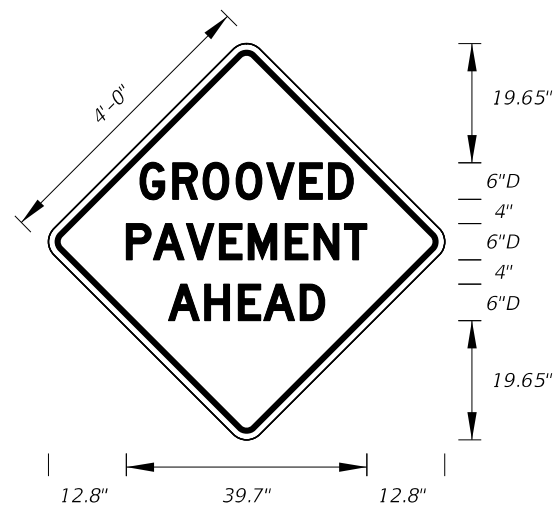


MOT-15-06
4' X 4'
2" Radii 3/4" Border
6" Series D Legend
Orange Background
Black Legend and Border

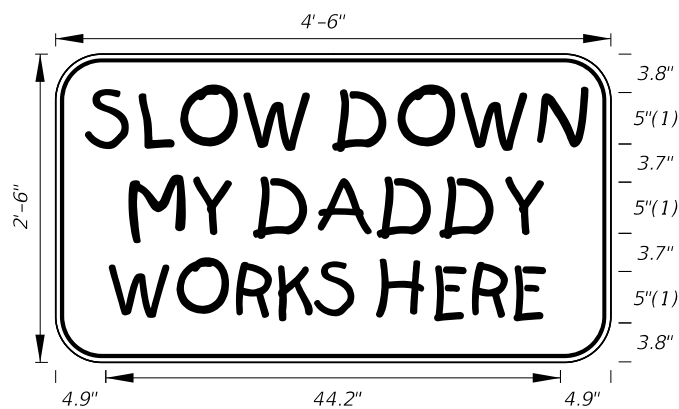


MOT-16-06
4'-6" X 2'-6"
4" Radii 3/4" Border
5" Kids Series Legend
Orange Background
Black Legend and Border

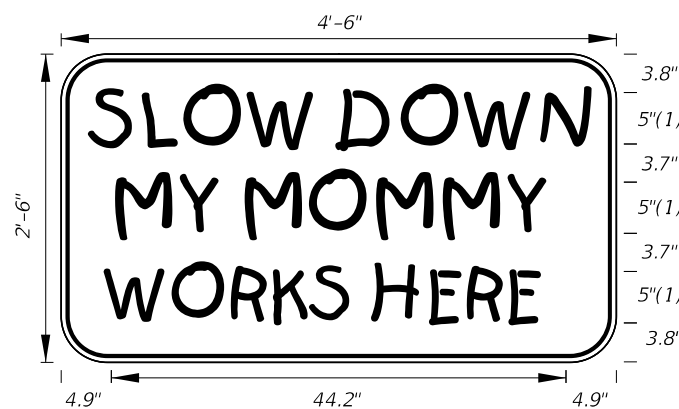


MOT-17-06
4'-6" X 2'-6"
4" Radii 3/4" Border
5" Kids Series Legend
Orange Background
Black Legend and Border

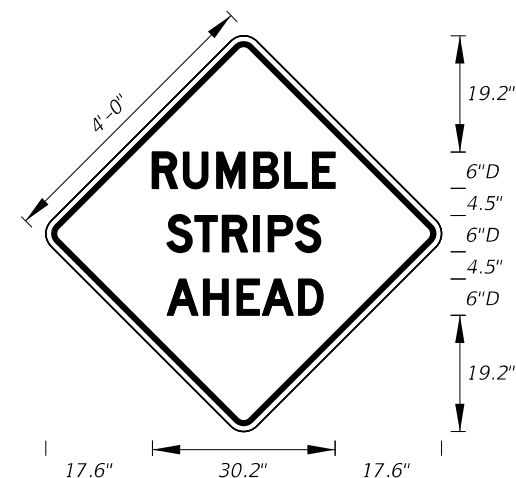


MOT-18-10
4' X 4'
2" Radii 3/4" Border
6" Series D Legend
Orange Background
Black Legend and Border

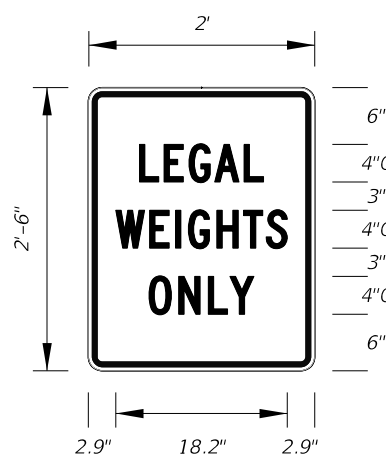


MOT-19-11
2' X 2'-6"
1.13" Radii 3/4" Border
4" Series C Legend
White Background
Red Legend and Border

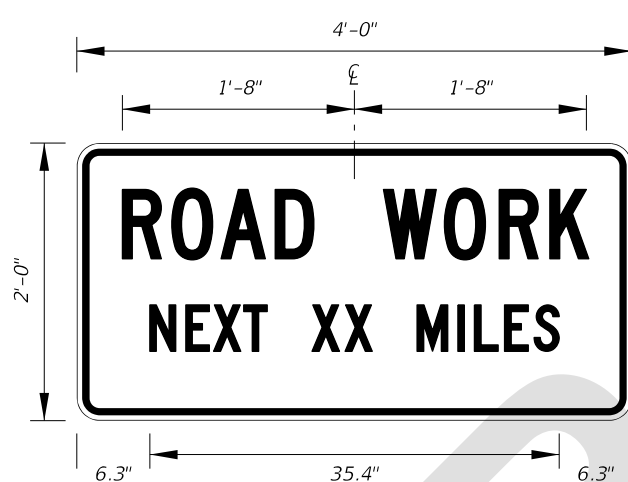


G20-1
4' X 2'
1.5" Radii 3/4" Border
Orange Background
Black Legend and Border

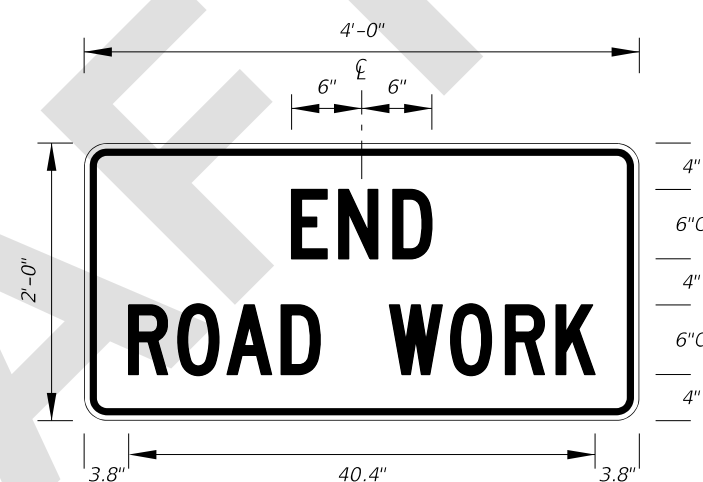


G20-2
4' X 2'
1.5" Radii 3/4" Border
Orange Background
Black Legend and Border

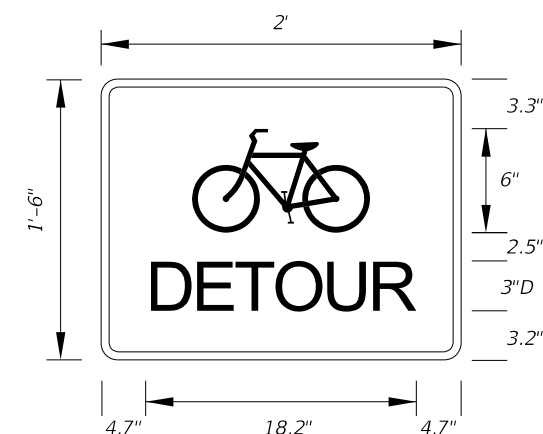

MOT-21-21
2' X 1'-6"
1.5" Radii 1/2" Border
3" Series D Legend
Orange Background
Black Legend and Border

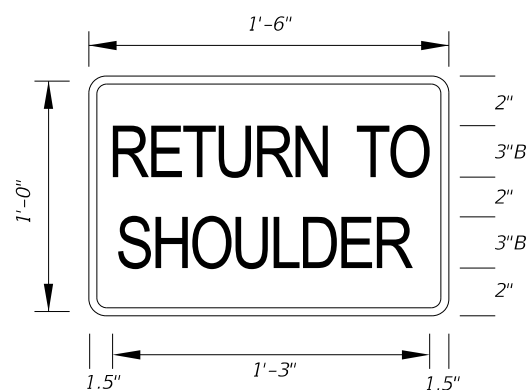

MOT-23-21
1'-6" X 1'-0"
1.5" Radii 1/4" Border
3" Series B Legend
Orange Background
Black Legend and Border

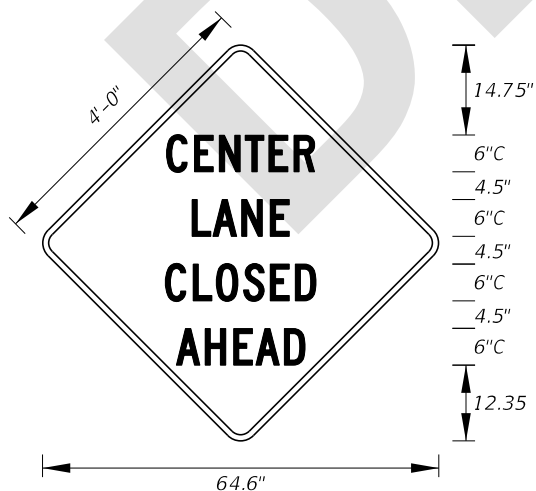

MOT-27-25
4' X 4'
3" Radii 5/4" Border
6" Series C Legend
Orange Background
Black Legend and Border

8/15/2024 1:21:29 PM