

Origination Form

Proposed Revisions to a Standard Plans Index

Originator:	Portal, Benazir	Index Number:	700-102
Date:	7/22/2024	Sheet Number(s):	6, 8, 9, 10, and 12
E-mail:	Benazir.Portal@dot.state.fl.us	Index Title:	SPECIAL SIGN DETAILS

Summary of the changes:

Sheet 6: Added FTP-45-25

Sheet 8: Updated the width of FTP-73-06 to 6'-6"; Deleted FTP-68A-06 and FTP-68B-06

Sheet 9: Updated the width of FTP-74-06, FTP-75-06, and FTP 76-06 to 6'-6"

Sheet 10: Added FTP-100-25

Sheet 12: Deleted MOT-20-21, MOT-22-21, MOT-24-21, MOT-25-21, MOT-26A-22, and MOT-26B-22; Added MOT-27-25










Sheet 6-12: Shifted Signs to accommodate new signs











Commentary/Background:

The 11th edition of the MUTCD now includes Work Zone Bike Warning Signs, which means some MOT signs shown in Index 700-102 can be deleted. Additionally, the 11th edition of the MUTCD includes Temporary Traffic Control Typical Applications for Work in the Vicinity of Bicycle Lanes and Shared Use Paths, which specify what warning signs need to be used and where they should be placed. Consequently, the "BIKE LANE CLOSED AHEAD" plaques (MOT-24-21, MOT-25-21) will no longer be used.


The depictions of FTP-68A-06 and FTP-68B-06 are being deleted since these designs are now sufficiently addressed by the MUTCD 11th Edition.

Other Affected Documents/Offices	Person Contacted	Affected (Yes/No)
Other Standard Plans		No
FDOT Design Manual		No
Standard Specifications		No
Basis of Estimates Manual		No
Approved Product List		No
Construction Office		No
Maintenance Office		No
Implementation		
["FY-Standard Plans (Next Release)"]		

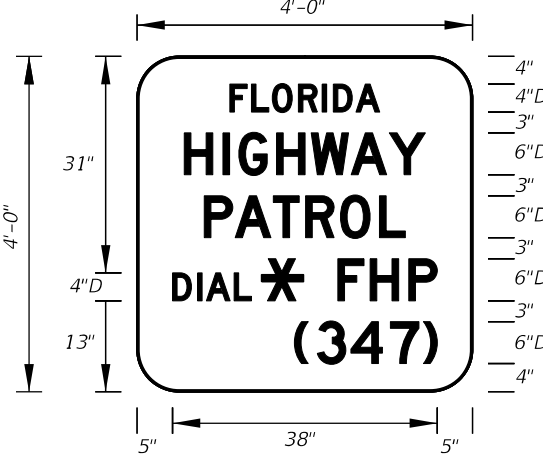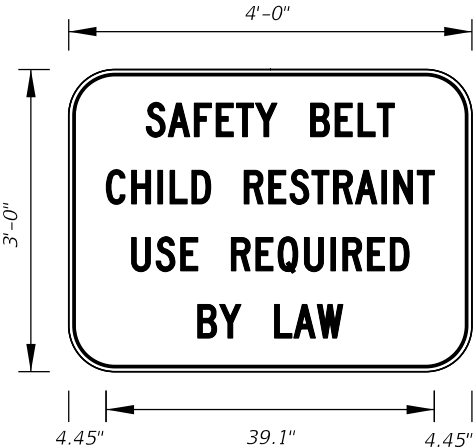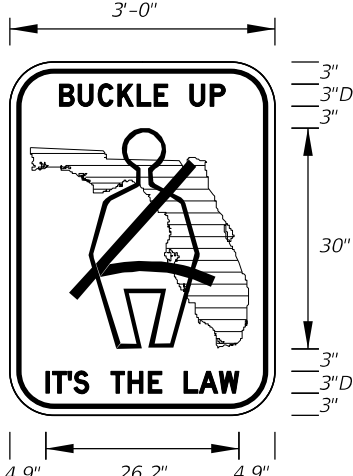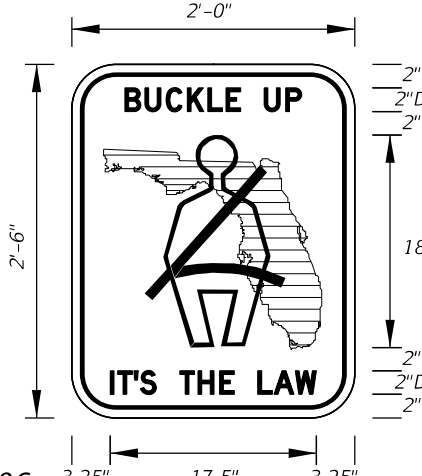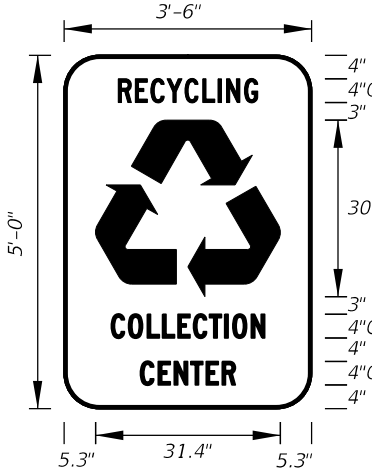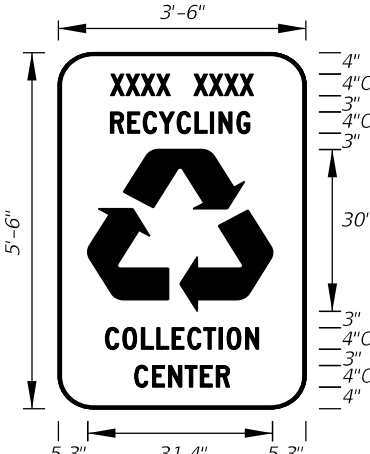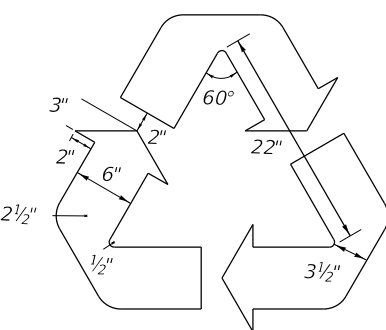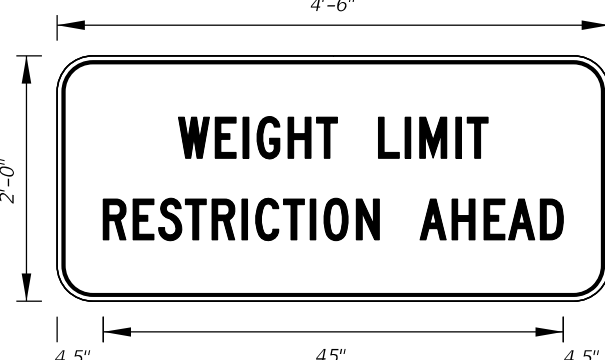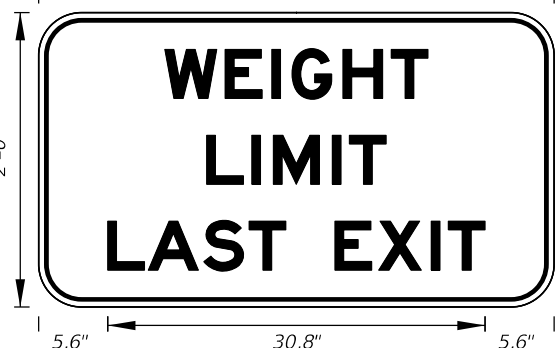 FTP-41-21 2'-6" X 3' 4" Radii ¾" Border		 FTP-42-06 4' X 2'-6" 3" Radii Top 4" Series C Legend		 FTP-43-06 4' X 4' 6" Radii 1" Border Top 4" Series D Legend		 FTP-44-06 9' X 6' 9" Radii ¾" Border											
 FTP-44A-25 FTP-45-06 4' X 3' 5" Radii ¾" Border		Added FTP-45-25  FTP-46-06 3' X 4' 5" Radii ¾" Border 3" Series D Legend White Background Green Florida Symbol Black Legend, Border and Man Belt Symbol		 FTP-47-06 2' X 2'-6" 3" Radii 5/8" Border 2" Series D Legend White Background Green Florida Symbol Black Legend, Border and Man Belt Symbol		 FTP-48-06 3'-6" X 5' 6" Radii 4" Series C Legend Green Background White Legend, Border and Symbol MOVED to Sheet 7											
 FTP-49-06 3'-6" X 5'-6" 6" Radii 4" Series C Legend Green Background Municipality Name Optional White Legend, Border and Symbol		 Detail for FTP-48-06 and FTP-49-06		 FTP-50-06 4'-6" X 2' 3" Radii ¾" Border 4" Series C Legend Yellow Background Black Legend and Border		 FTP-51-06 3' X 2' 3" Radii ¾" Border											
<table><tr><th>LAST REVISION</th><th>DESCRIPTION:</th></tr><tr><td>11/01/21</td><td></td></tr><tr><td>11/01/24</td><td></td></tr></table>		LAST REVISION	DESCRIPTION:	11/01/21		11/01/24		 FY 2024-25 2025-26 STANDARD PLANS		SPECIAL SIGN DETAILS		<table><tr><th>INDEX</th><th>SHEET</th></tr><tr><td>700-102</td><td>6 of 12</td></tr></table>		INDEX	SHEET	700-102	6 of 12
LAST REVISION	DESCRIPTION:																
11/01/21																	
11/01/24																	
INDEX	SHEET																
700-102	6 of 12																

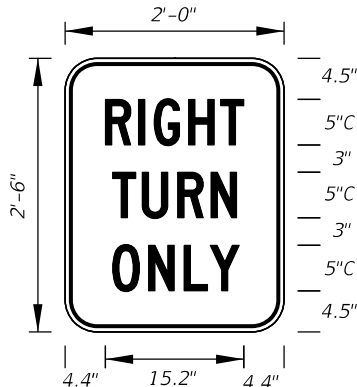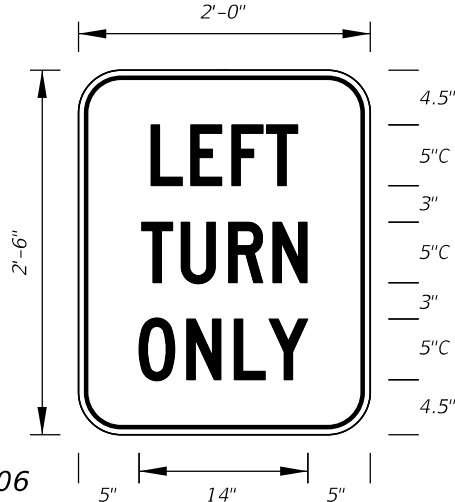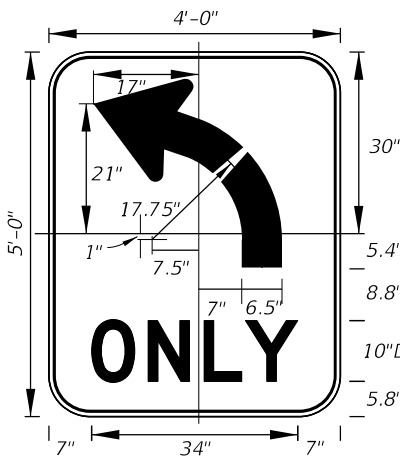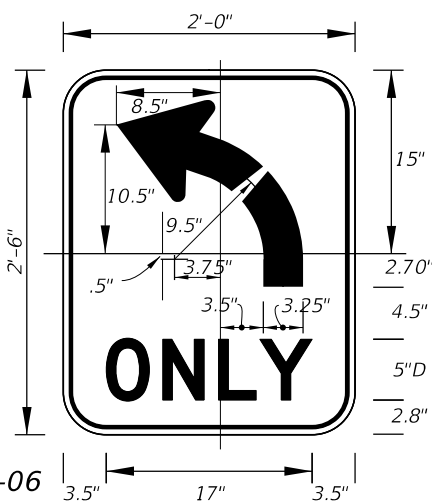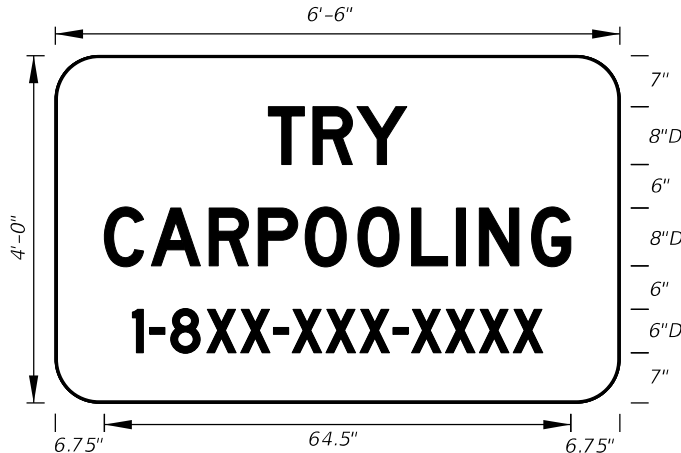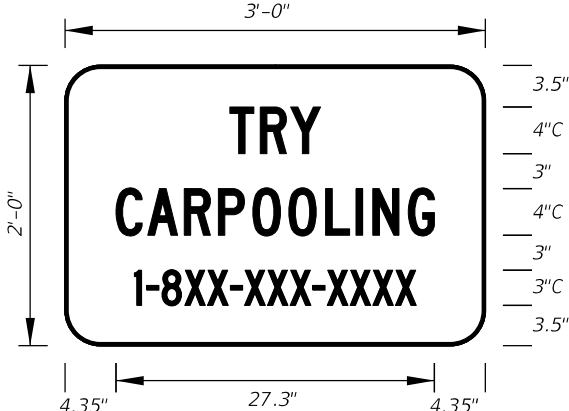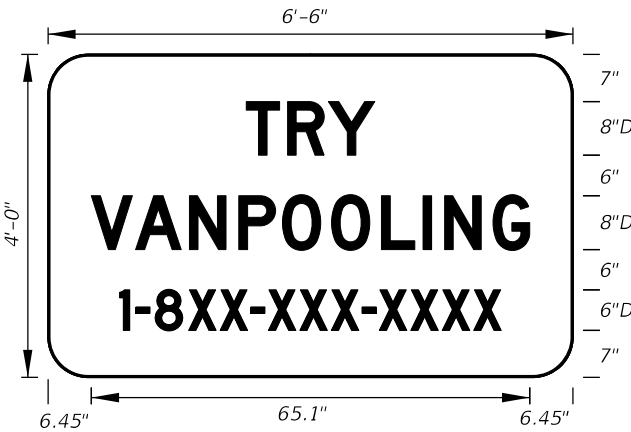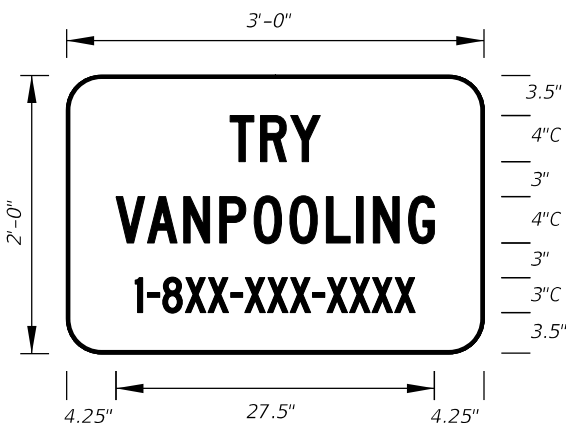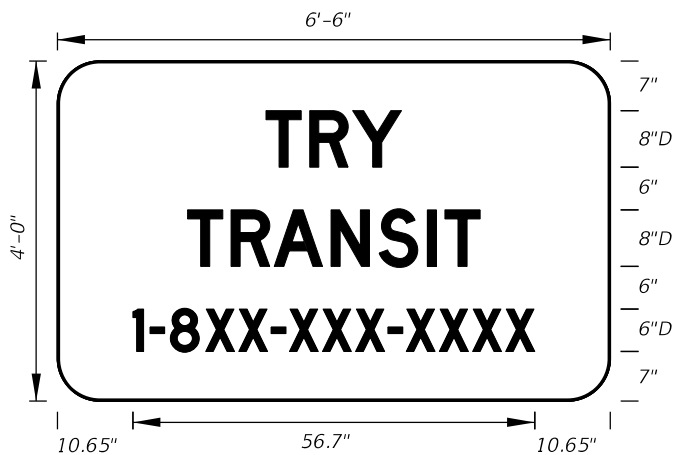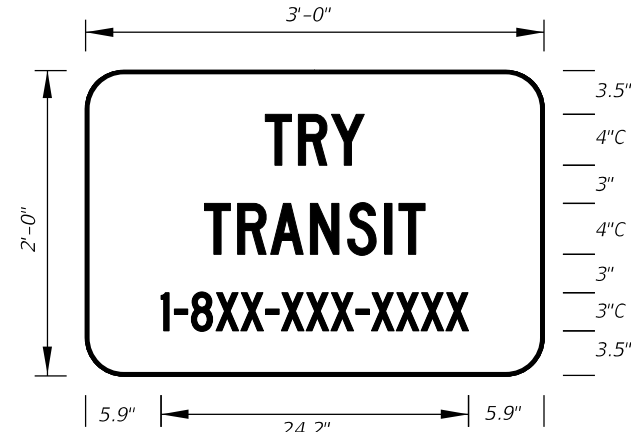 FTP-52-06 2' X 2'-6" 3" Radii 5/8" Border 5" Series C Legend White Background Black Legend and Border		 FTP-53-06 2' X 2'-6" 3" Radii 5/8" Border 5" Series C Legend White Background Black Legend and Border		 FTP-54L-06 4' X 5' 6" Radii 3/4" Border 10" Series D Legend White Background Black Legend and Border FTP-54R-06 for (Right Turn Arrow)		 FTP-55L-06 2' X 2'-6" 3" Radii 3/8" Border 5" Series D Legend White Background Black Legend and Border FTP-55R-06 for (Right Turn Arrow)						
 FTP-56-06 6'-6" X 4' 6" Radii 3/4" Border 8" and 6" Series D Legend Blue Background White Legend and Border Design Project Manager or Transit Administrator will supply correct 1-8XX number.		 FTP-56A-06 3' X 2' 3" Radii 4" and 3" Series C Legend Blue Background White Legend and Border Design Project Manager or Transit Administrator will supply correct 1-8XX number.		 FTP-57-06 6'-6" X 4' 6" Radii 8" and 6" Series D Legend Blue Background White Legend and Border Design Project Manager or Transit Administrator will supply correct 1-8XX number.		 FTP-58-06 3' X 2' 3" Radii 4" and 3" Series C Legend Blue Background White Legend and Border Design Project Manager or Transit Administrator will supply correct 1-8XX number.						
 FTP-59-06 6'-6" X 4' 6" Radii 8" and 6" Series D Legend Blue Background White Legend and Border Design Project Manager or Transit Administrator will supply correct 1-8XX number.		 FTP-60-06 3' X 2' 3" Radii 4" and 3" Series C Legend Blue Background White Legend and Border Design Project Manager or Transit Administrator will supply correct 1-8XX number.		MOVED to Sheet 8  FTP-61-06 3' X 2' 3" Radii 3/4" Border 4" and 3" Series C Legend Yellow Background Black Legend and Border		 FTP-62-06 3' X 3' 2" Radii 3/4" Border 4" and 5" Series C Legend Yellow Background Black Legend and Border						
<table><tr><td>LAST REVISION 11/01/20 11/01/24</td><td>REVISION</td><td>DESCRIPTION:</td></tr></table>		LAST REVISION 11/01/20 11/01/24	REVISION	DESCRIPTION:	 FY 2024-25 2025-26 STANDARD PLANS		SPECIAL SIGN DETAILS		<table><tr><td>INDEX 700-102</td><td>SHEET 7 of 12</td></tr></table>		INDEX 700-102	SHEET 7 of 12
LAST REVISION 11/01/20 11/01/24	REVISION	DESCRIPTION:										
INDEX 700-102	SHEET 7 of 12											

10/3/2023 3:09:45 PM

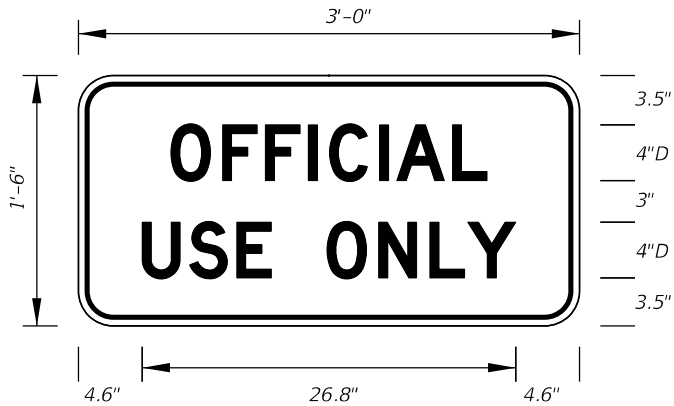

FTP-65-06
3' X 1'-6"
2" Radii $\frac{3}{4}$ " Border
4" Series D Legend
White Background
Black Legend and Border



FTP-66-21
4'X5'
3" Radii 1" Border
6" Series D Legend
Blue Background
White Legend and Border




FTP-67-21
5.5' X 6'
3" Radii 1" Border
8" Series D Legend
Blue Background
White Legend and Border



DETAIL for **FTP-66** AND **FTP-67**


Sign Mounting Holes Can Be Punched Or Field Drilled With No Obstruction To Text Or Symbols From Holes Or Bolts.

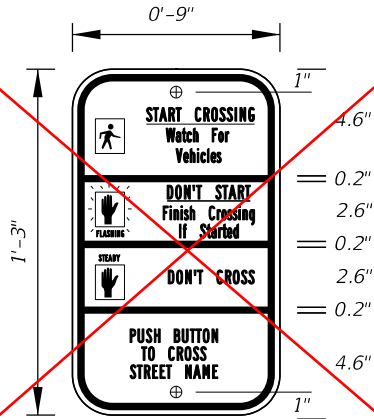

FTP-68A-06
9" X 1'-3"
1.5" Radii $\frac{3}{4}$ " Border
Series B Legend
White Background
Black Legend and Border


See Standard Highway Signs Manual, Sign R10-3b For Letter Size Spacing And Symbol Sizes.

Sign Mounting Holes Can Be Punched Or Field Drilled With No Obstruction To Text Or Symbols From Holes Or Bolts.

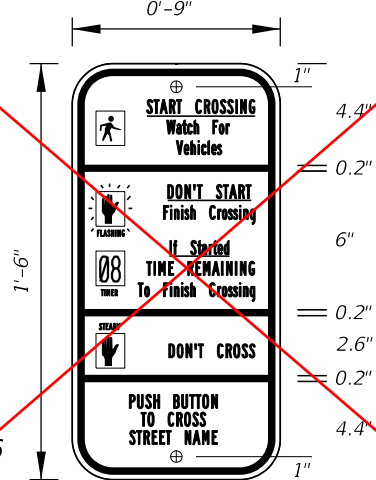


FTP-68B-06
9" X 1'-6"
1.5" Radii $\frac{3}{4}$ " Border
Series B Legend
White Background
Black Legend and Border

See Standard Highway Signs Manual, Sign R10-3b For Letter Size Spacing And Symbol Sizes.

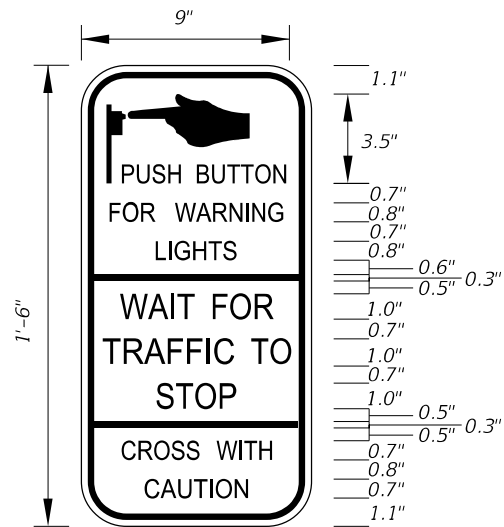


FTP-68C-21
9" X 1'-6"
1.5" Radii $\frac{1}{4}$ " Border


Series D Legend
White Background
Black Legend and Border

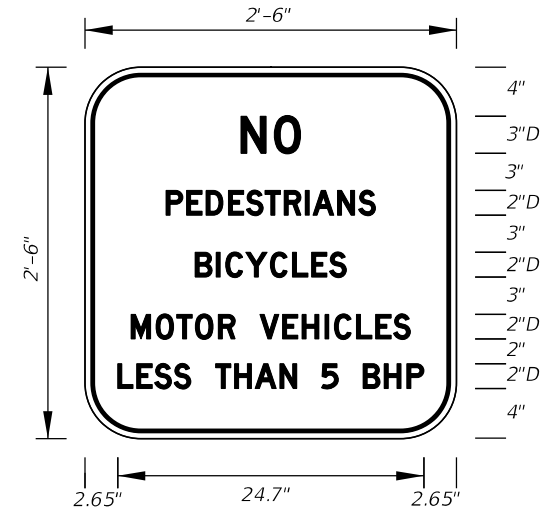

FTP-69-06
2'-6" X 2'-6"
4" Radii $\frac{3}{4}$ " Border
2" and 3" Series D Legend
White Background
Black Legend and Border

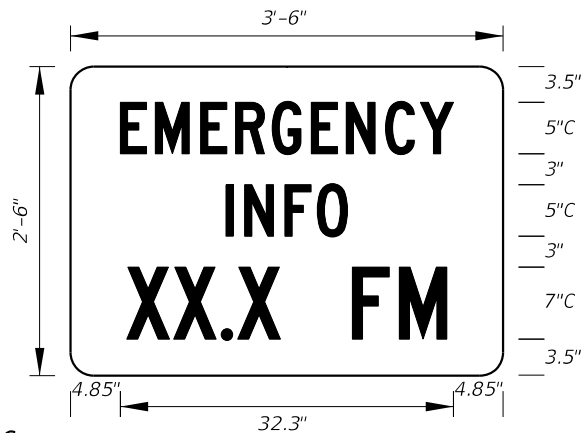

FTP-70-06
3'-6" X 2'-6"
2.25" Radii $\frac{3}{4}$ " Border
5" Series C and 7" Series C Legend
Blue Background
White Legend and Border

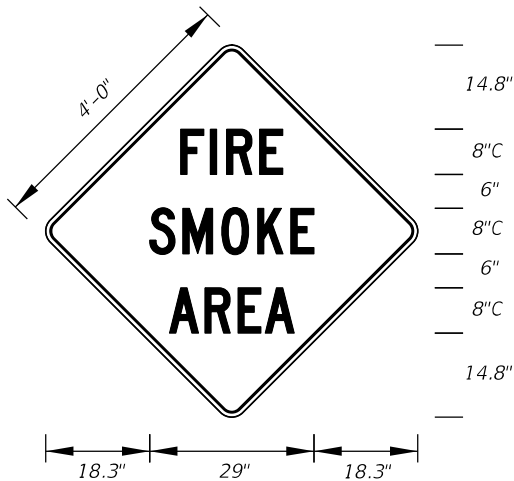


FTP-71-06
4' X 4'
2" Radii $\frac{3}{4}$ " Border
8" Series C Legend
Yellow Background
Black Legend and Border

UPDATED dimensions



FTP-72-06
3' X 3'
2" Radii $\frac{3}{4}$ " Border

6" Series C Legend
Yellow Background
Black Legend and Border

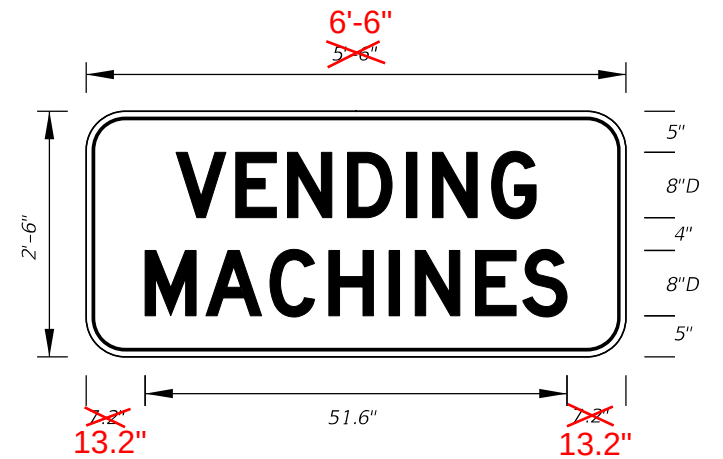

FTP-73-06
5'-6" X 2'-6"
4" Radii $\frac{3}{4}$ " Border
8" Series D Legend
Blue Background
White Legend and Border

6'-6" x 2'-6" to match above change

LAST REVISION DESCRIPTION:



FY ~~2024-25~~ 2025-26
STANDARD PLANS

SPECIAL SIGN DETAILS


INDEX SHEET
700-102 8 of 12

10/3/2023 3:09:52 PM




FTP-74-06
5'-6" X 2'-6"
4" Radii $\frac{3}{4}$ " Border
6" Series D Legend
Blue Background
White Legend and Border

MOVED TO SHEET 8

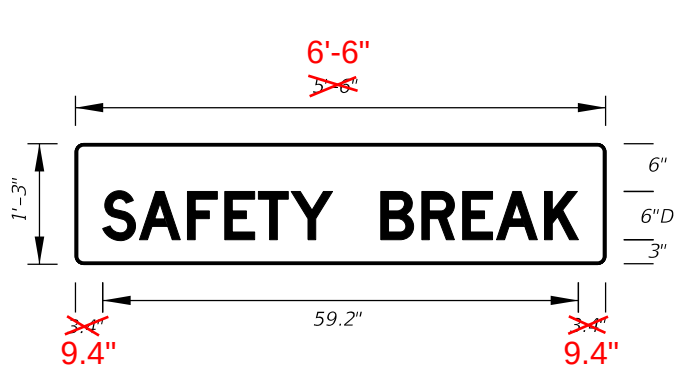


FTP-75-06
5'-6" X 1'-3"
1" Radii
6" Series D Legend
Blue Background
White Legend

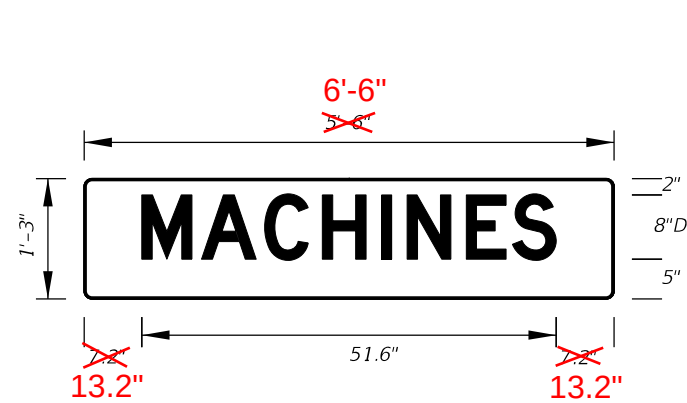


FTP-76-06
5'-6" X 1'-3"
1" Radii
8" Series D Legend
Blue Background
White Legend


Match above change

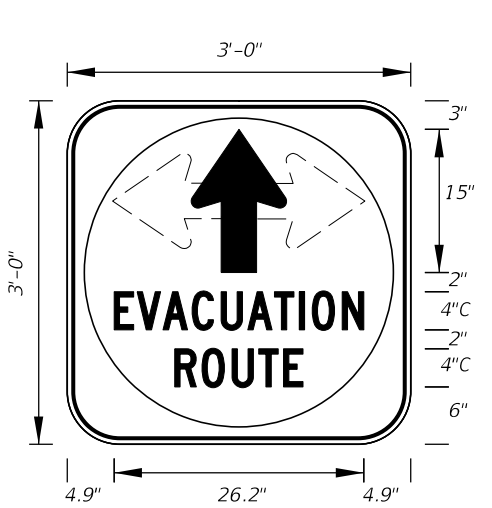

FTP-77-06
3' X 3'
5" Radii $\frac{3}{4}$ " Border
4" Series C Legend
White Background with Blue Circle Background
White Legend and Black Border

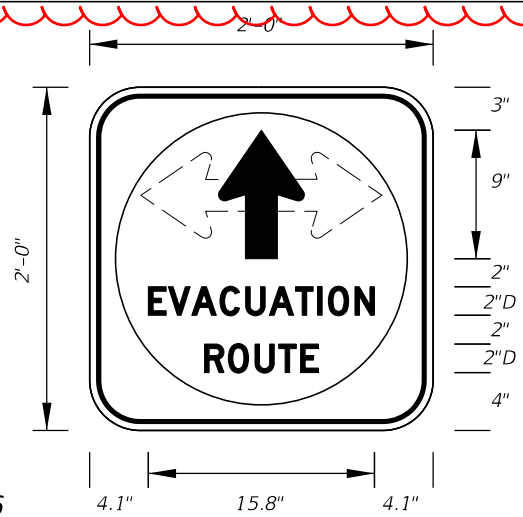


FTP-78-06
2' X 2'
3" Radii $\frac{3}{4}$ " Border
2" Series D Legend
White Background with Blue Circle Background
White Legend and Black Border

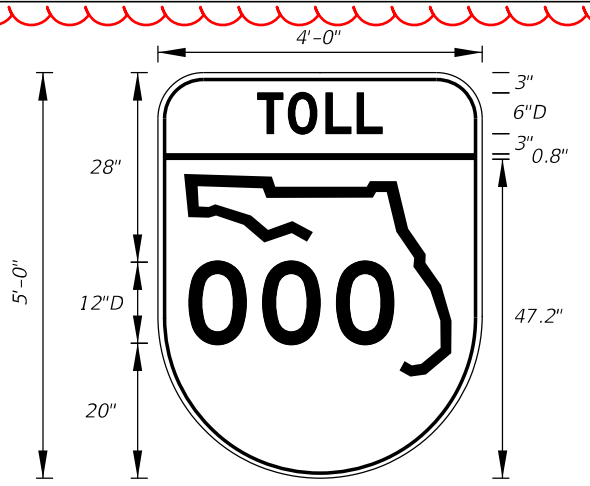


FTP-79-06
4' X 5'
6" Radii $\frac{3}{4}$ " Border
6" and 12" Series D Legend
Top Yellow Background with Black Legend and Black Border
Bottom White Background with Black Legend and Border


UPDATED dimensions

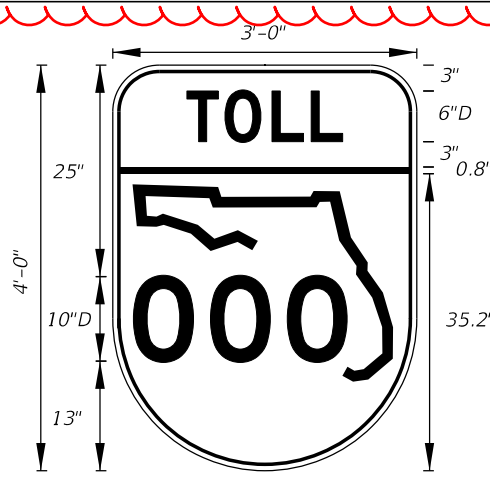


FTP-80-06
3' X 4'
5" Radii $\frac{3}{4}$ " Border
6" and 10" Series D Legend
Top Yellow Background with Black Legend and Black Border
Bottom White Background with Black Legend and Border

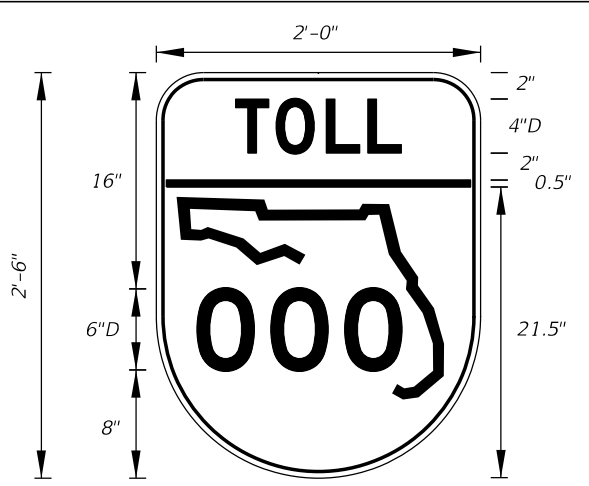

FTP-81-06
2' X 2'-6"
3" Radii $\frac{3}{4}$ " Border
4" and 6" Series D Legend
Top Yellow Background with Black Legend and Black Border
Bottom White Background with Black Legend and Border

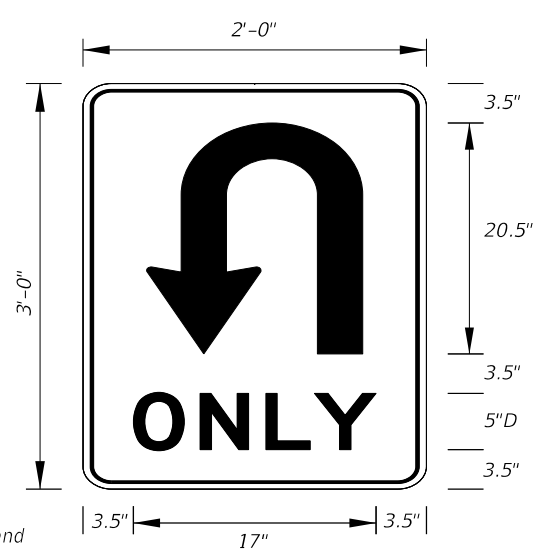


FTP-82-08
2' X 3'
1.5" Radii
5" Series D Legend
White Background
Black Legend and Border

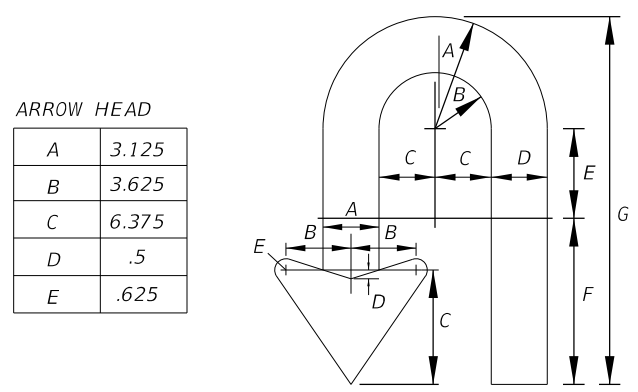


ARROW HEAD	
A	3.125
B	3.625
C	6.375
D	.5
E	.625

ARROW BODY						
A	B	C	D	E	F	G
6.25	3.125	3.125	3.125	5	9.25	20.5

FTP-82-08
Details

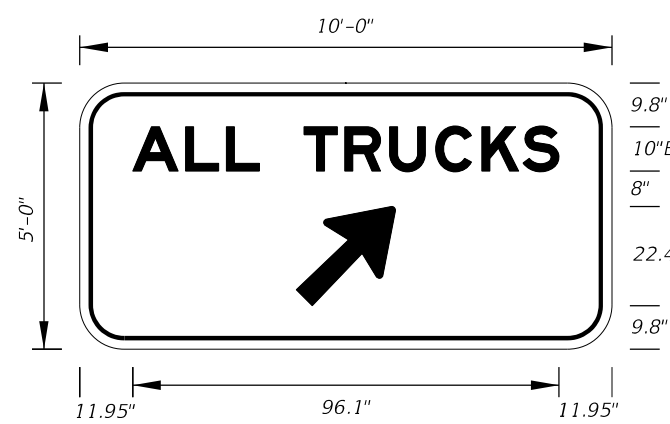

FTP-83-08
10'-0" X 5'-0"
8" Radii
10" Series E Legend
Green Background
White Legend

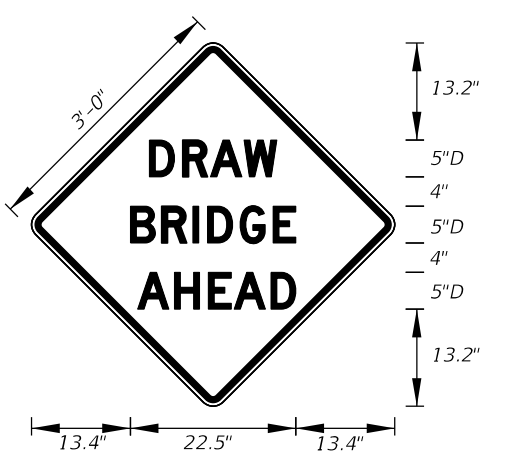

FTP-84-09
3' X 3'
1.5" Radii
5" Series D Legend
Yellow Background
Black Legend and Border



FY ~~2024-25~~ 2025-26
STANDARD PLANS

SPECIAL SIGN DETAILS

INDEX
700-102

SHEET
9 of 12

LAST REVISION
~~11/01/20~~
11/01/24

DESCRIPTION:

2'-6"

3'-0"

23.18"

LEFT TURN
YIELD ON
FLASHING
YELLOW
ARROW

3.75"

3.5" C

2.75"

3.5" C

2.75"

3.5" C

2.75"

3.5" C

2.75"

3.5" C

3.75"

FTP-85-13

2'-6" X 3'

1.875" Radii 3/4" Border

3.5" Series C Legend

White Background

Black Legend and Border

1.5" D

0.5"

1.5" D

0.6"

0.7"

1'-6"

0.7"

1.3" C

0.5"

1.2" C

0.5"

9"

STATE
LAW

STOP

FOR

WITHIN
CROSSWALK

Series C Legend and
Series D Legend

White on Yellow

Black Legend and Border

FTP-86-21

9" X 2'-3"

1.5" Radii No Border

15'-6"

8'-6"

15.5"

155"

15.5"

9"

12"EM

9"

12"EM

9"

22"

8"

12"D

9"

REST AREA
TRUCK PARKING

Digital
Display

XXX

SPACES AVAILABLE

FTP-87-21

15'-6" X 8'-6"

12" Radii 2" Border

Series D Legend

Series EM Legend

Blue Background

White Legend and Border

15'-6"

8'-6"

15.5"

155"

15.5"

9"

12"EM

9"

12"EM

9"

22"

8"

12"D

9"

WEIGH STATION
TRUCK PARKING

Digital
Display

XXX

SPACES AVAILABLE

FTP-88-21

15'-6" X 8'-6"

12" Radii 2" Border

Series D Legend

Series EM Legend

Blue Background

White Legend and Border

16'-6"

8'-6"

16.7"

164.6"

16.7"

9"

12"EM

9"

12"EM

9"

22"

8"

12"D

9"

WELCOME CENTER
TRUCK PARKING

Digital
Display

XXX

SPACES AVAILABLE

FTP-89-21

16'-6" X 8'-6"

12" Radii 2" Border

Series D Legend

Series EM Legend

Blue Background

White Legend and Border

3'-0"

3'-0"

2.5"

31"

2.5"

3"

3"C

2"

3"C

2"

5"D

2"

3"C

2"

3"C

2"

3"C

2"

3"C

3"

ALL TRAFFIC
BOTH DIRECTIONS
STOP
WHILE
SCHOOL BUSES
LOAD OR UNLOAD

3" Series C Legend and
5" Series D Legend

White Background

Black Legend and Border

FTP-90-22

3'-0" X 3'-0"

1.5" Radii 3/4" Border

3'-0"

3'-0"

2.5"

31"

2.5"

3"

3"C

2"

3"C

2"

5"D

2"

3"C

2"

3"C

2"

3"C

3"

STOP
WHILE
SCHOOL BUSES
LOAD OR UNLOAD
THIS ROADWAY

3" Series C Legend and
5" Series D Legend

White Background

Black Legend and Border

FTP-91-22

3'-0" X 3'-0"

1.5" Radii 3/4" Border

4'-0"

14.7"

8"C

6"

8"C

6"

8"C

14.7"

65.4"

STAY
IN YOUR
LANE

8" Series C Legend

Orange Background

Black Legend and Border

MOT-1-22

4' X 4'

3" Radii 3/4" Border

4'-0"

14.7"

8"C

6"

8"C

6"

8"C

14.7"

65.4"

LITTER
PICK UP
AHEAD

8" Series C Legend

Orange Background

Black Legend and Border

MOT-4-22

4' X 4'

3" Radii 3/4" Border

4'-0"

16.4"

7"C

5"

7"C

5"

7"C

18"

65.4"

TRUCKS
ENTERING
HIGHWAY

7" Series C Legend

Orange Background

Black Legend and Border

MOT-5-22

4' X 4'

3" Radii 3/4" Border

5'-0"

21.9"

8"D

6"

8"D

6"

8"D

24.5"

82.4"

TRUCKS
ENTERING
HIGHWAY

8" Series D Legend

Orange Background

Black Legend and Border

MOT-6-22

5' X 5'

3" Radii 3/4" Border

5'-0"

19.7"

7"D

5"

7"D

5"

7"D

19.7"

82.4"

TRUCKS
TURNING
LEFT
000 FT

7" Series D Legend

Orange Background

Black Legend and Border

MOT-7-22

5' X 5'

3" Radii 3/4" Border

5'-0"

19.7"

7"D

5"

7"D

5"

7"D

19.7"

82.4"

TRUCKS
TURNING
LEFT
000 FT

7" Series D Legend

Orange Background

Black Legend and Border

MOT-8-22

5' X 5'

3" Radii 3/4" Border

5'-0"

19.7"

7"D

5"

7"D

5"

7"D

19.7"

82.4"

TRUCKS
TURNING
LEFT
000 FT

7" Series D Legend

Orange Background

Black Legend and Border

MOT-9-22

5' X 5'

3" Radii 3/4" Border

5'-0"

19.7"

7"D

5"

7"D

5"

7"D

19.7"

82.4"

TRUCKS
TURNING
LEFT
000 FT

7" Series D Legend

Orange Background

Black Legend and Border

10/3/2023 3:09:59 PM

LAST REVISION 11/01/21 11/01/24	DESCRIPTION:	FDOT FY 2024-25 2025-26 STANDARD PLANS	SPECIAL SIGN DETAILS	INDEX 700-102	SHEET 10 of 12
--	--------------	---	----------------------	------------------	-------------------

MOT-8-22
5' X 5'
3" Radii ¾" Border

7" Series D Legend
Orange Background
Black Legend and Border

MOT-9-22
5' X 5'
3" Radii ¾" Border

7" Series D Legend
Orange Background
Black Legend and Border

MOT-10-22
4' X 4'
3" Radii ¾" Border

7" Series C Legend
Orange Background
Black Legend and Border

MOT-11-06
3' X 2'
2" Radii ¾" Border

6" Series B Legend
Blue Background
White Legend and Border

MOT-12R-06
2' X 1'
2" Radii ¾" Border

2" Series B Legend
White Background
Black Legend and Border

MOT-12L-06
For Diversion
to the left

2" Series B Legend
White Background
Black Legend and Border

MOT-13-06
Freeway Sign
6' X 4'
6" Radii ¾" Border

6" Series C Legend
White Background
Black Legend and Border

MOT-14-06
Arterial Sign
4'-6" X 3'
5" Radii ¾" Border

4" Series C Legend
White Background
Black Legend and Border

MOT-15-06
4' X 4'
2" Radii ¾" Border

6" Series D Legend
Orange Background
Black Legend and Border

MOT-16-06
4'-6" X 2'-6"
4" Radii ¾" Border

5" Kids Series Legend
Orange Background
Black Legend and Border

MOT-17-06
4'-6" X 2'-6"
4" Radii ¾" Border

5" Kids Series Legend
Orange Background
Black Legend and Border

MOT-18-10
4' X 4'
2" Radii ¾" Border

6" Series D Legend
Orange Background
Black Legend and Border

MOT-19-11
2' X 2'-6"
1.13" Radii ¾" Border

4" Series C Legend
White Background
Red Legend and Border

LAST
REVISION
11/01/21
11/01/24

REVISION


DESCRIPTION:

FY ~~2024-25~~ 2025-26
STANDARD PLANS


SPECIAL SIGN DETAILS

INDEX
700-102


SHEET
11 of 12

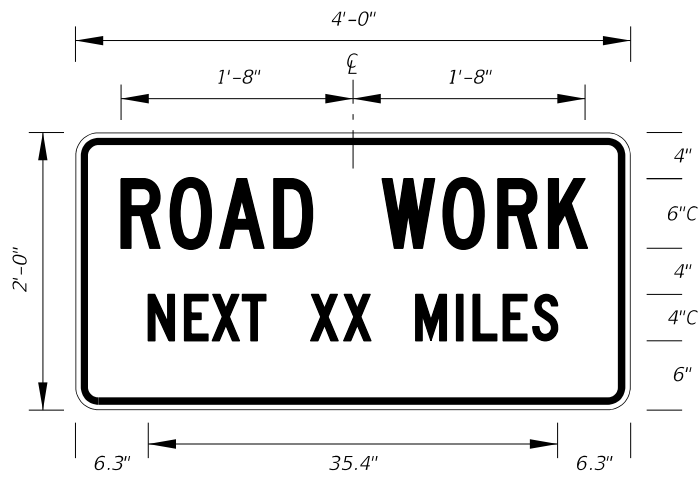


G20-1
4' X 2'
1.5" Radii 3/4" Border
Orange Background
Black Legend and Border

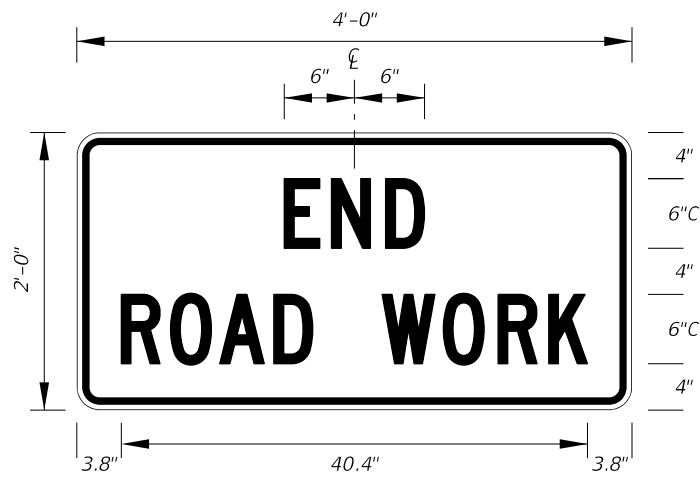


G20-2
4' X 2'
1.5" Radii 3/4" Border
Orange Background
Black Legend and Border

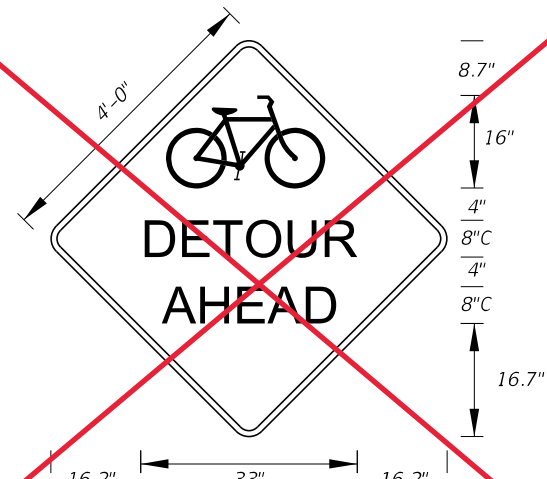


MOT-20-21
4' X 4'
3" Radii 3/4" Border
8" Series C Legend
Orange Background
Black Legend and Border

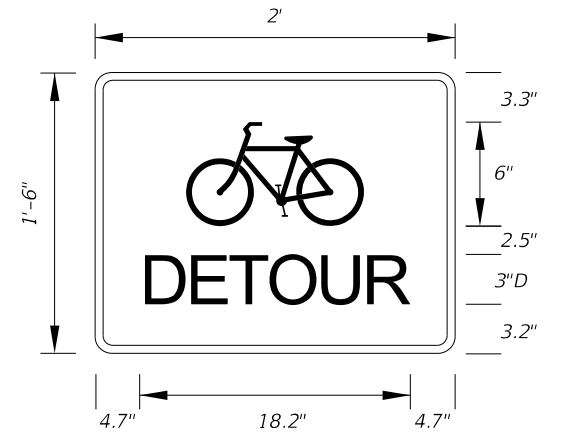

MOT-21-21
2' X 1'-6"
1.5" Radii 1/2" Border
3" Series D Legend
Orange Background
Black Legend and Border

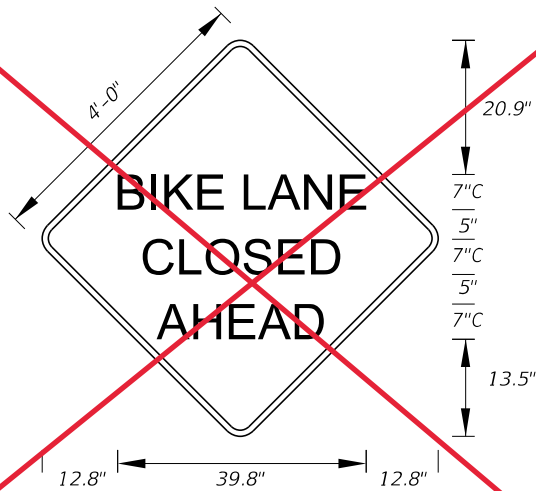

MOT-22-21
4' X 4'
3" Radii 3/4" Border
7" Series C Legend
Orange Background
Black Legend and Border

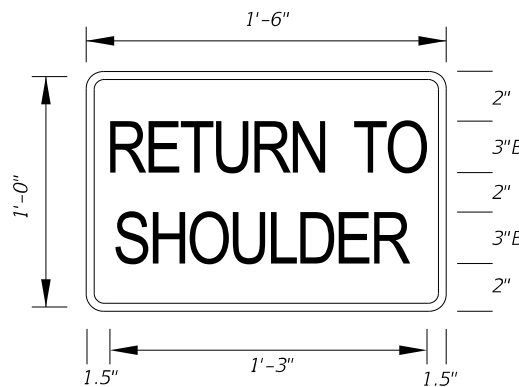


MOT-23-21
1'-6" X 1'-0"
1.5" Radii 1/4" Border
3" Series B Legend
Orange Background
Black Legend and Border




MOT-24-21
2'-6" X 1'-6"
1.5" Radii 1/2" Border
4" Series C Legend
White Background
Black Legend and Border




MOT-25-21
2'-0" X 1'-6"
1.5" Radii 1/2" Border
4" Series B Legend
White Background
Black Legend and Border

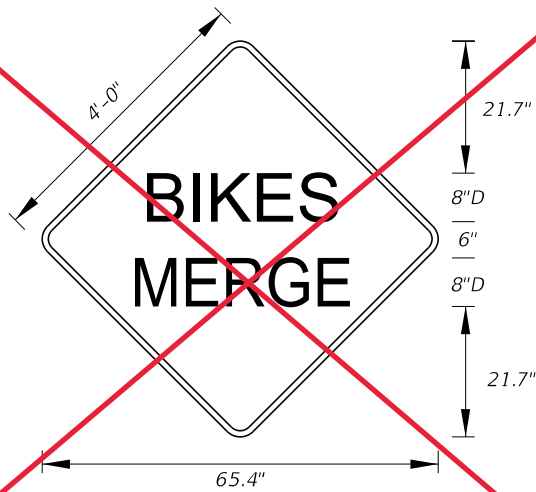

MOT-26A-22
4' X 4'
3" Radii 3/4" Border
8" Series D Legend
Orange Background
Black Legend and Border

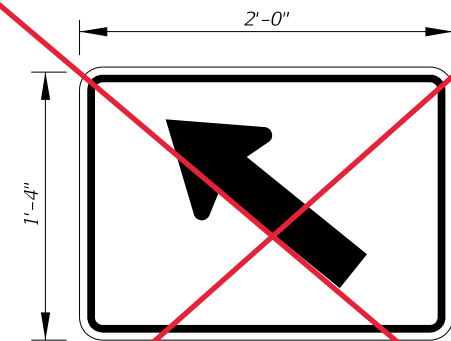

MOT-26B-22
2'-0" X 1'-4"
1.5" Radii 5/8" Border
Orange Background
Black Legend and Border

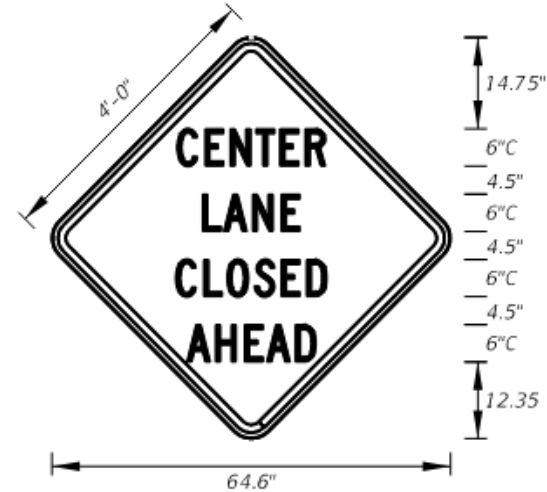

MOT-27-24
4' X 4'
3" Radii 5/8" Border
6" Series C Legend
Orange Background
Black Legend and Border

Added sign
MOT-27-25

10/3/2023 3:10:13 PM

8/1/2024 10:48:48 AM

FTP-41-21
2'-6" X 3"
4" Radii ¾" Border

2" and 4" Series C Legend
White Background
Black Legend and Border

FTP-42-06
4' X 2'-6"
3" Radii
Top 4" Series C Legend

Bottom 2" Series EM Legend
White Background
Blue Legend and Border

FTP-43-06
4' X 4"
6" Radii 1" Border
Top 4" Series D Legend

Bottom 6" Series D Legend
Blue Background
White Legend and Border

FTP-44-06
9' X 6"
9" Radii ¾" Border

8" Series D Legend
White Background
Black Legend and Border

FTP-44A-25
4' X 3"
5" Radii ¾" Border

4" Series C Legend
White Background
Black Legend and Border

FTP-45-25
4'-0" X 4'-0"
1.5" Radii
0.4" Border

2.5" Series C Legend
2" Series C Legend
1.5" Series C Legend and
White Background
Black Legend and Border

FTP-46-06
3' X 4"
5" Radii ¾" Border
3" Series D Legend
White Background
Green Florida Symbol
Black Legend, Border and Man Belt Symbol

FTP-47-06
2' X 2'-6"
3" Radii ⅝" Border
2" Series D Legend
White Background
Green Florida Symbol
Black Legend, Border and Man Belt Symbol


FTP-48-06
3'-6" X 5"
6" Radii
4" Series C Legend
Green Background
White Legend, Border and Symbol

FTP-49-06
3'-6" X 5'-6"
6" Radii
4" Series C Legend
Green Background
Municipality Name Optional
White Legend, Border and Symbol

Detail for **FTP-48-06** and **FTP-49-06**

FTP-50-06
4'-6" X 2"
3" Radii ¾" Border
4" Series C Legend
Yellow Background
Black Legend and Border

8/1/2024 10:48:56 AM

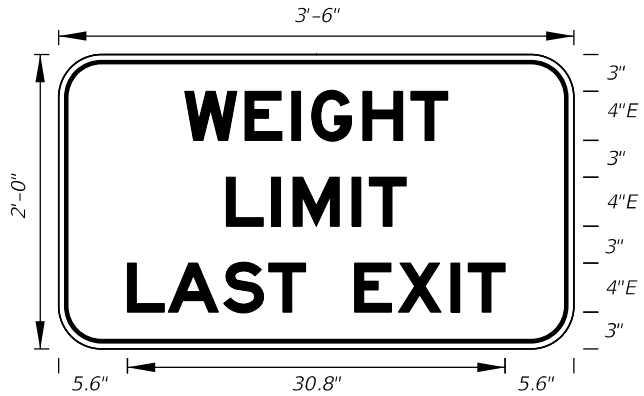

3'-6"

2'-0"

3"

4"E

3"

4"E

3"

4"E

3"


5.6"

30.8"

5.6"

FTP-51-06
3' X 2'
3" Radii $\frac{3}{4}$ " Border

4" Series E Legend
White Background
Black Legend and Border

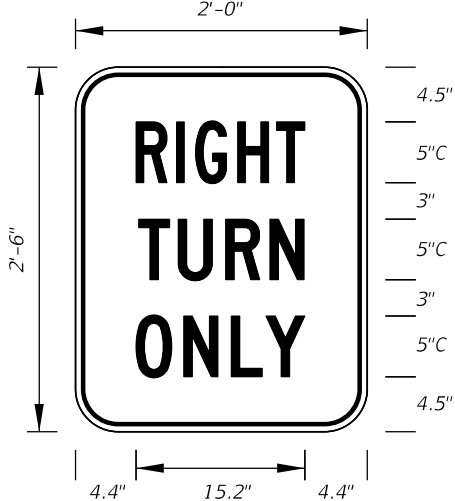

2'-0"

2'-6"

4.5"

5"C

3"

5"C

3"

5"C

3"

5"C

4.5"


4.4"

15.2"

4.4"

FTP-52-06
2' X 2'-6"
3" Radii $\frac{5}{8}$ " Border

5" Series C Legend
White Background
Black Legend and Border

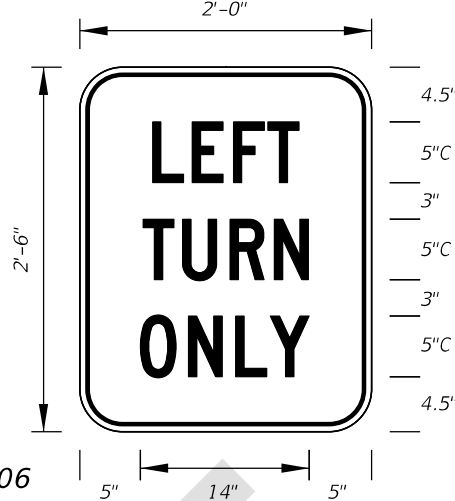

2'-0"

2'-6"

4.5"

5"C

3"

5"C

3"

5"C

3"

5"C


4.5"

5"

14"

5"

FTP-53-06
2' X 2'-6"
3" Radii $\frac{5}{8}$ " Border
5" Series C Legend
White Background
Black Legend and Border

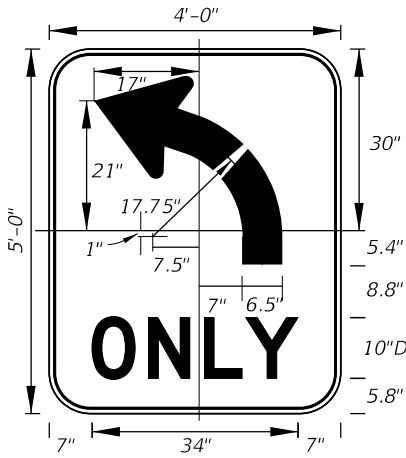

4'-0"

5'-0"

30"

5.4"

8.8"

10"D

5.8"


7"

34"

7"

FTP-54L-06
4' X 5'
6" Radii $\frac{3}{4}$ " Border
10" Series D Legend
White Background
Black Legend and Border

FTP-54R-06 for
(Right Turn Arrow)

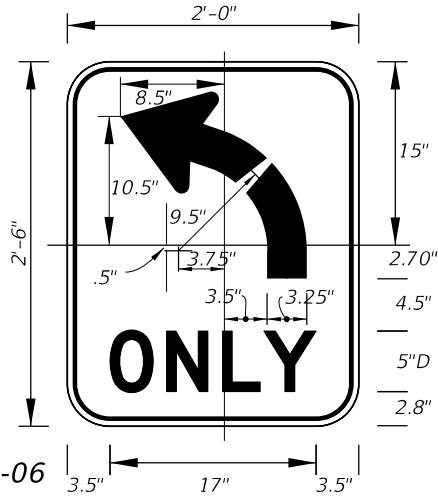

2'-0"

2'-6"

15"

2.70"

4.5"

5"D

2.8"

3.5"

17"

3.5"

FTP-55L-06
2' X 2'-6"
3" Radii $\frac{3}{8}$ " Border
5" Series D Legend
White Background
Black Legend and Border

FTP-55R-06 for
(Right Turn Arrow)



6'-6"

4'-0"

7"

8"D

6"

8"D

6"

6"D

7"


6.75"

64.5"

6.75"

FTP-56-06
6'-6" X 4'
6" Radii $\frac{3}{4}$ " Border
8" and 6" Series D Legend
Blue Background
White Legend and Border

Design Project Manager
or Transit Administrator
will supply correct 1-8XX
number.

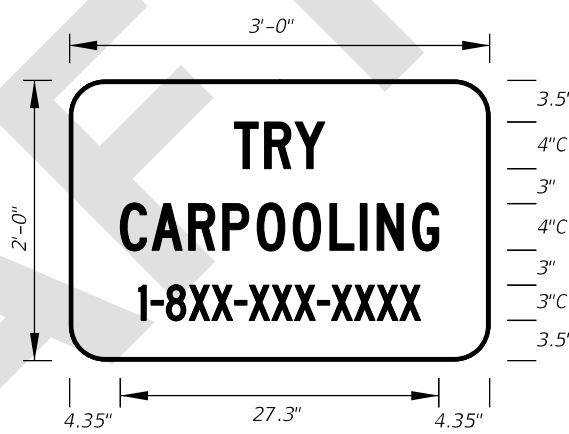

3'-0"

2'-0"

3.5"

4"C

3"

4"C

3"

3"C

3.5"


4.35"

27.3"

4.35"

FTP-56A-06
3' X 2'
3" Radii
4" and 3" Series C Legend
Blue Background
White Legend and Border

Design Project Manager
or Transit Administrator
will supply correct 1-8XX
number.

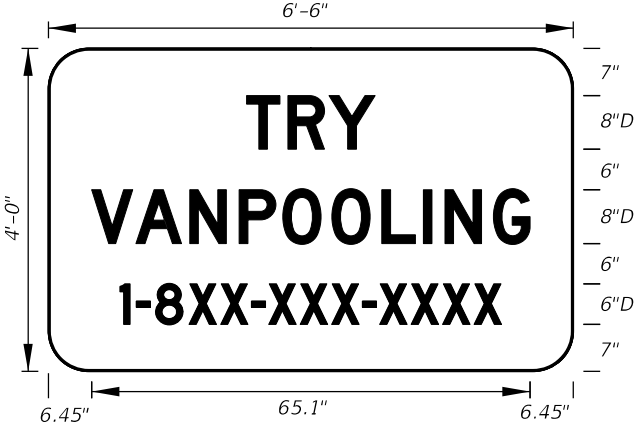

6'-6"

4'-0"

7"

8"D

6"

8"D

6"

6"D

7"


6.45"

65.1"

6.45"

FTP-57-06
6'-6" X 4'
6" Radii
8" and 6" Series D Legend
Blue Background
White Legend and Border

Design Project Manager
or Transit Administrator
will supply correct 1-8XX
number.

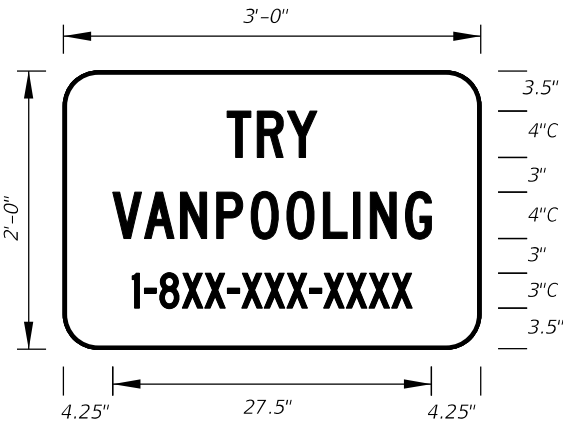

3'-0"

2'-0"

3.5"

4"C

3"

4"C

3"

3"C

3.5"


4.25"

27.5"

4.25"

FTP-58-06
3' X 2'
3" Radii
4" and 3" Series C Legend
Blue Background
White Legend and Border

Design Project Manager
or Transit Administrator
will supply correct 1-8XX
number.

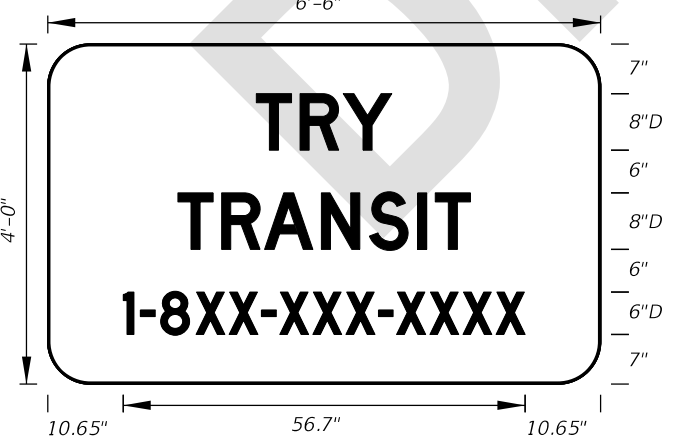

6'-6"

4'-0"

7"

8"D

6"

8"D

6"

6"D

7"


10.65"

56.7"

10.65"

FTP-59-06
6'-6" X 4'
6" Radii
8" and 6" Series D Legend
Blue Background
White Legend and Border

Design Project Manager
or Transit Administrator
will supply correct 1-8XX
number.

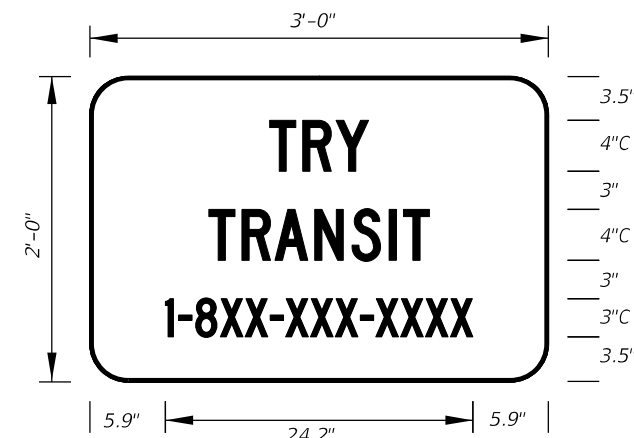

3'-0"

2'-0"

3.5"

4"C

3"

4"C

3"

3"C

3.5"

5.9"

24.2"

5.9"

FTP-60-06
3' X 2'
3" Radii
4" and 3" Series C Legend
Blue Background
White Legend and Border

Design Project Manager
or Transit Administrator
will supply correct 1-8XX
number.



3'-0"

2'-0"

4.5"

4"C

2"

4"C

2"

3"C

4.5"

4.3"

27.4"

4.3"

FTP-61-06
3' X 2'
3" Radii $\frac{3}{4}$ " Border
4" and 3" Series C Legend
Yellow Background
Black Legend and Border

8/1/2024 10:49:02 AM

FTP-62-06
3' X 3'
2" Radii ¾" Border 4"and 5" Series C Legend
Yellow Background Black Legend and Border

FTP-65-06
3' X 1'-6"
2" Radii ¾" Border
4" Series D Legend
White Background
Black Legend and Border

FTP-66-21
4'X5'
3" Radii 1" Border
6" Series D Legend
Blue Background
White Legend and Border

FTP-67-21
5.5' X 6'
3" Radii 1" Border
8" Series D Legend
Blue Background
White Legend and Border

DETAIL for **FTP-66** AND **FTP-67**

FTP-68C-21
9" X 1'-6"
1.5" Radii ¼" Border
Series D Legend
White Background
Black Legend and Border

FTP-69-06
2'-6" X 2'-6"
4" Radii ¾" Border
2" and 3" Series D Legend
White Background
Black Legend and Border

FTP-70-06
3'-6" X 2'-6"
2.25" Radii ¾" Border
5" Series C and 7" Series C Legend
Blue Background
White Legend and Border


FTP-71-06
4' X 4'
2" Radii ¾" Border
8" Series C Legend
Yellow Background
Black Legend and Border

FTP-72-06
3' X 3'
2" Radii ¾" Border
6" Series C Legend
Yellow Background
Black Legend and Border


FTP-73-06
6'-6" X 2'-6"
4" Radii ¾" Border
8" Series D Legend
Blue Background
White Legend and Border

FTP-74-06
6'-6" X 2'-6"
4" Radii ¾" Border
6" Series D Legend
Blue Background
White Legend and Border


8/1/2024 10:49:09 AM

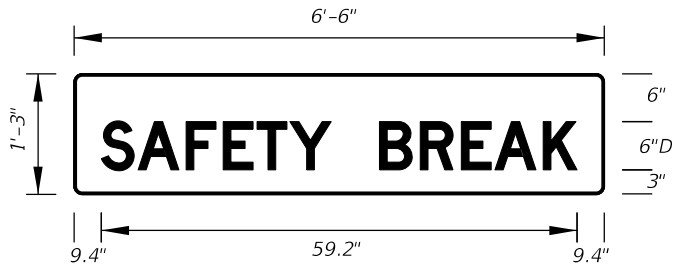


FTP-75-06
6'-6" X 1'-3"
1" Radii
6" Series D Legend
Blue Background
White Legend

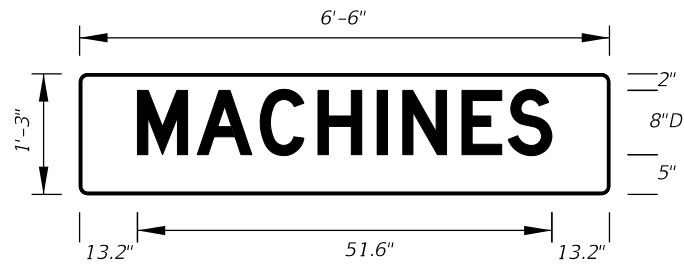


FTP-76-06
6'-6" X 1'-3"
1" Radii
8" Series D Legend
Blue Background
White Legend

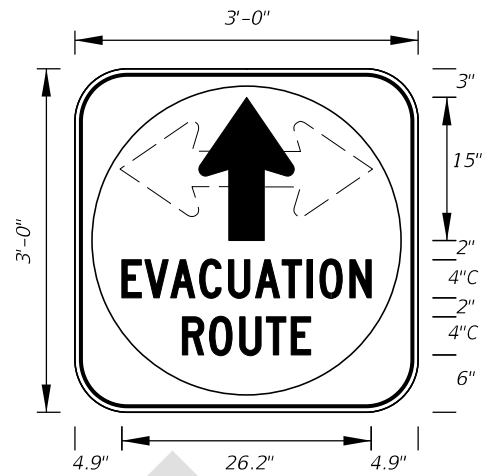


FTP-77-06
3' X 3'
5" Radii 3/4" Border
4" Series C Legend
White Background with Blue Circle Background
White Legend and Black Border

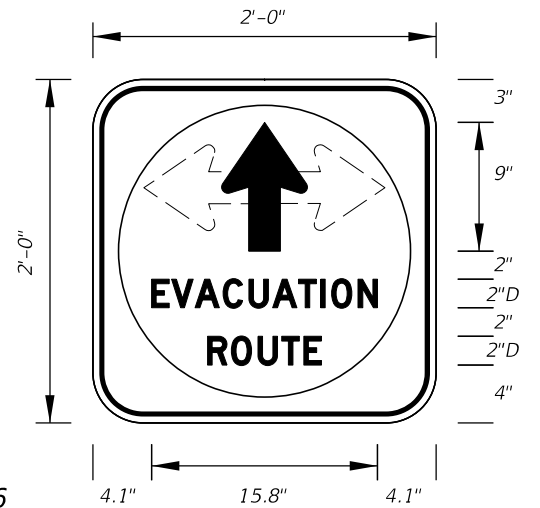


FTP-78-06
2' X 2'
3" Radii 3/4" Border
2" Series D Legend
White Background with Blue Circle Background
White Legend and Black Border

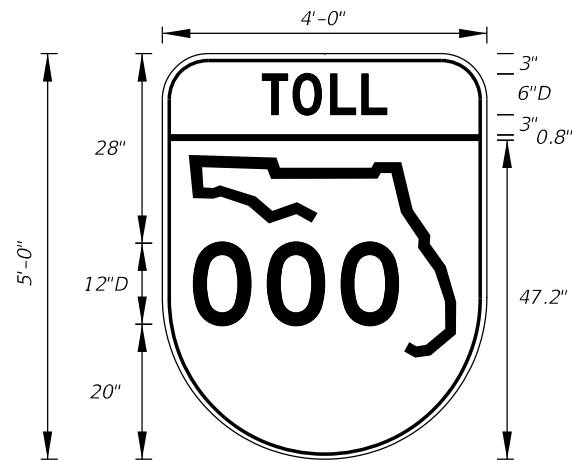


FTP-79-06
4' X 5'
6" Radii 3/4" Border
6" and 12" Series D Legend
Top Yellow Background with Black Legend and Black Border
Bottom White Background with Black Legend and Border

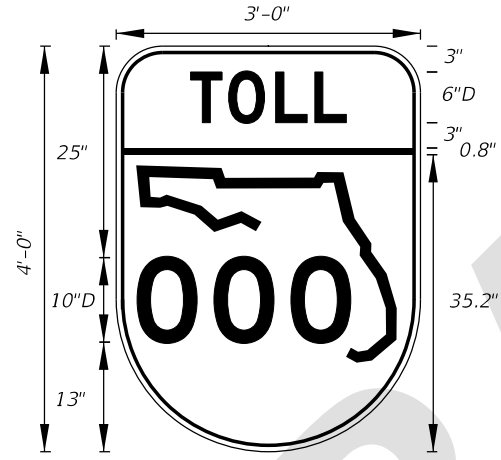

FTP-80-06
3' X 4'
5" Radii 3/4" Border
6" and 10" Series D Legend
Top Yellow Background with Black Legend and Black Border
Bottom White Background with Black Legend and Border

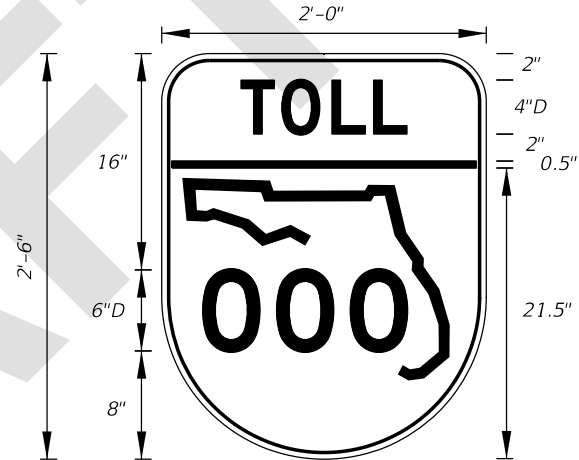


FTP-81-06
2' X 2'-6"
3" Radii 3/4" Border
4" and 6" Series D Legend
Top Yellow Background with Black Legend and Black Border
Bottom White Background with Black Legend and Border

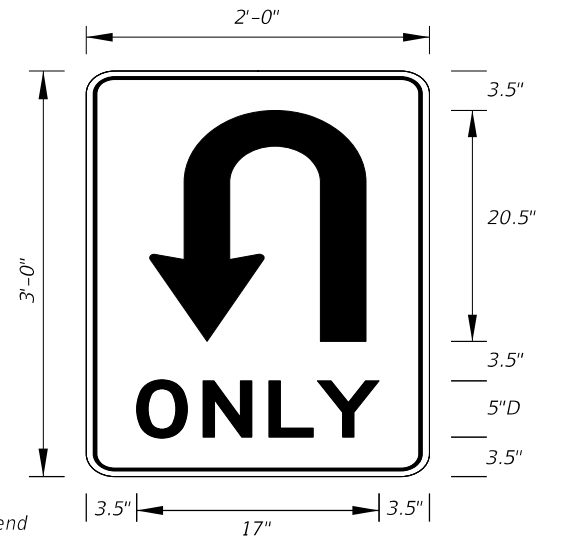


FTP-82-08
2' X 3'
1.5" Radii
5" Series D Legend
White Background
Black Legend and Border

ARROW HEAD	
A	3.125
B	3.625
C	6.375
D	.5
E	.625

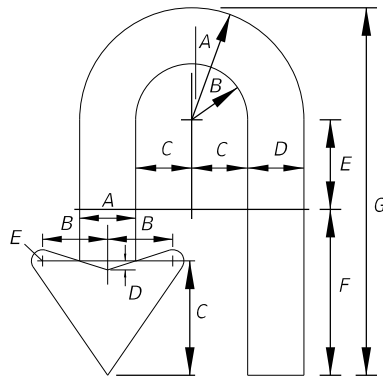


ARROW BODY						
A	B	C	D	E	F	G
6.25	3.125	3.125	3.125	5	9.25	20.5


FTP-82-08
Details

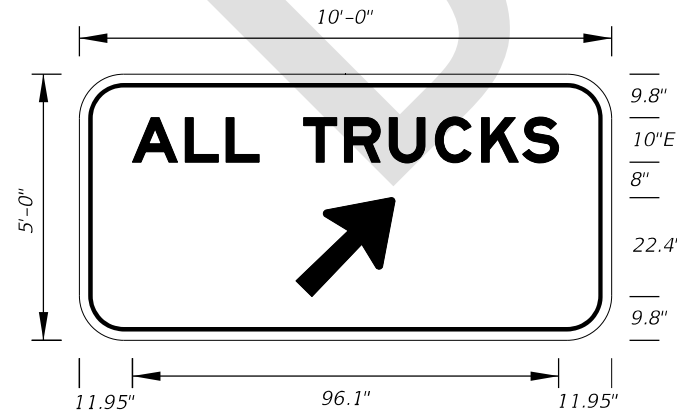

FTP-83-08
10'-0" X 5'-0"
8" Radii
10" Series E Legend
Green Background
White Legend

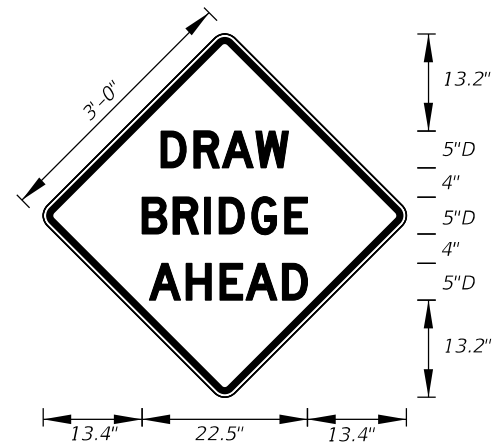

FTP-84-09
3' X 3'
1.5" Radii
5" Series D Legend
Yellow Background
Black Legend and Border

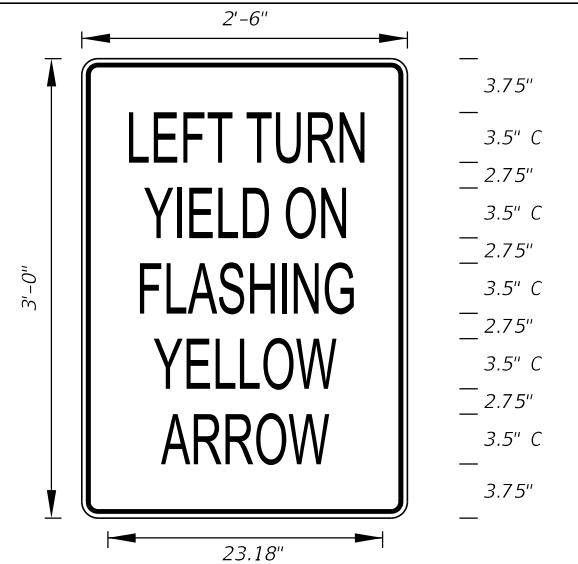

FTP-85-13
2'-6" X 3'
1.875" Radii 3/4" Border
3.5" Series C Legend
White Background
Black Legend and Border



FY 2025-26
STANDARD PLANS

SPECIAL SIGN DETAILS






INDEX
700-102

SHEET
9 of 12

LAST
REVISION
11/01/24

REVISION

DESCRIPTION:

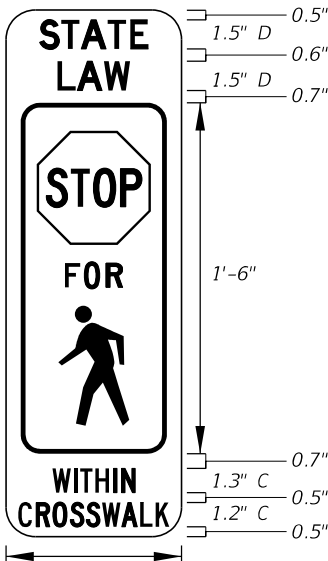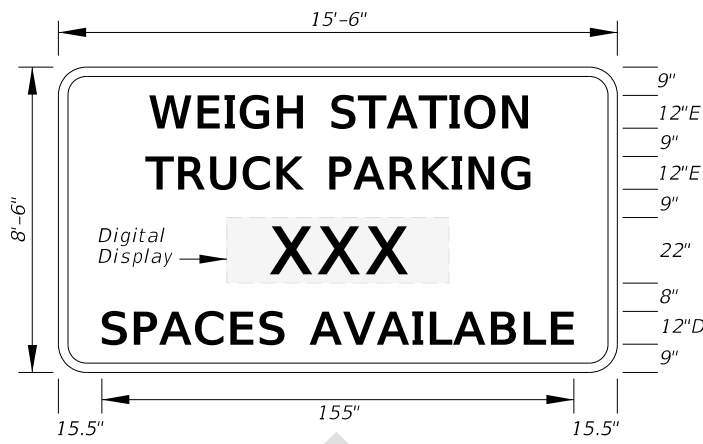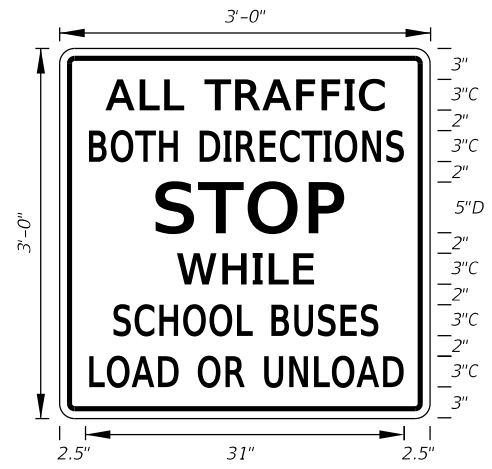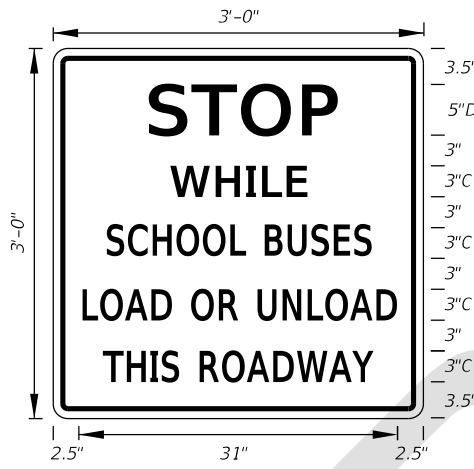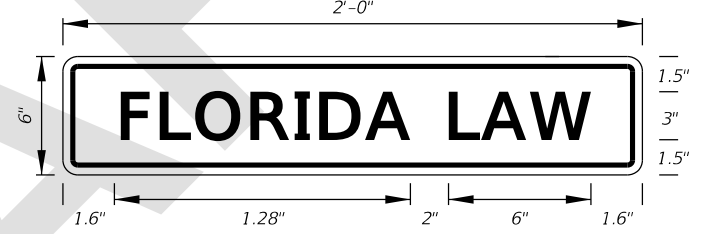 FTP-86-21 9" X 2'-3" 1.5" Radii No Border		 FTP-87-21 15'-6" X 8'-6" 12" Radii 2" Border		 FTP-88-21 15'-6" X 8'-6" 12" Radii 2" Border		 FTP-89-21 16'-6" X 8'-6" 12" Radii 2" Border			
 FTP-90-22 3'-0" X 3'-0" 1.5" Radii ¾" Border		 FTP-91-22 3'-0" X 3'-0" 1.5" Radii ¾" Border		 FTP-100-25 2'-0" X 6" 1.5" Radii 0.4" Border 0.4" Indent					
LAST REVISION 11/01/24 REVISION		DESCRIPTION:		 FY 2025-26 STANDARD PLANS		SPECIAL SIGN DETAILS		INDEX 700-102	SHEET 10 of 12

8/1/2024 10:49:22 AM

MOT-1-22
4' X 4'
3" Radii 3/4" Border

8" Series C Legend
Orange Background
Black Legend and Border

MOT-4-22
4' X 4'
3" Radii 3/4" Border

8" Series C Legend
Orange Background
Black Legend and Border

MOT-5-22
4' X 4'
3" Radii 3/4" Border

7" Series C Legend
Orange Background
Black Legend and Border

MOT-6-22
5' X 5'
3" Radii 3/4" Border

8" Series D Legend
Orange Background
Black Legend and Border

MOT-7-22
5' X 5'
3" Radii 3/4" Border

7" Series D Legend
Orange Background
Black Legend and Border

MOT-8-22
5' X 5'
3" Radii 3/4" Border

7" Series D Legend
Orange Background
Black Legend and Border

MOT-9-22
5' X 5'
3" Radii 3/4" Border

7" Series D Legend
Orange Background
Black Legend and Border

MOT-10-22
4' X 4'
3" Radii 3/4" Border

7" Series C Legend
Orange Background
Black Legend and Border

MOT-11-06
3' X 2'
2" Radii 3/4" Border

6" Series B Legend
Blue Background
White Legend and Border

MOT-12R-06
2' X 1'
2" Radii 3/4" Border

2" Series B Legend
White Background
Black Legend and Border


MOT-12L-06
For Diversion to the left

MOT-13-06
Freeway Sign
6' X 4'
6" Radii 3/4" Border


6" Series C Legend
White Background
Black Legend and Border

MOT-14-06
Arterial Sign
4'-6" X 3'
5" Radii 3/4" Border


4" Series C Legend
White Background
Black Legend and Border

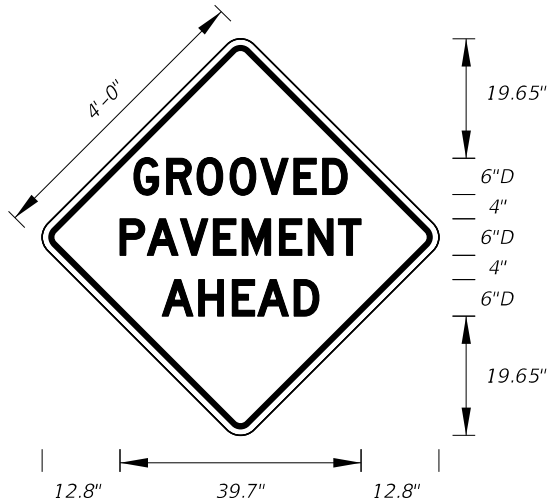


MOT-15-06
4' X 4'
2" Radii ¾" Border
6" Series D Legend
Orange Background
Black Legend and Border

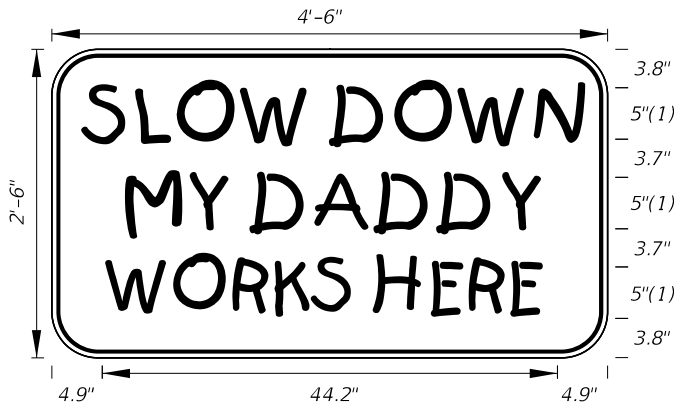


MOT-16-06
4'-6" X 2'-6"
4" Radii ¾" Border
5" Kids Series Legend
Orange Background
Black Legend and Border

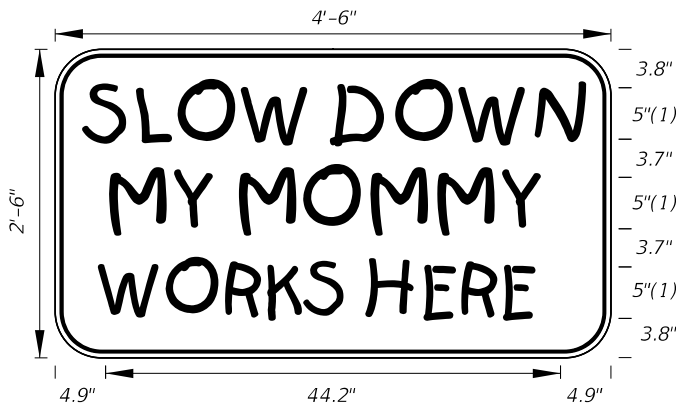


MOT-17-06
4'-6" X 2'-6"
4" Radii ¾" Border
5" Kids Series Legend
Orange Background
Black Legend and Border

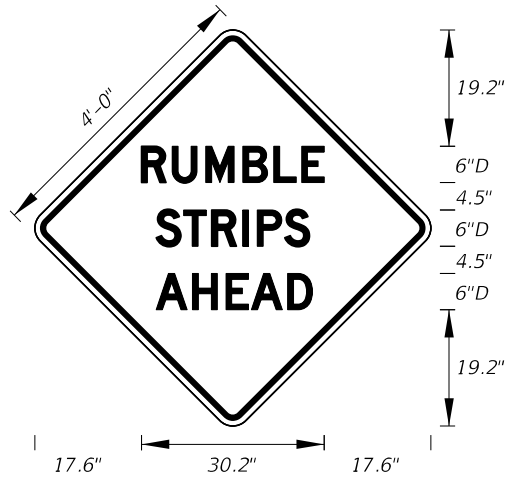


MOT-18-10
4' X 4'
2" Radii ¾" Border
6" Series D Legend
Orange Background
Black Legend and Border

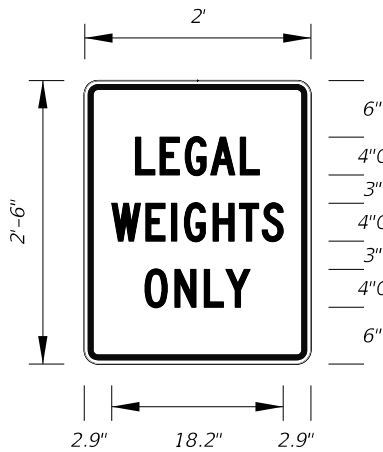


MOT-19-11
2' X 2'-6"
1.13" Radii ¾" Border
4" Series C Legend
White Background
Red Legend and Border

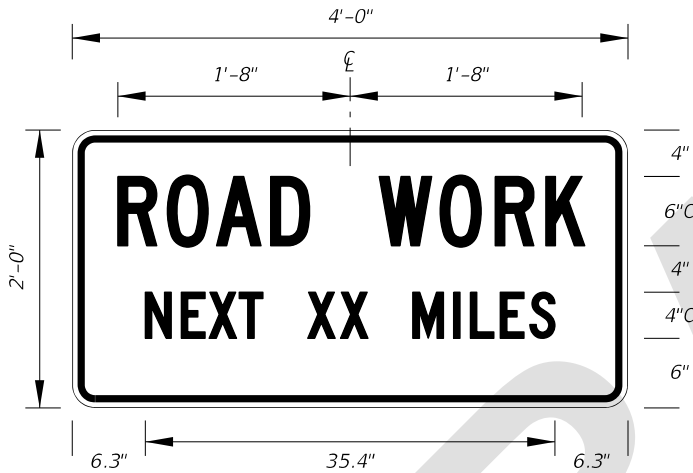


G20-1
4' X 2'
1.5" Radii ¾" Border
Orange Background
Black Legend and Border

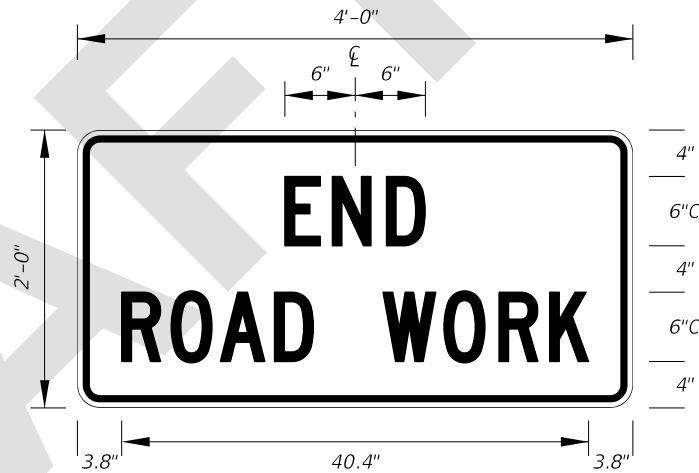


G20-2
4' X 2'
1.5" Radii ¾" Border
Orange Background
Black Legend and Border

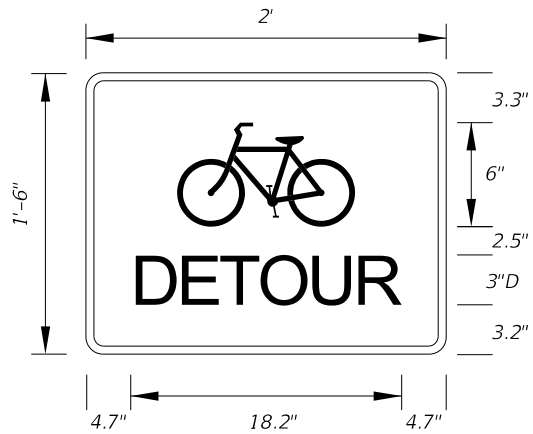

MOT-21-21
2' X 1'-6"
1.5" Radii ½" Border
3" Series D Legend
Orange Background
Black Legend and Border

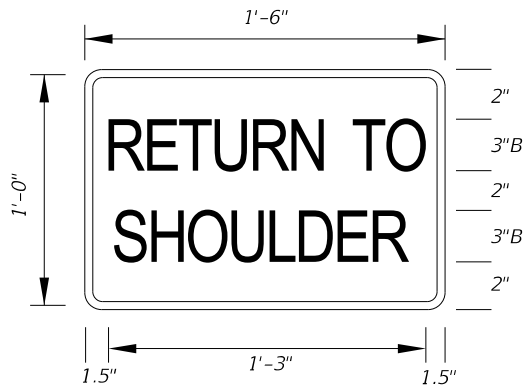

MOT-23-21
1'-6" X 1'-0"
1.5" Radii ¼" Border
3" Series B Legend
Orange Background
Black Legend and Border

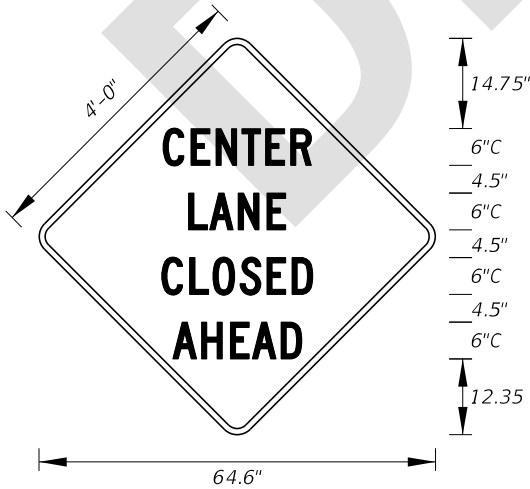

MOT-27-25
4' X 4'
3" Radii ¾" Border
6" Series C Legend
Orange Background
Black Legend and Border

8/1/2024 1:05:13 PM



FY 2025-26
STANDARD PLANS

SPECIAL SIGN DETAILS

INDEX
700-102

SHEET
12 of 12