
Index 711-001 Pavement Markings

ORIGINATION

Date: 9/17/24

Name: Shae Gibbs

Phone: 414-4314

Email: shae.gibbs@dot.state.fl.us

COMMENTARY

Coordination between FHWA and the FDOT Traffic Operations Office resulted in changes to the FDM and TEM to coincide with the MUTCD. The changes to this Index were made to coincide with the proposed updates to the FDM and TEM.

COMMENTS AND RESPONSES

BLACK = Industry Review Comments **BLUE** = Standard Plans Response **GREEN** = Change Made to Index

Name: John Olson

Date: 9/19/2024

COMMENT: I agree with the proposed changes on the marked up sheets for clarifying the striping of the separation for managed lanes. It seems like there is room for the same clarification on some of the other details showing buffer striping for bike lanes. The double stripes being removed from the small circled detail for managed lanes could also be removed for the bike lane buffer for consistency.

RESPONSE: Thank you for the comment. The goal was to match the zoomed-out detail to the zoomed-in detail. We will look at these in more detail and update as necessary.

CHANGE MADE TO INDEX: Yes. Added double lines to Managed Lane Detail.

Response Date: 10/3/2024

Name: Karen Byram

Date: 9/19/2024

COMMENT: On sheet 4 of 13 Note #3 refers to Managed Lane markers. These products are called tubular markers. Please change the words 'Managed Lane markers' to 'tubular markers'. Please contact me if you have any questions.

RESPONSE: Thank you for the comment. The note has been revised as requested.

CHANGE MADE TO INDEX: Yes. Revised the note to “tubular markers.”

Response Date: 10/3/2024

Name: Melissa Hollis


Date: 9/23/2024

COMMENT: The terminology "managed lane marker" is inconsistent with the specification and APL products that identify "tubular markers."

RESPONSE: Thank you for the comment. Managed lane markers will be revised to Tubular Markers.

CHANGE MADE TO INDEX: Yes. Revised the note to “tubular markers.”


Response Date: 10/3/2024

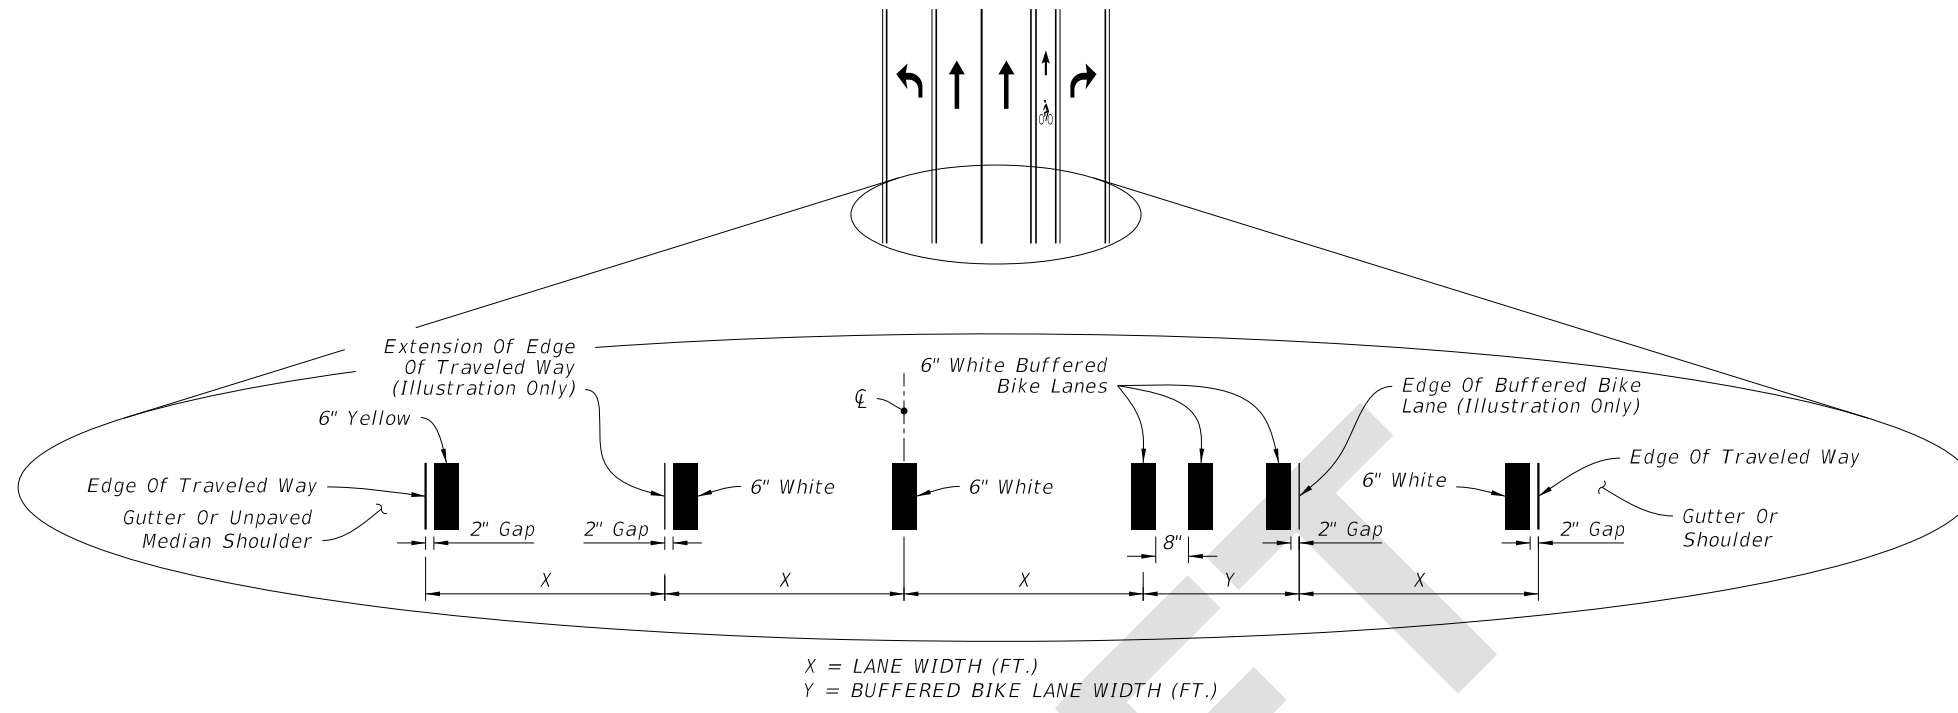

INTERSECTION APPROACH STRIPING WITH TURN LANES AND BUFFERED BIKE LANE KEY HOLE

NOTES:


1. Lane widths (X) may not be same for each lane in the section.
2. For placement of RPMs, see Index 706-001.
3. For placement of tubular markers and associated RPMs, see the Plans.

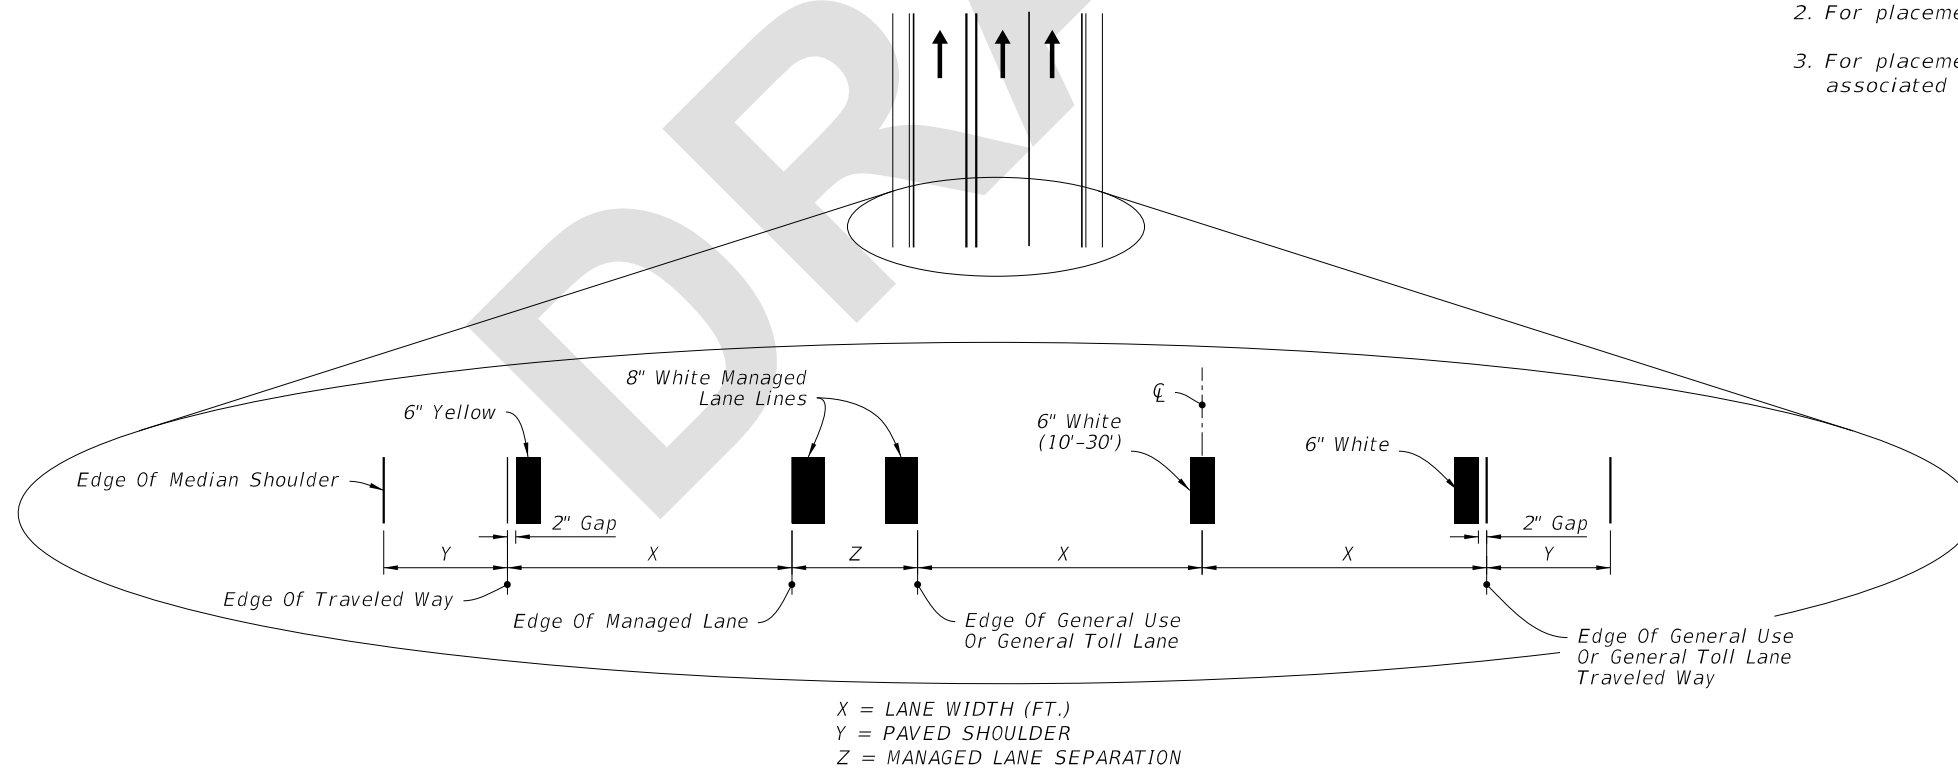

MANAGED LANE STRIPING

PLACEMENT OF LONGITUDINAL PAVEMENT MARKINGS

10:08:44 AM
10/3/2024

LAST REVISION 11/01/24	REVISION	DESCRIPTION:	 FY 2025-26 STANDARD PLANS	PAVEMENT MARKINGS	INDEX 711-001	SHEET 4 of 13
---------------------------	----------	--------------	--	-------------------	------------------	------------------