

Origination Form
Proposed Revisions to a Standard Plans Index

Originator:	Taylor, Earl	Index Number:	102-120
Date:	5/16/2025	Sheet Number(s):	2
E-mail:	earl.taylor@dot.state.fl.us	Index Title:	Low Profile Barrier

Summary of the changes:

Sheet 2: Deleted payment note in Note 2


Commentary/Background:

Requested by D1 to fix the inconsistency between this index and index 102-100


Other Affected Documents/Offices	Person Contacted	Affected (Yes/No)
Other Standard Plans		No
FDOT Design Manual		No
Standard Specifications		No
Basis of Estimates Manual		No
Approved Product List		No
Construction Office		No
Maintenance Office		No

Implementation


["FY-Standard Plans (Next Release)"]

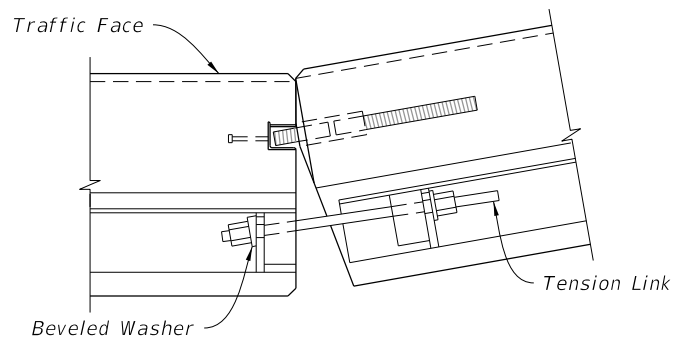

CONCAVE CONNECTION

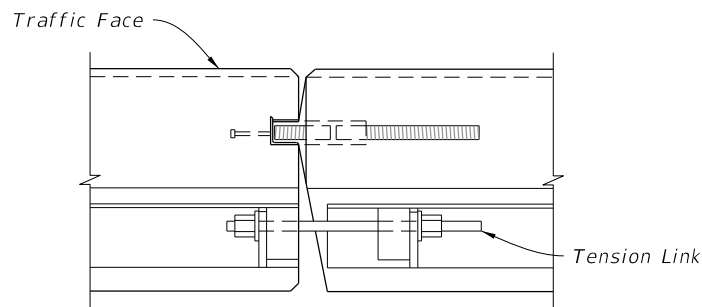


PARALLEL CONNECTION

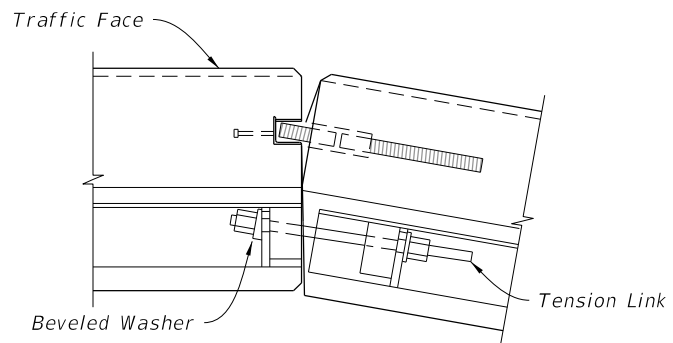


CONVEX CONNECTION


PLAN VIEWS OF CONNECTIONS

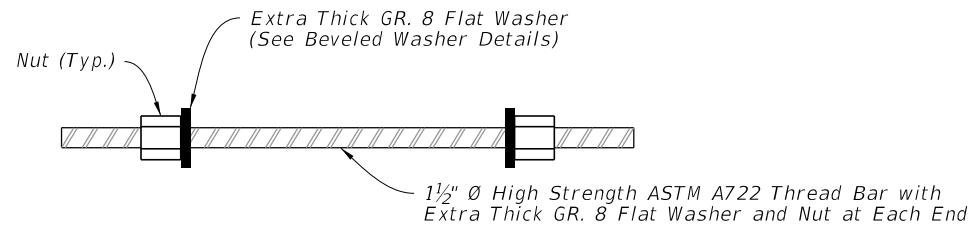

TENSION LINK DETAIL

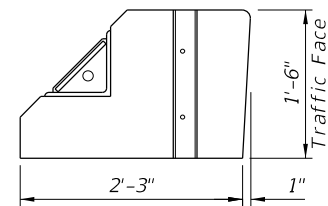


FLAT FACE FEMALE END

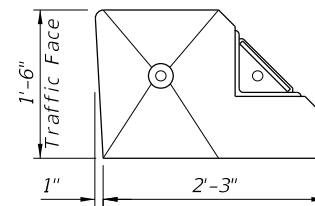

BEVELED FACE MALE END

END VIEWS

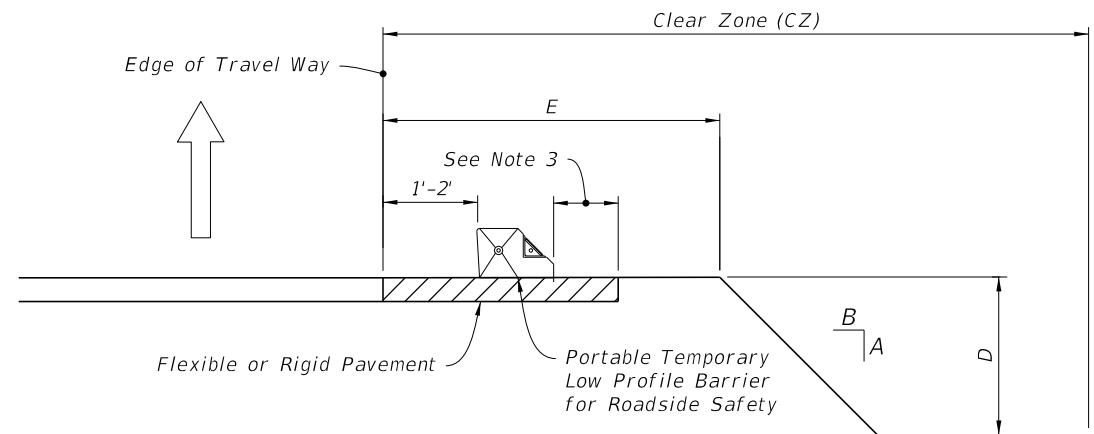

SETBACK DISTANCE AT DROP-OFFS

NOTES:


1. LIMITATION OF USE: This installation technique can only be used on flexible or rigid pavement
2. ASPHALT PAD: Where existing pavement is not present, construct 2" Asphalt Pad using miscellaneous asphalt pavement in accordance with Specification 339 with the exception that the use of a pre-emergent herbicide is not required. ~~Payment for asphalt pad will be included in the cost of the barrier.~~
3. Minimum 9" on 1:10 or flatter slopes for 'Portable Temporary Low Profile Barrier For Roadside Safety.' For values A, B, D and E see Index 102-600.

DELETED Payment Note

SYMBOLS:


- Type I Object Marker
⇒ Direction of Traffic

WORK ZONE SPEED	LATERAL OFFSET	SETBACK DISTANCE
45 MPH OR LESS	1' MIN, 2' PREFERRED	9"

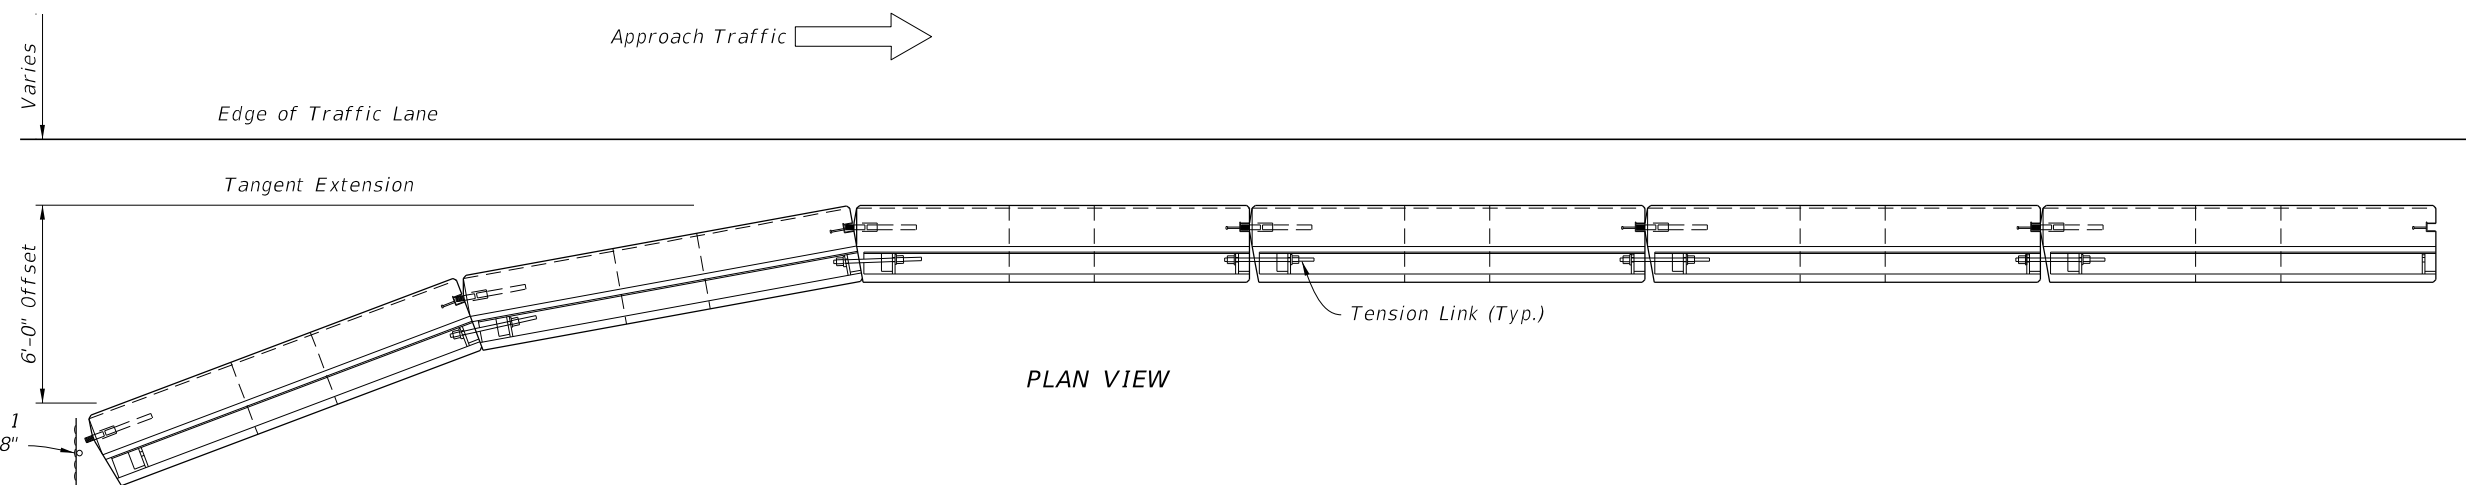


APPROACH END OFFSET


10/30/2024 2:48:42 PM

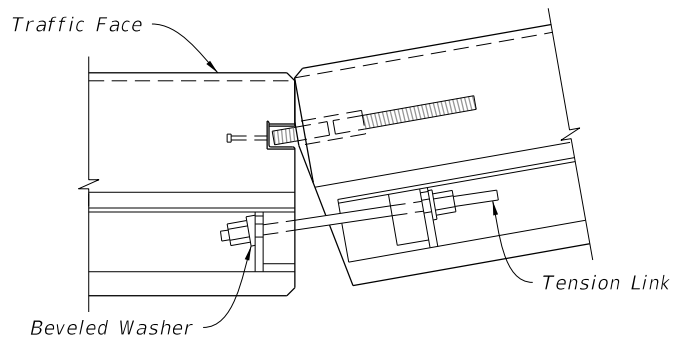

CONCAVE CONNECTION

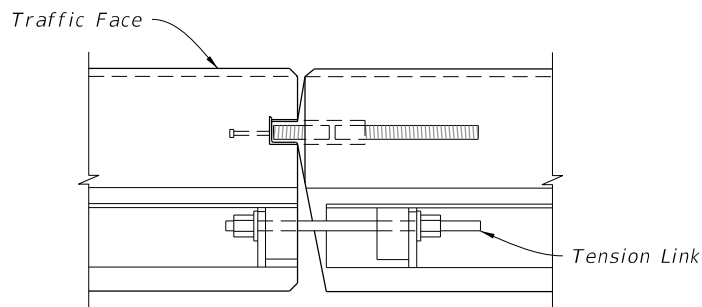


PARALLEL CONNECTION

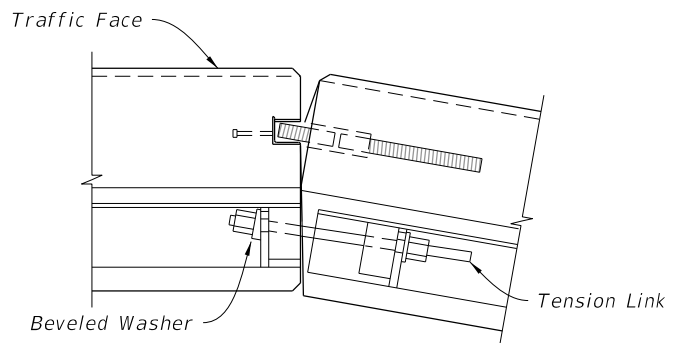


CONVEX CONNECTION


PLAN VIEWS OF CONNECTIONS

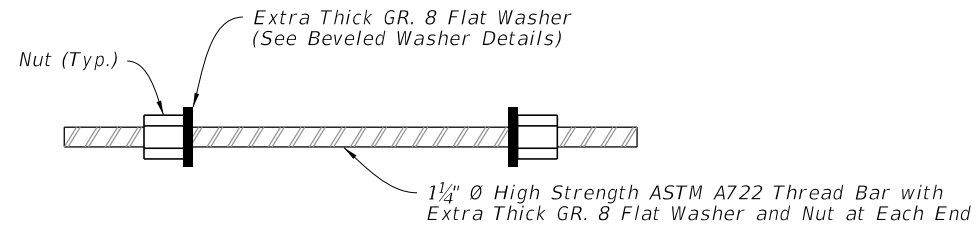

TENSION LINK DETAIL

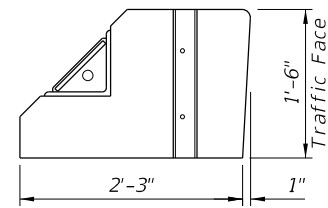


FLAT FACE FEMALE END

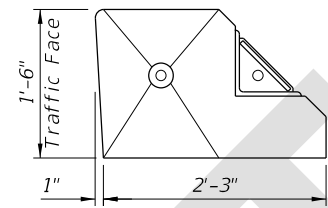

BEVELED FACE MALE END

END VIEWS

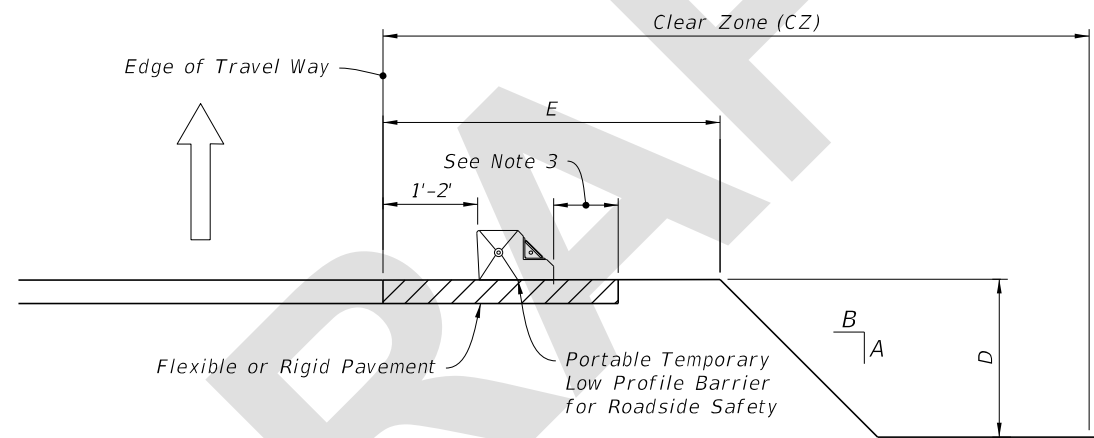

SETBACK DISTANCE AT DROP-OFFS


NOTES:

1. LIMITATION OF USE: This installation technique can only be used on flexible or rigid pavement.
2. ASPHALT PAD: Where existing pavement is not present, construct 2" Asphalt Pad using miscellaneous asphalt pavement in accordance with Specification 339 with the exception that the use of a pre-emergent herbicide is not required.
3. Minimum 9" on 1:10 or flatter slopes for 'Portable Temporary Low Profile Barrier For Roadside Safety.' For values A, B, D and E see Index 102-600.

SYMBOLS:

- Type I Object Marker
- ⇒ Direction of Traffic

WORK ZONE SPEED	LATERAL OFFSET	SETBACK DISTANCE
45 MPH OR LESS	1' MIN, 2' PREFERRED	9"

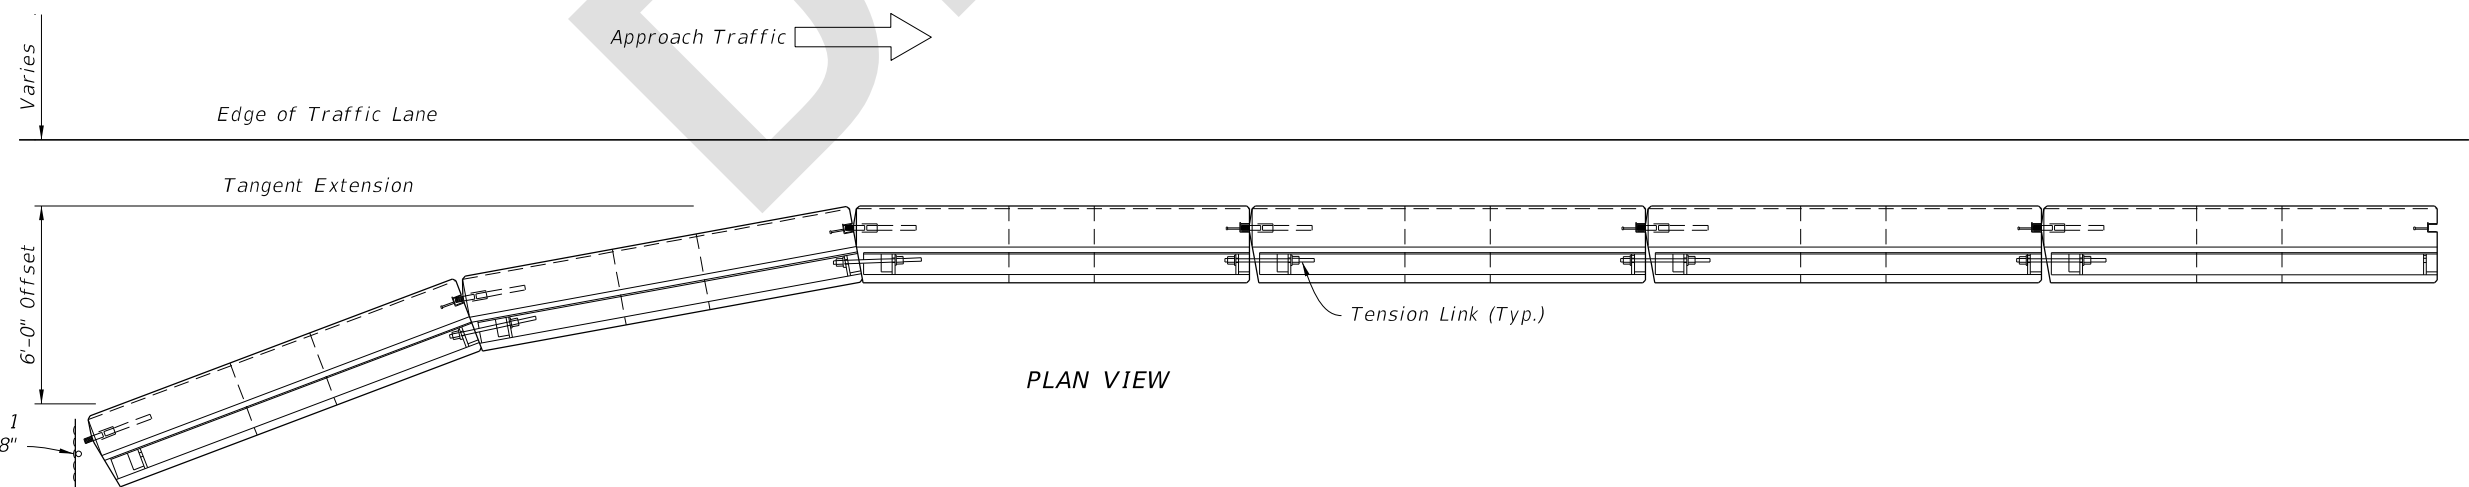

PLAN VIEW

APPROACH END OFFSET

6/26/2025 8:38:25 AM