

Origination Form
Proposed Revisions to a Standard Plans Index

Originator:	Turley, Joshua	Index Number:	102-200
Date:	5/15/2025	Sheet Number(s):	All sheets
E-mail:	Joshua.Turley@dot.state.fl.us	Index Title:	TEMPORARY ACROW 300 SERIES DETOUR BRIDGE GENERAL NOTES AND DETAILS

Summary of the changes:

Sheet 1: Changed number of sheets
Sheet 2: Changed number of sheets
Sheet 3: Removed underside of expansion bearing dimension and added a note that it will be set in final design.
Sheet4: Removed the note that indicated FDOT will provide both the expansion and fixed bearings and changed it to just the ACROW AB7 bearing and added a sheet reference to it.
Sheet 5: Removed sheet
Sheet 6: Changed number of sheets
Sheet 7(NEW): Added an expanded set of details for the intermediate bearings instead of the abbreviated details on the old Sheet 5.
Sheet 8(NEW): Added an expanded set of details for the end bent bearings instead of the abbreviated details on the old Sheet 5.

Commentary/Background:

Sheet 3: We dont actually know the underside dimension for the bearings until final design so it is inappropriate to ball park the dimension.
Sheet4: We are being more specific about what FDOT does and does not provide to the Contractor.
Sheet 5: Deleted sheet and added information with expanded details for clarity on new Sheets 7 and 8.
Sheet 7: Expanded details of the bearings add clarity.
Sheet 8: Expanded details of the bearings add clarity.

Other Affected Documents/Offices	Person Contacted	Affected (Yes/No)
Other Standard Plans		No
FDOT Design Manual		No
Standard Specifications		No
Basis of Estimates Manual		No
Approved Product List		No
Construction Office		No
Maintenance Office		No

Implementation

["FY-Standard Plans (Next Release)"]

10/17/2024 7:58:13 AM

GENERAL NOTES:

This Index is only applicable to the current FDOT inventory of temporary bridge components which are manufactured in accordance with Acrow Series 300, Triple Single design.

Work this Index with Index 102-210, 102-220, 102-230 and 102-240.

STRUCTURAL STEEL:

Steel Plates and Rolled Sections shall be ASTM A709 Grade 36.
Pipe piles shall be ASTM A252 Grade 2, Fy = 35 ksi.

BOLTS, LAG SCREWS AND THREADED BOLT STOCK:

Furnish high strength bolts in accordance with ASTM F3125 Grade A325 Type 1. Furnish Threaded Stock in accordance with ASTM A36. Furnish Lag Screws in accordance with ASTM A307. Furnish steel washers and nuts compatible with Bolts, Threaded Stock and Lag Screws.

TIMBER AND LAGGING:

Timber and Lagging shall be No. 1 Southern Yellow Pine.

BACKWALL BENT PILES:

Timber Piles:
10' Minimum Embedment into compacted backfill or into soil having a blow count greater than 6 (N>6).
Ultimate Capacity greater than 18 tons.
Splices are not allowed on any timber piles.

H-Piles:

12' Minimum Embedment into compacted backfill or into soil having a blow count greater than 6 (N>6).
Ultimate Capacity greater than 18 tons.

Shims admissible between backwall pile and cap.
Test piles are not required for backwall piles.

EXPANSION BEARINGS:

Inspect the PTFE (Teflon) layer and stainless steel plate prior to installation.
Do not use bearings that have a severely damaged or unbonded PTFE layer.
Clean PTFE of all grit and grime prior to installation.
Clean Stainless steel plate of all grit and grime prior to installation and finish to a smooth buffed surface.

DISTRIBUTING BEAMS:

Longitudinal stops restraining the distributing beams may be lengthened or shortened to center the distributing beam bearing on the cap beam.
The longitudinal stops are to bear on the distributing beam end frame.

EXPANSION JOINT SETTINGS:

Install the expansion joint considering the total continuous bridge length, location of fixed bearings and ambient temperature at the time of installation, assume a 1" expansion joint opening at 70 degrees F.

STORAGE FACILITY:

Contact
FDOT Statewide Aluminum Shop
2590 Camp Rd.
Oviedo, FL.
407-278-2727
For shipping weights and dimensions of Temporary Bridge elements.

SHIPPING WEIGHTS AND DIMENSIONS:

Decking Sizes:

Type	Length	Width	Weight (lbs.)
Curb	5'	6'-9"	800
Curb	10'	6'-9"	1420
Curb	15'	6'-9"	2200
Curb	20'	6'-9"	2800
NonCurb	5'	5'-3"	650
NonCurb	10'	5'-3"	1000
NonCurb	15'	5'-3"	1600
NonCurb	20'	5'-3"	2100

Shipping weights and dimensions of other bridge components can be referenced in "Acrow Panel Bridging, Series 300, Technical Handbook".

TRAFFIC RAILING NOTES:

See Index 536-001 for component details, geometric layouts and associated notes not fully detailed herein.

CONCRETE: Concrete for Transition Blocks shall be Class II (Bridge Deck).

THRIE-BEAM PANEL: Steel Thrie-Beam Elements shall meet the requirements of AASHTO M180, Type II (Zinc coated).

BOLTS, NUTS AND WASHERS: Bolts, nuts and round washers shall be in accordance with AASHTO M180. Plate Washers shall be in accordance with ASTM A36 or ASTM A709 Grade 36. Do not drill Temporary Bridge components to attach Guardrail. Guardrail Bolts shall be placed between Truss members as shown in Index 102-240.

COATINGS: All Nuts, Bolts, Anchors, Washers and Backer Plates shall be hot-dip galvanized in accordance with the Specifications.


WOOD BLOCKS: All wood blocks, including required wedge shaped blocks shall be Pressure Treated Lumber in accordance with Specifications Section 955. Bolt holes in blocks to be centered ($\pm 1/4"$).

PAYMENT:

Temporary Detour Bridge is to be paid for under Contract Unit Price for Special Detour. If a temporary bridge system other than that shown herein is used, the Contractor is responsible for renting or purchasing their own system. Payment for Temporary Guardrail work and Transition Block will be made under Pay Item Temporary Guardrail, LF.

Furnish and install Bridge Thrie-Beam Panels and all associated hardware as shown. Payment will be made with the Temporary Detour Bridge under the Pay Item Special Detour, LS. Turn over Bridge Thrie-Beam Panels and all associated hardware to the Department with the Detour Bridge components per Specifications Section 102-6.

10/17/2024 7:58:29 AM

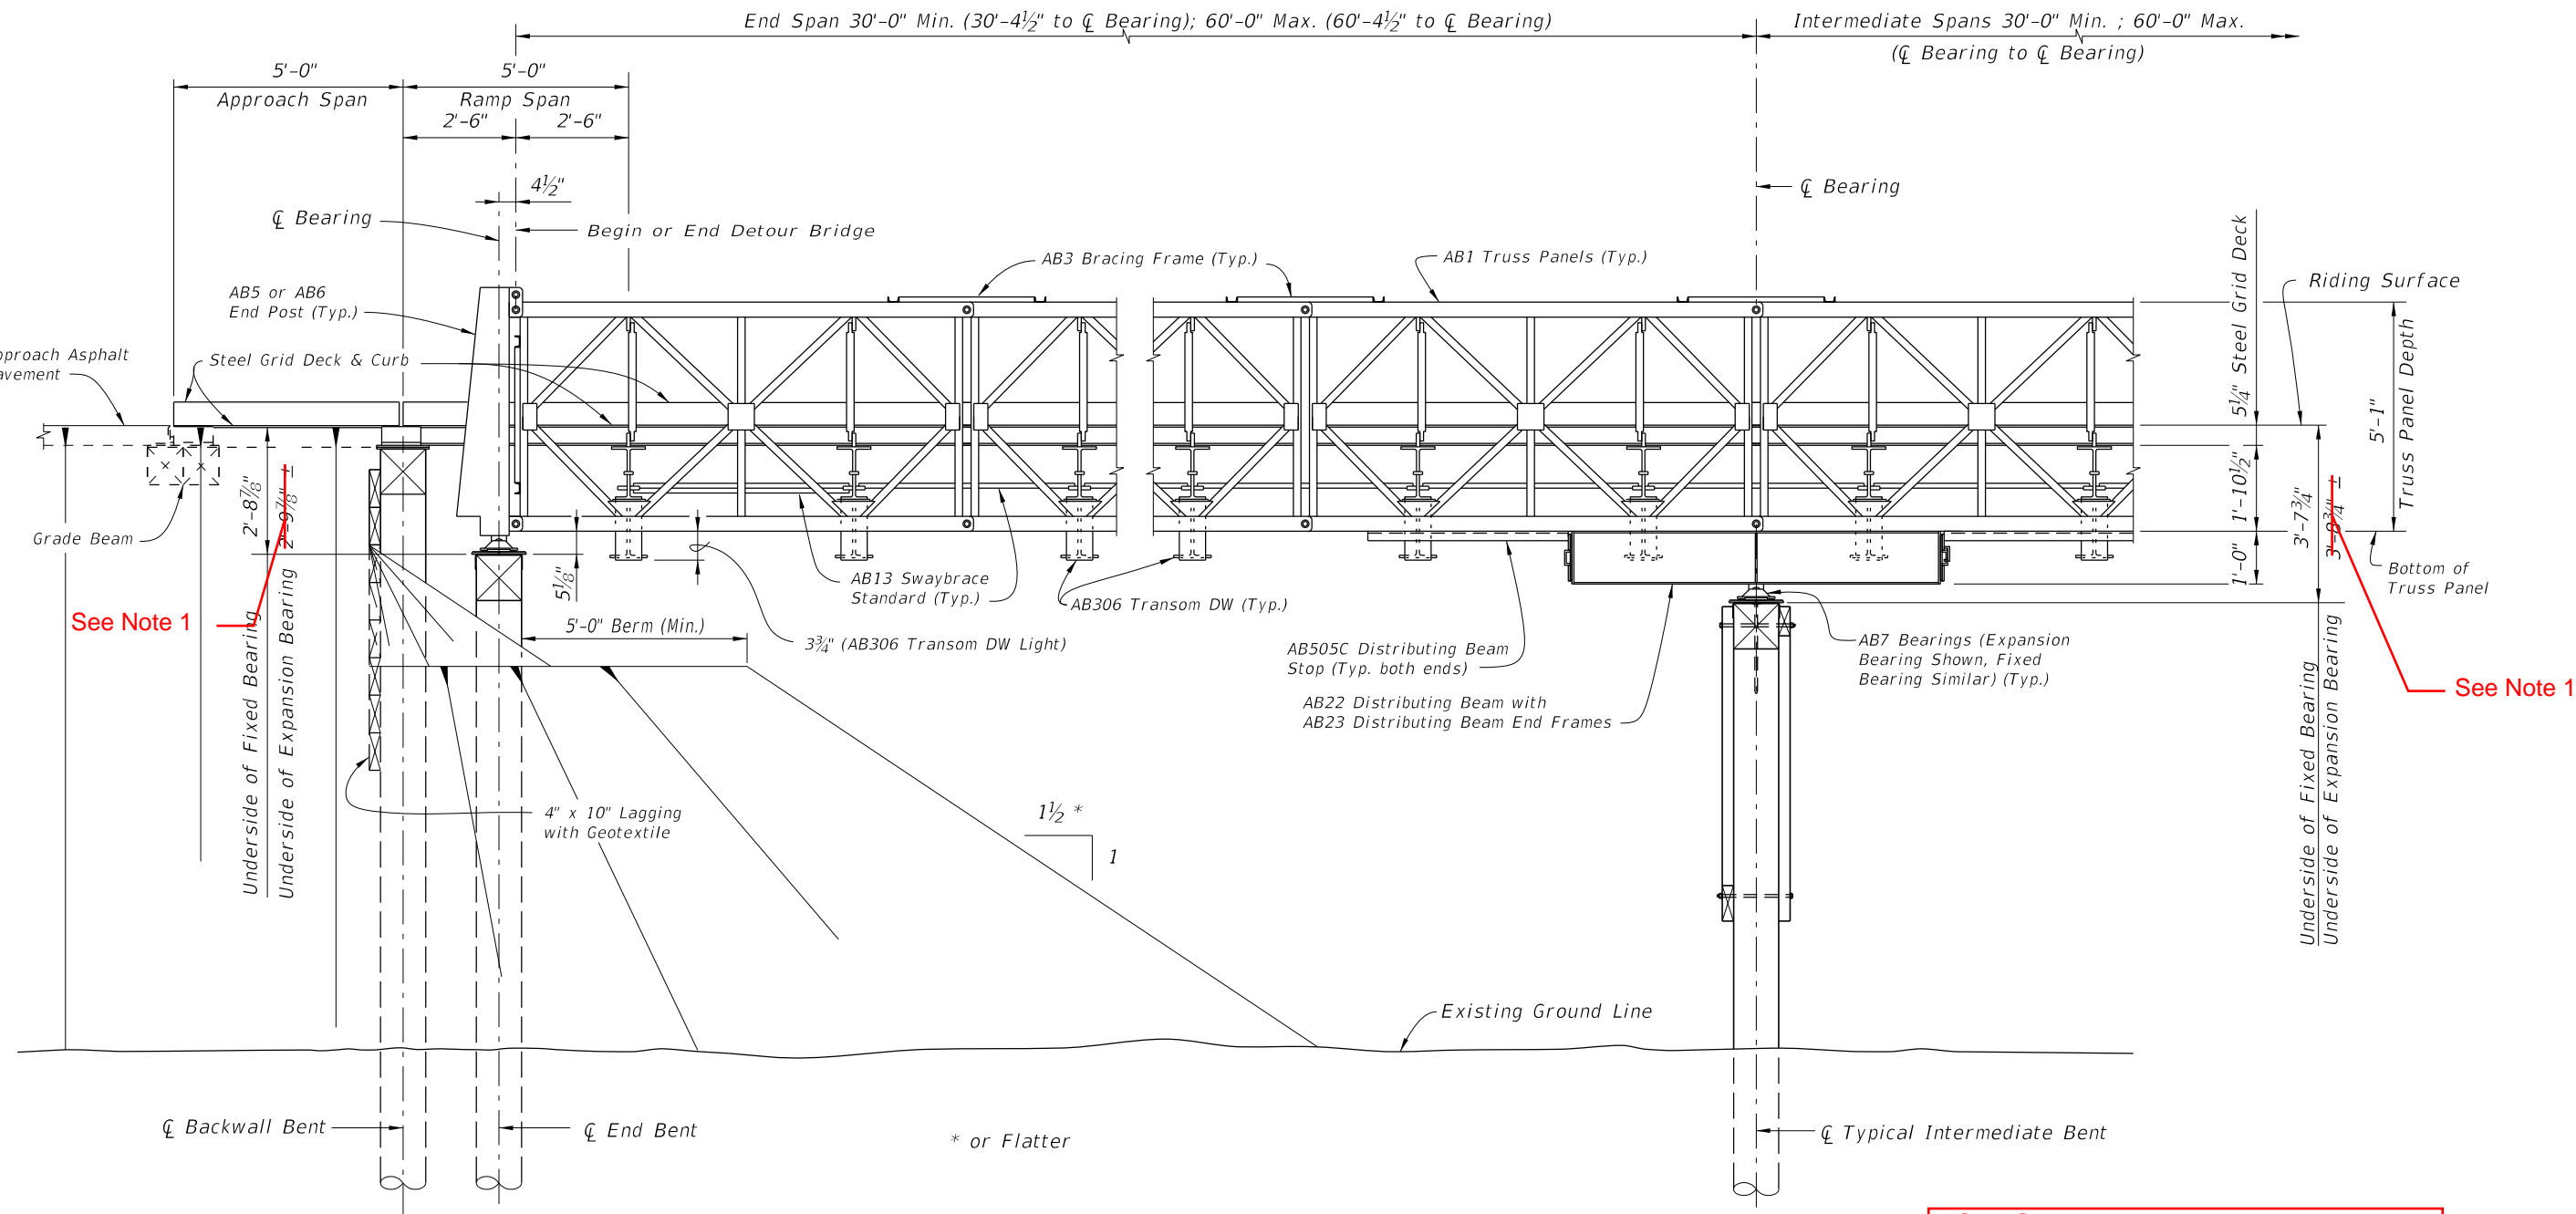


ELEVATION VIEW
(TIMBER PILES SHOWN, STEEL H PILES AND STEEL PIPE PILES SIMILAR)
(Thrie-Beam Panel not shown for clarity, See Index 102-240)

NOTES:


1. The dimension to be determined based on final design of substructure. Expansion bearings designed & detailed by Specialty Engineer and supplied by Contractor.

2026-27		FY 2025-26		TEMPORARY ACROW 300 SERIES DETOUR BRIDGE		INDEX		SHEET 8	
LAST REVISION		FDOT		GENERAL NOTES AND DETAILS		102-200		3 of 7	
11/01/23									
11/01/25									
REVISION		DESCRIPTION:							


10/17/2024 7:58:43 AM

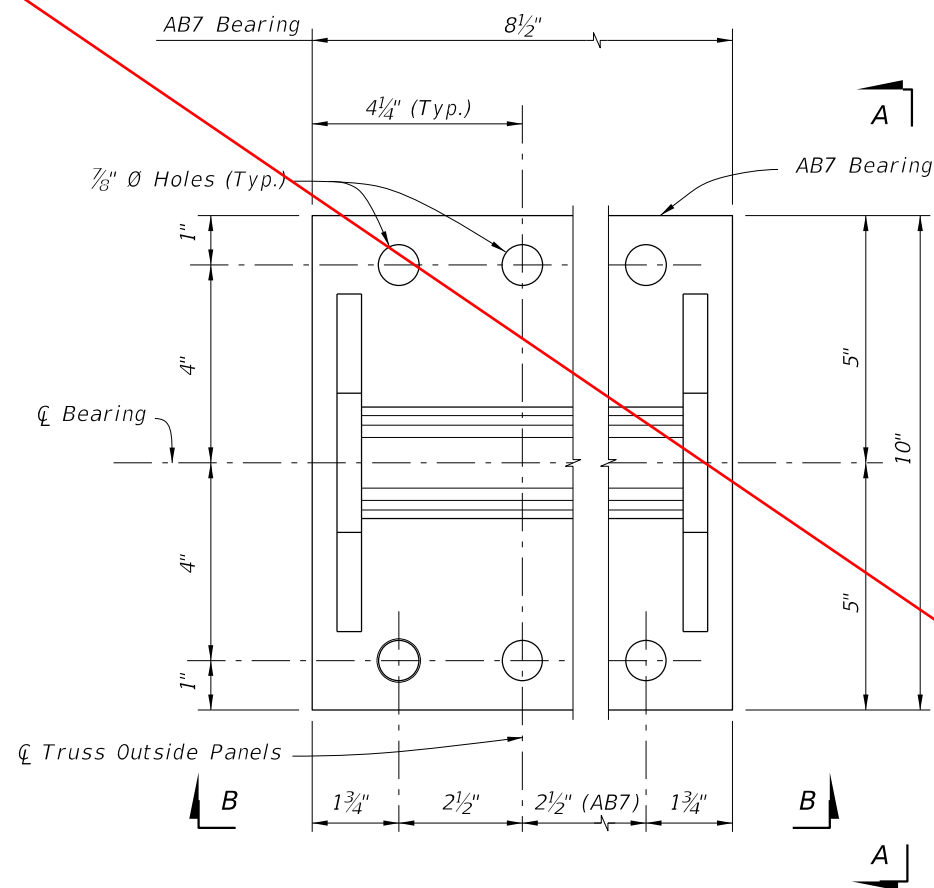

PLAN VIEW

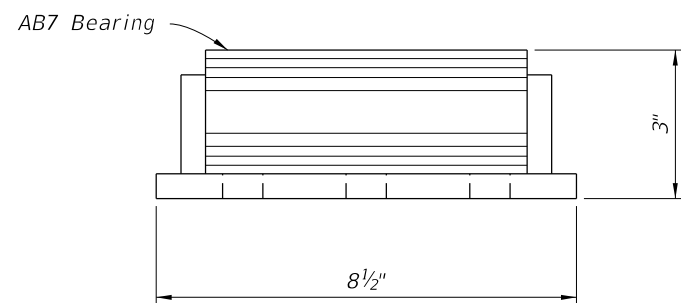


VIEW B-B

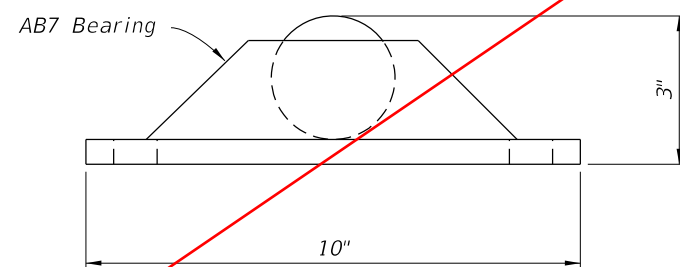


VIEW A-A


DETAILS FOR FDOT SUPPLIED FIXED BEARINGS

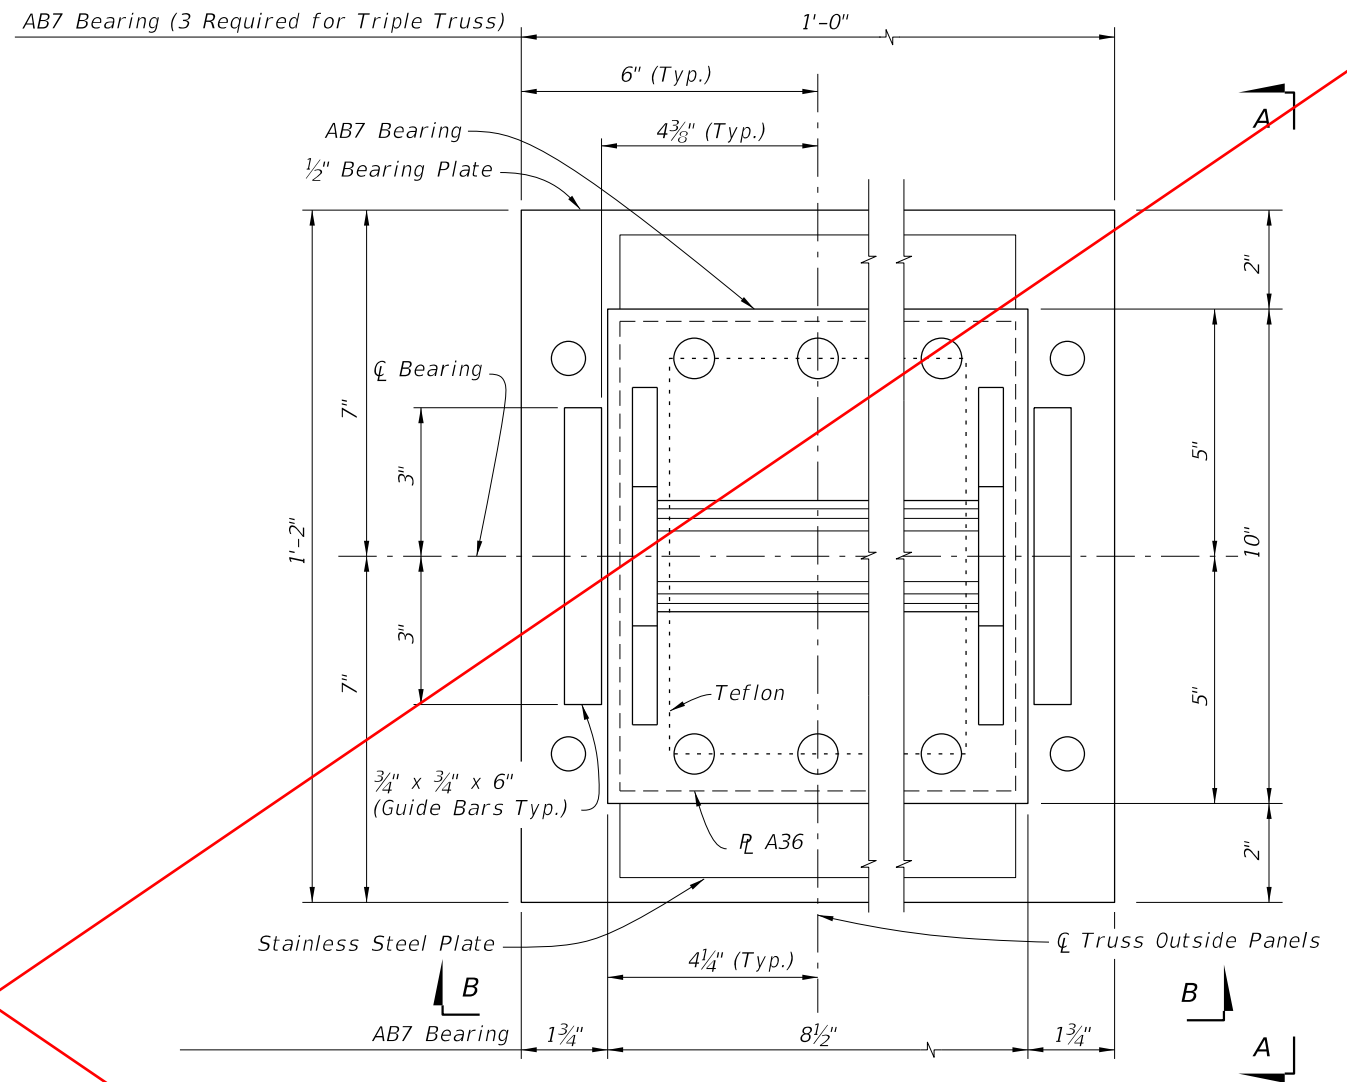

PLAN VIEW

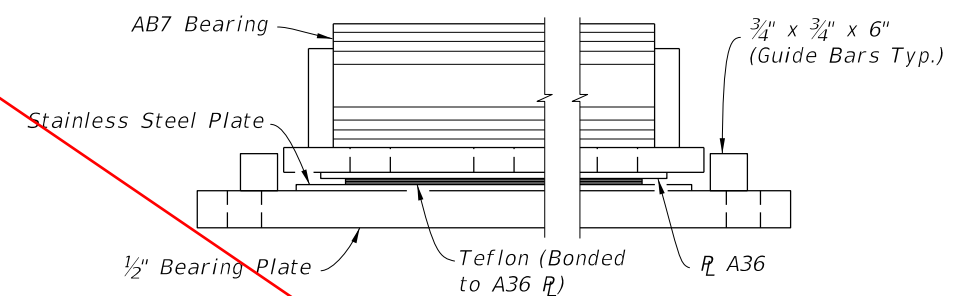

VIEW B-B

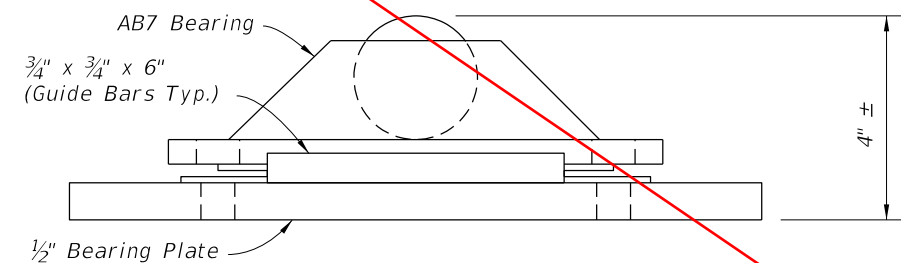

VIEW A-A

DETAILS FOR FDOT SUPPLIED EXPANSION BEARINGS

LAST REVISION	DESCRIPTION:
11/01/22	



FY 2025-26
STANDARD PLANS


TEMPORARY ACROW 300 SERIES DETOUR BRIDGE
GENERAL NOTES AND DETAILS

INDEX
102-200

SHEET
5 of 7


Remove Sheet

10/17/2024 7:58:50 AM

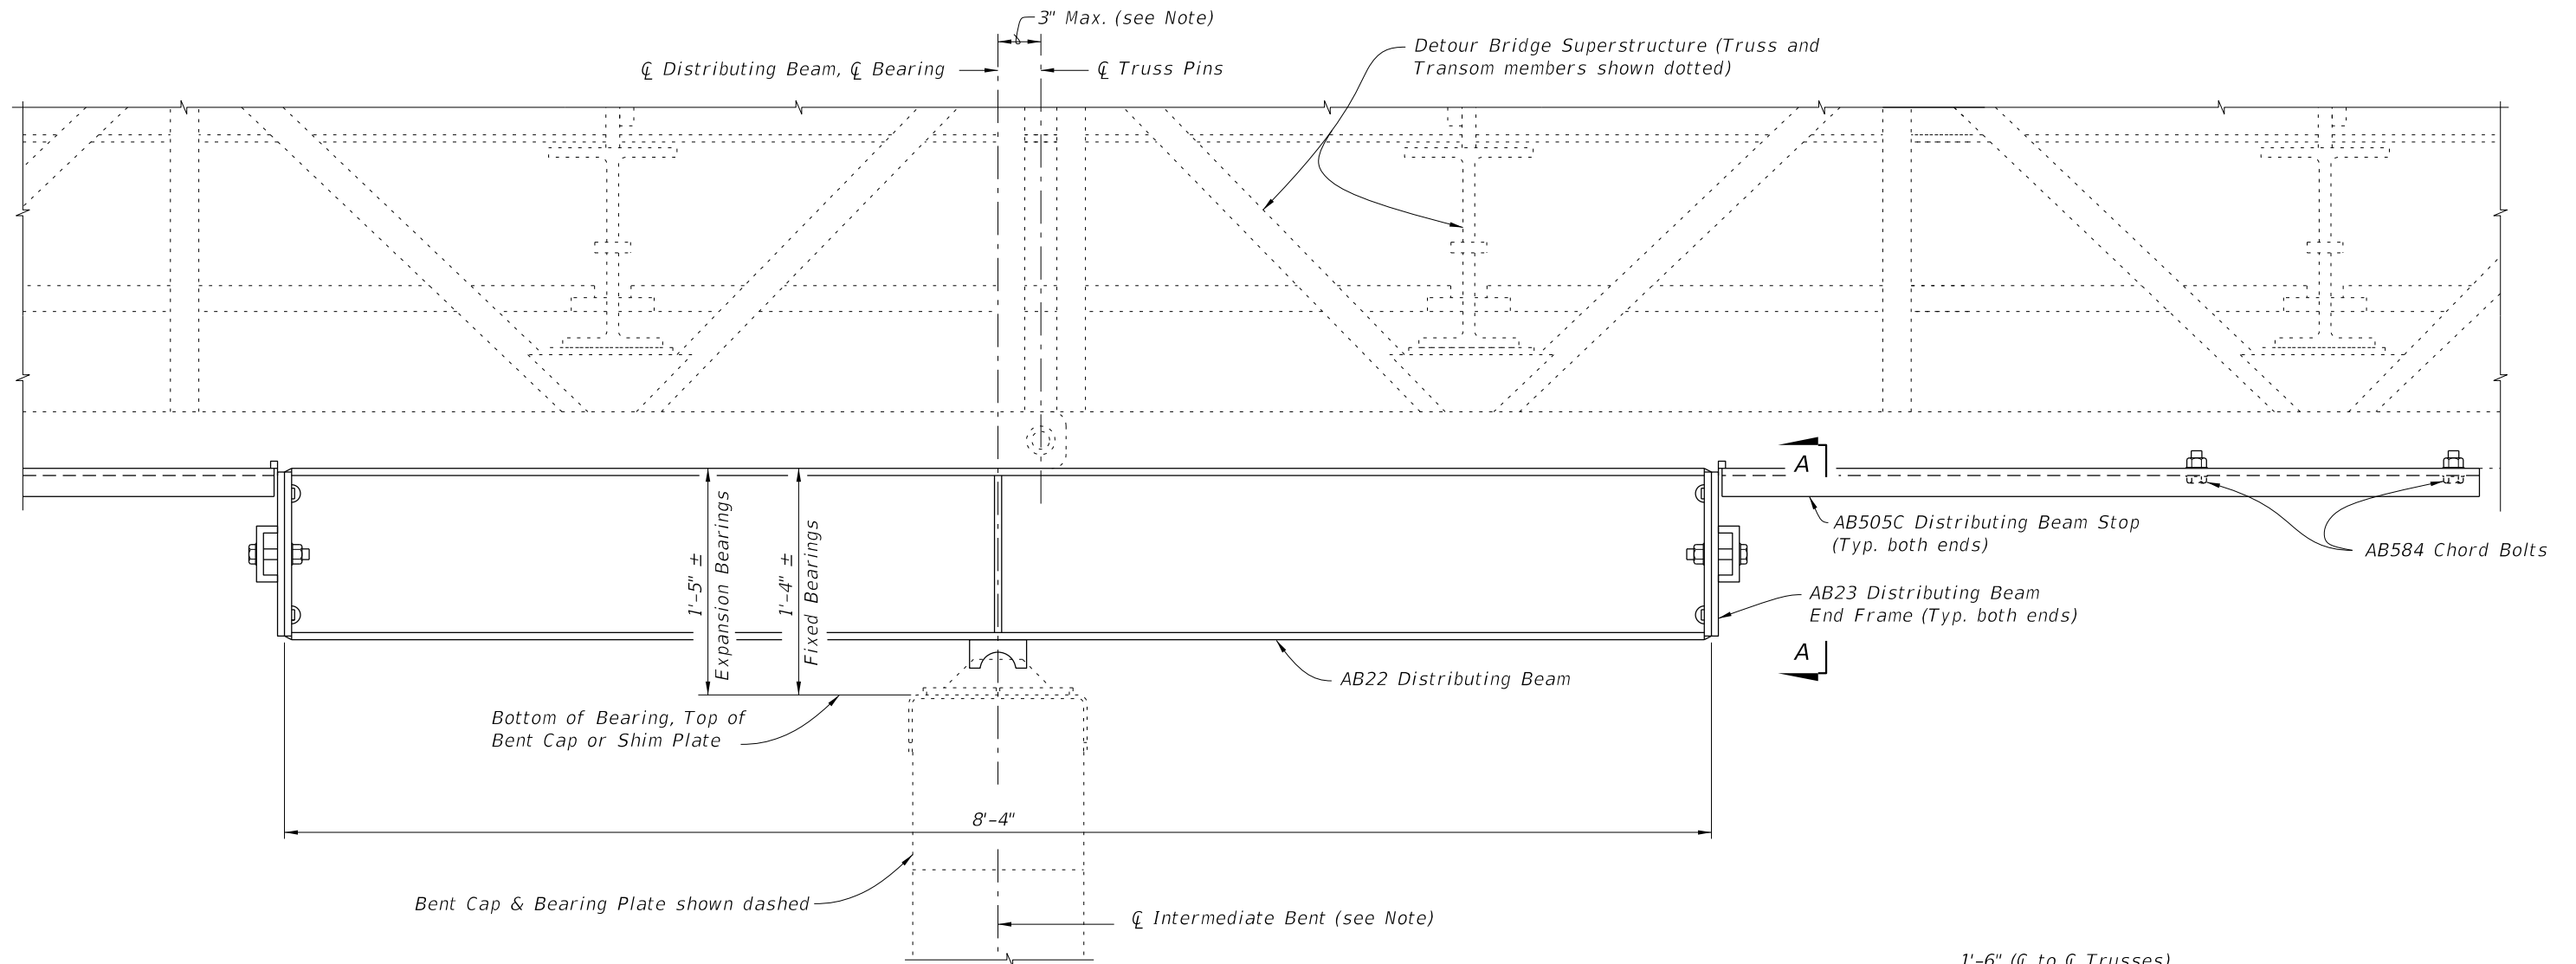


ELEVATION VIEW OF DISTRIBUTING BEAM
(FIXED BEARING SHOWN, EXPANSION BEARING SIMILAR)
(Timber Intermediate Bent shown, Steel Intermediate Bents similar)

Note:
CL Bearing may be shifted from CL Truss Pins as shown, CL Intermediate Bent may be shifted from CL Bearing an additional 3" to allow for pile placement tolerances.

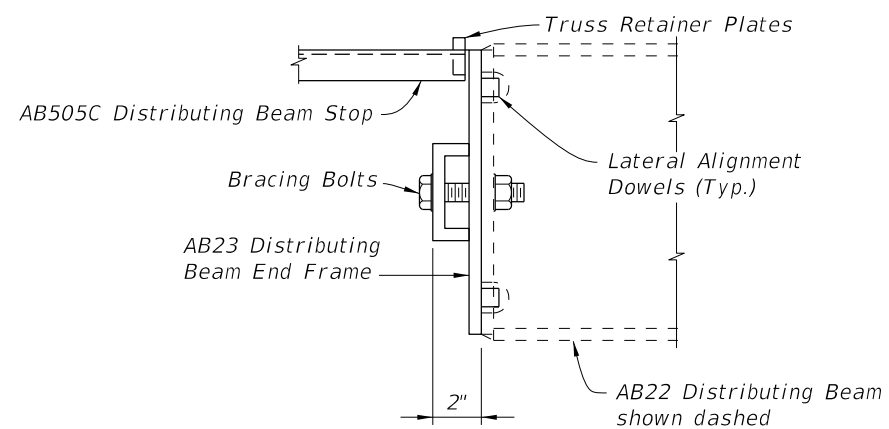


VIEW B-B
2026-27

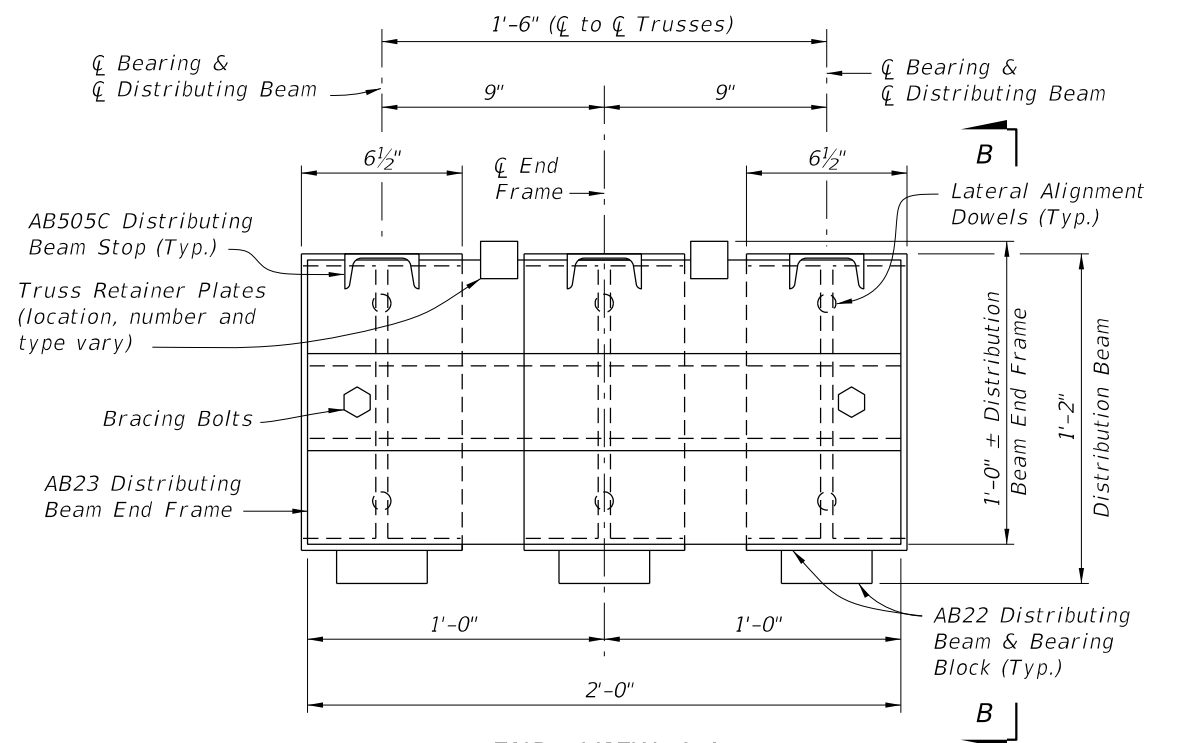


END VIEW A-A
DISTRIBUTING BEAM END FRAME DETAIL


LAST REVISION	DESCRIPTION:	FDOT	FY 2025-26 STANDARD PLANS	TEMPORARY ACROW 300 SERIES DETOUR BRIDGE GENERAL NOTES AND DETAILS	INDEX 102-200	SHEET 5 of 8 6 of 7
11/01/22 11/01/25						

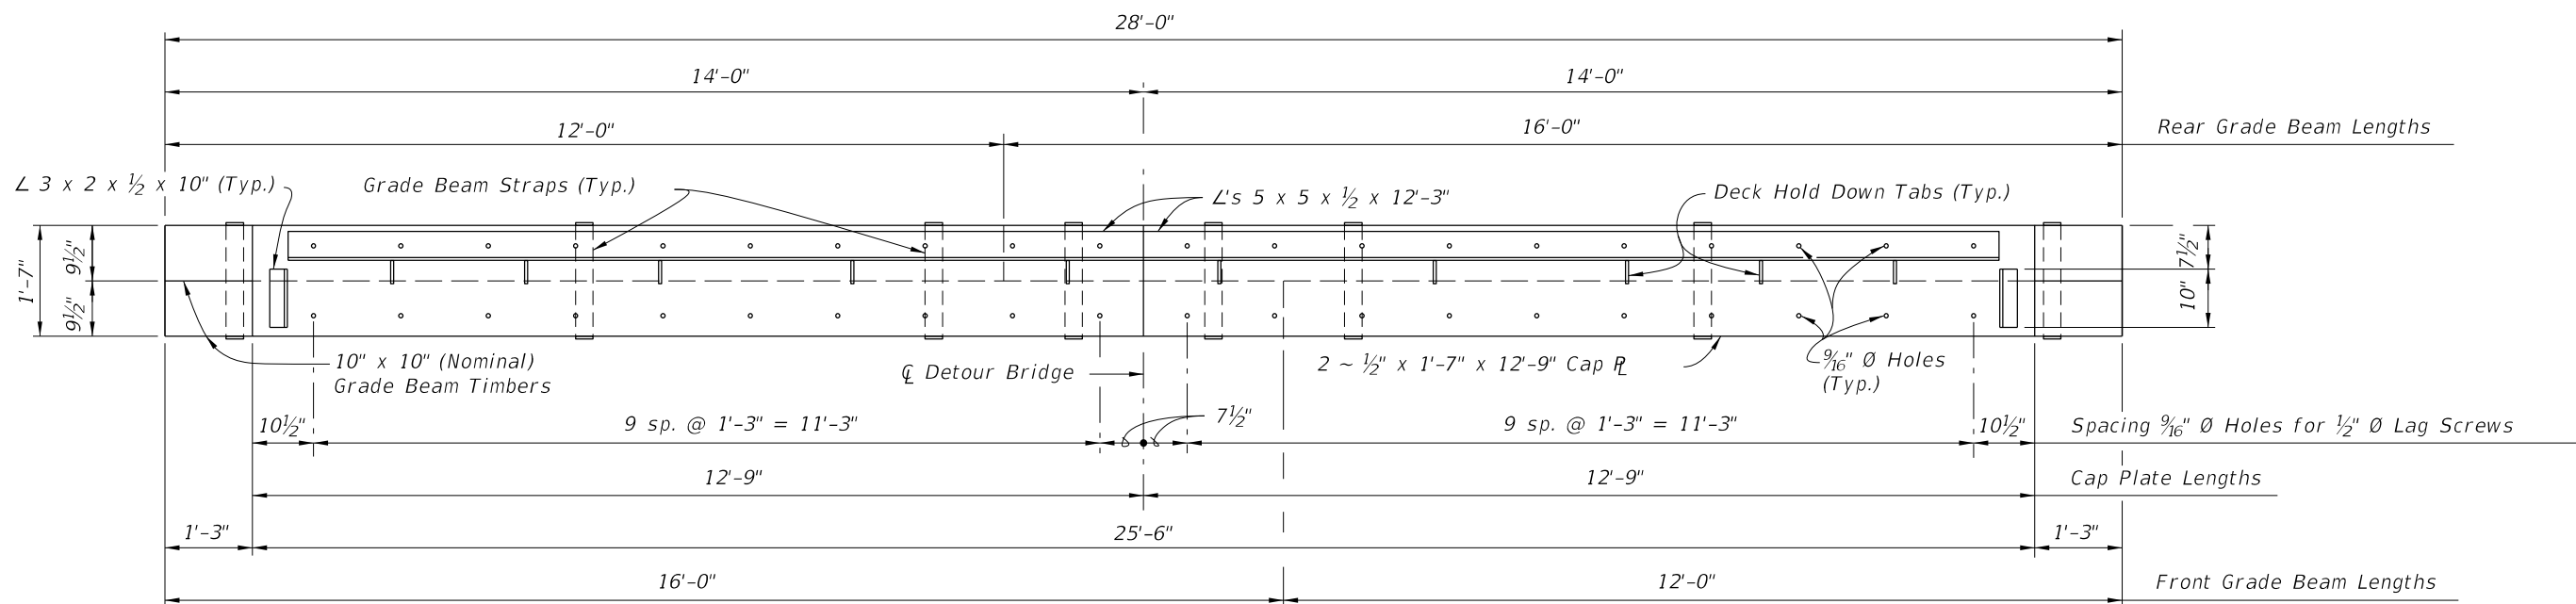

PLAN VIEW

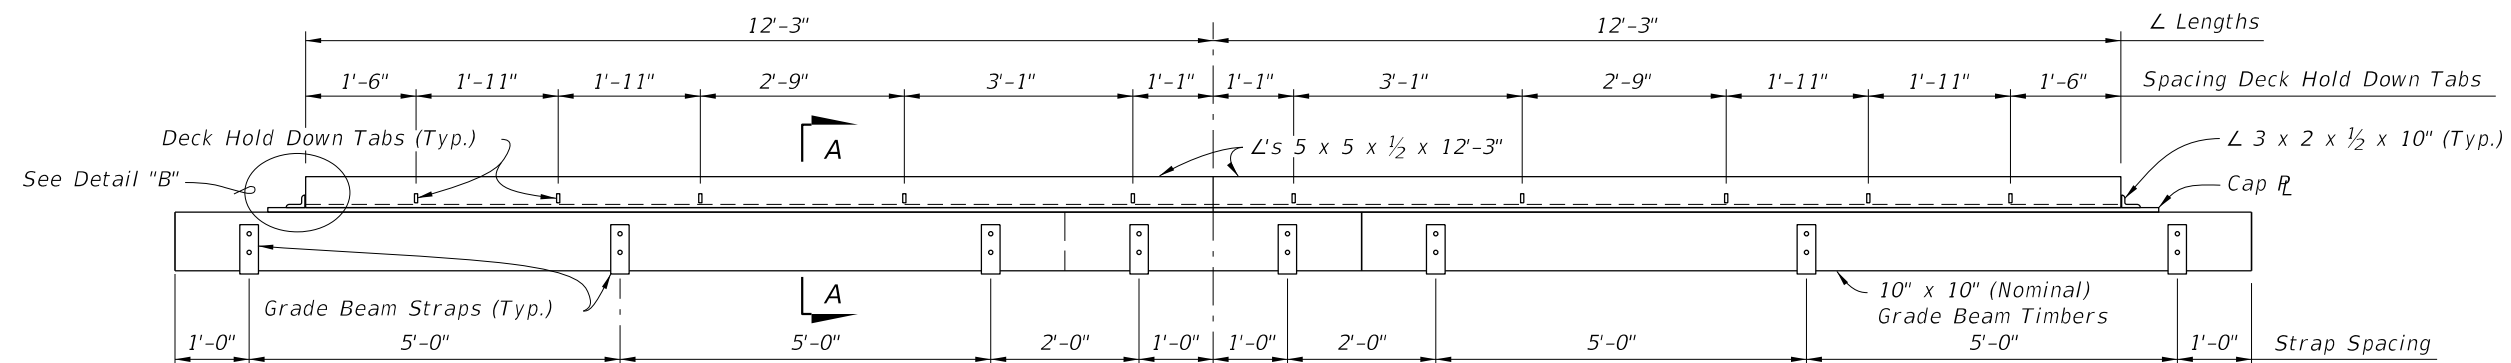


ELEVATION VIEW

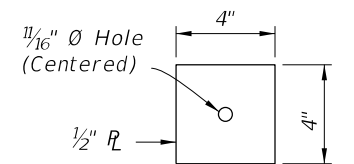


ANCHOR PLATE DETAIL


* See General Notes for setting widths other than 70° F.

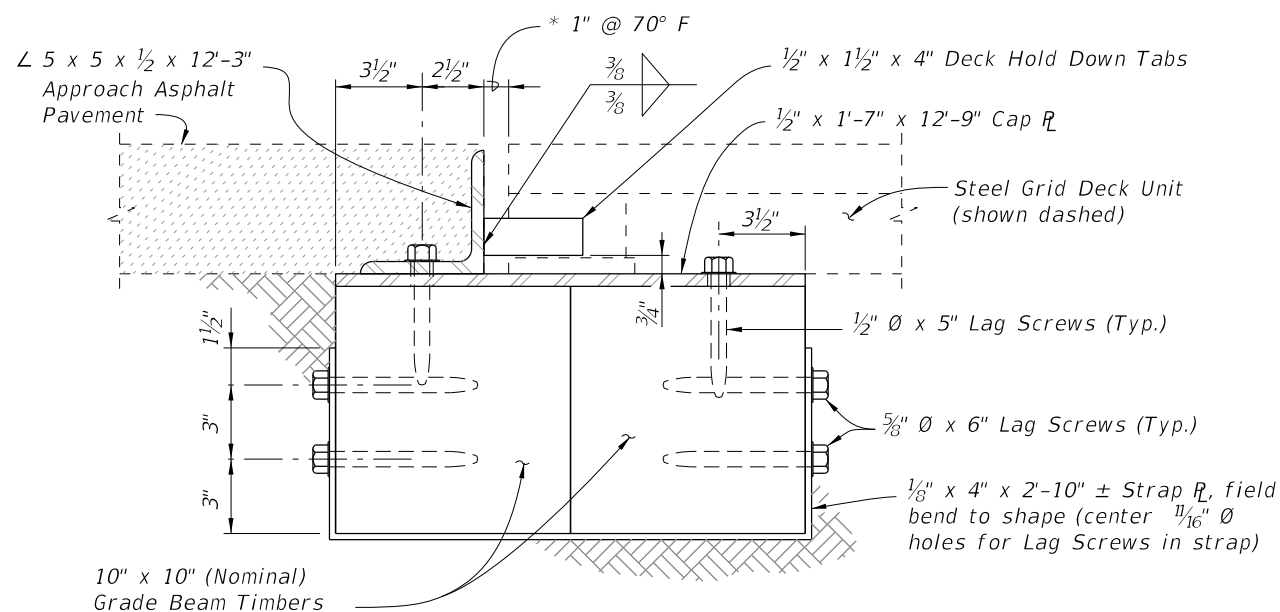

SECTION A-A

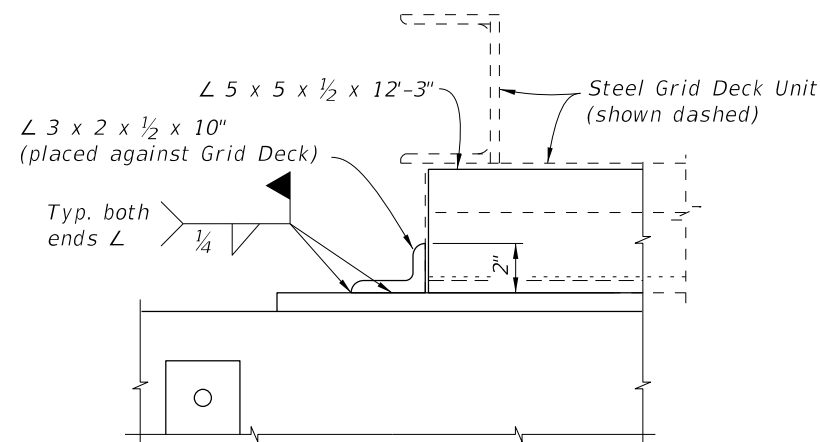

DETAIL "B"

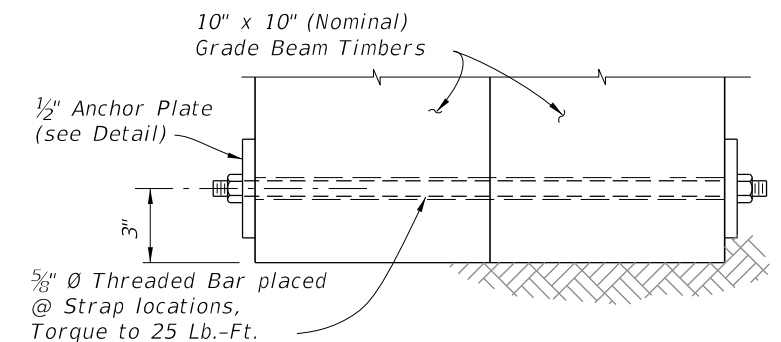

OPTIONAL THROUGH BOLT DETAIL (MAY BE USED IN LIEU OF STRAPS)

GRADE BEAM DETAILS

10/17/2024 7:58:56 AM

<p>LAST REVISION</p> <p>11/01/20</p> <p>11/01/25</p>	<p>REVISION</p> <p>DESCRIPTION:</p>	<p>2026-27</p> <p>FY 2025-26</p> <p>STANDARD PLANS</p>	<p>TEMPORARY ACROW 300 SERIES DETOUR BRIDGE</p> <p>GENERAL NOTES AND DETAILS</p>	<p>INDEX</p> <p>102-200</p>	<p>SHEET</p> <p>6 of 8</p> <p>7 of 7</p>
--	-------------------------------------	---	--	-----------------------------	--

**NEW SHEET 7: Details for
Intermediate Bearings**

NEW SHEET 8: Details for End
Bent Bearings

GENERAL NOTES:

This Index is only applicable to the current FDOT inventory of temporary bridge components which are manufactured in accordance with Acrow Series 300, Triple Single design.

Work this Index with Index 102-210, 102-220, 102-230 and 102-240.

STRUCTURAL STEEL:

Steel Plates and Rolled Sections shall be ASTM A709 Grade 36.
Pipe piles shall be ASTM A252 Grade 2, Fy = 35 ksi.

BOLTS, LAG SCREWS AND THREADED BOLT STOCK:

Furnish high strength bolts in accordance with ASTM F3125 Grade A325 Type 1. Furnish Threaded Stock in accordance with ASTM A36. Furnish Lag Screws in accordance with ASTM A307.
Furnish steel washers and nuts compatible with Bolts, Threaded Stock and Lag Screws.

TIMBER AND LAGGING:

Timber and Lagging shall be No. 1 Southern Yellow Pine.

BACKWALL BENT PILES:

Timber Piles:
10' Minimum Embedment into compacted backfill or into soil having a blow count greater than 6 (N>6).
Ultimate Capacity greater than 18 tons.
Splices are not allowed on any timber piles.

H-Piles:

12' Minimum Embedment into compacted backfill or into soil having a blow count greater than 6 (N>6).
Ultimate Capacity greater than 18 tons.

Shims admissible between backwall pile and cap.
Test piles are not required for backwall piles.

EXPANSION BEARINGS:

Inspect the PTFE (Teflon) layer and stainless steel plate prior to installation.
Do not use bearings that have a severely damaged or unbonded PTFE layer.
Clean PTFE of all grit and grime prior to installation.
Clean Stainless steel plate of all grit and grime prior to installation and finish to a smooth buffed surface.

DISTRIBUTING BEAMS:

Longitudinal stops restraining the distributing beams may be lengthened or shortened to center the distributing beam bearing on the cap beam.
The longitudinal stops are to bear on the distributing beam end frame.

EXPANSION JOINT SETTINGS:

Install the expansion joint considering the total continuous bridge length, location of fixed bearings and ambient temperature at the time of installation, assume a 1" expansion joint opening at 70 degrees F.

STORAGE FACILITY:

Contact
FDOT Statewide Aluminum Shop
2590 Camp Rd.
Oviedo, FL.
407-278-2727
For shipping weights and dimensions of Temporary Bridge elements.

SHIPPING WEIGHTS AND DIMENSIONS:

Decking Sizes:

Type	Length	Width	Weight (lbs.)
Curb	5'	6'-9"	800
Curb	10'	6'-9"	1420
Curb	15'	6'-9"	2200
Curb	20'	6'-9"	2800
NonCurb	5'	5'-3"	650
NonCurb	10'	5'-3"	1000
NonCurb	15'	5'-3"	1600
NonCurb	20'	5'-3"	2100

Shipping weights and dimensions of other bridge components can be referenced in "Acrow Panel Bridging, Series 300, Technical Handbook".

TRAFFIC RAILING NOTES:

See Index 536-001 for component details, geometric layouts and associated notes not fully detailed herein.

CONCRETE: Concrete for Transition Blocks shall be Class II (Bridge Deck).

THRIE-BEAM PANEL: Steel Thrie-Beam Elements shall meet the requirements of AASHTO M180, Type II (Zinc coated).

BOLTS, NUTS AND WASHERS: Bolts, nuts and round washers shall be in accordance with AASHTO M180. Plate Washers shall be in accordance with ASTM A36 or ASTM A709 Grade 36. Do not drill Temporary Bridge components to attach Guardrail. Guardrail Bolts shall be placed between Truss members as shown in Index 102-240.

COATINGS: All Nuts, Bolts, Anchors, Washers and Backer Plates shall be hot-dip galvanized in accordance with the Specifications.

WOOD BLOCKS: All wood blocks, including required wedge shaped blocks shall be Pressure Treated Lumber in accordance with Specifications Section 955. Bolt holes in blocks to be centered (±1/4").


PAYMENT:

Temporary Detour Bridge is to be paid for under Contract Unit Price for Special Detour. If a temporary bridge system other than that shown herein is used, the Contractor is responsible for renting or purchasing their own system. Payment for Temporary Guardrail work and Transition Block will be made under Pay Item Temporary Guardrail, LF.

Furnish and install Bridge Thrie-Beam Panels and all associated hardware as shown. Payment will be made with the Temporary Detour Bridge under the Pay Item Special Detour, LS. Turn over Bridge Thrie-Beam Panels and all associated hardware to the Department with the Detour Bridge components per Specifications Section 102-6.

5/23/2025 12:07:10 PM

LAST REVISION 11/01/25	REVISION	DESCRIPTION:	 FY 2026-27 STANDARD PLANS	TEMPORARY ACROW 300 SERIES DETOUR BRIDGE GENERAL NOTES AND DETAILS	INDEX 102-200	SHEET 1 of 8
------------------------------	----------	--------------	--	---	------------------	-----------------

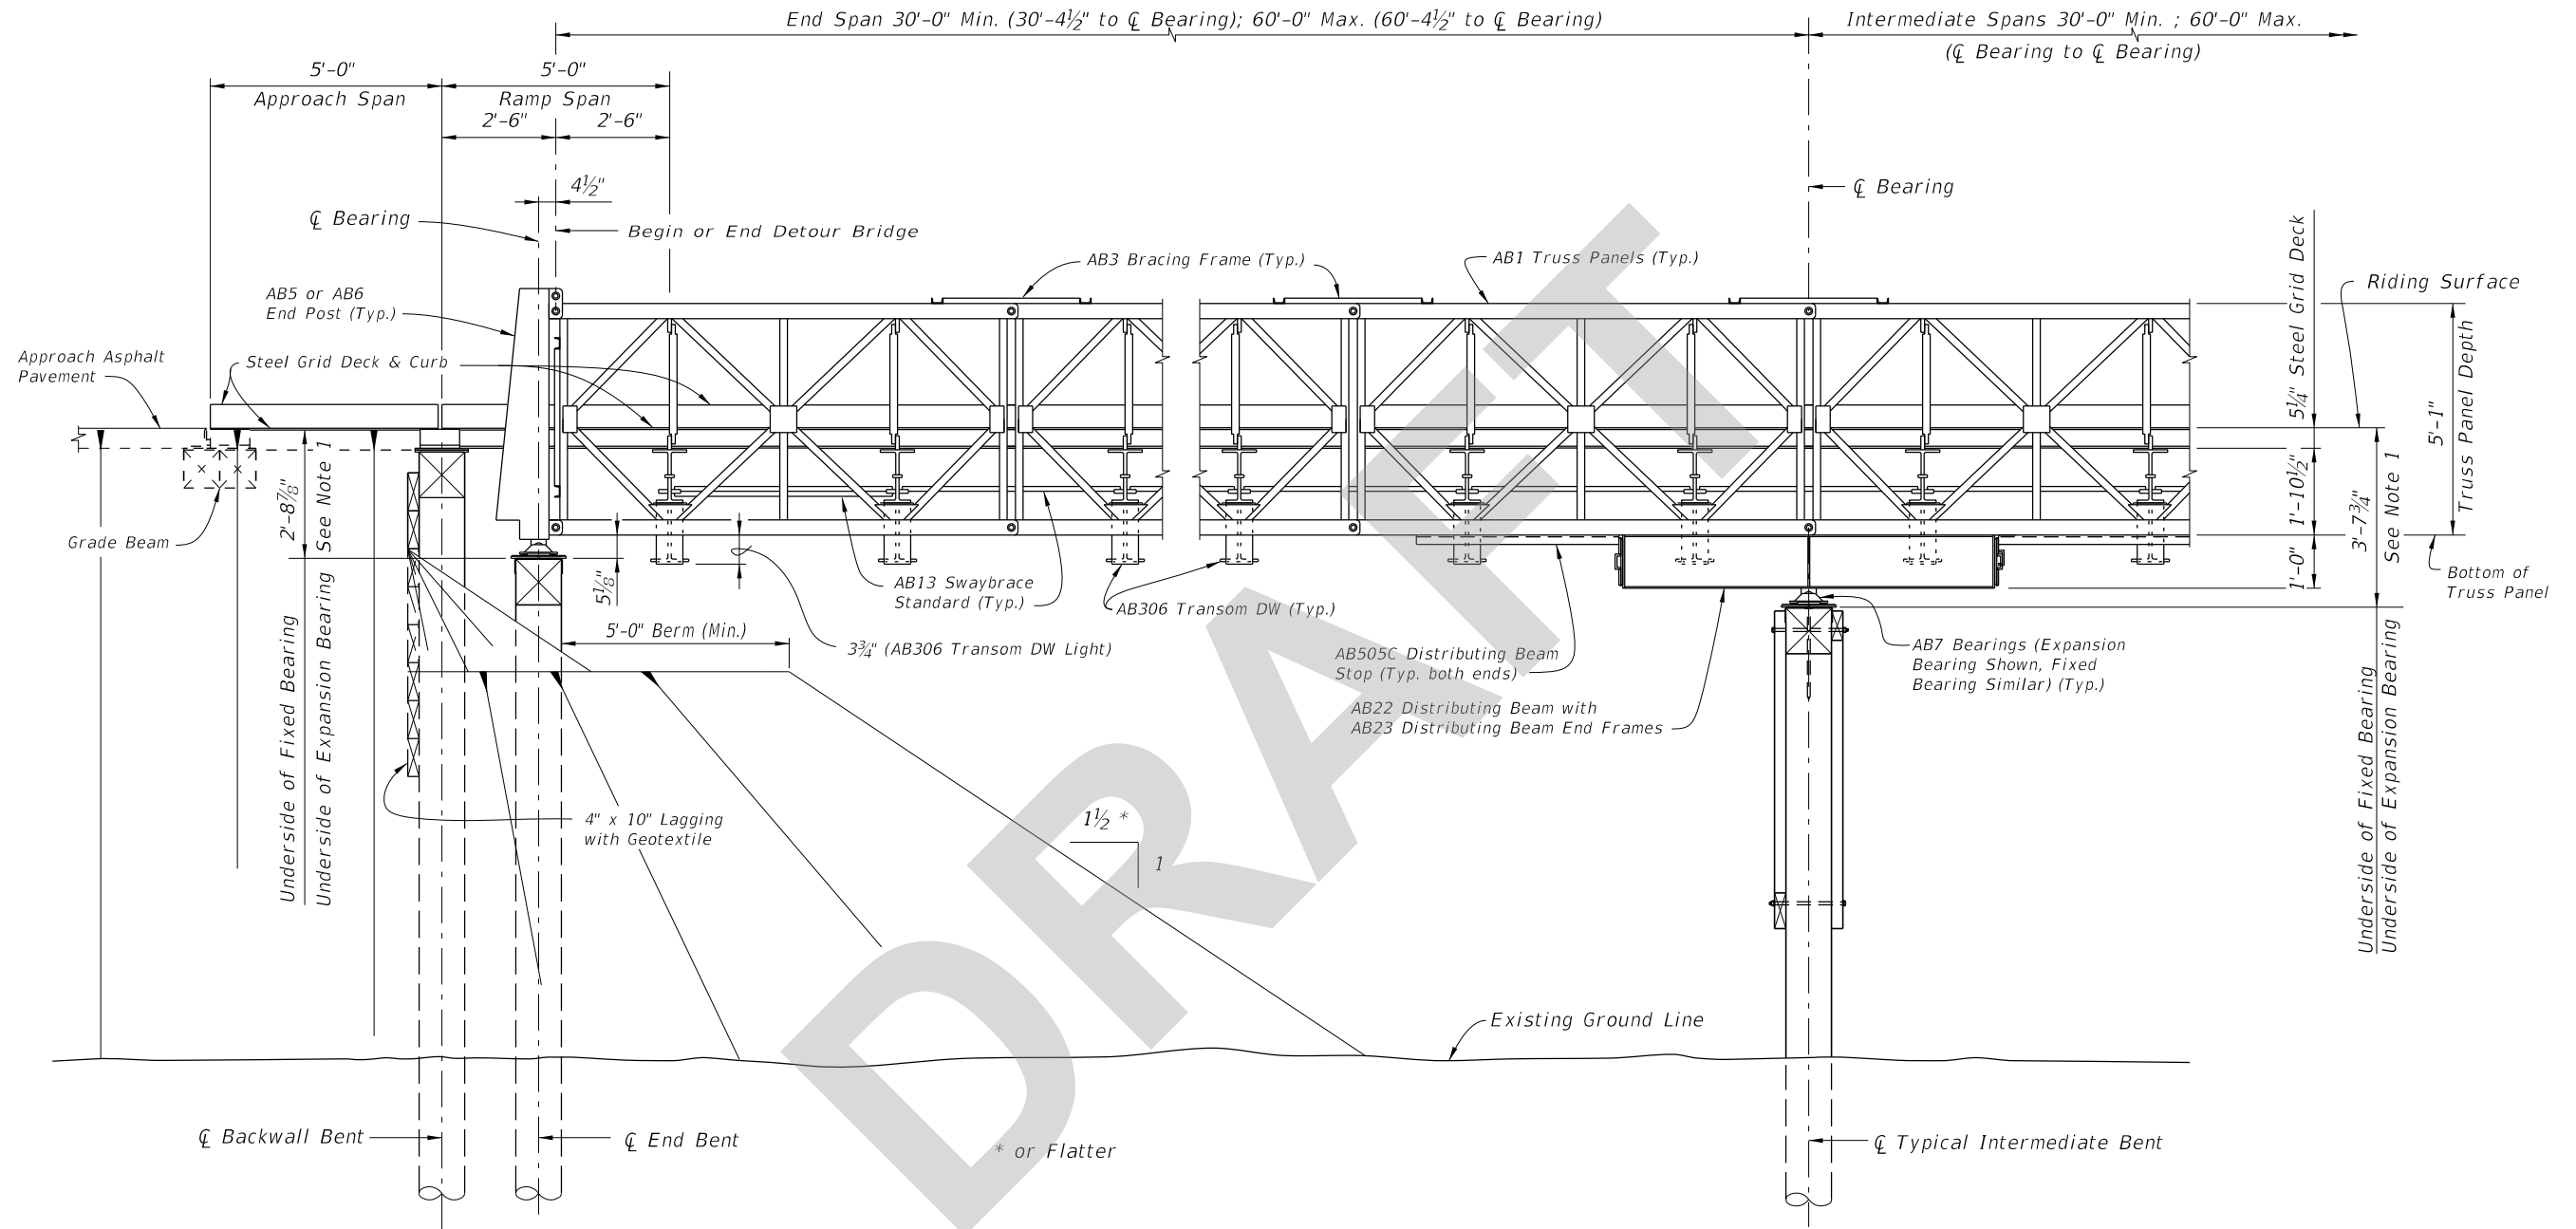


ELEVATION VIEW
(TIMBER PILES SHOWN, STEEL H PILES AND STEEL PIPE PILES SIMILAR)
 (Thrie-Beam Panel not shown for clarity, See Index 102-240)

NOTES:
 1. The dimension to be determined based on final design of substructure. Expansion bearings designed & detailed by Specialty Engineer and supplied by Contractor.

5/23/2025 12:08:06 PM

LAST REVISION	DESCRIPTION:	FDOT	FY 2026-27 STANDARD PLANS	TEMPORARY ACROW 300 SERIES DETOUR BRIDGE GENERAL NOTES AND DETAILS	INDEX	SHEET
11/01/25					102-200	3 of 8

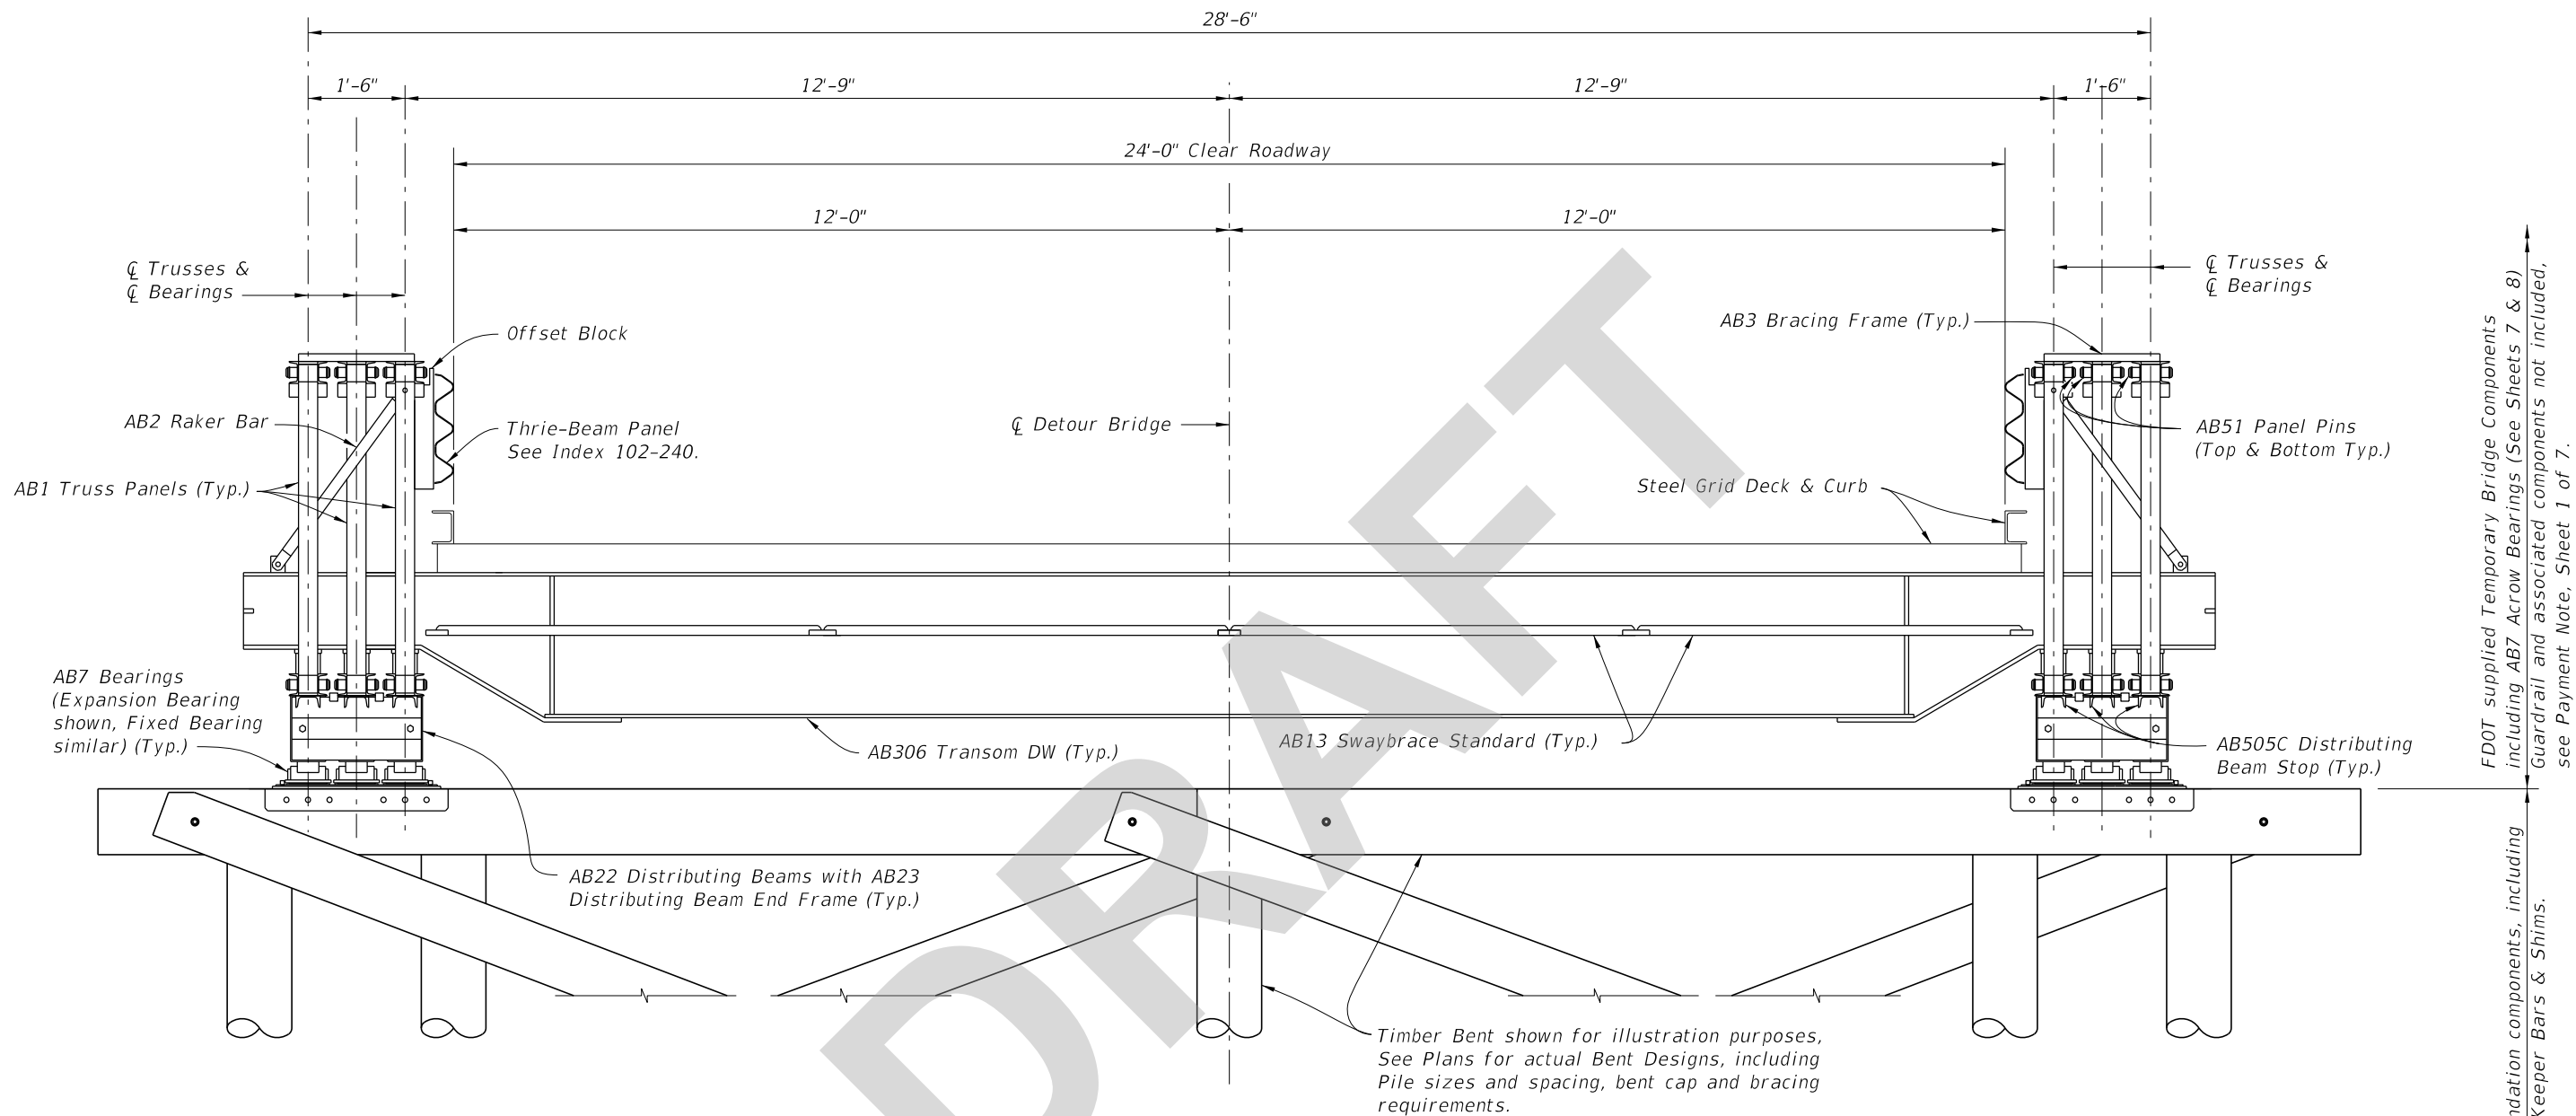


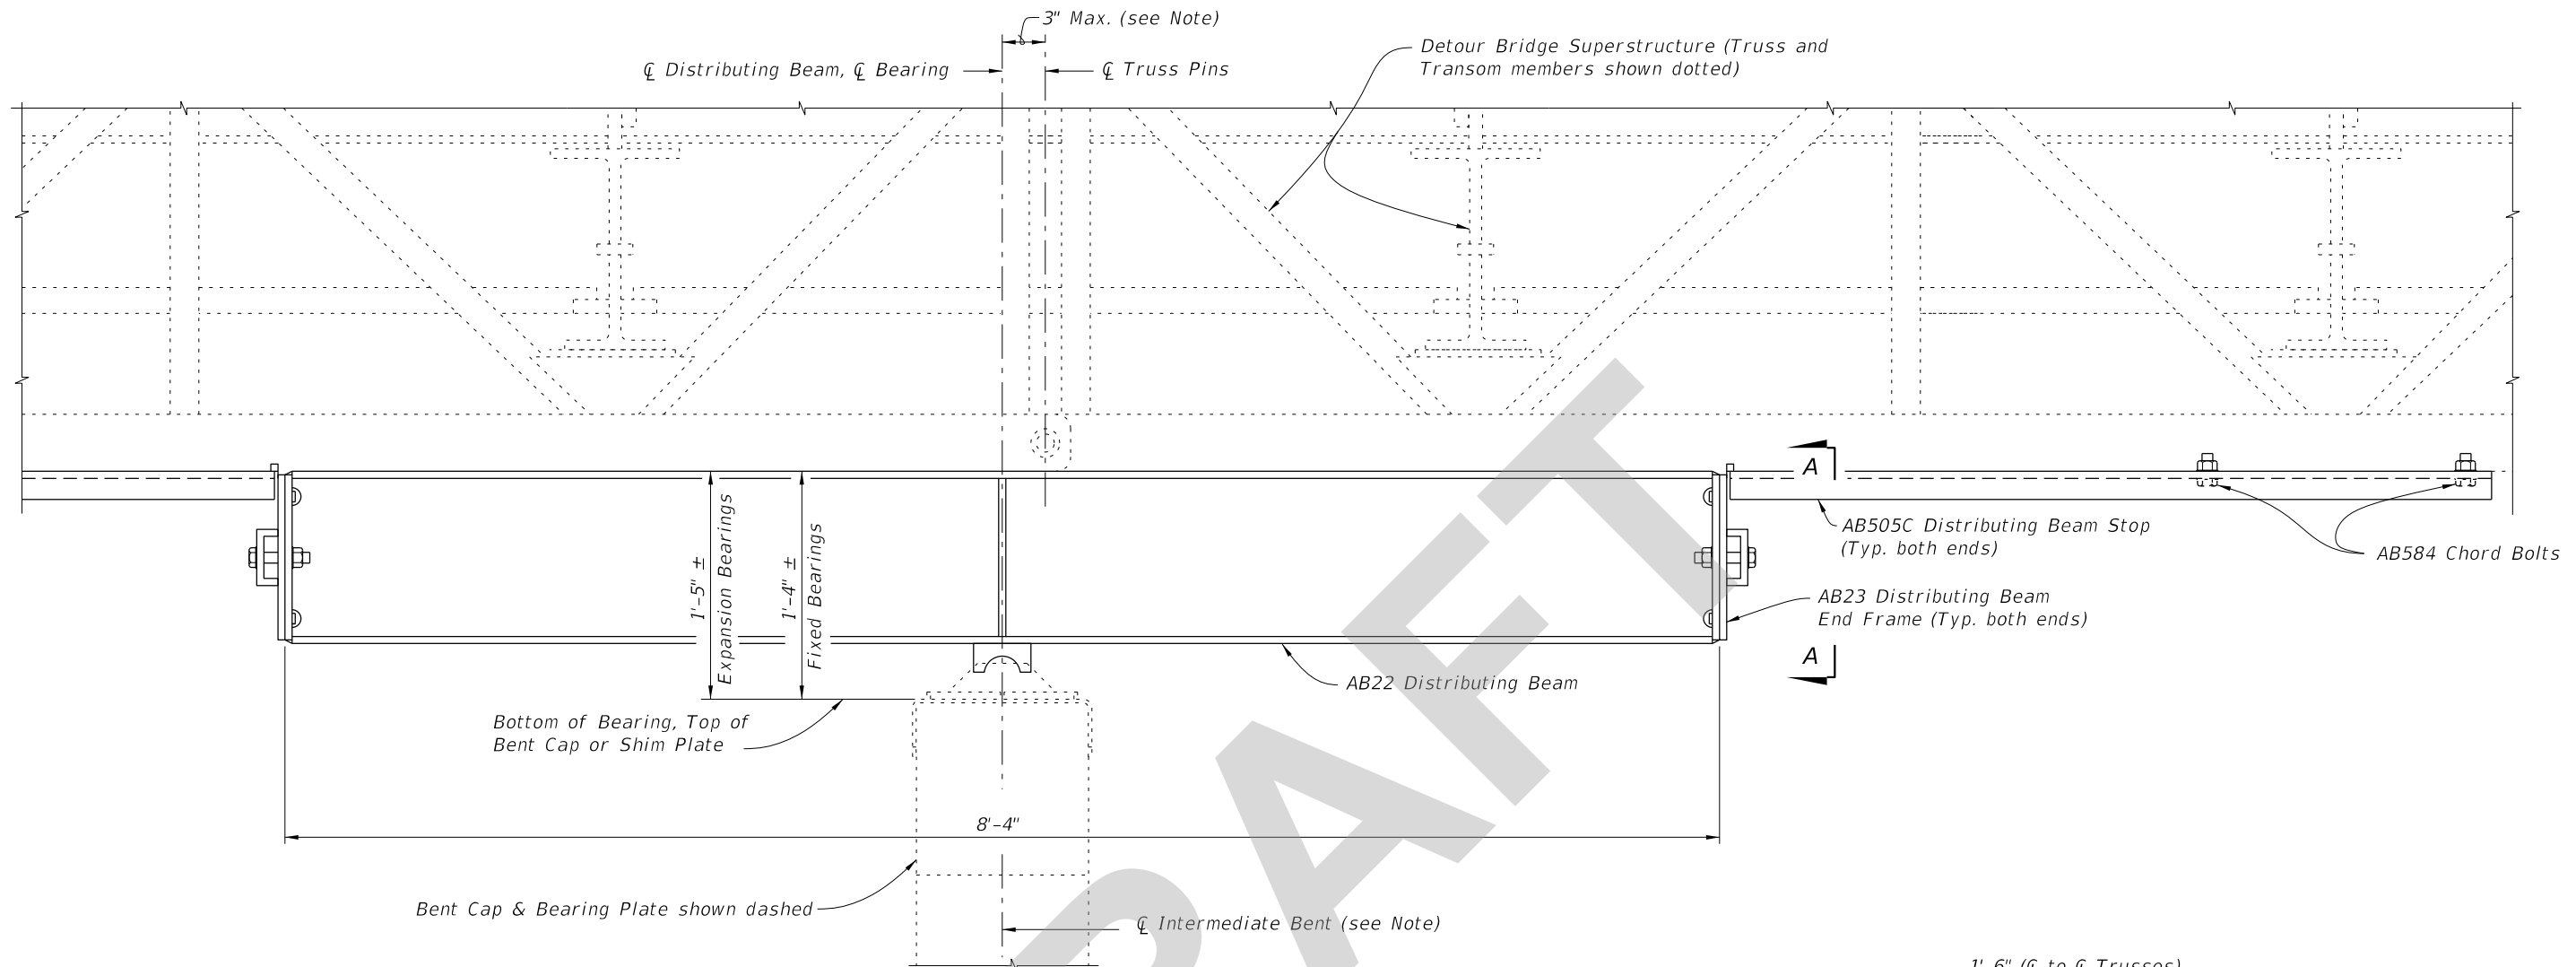
TYPICAL SECTION THRU DETOUR BRIDGE AT INTERIOR BENTS (TYPICAL SECTION AT END BENTS SIMILAR WITHOUT DISTRIBUTING BEAMS)
(TIMBER PILES SHOWN, STEEL H PILES AND STEEL PIPE PILES SIMILAR)

FDOT supplied Temporary Bridge Components including AB7 Acrow Bearings (See Sheets 7 & 8) Guardrail and associated components not included, see Payment Note, Sheet 1 of 7.

Contractor supplied foundation components, including Bearing Saddle Plates, Keeper Bars & Shims.


5/23/2025 12:09:14 PM

LAST REVISION 11/01/25	REVISION	DESCRIPTION:	 FY 2026-27 STANDARD PLANS	TEMPORARY ACROW 300 SERIES DETOUR BRIDGE GENERAL NOTES AND DETAILS	INDEX 102-200	SHEET 4 of 8
------------------------------	----------	--------------	--	---	------------------	-----------------




ELEVATION VIEW OF DISTRIBUTING BEAM
 (FIXED BEARING SHOWN, EXPANSION BEARING SIMILAR)
 (Timber Intermediate Bent shown, Steel Intermediate Bents similar)

Note:
 CL Bearing may be shifted from CL Truss Pins as shown, CL Intermediate Bent may be shifted from CL Bearing an additional 3" to allow for pile placement tolerances.

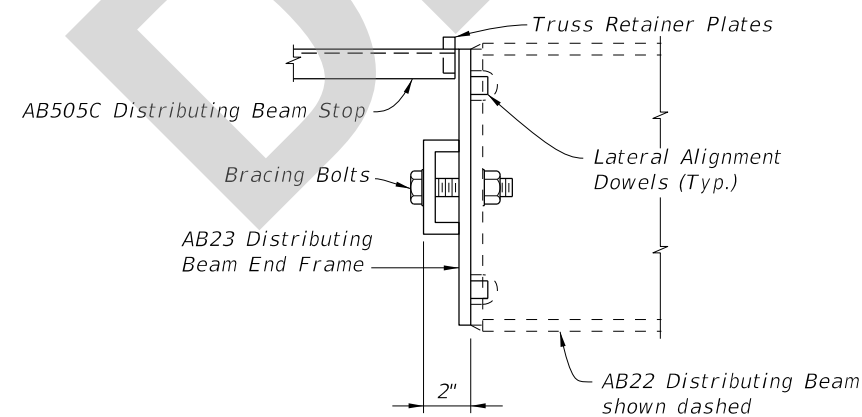



VIEW B-B

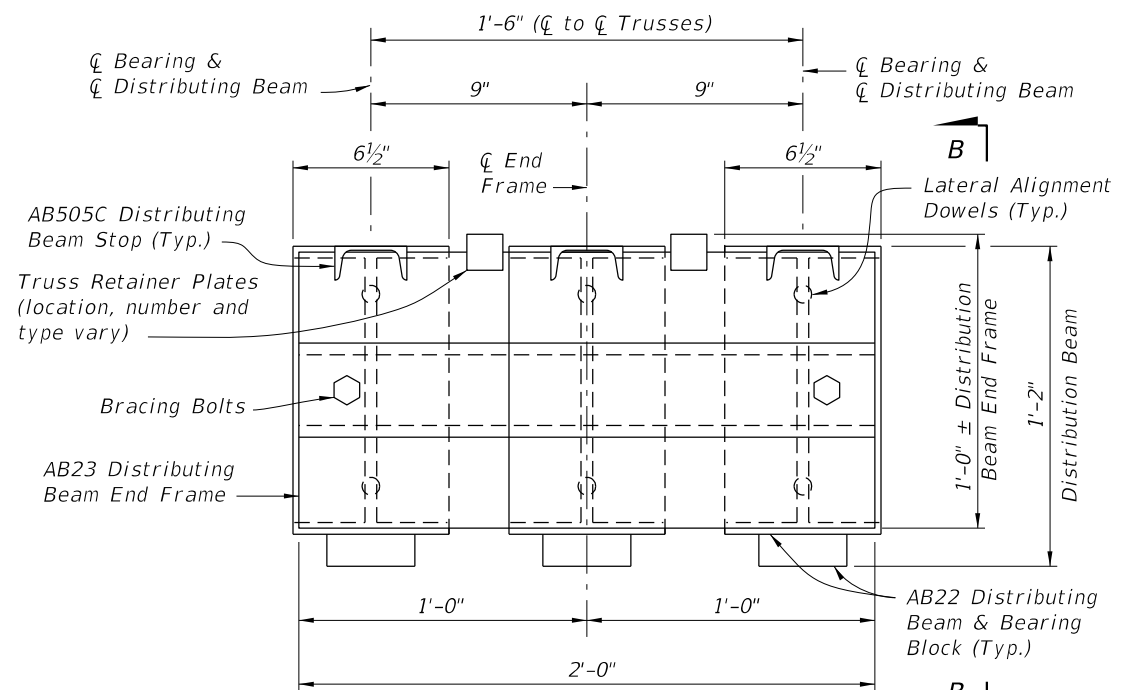




END VIEW A-A
DISTRIBUTING BEAM END FRAME DETAIL

5/23/2025 12:09:42 PM

LAST REVISION 11/01/25	REVISION	DESCRIPTION:	FDOT FY 2026-27 STANDARD PLANS	TEMPORARY ACROW 300 SERIES DETOUR BRIDGE GENERAL NOTES AND DETAILS	INDEX 102-200	SHEET 5 of 8
------------------------------	----------	--------------	--------------------------------------	---	------------------	-----------------

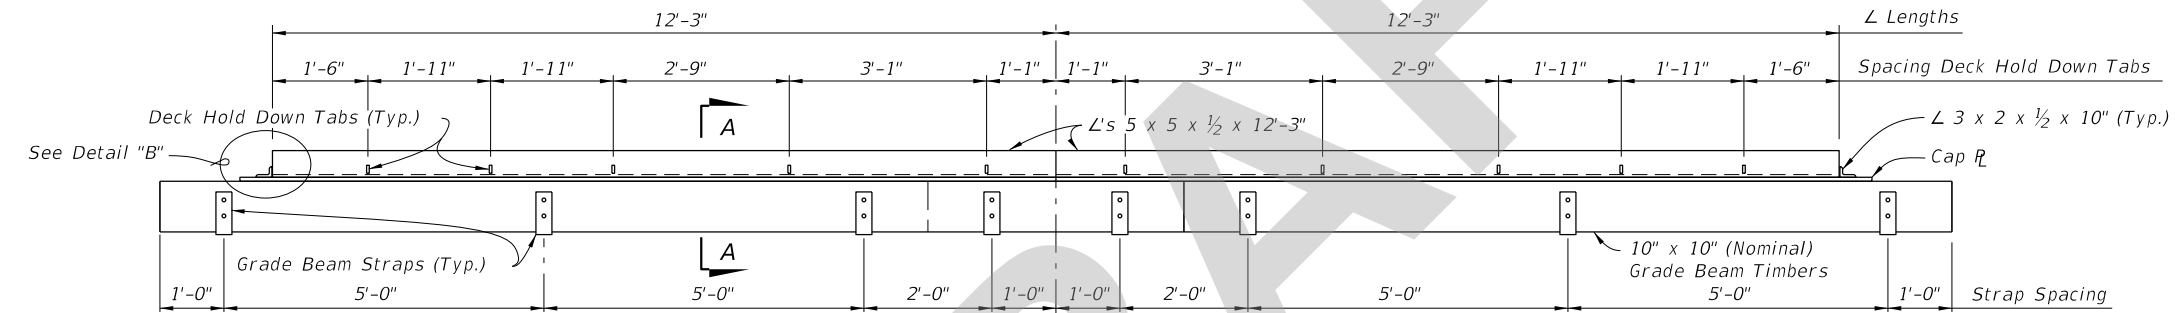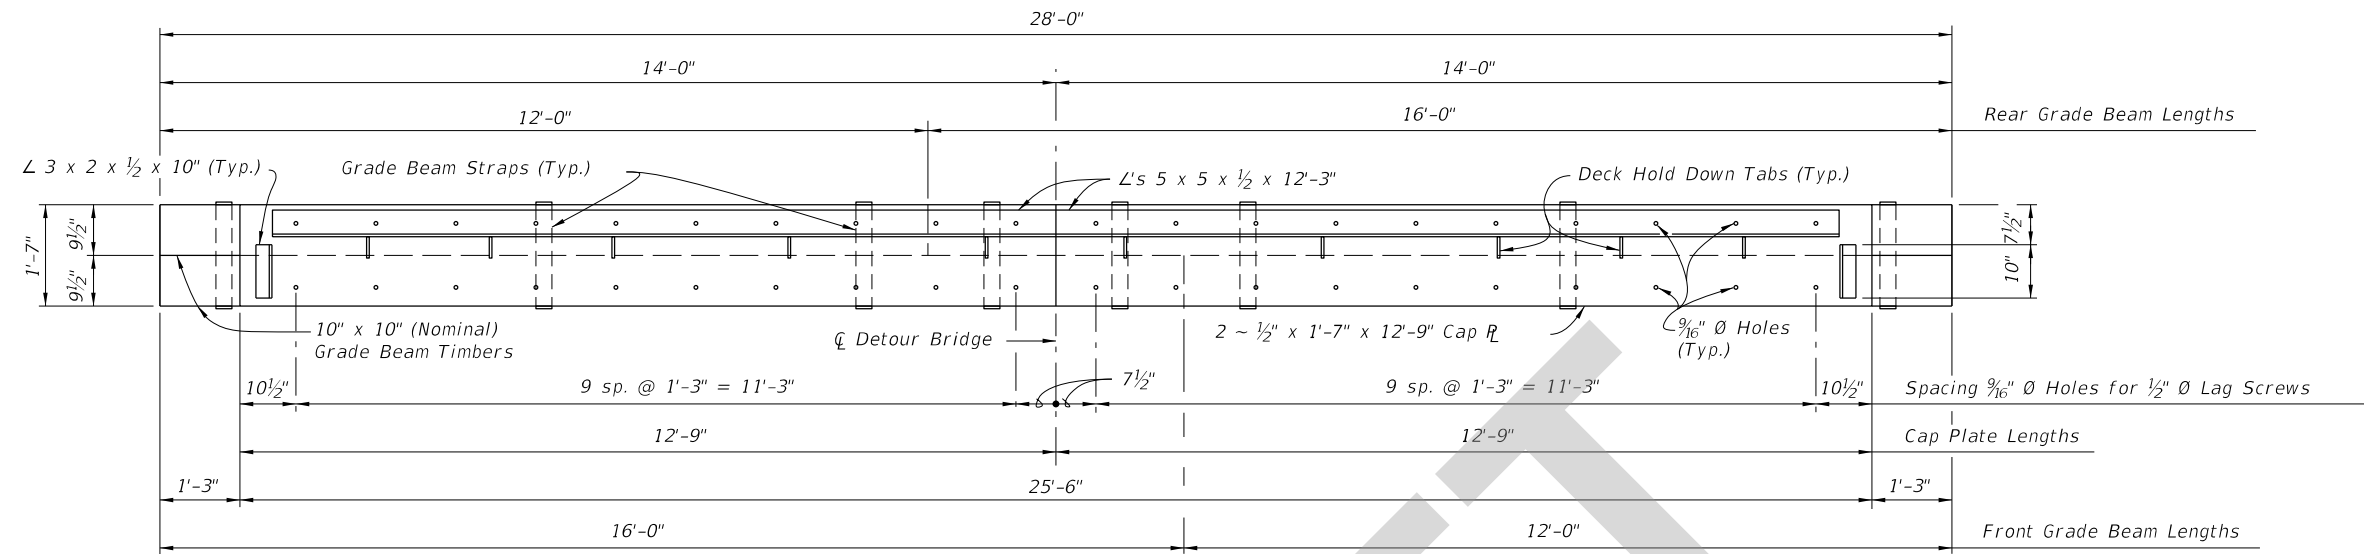

* See General Notes for setting widths other than 70° F.

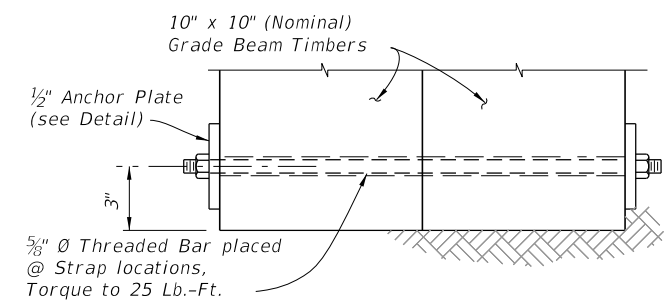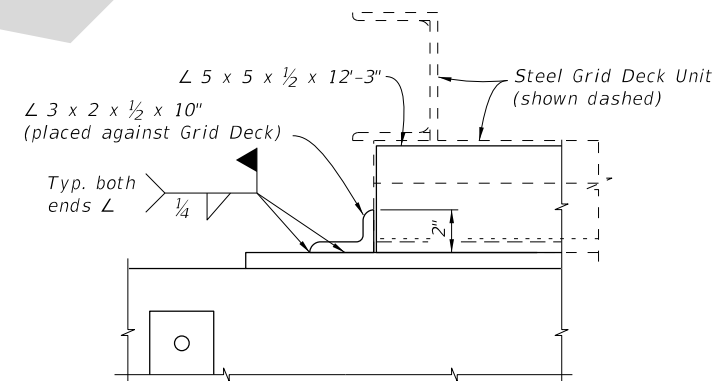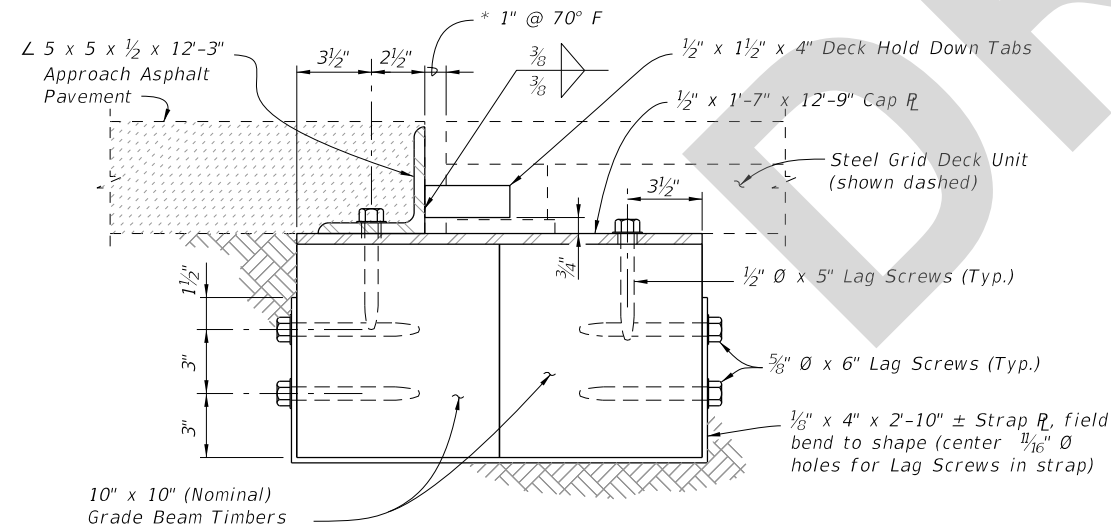

SECTION A-A


DETAIL "B"

OPTIONAL THROUGH BOLT DETAIL (MAY BE USED IN LIEU OF STRAPS)


GRADE BEAM DETAILS

5/23/2025 12:10:23 PM


LAST REVISION 11/01/25	REVISION	DESCRIPTION:	FDOT	FY 2026-27 STANDARD PLANS	TEMPORARY ACROW 300 SERIES DETOUR BRIDGE GENERAL NOTES AND DETAILS	INDEX 102-200	SHEET 6 of 8
------------------------------	----------	--------------	------	------------------------------	---	------------------	-----------------

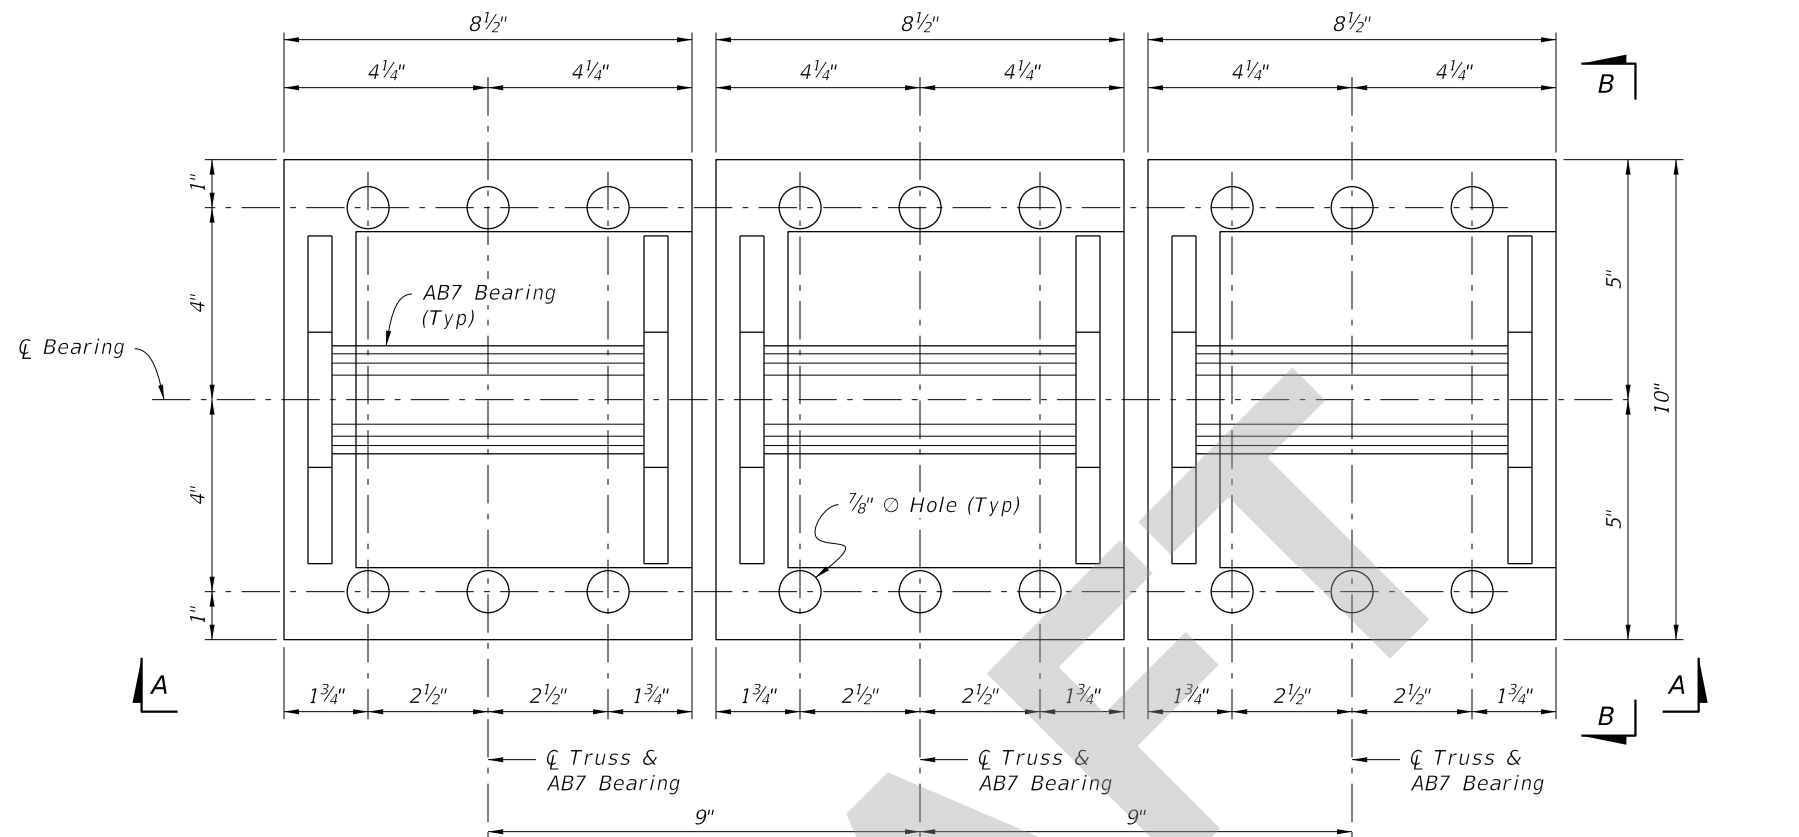

PLAN - AB7 BEARINGS

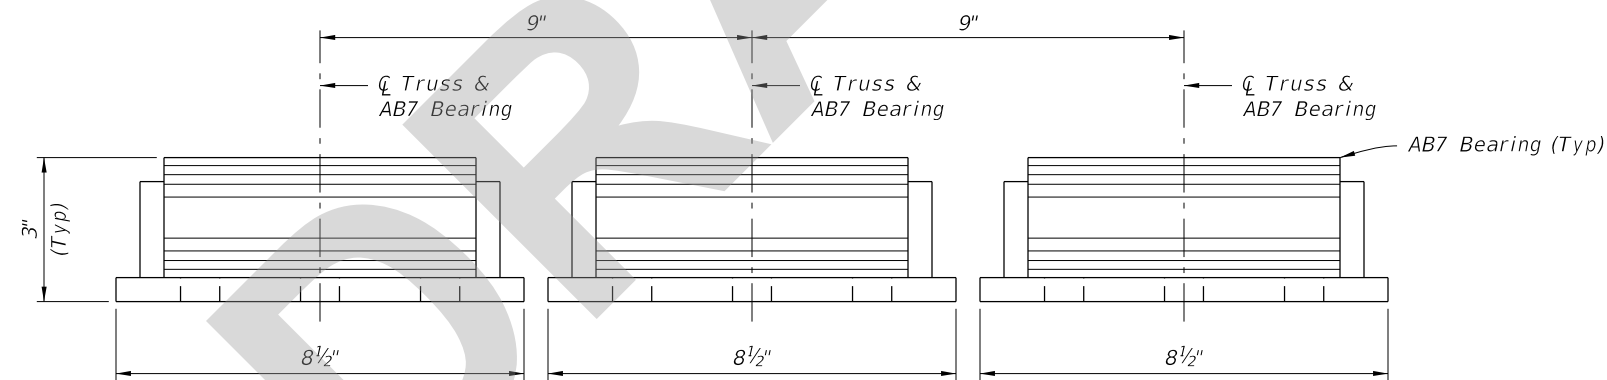

VIEW A-A

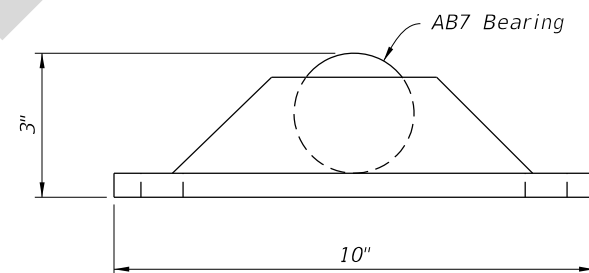

VIEW B-B

5/23/2025 12:10:57 PM

<p>LAST REVISION 11/01/25</p>	<p>REVISION</p> <p>DESCRIPTION:</p>	<p>FDOT</p> <p>FY 2026-27 STANDARD PLANS</p>	<p>FIXED BEARING DETAILS AT INTERMEDIATE BENT</p>	<p>INDEX 102-200</p>	<p>SHEET 7 of 8</p>
---------------------------------------	-------------------------------------	--	---	--------------------------	-------------------------

