

Origination Form
Proposed Revisions to a Standard Plans Index

Originator:	Stepp, Richard	Index Number:	521-404
Date:	8/28/2024	Sheet Number(s):	7
E-mail:	richard.stepp@dot.state.fl.us	Index Title:	Guardrail Transitions - Existing Post and Beam Bridge Railings (Narrow and Recessed Curbs)

Summary of the changes:

Sheet 7: SCHEME 5 - Changed "W-Thrie Beam" wording to "Thrie-Beam"; SCHEME 6 - Changed Trailing End Guardrail Connection to show a Thrie-Beam Terminal Connector, Corrected reference to Index 536-001.


Commentary/Background:

Miscellaneous updates have been made to use the latest trailing end connection and nomenclature as shown in the Standard Plans 536 series for guardrail.

Other Affected Documents/Offices	Person Contacted	Affected (Yes/No)
Other Standard Plans		No
FDOT Design Manual		No
Standard Specifications		No
Basis of Estimates Manual		No
Approved Product List		No
Construction Office		No
Maintenance Office		No

Implementation


FY-Standard Plans (Next Release)

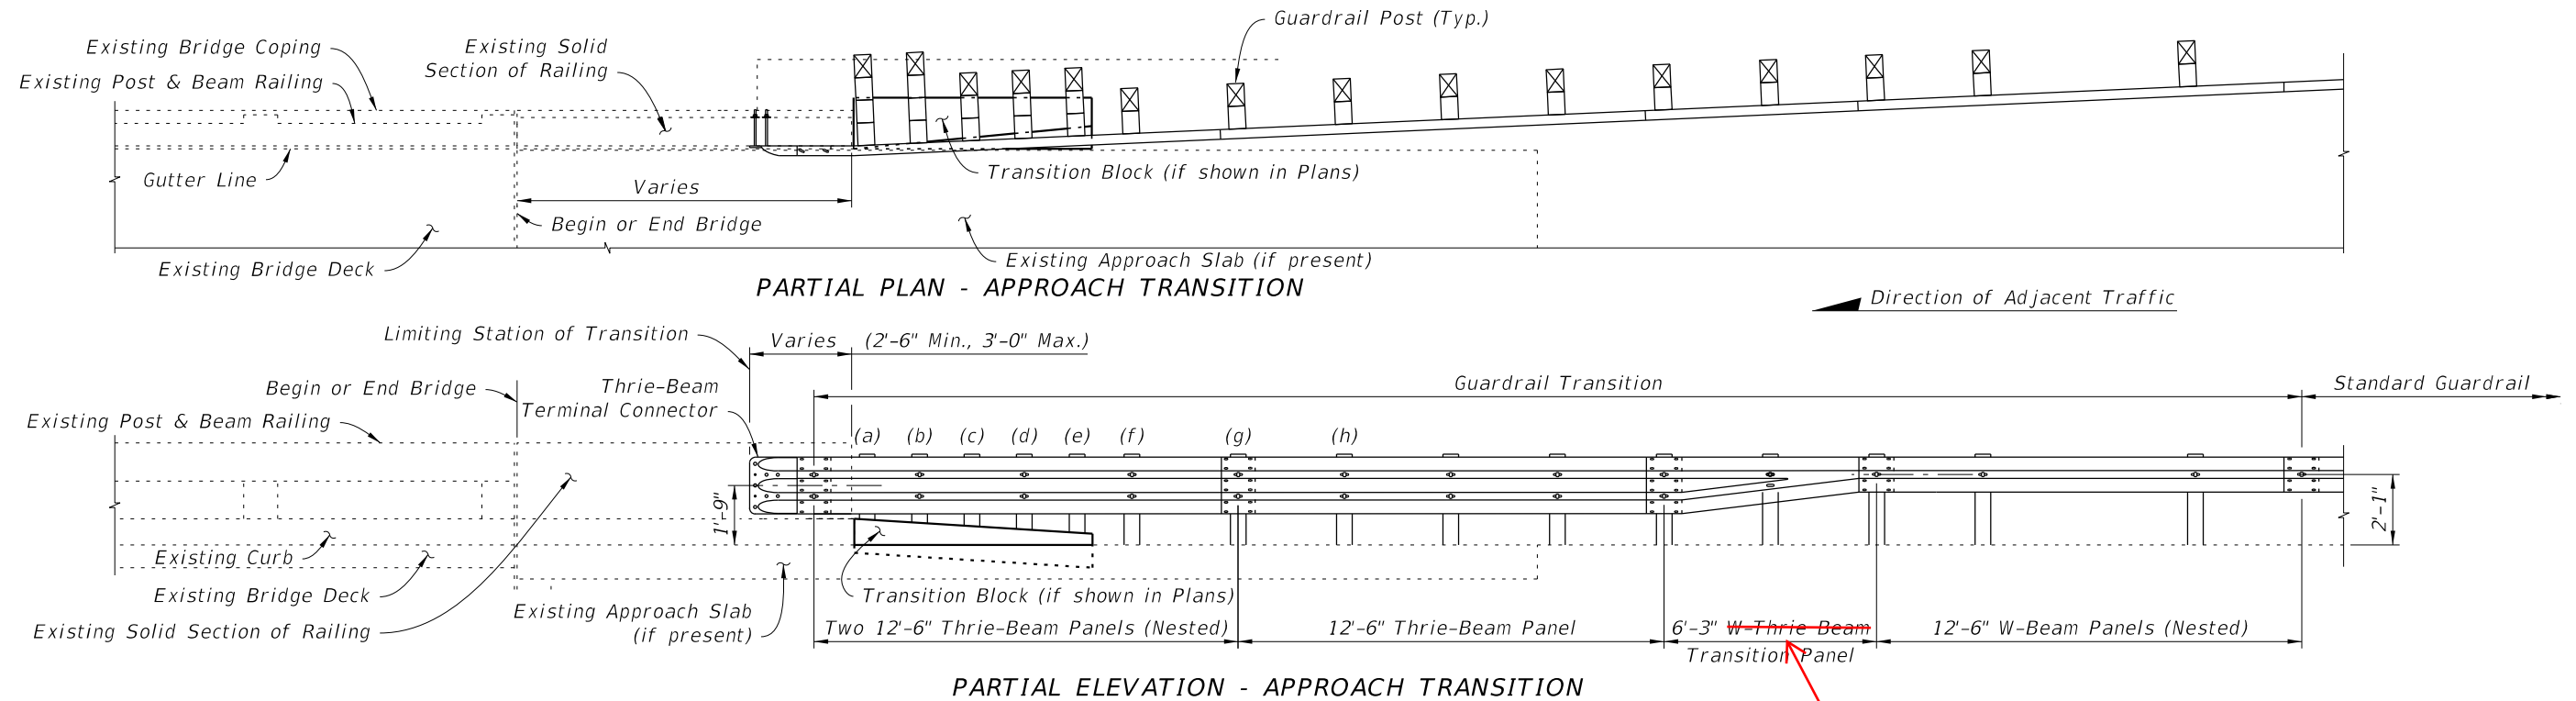

SCHEME 5

(Narrow Curb shown; Recessed Curb similar)

CHANGED: "W-Thrie Beam" to "Thrie-Beam"

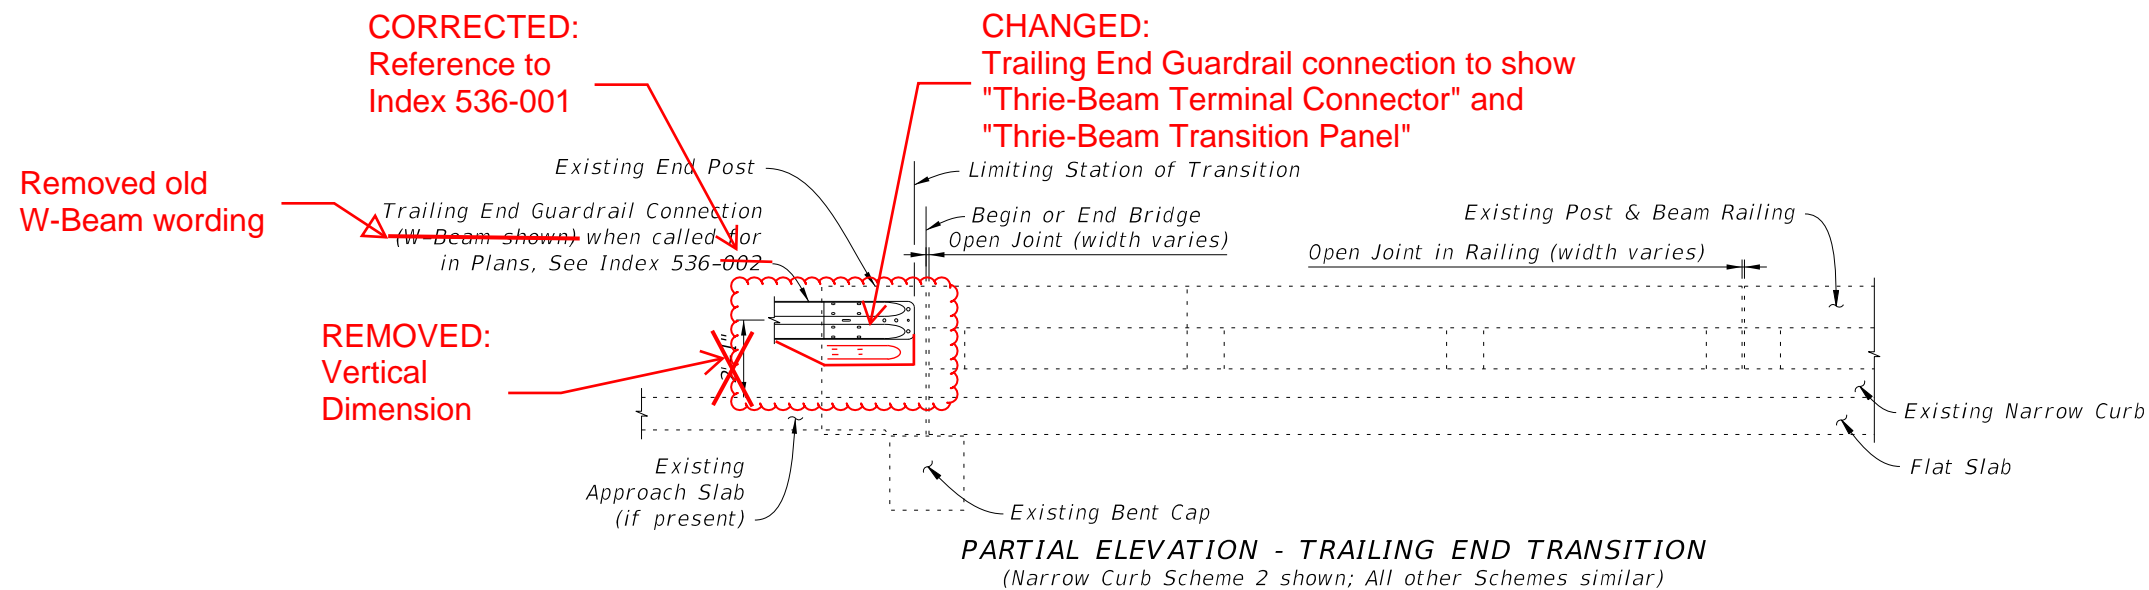

SCHEME 6



2026-27

GUARDRAIL TRANSITION DETAILS - SHEET 2 OF 2

LAST REVISION 07/01/14	DESCRIPTION:	FDOT	FY 2025-26 STANDARD PLANS	GUARDRAIL TRANSITIONS-EXISTING POST & BEAM BRIDGE RAILINGS (NARROW & RECESSED CURBS)	INDEX 521-404	SHEET 7 of 8
---	--------------	------	---	---	------------------	-----------------


11/01/25

10/17/2024 10:26:59 AM

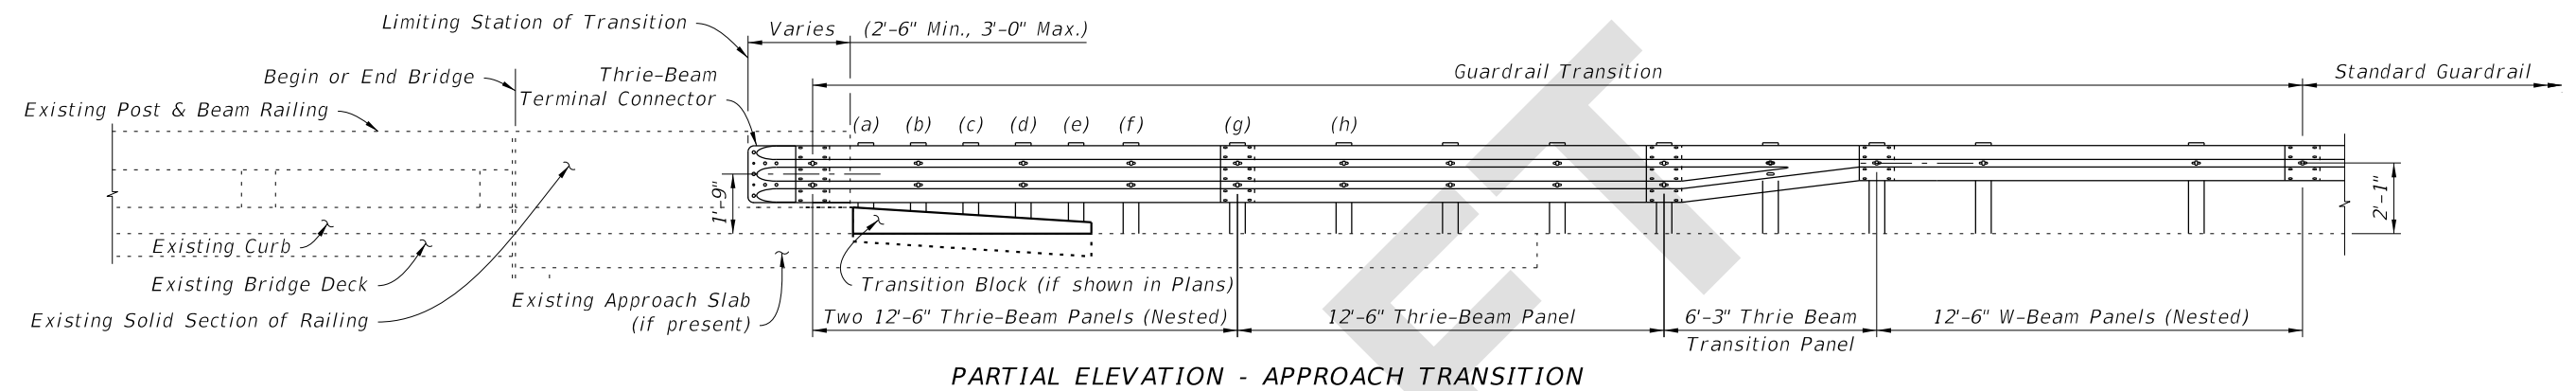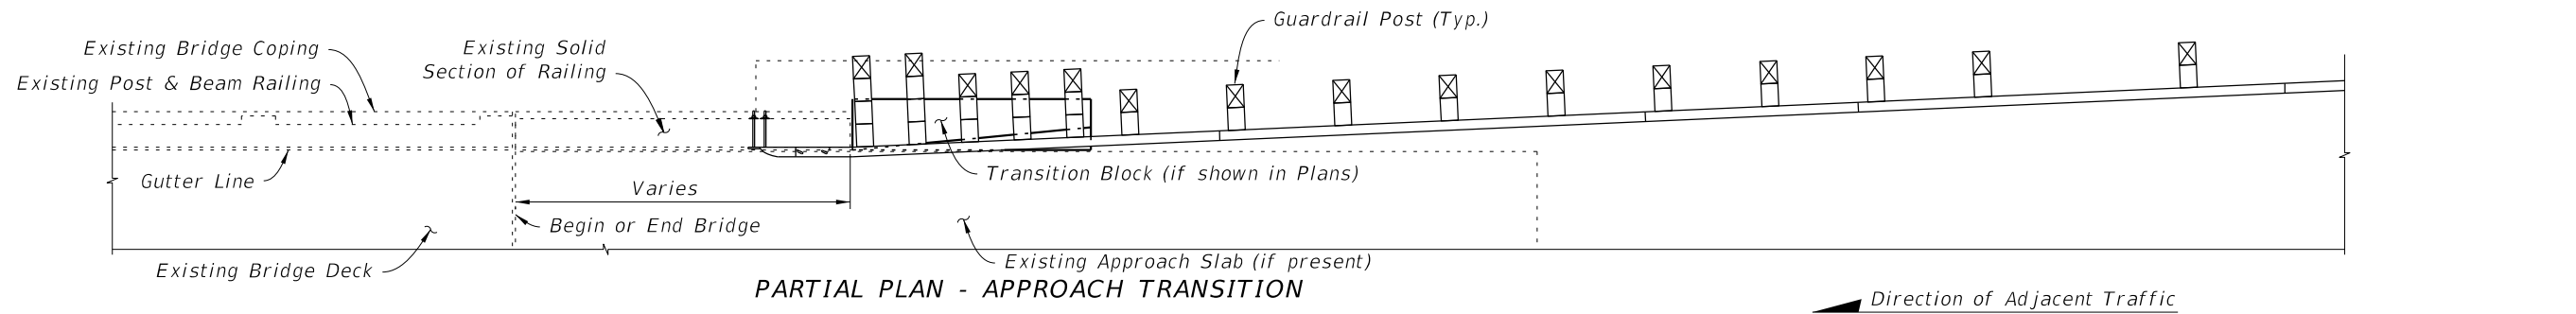

SCHEME 5

(Narrow Curb shown; Recessed Curb similar)

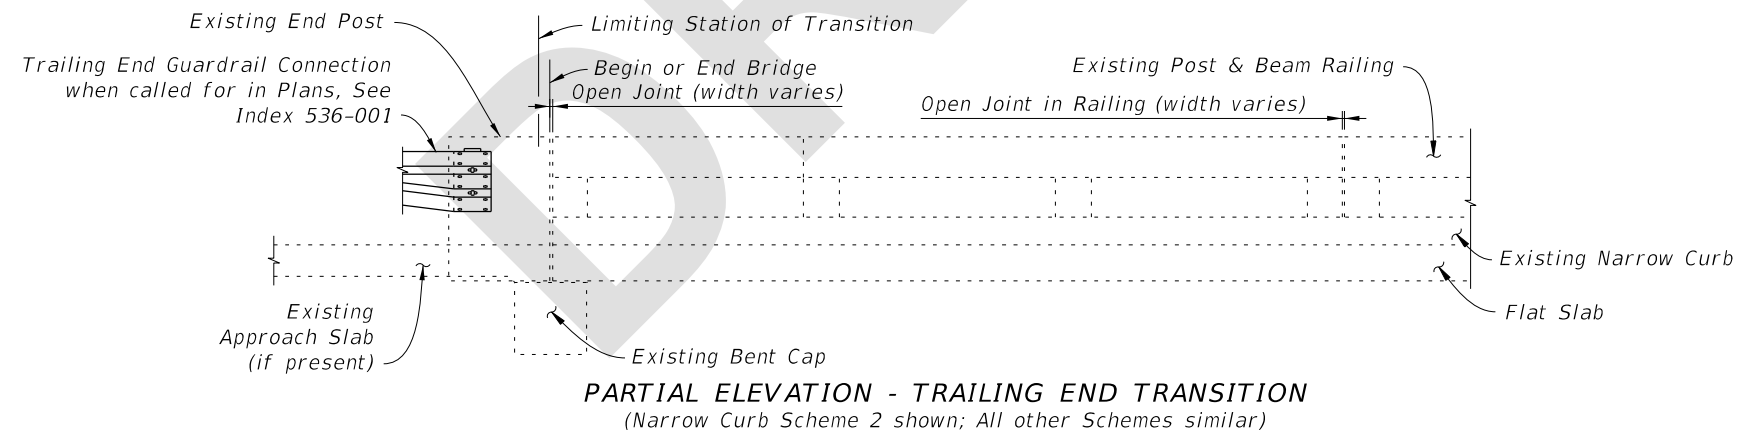

(Narrow Curb Scheme 2 shown; All other Schemes similar)

SCHEME 6

LAST REVISION 11/01/25	REVISION	DESCRIPTION:	FDOT FY 2026-27 STANDARD PLANS	GUARDRAIL TRANSITIONS-EXISTING POST & BEAM BRIDGE RAILINGS (NARROW & RECESSED CURBS)	INDEX 521-404	SHEET 7 of 8
------------------------------	----------	--------------	--------------------------------------	---	------------------	-----------------