

**Origination Form**  
Proposed Revisions to a Standard Plans Index

<b>Originator:</b>	Turley, Joshua	<b>Index Number:</b>	521-423
<b>Date:</b>	1/15/2025	<b>Sheet Number(s):</b>	2, 3
<b>E-mail:</b>	Joshua.Turley@dot.state.fl.us	<b>Index Title:</b>	Traffic Railing - (32" Vertical Shape)

**Summary of the changes:**

Sheet 2: Added "Max." to the slope.  
Sheet 3: Added a grout plug option as an alternate detail.


**Commentary/Background:**

Sheet 2: Some Districts and EORs have been using a sidewalk slope of 0.015 ft/ft to help make sure the finished slope stays within the ADA limit of 0.02 ft/ft. By adding "max" to the slope detail, the EOR has the flexibility to choose the slope. The intent is to hold the barrier height constant and thus the curb height along the roadway may be slightly taller (if the slope is less).  
Sheet 3: Contractors requested a more constructible and economical option that would still perform the intended function of preventing water to flow out between the open joints.


<b>Other Affected Documents/Offices</b>	<b>Person Contacted</b>	<b>Affected (Yes/No)</b>
<b>Other Standard Plans</b>		No
<b>FDOT Design Manual</b>		No
<b>Standard Specifications</b>		No
<b>Basis of Estimates Manual</b>		No
<b>Approved Product List</b>		No
<b>Construction Office</b>		No
<b>Maintenance Office</b>		No

**Implementation**

["FY-Standard Plans (Next Release)"]

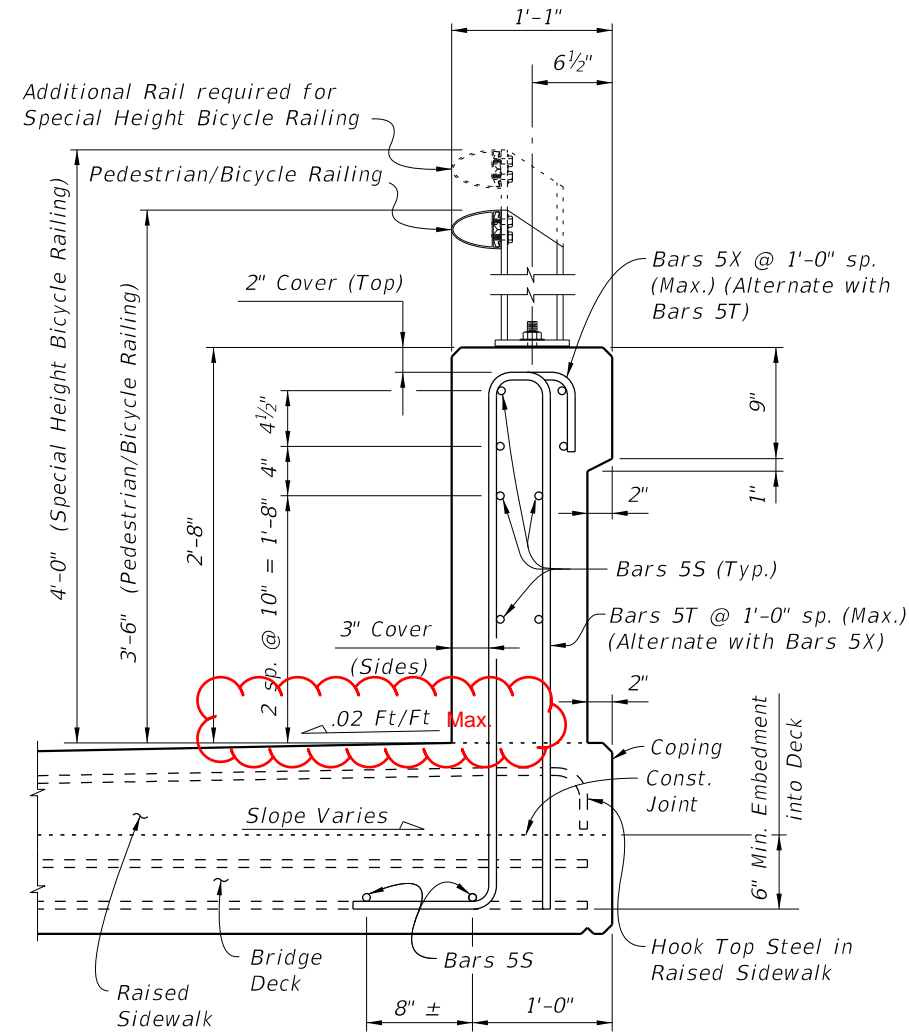


**SECTION A-A**  
TYPICAL SECTION THRU TRAFFIC RAILING  
(Section Thru Bridge Deck shown)

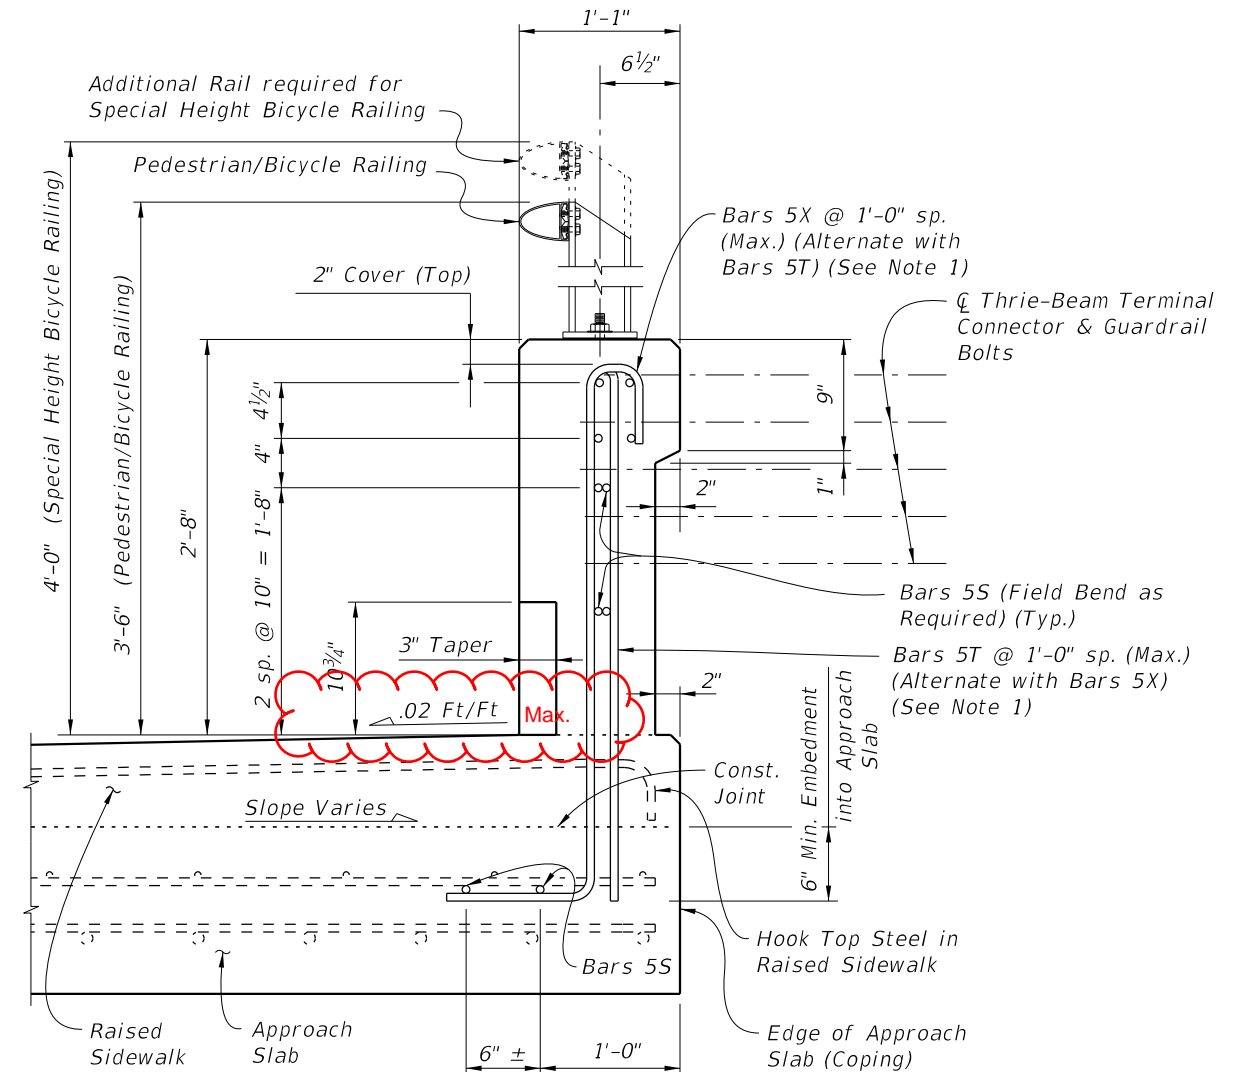

**VIEW B-B**  
APPROACH SLAB END VIEW  
OF TRAFFIC RAILING

**CROSS REFERENCE:**  
For location of Section A-A and View B-B  
see Sheet 1.

**NOTE:** For Bullet Railing Details,  
see Index 515-022.

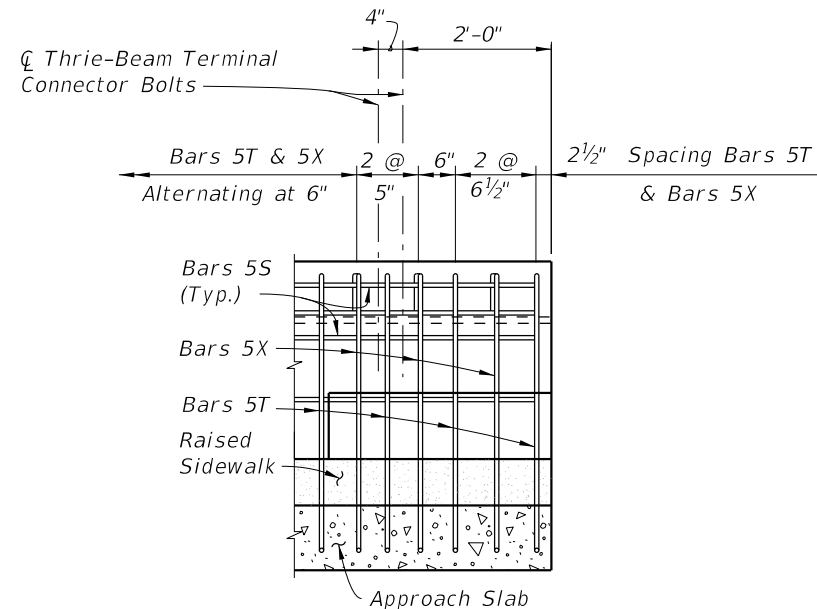

**RAILING END DETAIL**  
(Guardrail Not Shown For Clarity)

**NOTES:**

1. Begin placing Railing Bars 5T and 5X on Approach Slab at the railing end and proceed toward Begin or End Bridge to avoid conflict with guardrail bolt holes. If required, adjustments to the bar spacing for Bars 5T and 5X shall be made immediately adjacent to Begin or End Bridge. Cut, shift and rotate Bars 5T and 5X as required to maintain cover in Railing End Transition.
2. Omit Railing End Transition and Guardrail if Concrete Traffic Railing is used beyond the Approach Slab or Retaining Wall. See Structures Plans, Plan and Elevation Sheet and Roadway Plans. If Taper and Railing End Transition is omitted, extend Typical Section to end of the Approach Slab or limiting station on Retaining Wall, and space Bars 5T and 5X at 1'-0" (Typ.)


10/17/2024 10:29:14 AM

LAST REVISION	DESCRIPTION:	FDOT	FY <del>2025-26</del> 2026-27	STANDARD PLANS	TRAFFIC RAILING - (32" VERTICAL SHAPE)	INDEX	SHEET
11/01/17 11/01/25						521-423	2 of 3


## CONVENTIONAL REINFORCING STEEL BENDING DIAGRAMS

BILL OF REINFORCING STEEL		
MARK	SIZE	LENGTH
S	5	As Reqd.
T	5	9'-0"
X	5	5'-10"


ROADWAY CROSS-SLOPE	ØA	
	LOW GUTTER	HIGH GUTTER
0% to 2%	90°	90°
2% to 6%	87°	
6% to 10%	84°	

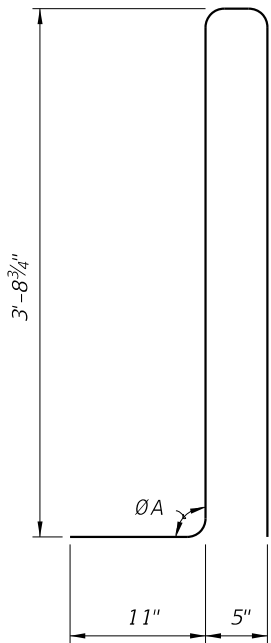

STIRRUP BAR 5T

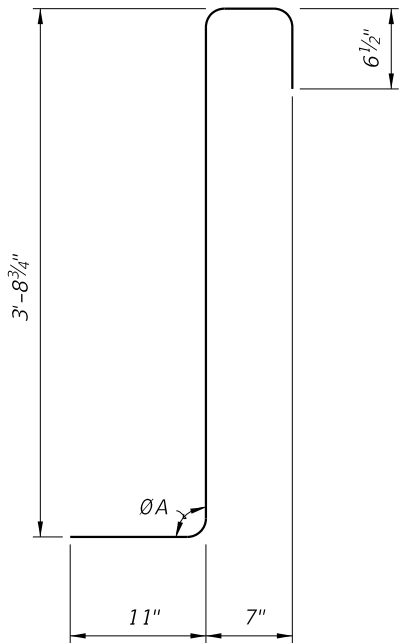


STIRRUP BAR 5X

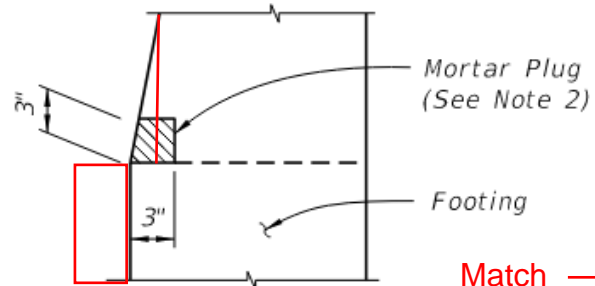

Option II  
~~DETAIL "A" -~~  
~~SECTION AT OPEN JOINT~~  
(Alternative Mortar Plug at  
Open Joint)

BAR 5S

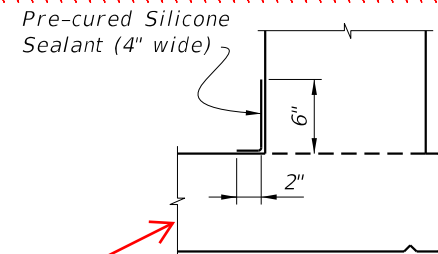


**Option I**  
~~DETAIL "A" - SECTION~~  
~~AT INTERMEDIATE OPEN JOINT~~

INTERMEDIATE JOINT SEAL NOTES:

1. *At Intermediate Open Joints, seal the lower 6" portion of the open joint with Pre-cured Silicone Sealant in accordance with Specification Section 932.*
2. *Apply sealant prior to any Class V finish coating and remove all curing compound and loose material from the surface prior to application of bonding agent.*
3. *The cost of the Pre-cured Silicone Sealant shall be included in the Contract Unit Price for the Traffic Railing.*

4. As an alternative option, a mortar plug may be used to seal the joint as shown in the mortar plug detail and in accordance with Specification Section 400.

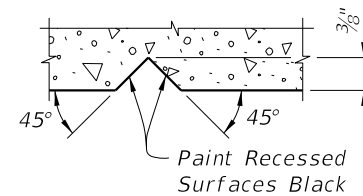

SECTION THRU RECESSED "V" GROOVE  
TO FORM INSCRIBED LETTERS AND FIGURES

### ESTIMATED TRAFFIC RAILING QUANTITIES

ITEM	UNIT	QUANTITY
Concrete	CY/LF	0.095
Reinforcing Steel	LB/LF	25.90

*(The above quantities are based on a 6" thick x 6' wide raised sidewalk at low side of deck, 2% deck cross slope and counter 2% sidewalk cross slope.)*

2026-27

~~FY 2025-26~~  
STANDARD PLANS

TRAFFIC RAILING - (32" VERTICAL SHAPE)

INDEX  
521-423


*SHEET*  
*3 of 3*

LAST	NC	DESCRIPTION:
------	----	--------------


LAST  
REVISION  
~~07/01/13~~  
11/01/25

REVISION

10/17/2024 10:29:21 AM

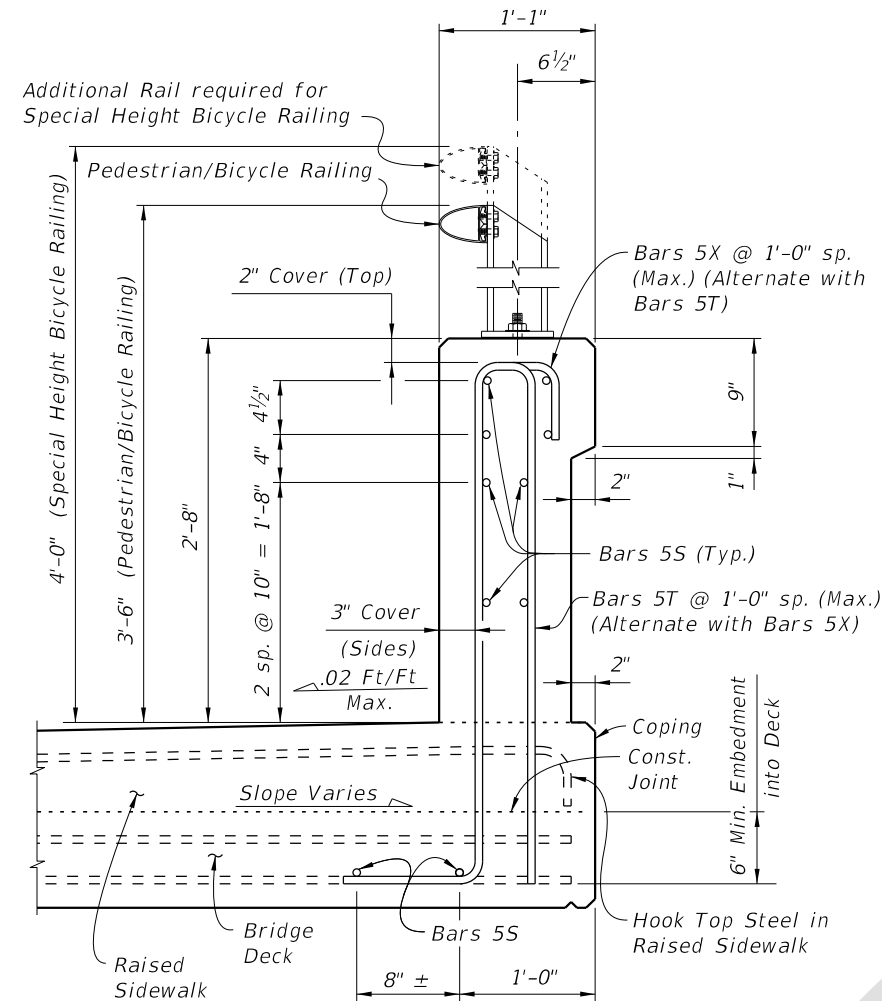


**SECTION A-A**  
TYPICAL SECTION THRU TRAFFIC RAILING  
(Section Thru Bridge Deck shown)

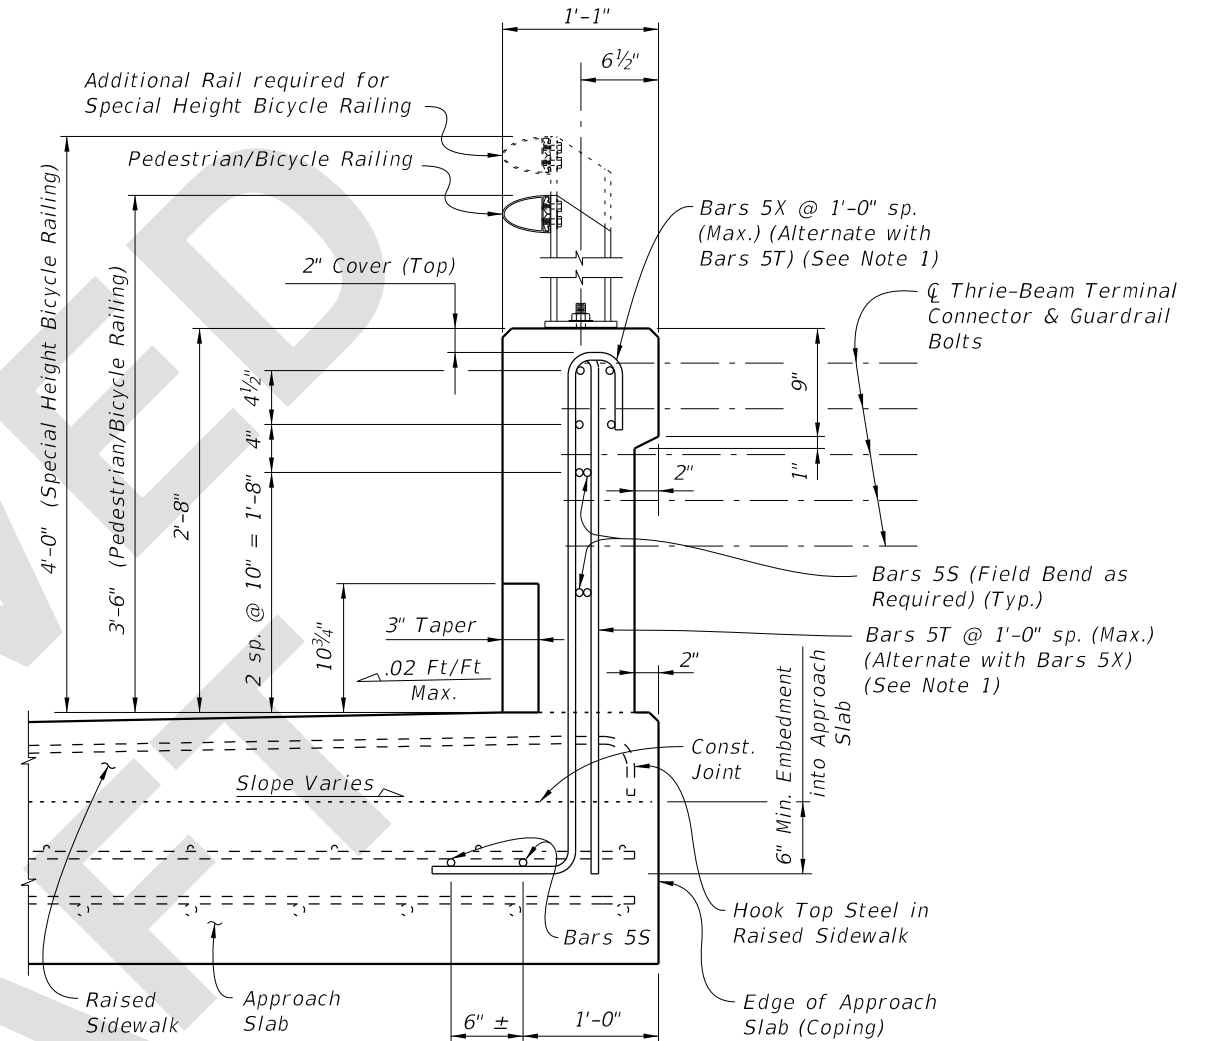

**VIEW B-B**  
APPROACH SLAB END VIEW  
OF TRAFFIC RAILING

**NOTES:**

1. Begin placing Railing Bars 5T and 5X on Approach Slab at the railing end and proceed toward Begin or End Bridge to avoid conflict with guardrail bolt holes. If required, adjustments to the bar spacing for Bars 5T and 5X shall be made immediately adjacent to Begin or End Bridge. Cut, shift and rotate Bars 5T and 5X as required to maintain cover in Railing End Transition.
2. Omit Railing End Transition and Guardrail if Concrete Traffic Railing is used beyond the Approach Slab or Retaining Wall. See Structures Plans, Plan and Elevation Sheet and Roadway Plans. If Taper and Railing End Transition is omitted, extend Typical Section to end of the Approach Slab or limiting station on Retaining Wall, and space Bars 5T and 5X at 1'-0" (Typ.)

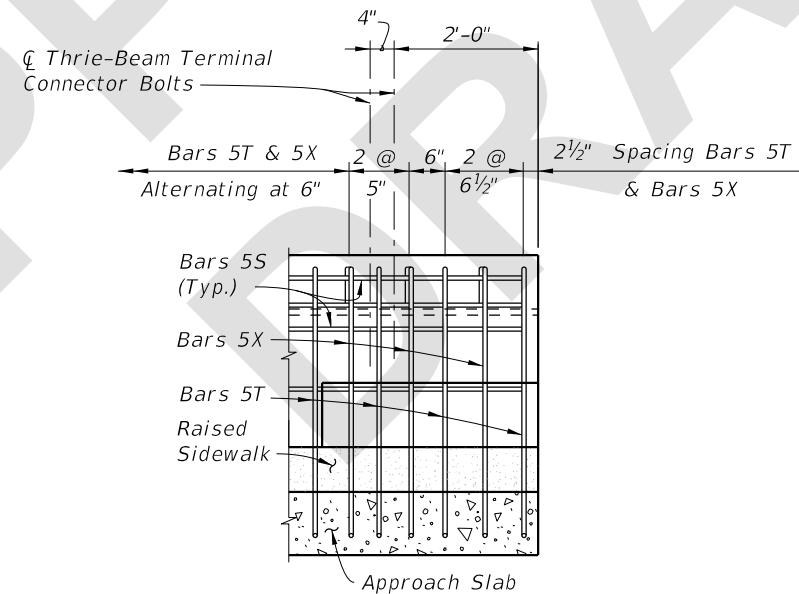

**RAILING END DETAIL**  
(Guardrail Not Shown For Clarity)

**CROSS REFERENCE:**

For location of Section A-A and View B-B see Sheet 1.

NOTE: For Bullet Railing Details, see Index 515-022.


1/10/2025 1:12:38 PM

LAST REVISION	DESCRIPTION:	FY 2026-27 STANDARD PLANS	TRAFFIC RAILING - (32" VERTICAL SHAPE)	INDEX	SHEET
11/01/25				521-423	2 of 3


## CONVENTIONAL REINFORCING STEEL BENDING DIAGRAMS

<i>BILL OF REINFORCING STEEL</i>		
<i>MARK</i>	<i>SIZE</i>	<i>LENGTH</i>
<i>S</i>	<i>5</i>	<i>As Req'd.</i>
<i>T</i>	<i>5</i>	<i>9'-0"</i>
<i>X</i>	<i>5</i>	<i>5'-10"</i>


ROADWAY CROSS-SLOPE	ØA	
	LOW GUTTER	HIGH GUTTER
0% to 2%	90°	90°
2% to 6%	87°	93°
6% to 10%	84°	96°

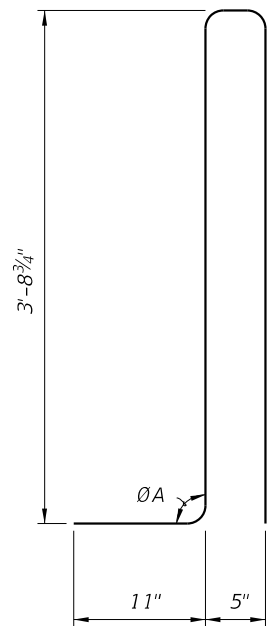

STIRRUP BAR 5T

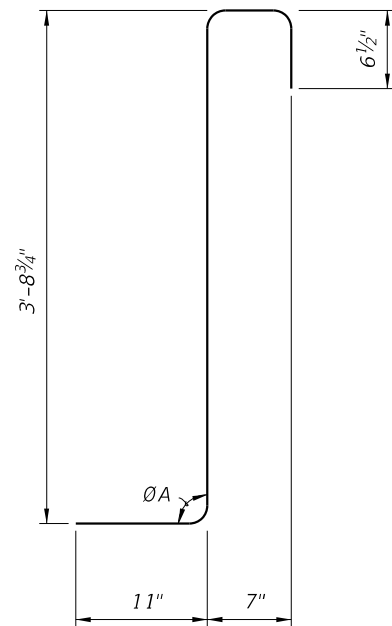

STIRRUP BAR 5X

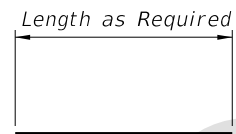


BAR 55

REINFORCING STEEL NOTES:


1. All bar dimensions in the bending diagrams are out to out.
2. The 3'-8 $\frac{3}{4}$ " vertical dimensions shown for Bars 5T and 5X are based on a bridge deck with a 6" thick x 6' wide raised sidewalk at low side of deck, 2% deck cross slope and a counter 2% raised sidewalk cross slope. If the raised sidewalk thickness, width or cross slopes vary from the above amounts, adjust these vertical dimensions accordingly to achieve a 6" minimum embedment into the bridge deck.
3. The reinforcement for the railing on a Retaining Wall shall be the same as detailed with  $\theta A = 90^\circ$ .
4. All reinforcing steel at the open joints shall have a 2" minimum cover.
5. Bars 5S may be continuous or spliced at the construction joints. Bar splices for Bars 5S shall be a minimum of 2'-2".
6. The Contractor may utilize Welded Wire Reinforcement (WWR) when approved by the Engineer. WWR must consist of Deformed wire meeting the requirements of Specification Section 931.

INTERMEDIATE JOINT SEAL NOTES:

1. *At Intermediate Open Joints, seal the lower 6" portion of the open joint with Pre-cured Silicone Sealant in accordance with Specification Section 932.*
2. *Apply sealant prior to any Class V finish coating and remove all curing compound and loose material from the surface prior to application of bonding agent.*
3. *The cost of the Pre-cured Silicone Sealant shall be included in the Contract Unit Price for the Traffic Railing.*
4. *As an alternative option, a mortar plug may be used to seal the joint as shown in the mortar plug detail and in accordance with Specification Section 400.*

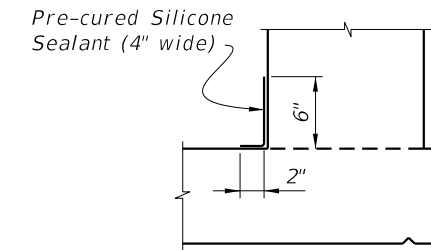


OPTION 1

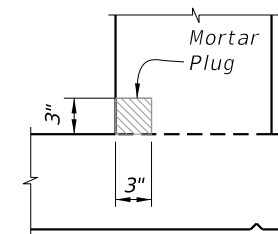

OPTION II

(Alternative Mortar Plug at Open Joint)

DETAIL "A"

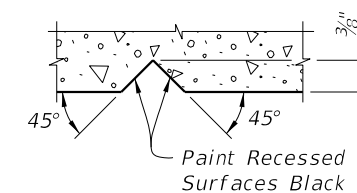

SECTION THRU RECESSED "V" GROOVE  
TO FORM INSCRIBED LETTERS AND FIGURES

ESTIMATED TRAFFIC RAILING QUANTITIES		
ITEM	UNIT	QUANTITY
Concrete	CY/LF	0.095
Reinforcing Steel	LB/LF	25.90

(The above quantities are based on a 6" thick x 6' wide raised sidewalk at low side of deck, 2% deck cross slope and counter 2% sidewalk cross slope.)