

Origination Form
Proposed Revisions to a Standard Plans Index

Originator:	Portal, Benazir	Index Number:	700-102
Date:	7/1/2025	Sheet Number(s):	ALL
E-mail:	Benazir.Portal@dot.state.fl.us	Index Title:	Special Sign Details

Summary of the changes:

ALL SHEETS: All FTP and MOT signs were renumbered by sign type and organized numerically; All MOT Signs were updated to TTC Signs

Sheet 1: NEW Cover Sheet with Table of Contents and General Notes

Sheet 2: Added NEW Fender Bender Signs

Sheet 3: Added NEW Emergency Stopping Site Signs

Sheet 5: Added NEW Crosswalk Signs

Sheet 6: Updated dimensions on Florida Law Sign

Sheet 7: Added NEW "X-ING", "ON SIDEWALK", and "MOTORCYCLES USE CAUTION" Signs

Sheet 8: Added NEW "PRESCRIBED BURN AHEAD" Signs

Sheet 12: Added NEW Share-A-Ride Signs, Added 2 additional sizes of signs for Emergency Info

Sheet 13: Added NEW Traffic Info Signs

Sheet 14: Added NEW Location Reference Marker Sign

Sheet 15: Removed line through FL symbol on Turnpike Signs

Sheet 17: Added NEW Guide Signs

Sheet 18: Added NEW Guide Signs

Sheet 19: Added NEW Recreational and Culture Signs

Sheet 21: Removed G20-1 and G20-2 Signs

Sheet 22: Added NEW "REDUCE SPEED SMOKE AHEAD" and "MOTORCYCLES USE CAUTION" Signs

Commentary/Background:

Updated naming convention for all signs. Changed all MOT signs to TTC signs. Worked details to clean up inconsistencies, add structure to sign assignment, and allow for an easier addition of new signs. The requested Index updates reflect consistency with MUTCD, TEM, Sign Library and Highway Signing Program.

MOT Signs G20-1 and G20-2 removed because they are already covered in the MUTCD.

Any Indexes with references to these FTP and MOT numbers have also been updated accordingly.

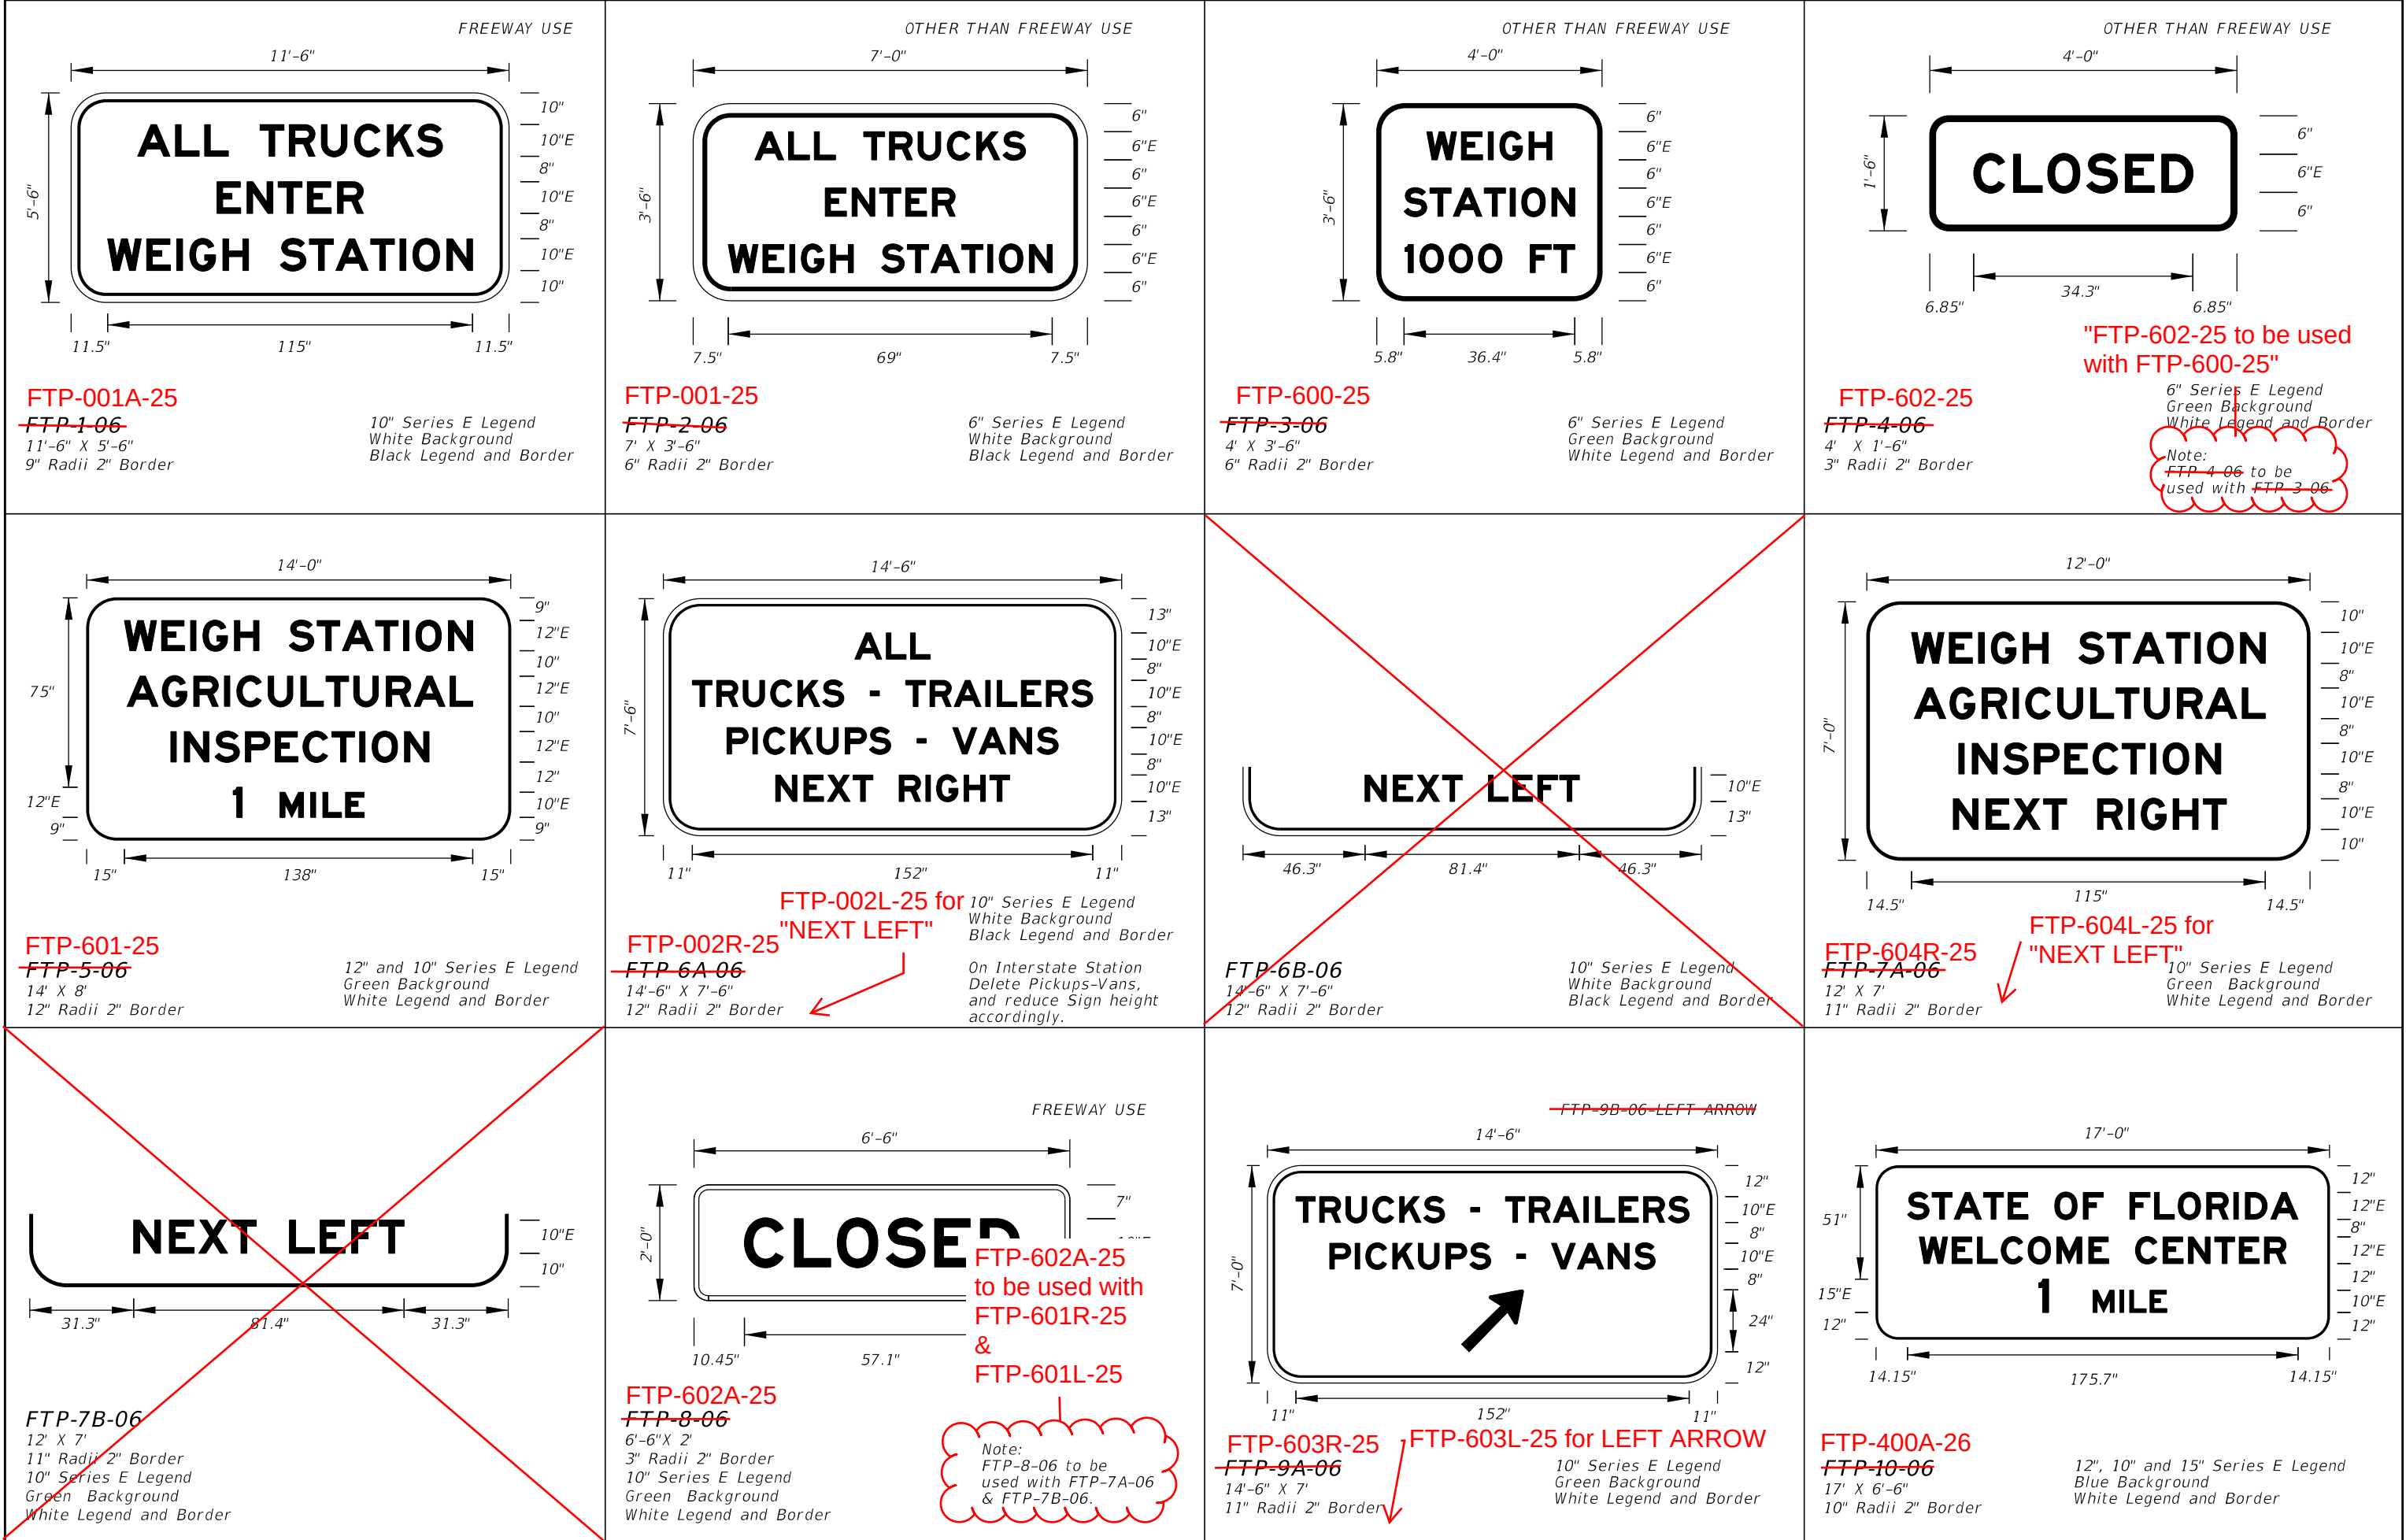
Other Affected Documents/Offices	Person Contacted	Affected (Yes/No)
Other Standard Plans	Rick Jenkins & Shae Gibbs	Yes
FDOT Design Manual	Mark Musselman	Yes
Standard Specifications	Daniel Strickland	No
Basis of Estimates Manual		No
Approved Product List		No

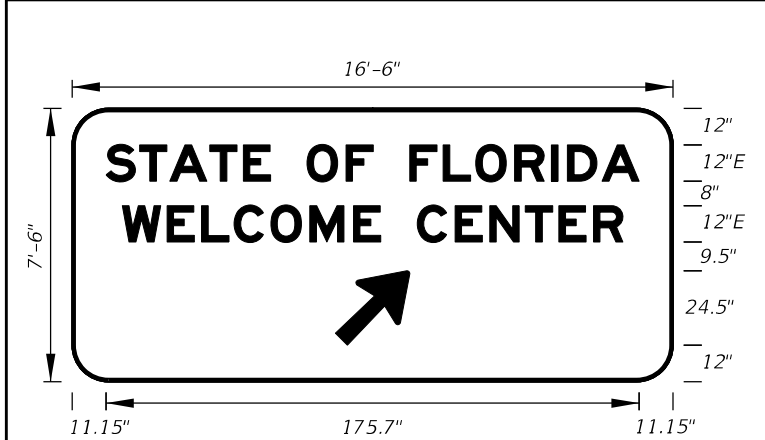
Construction Office	Ryan Buck	Yes
Maintenance Office		No
Implementation		
["FY-Standard Plans (Next Release)"]		

NEW Cover Sheet


ADDED: Table of Contents and
General Notes

REDEVELOPED: Renumbered Signs by
Sign Type and Organized Numerically






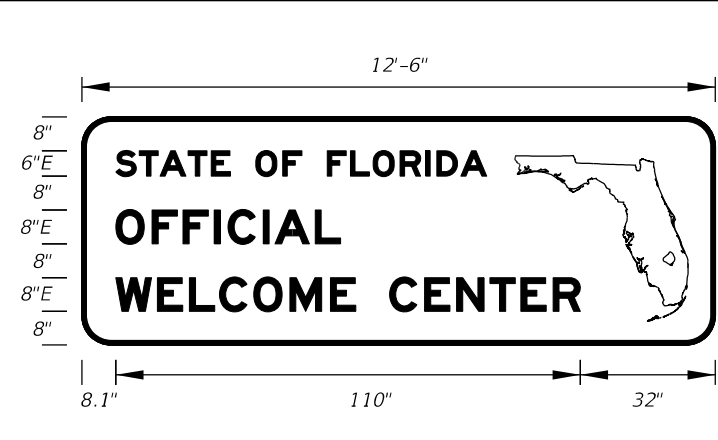
FTP-402A-25
~~FTP-11-06~~
16'-6" X 7'-6"
12" Radii 2" Border
12" Series E Legend
Blue Background
White Legend and Border



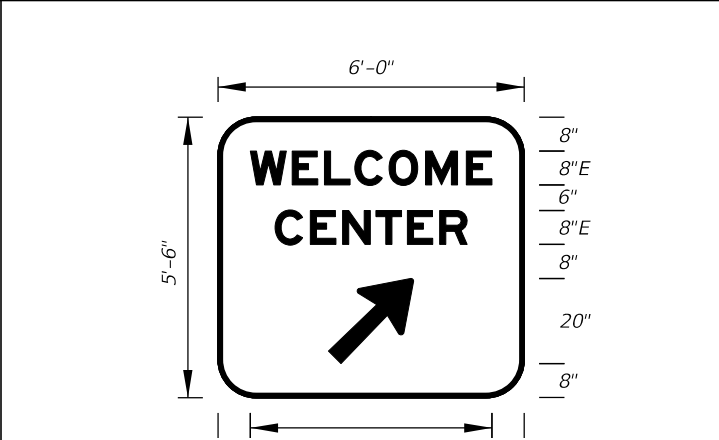
FTP-404-25
~~FTP-12-06~~
12'-6" X 4'-6"
7" Radii 2" Border
6" and 8" Series E Legend
Blue Background
White Legend and Border



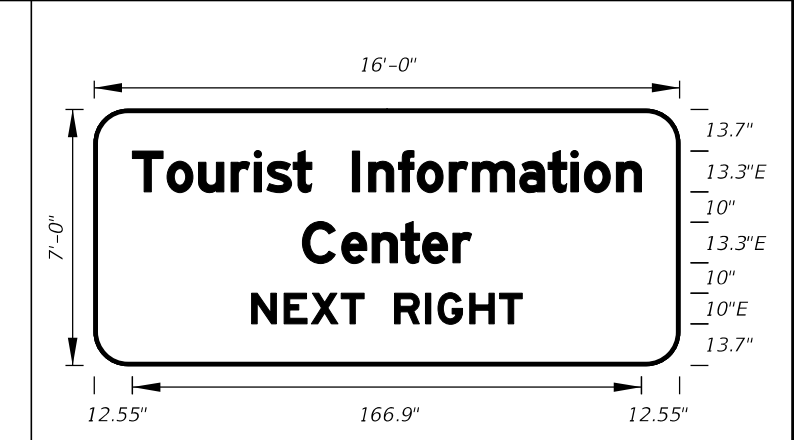
FTP-403-25
~~FTP-13-06~~
6' 0" X 5'-6"
9" Radii 2" Border
8" Series E Legend
Blue Background
White Legend and Border



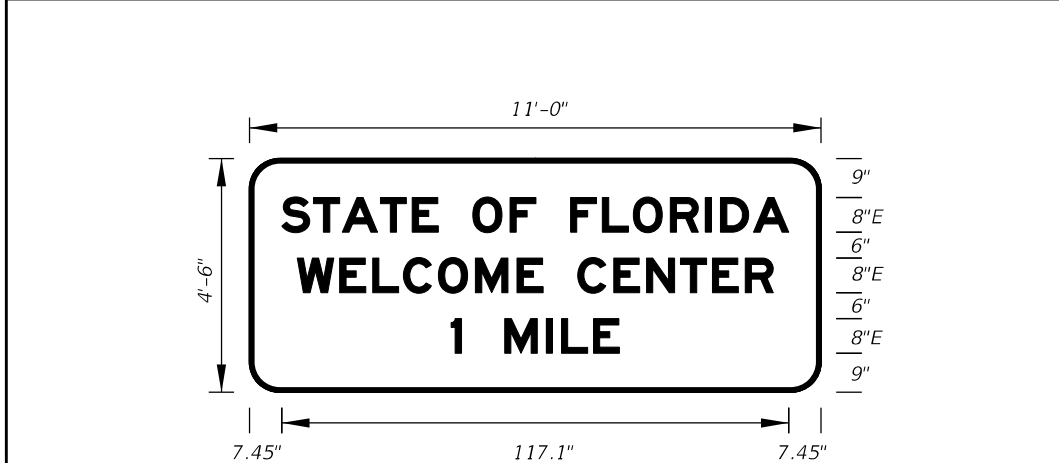
FTP-405-25
~~FTP-14-06~~
16'-0" X 7'-0"
11" Radii 2" Border
13.3 and 10" Series E Legend
Blue Background
White Legend and Border



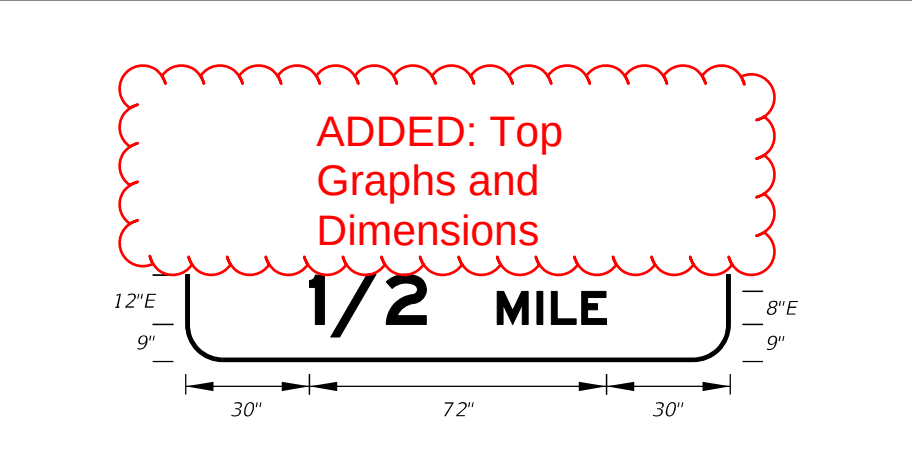
FTP-400-25
~~FTP-15A-06~~
11'-0" X 4'-6"
7" Radii 2" Border
8" Series E Legend
Blue Background
White Legend and Border



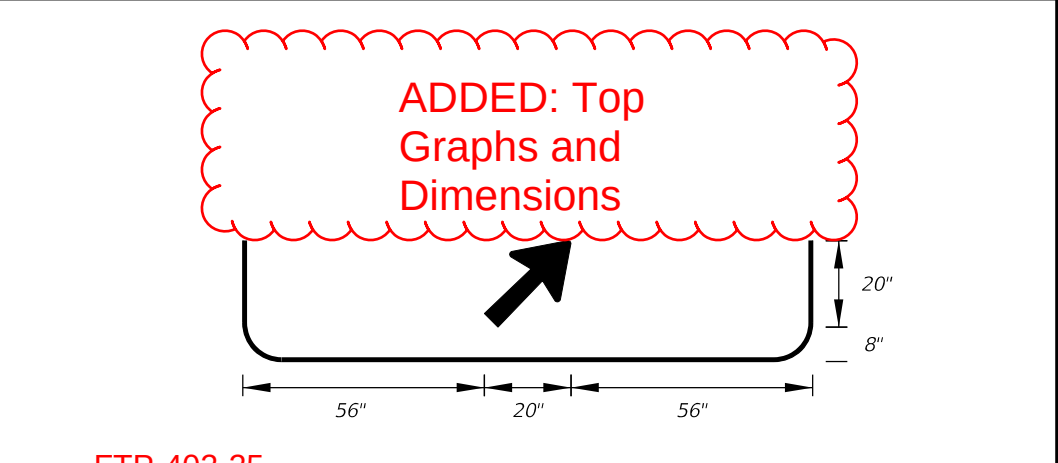
FTP-401-25
~~FTP-15B-06~~
11'-0" X 5'-6"
8" Radii 2" Border
8" and 12" Series E Legend
Blue Background
White Legend and Border



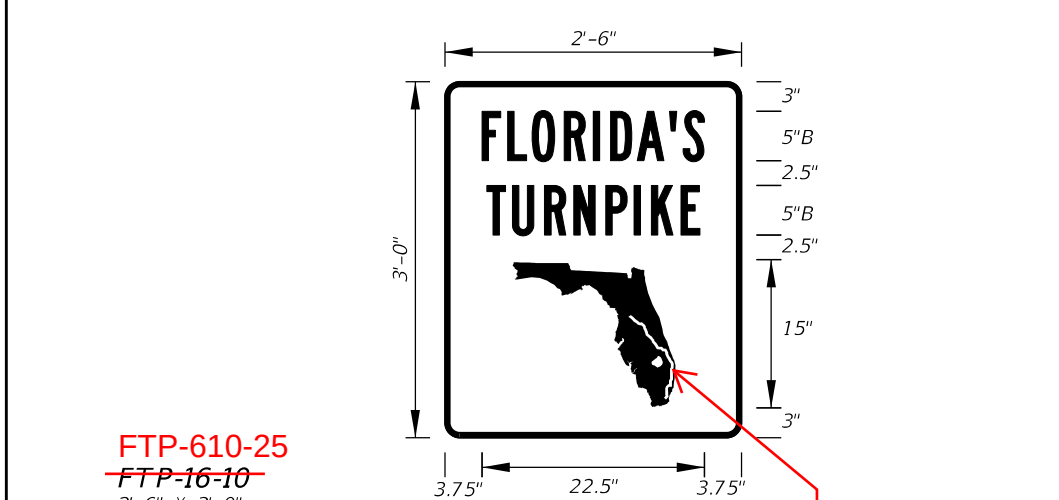
FTP-402-25
~~FTP-15C-06~~
11'-0" X 5'-6"
9" Radii 2" Border
8" Series E Legend
Blue Background
White Legend and Border



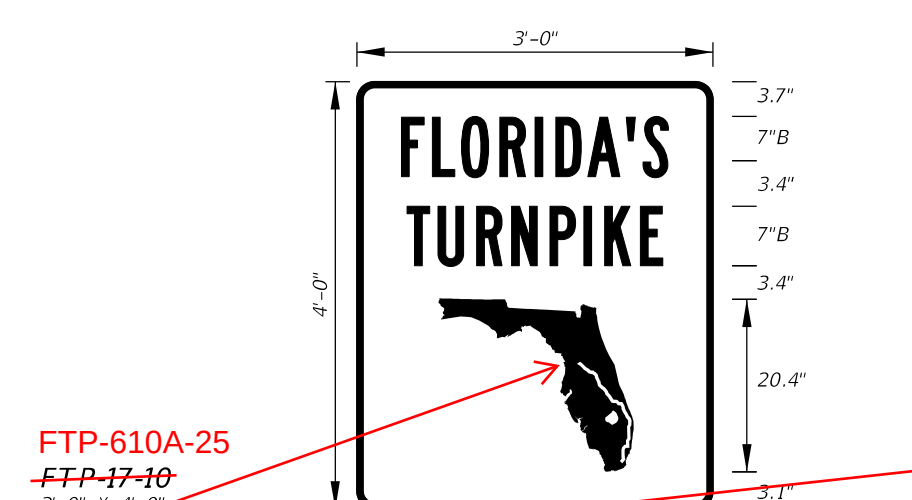
FTP-610-25
~~FTP-16-10~~
2'-6" X 3'-0"
1.5" Radii 3/4" Border
5" Series B Legend
Green Background
White Legend, Border, and Florida Symbol



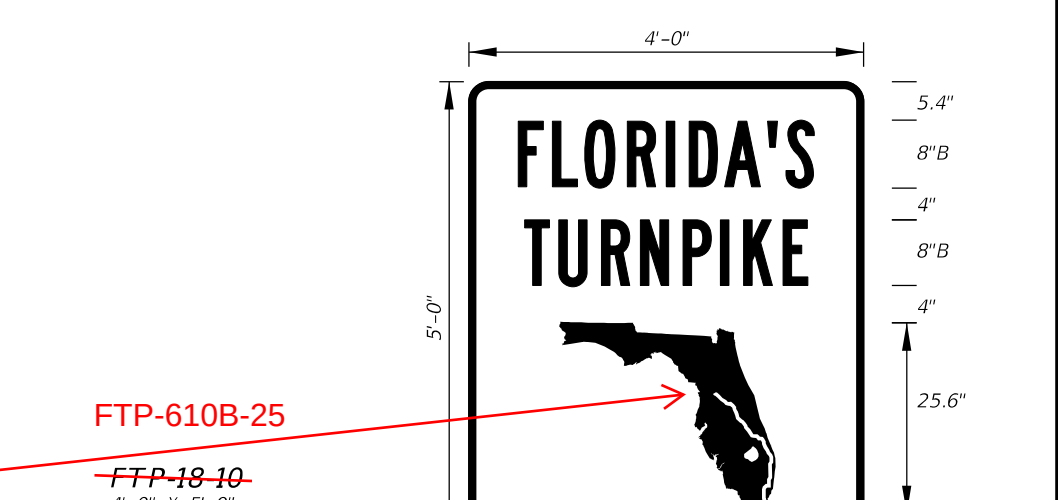FTP-610A-25
~~FTP-17-10~~
3'-0" X 4'-0"
1.5" Radii 3/4" Border
7" Series B Legend
Green Background
White Legend, Border, and Florida Symbol



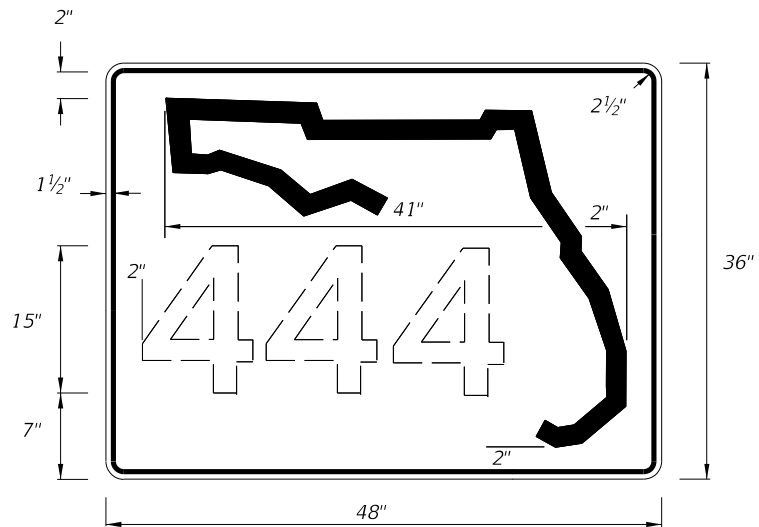
FTP-610B-25
~~FTP-18-10~~
4'-0" X 5'-0"
3" Radii 1 1/4" Border
8" Series B Legend
Green Background
White Legend, Border, and Florida Symbol




DIGITS	NUMERAL SIZE	SERIES LEGEND	PANEL SIZE
1-3	15"	C	48" x 36"
4	12"	C	48" x 36"

- NOTES:
- Stroke width of State Outline shall be 1".
 - 2 1/2" Radii

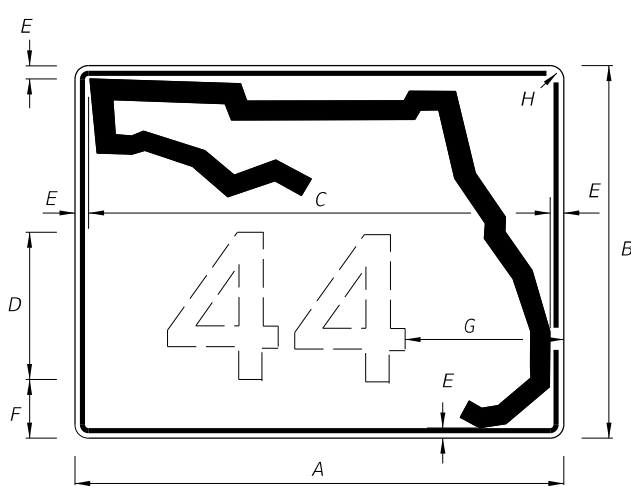INDEPENDENT USE FOR FREEWAY



1 OR 2 DIGITS

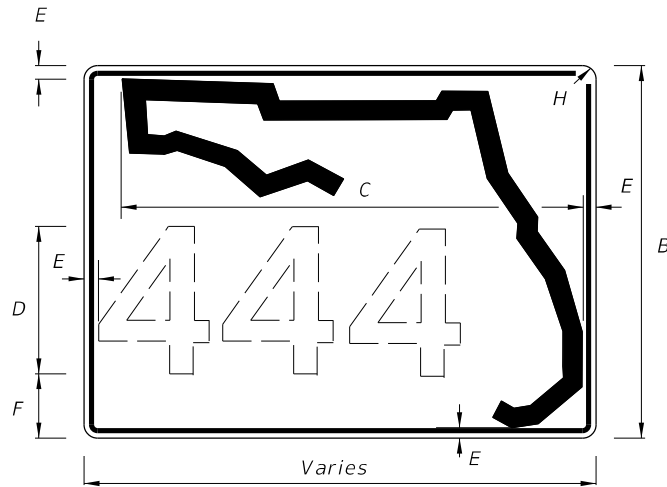


3 OR MORE DIGITS

- NOTES:
- Florida marker shall have Black Legend with White Background.
 - Stroke width of State outline shall be 3/4" for Guide Sign.
 - Series D Legend.
 - 5/8" Border

A	B	C	D	E	F	G	H
30"	24"	26"	12"	1 1/4"	2 3/4"	8 1/4"	1 1/4"
36"	30"	32"	15"	1 1/4"	3 1/4"	8 3/4"	1 1/4"
42"	36"	38"	15"	1 1/4"	6 1/4"	11"	1 1/4"


FTP-612-25 GUIDE SIGN USE

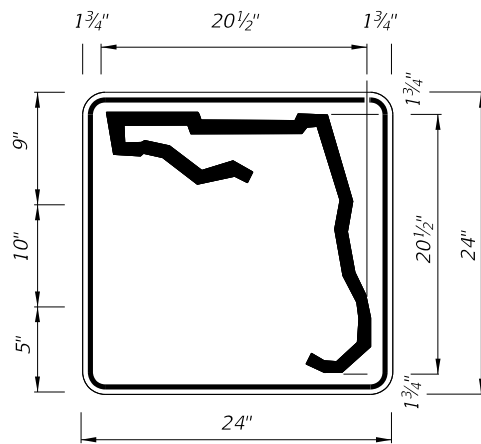~~FTP-17-06~~ - FLORIDA ROUTE MARKER



1 or 2 DIGITS

DIGITS	NUMERAL SIZE	SERIES LEGEND	PANEL SIZE
1-2	10"	D	24" x 24"

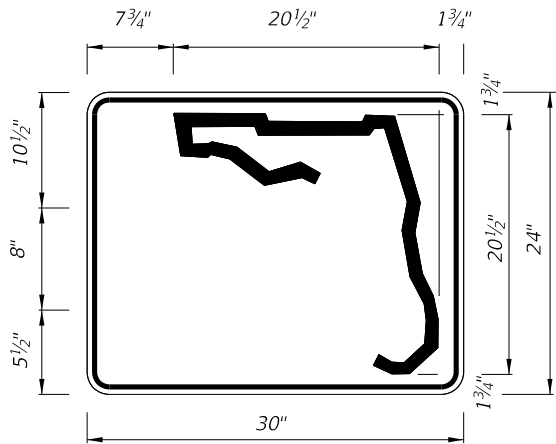


3 or 4 DIGITS

DIGITS	NUMERAL SIZE	SERIES LEGEND	PANEL SIZE
3	8"	D	30" x 24"
4	8"	C	30" x 24"

- NOTES:
- Stroke width of State Outline shall be 1".
 - The 24" X 24" panel shall only be used for a 3 digit route when the panel is to be used on a sign cluster with other 24" X 24" panels.
 - 1 1/2" Radii

INDEPENDENT USE OTHER THAN FREEWAY

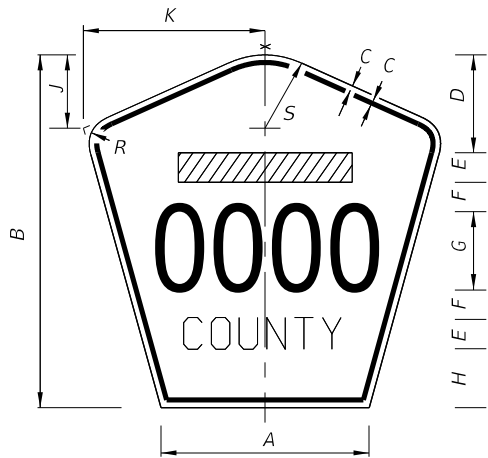
- NOTES:
- Series D Legend.
 - Color: Yellow Legend and Border on Blue Background.
 - When used on a guide sign, marker must be overlaid on a rectangular Yellow Background as shown in chart.
 - When two or more County Route Markers are mounted together, use the dimensions of the largest marker for all other markers.




SIGN	DIMENSIONS												Rectangular Yellow Background Dimensions (See Note 3)
	A	B	C	D	E	F	G	H	J	K	R	S	
4 DIGIT POST MOUNTED	25 1/8"	42"	3/4"	10"	4"	4"	8"	8"	8 3/8"	22"	5"	8 3/4"	
2 DIGIT OVERHEAD	21 1/2"	36"	1/2"	7 1/2"	3"	3"	12"	4 1/2"	7 1/8"	18 1/8"	4 1/4"	7 1/2"	42"x 42"
3 DIGIT OVERHEAD	25 1/8"	42"	3/4"	8"	4"	4"	12"	6"	8 3/8"	22"	5"	8 3/4"	48"x 48"
4 DIGIT OVERHEAD	29 7/8"	48"	3/4"	8"	5"	5"	12"	8"	9 3/4"	25 5/8"	5 3/4"	10 1/4"	52"x 52"

FTP-613-25

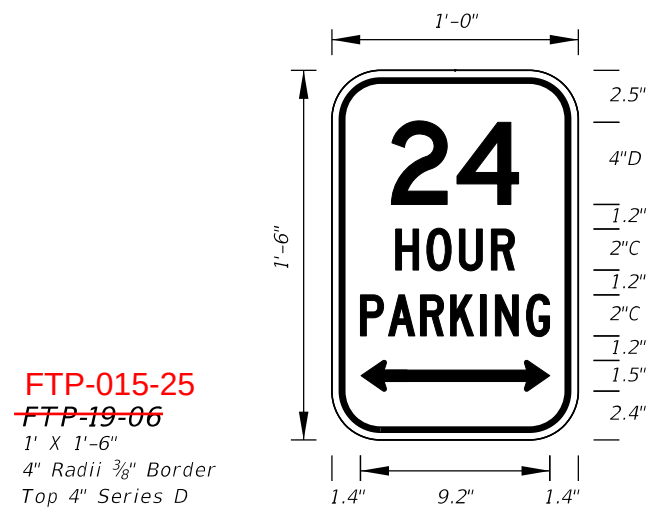~~FTP-18-06~~ - COUNTY ROUTE MARKER (M1-6)



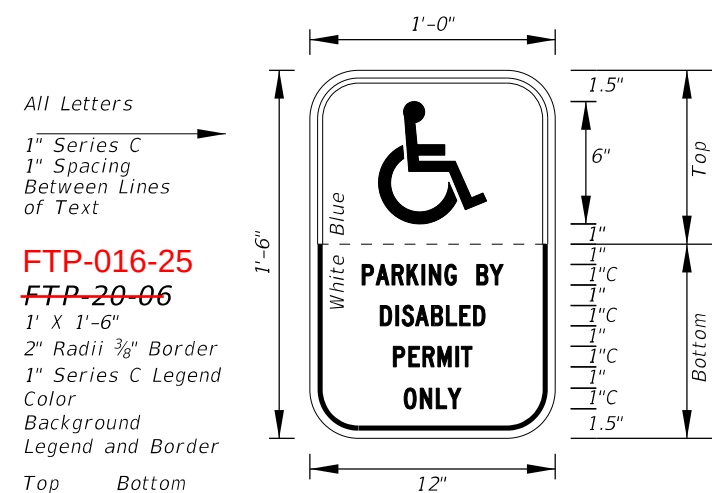
4" Radii $\frac{3}{8}$ " Border
Top 4" Series D
Bottom 2" Series C
White Background
Green Legend and Border



FTP-016-25
~~FTP-20-06~~
1' X 1'-6"
2" Radii $\frac{3}{8}$ " Border
1" Series C Legend
Color
Background
Legend and Border

Top	Bottom
Blue	White
White	Black



Top	Bottom
Blue	White
White	Black

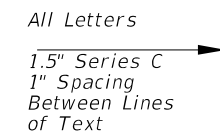

FTP-017-25
~~FTP-21-06~~
1'-6" X 2'-6"
2" Radii $\frac{3}{8}$ " Border
1.5" Series C Legend
Color
Background
Legend and Border


<i>Top</i>	<i>Bottom</i>
<i>Blue</i>	<i>White</i>
<i>White</i>	<i>Black</i>

<i>Top</i>	<i>Bottom</i>
<i>Blue</i>	<i>White</i>
<i>White</i>	<i>Black</i>

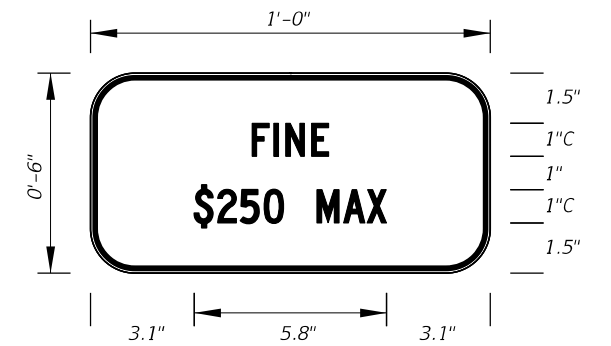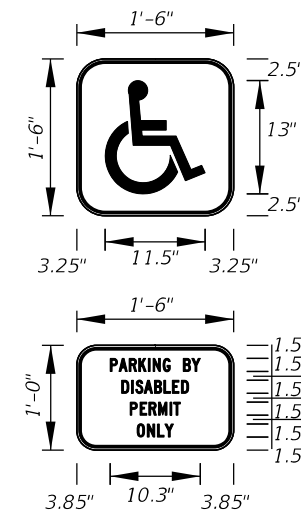

FTP-018-25
~~**FTP-22-06**~~
1' X 6"
1" Radii $\frac{3}{8}$ " Border
1" Series C Legend
White Background
Black Legend and Border

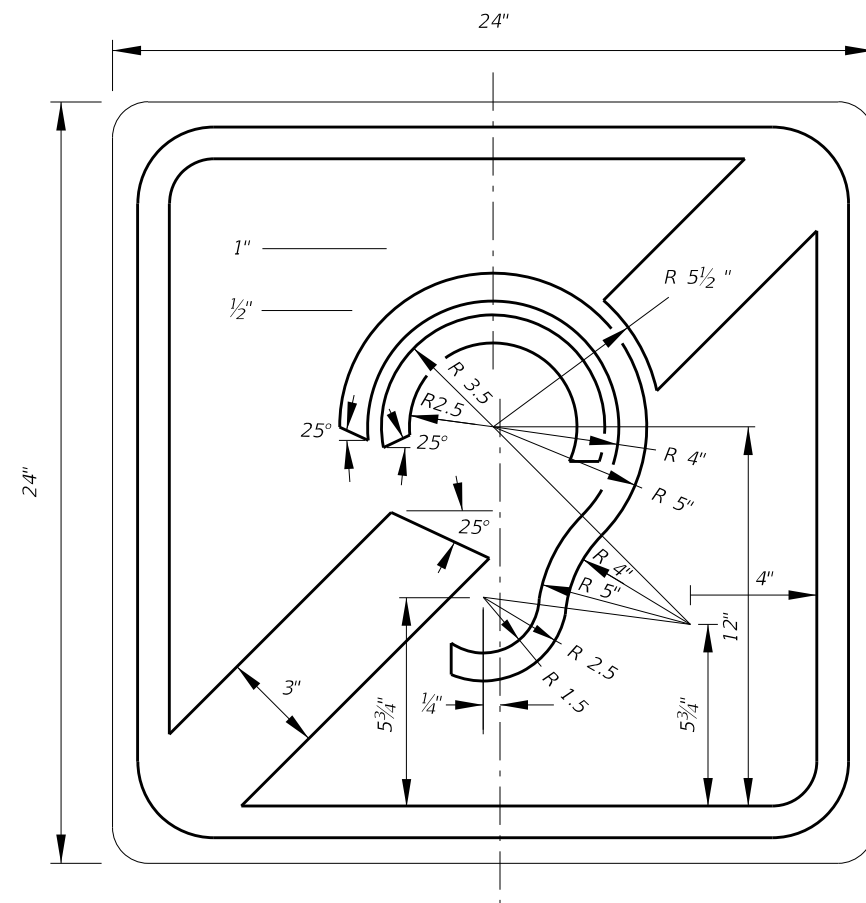
Supplemental Panel
for the FTP-20-06
and FTP-21-06 signs



FTP-416-25
~~FTP-23-06~~
2' X 2'
1.5" Radii 5/8" Border
Blue Background
White Legend and Border

1.5" Radii $\frac{5}{8}$ " Border
Blue Background
White Legend and Border

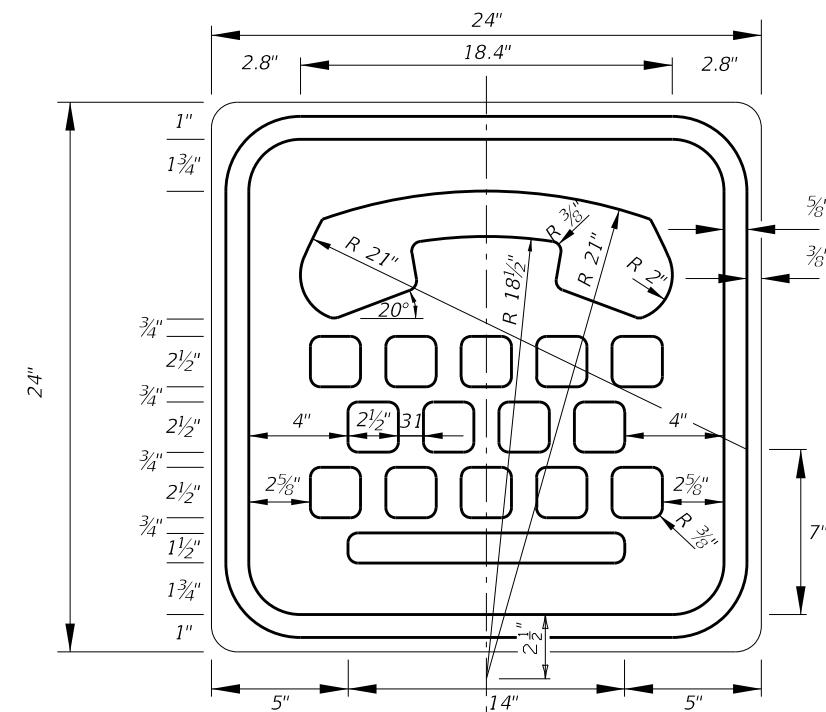INTERNATIONAL SYMBOL OF
ACCESS FOR HEARING LOSS













INTERNATIONAL TDD SYMBOL

FTP-417-25
~~FTP-24-06~~
2' X 2'
1.5" Radii $\frac{5}{8}$ " Border
Blue Background
White Legend and Border

1.5" Radii $\frac{5}{8}$ " Border
Blue Background
White Legend and Border

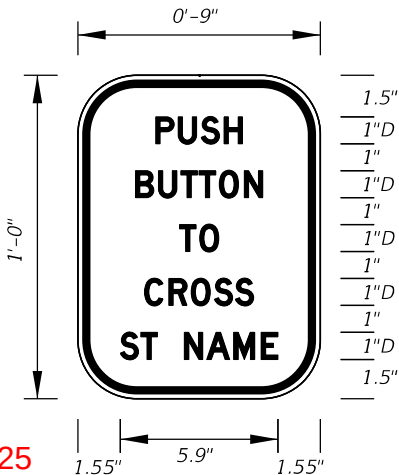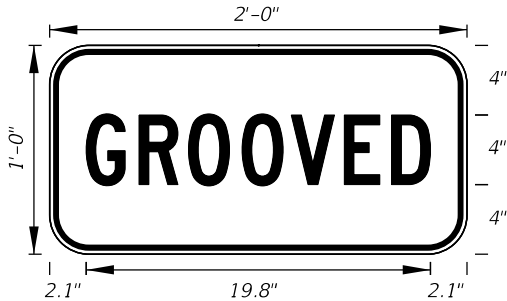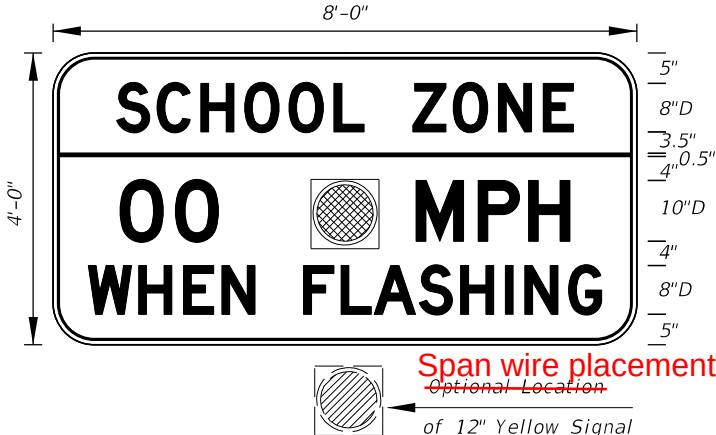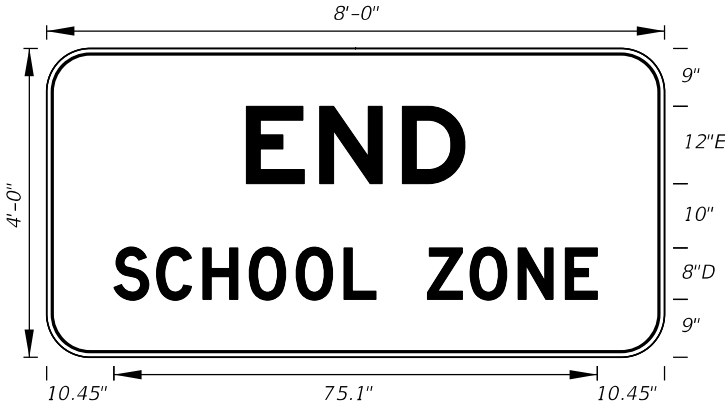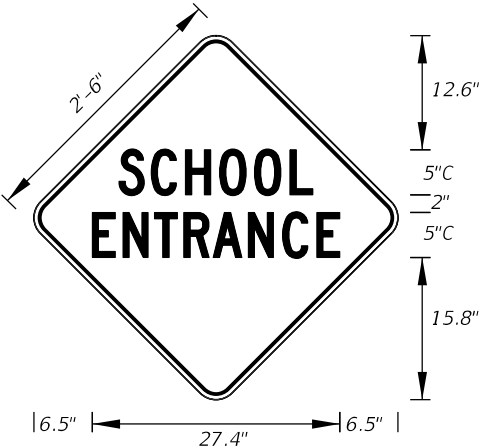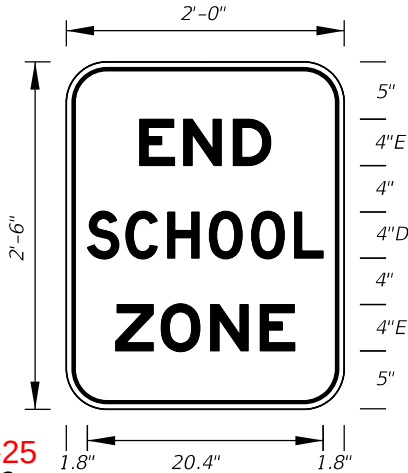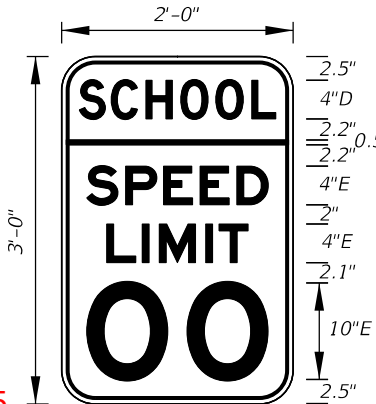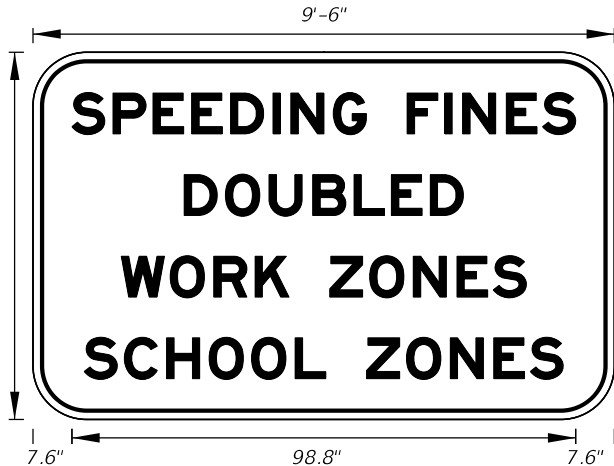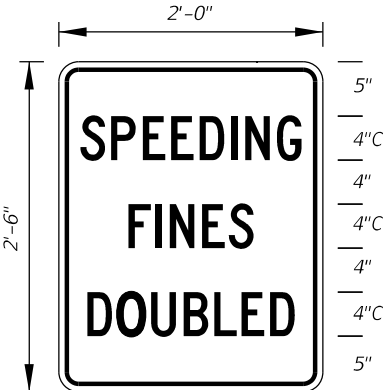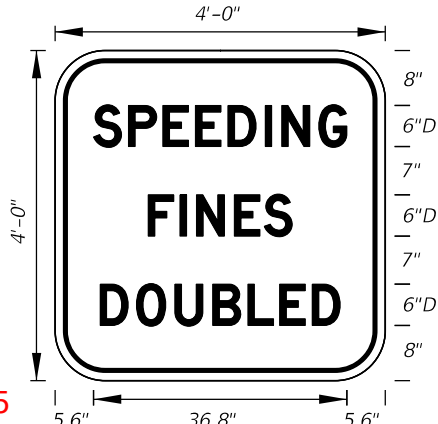9/10/2024 2:49:56 PM

 FTP-033-25 FTP-25-06 9" X 1'-0" 2" Radii $\frac{3}{8}$" Border 1" Series D Legend White Background Black Legend and Border		 FTP-013-25 FTP-29-06 2'-0" X 1'-0" 2" Radii $\frac{5}{8}$" Border 4" Series C Legend Yellow Background Black Legend and Border		 FTP-022-25 FTP-31-06 8' X 4' 6" Radii $\frac{3}{4}$" Border Series D Legend Fluorescent Yellow-Green Background Top White Background Bottom Black Legend and Border		 FTP-023A-25 FTP-32-06 8' X 4' 6" Radii $\frac{3}{4}$" Border 12" Series E and 8" Series D Legend White Background Black Legend and Border			
 FTP-201-25 FTP-33-06 2'-6" X 2'-6" 2" Radii $\frac{3}{4}$" Border 5" Series C Legend Fluorescent Yellow-Green Background Black Legend and Border		 FTP-023-25 FTP-34-06 2' X 2'-6" 3" Radii $\frac{5}{8}$" Border Top 4" Series D Legend Bottom 4" and 10" Series E Legend Fluorescent Yellow-Green Background Top White Background Bottom Black Legend and Border		 FTP-021-25 FTP-35-06 2' X 3' 3" Radii $\frac{5}{8}$" Border Top 4" Series D Legend Bottom 4" and 10" Series E Legend Fluorescent Yellow-Green Background Top White Background Bottom Black Legend and Border		 FTP-606-25 FTP-36-06 3' X 3' 5" Radii 4" Series D Legend Green Background White Legend and Border			
 FTP-019-25 FTP-37-06 9'-6" X 6' 9" Radii 2" Border 8" Series E Legend White Background Black Legend and Border State Line Sign		 FTP-020-25 FTP-38-22 2' X 2'-6" 1.5" Radii $\frac{1}{2}$" Border 4" Series C Legend 80% Spacing White Background Black Legend and Border		 FTP-020A-25 FTP-39-06 4' X 4' 6" Radii $\frac{3}{4}$" Border 6" Series D Legend White Background Black Legend and Border Freeway Sign		 FTP-014A-25 FTP-40-21 3'-6" X 4' 6" Radii $\frac{3}{4}$" Border 3" and 6" Series C Legend White Background Black Legend and Border			
LAST REVISION 11/01/25		DESCRIPTION:		FY 2025-26 2026-27 STANDARD PLANS		SPECIAL SIGN DETAILS		INDEX 700-102	SHEET 5 of 12

9/10/2024 2:50:06 PM

FTP-014-25
~~FTP-41-21~~

2" and 4" Series C Legend
White Background
Black Legend and Border

FTP-803-25
~~FTP-42-06~~

4" X 2'-6"
3" Radii
Top 4" Series C Legend
Bottom 2" Series EM Legend
White Background
Blue Legend and Border

FTP-413-25
~~FTP-43-06~~

4' X 4'
6" Radii 1" Border
Top 4" Series D Legend
Bottom 6" Series D Legend
Blue Background
White Legend and Border

FTP-004A-25
~~FTP-44-06~~

9' X 6'
9" Radii ¾" Border
8" Series D Legend
White Background
Black Legend and Border

FTP-004-25
~~FTP-44A-25~~

4' X 3'
5" Radii ¾" Border
4" Series C Legend
White Background
Black Legend and Border

~~FTP-45-25~~ **FTP-006-25**

4'-0" X 4'-0"
1.5" Radii
0.4" Border
2.5" Series C Legend
2" Series C Legend
1.5" Series C Legend and White Background
Black Legend and Border

FTP-005A-25
~~FTP-46-06~~

3' X 4'
5" Radii ¾" Border
3" Series D Legend
White Background
Green Florida Symbol
Black Legend, Border and Man Belt Symbol

FTP-005-25
~~FTP-47-06~~

2' X 2'-6"
3" Radii 5/8" Border
2" Series D Legend
White Background
Green Florida Symbol
Black Legend, Border and Man Belt Symbol

FTP-607-25
~~FTP-48-06~~

3'-6" X 5'
6" Radii
4" Series C Legend
Green Background
White Legend, Border and Symbol

FTP-608-25
~~FTP-49-06~~

3'-6" X 5'-6"
6" Radii
4" Series C Legend
Green Background
Municipality Name Optional
White Legend, Border and Symbol

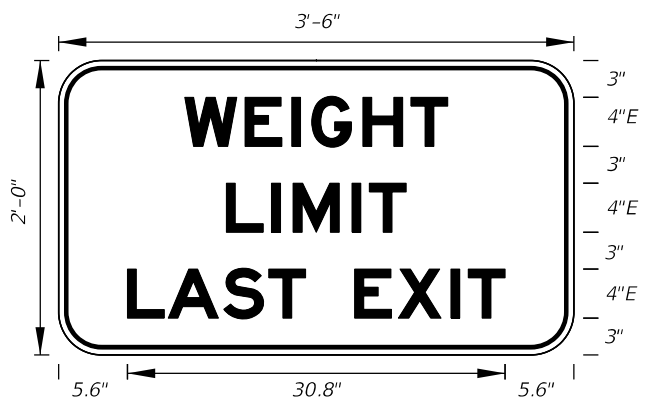
FTP-607-25 **FTP-608-25**

Detail for ~~FTP-48-06~~ and ~~FTP-49-06~~

~~FTP-50-06~~ **FTP-200-25**

4'-6" X 2'
3" Radii ¾" Border
4" Series C Legend
Yellow Background
Black Legend and Border

9/10/2024 2:50:13 PM



3'-6"

2'-0"

3"

4"E

3"

4"E

3"

4"E

3"

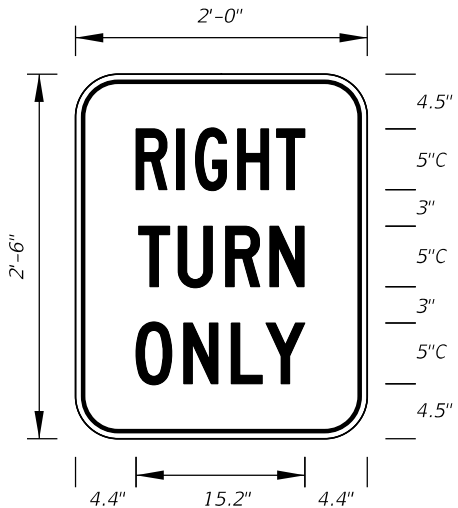
5.6"

30.8"

5.6"

FTP-003-25
~~FTP-51-06~~
3' X 2'
3" Radii 3/4" Border

4" Series E Legend
White Background
Black Legend and Border



2'-0"

2'-6"

4.5"

5"C

3"

5"C

3"

5"C

3"

5"C

4.5"

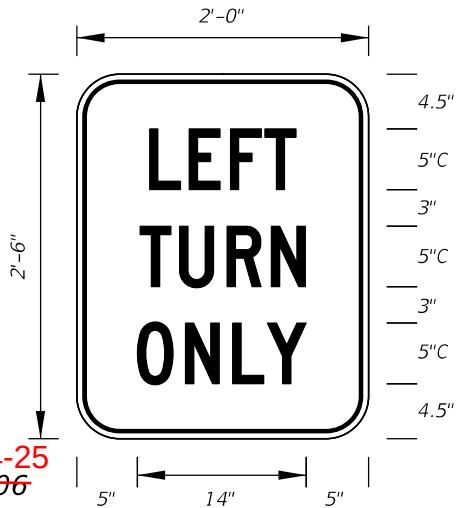
4.4"

15.2"

4.4"

FTP-043-25
~~FTP-52-06~~
2' X 2'-6"
3" Radii 5/8" Border

5" Series C Legend
White Background
Black Legend and Border



2'-0"

2'-6"

4.5"

5"C

3"

5"C

3"

5"C

3"

5"C

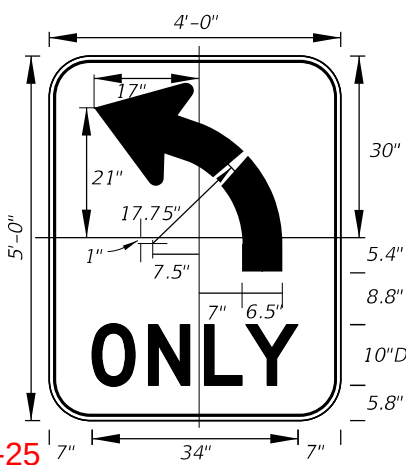
4.5"

5"

14"

5"

FTP-044-25
~~FTP-53-06~~
2' X 2'-6"
3" Radii 5/8" Border
5" Series C Legend
White Background
Black Legend and Border



4'-0"

5'-0"

30"

5.4"

8.8"

10"D

5.8"

7"

34"

7"

17"

21"

17.75"

1"

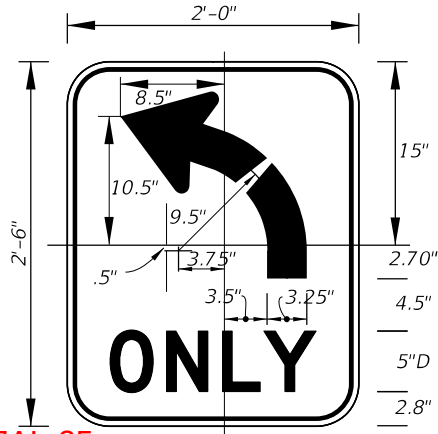
7.5"

7"

6.5"

FTP-037L-25
~~FTP-54L-06~~
4' X 5'
6" Radii 3/4" Border
10" Series D Legend
White Background
Black Legend and Border

FTP-037R-25
~~FTP-54R-06~~ for
(Right Turn Arrow)



2'-0"

2'-6"

15"

2.70"

4.5"

5"D

2.8"

3.5"

17"

3.5"

8.5"

10.5"

9.5"

3.75"

.5"

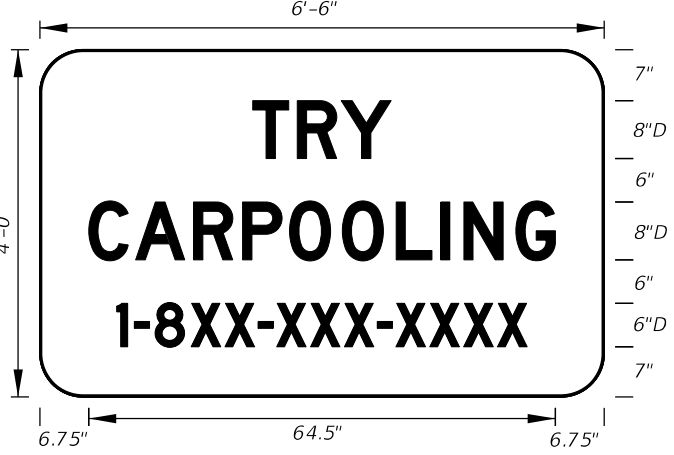
3.5"

3.25"

FTP-037AL-25
~~FTP-55L-06~~
2' X 2'-6"
3" Radii 3/8" Border
5" Series D Legend
White Background
Black Legend and Border

FTP-037A-R-25
~~FTP-55R-06~~ for
(Right Turn Arrow)

FTP-037A-U-25 for (U-Turn Arrow)



6'-6"

4'-0"

7"

8"D

6"

8"D

6"

6"D

7"

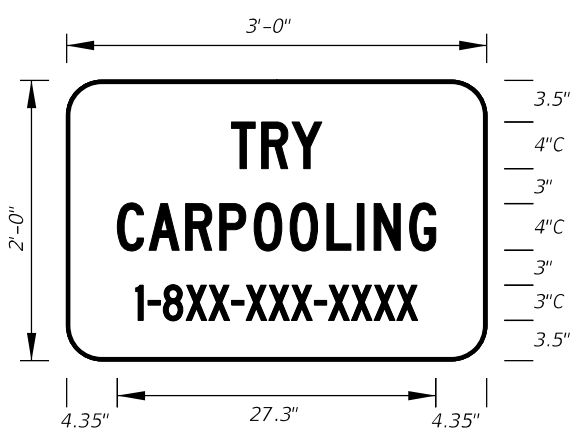
6.75"

64.5"

6.75"

~~FTP-56-06~~ **FTP-418A-25**
6'-6" X 4'
6" Radii 3/4" Border
8" and 6" Series D Legend
Blue Background
White Legend and Border

Design Project Manager
or Transit Administrator
will supply correct 1-8XX
number.



3'-0"

2'-0"

3.5"

4"C

3"

4"C

3"

3"C

3.5"

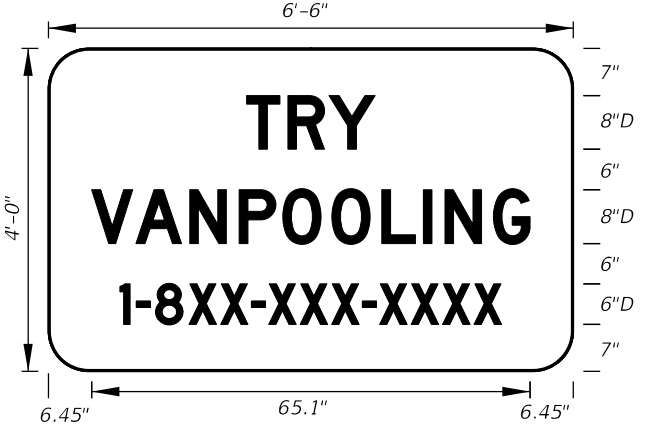
4.35"

27.3"

4.35"

~~FTP-56A-06~~ **FTP-418-25**
3' X 2'
3" Radii
4" and 3" Series C Legend
Blue Background
White Legend and Border

Design Project Manager
or Transit Administrator
will supply correct 1-8XX
number.



6'-6"

4'-0"

7"

8"D

6"

8"D

6"

6"D

7"

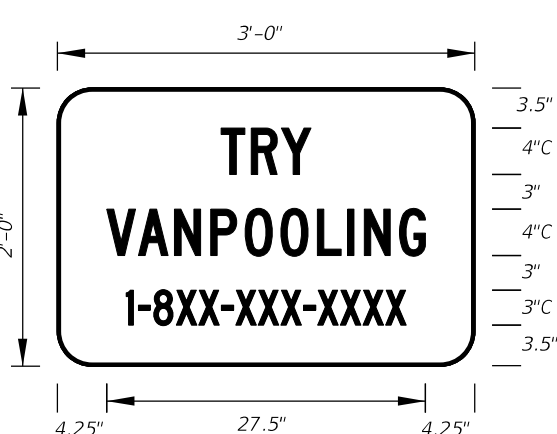
6.45"

65.1"

6.45"

~~FTP-57-06~~ **FTP-419A-25**
6'-6" X 4'
6" Radii
8" and 6" Series D Legend
Blue Background
White Legend and Border

Design Project Manager
or Transit Administrator
will supply correct 1-8XX
number.



3'-0"

2'-0"

3.5"

4"C

3"

4"C

3"

3"C

3.5"

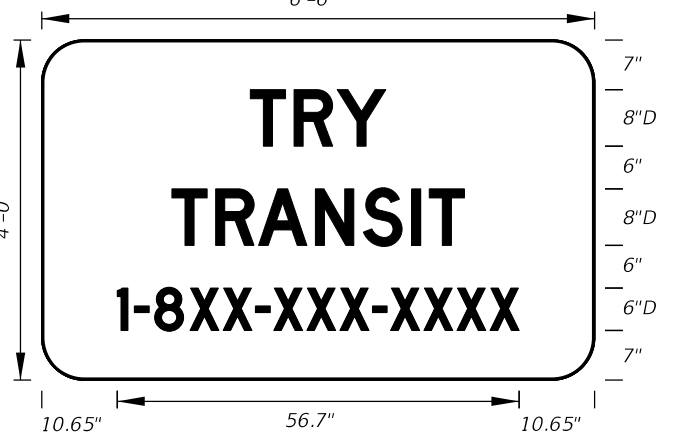
4.25"

27.5"

4.25"

~~FTP-58-06~~ **FTP-419-25**
3' X 2'
3" Radii
4" and 3" Series C Legend
Blue Background
White Legend and Border

Design Project Manager
or Transit Administrator
will supply correct 1-8XX
number.



6'-6"

4'-0"

7"

8"D

6"

8"D

6"

6"D

7"

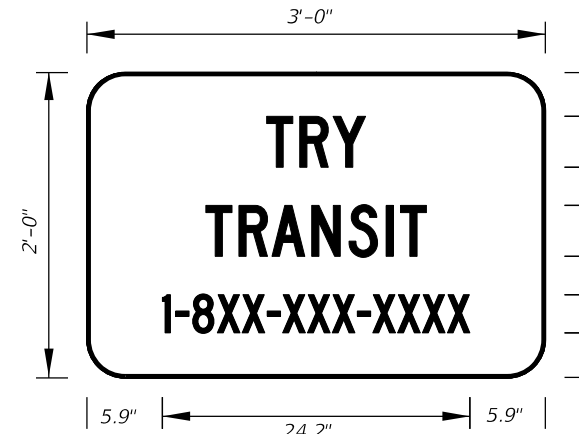
10.65"

56.7"

10.65"

~~FTP-59-06~~ **FTP-420A-25**
6'-6" X 4'
6" Radii
8" and 6" Series D Legend
Blue Background
White Legend and Border

Design Project Manager
or Transit Administrator
will supply correct 1-8XX
number.



3'-0"

2'-0"

3.5"

4"C

3"

4"C

3"

3"C

3.5"

5.9"

24.2"

5.9"

~~FTP-60-06~~ **FTP-420-25**
3' X 2'
3" Radii
4" and 3" Series C Legend
Blue Background
White Legend and Border

Design Project Manager
or Transit Administrator
will supply correct 1-8XX
number.



3'-0"

2'-0"

4.5"

4"C

2"

4"C

2"

3"C

4.5"

4.3"

27.4"

4.3"

~~FTP-61-06~~ **FTP-203-25**
3' X 2'
3" Radii 3/4" Border
4" and 3" Series C Legend
Yellow Background
Black Legend and Border



FTP-203A-25
~~FTP-62-06~~
3' X 3'
2" Radii 3/4" Border 4" and 5" Series C Legend
Yellow Background Black Legend and Border



FTP-012-25
~~FTP-65-06~~
3' X 1'-6"
2" Radii 3/4" Border
4" Series D Legend
White Background
Black Legend and Border



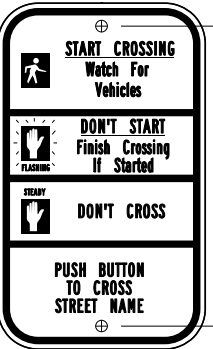
FTP-414-25
~~FTP-66-21~~
4' X 5'
3" Radii 1" Border
6" Series D Legend
Blue Background
White Legend and Border



FTP-414A-25
~~FTP-67-21~~
5.5' X 6'
3" Radii 1" Border
8" Series D Legend
Blue Background
White Legend and Border




FTP-414-25 FTP-414A-25
DETAIL for ~~FTP-66~~ AND ~~FTP-67~~



FTP-034-25
~~FTP-68A-06~~
9" X 1'-3"
1.5" Radii 3/4" Border
Series B Legend
White Background
Black Legend and Border

Sign Mounting Holes Can Be Punched Or Field Drilled With No Obstruction To Text Or Symbols From Holes Or Bolts.

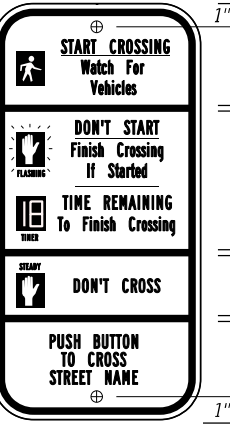See MUTCD R10-3f for Letter Size, Spacing, and Symbol Sizes and Color



FTP-035-25
~~FTP-68B-06~~
9" X 1'-6"
1.5" Radii 3/4" Border
Series B Legend
White Background
Black Legend and Border

Sign Mounting Holes Can Be Punched Or Field Drilled With No Obstruction To Text Or Symbols From Holes Or Bolts.

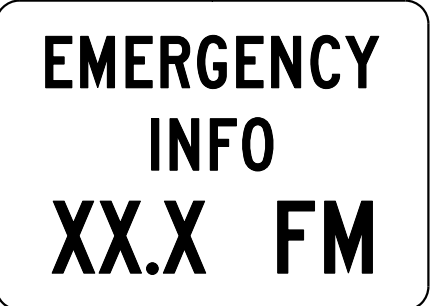
See MUTCD R10-3i for Letter Size, Spacing, and Symbol Sizes and Color



FTP-036-25
~~FTP-68C-21~~
9" X 1'-6"
1.5" Radii 1/4" Border
Series D Legend
White Background
Black Legend and Border



FTP-69-06
2'-6" X 2'-6"
4" Radii 3/4" Border
2" and 3" Series D Legend
White Background
Black Legend and Border



FTP-422B-25
~~FTP-70-06~~
3'-6" X 2'-6"
2.25" Radii 3/4" Border
5" Series C and 7" Series C Legend
Blue Background
White Legend and Border



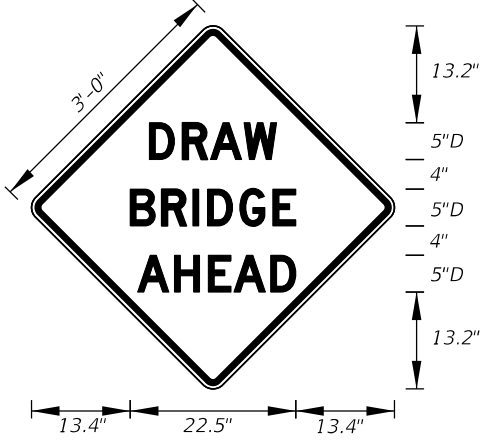
FTP-208A-25
~~FTP-71-06~~
4' X 4'
2" Radii 3/4" Border
8" Series C Legend
Yellow Background
Black Legend and Border



FTP-208-25
~~FTP-72-06~~
3' X 3'
2" Radii 3/4" Border
6" Series C Legend
Yellow Background
Black Legend and Border

NEW Sheet 13 of 22:

ADDED NEW Traffic Info Tune
Radio Signs



3'-0"

13.2"

5"D

4"

5"D

4"

5"D

13.2"

13.4"

22.5"

13.4"

FTP-202-25

~~FTP-84-09~~

3' X 3'
1.5" Radii

5" Series D Legend
Yellow Background
Black Legend and
Border



2'-6"

3'-0"

3.75"

3.5" C

2.75"

3.5" C

2.75"

3.5" C

2.75"

3.5" C

2.75"

3.5" C

3.75"

23.18"

FTP-026-25

~~FTP-85-13~~

2'-6" X 3'
1.875" Radii ¾" Border

3.5" Series C Legend
White Background
Black Legend and Border



STATE
LAW

STOP

FOR

WITHIN
CROSSWALK

9"

1'-6"

1.5" D

0.5"

1.5" D

0.6"

0.7"

0.7"

1.3" C

0.5"

1.2" C

0.5"

FTP-032-25

~~FTP-86-21~~

9' X 2'-3"
1.5" Radii No Border

Series C Legend and
Series D Legend
White on Yellow
Black Legend and Border



15'-6"

8'-6"

9"

12"EM

9"

12"EM

9"

22"

8"

12"D

9"

15.5"

155"

15.5"

FTP-406-25

~~FTP-87-21~~

15'-6" X 8'-6"
12" Radii 2" Border

Series D Legend
Series EM Legend
Blue Background
White Legend and Border



15'-6"

8'-6"

9"

12"EM

9"

12"EM

9"

22"

8"

12"D

9"

15.5"

155"

15.5"

FTP-407-25

~~FTP-88-21~~

15'-6" X 8'-6"
12" Radii 2" Border

Series D Legend
Series EM Legend
Blue Background
White Legend and Border



16'-6"

8'-6"

9"

12"EM

9"

12"EM

9"

22"

8"

12"D

9"

16.7"

164.6"

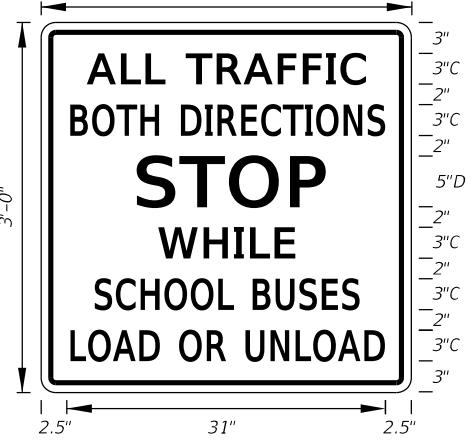
16.7"

FTP-408-25

~~FTP-89-21~~

16'-6" X 8'-6"
12" Radii 2" Border

Series D Legend
Series EM Legend
Blue Background
White Legend and Border



3'-0"

3'-0"

3"

3"C

2"

3"C

2"

5"D

2"

3"C

2"

3"C

2"

3"C

2"

3"

2.5"

31"

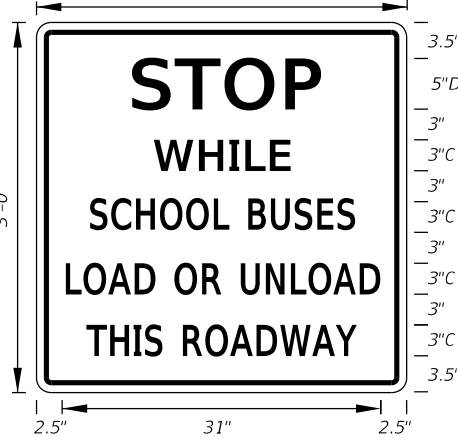
2.5"

FTP-024-25

~~FTP-90-22~~

3'-0" X 3'-0"
1.5" Radii ¾" Border

3" Series C Legend and
5" Series D Legend
White Background
Black Legend and Border



3'-0"

3'-0"

3.5"

5"D

3"

3"C

3"

3"C

3"

3"C

3"

3"C

3"

3.5"

2.5"

31"

2.5"

FTP-025-25

~~FTP-91-22~~

3'-0" X 3'-0"
1.5" Radii ¾" Border

3" Series C Legend and
5" Series D Legend
White Background
Black Legend and Border



2'-0"

6"

1.5"

3"

1.5"

1.6"

1.28"

2"

6"

1.6"

FTP-040-25

~~FTP-100-25~~

2'-0" X 6"
1.5" Radii
0.4" Border
0.4" Indent

3" Series C Legend and
Bright Yellow Green Background
Black Legend and Border

NEW Sheet 17 of 22:

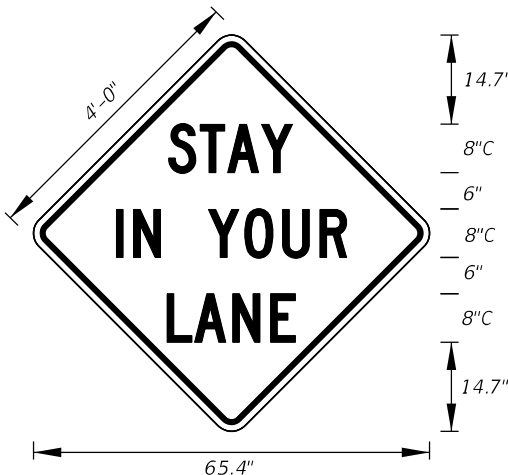
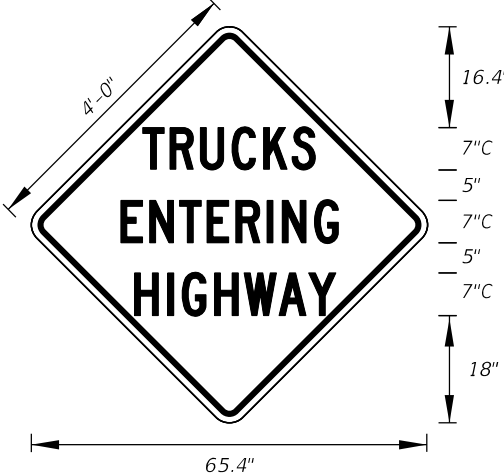
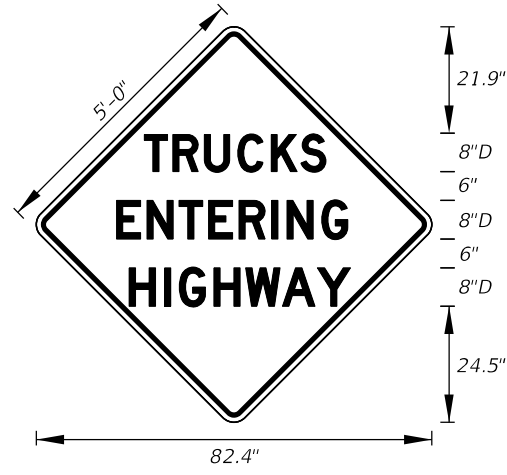
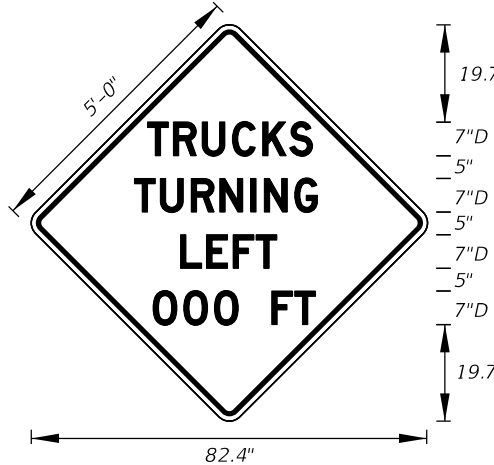
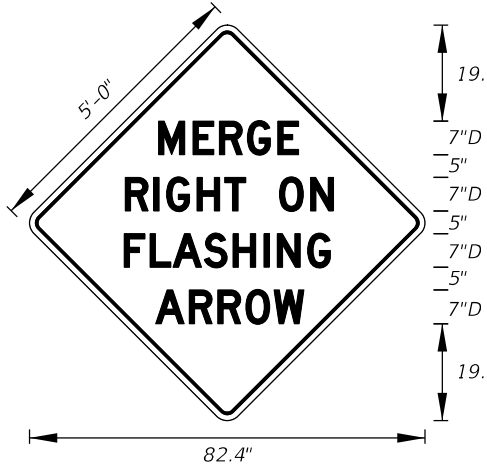
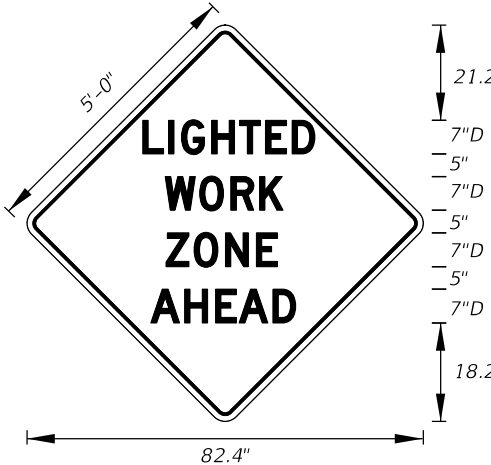
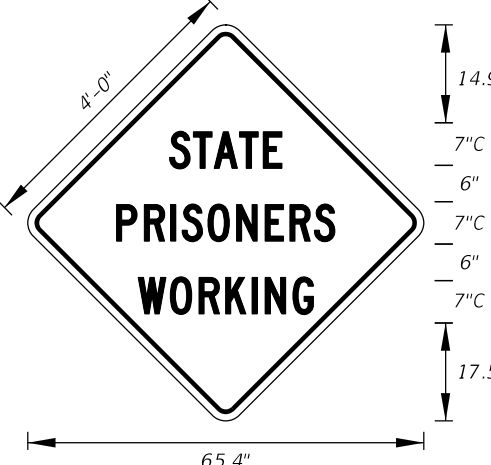
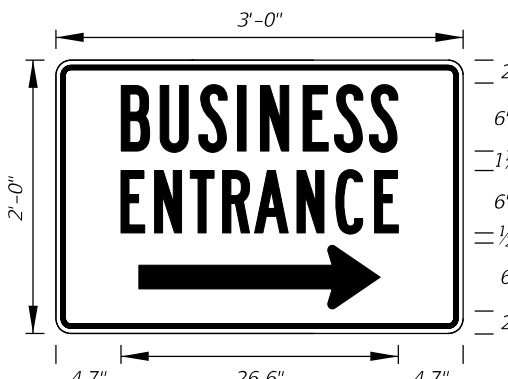
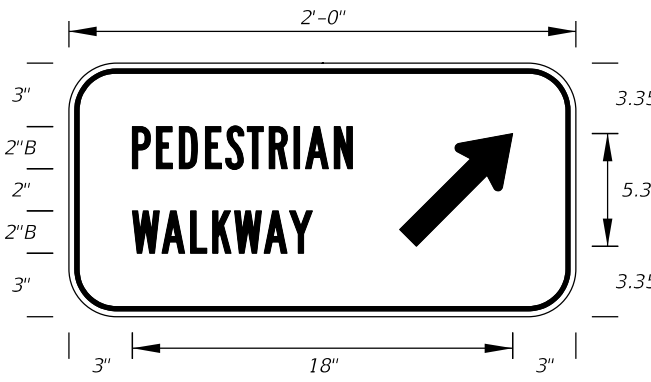
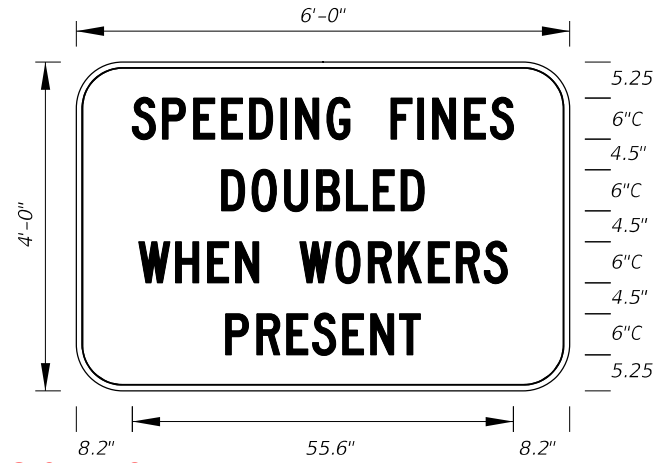
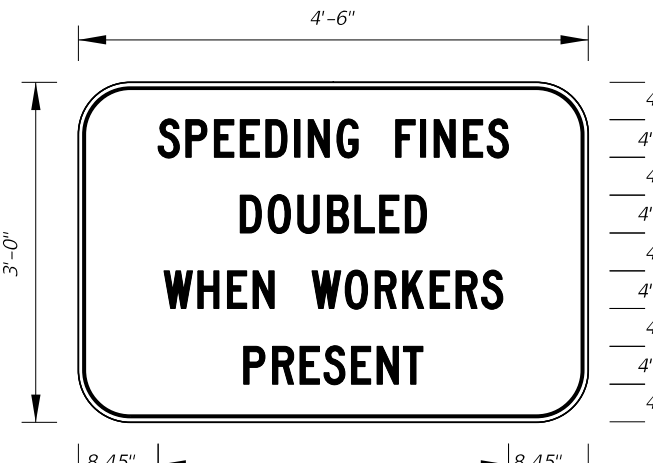
NEW Guide Signs

NEW Sheet 18 of 22:











NEW Guide Signs

NEW Sheet 19 of 22:

NEW Recreational and Culture
Signs

 TTC-001-25 MOT-1-22 4' X 4' 3" Radii 3/4" Border 8" Series C Legend Orange Background Black Legend and Border	 TTC-002-25 MOT-4-22 4' X 4' 3" Radii 3/4" Border 8" Series C Legend Orange Background Black Legend and Border	 TTC-003-25 MOT-5-22 4' X 4' 3" Radii 3/4" Border 7" Series C Legend Orange Background Black Legend and Border	 TTC-003A-25 MOT-6-22 5' X 5' 3" Radii 3/4" Border 8" Series D Legend Orange Background Black Legend and Border
 TTC-004-25 MOT-7-22 5' X 5' 3" Radii 3/4" Border 7" Series D Legend Orange Background Black Legend and Border	 TTC-005-25 MOT-8-22 5' X 5' 3" Radii 3/4" Border 7" Series D Legend Orange Background Black Legend and Border	 TTC-006-25 MOT-9-22 5' X 5' 3" Radii 3/4" Border 7" Series D Legend Orange Background Black Legend and Border	 TTC-007-25 MOT-10-22 4' X 4' 3" Radii 3/4" Border 7" Series C Legend Orange Background Black Legend and Border
 TTC-016-25 MOT-11-06 3' X 2' 2" Radii 3/4" Border 6" Series B Legend Blue Background White Legend and Border	 TTC-017R-25 MOT-12R-06 2' X 1' 2" Radii 3/4" Border 2" Series B Legend White Background Black Legend and Border	 TTC-011A-25 MOT-13-06 Freeway Sign 6' X 4' 6" Radii 3/4" Border 6" Series C Legend White Background Black Legend and Border	 TTC-011-25 MOT-14-06 Arterial Sign 4'-6" X 3' 5" Radii 3/4" Border 4" Series C Legend White Background Black Legend and Border

LAST REVISION 11/01/24 11/01/25	REVISION	DESCRIPTION:	 FY 2025-26 2026-27 STANDARD PLANS	SPECIAL SIGN DETAILS	INDEX 700-102	SHEET 20 11 of 12
---------------------------------------	----------	--------------	---	----------------------	------------------	-------------------------

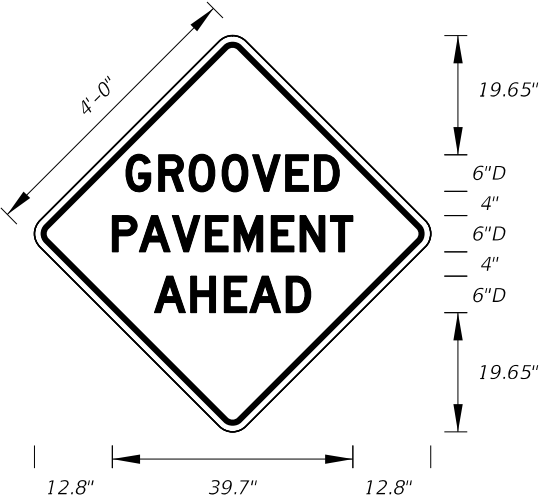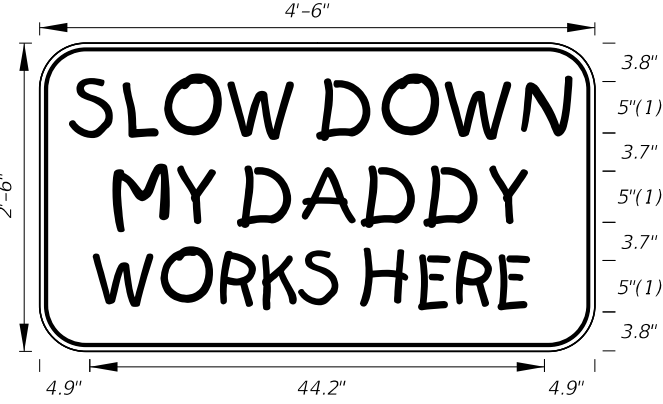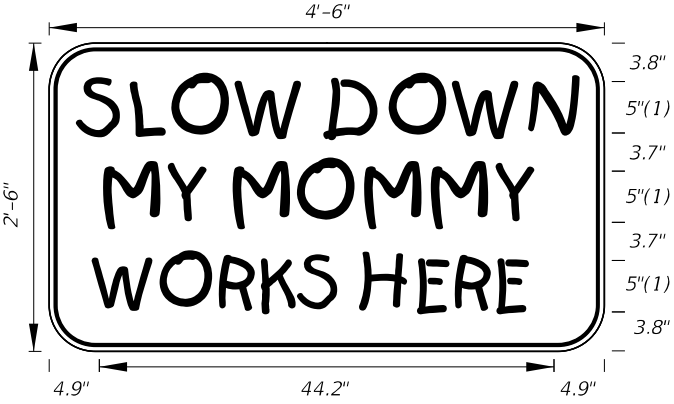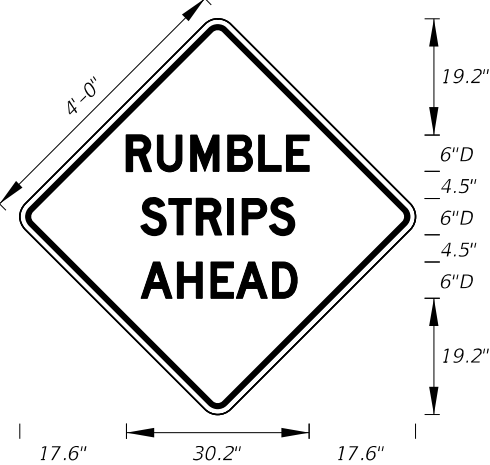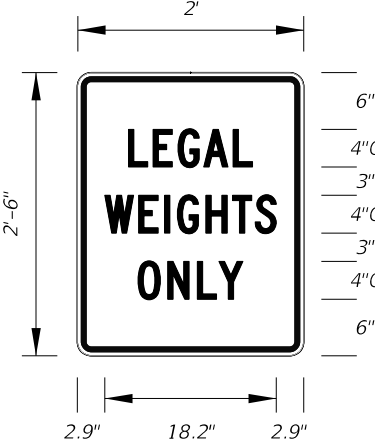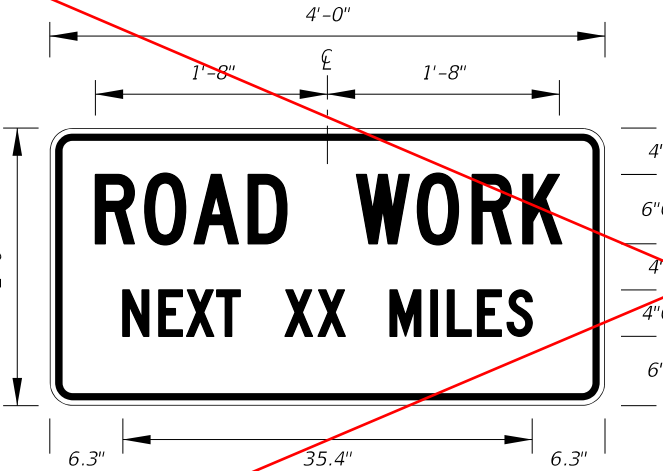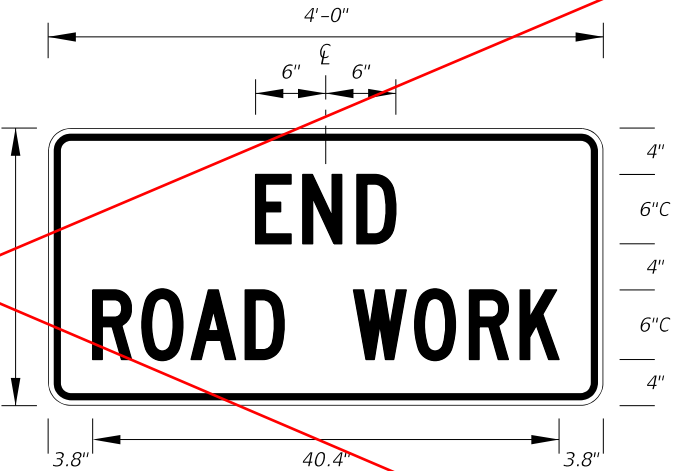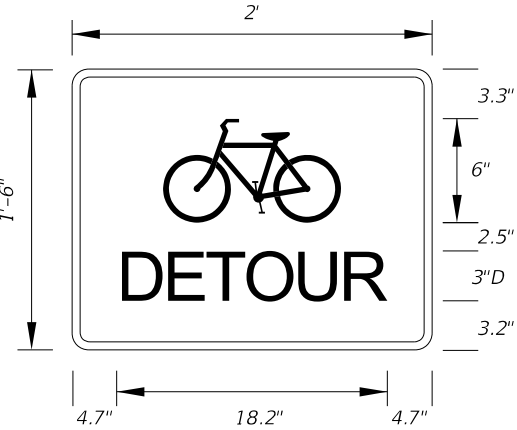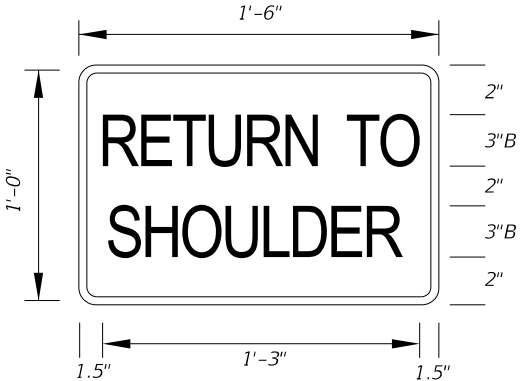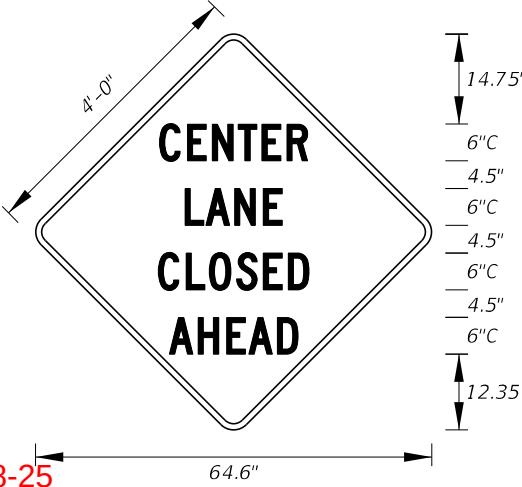 MOT-15-06 TTC-009-25 6" Series D Legend Orange Background Black Legend and Border	 TTC-012-25 MOT-16-06 5" Kids Series Legend Orange Background Black Legend and Border	 TTC-013-25 MOT-17-06 5" Kids Series Legend Orange Background Black Legend and Border	 TTC-010-25 MOT-18-10 6" Series D Legend Orange Background Black Legend and Border
 TTC-014-25 MOT-19-11 4" Series C Legend White Background Red Legend and Border	 G20-1 DELETED Orange Background Black Legend and Border	 G20-2 DELETED Orange Background Black Legend and Border	 TTC-018-25 MOT-21-21 3" Series D Legend Orange Background Black Legend and Border
 TTC-015-25 MOT-23-21 3" Series B Legend Orange Background Black Legend and Border	 TTC-008-25 MOT-27-25 6" Series C Legend Orange Background Black Legend and Border		

NEW Sheet 22 of 22:

NEW Signs Added for
REDUCE SPEED SMOKE
AHEAD and MOTORCYCLES
USE CAUTION

9/18/2025 4:32:15 PM

GENERAL NOTES:

- 1. Sign dimensions are shown in width by height (W x H) throughout the Index.
- 2. See APPENDIX for previous sign numbering crosswalk.

NUMBERING CONVENTION:

FTP-AAA B/C-DD or TTC-AAA B/C-DD

AAA = Sign Type
B = Size Adjustments to Smallest Available Sign Size (A,B,C)
C = Left or Right (L or R)
DD = Year of update

Example 1: Size Adjustment - FTP-001A-25
Example 2: Direction Application - FTP-103R-25
Example 3: Size and Direction - FTP-037AR-25

SIGN TYPES (AAA):

FTP-001-199: Regulatory
FTP-200-399: Warning & Advisory
FTP-400-599: Motorist Service
FTP-600-799: Guide
FTP-800-899: Recreational & Cultural
FTP-900-999: Miscellaneous
TTC-001-199: Temporary Traffic Control

TABLE OF CONTENTS:

Sheet	Description
1	General Notes and Table of Contents
2	Sign Details FTP-001-25 through FTP-007B-25
3	Sign Details FTP-008-25 through FTP-018-25
4	Sign Details FTP-019-25 through FTP-026-25
5	Sign Details FTP-027-25 through FTP-034U-25
6	Sign Details FTP-035L-25 through FTP-037-25
7	Sign Details FTP-200-25 through FTP-206B-25
8	Sign Details FTP-207-25 through FTP-208A-25
9	Sign Details FTP-400-25 through FTP-409-25
10	Sign Details FTP-410-25 through FTP-415A-25
11	Sign Details FTP-416-25 through FTP-417-25
12	Sign Details FTP-418-25 through FTP-422B-25
13	Sign Details FTP-423-25 through FTP-423A-25
14	Sign Details FTP-600-25 through FTP-609-25
15	Sign Details FTP-610 through FTP-611B-25
16	Sign Details FTP-612-25 through FTP-613-25
17	Sign Details FTP-614-25 through FTP-616A-25
18	Sign Details FTP-800-25 through FTP-802A-25
19	Sign Details TTC-001-25 through TTC-010-25
20	Sign Details TTC-011-25 through TTC-018-25
21	Sign Details TTC-019-25 through TTC-020B-25
APPENDIX	Crosswalk



FY 2026-27
STANDARD PLANS

SPECIAL SIGN DETAILS






INDEX
700-102













SHEET
1 of 21

LAST
REVISION
11/01/25

REVISION
DESCRIPTION:

OTHER THAN FREEWAY USE FTP-001-25 7'-0" X 3'-6" 3" Radii 1" Border 6" Series E Legend White Background Black Legend and Border		FREEWAY USE FTP-001A-25 11'-6" X 5'-6" 9" Radii 2" Border 10" Series E Legend White Background Black Legend and Border		FTP-002R-25 FTP-002L-25 14'-6" X 7'-6" 9" Radii 2" Border 10" Series E Legend White Background Black Legend and Border NOTES: 1. Use FTP-002L-25 for "NEXT LEFT". 2. On Interstate Station, delete PICKUPS-VANS, and reduce sign height accordingly.		FTP-003-25 3'-6" X 2'-0" 1.5" Radii ¾" Border 4" Series E Legend White Background Black Legend and Border
FTP-004-25 4'-0" X 3'-0" 1.5" Radii ¾" Border 4" Series C Legend White Background Black Legend and Border		FTP-004A-25 9'-0" X 6'-0" 9" Radii ¾" Border 8" Series D Legend White Background Black Legend and Border		FTP-005-25 2'-0" X 2'-6" 1.5" Radii ⅝" Border 2" Series D Legend White Background - Green Florida Symbol Black Legend, Border and Man Belt Symbol		FTP-005A-25 3'-0" X 4'-0" 1.5" Radii ¾" Border 3" Series D Legend White Background - Green Florida Symbol Black Legend, Border and Man Belt Symbol
FTP-006-25 4'-0" X 4'-0" 1.5" Radii 0.4" Border 2.5" Series C Legend 2" Series C Legend 1.5" Series C Legend and White Background Black Legend and Border		Non-Limited Access FTP-007-25 4'-4" X 2'-0" 1.5" Radii 0.6" Border TOP: 4" Series D Legend Yellow Background Black Legend and Border Bottom: 4" Series D Legend White Background Black Legend and Border		Non-Limited Access FTP-007A-25 7'-0" X 3'-0" 3" Radii 0.9" Border TOP: 6" Series D Legend Yellow Background Black Legend and Border Bottom: 6" Series D Legend White Background Black Legend and Border		FTP-007B-25 10'-0" X 4'-6" 3" Radii X 0.8" Border TOP: 8" Series D Legend Yellow Background Black Legend and Border Bottom: 8" Series D Legend White Background Black Legend and Border

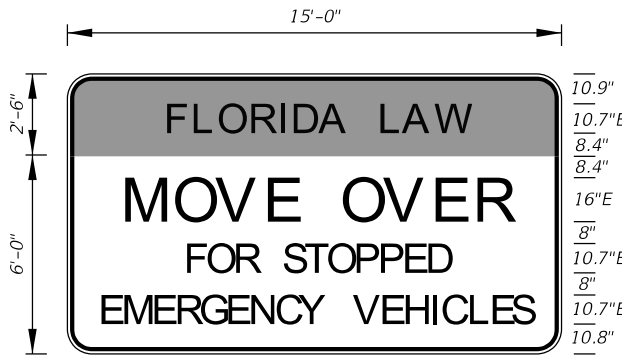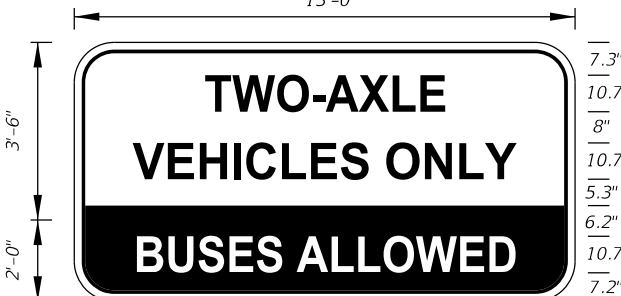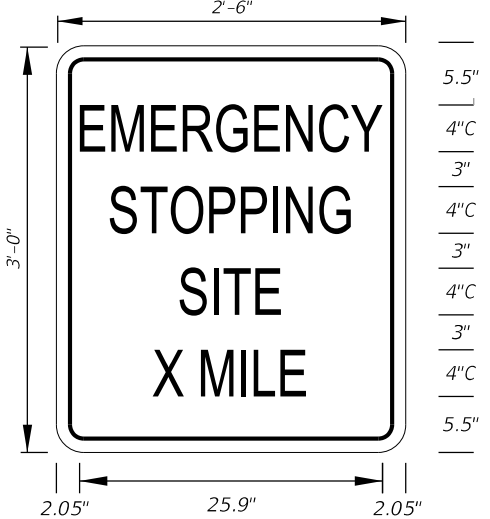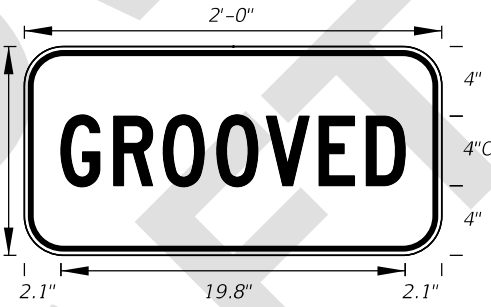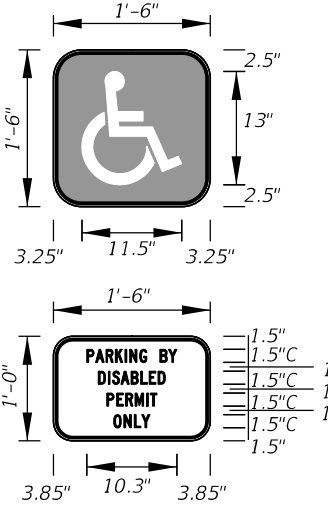 15'-0" 2'-6" 6'-0" 10.9" 10.7"E 8.4" 8.4" 16"E 8" 10.7"E 8" 10.7"E 10.8" FTP-008-25 15'-0" X 8'-6" 9" Radii 1.5" Border TOP: 10.7" Series E Legend Yellow Background Black Legend and Border BOTTOM: 10.7" Series E Legend White Background Black Legend and Border		Limited Access  13'-0" 3'-6" 2'-0" 7.3" 10.7"E 8" 10.7"E 5.3" 6.2" 10.7"E 7.2" FTP-009-25 13'-0" X 5'-6" 6" Radii 1" Border TOP: 10.7" Series E Legend White Background Black Legend and Border BOTTOM: 10.7" Series E Legend Black Background White Legend		 2'-6" 2'-6" 2.05" 25.9" 2.05" 3.5" 4"D 2.5" 4"C 2.5" 4"C 3.5" FTP-010-25 2'-6" X 2'-6" 1.5" Radii 0.625" Border 4" Series D and C Legend White Background Black Legend and Border		 2'-6" 3'-0" 2.05" 25.9" 2.05" 5.5" 4"C 3" 4"C 3" 4"C 3" 4"C 5.5" FTP-011-25 2'-6" X 3'-0" 1.5" Radii ¾" Border 4" Series C Legend White Background Black Legend and Border	
 2'-6" 3'-0" 2.05" 25.9" 2.05" 5.5" 4"C 3" 4"C 3" 4"C 3" 4"C 5.5" FTP-012-25 2'-6" X 3'-0" 1.5" Radii ¾" Border 4" Series C Legend White Background Black Legend and Border		 3'-0" 1'-6" 4.6" 26.8" 4.6" 3.5" 4"D 3" 4"D 3.5" FTP-013-25 3'-0" X 1'-6" 1.5" Radii ¾" Border 4" Series D Legend White Background Black Legend and Border		 2'-0" 1'-0" 2.1" 19.8" 2.1" 4" 4"C 4" FTP-014-25 2'-0" X 1'-0" 1.5" Radii ⅝" Border 4" Series C Legend Yellow Background Black Legend and Border		 2'-6" 3'-0" 3.1" 23.8" 3.1" 5" 2"C 4"C 4"C 4"C 4"C 4"C 5" FTP-015-25 2'-6"X 3'-0" 1.5" Radii ¾" Border 2" and 4" Series C Legend White Background Black Legend and Border	
 3'-6" 4'-0" 3.15" 35.7" 3.15" 6" 3"C 5" 6"C 5" 6"C 5" 6"C 6" FTP-015A-25 3'-6" X 4'-0" 1.5" Radii ¾" Border 3" and 6" Series C Legend White Background Black Legend and Border		 1'-0" 1'-6" 1.4" 9.2" 1.4" 2.5" 4"D 1.2" 2"C 1.2" 2"C 1.2" 1.5" 2.4" FTP-016-25 1'-0" X 1'-6" 1.5" Radii ⅜" Border TOP: 4" Series D Legend BOTTOM: 2" Series C Legend White Background Green Legend and Border		 1'-0" 1'-6" 12" 1.5" 6" 1" 1"C 1" 1"C 1" 1"C 1" 1.5" FTP-017-25 1'-0" X 1'-6" 1.5" Radii ⅜" Border TOP: Blue Background White Border BOTTOM: 1" Series C Legend White Background Black Legend and Border		 1'-6" 1'-6" 1'-0" 3.25" 11.5" 3.25" 2.5" 13" 2.5" 1.5" 1.5"C 1" 1.5"C 1" 1.5"C 1" 1.5" FTP-018-25 1'-6" X 2'-6" 1.5" Radii ⅜" Border TOP: Blue Background White Border BOTTOM: 1.5" Series C Legend White Background Black Legend and Border	
LAST REVISION 11/01/25	REVISION	DESCRIPTION:	 FY 2026-27 STANDARD PLANS	SPECIAL SIGN DETAILS		INDEX 700-102	SHEET 3 of 21

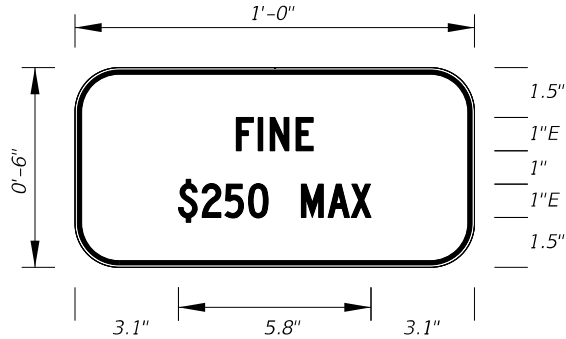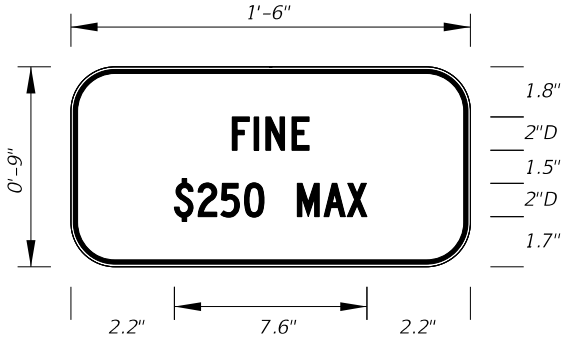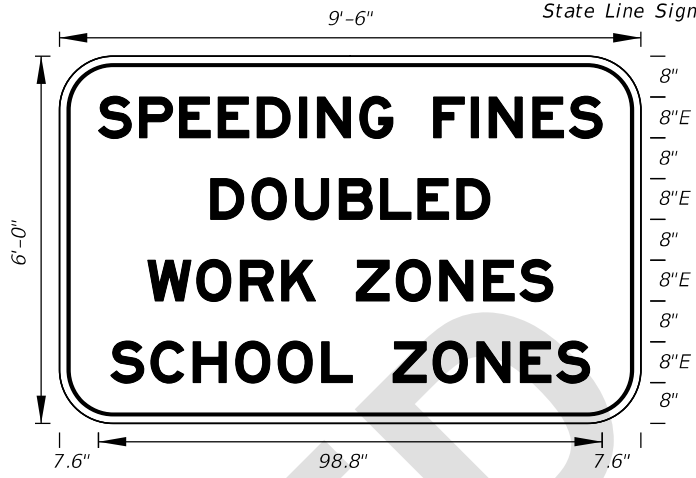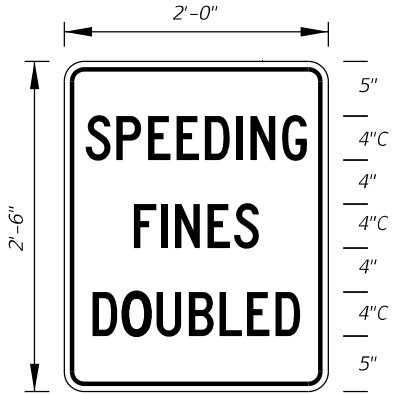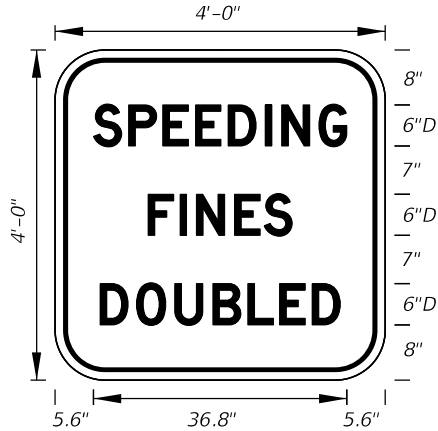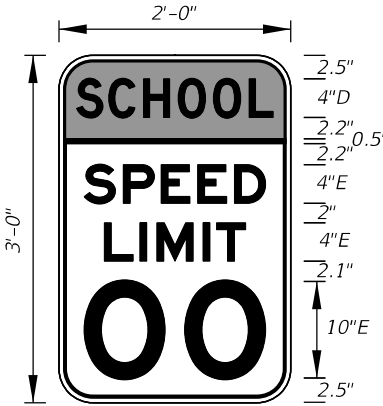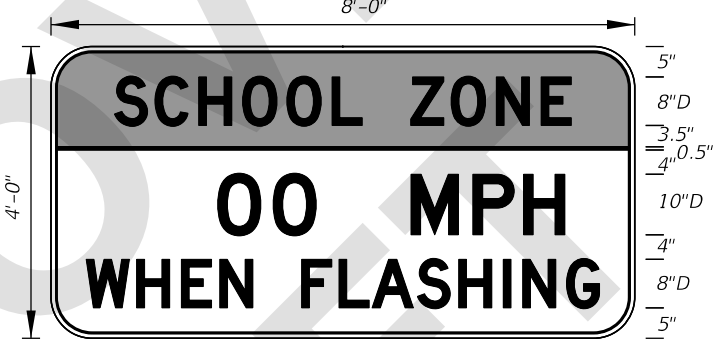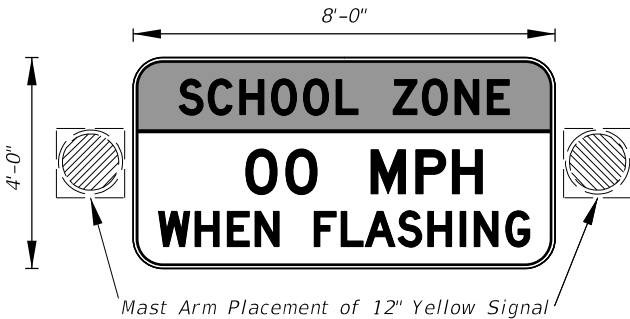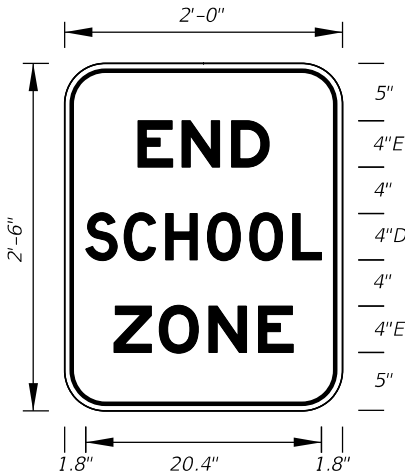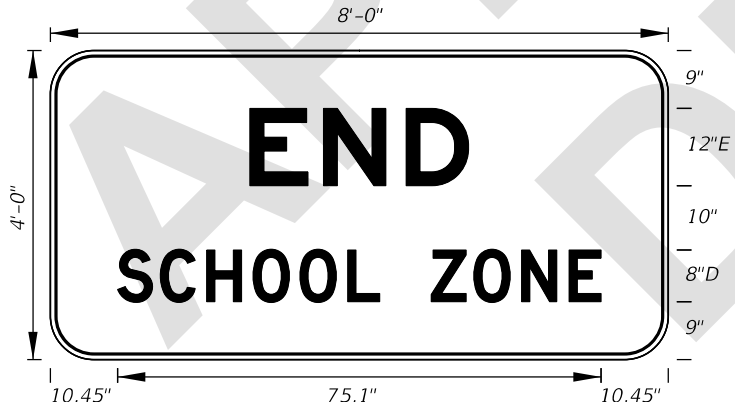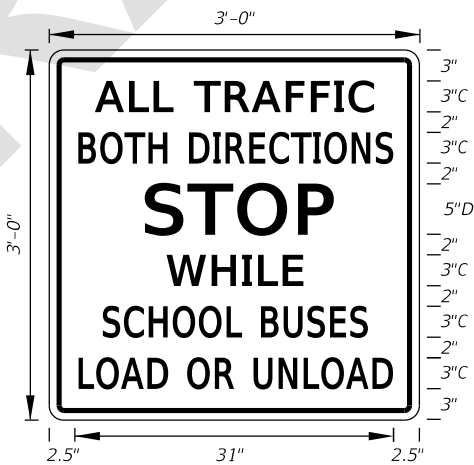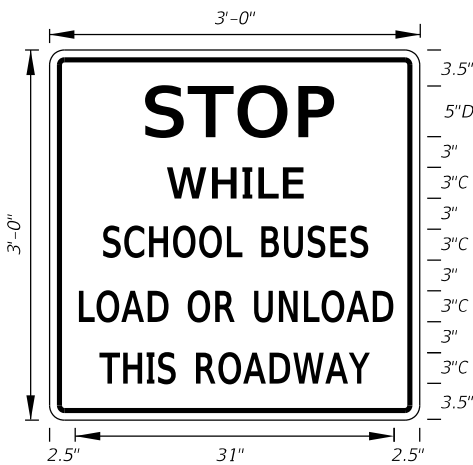NOTE: Supplemental Panel for the FTP-016-25 sign  FTP-019-25 1'-0" X 6" 1.5" Radii 3⁄8" Border 1" Series E Legend White Background Black Legend and Border		NOTE: Supplemental Panel for the FTP-017-25 sign  FTP-019A-25 1'-6" X 9" 1.5" Radii 3⁄8" Border 2" Series D Legend White Background Black Legend and Border		State Line Sign  FTP-020-25 9'-6" X 6'-0" 9" Radii 2" Border 8" Series E Legend White Background Black Legend and Border		 FTP-021-25 2'-0" X 2'-6" 1.5" Radii 1⁄2" Border 4" Series C Legend 80% Spacing White Background Black Legend and Border
Freeway Sign  FTP-021A-25 4'-0" X 4'-0" 3" Radii 3⁄4" Border 6" Series D Legend White Background Black Legend and Border		 FTP-022-25 2'-0" X 3'-0" 1.5" Radii 5⁄8" Border TOP: 4" Series D Legend Fluorescent Yellow-Green Background Black Legend and Border BOTTOM: 4" and 10" Series E Legend White Background Black Legend and Border		 FTP-023-25 8'-0" X 4'-0" 3" Radii 3⁄4" Border TOP: 8" Series D Legend Fluorescent Yellow-Green Background Black Legend and Border BOTTOM: 8" and 10" Series D Legend White Background Black Legend and Border		 FTP-023A-25 8'-0" X 4'-0" 3" Radii 3⁄4" Border TOP: 8" Series D Legend Fluorescent Yellow-Green Background Black Legend and Border BOTTOM: 8" and 10" Series D Legend White Background Black Legend and Border
 FTP-024-25 2'-0" X 2'-6" 1.5" Radii 5⁄8" Border 4" Series D and E Legend White Background Black Legend and Border		 FTP-024A-25 8'-0" X 4'-0" 3" Radii 3⁄4" Border 12" Series E and 8" Series D Legend White Background Black Legend and Border		 FTP-025-25 3'-0" X 3'-0" 1.5" Radii 3⁄4" Border 3" Series C Legend and 5" Series D Legend White Background Black Legend and Border		 FTP-026-25 3'-0" X 3'-0" 1.5" Radii 3⁄4" Border 3" Series C Legend 5" Series D Legend White Background Black Legend and Border

FTP-027-25
2'-6" X 3'-6"
1.5" Radii 0.8" Border

TOP:
Series D Legend
Fluorescent Yellow Green
Background
Black Legend and Border
Bottom:
Series D Legend
White Background
Black Legend and Border

FTP-027A-25
4'-0" X 5'-0"
3" Radii 0.8" Border

TOP:
Series D Legend
Fluorescent Yellow Green
Background
Black Legend and Border
Bottom:
Series E Legend
White Background
Black Legend and Border

FTP-028-25
2'-6" X 3'-0"
1.5" Radii 0.625" Border

TOP:
Series C Legend
Yellow Background
Black Legend and Border
Bottom:
Series C Legend
White Background
Black Legend and Border

FTP-029-25
9" X 2'-3"
1.5" Radii No Border

Series C Legend and
Series D Legend
White on Yellow
Black Legend and Border

FTP-030-25
9" X 1'-0"
1.5" Radii 3/8" Border

1" Series D Legend
White Background
Black Legend and Border

NOTES:
1. Sign mounting holes can be punched or field drilled with no obstruction to text or symbols from holes or bolts.
2. See MUTCD R10-3f for Letter Size, Spacing, and Symbol Sizes and Color

FTP-031-25
9" X 1'-3"
1.5" Radii 3/4" Border

Series B Legend
White Background
Black Legend and Border

NOTES:
1. Sign mounting holes can be punched or field drilled with no obstruction to text or symbols from holes or bolts.
2. See MUTCD R10-3i for Letter Size, Spacing, and Symbol Sizes and Color

FTP-032-25
9" X 1'-6"
1.5" Radii 3/4" Border

Series B Legend
White Background
Black Legend and Border

FTP-033-25
9" X 1'-6"
1.5" Radii 1/4" Border

Series D Legend
White Background
Black Legend and Border

FTP-034L-25
2'-0" X 2'-6"
1.5" Radii 3/8" Border

5" Series D Legend
White Background
Black Legend and Border

Note: Use FTP-033R for RIGHT TURN ONLY

FTP-034AL-25
4'-0" X 5'-0"
3" Radii 3/4" Border

10" Series D Legend
White Background
Black Legend and Border

Note: Use FTP-033AR for RIGHT TURN ONLY

FTP-034U-25
2'-0" X 3'-0"
1.5" Radii
5" Series D Legend
White Background
Black Legend and Border

	A	B	C	D	E
A	3.125				
B	3.625				
C	6.375				
D	.5				
E	.625				

	A	B	C	D	E	F	G
A	6.25	3.125	3.125	3.125	5	9.25	20.5

DETAILS

**RIGHT
TURN
ONLY**

2'-0"
2'-6"
4.5"
5"
3"
5"
3"
5"
4.5"
4.4"
15.2"
4.4"

FTP-035R-25
2'-0" X 2'-6"
1.5" Radii 5/8" Border

5" Series C Legend
White Background
Black Legend and Border

**LEFT
TURN
ONLY**

2'-0"
2'-6"
4.5"
5"
3"
5"
3"
5"
4.5"
5"
14"
5"

FTP-035L-25
2'-0" X 2'-6"
1.5" Radii 5/8" Border

5" Series C Legend
White Background
Black Legend and Border

**NO PEDESTRIANS
OR BICYCLES
BEYOND GATE**

3'-0"
1'-6"
2.5"
3"
2"
3"
2"
3"
2.5"
3.7"
28.6"
3.7"

FTP-036-25
3'-0" X 1'-6"
1.5" Radii 0.5" Border

3" Series C Legend and
White Background
Black Legend and Border

FLORIDA LAW

3'-0"
1'-0"
4"
4"
4"
3.7"
17.9"
2.6"
8.1"
3.7"

FTP-037-25
3'-0" X 1'-0"
1.5" Radii 0.4" Border

4" Series C Legend
Fluorescent Yellow Green
Background
Black Legend and Border

FTP-200-25 4'-6" X 2'-0" 1.5" Radii ¾" Border 4" Series C Legend Yellow Background Black Legend and Border		FTP-201-25 2'-6" X 2'-6" 1.5" Radii ¾" Border 5" Series C Legend Fluorescent Yellow-Green Background Black Legend and Border		FTP-202-25 3'-0" X 3'-0" 1.5" Radii 5" Series D Legend Yellow Background Black Legend and Border		FTP-203-25 3'-0" X 2'-0" 1.5" Radii ¾" Border 4" and 3" Series C Legend Yellow Background Black Legend and Border					
FTP-203A-25 3'-0" X 3'-0" 1.5" Radii ¾" Border 4" and 5" Series C Legend Yellow Background Black Legend and Border		FTP-204-25 2'-0" X 1'-0" 1.5" Radii ¾" Border 4" Series C Legend Yellow Background Black Legend and Border		FTP-205-25 3'-6" X 1'-0" 1.5" Radii ¾" Border 4" Series C Legend Yellow Background Black Legend and Border		FTP-206-25 2'-6" X 2'-6" 1.5" Radii ¾" Border 4" Series B Legend Yellow Background Black Legend and Border					
FTP-206A-25 3'-0" X 3'-0" 1.5" Radii ¾" Border 5" Series B Legend Yellow Background Black Legend and Border		FTP-206B-25 4'-0" X 4'-0" 3" Radii ¾" Border 6" Series B Legend Yellow Background Black Legend and Border									
LAST REVISION 11/01/25		DESCRIPTION:		FY 2026-27 STANDARD PLANS		SPECIAL SIGN DETAILS		INDEX 700-102		SHEET 7 of 21	

Non-Limited Access

FTP-207-25

3'-0" X 3'-0"

1.5" Radii 0.8" Border

5" Series C Legend

Yellow Background

Black Legend and Border

Limited Access

FTP-207A-25

4'-0" X 4'-0"

3" Radii 0.8" Border

6" Series D Legend

Yellow Background

Black Legend and Border

FTP-208-25

3'-0" X 3'-0"

1.5" Radii 3/4" Border

6" Series C Legend

Yellow Background

Black Legend and Border

FTP-208A-25

4'-0" X 4'-0"

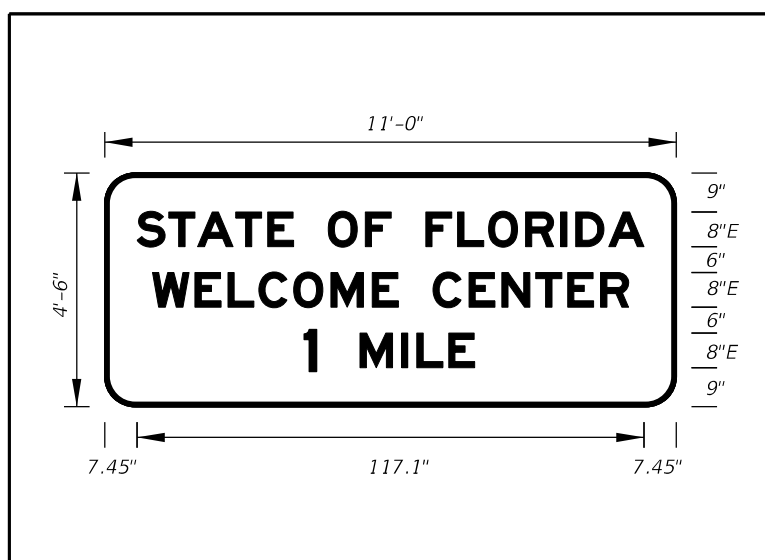
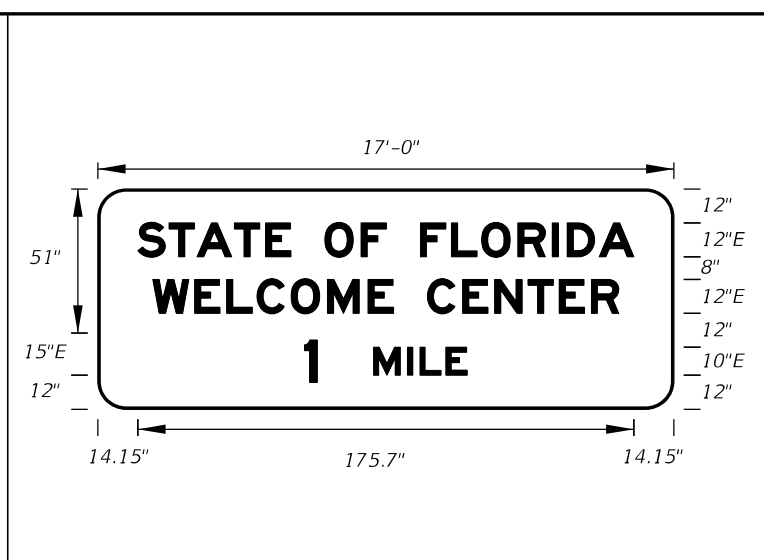
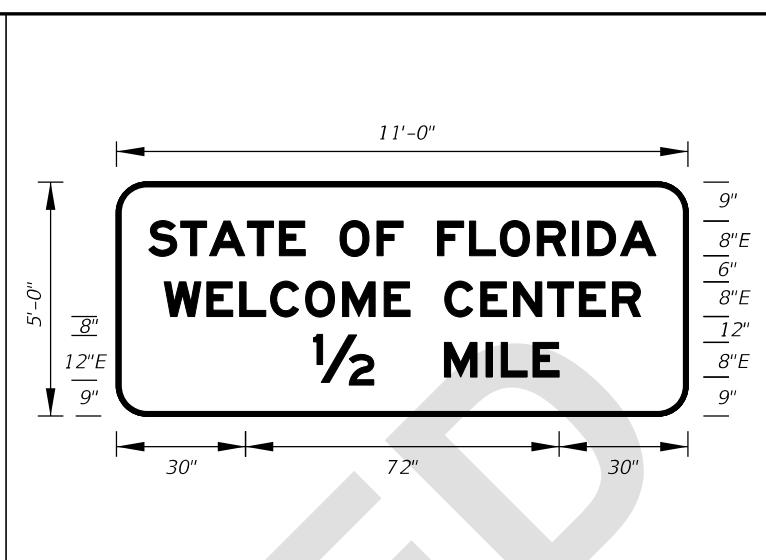
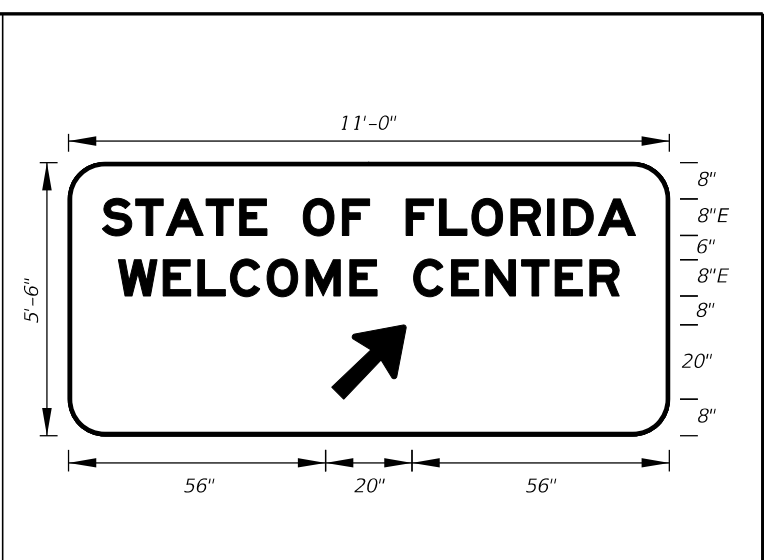
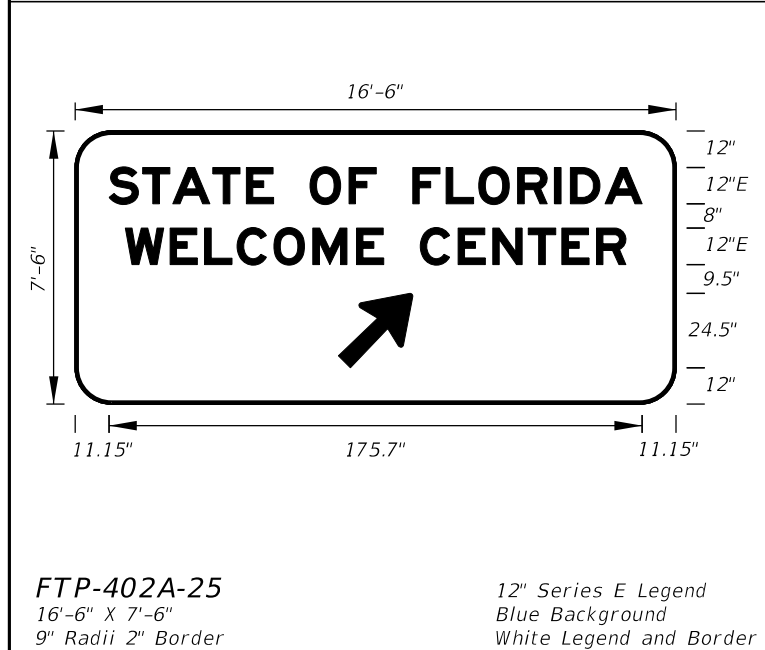
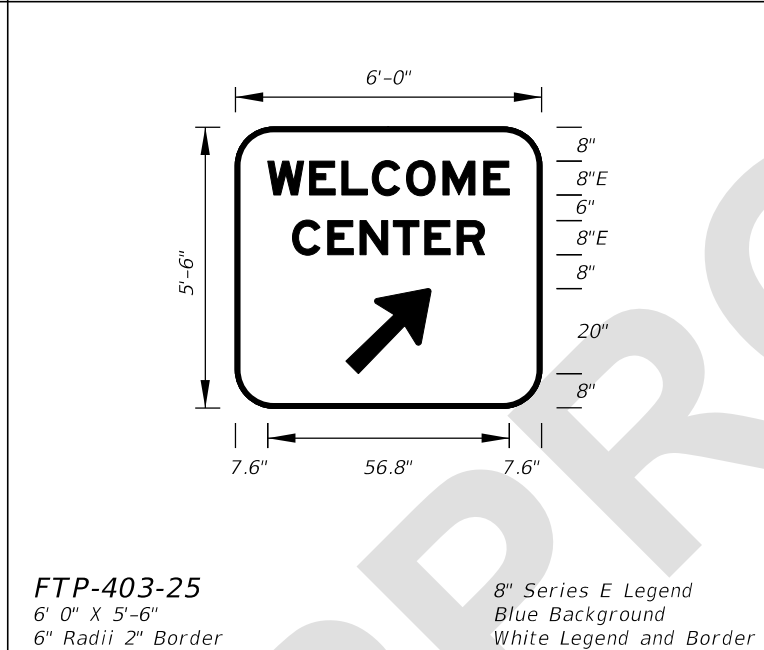
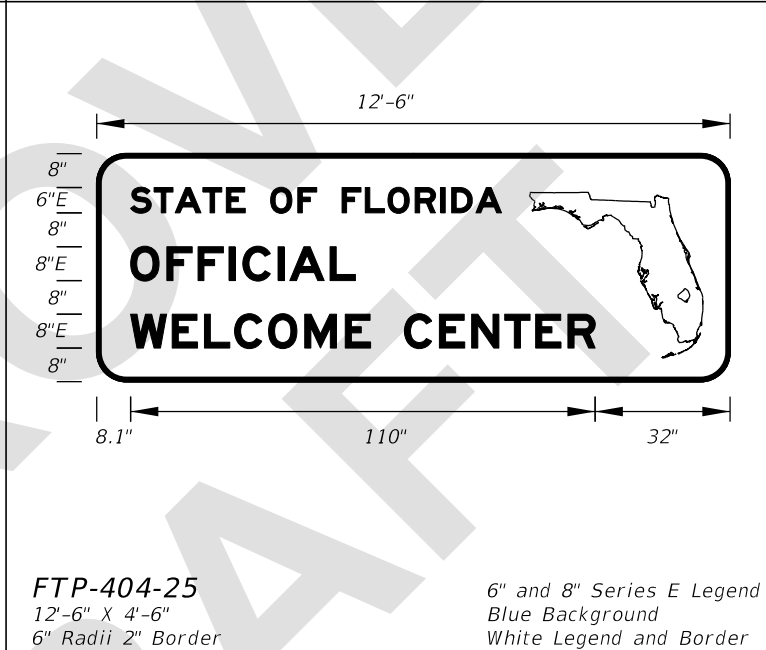
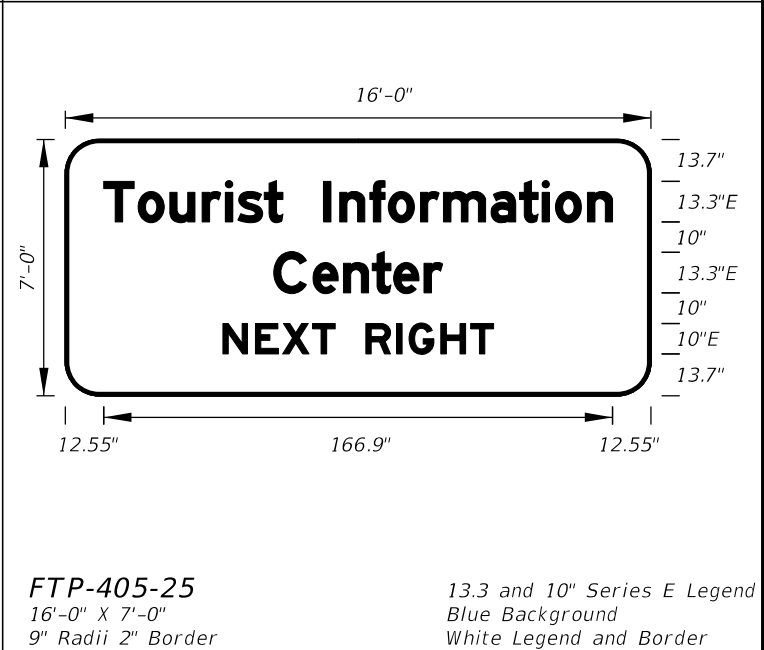
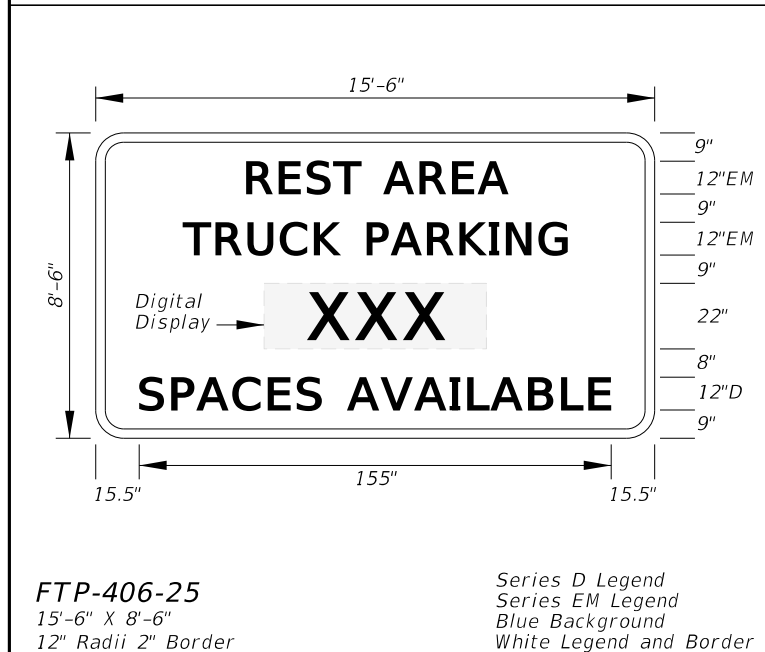
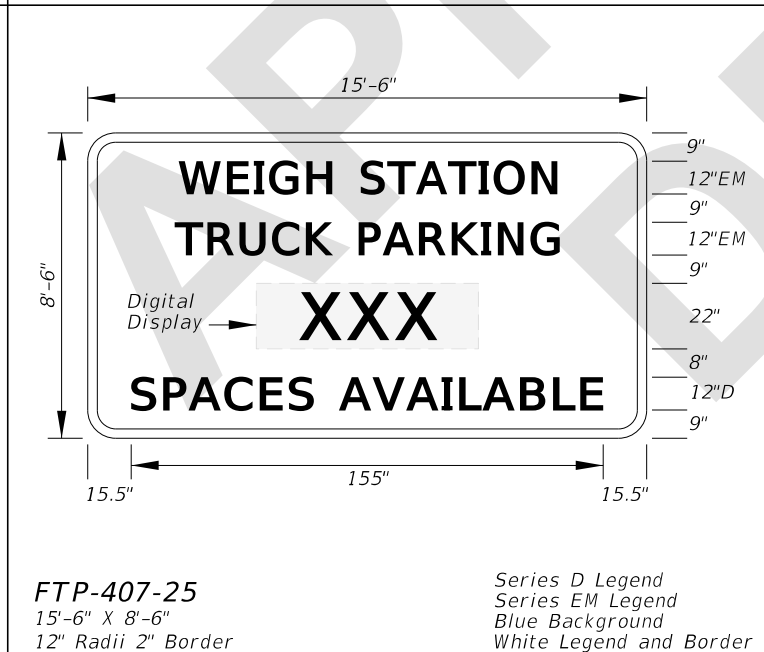
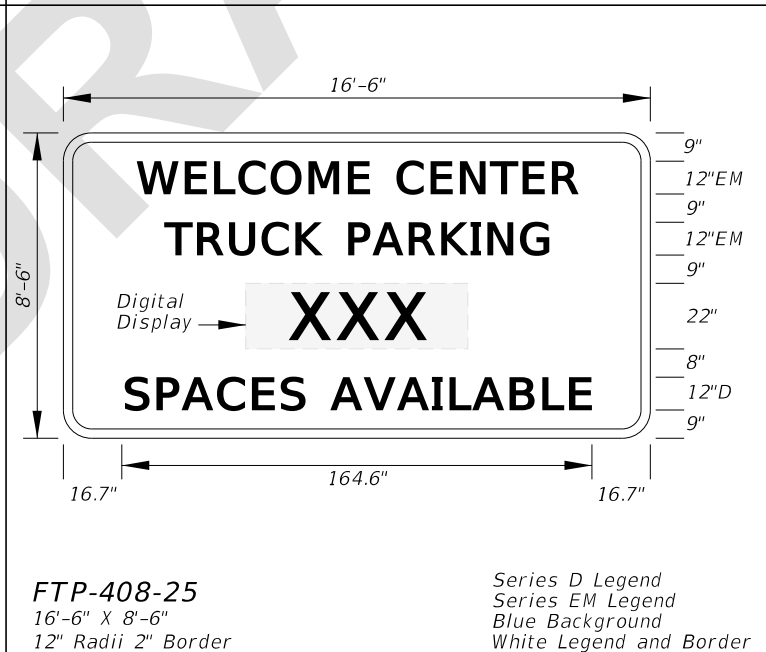
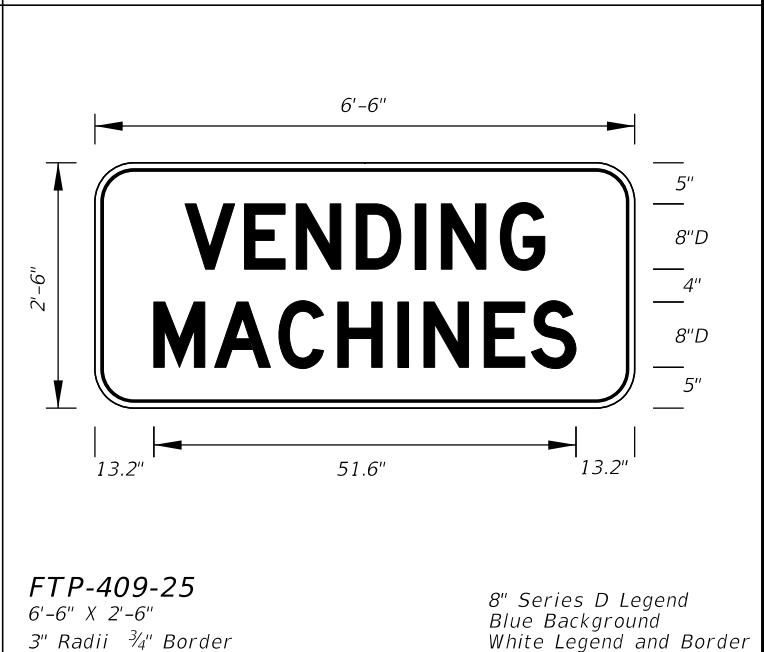
1.5" Radii 3/4" Border

8" Series C Legend

Yellow Background


Black Legend and Border

9/18/2025 4:33:21 PM


 FTP-400-25 11'-0" X 4'-6" 6" Radii 2" Border 8" Series E Legend Blue Background White Legend and Border		 FTP-400A-25 17'-0" X 6'-6" 9" Radii 2" Border 12", 10" and 15" Series E Legend Blue Background White Legend and Border		 FTP-401-25 11'-0" X 5'-0" 9" Radii 2" Border 8" and 12" Series E Legend Blue Background White Legend and Border		 FTP-402-25 11'-0" X 5'-6" 9" Radii 2" Border 8" Series E Legend Blue Background White Legend and Border			
 FTP-402A-25 16'-6" X 7'-6" 9" Radii 2" Border 12" Series E Legend Blue Background White Legend and Border		 FTP-403-25 6' 0" X 5'-6" 6" Radii 2" Border 8" Series E Legend Blue Background White Legend and Border		 FTP-404-25 12'-6" X 4'-6" 6" Radii 2" Border 6" and 8" Series E Legend Blue Background White Legend and Border		 FTP-405-25 16'-0" X 7'-0" 9" Radii 2" Border 13.3 and 10" Series E Legend Blue Background White Legend and Border			
 FTP-406-25 15'-6" X 8'-6" 12" Radii 2" Border Series D Legend Series EM Legend Blue Background White Legend and Border		 FTP-407-25 15'-6" X 8'-6" 12" Radii 2" Border Series D Legend Series EM Legend Blue Background White Legend and Border		 FTP-408-25 16'-6" X 8'-6" 12" Radii 2" Border Series D Legend Series EM Legend Blue Background White Legend and Border		 FTP-409-25 6'-6" X 2'-6" 3" Radii 3/4" Border 8" Series D Legend Blue Background White Legend and Border			
LAST REVISION 11/01/25 REVISION		DESCRIPTION:		 FY 2026-27 STANDARD PLANS		SPECIAL SIGN DETAILS		INDEX 700-102	SHEET 9 of 21



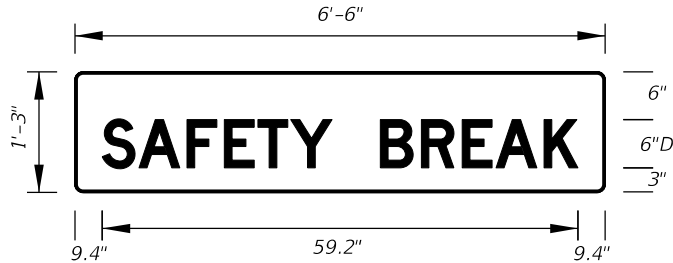FTP-410-25
6'-6" X 2'-6"
3" Radii ¾" Border
6" Series D Legend
Blue Background
White Legend and Border



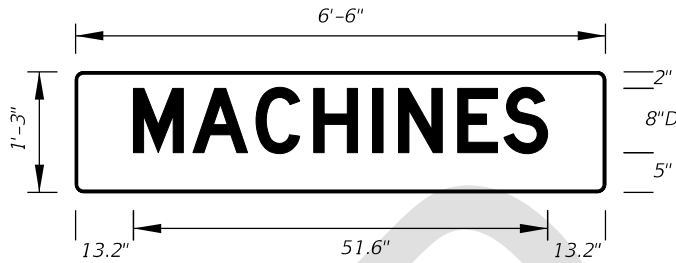FTP-411-25
6'-6" X 1'-3"
1.5" Radii
6" Series D Legend
Blue Background
White Legend



FTP-412-25
6'-6" X 1'-3"
1.5" Radii
8" Series D Legend
Blue Background
White Legend



FTP-413-25
4'-0" X 4'-0"
3" Radii 1" Border
4" and 6" Series D Legend
Blue Background
White Legend and Border



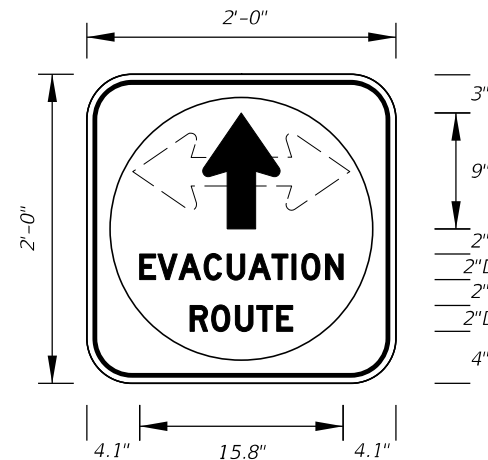
FTP-414-25
4'-0" X 5'-0"
3" Radii 1" Border
6" Series D Legend
Blue Background
White Legend and Border




FTP-414A-25
5'-6" X 6'-0"
3" Radii 1" Border
8" Series D Legend
Blue Background
White Legend and Border



DETAIL for FTP-414-25 AND FTP-414A-25



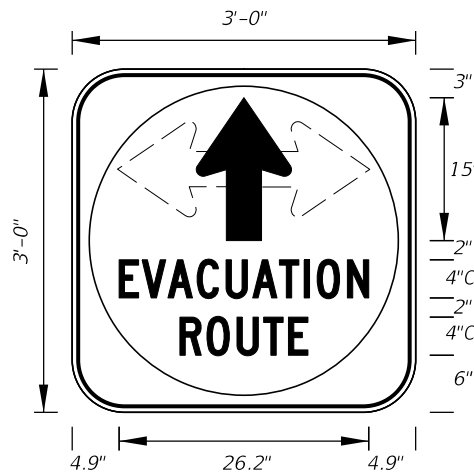FTP-415-25
2'-0" X 2'-0"
1.5" Radii ¾" Border
2" Series D Legend
White Background with Blue Circle
Background
White Legend and Black Border



FTP-415A-25
3'-0" X 3'-0"
1.5" Radii ¾" Border
4" Series C Legend
White Background with Blue Circle
Background
White Legend and Black Border

9/18/2025 4:33:29 PM



FY 2026-27
STANDARD PLANS

SPECIAL SIGN DETAILS

INDEX
700-102

SHEET
10 of 21

LAST
REVISION
11/01/25

REVISION

DESCRIPTION:




Blue Background
White Legend and Border



Blue Background
White Legend and Border


Non-Limited Access FTP-418-25 3'-0" X 2'-0" 1.5" Radii		Limited Access FTP-418A-25 6'-6" X 4'-0" 3" Radii 3/4" Border		Non-Limited Access FTP-419-25 3'-0" X 2'-0" 1.5" Radii		Limited Access FTP-419A-25 6'-6" X 4'-0" 3" Radii 3/4" Border			
Non-Limited Access FTP-420-25 3'-0" X 2'-0" 1.5" Radii		Limited Access FTP-420A-25 6'-6" X 4'-0" 3" Radii 3/4" Border		Non-Limited Access FTP-421-25 3'-0" X 2'-6" 1.5" Radii 0.8" Border		Limited Access FTP-421A-25 6'-0" X 3'-6" 1.5" Radii 0.8" Border			
FTP-421B-25 12'-0" X 6'-0" 9" Radii 1.5" Border		FTP-422-25 2'-0" X 1'-6" 1.5" Radii 0.5" Border		FTP-422A-25 3'-0" X 2'-0" 1.5" Radii 0.8" Border		FTP-422B-25 3'-6" X 2'-6" 1.5" Radii 3/4" Border			
LAST REVISION 11/01/25	REVISION	DESCRIPTION:		FY 2026-27 STANDARD PLANS		SPECIAL SIGN DETAILS		INDEX 700-102	SHEET 12 of 21

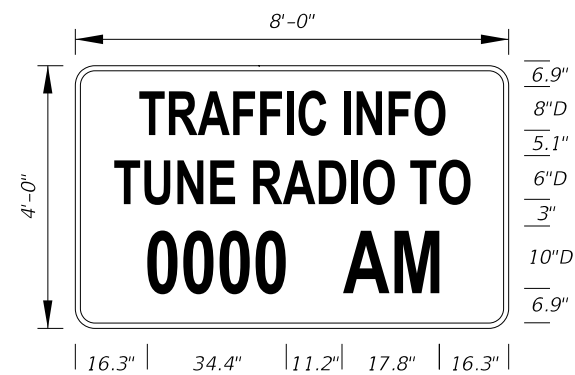

FTP-423-25

8'-0" X 4'-0"
3" Radii $\frac{3}{4}$ " Border











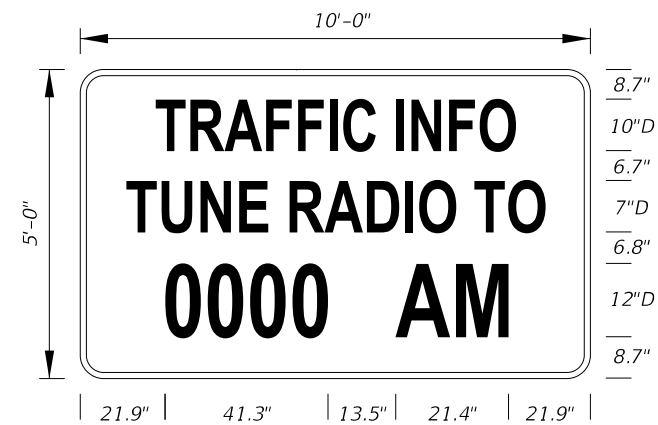
6", 8" and 10" Series D Legend
Blue Background
White Legend and Border







FTP-423A-25


10'-0" X 5'-0"
9" Radii 2" Border

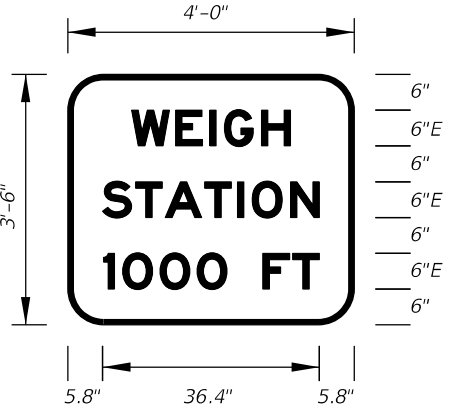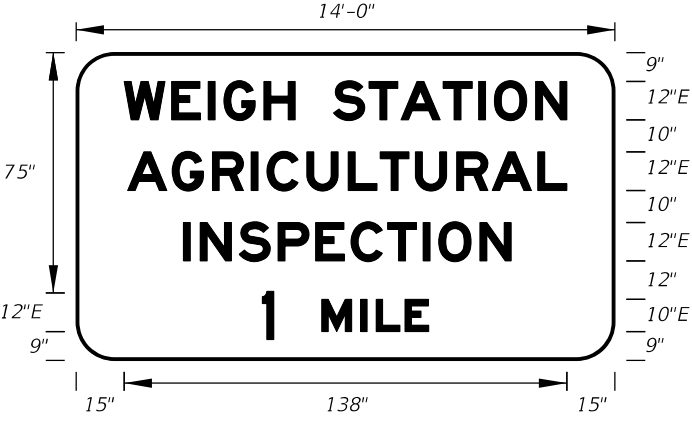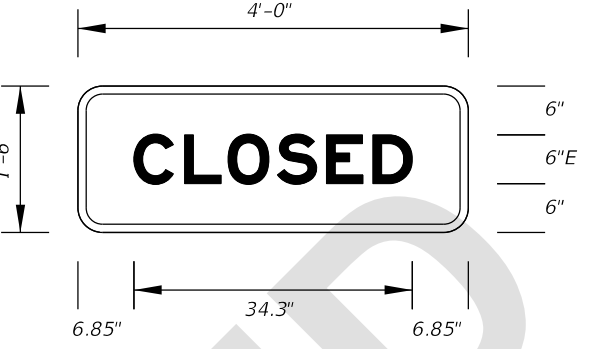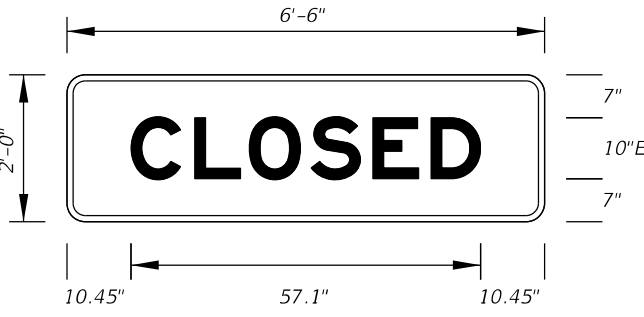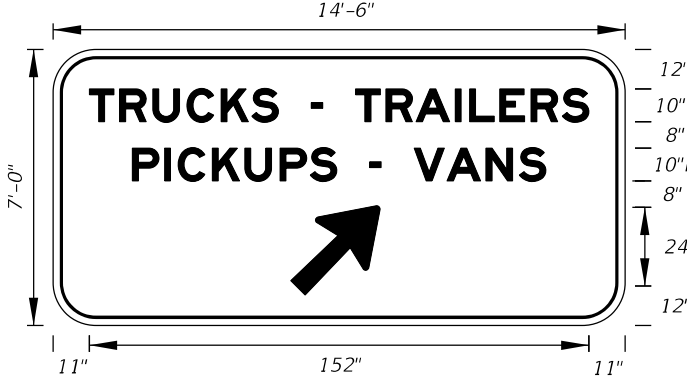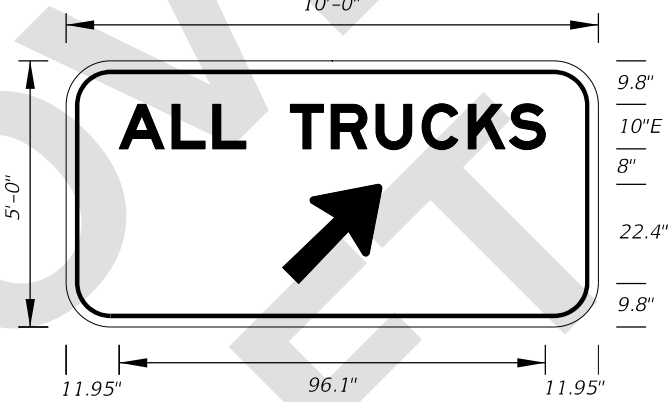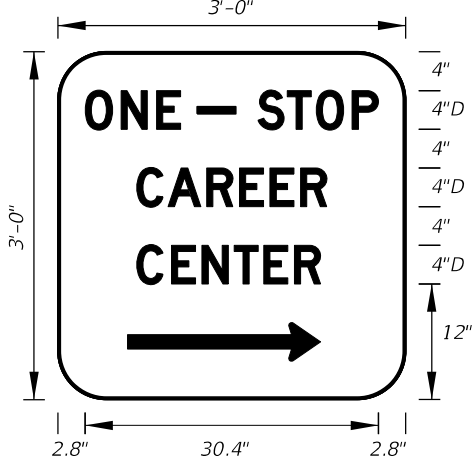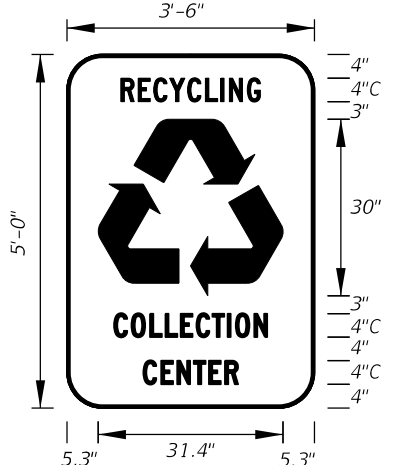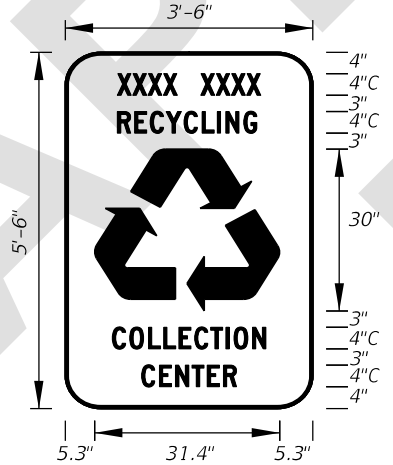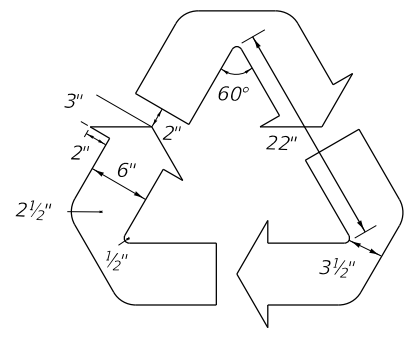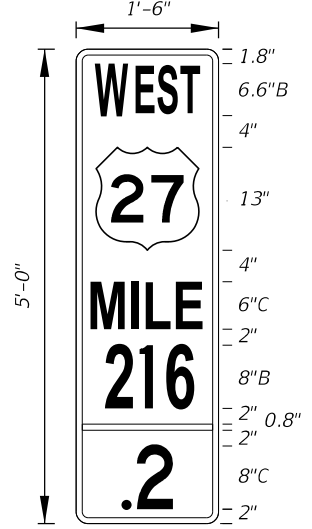7", 10" and 12" Series D Legend
Blue Background
White Legend and Border

Other Than Freeway Use  FTP-600-25 4'-0" X 3'-6" 1.5" Radii 2" Border 6" Series E Legend Green Background White Legend and Border	Other Than Freeway Use  FTP-601-25 14'-0" X 8'-0" 9" Radii 2" Border 12" and 10" Series E Legend Green Background White Legend and Border	Other Than Freeway Use  FTP-602-25 4'-0" X 1'-6" 1.5" Radii 2" Border 6" Series E Legend Green Background White Legend and Border NOTE: FTP-602-25 to be used with FTP-600-25	Freeway Use  FTP-602A-25 6'-6" X 2'-0" 1.5" Radii 2" Border 10" Series E Legend Green Background White Legend and Border NOTE: FTP-620A-25 to be used with FTP-604R-25
 FTP-603R-25 FTP-603L-25 14'-6" X 7'-0" 9" Radii 2" Border 10" Series E Legend Green Background White Legend and Border	 FTP-604R-25 FTP-604L-25 12'-0" X 7'-0" 9" Radii 2" Border 10" Series E Legend Green Background White Legend and Border NOTE: Use FTP-604L-25 for "NEXT LEFT".	 FTP-605R-25 10'-0" X 5'-0" 9" Radii 10" Series E Legend Green Background White Legend NOTE: Use FTP-605L-25 for LEFT ARROW.	 FTP-606-25 3'-0" X 3'-0" 1.5" Radii 4" Series D Legend Green Background White Legend and Border
 FTP-607-25 3'-6" X 5'-0" 1.5" Radii 4" Series C Legend Green Background White Legend, Border and Symbol	 FTP-608-25 3'-6" X 5'-6" 3" Radii 4" Series C Legend Green Background Municipality Name Optional White Legend, Border and Symbol	 Detail for FTP-607-25 and FTP-608-25	 FTP-609-25 1'-6" X 5'-0" 1.5" Radii 0.8" Border 6" Series B, 6" series C 8" Series B, and 8" Series C Green Background White Legend and Border

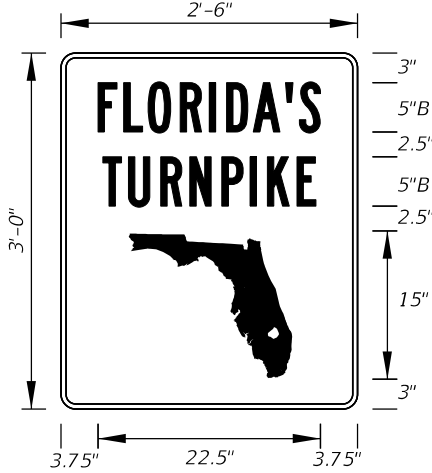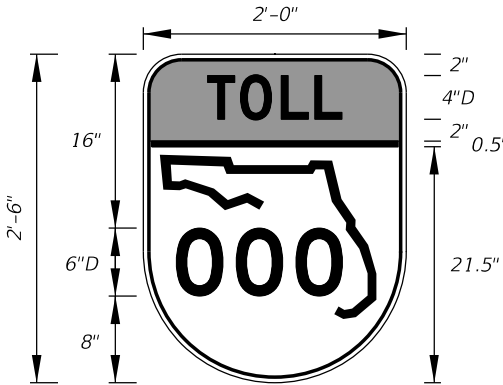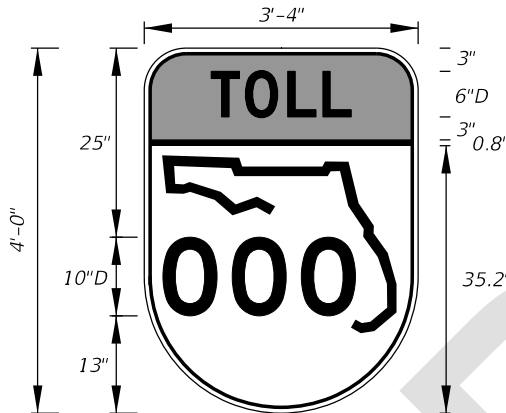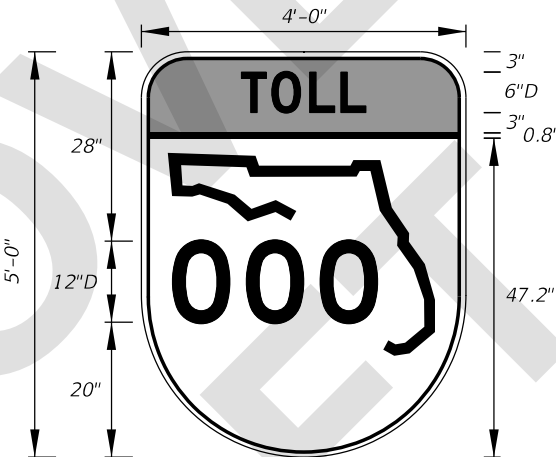 FTP-610-25 2'-6" X 3'-0" 1.5" Radii ¾" Border 5" Series B Legend Green Background White Legend, Border, and Florida Symbol	 FTP-610A-25 3'-4" X 4'-0" 1.5" Radii ¾" Border 7" Series B Legned Green Background White Legend, Border, and Florida Symbol	 FTP-610B-25 4'-0" X 5'-0" 3" Radii 1 ¼" Border 8" Series B Legend Green Background White Legend, Border, and Florida Symbol
 FTP-611-25 2'-0" X 2'-6" 1.5" Radii ¾" Border TOP: 4" Series D Legend Yellow Background Black Legend and Border BOTTOM: 6" Series D Legend White Background Black Legend and Border	 FTP-611A-25 3'-4" X 4'-0" 3" Radii ¾" Border TOP: 6" Series D Legend Yellow Background Black Legend and Border BOTTOM: 10" Series D Legend White Background Black Legend and Border	 FTP-611B-25 4'-0" X 5'-0" 3" Radii ¾" Border TOP: 6" Series D Legend Yellow Background Black Legend and Border BOTTOM: 12" Series D Legend White Background Black Legend and Border

LAST REVISION 11/01/25	REVISION	DESCRIPTION:	 FY 2026-27 STANDARD PLANS	SPECIAL SIGN DETAILS	INDEX 700-102	SHEET 15 of 21
------------------------------	----------	--------------	--	----------------------	------------------	-------------------

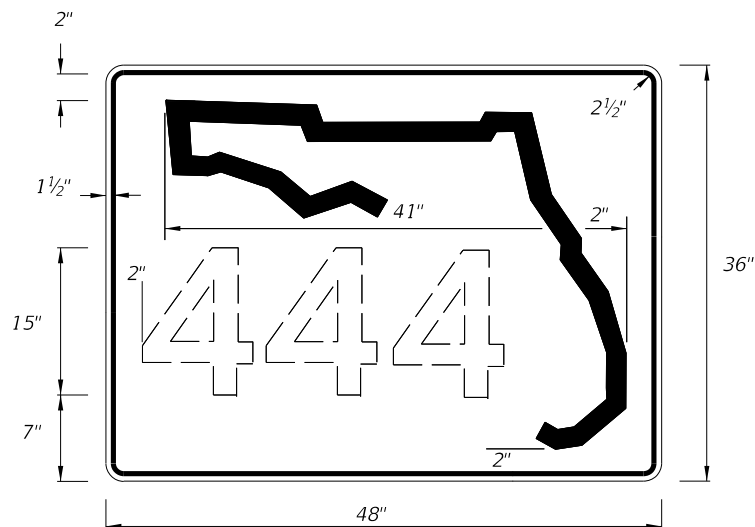


DIGITS	NUMERAL SIZE	SERIES LEGEND	PANEL SIZE
1-3	15"	C	48" x 36"
4	12"	C	48" x 36"


NOTES:

- Stroke width of State Outline shall be 1".
- 2 1/2" Radii

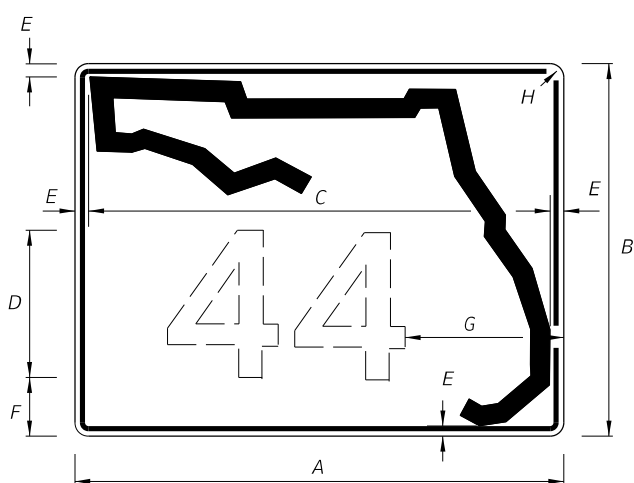INDEPENDENT USE FOR FREEWAY



1 OR 2 DIGITS

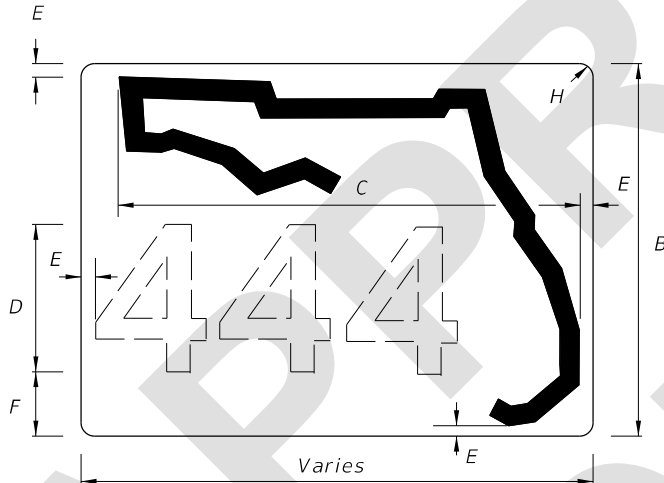

3 OR MORE DIGITS


NOTES:

- Florida marker shall have Black Legend with White Background.
- Stroke width of State outline shall be 3/4" for Guide Sign.
- Series D Legend.
- Width varies with the number scheme combination, within a range of 48"-58".

A	B	C	D	E	F	G	H
30"	24"	26"	12"	1 1/4"	2 3/4"	8 1/4"	1 1/4"
36"	30"	32"	15"	1 1/4"	3 1/4"	8 3/4"	1 1/4"
42"	36"	38"	15"	1 1/4"	6 1/4"	11"	1 1/4"


GUIDE SIGN USE

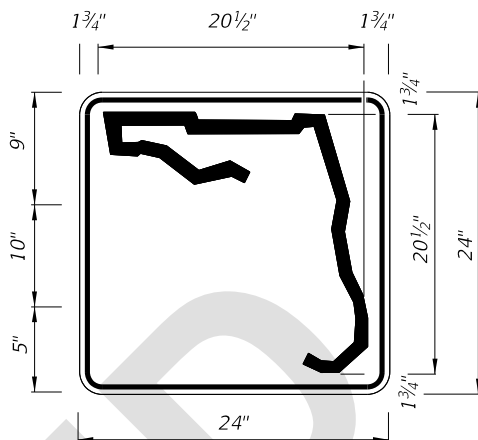FTP-612-25 - FLORIDA ROUTE MARKER



1 or 2 DIGITS

DIGITS	NUMERAL SIZE	SERIES LEGEND	PANEL SIZE
1-2	10"	D	24" x 24"

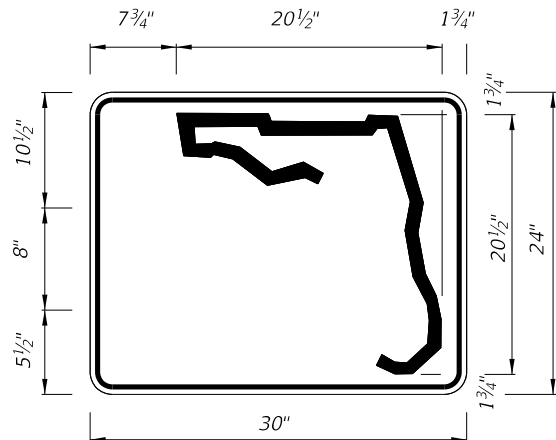

3 or 4 DIGITS

DIGITS	NUMERAL SIZE	SERIES LEGEND	PANEL SIZE
3	8"	D	30" x 24"
4	8"	C	30" x 24"

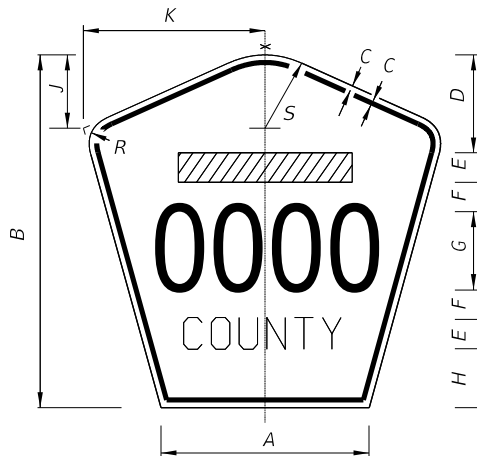
NOTES:

- Stroke width of State Outline shall be 1".
- The 24" X 24" panel shall only be used for a 3 digit route when the panel is to be used on a sign cluster with other 24" X 24" panels.
- 1 1/2" Radii

INDEPENDENT USE OTHER THAN FREEWAY

NOTES:

- Series D Legend, all upper case.
- Color: Yellow Legend and Border on Blue Background.
- When used on a guide sign, marker must be overlaid on a square Yellow Background as shown in chart.
- When two or more County Route Markers are mounted together, use the dimensions of the largest marker for all other markers.














SIGN	DIMENSIONS												Rectangular Yellow Background Dimensions (See Note 3)
	A	B	C	D	E	F	G	H	J	K	R	S	
4 DIGIT POST MOUNTED	25 1/8"	42"	3/4"	10"	4"	4"	8"	8"	8 3/8"	22"	5"	8 3/4"	
2 DIGIT OVERHEAD	21 1/2"	36"	1/2"	7 1/2"	3"	3"	12"	4 1/2"	7 1/8"	18 7/8"	4 1/4"	7 1/2"	42"x 42"
3 DIGIT OVERHEAD	25 1/8"	42"	3/4"	8"	4"	4"	12"	6"	8 3/8"	22"	5"	8 3/4"	48"x 48"
4 DIGIT OVERHEAD	29 7/8"	48"	3/4"	8"	5"	5"	12"	8"	9 3/4"	25 5/8"	5 3/4"	10 1/4"	52"x 52"









FTP-613-25 - COUNTY ROUTE MARKER (M1-6)


Non-Limited Access FTP-614-25 2'-0" X 2'-0" 1.5" Radii 0.75" Border Green Background White Legend, Border and Symbol		Limited Access FTP-614A-25 2'-6" X 2'-6" 1.5" Radii 0.75" Border Green Background White Legend, Border and Symbol		Non-Limited Access FTP-615-25 2'-0" X 2'-0" 1.5" Radii 0.5" Border Green Background White Legend, Border and Symbol		Limited Access FTP-615A-25 2'-6" X 2'-6" 1.5" Radii 0.75" Border Green Background White Legend, Border and Symbol	
Non-Limited Access FTP-616-25 2'-0" X 2'-0" 1.5" Radii 0.75" Border Green Background White Legend, Border and Symbol		Limited Access FTP-616A-25 2'-6" X 2'-6" 1.5" Radii 0.75" Border Green Background White Legend, Border and Symbol					

LAST REVISION 11/01/25	REVISION	DESCRIPTION:	FDOT FY 2026-27 STANDARD PLANS	SPECIAL SIGN DETAILS		INDEX 700-102	SHEET 17 of 21
------------------------------	----------	--------------	---	----------------------	--	------------------	-------------------


---	--

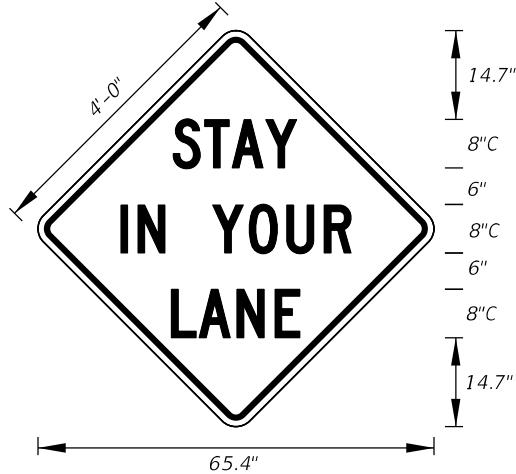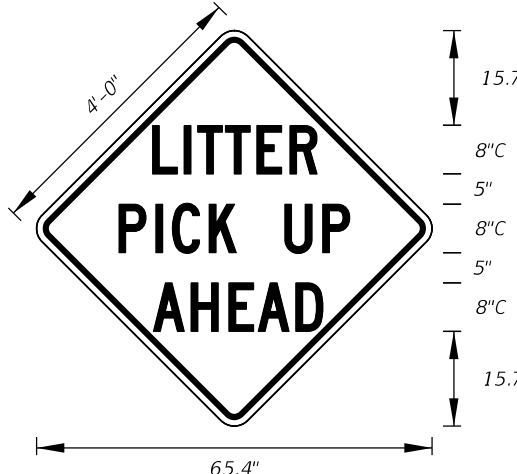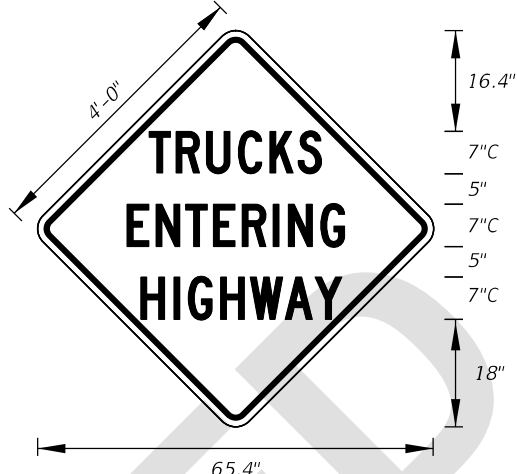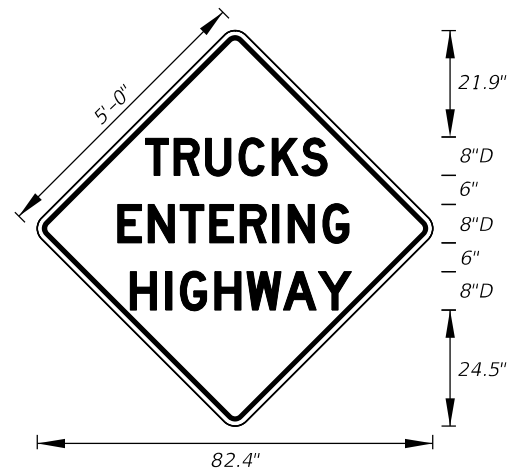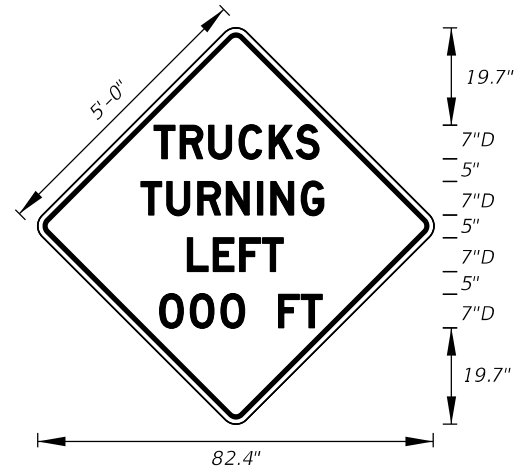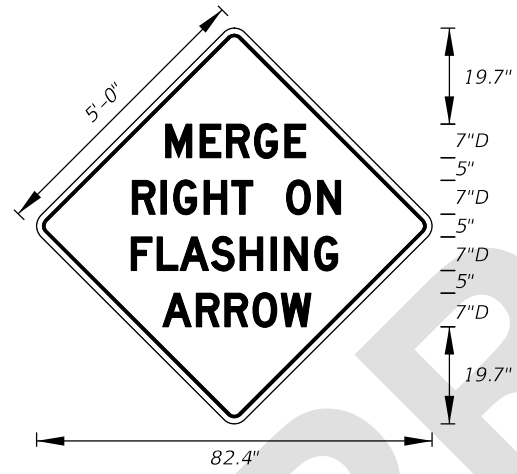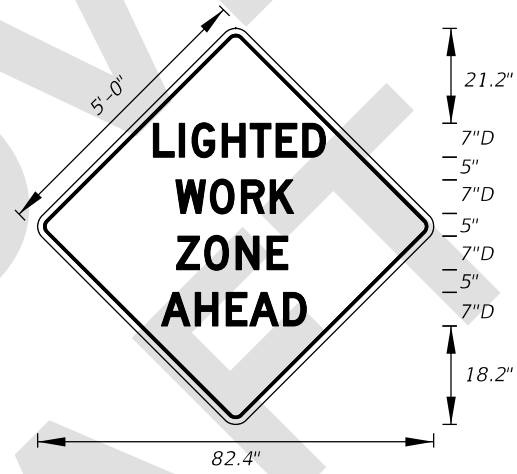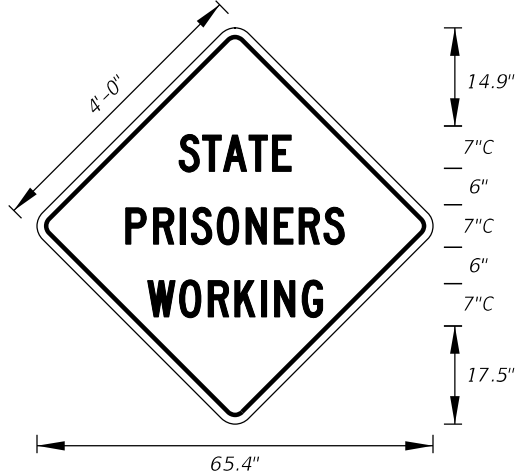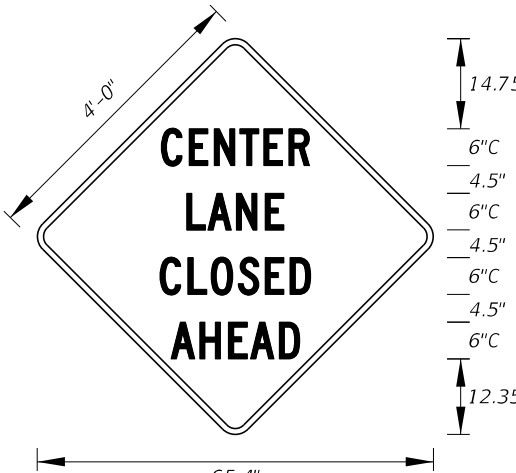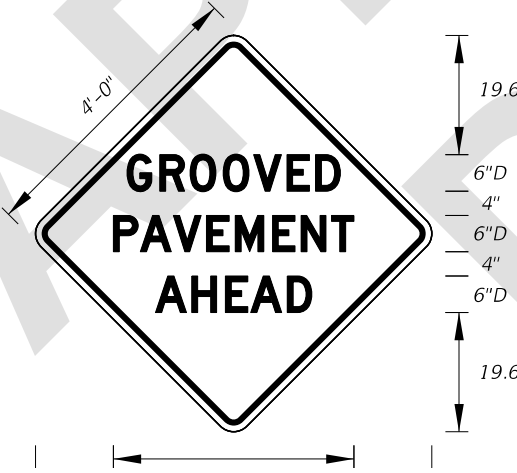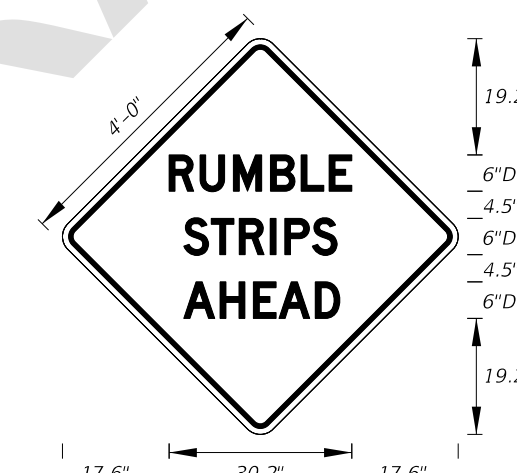 TTC-001-25 4'-0" X 4'-0" 3" Radii 3/4" Border 8" Series C Legend Orange Background Black Legend and Border	 TTC-002-25 4'-0" X 4'-0" 3" Radii 3/4" Border 8" Series C Legend Orange Background Black Legend and Border	 TTC-003-25 4'-0" X 4'-0" 3" Radii 3/4" Border 7" Series C Legend Orange Background Black Legend and Border	 TTC-003A-25 5'-0" X 5'-0" 3" Radii 3/4" Border 8" Series D Legend Orange Background Black Legend and Border
 TTC-004-25 5'-0" X 5'-0" 3" Radii 3/4" Border 7" Series D Legend Orange Background Black Legend and Border	 TTC-005-25 5'-0" X 5'-0" 3" Radii 3/4" Border 7" Series D Legend Orange Background Black Legend and Border	 TTC-006-25 5'-0" X 5'-0" 3" Radii 3/4" Border 7" Series D Legend Orange Background Black Legend and Border	 TTC-007-25 4'-0" X 4'-0" 3" Radii 3/4" Border 7" Series C Legend Orange Background Black Legend and Border
 TTC-008-25 4'-0" X 4'-0" 3" Radii 3/4" Border 6" Series C Legend Orange Background Black Legend and Border	 TTC-009-25 4'-0" X 4'-0" 3" Radii 3/4" Border 6" Series D Legend Orange Background Black Legend and Border	 TTC-010-25 4'-0" X 4'-0" 3" Radii 3/4" Border 6" Series D Legend Orange Background Black Legend and Border	

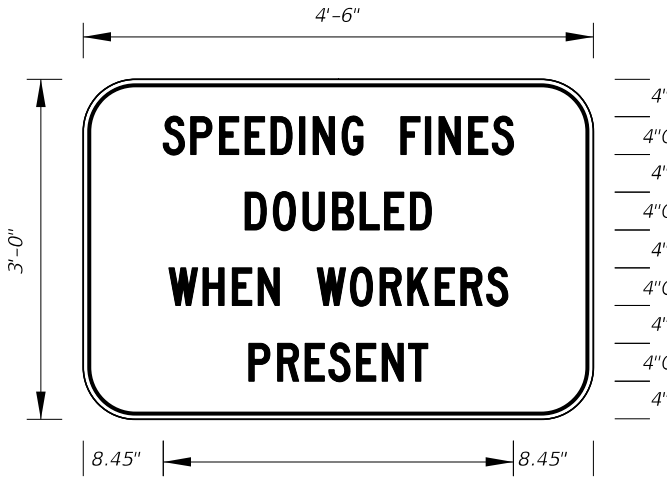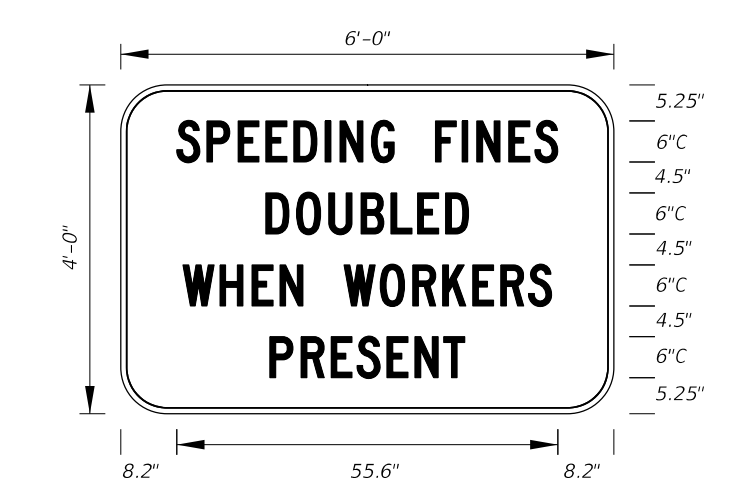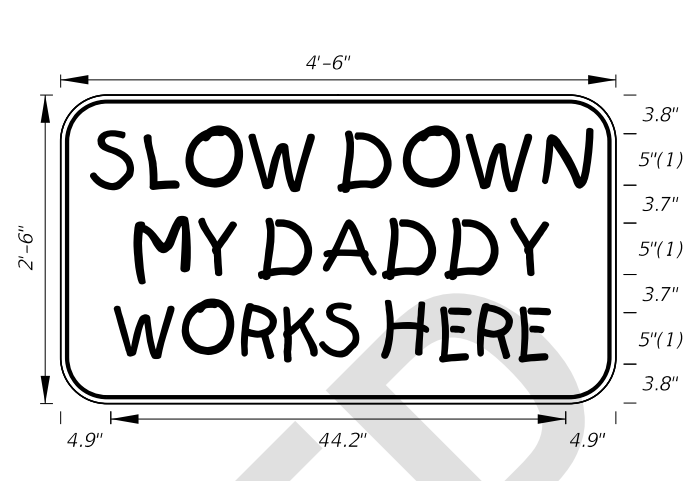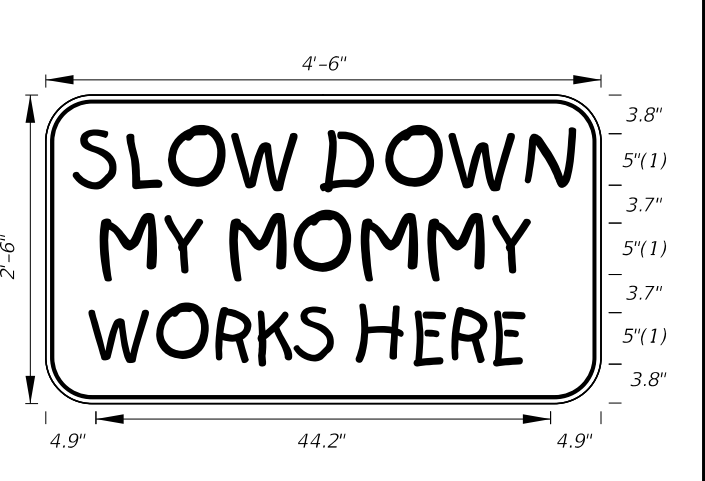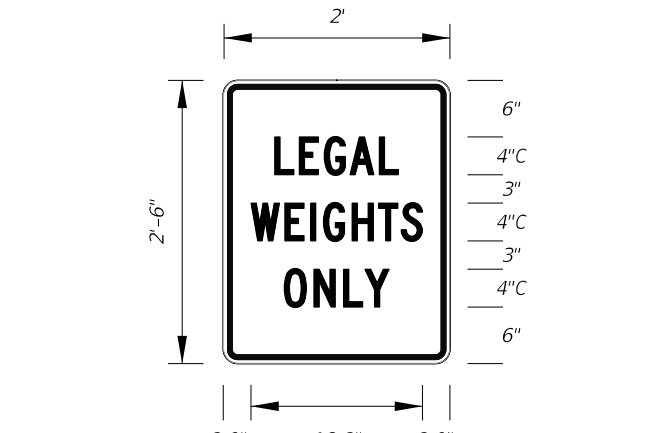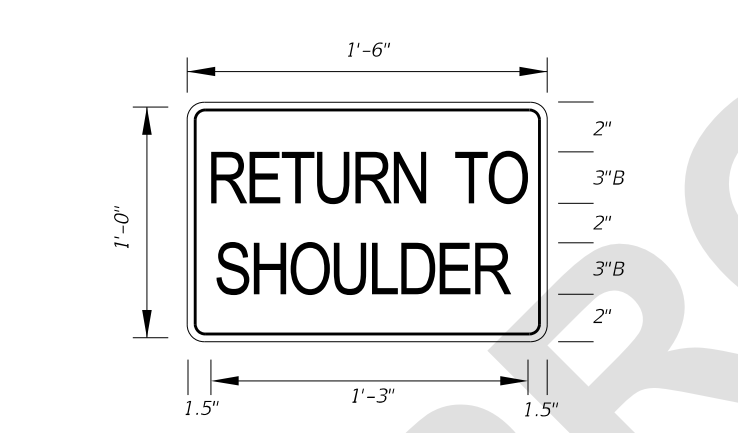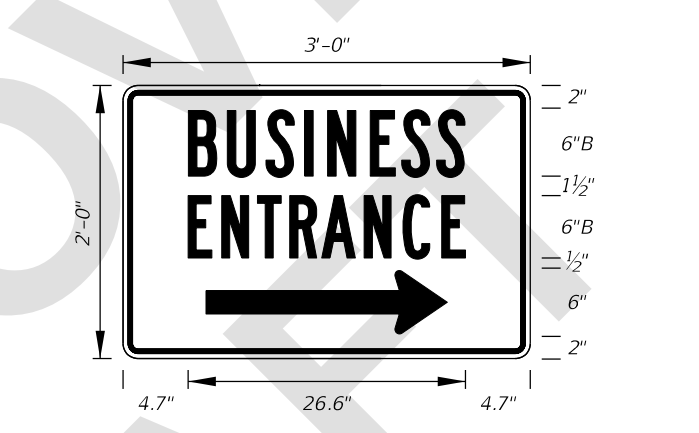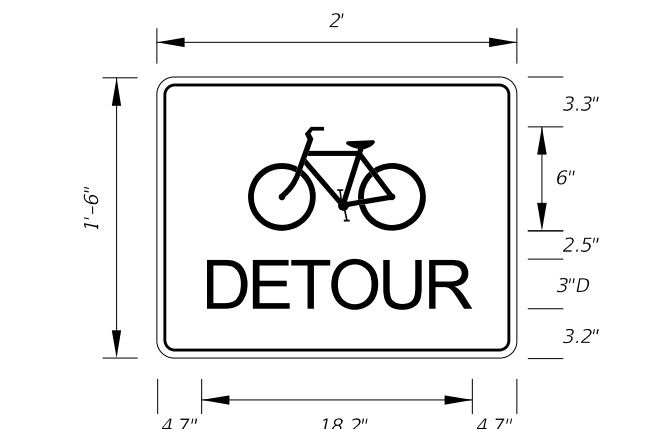
 TTC-011-25 Arterial Sign 4'-6" X 3'-0" 1.5" Radii 3/4" Border 4" Series C Legend White Background Black Legend and Border		 TTC-011A-25 Freeway Sign 6'-0" X 4'-0" 3" Radii 3/4" Border 6" Series C Legend White Background Black Legend and Border		 TTC-012-25 4'-6" X 2'-6" 3" Radii 3/4" Border 5" Kids Series Legend Orange Background Black Legend and Border		 TTC-013-25 4'-6" X 2'-6" 3" Radii 3/4" Border 5" Kids Series Legend Orange Background Black Legend and Border			
 TTC-014-25 2'-0" X 2'-6" 1.5" Radii 3/4" Border 4" Series C Legend White Background Red Legend and Border		 TTC-015-25 1'-6" X 1'-0" 1.5" Radii 1/4" Border 3" Series B Legend Orange Background Black Legend and Border		 TTC-016R-25 TTC-016L-25 3'-0" X 2'-0" 1.5" Radii 3/4" Border 6" Series B Legend Blue Background White Legend and Border		 TTC-017R-25 TTC-017L-25 2'-0" X 1'-0" 1.5" Radii 3/4" Border 2" Series B Legend White Background Black Legend and Border			
 TTC-018-25 2'-0" X 1'-6" 1.5" Radii 1/2" Border 3" Series D Legend Orange Background Black Legend and Border									
LAST REVISION 11/01/25	REVISION	DESCRIPTION:		 FY 2026-27 STANDARD PLANS		SPECIAL SIGN DETAILS		INDEX 700-102	SHEET 20 of 21

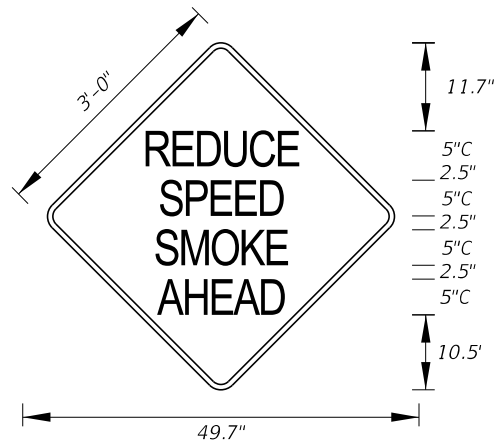

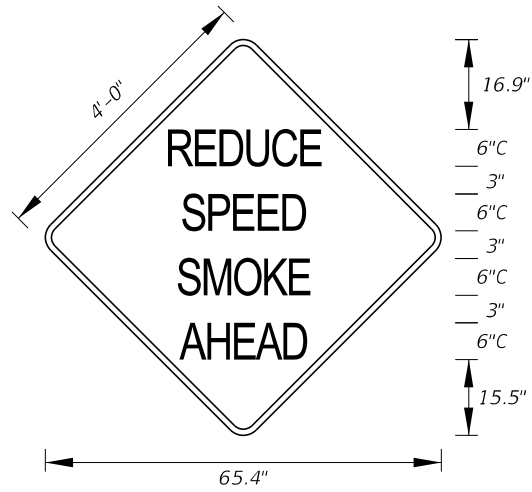
TTC-019-25
3'-0" x 3'-0"
1.5" Radii 0.8" Border
5" Series C Legend
Pink Background
Black Legend and Border



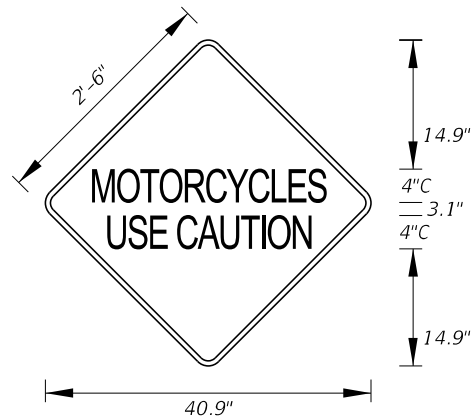
TTC-019A-25
3'-0" x 3'-0"
3" Radii 0.8" Border
6" Series C Legend
Pink Background
Black Legend and Border



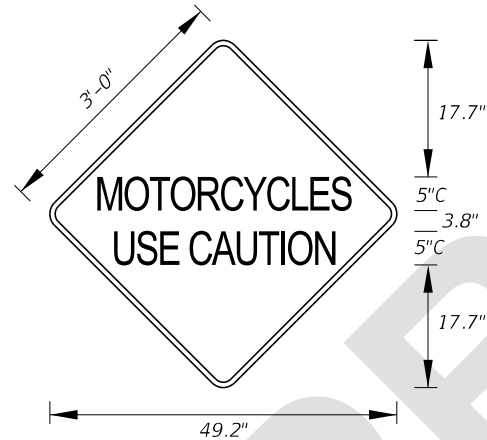TTC-020-25
2'-6" x 2'-6"
1.5" Radii 0.75" Border
4" Series C Legend
Pink Background
Black Legend and Border



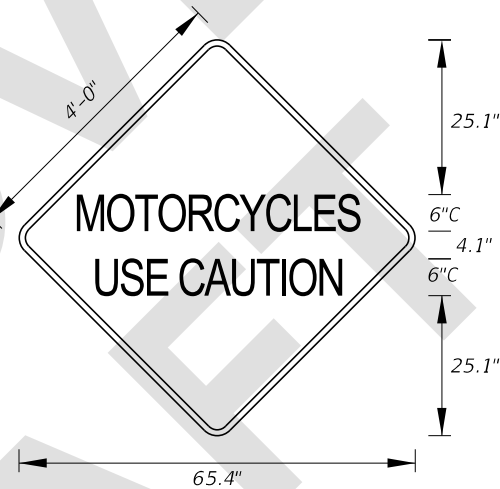TTC-020A-25
3'-0" x 3'-0"
1.5" Radii 0.8" Border
5" Series C Legend
Pink Background
Black Legend and Border



TTC-020B-25
3'-0" x 3'-0"
1.5" Radii 0.8" Border
6" Series C Legend
Pink Background
Black Legend and Border

APPROVED

9/18/2025 4:35:04 PM