

**Origination Form**  
Proposed Revisions to a Standard Plans Index

|                    |                                |                         |                      |
|--------------------|--------------------------------|-------------------------|----------------------|
| <b>Originator:</b> | Portal, Benazir                | <b>Index Number:</b>    | 700-102              |
| <b>Date:</b>       | 7/1/2025                       | <b>Sheet Number(s):</b> | ALL                  |
| <b>E-mail:</b>     | Benazir.Portal@dot.state.fl.us | <b>Index Title:</b>     | Special Sign Details |

**Summary of the changes:**

ALL SHEETS: All FTP and MOT signs were renumbered by sign type and organized numerically; All MOT Signs were updated to TTC Signs; Radii updated on most signs  
Sheet 1: NEW Cover Sheet with Table of Contents and General Notes  
Sheet 2: Added NEW Fender Bender Signs  
Sheet 3: Added NEW Emergency Stopping Site Signs, Added NEW Move Over sign, Updated letter height on Fine \$250 Max sign  
Sheet 4: Added a NEW size for the Fine \$250 Max sign, Removed FTP-85-13  
Sheet 5: Added NEW Crosswalk Signs  
Sheet 6: Updated dimensions on Florida Law Sign  
Sheet 7: Added NEW "X-ING", "ON SIDEWALK", and "MOTORCYCLES USE CAUTION" Signs  
Sheet 8: Added NEW "PRESCRIBED BURN AHEAD" Signs  
Sheet 12: Added NEW Share-A-Ride Signs, Added 2 additional sizes of signs for Emergency Info  
Sheet 13: Added NEW Traffic Info Signs  
Sheet 14: Added NEW Location Reference Marker Sign  
Sheet 15: Removed line through FL symbol on Turnpike Signs  
Sheet 16: Note 4 on the 3 digit Guide Sign was removed and updated to "Width varies with the number scheme combination, within 48"-58" ", Updated Note 1 on the County Route Marker notes to specify "all upper case"  
Sheet 17: Added NEW Guide Signs  
Sheet 18: Added NEW Recreational and Culture Signs; Update FDOT logo on Adopt-A-Highway sign  
Sheet 20: Removed G20-1 and G20-2 Signs  
Sheet 21: Added NEW "REDUCE SPEED SMOKE AHEAD" and "MOTORCYCLES USE CAUTION" Signs

**Commentary/Background:**

Updated naming convention for all signs. Changed all MOT signs to TTC signs. Worked details to clean up inconsistencies, add structure to sign assignment, and allow for an easier addition of new signs. The requested Index updates reflect consistency with MUTCD, TEM, Sign Library and Highway Signing Program.

FTP-85-13 removed because it is already covered in the MUTCD.

MOT Signs G20-1 and G20-2 removed because they are already covered in the MUTCD.

Radii updates based on sign shop direction to better reflect what is done currently.

Any Indexes with references to these FTP and MOT numbers have also been updated accordingly.

| Other Affected Documents/Offices | Person Contacted          | Affected (Yes/No) |
|----------------------------------|---------------------------|-------------------|
| Other Standard Plans             | Rick Jenkins & Shae Gibbs | Yes               |
| FDOT Design Manual               | Mark Musselman            | Yes               |

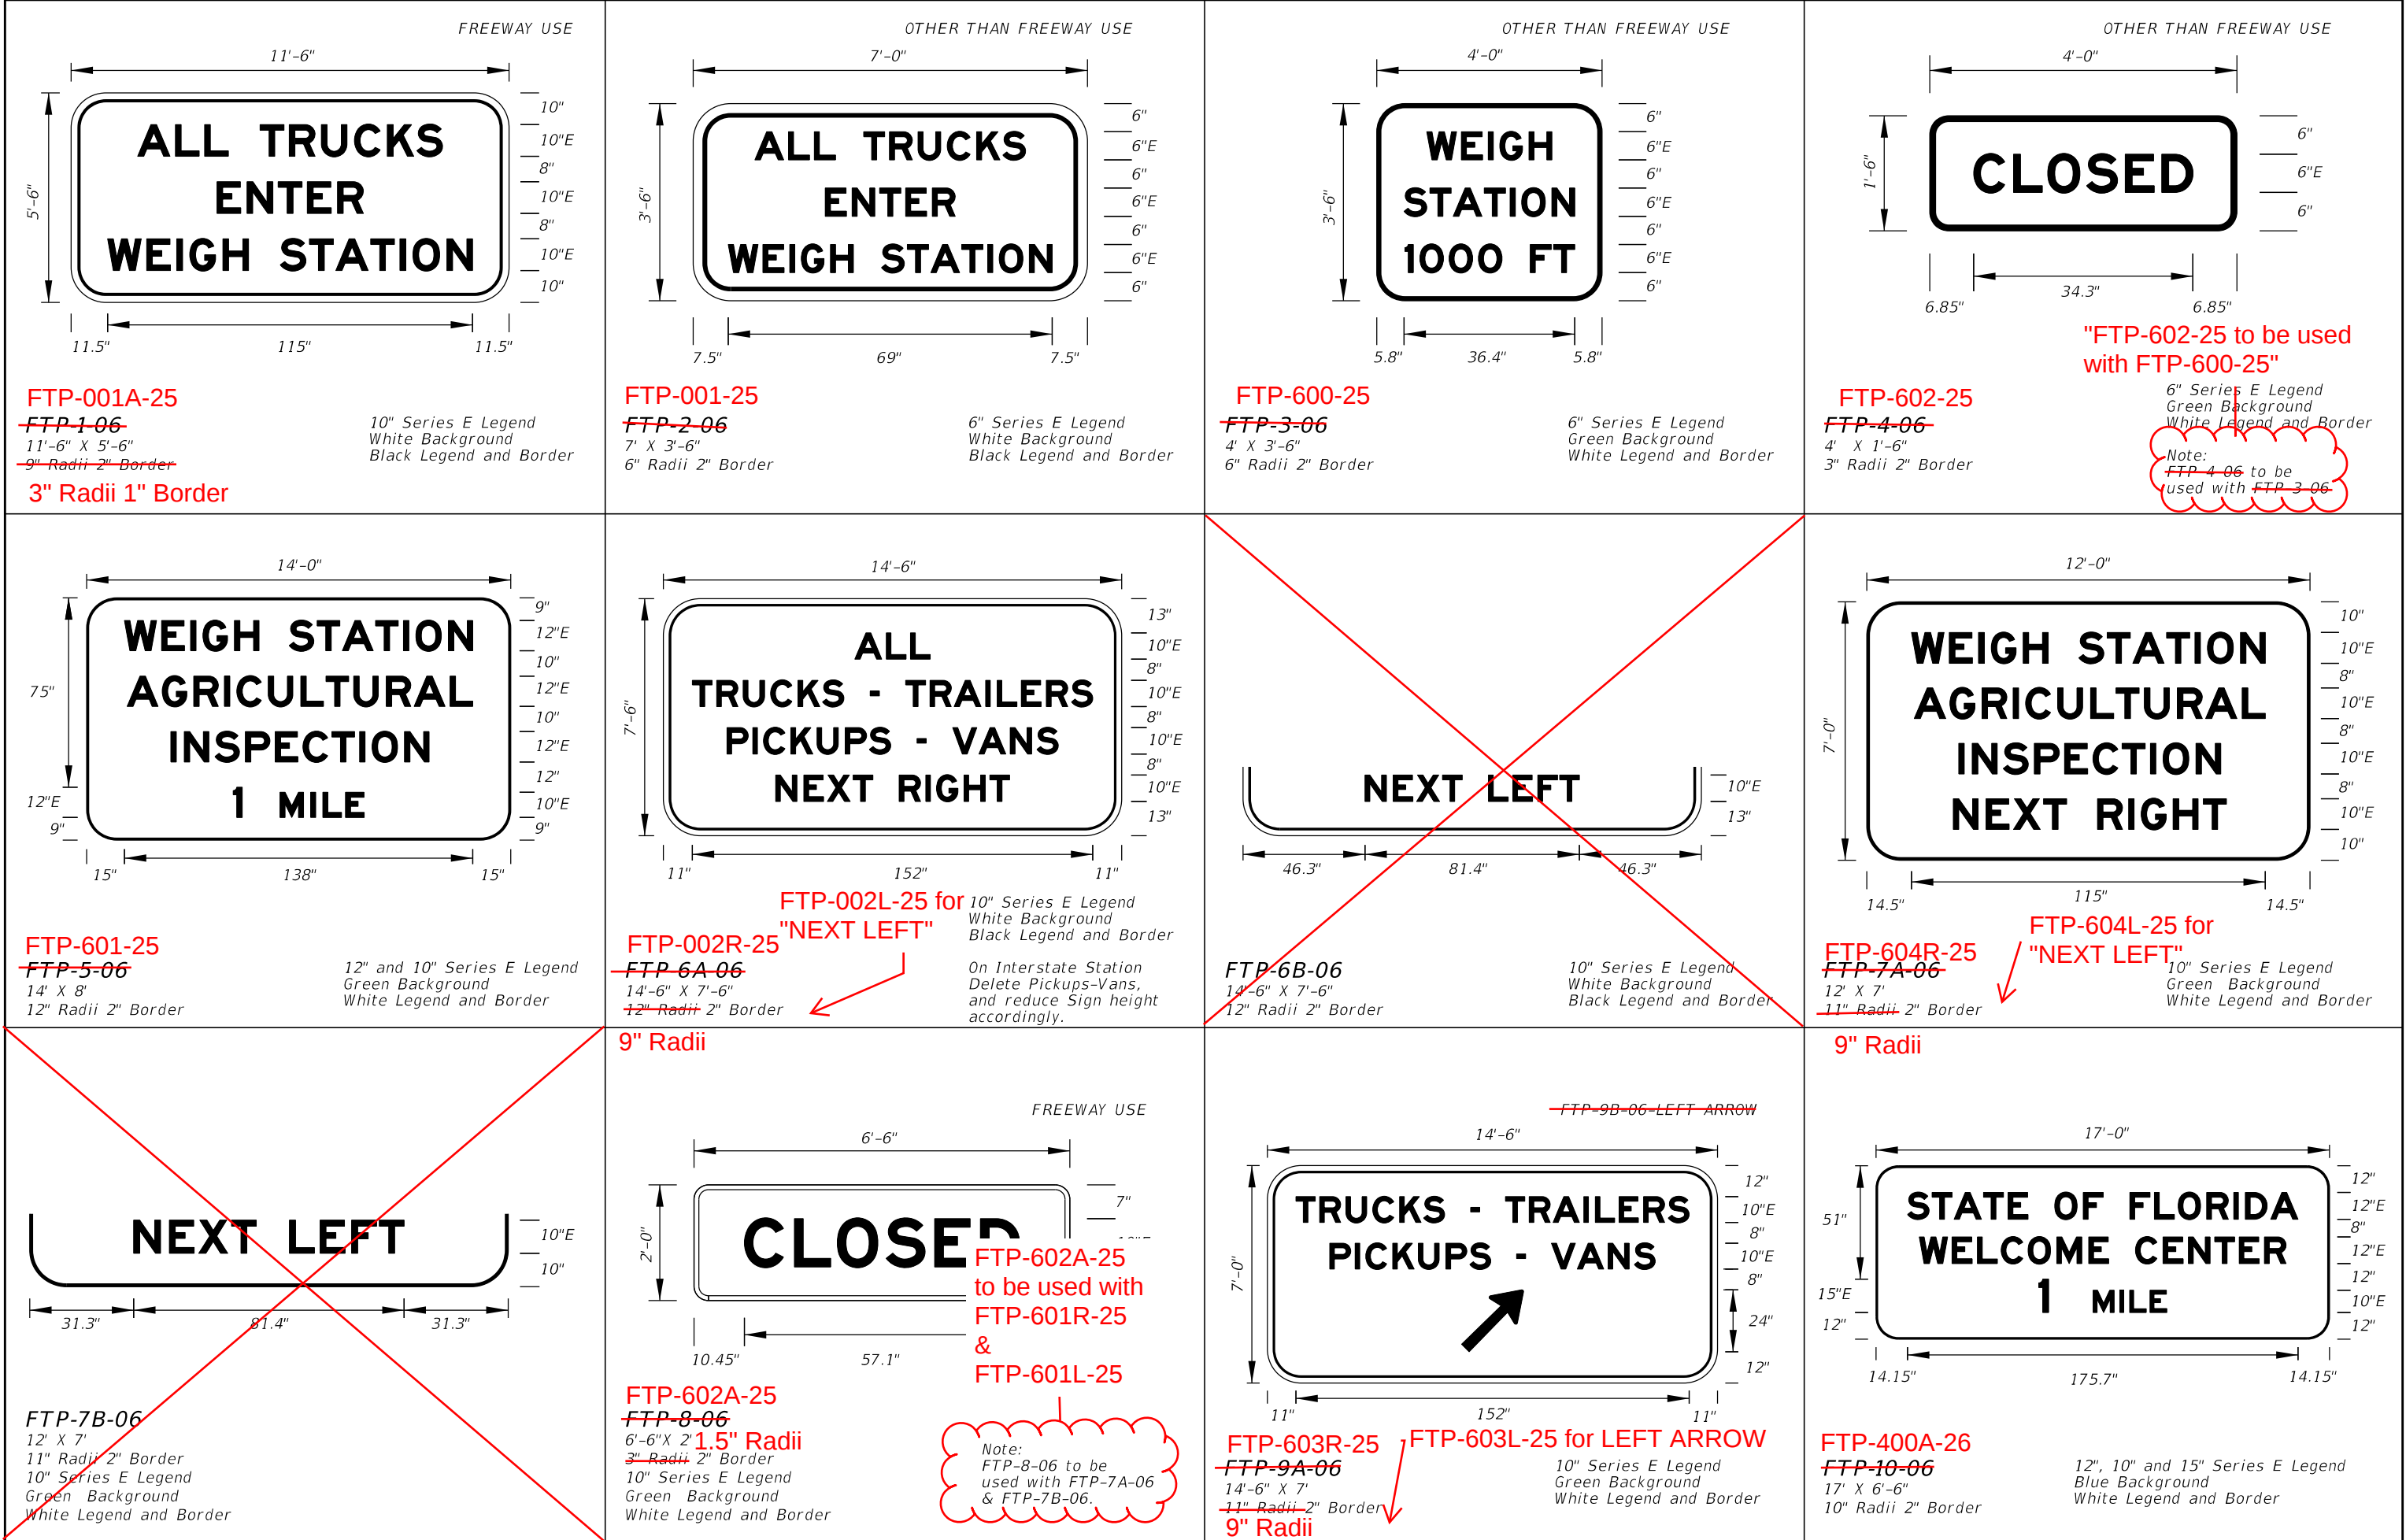
|                           |                   |     |
|---------------------------|-------------------|-----|
| Standard Specifications   | Daniel Strickland | No  |
| Basis of Estimates Manual |                   | No  |
| Approved Product List     |                   | No  |
| Construction Office       | Ryan Buck         | Yes |
| Maintenance Office        |                   | No  |

|                                      |
|--------------------------------------|
| Implementation                       |
| ["FY-Standard Plans (Next Release)"] |

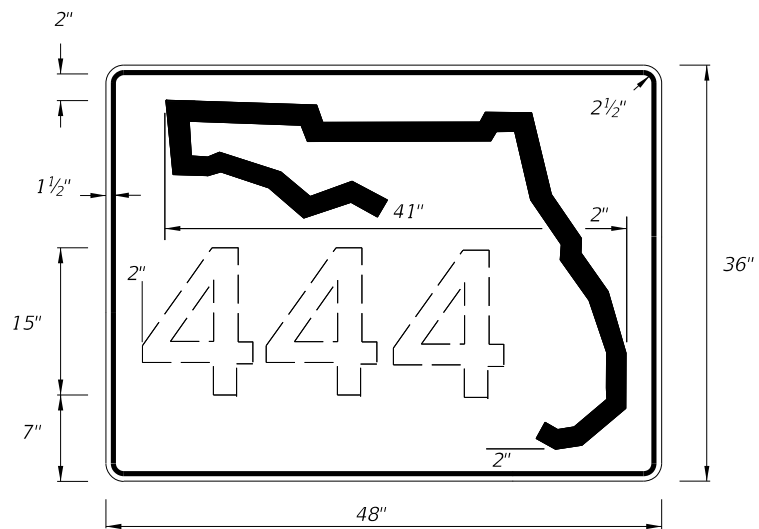
NEW Cover Sheet

ADDED: Table of Contents and  
General Notes

REDEVELOPED: Renumbered Signs by  
Sign Type and Organized Numerically








| DIGITS | NUMERAL SIZE | SERIES LEGEND | PANEL SIZE |
|--------|--------------|---------------|------------|
| 1-3    | 15"          | C             | 48" x 36"  |
| 4      | 12"          | C             | 48" x 36"  |


NOTES:

- Stroke width of State Outline shall be 1".
- 2 1/2" Radii

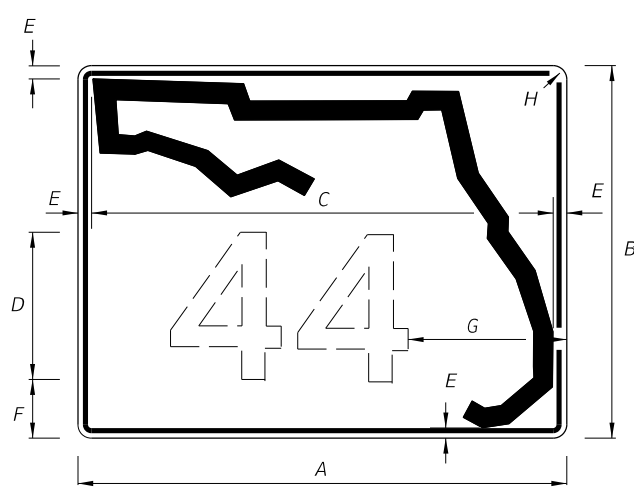INDEPENDENT USE FOR FREEWAY



1 OR 2 DIGITS

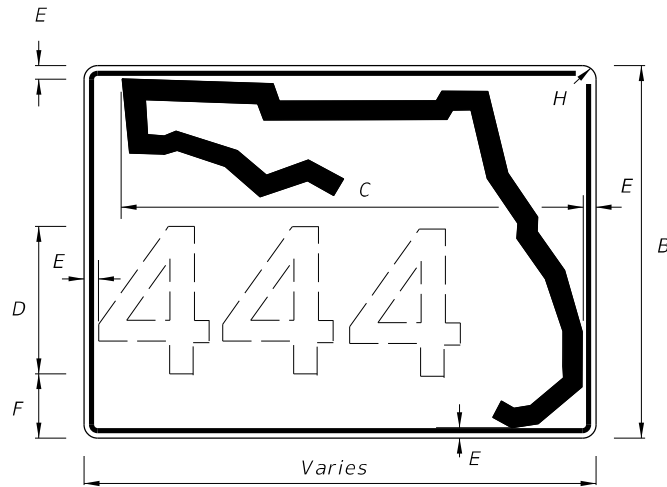

3 OR MORE DIGITS

NOTES:

- Florida marker shall have Black Legend with White Background.
- Stroke width of State outline shall be 1 3/4" for Guide Sign.
- Series D Legend.

~~4. 5/8" Border~~

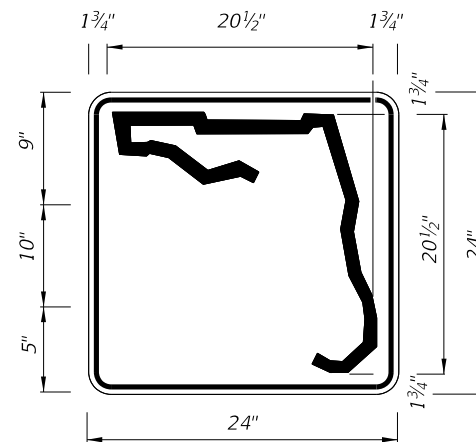
4. Width varies with the number scheme combination, within a range of 48"-58"

FTP-612-25

GUIDE SIGN USE


~~FTP-17-06~~

- FLORIDA ROUTE MARKER



1 or 2 DIGITS

| DIGITS | NUMERAL SIZE | SERIES LEGEND | PANEL SIZE |
|--------|--------------|---------------|------------|
| 1-2    | 10"          | D             | 24" x 24"  |

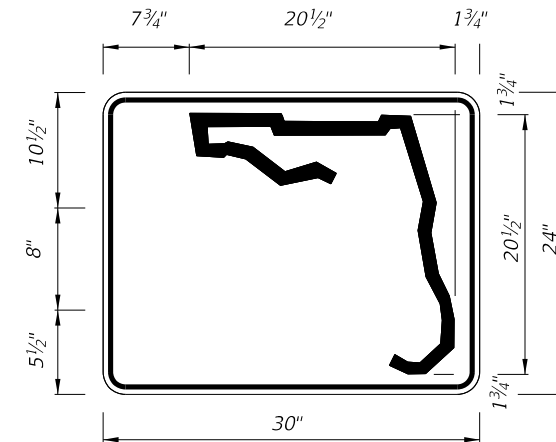

3 or 4 DIGITS

| DIGITS | NUMERAL SIZE | SERIES LEGEND | PANEL SIZE |
|--------|--------------|---------------|------------|
| 3      | 8"           | D             | 30" x 24"  |
| 4      | 8"           | C             | 30" x 24"  |

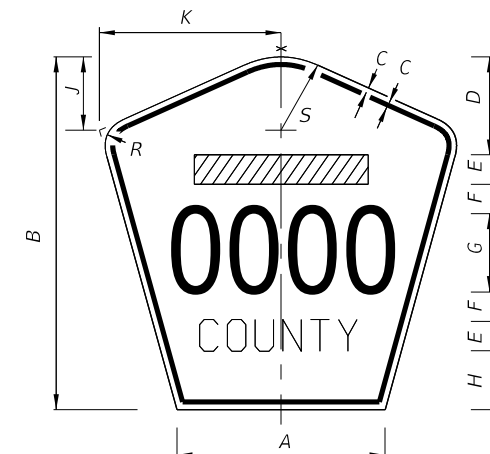
NOTES:

- Stroke width of State Outline shall be 1".
- The 24" X 24" panel shall only be used for a 3 digit route when the panel is to be used on a sign cluster with other 24" X 24" panels.
- 1 1/2" Radii

INDEPENDENT USE OTHER THAN FREEWAY

NOTES:

- Series D Legend. **all upper case**
- Color: Yellow Legend and Border on Blue Background.
- When used on a guide sign, marker must be overlaid on a rectangular Yellow Background as shown in chart.
- When two or more County Route Markers are mounted together, use the dimensions of the largest marker for all other markers.



| SIGN                 | DIMENSIONS |     |      |        |    |    |     |        |        |         |        |         | Rectangular Yellow Background Dimensions (See Note 3) |
|----------------------|------------|-----|------|--------|----|----|-----|--------|--------|---------|--------|---------|-------------------------------------------------------|
|                      | A          | B   | C    | D      | E  | F  | G   | H      | J      | K       | R      | S       |                                                       |
| 4 DIGIT POST MOUNTED | 25 1/8"    | 42" | 3/4" | 10"    | 4" | 4" | 8"  | 8"     | 8 3/8" | 22"     | 5"     | 8 3/4"  |                                                       |
| 2 DIGIT OVERHEAD     | 21 1/2"    | 36" | 1/2" | 7 1/2" | 3" | 3" | 12" | 4 1/2" | 7 1/8" | 18 1/8" | 4 1/4" | 7 1/2"  | 42"x 42"                                              |
| 3 DIGIT OVERHEAD     | 25 1/8"    | 42" | 3/4" | 8"     | 4" | 4" | 12" | 6"     | 8 3/8" | 22"     | 5"     | 8 3/4"  | 48"x 48"                                              |
| 4 DIGIT OVERHEAD     | 29 7/8"    | 48" | 3/4" | 8"     | 5" | 5" | 12" | 8"     | 9 3/4" | 25 5/8" | 5 3/4" | 10 1/4" | 52"x 52"                                              |

FTP-613-25

~~FTP-18-06~~

- COUNTY ROUTE MARKER (M1-6)

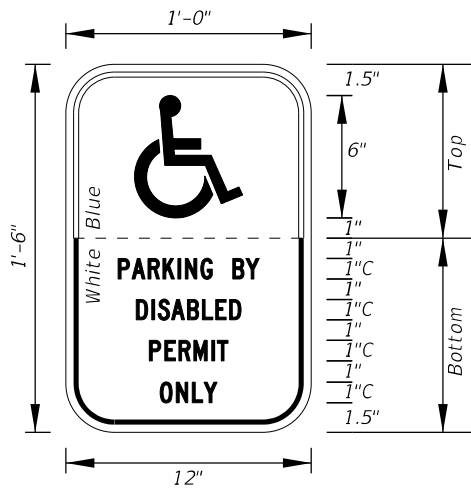
9/10/2024 2:49:51 PM

FTP-016-25  
~~FTP-19-06~~  
1' X 1'-6" 1.5" Radii  
~~4" Radii 3/8" Border~~  
Top 4" Series D  
Bottom 2" Series C  
White Background  
Green Legend and Border




All Letters  
1" Series C  
1" Spacing  
Between Lines  
of Text  
FTP-017-25  
~~FTP-20-06~~  
1' X 1'-6" 1.5" Radii  
~~2" Radii 3/8" Border~~  
1" Series C Legend  
Color  
Background  
Legend and Border

Top Bottom  
Blue White  
White Black




All Letters  
1.5" Series C  
1" Spacing  
Between Lines  
of Text  
FTP-018-25  
~~FTP-21-06~~  
1'-6" X 2'-6" 1.5" Radii  
~~2" Radii 3/8" Border~~  
1.5" Series C Legend  
Color  
Background  
Legend and Border

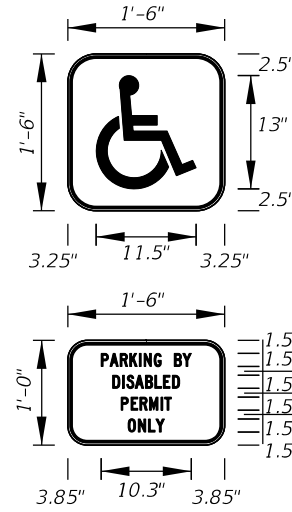Top Bottom  
Blue White  
White Black




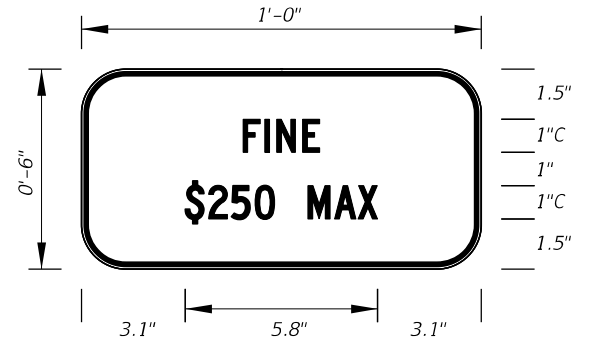FTP-019-25  
~~FTP-22-06~~  
1' X 6" 1.5" Radii  
~~1" Radii 3/8" Border~~  
1" Series C Legend  
White Background  
Black Legend and Border




Supplemental Panel  
for the FTP-20-06  
and FTP-21-06 signs

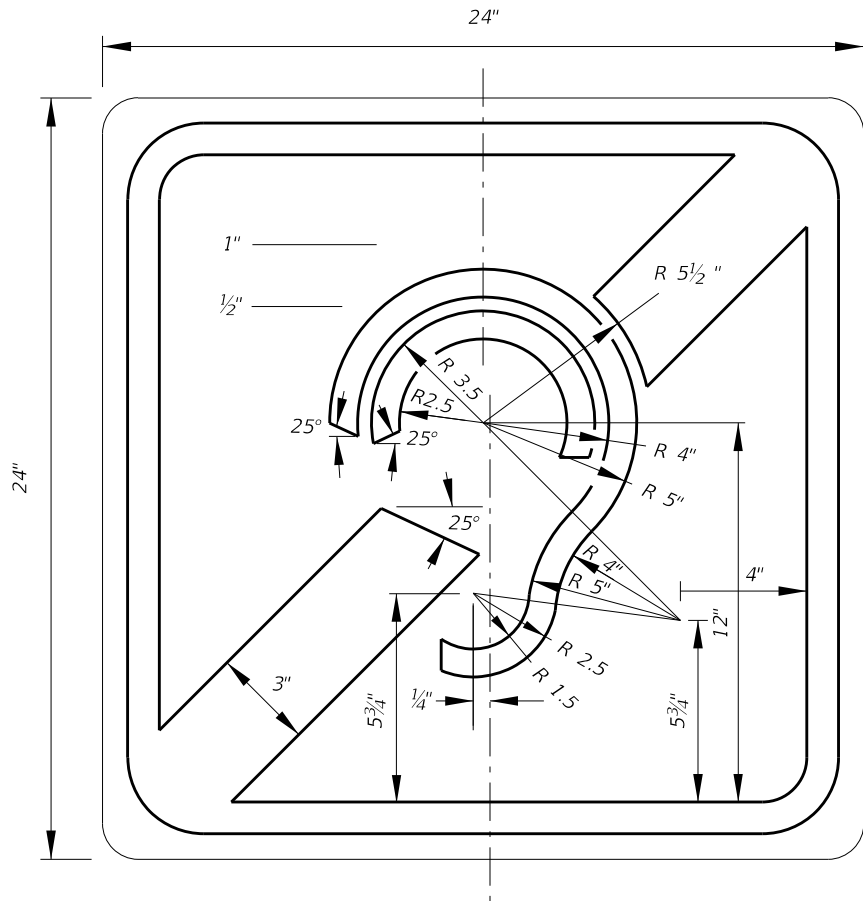FTP-416-25  
~~FTP-23-06~~  
2' X 2'  
1.5" Radii 5/8" Border  
Blue Background  
White Legend and Border



INTERNATIONAL SYMBOL OF  
ACCESS FOR HEARING LOSS

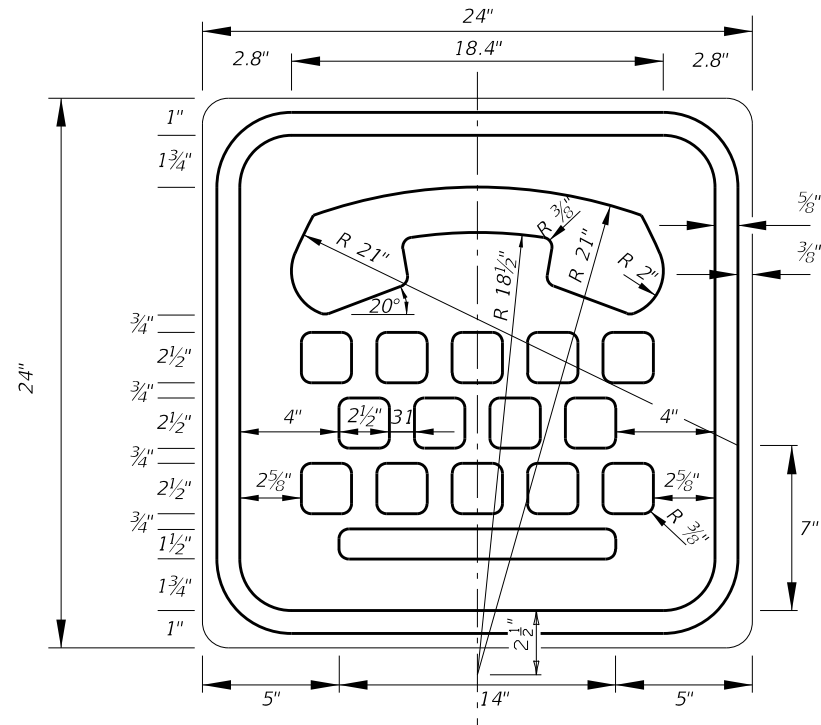FTP-417-25  
~~FTP-24-06~~  
2' X 2'  
1.5" Radii 5/8" Border  
Blue Background  
White Legend and Border



INTERNATIONAL TDD SYMBOL

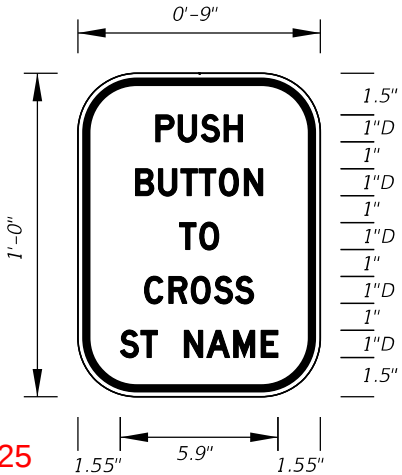
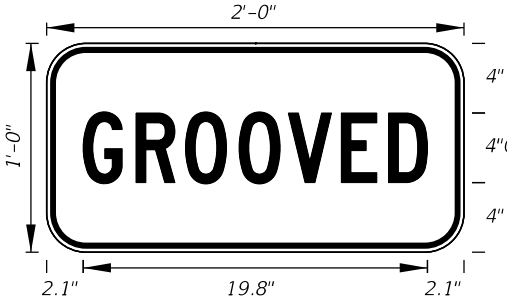
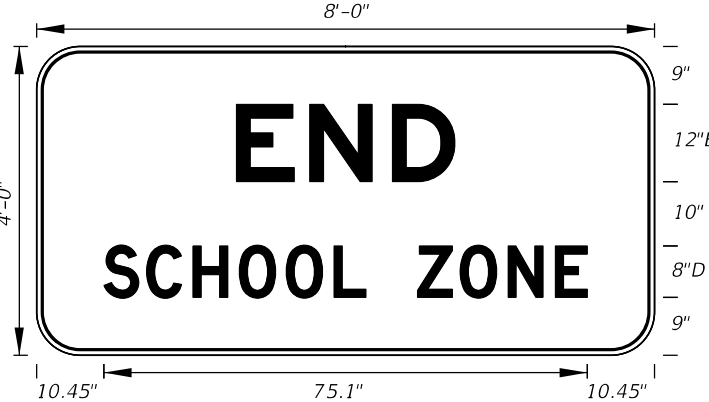
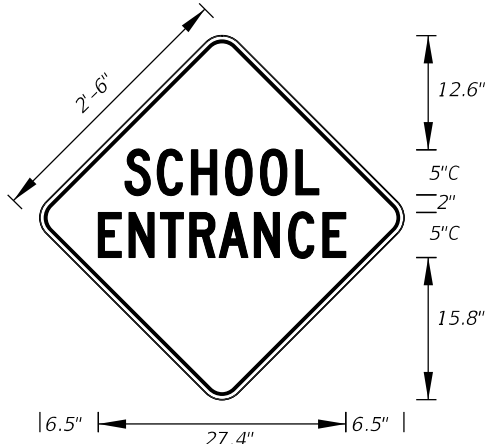
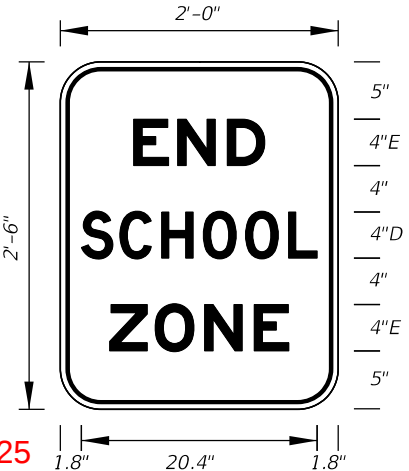
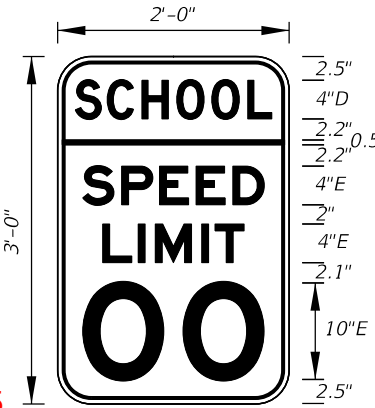
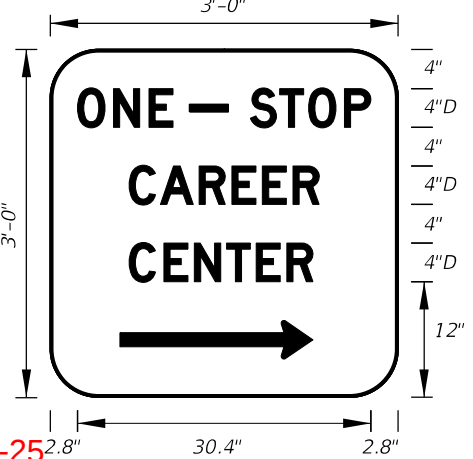
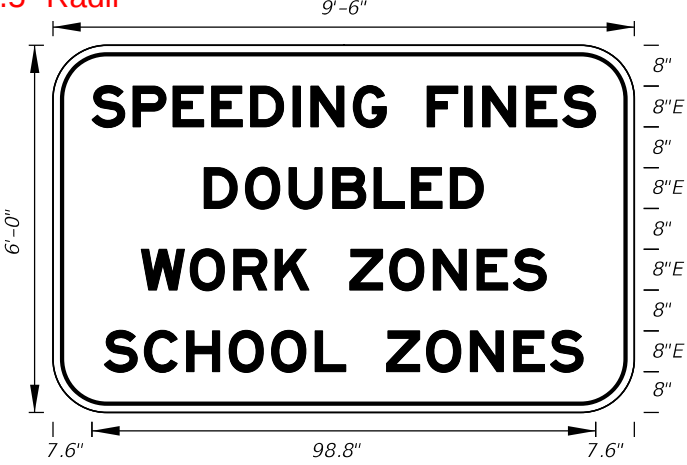
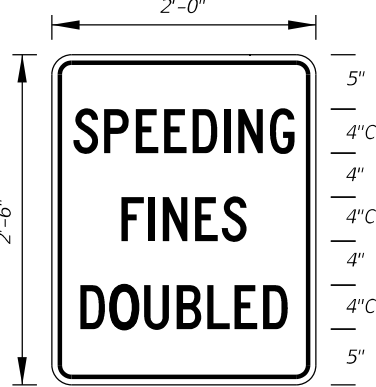
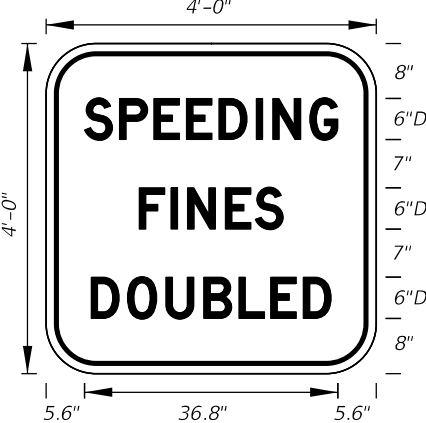


FY ~~2025-26~~ 2026-27  
STANDARD PLANS

SPECIAL SIGN DETAILS

INDEX  
700-102

11 SHEET 21  
4 of 12

|   |   |   |   |
|---|---|---|---|
|  <p><b>FTP-030-25</b><br/> <del>FTP-25-06</del><br/>           9" X 1'-0" <b>1.5" Radii</b><br/> <del>2" Radii</del> 3/8" Border<br/>           1" Series D Legend<br/>           White Background<br/>           Black Legend and Border</p>                        |  <p><b>FTP-014-25</b><br/> <del>FTP-29-06</del><br/>           2'-0" X 1'-0" <b>1.5" Radii</b><br/> <del>2" Radii</del> 5/8" Border<br/>           4" Series C Legend<br/>           Yellow Background<br/>           Black Legend and Border</p>             |  <p><b>FTP-023-25</b><br/> <del>FTP-31-06</del><br/>           8' X 4' <b>3" Radii</b><br/> <del>6" Radii</del> 3/4" Border<br/>           Series D Legend</p> <p>Fluorescent Yellow-Green Background Top<br/>           White Background Bottom<br/>           Black Legend and Border</p> <p>Span wire placement<br/> <del>Optional Location</del><br/>           of 12" Yellow Signal</p> |  <p><b>FTP-024A-25</b><br/> <del>FTP-32-06</del><br/>           8' X 4' <b>3" Radii</b><br/> <del>6" Radii</del> 3/4" Border</p> <p>12" Series E and 8" Series D Legend<br/>           White Background<br/>           Black Legend and Border</p> |
|  <p><b>FTP-201-25</b><br/> <del>FTP-33-06</del><br/>           2'-6" X 2'-6" <b>1.5" Radii</b><br/> <del>2" Radii</del> 3/4" Border</p> <p>5" Series C Legend<br/>           Fluorescent Yellow-Green Background<br/>           Black Legend and Border</p>        |  <p><b>FTP-024-25</b><br/> <del>FTP-34-06</del><br/>           2' X 2'-6" <b>1.5" Radii</b><br/> <del>3" Radii</del> 5/8" Border<br/>           4" Series D and E Legend<br/>           White Background<br/>           Black Legend and Border</p>          |  <p><b>FTP-022-25</b><br/> <del>FTP-35-06</del><br/>           2' X 3' <b>1.5" Radii</b><br/> <del>3" Radii</del> 5/8" Border<br/>           Top 4" Series D Legend<br/>           Bottom 4" and 10" Series E Legend<br/>           Fluorescent Yellow-Green Background Top<br/>           White Background Bottom<br/>           Black Legend and Border</p>                              |  <p><b>FTP-606-25</b><br/> <del>FTP-36-06</del><br/>           3' X 3' <b>1.5" Radii</b><br/> <del>5" Radii</del> 1" Border<br/>           4" Series D Legend<br/>           Green Background<br/>           White Legend and Border</p>         |
|  <p><b>FTP-020-25</b><br/> <del>FTP-37-06</del><br/>           9'-6" X 6' <b>1.5" Radii</b><br/>           9" Radii 2" Border<br/>           8" Series E Legend<br/>           White Background<br/>           Black Legend and Border</p> <p>State Line Sign</p> |  <p><b>FTP-021-25</b><br/> <del>FTP-38-22</del><br/>           2' X 2'-6" <b>1.5" Radii</b><br/>           1.5" Radii 1/2" Border<br/>           4" Series C Legend 80% Spacing<br/>           White Background<br/>           Black Legend and Border</p> |  <p><b>FTP-021A-25</b><br/> <del>FTP-39-06</del><br/>           4' X 4' <b>3" Radii</b><br/> <del>6" Radii</del> 3/4" Border<br/>           6" Series D Legend<br/>           White Background<br/>           Black Legend and Border</p> <p>Freeway Sign</p>   |  <p><b>FTP-015A-25</b><br/> <del>FTP-40-21</del><br/>           3'-6" X 4' <b>1.5" Radii</b><br/> <del>6" Radii</del> 3/4" Border</p> <p>3" and 6" Series C Legend<br/>           White Background<br/>           Black Legend and Border</p>   |
| <div> <div> <div>LAST</div> <div>REVISION</div> <div>11/01/21</div> <div>11/01/25</div> </div> <div>REVISION</div> </div> <div>DESCRIPTION:</div>   | <div> <div>FY <del>2025-26</del> 2026-27</div> <div>STANDARD PLANS</div> </div>   | <div>SPECIAL SIGN DETAILS</div>   | <div> <div>INDEX</div> <div>700-102</div> <div>SHEET</div> <div>5 of 21</div> </div>   |

9/10/2024 2:50:06 PM

~~FTP-015-25~~  
~~FTP-41-21~~  
2'-6" X 3'  
~~4" Radii~~ 3/4" Border  
1.5" Radii

2" and 4" Series C Legend  
White Background  
Black Legend and Border

~~FTP-801-25~~  
~~FTP-42-06~~  
4' X 2'-6"  
~~3" Radii~~ 1.5" Radii  
Top 4" Series C Legend

Bottom 2" Series EM Legend  
White Background  
Blue Legend and Border

~~FTP-413-25~~  
~~FTP-43-06~~  
4' X 4'  
~~6" Radii~~ 1" Border  
Top 4" Series D Legend

Bottom 6" Series D Legend  
Blue Background  
White Legend and Border

~~FTP-004A-25~~  
~~FTP-44-06~~  
9' X 6'  
9" Radii 3/4" Border

8" Series D Legend  
White Background  
Black Legend and Border

~~FTP-004-25~~  
~~FTP-44A-25~~  
4' X 3'  
~~5" Radii~~ 3/4" Border

4" Series C Legend  
White Background  
Black Legend and Border

~~FTP-45-25~~ ~~FTP-006-25~~  
4'-0" X 4'-0"  
1.5" Radii  
0.4" Border

2.5" Series C Legend  
2" Series C Legend  
1.5" Series C Legend and  
White Background  
Black Legend and Border

~~FTP-005A-25~~  
~~FTP-46-06~~  
3' X 4'  
~~5" Radii~~ 3/4" Border  
3" Series D Legend  
White Background  
Green Florida Symbol  
Black Legend, Border and Man Belt Symbol

~~FTP-005-25~~  
~~FTP-47-06~~  
2' X 2'-6"  
1.5" Radii  
~~3" Radii~~ 3/8" Border  
2" Series D Legend  
White Background  
Green Florida Symbol  
Black Legend, Border and Man Belt Symbol

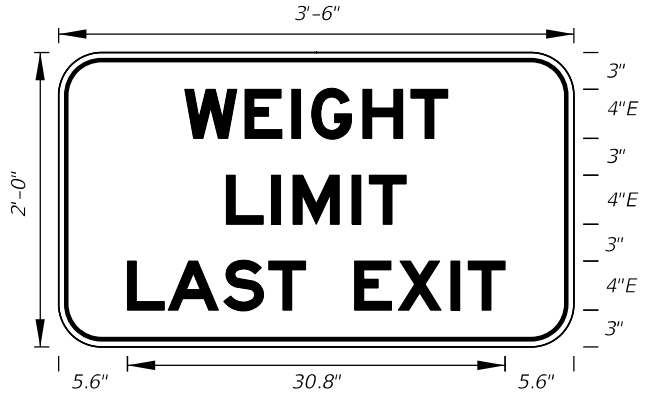
~~FTP-607-25~~  
~~FTP-48-06~~  
3'-6" X 5'  
~~6" Radii~~ 1.5" Radii  
4" Series C Legend  
Green Background  
White Legend, Border and Symbol

~~FTP-608-25~~  
~~FTP-49-06~~  
3'-6" X 5'-6"  
~~6" Radii~~ 3" Radii  
4" Series C Legend  
Green Background  
Municipality Name Optional  
White Legend, Border and Symbol

~~FTP-607-25~~ ~~FTP-608-25~~  
Detail for ~~FTP-48-06~~ and ~~FTP-49-06~~

~~FTP-50-06~~ ~~FTP-200-25~~  
4'-6" X 2'-0"  
1.5" Radii  
~~3" Radii~~ 3/4" Border  
4" Series C Legend  
Yellow Background  
Black Legend and Border

9/10/2024 2:50:13 PM



3'-6"

2'-0"

3"

4"E

3"

4"E

3"

4"E

3"

5.6"

30.8"

5.6"

**FTP-003-25**

~~FTP-51-06~~

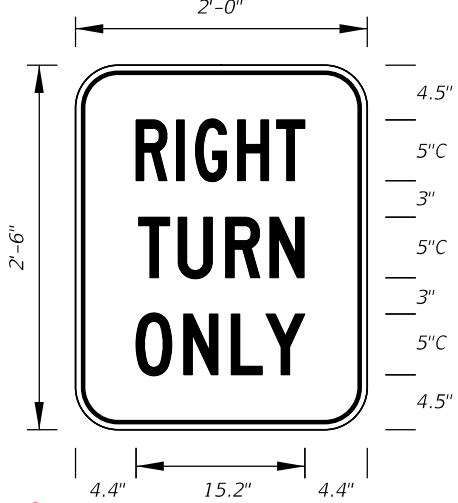
3' X 2'

~~3" Radii~~ 3/4" Border

4" Series E Legend

White Background

Black Legend and Border



2'-0"

2'-6"

4.5"

5"C

3"

5"C

3"

5"C

3"

5"C

4.5"

4.4"

15.2"

4.4"

**FTP-035R-25**

~~FTP-52-06~~

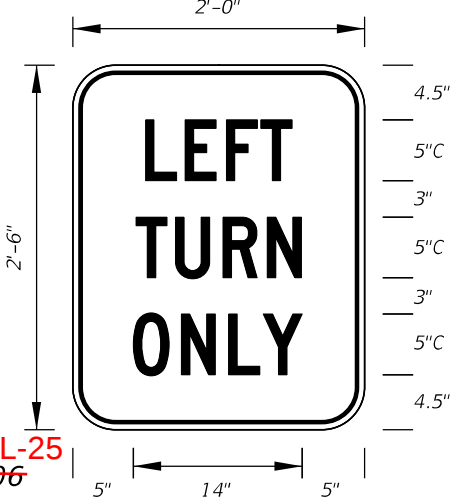
2' X 2'-6"

~~3" Radii~~ 5/8" Border

5" Series C Legend

White Background

Black Legend and Border



2'-0"

2'-6"

4.5"

5"C

3"

5"C

3"

5"C

3"

5"C

4.5"

5"

14"

5"

**FTP-035L-25**

~~FTP-53-06~~

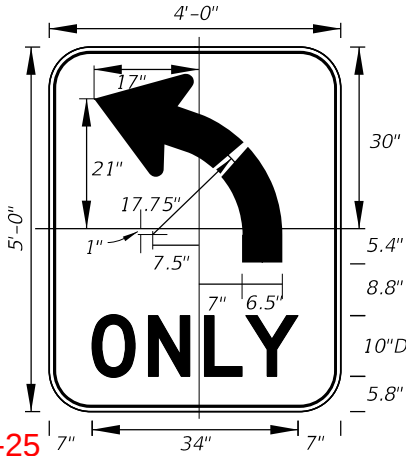
2' X 2'-6"

~~3" Radii~~ 5/8" Border

5" Series C Legend

White Background

Black Legend and Border



4'-0"

5'-0"

30"

5.4"

8.8"

10"D

5.8"

7"

34"

7"

17"

21"

17.75"

1"

7.5"

7"

6.5"

**FTP-034L-25**

~~FTP-54L-06~~

4' X 5'

~~6" Radii~~ 3/4" Border

10" Series D Legend

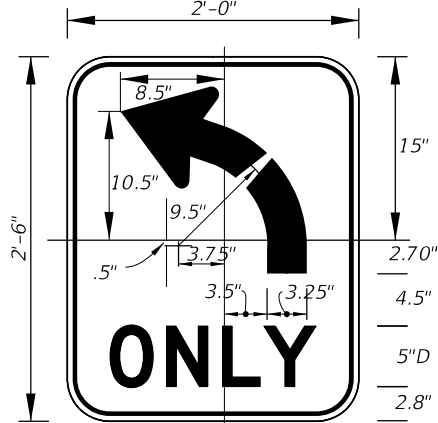
White Background

Black Legend and Border

**FTP-037R-25**

~~FTP-54R-06~~

for (Right Turn Arrow)



2'-0"

2'-6"

15"

2.70"

4.5"

5"D

2.8"

8.5"

10.5"

9.5"

3.75"

.5"

3.5"

3.25"

17"

3.5"

**FTP-034AL-25**

~~FTP-55L-06~~

2' X 2'-6"

**1.5" Radii**

~~3" Radii~~ 3/8" Border

5" Series D Legend

White Background

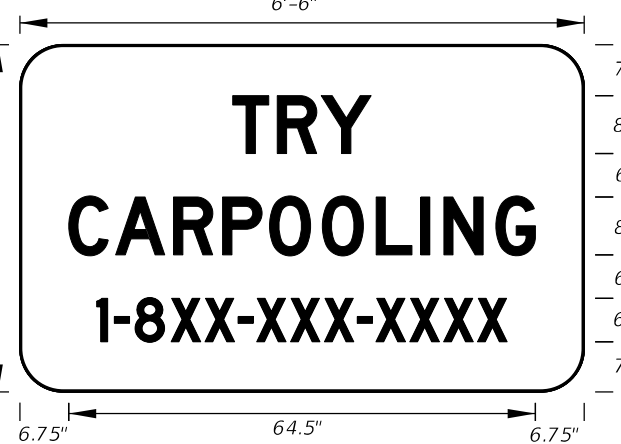
Black Legend and Border

**FTP-037A-R-25**

~~FTP-55R-06~~

for (Right Turn Arrow)

**FTP-037A-U-25 for (U-Turn Arrow)**



6'-6"

4'-0"

7"

8"D

6"

8"D

6"

6"D

7"

6.75"

64.5"

6.75"

**FTP-56-06**

~~FTP-418A-25~~

6'-6" X 4'

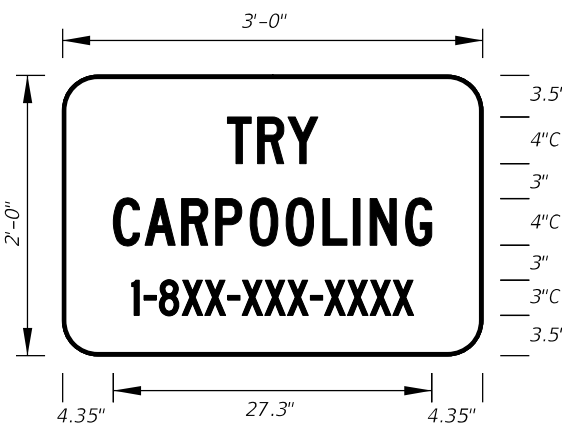
**3" Radii 3/4" Radii**

8" and 6" Series D Legend

Blue Background

White Legend and Border

Design Project Manager or Transit Administrator will supply correct 1-8XX number.



3'-0"

2'-0"

3.5"

4"C

3"

4"C

3"

3"C

3.5"

4.35"

27.3"

4.35"

**FTP-56A-06**

~~FTP-418-25~~

3' X 2'

**1.5" Radii**

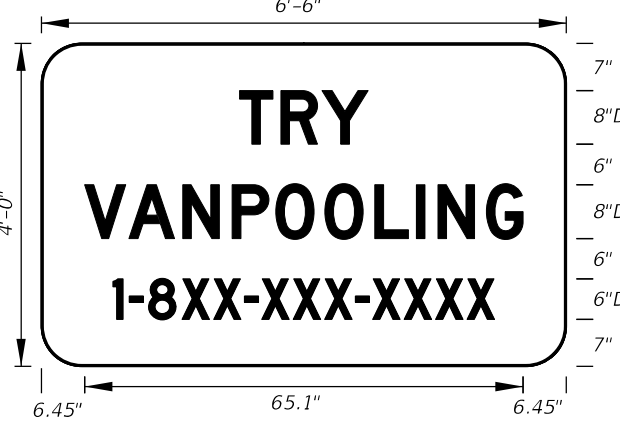
~~3" Radii~~ 1/4" Border

4" and 3" Series C Legend

Blue Background

White Legend and Border

Design Project Manager or Transit Administrator will supply correct 1-8XX number.



6'-6"

4'-0"

7"

8"D

6"

8"D

6"

6"D

7"

6.45"

65.1"

6.45"

**FTP-57-06**

~~FTP-419A-25~~

6'-6" X 4'

**3" Radii 3/4" Radii**

8" and 6" Series D Legend

Blue Background

White Legend and Border

Design Project Manager or Transit Administrator will supply correct 1-8XX number.



3'-0"

2'-0"

3.5"

4"C

3"

4"C

3"

3"C

3.5"

4.25"

27.5"

4.25"

**FTP-58-06**

~~FTP-419-25~~

3' X 2'

**1.5" Radii**

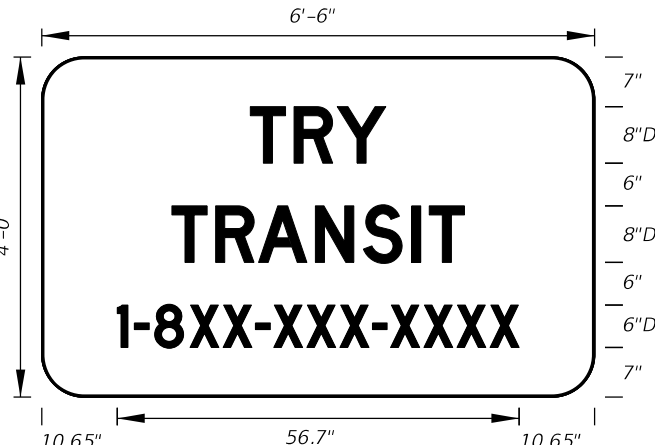
~~3" Radii~~

4" and 3" Series C Legend

Blue Background

White Legend and Border

Design Project Manager or Transit Administrator will supply correct 1-8XX number.



6'-6"

4'-0"

7"

8"D

6"

8"D

6"

6"D

7"

10.65"

56.7"

10.65"

**FTP-59-06**

~~FTP-420A-25~~

6'-6" X 4'

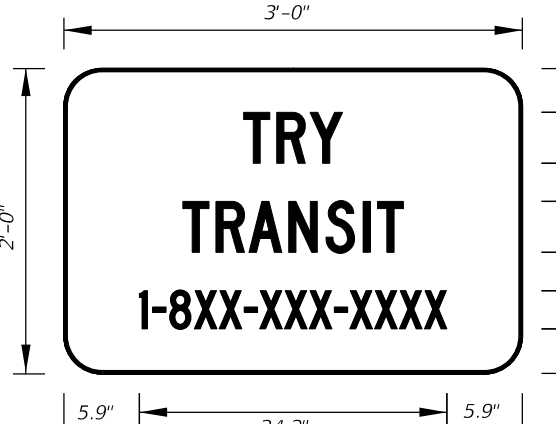
**3" Radii 3/4" Radii**

8" and 6" Series D Legend

Blue Background

White Legend and Border

Design Project Manager or Transit Administrator will supply correct 1-8XX number.



3'-0"

2'-0"

3.5"

4"C

3"

4"C

3"

3"C

3.5"

5.9"

24.2"

5.9"

**FTP-60-06**

~~FTP-420-25~~

3' X 2'

**1.5" Radii**

~~3" Radii~~

4" and 3" Series C Legend

Blue Background

White Legend and Border

Design Project Manager or Transit Administrator will supply correct 1-8XX number.



3'-0"

2'-0"

4.5"

4"C

2"

4"C

2"

3"C

4.5"

4.3"

27.4"

4.3"

**FTP-61-06**

~~FTP-203-25~~

3' X 2'

**1.5" Radii**

~~3" Radii~~ 3/4" Border

4" and 3" Series C Legend

Yellow Background

Black Legend and Border

FTP-203A-25  
~~FTP-62-06~~  
3' X 3' 1.5" Radii  
~~2" Radii~~ 3/4" Border 4" and 5" Series C Legend  
Yellow Background Black Legend and Border

FTP-013-25  
~~FTP-65-06~~  
3' X 1'-6" 1.5" Radii  
~~2" Radii~~ 3/4" Border  
4" Series D Legend  
White Background  
Black Legend and Border

FTP-414-25  
~~FTP-66-21~~  
4' X 5'  
3" Radii 1" Border  
6" Series D Legend  
Blue Background  
White Legend and Border

FTP-414A-25  
~~FTP-67-21~~  
5.5' X 6'  
3" Radii 1" Border  
8" Series D Legend  
Blue Background  
White Legend and Border

FTP-414-25 FTP-414A-25  
DETAIL for ~~FTP-66~~ AND ~~FTP-67~~

Sign Mounting Holes Can Be Punched Or Field Drilled With No Obstruction To Text Or Symbols From Holes Or Bolts.

FTP-031-25  
~~FTP-68A-06~~  
9" X 1'-3"  
1.5" Radii 3/4" Border  
Series B Legend  
White Background  
Black Legend and Border

See MUTCD R10-3f for for Letter Size, Spacing, and Symbol Sizes and Color

Sign Mounting Holes Can Be Punched Or Field Drilled With No Obstruction To Text Or Symbols From Holes Or Bolts.

FTP-032-25  
~~FTP-68B-06~~  
9" X 1'-6"  
1.5" Radii 3/4" Border  
Series B Legend  
White Background  
Black Legend and Border

See MUTCD R10-3i for for Letter Size, Spacing, and Symbol Sizes and Color

FTP-033-25  
~~FTP-68C-21~~  
9" X 1'-6"  
1.5" Radii 1/4" Border  
Series D Legend  
White Background  
Black Legend and Border

FTP-69-06  
2'-6" X 2'-6"  
4" Radii 3/4" Border  
2" and 3" Series D Legend  
White Background  
Black Legend and Border

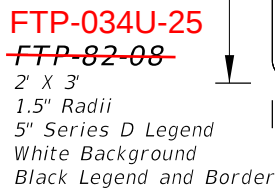
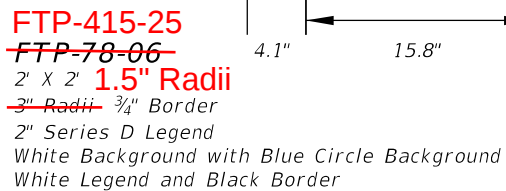
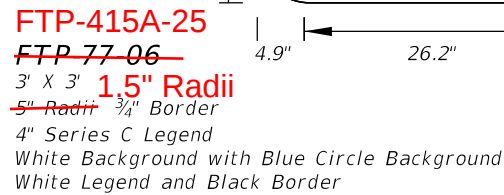
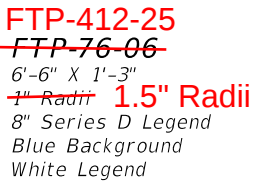
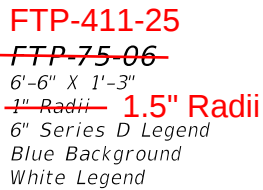
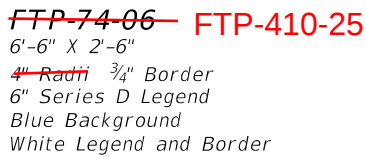
FTP-422B-25  
~~FTP-70-06~~  
3'-6" X 2'-6" 1.5" Radii  
~~2.25" Radii~~ 3/4" Border  
5" Series C and 7" Series C Legend  
Blue Background  
White Legend and Border

FTP-208A-25  
~~FTP-71-06~~  
4' X 4'  
~~2" Radii~~ 3/4" Border  
8" Series C Legend  
Yellow Background  
Black Legend and Border

FTP-208-25  
~~FTP-72-06~~  
3' X 3'  
~~2" Radii~~ 3/4" Border  
6" Series C Legend  
Yellow Background  
Black Legend and Border


NEW Sheet 13 of 22:

ADDED NEW Traffic Info Tune  
Radio Signs




| <i>A</i> | <i>B</i> | <i>C</i> | <i>D</i> | <i>E</i> | <i>F</i> | <i>G</i> |
|----------|----------|----------|----------|----------|----------|----------|
| 6.25     | 3.125    | 3.125    | 3.125    | 5        | 9.25     | 20.5     |




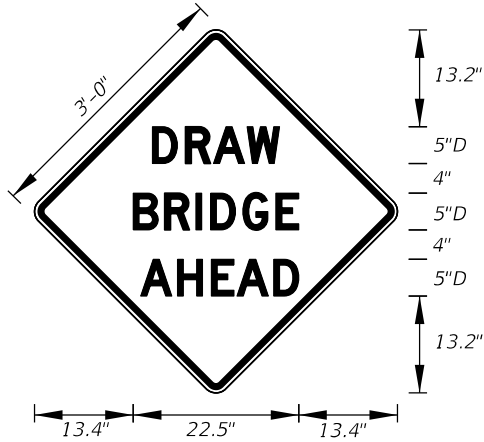

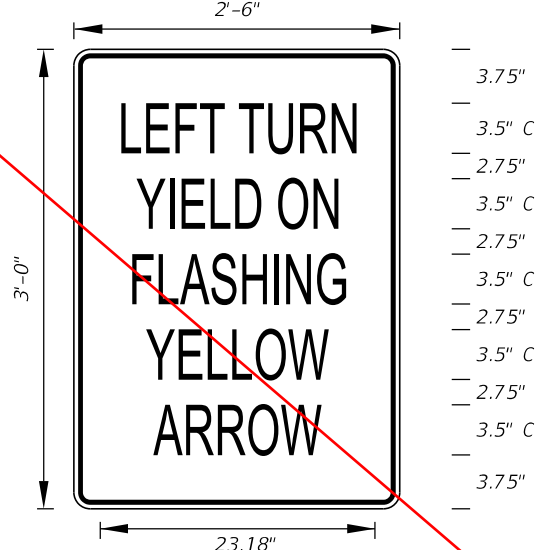FTP-202-25  
~~FTP-84-09~~  
3' X 3'  
1.5" Radii  
5" Series D Legend  
Yellow Background  
Black Legend and  
Border



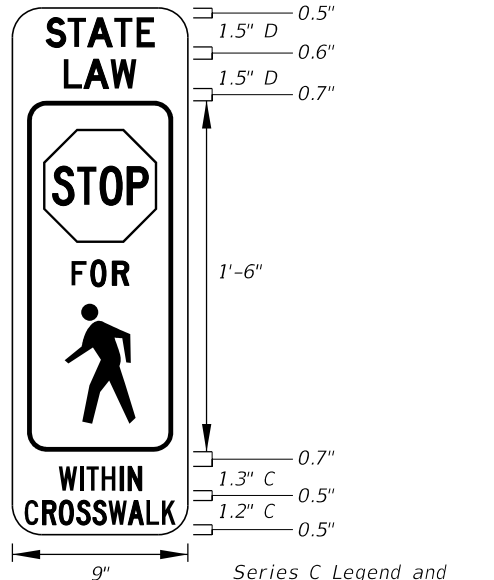
FTP-85-13  
2'-6" X 3'  
1.875" Radii 3/4" Border  
3.5" Series C Legend  
White Background  
Black Legend and Border




FTP-029-25  
~~FTP-86-21~~  
9" X 2'-3"  
1.5" Radii No Border  
Series C Legend and  
Series D Legend  
White on Yellow  
Black Legend and Border



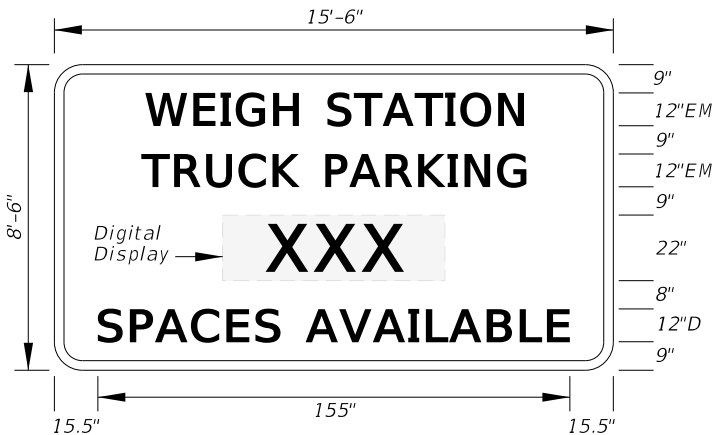
FTP-406-25  
~~FTP-87-21~~  
15'-6" X 8'-6"  
12" Radii 2" Border  
Series D Legend  
Series EM Legend  
Blue Background  
White Legend and Border



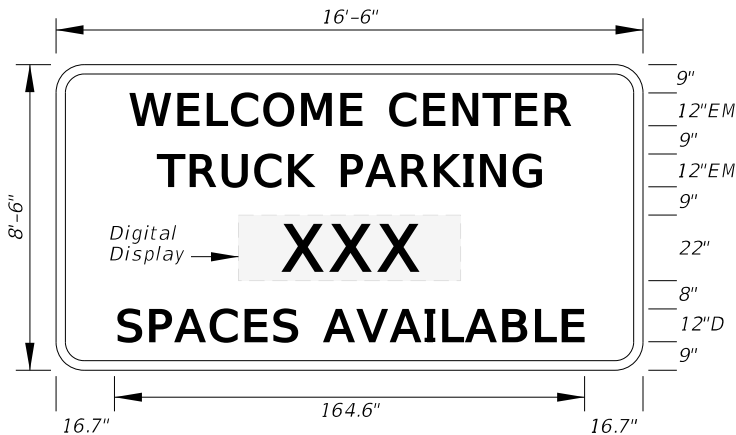
FTP-407-25  
~~FTP-88-21~~  
15'-6" X 8'-6"  
12" Radii 2" Border  
Series D Legend  
Series EM Legend  
Blue Background  
White Legend and Border



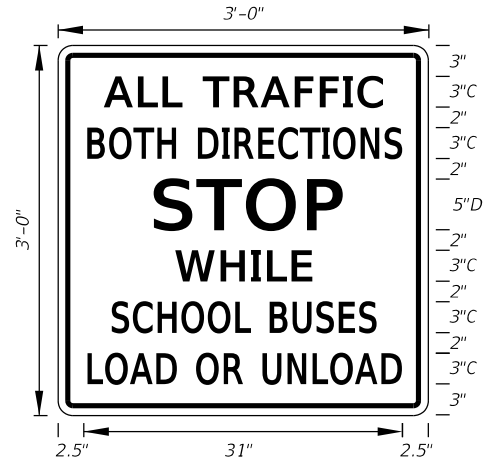
FTP-408-25  
~~FTP-89-21~~  
16'-6" X 8'-6"  
12" Radii 2" Border  
Series D Legend  
Series EM Legend  
Blue Background  
White Legend and Border



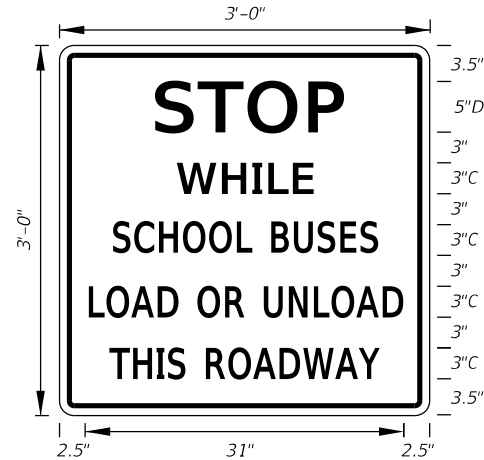FTP-024-25  
~~FTP-90-22~~  
3'-0" X 3'-0"  
1.5" Radii 3/4" Border  
3" Series C Legend and  
5" Series D Legend  
White Background  
Black Legend and Border



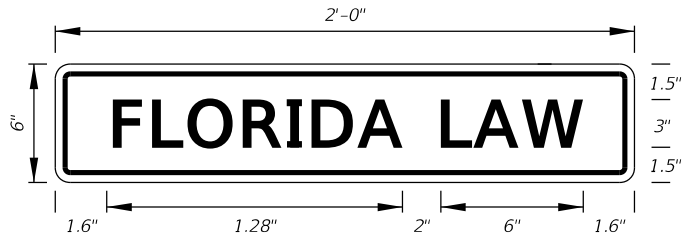FTP-025-25  
~~FTP-91-22~~  
3'-0" X 3'-0"  
1.5" Radii 3/4" Border  
3" Series C Legend and  
5" Series D Legend  
White Background  
Black Legend and Border



FTP-037-25  
~~FTP-100-25~~  
2'-0" X 6"  
1.5" Radii  
0.4" Border  
0.4" Indent  
3" Series C Legend and  
Bright Yellow Green Background  
Black Legend and Border

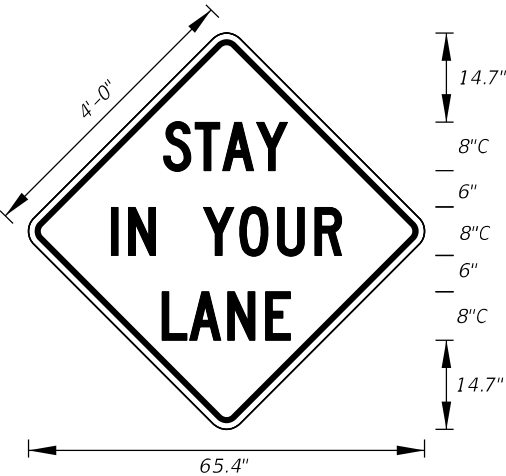
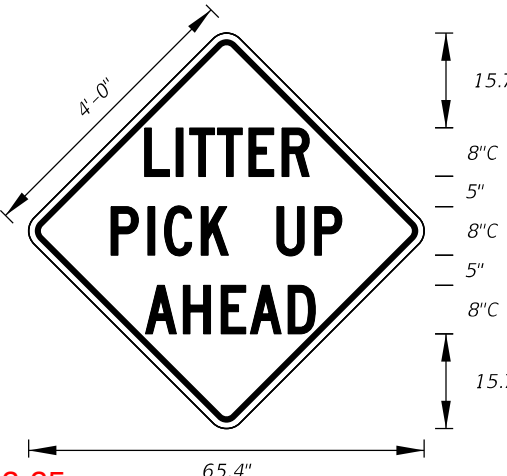
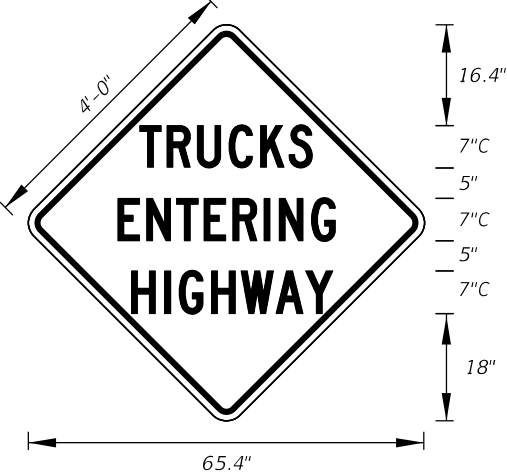
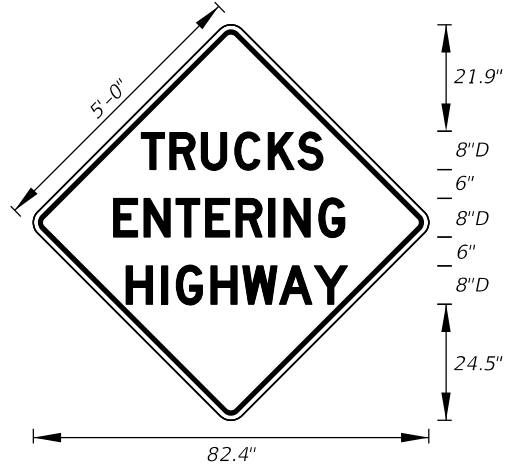
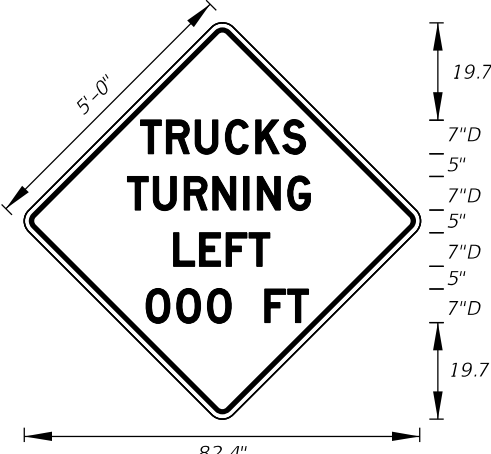
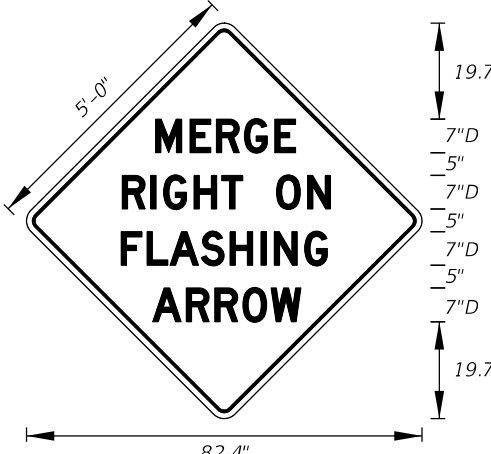
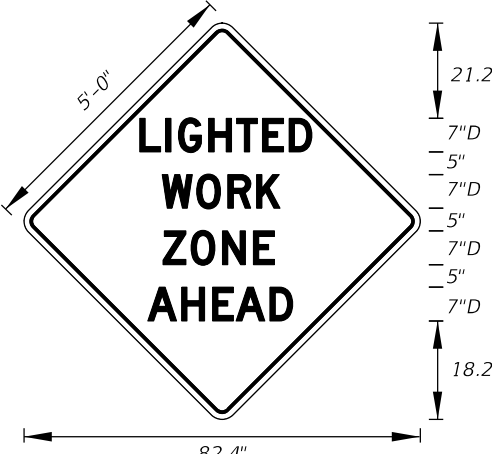
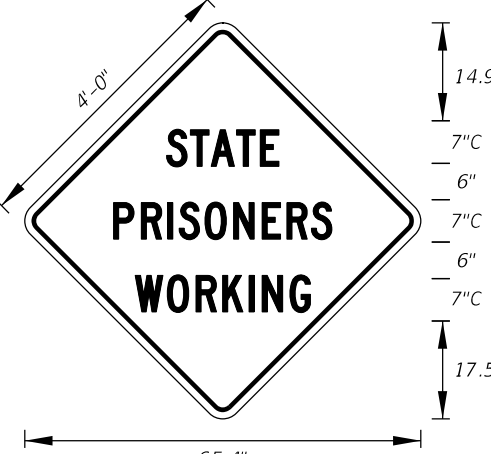
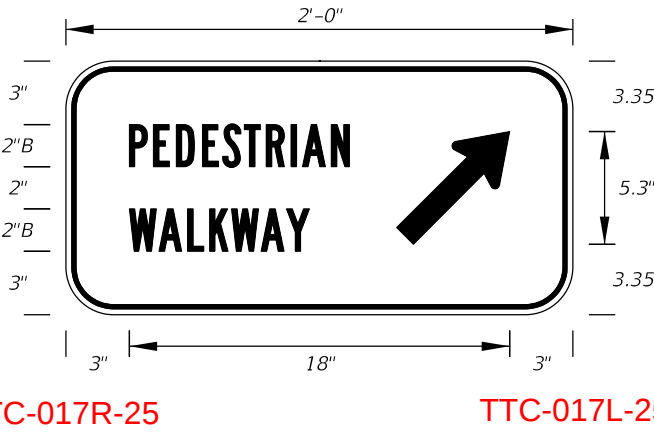
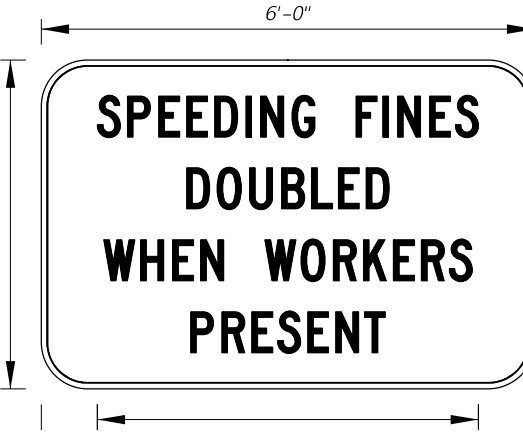
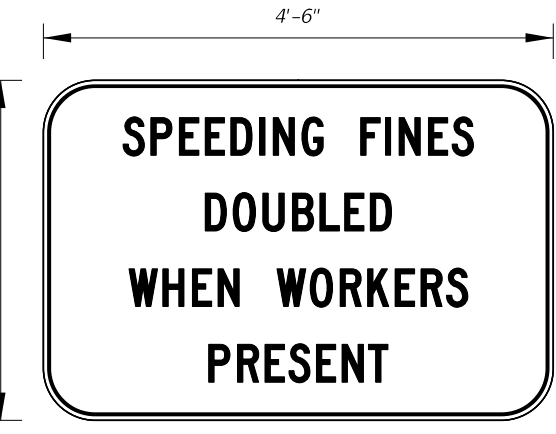
9/10/2024 2:50:33 PM

NEW Sheet 17 of 22:

NEW Guide Signs

NEW Sheet 18 of 21:

NEW Recreational and Culture  
Signs

|   |   |   |   |
|---|---|---|---|
|  <p><b>TTC-001-25</b><br/><del>MOT-1-22</del></p> <p>8" Series C Legend<br/>Orange Background<br/>Black Legend and Border</p> <p>4' X 4'<br/>3" Radii 3/4" Border</p>                           |  <p><b>TTC-002-25</b><br/><del>MOT-4-22</del></p> <p>8" Series C Legend<br/>Orange Background<br/>Black Legend and Border</p> <p>4' X 4'<br/>3" Radii 3/4" Border</p>                                                  |  <p><b>TTC-003-25</b><br/><del>MOT-5-22</del></p> <p>7" Series C Legend<br/>Orange Background<br/>Black Legend and Border</p> <p>4' X 4'<br/>3" Radii 3/4" Border</p>                               |  <p><b>TTC-003A-25</b><br/><del>MOT-6-22</del></p> <p>8" Series D Legend<br/>Orange Background<br/>Black Legend and Border</p> <p>5' X 5'<br/>3" Radii 3/4" Border</p>                        |
|  <p><b>TTC-004-25</b><br/><del>MOT-7-22</del></p> <p>7" Series D Legend<br/>Orange Background<br/>Black Legend and Border</p> <p>5' X 5'<br/>3" Radii 3/4" Border</p>                         |  <p><b>TTC-005-25</b><br/><del>MOT-8-22</del></p> <p>7" Series D Legend<br/>Orange Background<br/>Black Legend and Border</p> <p>5' X 5'<br/>3" Radii 3/4" Border</p>                                                |  <p><b>TTC-006-25</b><br/><del>MOT-9-22</del></p> <p>7" Series D Legend<br/>Orange Background<br/>Black Legend and Border</p> <p>5' X 5'<br/>3" Radii 3/4" Border</p>                             |  <p><b>TTC-007-25</b><br/><del>MOT-10-22</del></p> <p>7" Series C Legend<br/>Orange Background<br/>Black Legend and Border</p> <p>4' X 4'<br/>3" Radii 3/4" Border</p>                      |
|  <p><b>TTC-016R-25</b><br/><b>TTC-016L-25</b><br/><del>MOT-11-06</del></p> <p>6" Series B Legend<br/>Blue Background<br/>White Legend and Border</p> <p>3' X 2'<br/>2" Radii 3/4" Border</p> |  <p><b>TTC-017R-25</b><br/><del>MOT-12R-06</del></p> <p>2' X 1' 1.5" Radii<br/>2" Radii 3/4" Border</p> <p>2" Series B Legend<br/>White Background<br/>Black Legend and Border</p> <p>For Diversion to the left</p> |  <p><b>TTC-011A-25</b><br/><del>MOT-13-06</del></p> <p>Freeway Sign<br/>6' X 4' 3" Radii<br/>6" Radii 3/4" Border</p> <p>6" Series C Legend<br/>White Background<br/>Black Legend and Border</p> |  <p><b>TTC-011-25</b><br/><del>MOT-14-06</del></p> <p>Arterial Sign<br/>4'-6" X 3'<br/>5" Radii 3/4" Border</p> <p>4" Series C Legend<br/>White Background<br/>Black Legend and Border</p> |
| <div> <div>LAST REVISION</div> <div>11/01/24</div> <div>11/01/25</div> </div> <div> <div>REVISION</div> <div></div> <div></div> </div> <div>DESCRIPTION:</div>   | <div> <div>FDOT</div> <div>FY <del>2025-26</del> 2026-27</div> <div>STANDARD PLANS</div> </div>   | <div>SPECIAL SIGN DETAILS</div>   | <div> <div>INDEX</div> <div>700-102</div> </div> <div> <div>SHEET</div> <div>19 of 21</div> </div>   |

|   |   |   |   |
|---|---|---|---|
| <p><del>MOT-15-06</del> <b>TTC-009-25</b><br/>4" X 4"<br/>2" Radii 3/4" Border<br/>6" Series D Legend<br/>Orange Background<br/>Black Legend and Border</p>             | <p><b>TTC-012-25</b><br/><del>MOT-16-06</del><br/>4'-6" X 2'-6"<br/>4" Radii 3/4" Border<br/>5" Kids Series Legend<br/>Orange Background<br/>Black Legend and Border</p> | <p><b>TTC-013-25</b><br/><del>MOT-17-06</del><br/>4'-6" X 2'-6"<br/>4" Radii 3/4" Border<br/>5" Kids Series Legend<br/>Orange Background<br/>Black Legend and Border</p> | <p><b>TTC-010-25</b><br/><del>MOT-18-10</del><br/>4" X 4"<br/>2" Radii 3/4" Border<br/>6" Series D Legend<br/>Orange Background<br/>Black Legend and Border</p>      |
| <p><b>TTC-014-25</b><br/><del>MOT-19-11</del><br/>2' X 2'-6"<br/>1.13" Radii 3/4" Border<br/>4" Series C Legend<br/>White Background<br/>Red Legend and Border</p>      | <p><b>G20-1</b><br/>4' X 2'<br/>1.5" Radii 3/4" Border<br/><b>DELETED</b><br/>Orange Background<br/>Black Legend and Border</p>                                          | <p><b>G20-2</b><br/>4' X 2'<br/>1.5" Radii 3/4" Border<br/><b>DELETED</b><br/>Orange Background<br/>Black Legend and Border</p>                                          | <p><b>TTC-018-25</b><br/><del>MOT-21-21</del><br/>2' X 1'-6"<br/>1.5" Radii 1/2" Border<br/>3" Series D Legend<br/>Orange Background<br/>Black Legend and Border</p> |
| <p><b>TTC-015-25</b><br/><del>MOT-23-21</del><br/>1'-6" X 1'-0"<br/>1.5" Radii 1/4" Border<br/>3" Series B Legend<br/>Orange Background<br/>Black Legend and Border</p> | <p><b>TTC-008-25</b><br/><del>MOT-27-25</del><br/>4' X 4'<br/>3" Radii 5/4" Border<br/>6" Series C Legend<br/>Orange Background<br/>Black Legend and Border</p>          |   |   |

NEW Sheet 21 of 21:

NEW Signs Added for  
REDUCE SPEED SMOKE  
AHEAD and MOTORCYCLES  
USE CAUTION

9/18/2025 10:13:58 AM

GENERAL NOTES:

- 1. Sign dimensions are shown in width by height (W x H) throughout the Index.
- 2. See APPENDIX for previous sign numbering crosswalk.

NUMBERING CONVENTION:

FTP-AAA B/C-DD or TTC-AAA B/C-DD

AAA = Sign Type  
B = Size Adjustments to Smallest Available Sign Size (A,B,C)  
C = Left or Right (L or R)  
DD = Year of update











Example 1: Size Adjustment - FTP-001A-25  
Example 2: Direction Application - FTP-103R-25  
Example 3: Size and Direction - FTP-037AR-25

SIGN TYPES (AAA):








FTP-001-199: Regulatory  
FTP-200-399: Warning & Advisory  
FTP-400-599: Motorist Service  
FTP-600-799: Guide  
FTP-800-899: Recreational & Cultural  
FTP-900-999: Miscellaneous  
TTC-001-199: Temporary Traffic Control













| TABLE OF CONTENTS: |                                             |
|--------------------|---------------------------------------------|
| Sheet              | Description                                 |
| 1                  | General Notes and Table of Contents         |
| 2                  | Sign Details FTP-001-25 through FTP-007B-25 |
| 3                  | Sign Details FTP-008-25 through FTP-018-25  |
| 4                  | Sign Details FTP-019-25 through FTP-026-25  |
| 5                  | Sign Details FTP-027-25 through FTP-034U-25 |
| 6                  | Sign Details FTP-035L-25 through FTP-037-25 |
| 7                  | Sign Details FTP-200-25 through FTP-206B-25 |
| 8                  | Sign Details FTP-207-25 through FTP-208A-25 |
| 9                  | Sign Details FTP-400-25 through FTP-409-25  |
| 10                 | Sign Details FTP-410-25 through FTP-415A-25 |
| 11                 | Sign Details FTP-416-25 through FTP-417-25  |
| 12                 | Sign Details FTP-418-25 through FTP-422B-25 |
| 13                 | Sign Details FTP-423-25 through FTP-423A-25 |
| 14                 | Sign Details FTP-600-25 through FTP-609-25  |
| 15                 | Sign Details FTP-610 through FTP-611B-25    |
| 16                 | Sign Details FTP-612-25 through FTP-613-25  |
| 17                 | Sign Details FTP-614-25 through FTP-616A-25 |
| 18                 | Sign Details FTP-800-25 through FTP-802A-25 |
| 19                 | Sign Details TTC-001-25 through TTC-010-25  |
| 20                 | Sign Details TTC-011-25 through TTC-018-25  |
| 21                 | Sign Details TTC-019-25 through TTC-020B-25 |
| APPENDIX           | Crosswalk                                   |

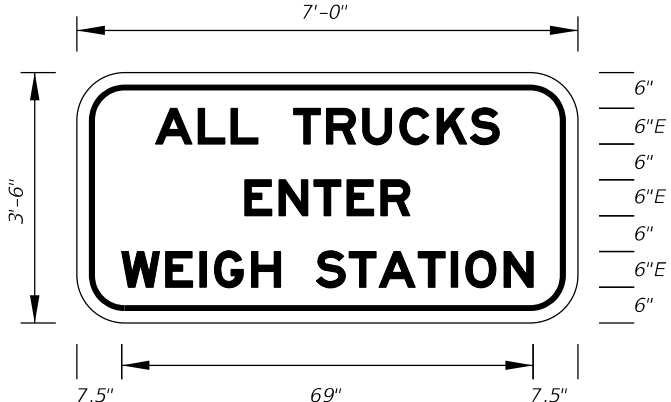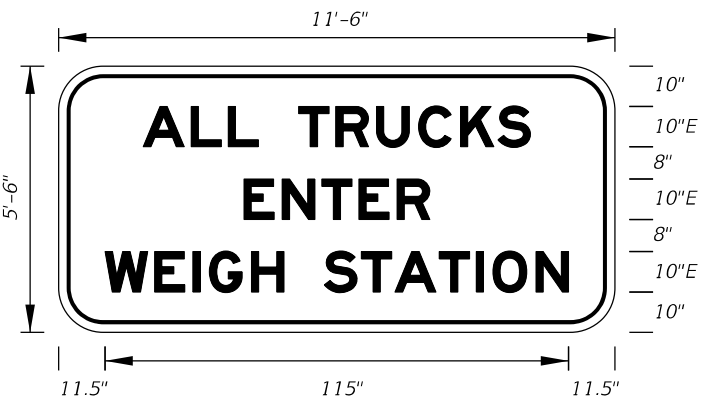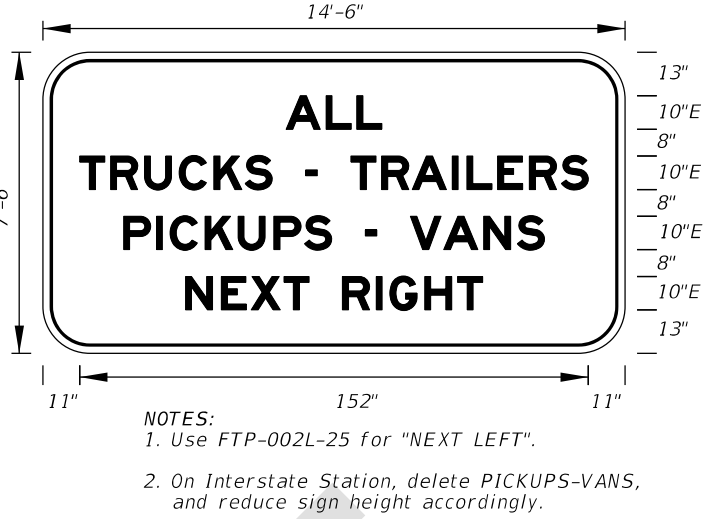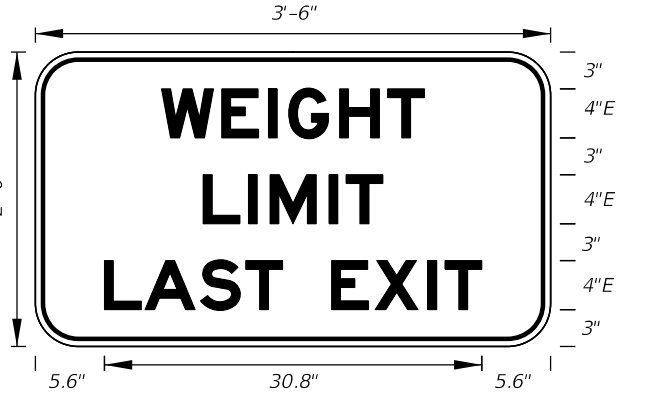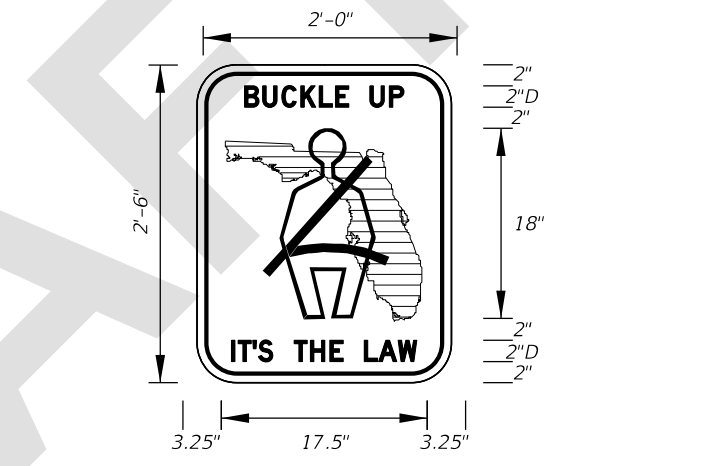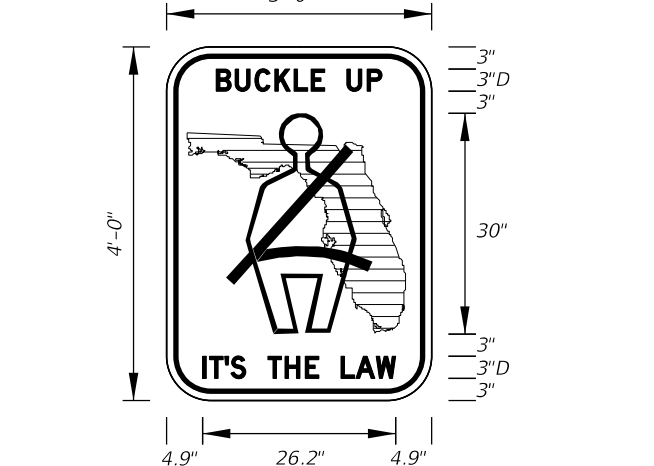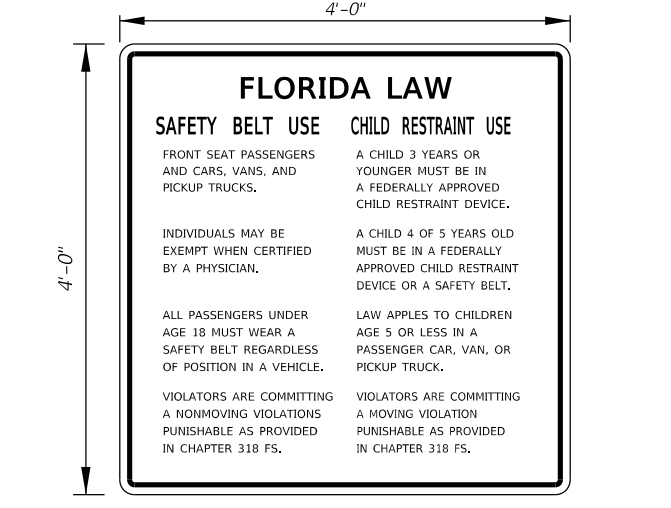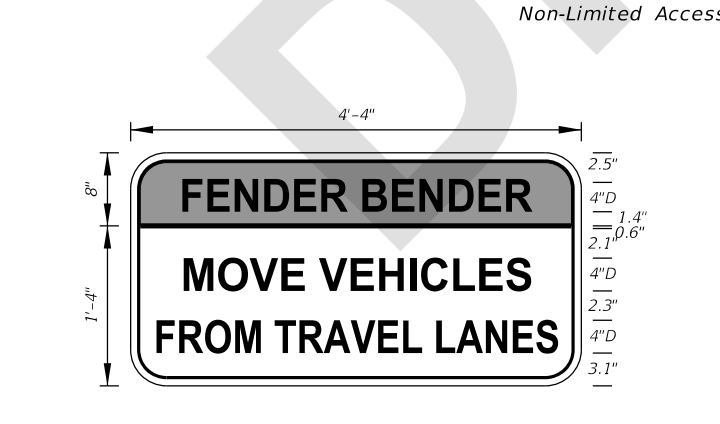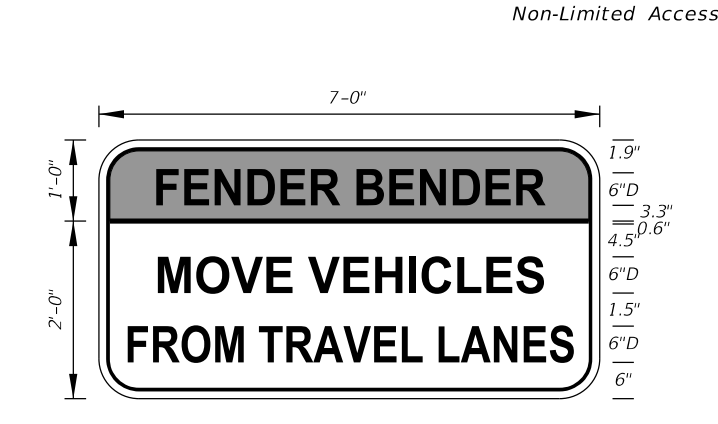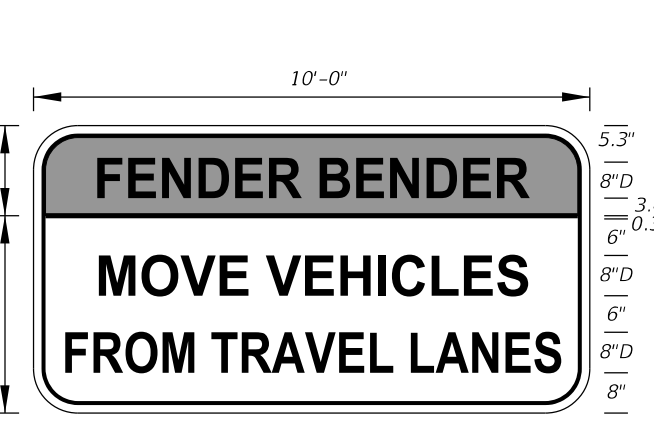9/18/2025 10:14:10 AM

|   |  |   |  |   |  |   |
|---|--|---|--|---|--|---|
| <div>OTHER THAN FREEWAY USE</div>  <div>FTP-001-25<br/>7'-0" X 3'-6"<br/>3" Radii 1" Border</div> <div>6" Series E Legend<br/>White Background<br/>Black Legend and Border</div>                            |  | <div>FREEWAY USE</div>  <div>FTP-001A-25<br/>11'-6" X 5'-6"<br/>9" Radii 2" Border</div> <div>10" Series E Legend<br/>White Background<br/>Black Legend and Border</div>   |  | <div>OTHER THAN FREEWAY USE</div>  <div>FTP-002R-25<br/>FTP-002L-25<br/>14'-6" X 7'-6"<br/>9" Radii 2" Border</div> <div>10" Series E Legend<br/>White Background<br/>Black Legend and Border</div> <div>NOTES:<br/>1. Use FTP-002L-25 for "NEXT LEFT".<br/>2. On Interstate Station, delete PICKUPS-VANS, and reduce sign height accordingly.</div> |  | <div>OTHER THAN FREEWAY USE</div>  <div>FTP-003-25<br/>3'-6" X 2'-0"<br/>1.5" Radii ¾" Border</div> <div>4" Series E Legend<br/>White Background<br/>Black Legend and Border</div>                                                                    |
|  <div>FTP-004-25<br/>4'-0" X 3'-0"<br/>1.5" Radii ¾" Border</div> <div>4" Series C Legend<br/>White Background<br/>Black Legend and Border</div>                                                          |  |  <div>FTP-004A-25<br/>9'-0" X 6'-0"<br/>9" Radii ¾" Border</div> <div>8" Series D Legend<br/>White Background<br/>Black Legend and Border</div>   |  |  <div>FTP-005-25<br/>2'-0" X 2'-6"<br/>1.5" Radii ⅝" Border</div> <div>2" Series D Legend<br/>White Background - Green Florida Symbol<br/>Black Legend, Border and Man Belt Symbol</div>   |  |  <div>FTP-005A-25<br/>3'-0" X 4'-0"<br/>1.5" Radii ¾" Border</div> <div>3" Series D Legend<br/>White Background - Green Florida Symbol<br/>Black Legend, Border and Man Belt Symbol</div>                                                           |
|  <div>FTP-006-25<br/>4'-0" X 4'-0"<br/>1.5" Radii 0.4" Border</div> <div>2.5" Series C Legend<br/>2" Series C Legend<br/>1.5" Series C Legend and<br/>White Background<br/>Black Legend and Border</div> |  | <div>Non-Limited Access</div>  <div>FTP-007-25<br/>4'-4" X 2'-0"<br/>1.5" Radii 0.6" Border</div> <div>TOP:<br/>4" Series D Legend<br/>Yellow Background<br/>Black Legend and Border<br/>Bottom:<br/>4" Series D Legend<br/>White Background<br/>Black Legend and Border</div> |  | <div>Non-Limited Access</div>  <div>FTP-007A-25<br/>7'-0" X 3'-0"<br/>3" Radii 0.9" Border</div> <div>TOP:<br/>6" Series D Legend<br/>Yellow Background<br/>Black Legend and Border<br/>Bottom:<br/>6" Series D Legend<br/>White Background<br/>Black Legend and Border</div>                                                                     |  |  <div>FTP-007B-25<br/>10'-0" X 4'-6"<br/>3" Radii X 0.8" Border</div> <div>TOP:<br/>8" Series D Legend<br/>Yellow Background<br/>Black Legend and Border<br/>Bottom:<br/>8" Series D Legend<br/>White Background<br/>Black Legend and Border</div> |

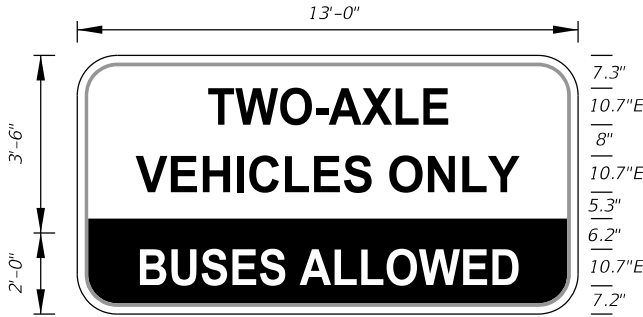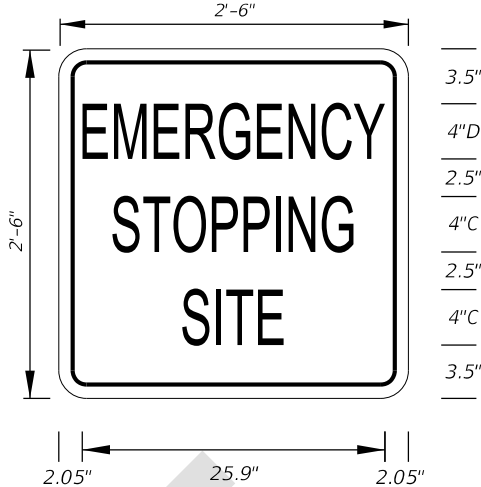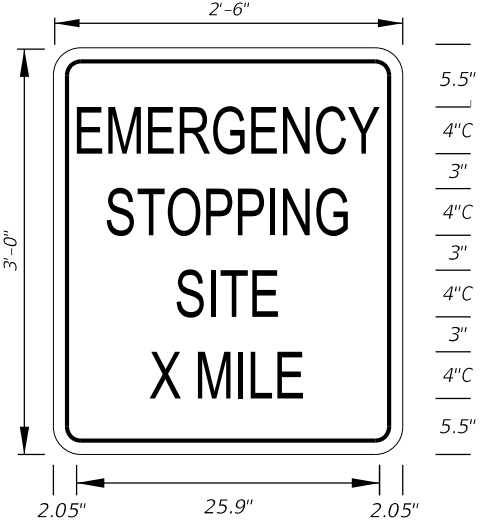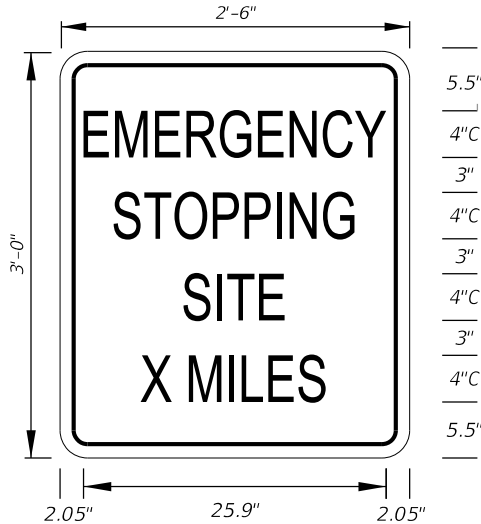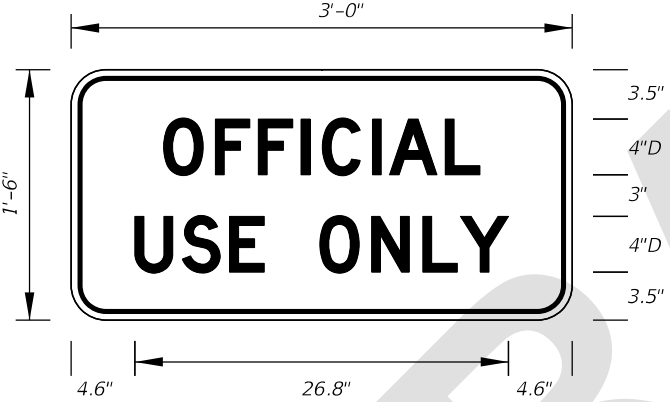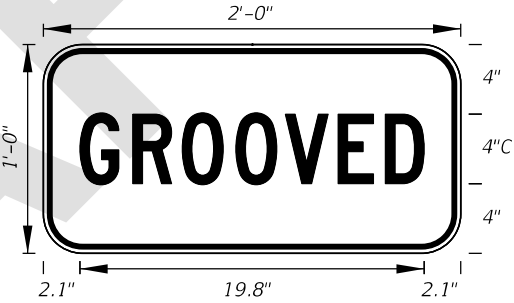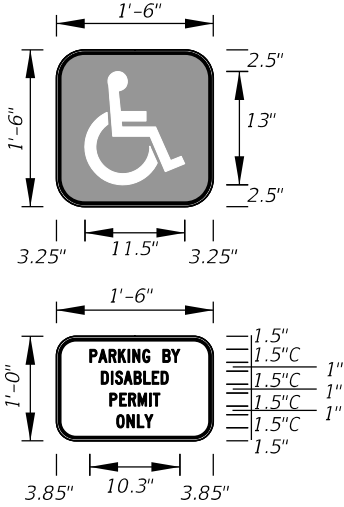9/18/2025 10:14:18 AM

|   |  |   |  |   |  |   |  |
|---|--|---|--|---|--|---|--|
|  <p>FTP-008-25<br/>15'-0" X 8'-6"<br/>9" Radii 1.5" Border</p> <p>TOP:<br/>10.7" Series E Legend<br/>Yellow Background<br/>Black Legend and Border<br/>BOTTOM:<br/>10.7" Series E Legend<br/>White Background<br/>Black Legend and Border</p> |  |  <p>FTP-009-25<br/>13'-0" X 5'-6"<br/>6" Radii 1" Border</p> <p>TOP:<br/>10.7" Series E Legend<br/>White Background<br/>Black Legend and Border<br/>BOTTOM:<br/>10.7" Series E Legend<br/>Black Background<br/>White Legend</p> |  |  <p>FTP-010-25<br/>2'-6" X 2'-6"<br/>1.5" Radii 0.625" Border</p> <p>4" Series D and C Legend<br/>White Background<br/>Black Legend and Border</p>                                                      |  |  <p>FTP-011-25<br/>2'-6" X 3'-0"<br/>1.5" Radii 3/4" Border</p> <p>4" Series C Legend<br/>White Background<br/>Black Legend and Border</p>                                                                |  |
|  <p>FTP-012-25<br/>2'-6" X 3'-0"<br/>1.5" Radii 3/4" Border</p> <p>4" Series C Legend<br/>White Background<br/>Black Legend and Border</p>                                                                                                  |  |  <p>FTP-013-25<br/>3'-0" X 1'-6"<br/>1.5" Radii 3/4" Border</p> <p>4" Series D Legend<br/>White Background<br/>Black Legend and Border</p>                                                                                     |  |  <p>FTP-014-25<br/>2'-0" X 1'-0"<br/>1.5" Radii 5/8" Border</p> <p>4" Series C Legend<br/>Yellow Background<br/>Black Legend and Border</p>                                                           |  |  <p>FTP-015-25<br/>2'-6" X 3'-0"<br/>1.5" Radii 3/4" Border</p> <p>2" and 4" Series C Legend<br/>White Background<br/>Black Legend and Border</p>                                                       |  |
|  <p>FTP-015A-25<br/>3'-6" X 4'-0"<br/>1.5" Radii 3/4" Border</p> <p>3" and 6" Series C Legend<br/>White Background<br/>Black Legend and Border</p>                                                                                         |  |  <p>FTP-016-25<br/>1'-0" X 1'-6"<br/>1.5" Radii 3/8" Border</p> <p>TOP:<br/>4" Series D Legend<br/>BOTTOM:<br/>2" Series C Legend<br/>White Background<br/>Green Legend and Border</p>                                        |  |  <p>FTP-017-25<br/>1'-0" X 1'-6"<br/>1.5" Radii 3/8" Border</p> <p>TOP:<br/>Blue Background<br/>White Border<br/>BOTTOM:<br/>1" Series C Legend<br/>White Background<br/>Black Legend and Border</p> |  |  <p>FTP-018-25<br/>1'-6" X 2'-6"<br/>1.5" Radii 3/8" Border</p> <p>TOP:<br/>Blue Background<br/>White Border<br/>BOTTOM:<br/>1.5" Series C Legend<br/>White Background<br/>Black Legend and Border</p> |  |
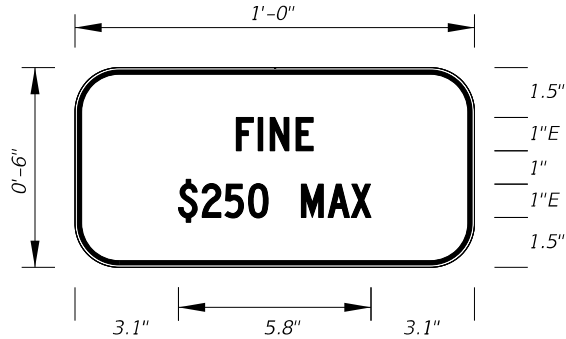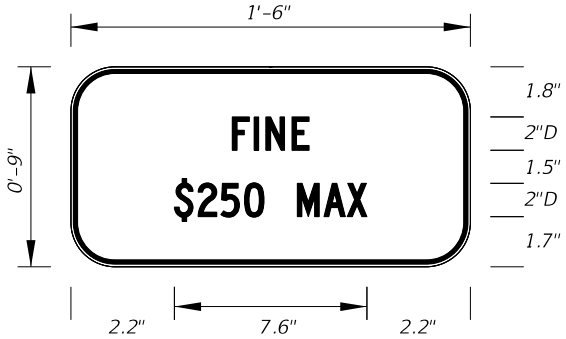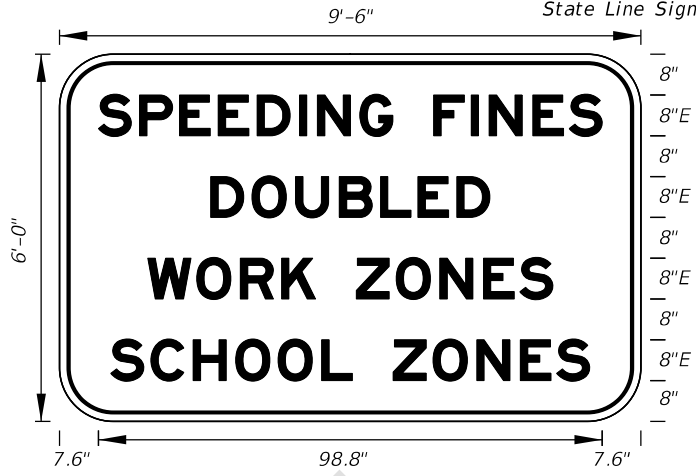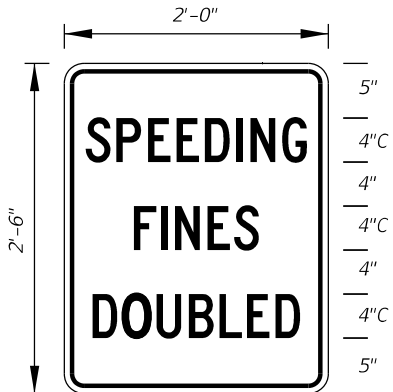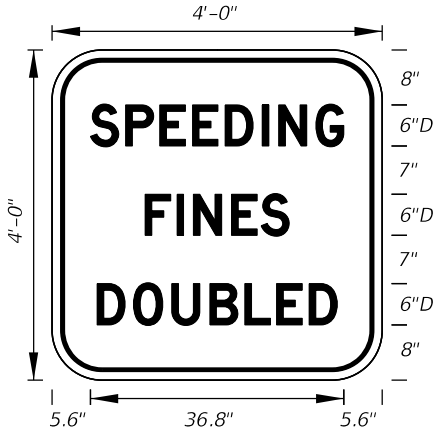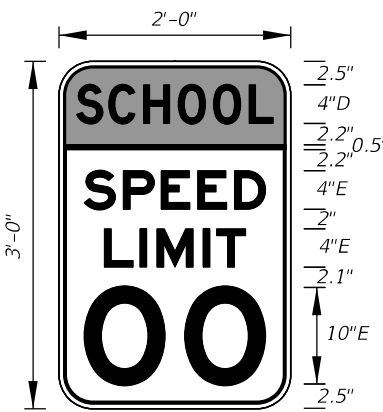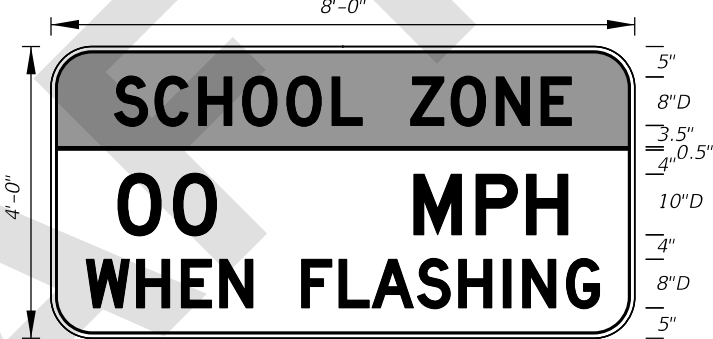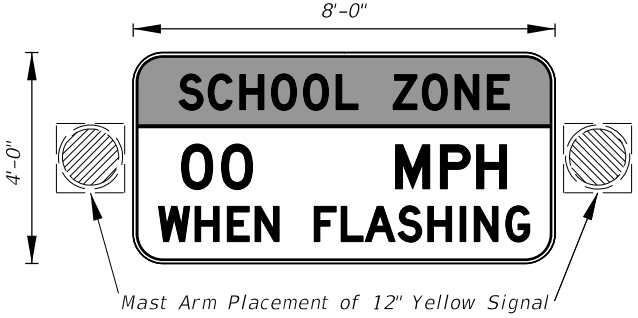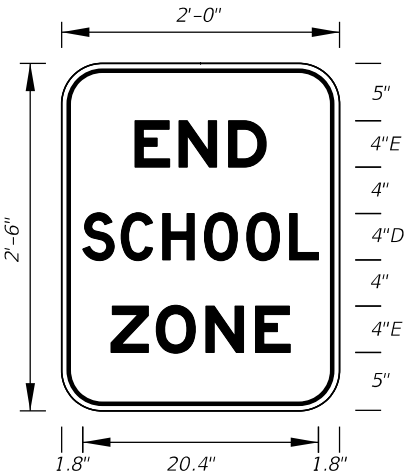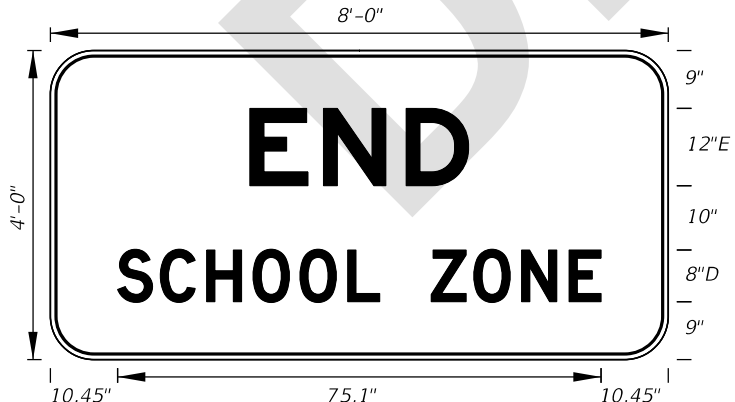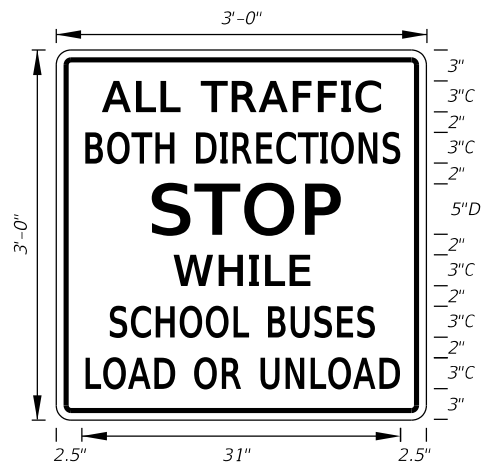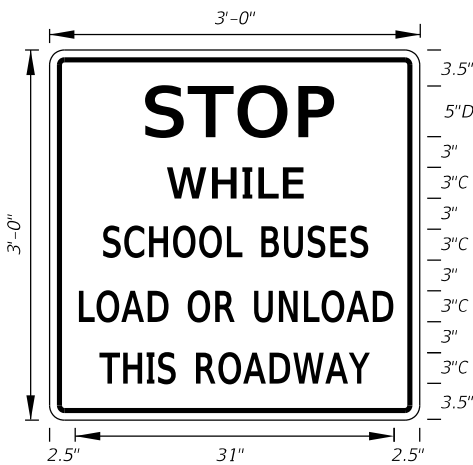
|   |  |   |  |   |  |   |
|---|--|---|--|---|--|---|
| <div><p>NOTE:<br/>Supplemental Panel for the<br/>FTP-016-25 sign</p></div> <div><p>FTP-019-25<br/>1'-0" X 6"<br/>1.5" Radii 3⁄8" Border</p><p>1" Series E Legend<br/>White Background<br/>Black Legend and Border</p></div> |  | <div><p>NOTE:<br/>Supplemental Panel for the<br/>FTP-017-25 sign</p></div> <div><p>FTP-019A-25<br/>1'-6" X 9"<br/>1.5" Radii 3⁄8" Border</p><p>2" Series D Legend<br/>White Background<br/>Black Legend and Border</p></div>                                                                 |  | <div><p>State Line Sign</p></div> <div><p>FTP-020-25<br/>9'-6" X 6'-0"<br/>9" Radii 2" Border</p><p>8" Series E Legend<br/>White Background<br/>Black Legend and Border</p></div>   |  | <div></div> <div><p>FTP-021-25<br/>2'-0" X 2'-6"<br/>1.5" Radii 1⁄2" Border</p><p>4" Series C Legend 80% Spacing<br/>White Background<br/>Black Legend and Border</p></div>   |
| <div><p>Freeway Sign</p></div> <div><p>FTP-021A-25<br/>4'-0" X 4'-0"<br/>3" Radii 3⁄4" Border</p><p>6" Series D Legend<br/>White Background<br/>Black Legend and Border</p></div>                                          |  | <div><p>TOP:<br/>4" Series D Legend<br/>Fluorescent Yellow-Green<br/>Background<br/>Black Legend and Border<br/>BOTTOM:<br/>4" and 10" Series E Legend<br/>White Background<br/>Black Legend and Border</p></div> <div><p>FTP-022-25<br/>2'-0" X 3'-0"<br/>1.5" Radii 5⁄8" Border</p></div> |  | <div><p>Span Wire Placement<br/>of 12" Yellow Signal</p><p>TOP:<br/>8" Series D Legend<br/>Fluorescent Yellow-Green<br/>Background<br/>Black Legend and Border<br/>BOTTOM:<br/>8" and 10" Series D Legend<br/>White Background<br/>Black Legend and Border</p></div> <div><p>FTP-023-25<br/>8'-0" X 4'-0"<br/>3" Radii 3⁄4" Border</p></div> |  | <div><p>Mast Arm Placement of 12" Yellow Signal</p><p>TOP:<br/>8" Series D Legend<br/>Fluorescent Yellow-Green<br/>Background<br/>Black Legend and Border<br/>BOTTOM:<br/>8" and 10" Series D Legend<br/>White Background<br/>Black Legend and Border</p></div> <div><p>FTP-023A-25<br/>8'-0" X 4'-0"<br/>3" Radii 3⁄4" Border</p></div> |
| <div></div> <div><p>FTP-024-25<br/>2'-0" X 2'-6"<br/>1.5" Radii 5⁄8" Border</p><p>4" Series D and E Legend<br/>White Background<br/>Black Legend and Border</p></div>                                                     |  | <div></div> <div><p>FTP-024A-25<br/>8'-0" X 4'-0"<br/>3" Radii 3⁄4" Border</p><p>12" Series E and<br/>8" Series D Legend<br/>White Background<br/>Black Legend and Border</p></div>   |  | <div></div> <div><p>FTP-025-25<br/>3'-0" X 3'-0"<br/>1.5" Radii 3⁄4" Border</p><p>3" Series C Legend and<br/>5" Series D Legend<br/>White Background<br/>Black Legend and Border</p></div>   |  | <div></div> <div><p>FTP-026-25<br/>3'-0" X 3'-0"<br/>1.5" Radii 3⁄4" Border</p><p>3" Series C Legend<br/>5" Series D Legend<br/>White Background<br/>Black Legend and Border</p></div>   |

9/18/2025 10:14:36 AM

**FTP-027-25**  
2'-6" X 3'-6"  
1.5" Radii 0.8" Border

TOP:  
Series D Legend  
Fluorescent Yellow Green  
Background  
Black Legend and Border  
Bottom:  
Series D Legend  
White Background  
Black Legend and Border

**FTP-027A-25**  
4'-0" X 5'-0"  
3" Radii 0.8" Border

TOP:  
Series D Legend  
Fluorescent Yellow Green  
Background  
Black Legend and Border  
Bottom:  
Series E Legend  
White Background  
Black Legend and Border

**FTP-028-25**  
2'-6" X 3'-0"  
1.5" Radii 0.625" Border

TOP:  
Series C Legend  
Yellow Background  
Black Legend and Border  
Bottom:  
Series C Legend  
White Background  
Black Legend and Border

**FTP-029-25**  
9" X 2'-3"  
1.5" Radii No Border

Series C Legend and  
Series D Legend  
White on Yellow  
Black Legend and Border

**FTP-030-25**  
9" X 1'-0"  
1.5" Radii 3/8" Border

1" Series D Legend  
White Background  
Black Legend and Border

NOTES:  
1. Sign mounting holes can be punched or field drilled with no obstruction to text or symbols from holes or bolts.  
2. See MUTCD R10-3f for Letter Size, Spacing, and Symbol Sizes and Color

**FTP-031-25**  
9" X 1'-3"  
1.5" Radii 3/4" Border

Series B Legend  
White Background  
Black Legend and Border

NOTES:  
1. Sign mounting holes can be punched or field drilled with no obstruction to text or symbols from holes or bolts.  
2. See MUTCD R10-3i for Letter Size, Spacing, and Symbol Sizes and Color

**FTP-032-25**  
9" X 1'-6"  
1.5" Radii 3/4" Border

Series B Legend  
White Background  
Black Legend and Border

**FTP-033-25**  
9" X 1'-6"  
1.5" Radii 1/4" Border

Series D Legend  
White Background  
Black Legend and Border

**FTP-034L-25**  
2'-0" X 2'-6"  
1.5" Radii 3/8" Border

5" Series D Legend  
White Background  
Black Legend and Border

Note: Use FTP-033R for RIGHT TURN ONLY

**FTP-034AL-25**  
4'-0" X 5'-0"  
3" Radii 3/4" Border

10" Series D Legend  
White Background  
Black Legend and Border


Note: Use FTP-033AR for RIGHT TURN ONLY

**FTP-034U-25**  
2'-0" X 3'-0"  
1.5" Radii  
5" Series D Legend  
White Background  
Black Legend and Border

|   | A     | B | C | D | E |
|---|-------|---|---|---|---|
| A | 3.125 |   |   |   |   |
| B | 3.625 |   |   |   |   |
| C | 6.375 |   |   |   |   |
| D | .5    |   |   |   |   |
| E | .625  |   |   |   |   |

|   | A    | B     | C     | D     | E | F    | G    |
|---|------|-------|-------|-------|---|------|------|
| A | 6.25 | 3.125 | 3.125 | 3.125 | 5 | 9.25 | 20.5 |

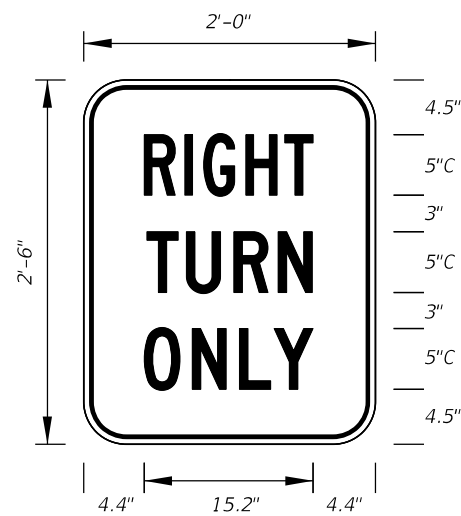
DETAILS



FTP-035R-25

2'-0" X 2'-6"  
1.5" Radii 5/8" Border

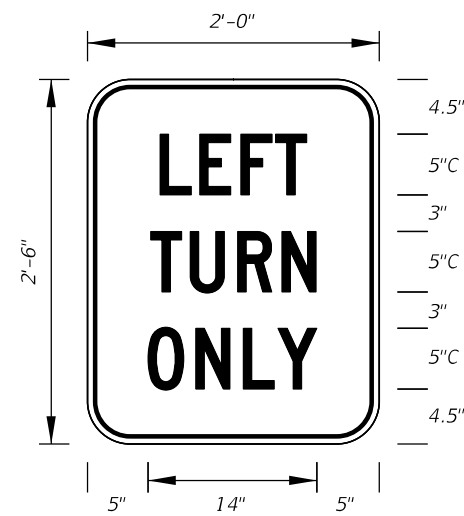
5" Series C Legend  
White Background  
Black Legend and Border



FTP-035L-25

2'-0" X 2'-6"  
1.5" Radii 5/8" Border

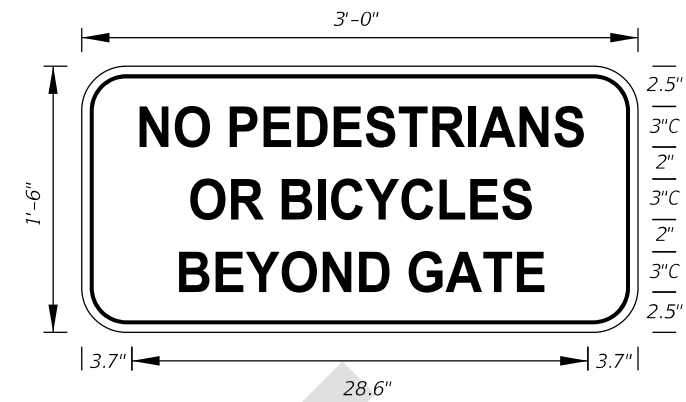
5" Series C Legend  
White Background  
Black Legend and Border



FTP-036-25

3'-0" X 1'-6"  
1.5" Radii 0.5" Border









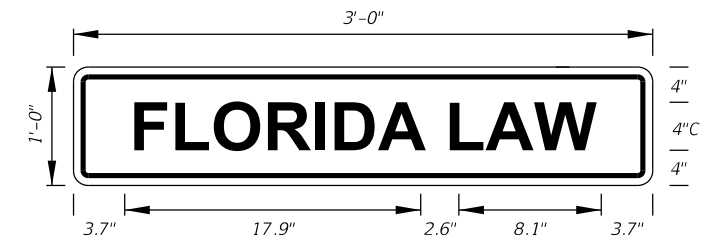
3" Series C Legend and  
White Background  
Black Legend and Border







FTP-037-25













3'-0" X 1'-0"  
1.5" Radii 0.4" Border

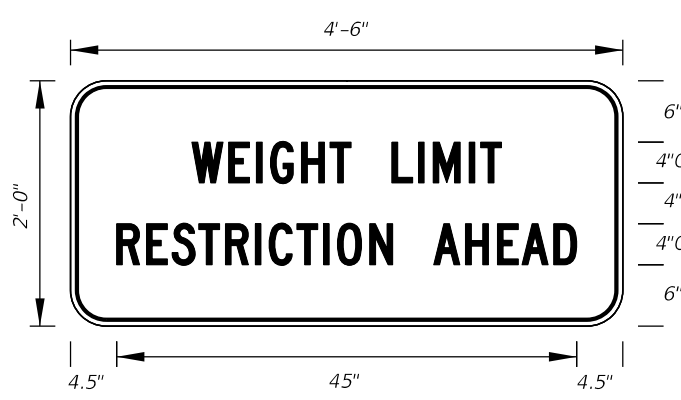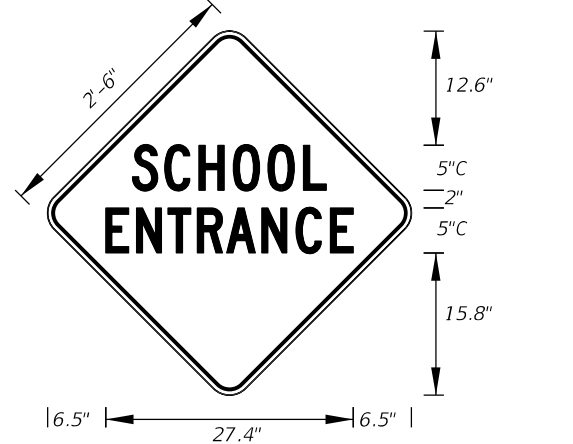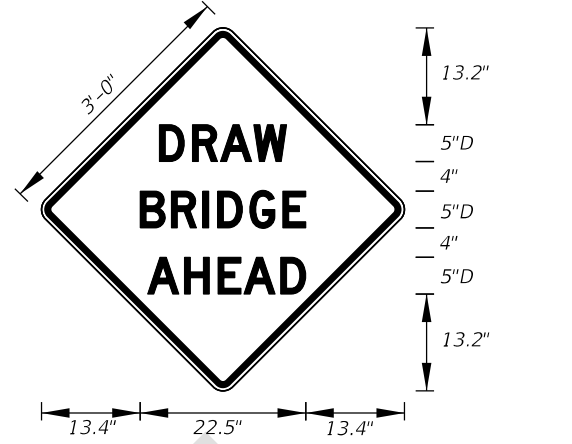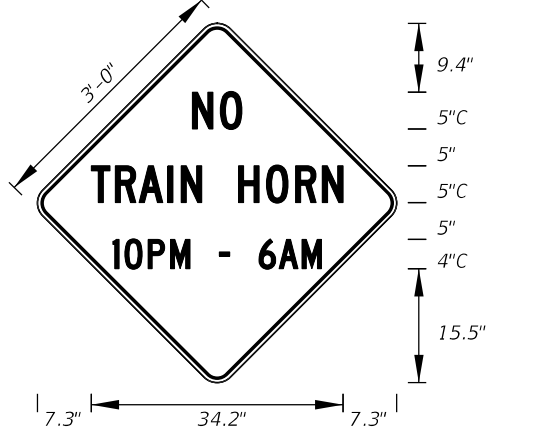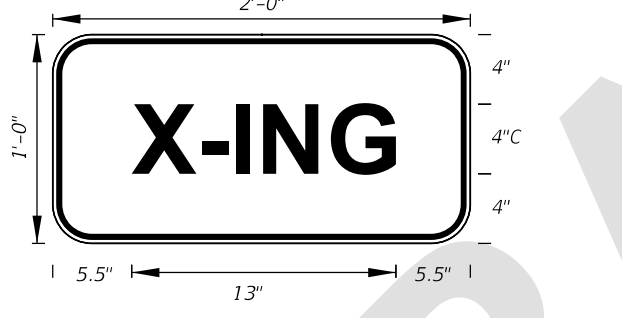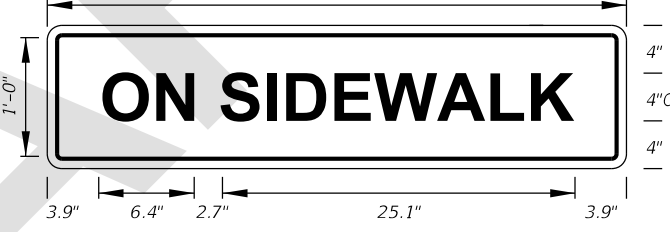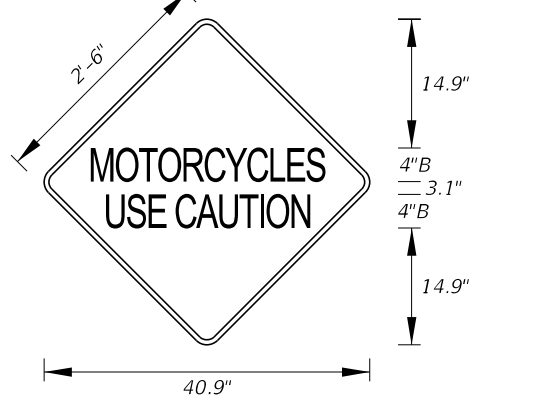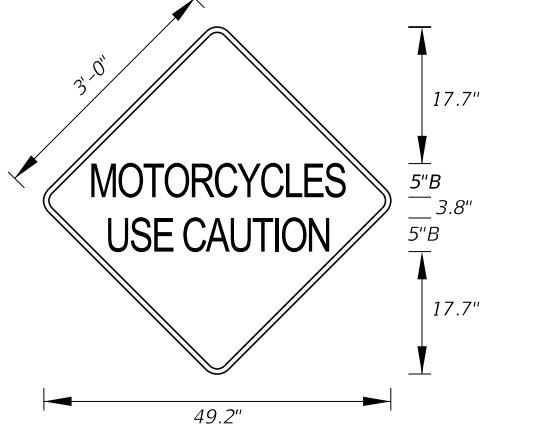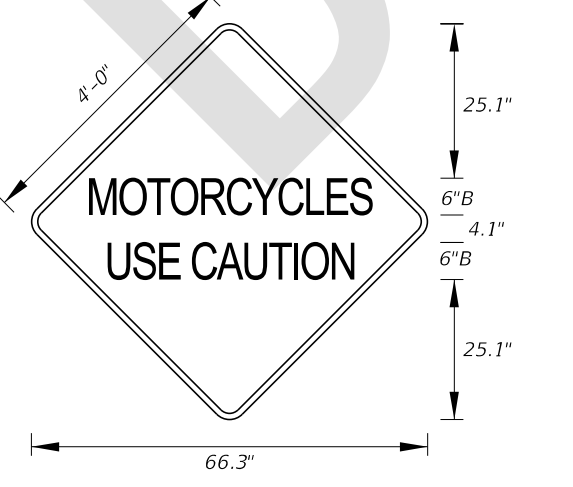4" Series C Legend  
Fluorescent Yellow Green  
Background  
Black Legend and Border

|   |  |   |  |   |  |   |  |                  |  |                  |  |
|---|--|---|--|---|--|---|--|------------------|--|------------------|--|
|  <p><b>FTP-200-25</b><br/>4'-6" X 2'-0"<br/>1.5" Radii ¾" Border</p> <p>4" Series C Legend<br/>Yellow Background<br/>Black Legend and Border</p>                       |  |  <p><b>FTP-201-25</b><br/>2'-6" X 2'-6"<br/>1.5" Radii ¾" Border</p> <p>5" Series C Legend<br/>Fluorescent Yellow-Green Background<br/>Black Legend and Border</p>       |  |  <p><b>FTP-202-25</b><br/>3'-0" X 3'-0"<br/>1.5" Radii</p> <p>5" Series D Legend<br/>Yellow Background<br/>Black Legend and Border</p>             |  |  <p><b>FTP-203-25</b><br/>3'-0" X 2'-0"<br/>1.5" Radii ¾" Border</p> <p>4" and 3" Series C Legend<br/>Yellow Background<br/>Black Legend and Border</p>               |  |                  |  |                  |  |
|  <p><b>FTP-203A-25</b><br/>3'-0" X 3'-0"<br/>1.5" Radii ¾" Border</p> <p>4" and 5" Series C Legend<br/>Yellow Background<br/>Black Legend and Border</p>             |  |  <p><b>FTP-204-25</b><br/>2'-0" X 1'-0"<br/>1.5" Radii ¾" Border</p> <p>4" Series C Legend<br/>Yellow Background<br/>Black Legend and Border</p>                       |  |  <p><b>FTP-205-25</b><br/>3'-6" X 1'-0"<br/>1.5" Radii ¾" Border</p> <p>4" Series C Legend<br/>Yellow Background<br/>Black Legend and Border</p> |  | <p>Single-Lane</p>  <p><b>FTP-206-25</b><br/>2'-6" X 2'-6"<br/>1.5" Radii ¾" Border</p> <p>4" Series B Legend<br/>Yellow Background<br/>Black Legend and Border</p> |  |                  |  |                  |  |
| <p>Multi-Lane</p>  <p><b>FTP-206A-25</b><br/>3'-0" X 3'-0"<br/>1.5" Radii ¾" Border</p> <p>5" Series B Legend<br/>Yellow Background<br/>Black Legend and Border</p> |  | <p>Limited Access</p>  <p><b>FTP-206B-25</b><br/>4'-0" X 4'-0"<br/>3" Radii ¾" Border</p> <p>6" Series B Legend<br/>Yellow Background<br/>Black Legend and Border</p> |  |   |  |   |  |                  |  |                  |  |
| LAST REVISION<br>11/01/25   |  | DESCRIPTION:   |  | FY 2026-27<br>STANDARD PLANS   |  | SPECIAL SIGN DETAILS   |  | INDEX<br>700-102 |  | SHEET<br>7 of 21 |  |

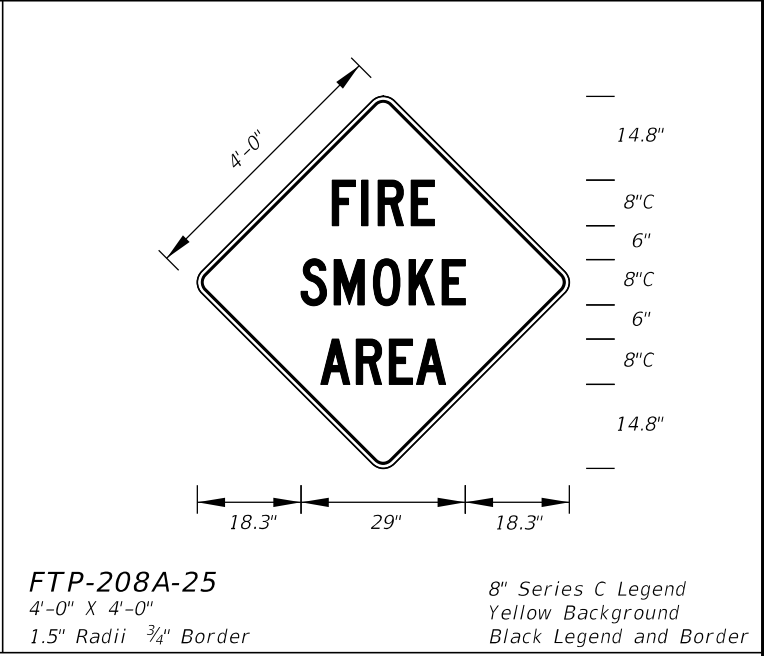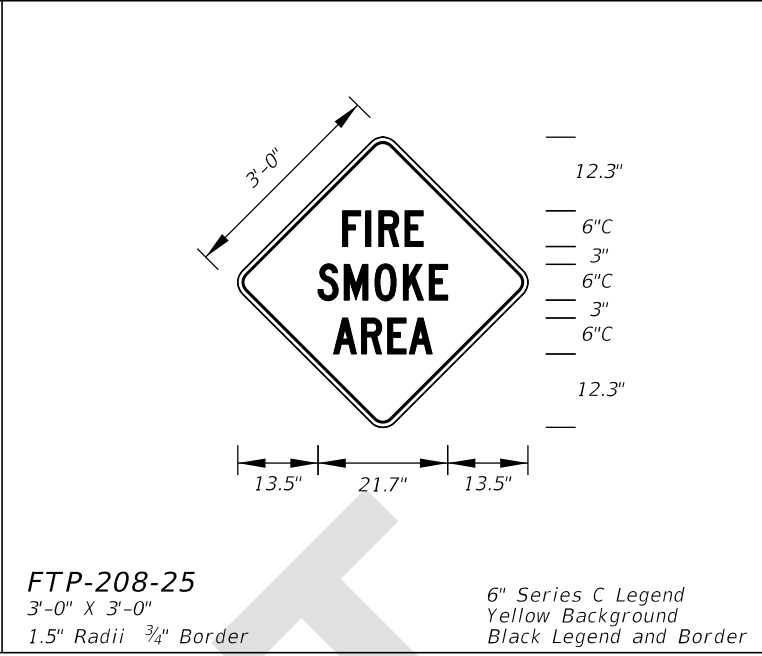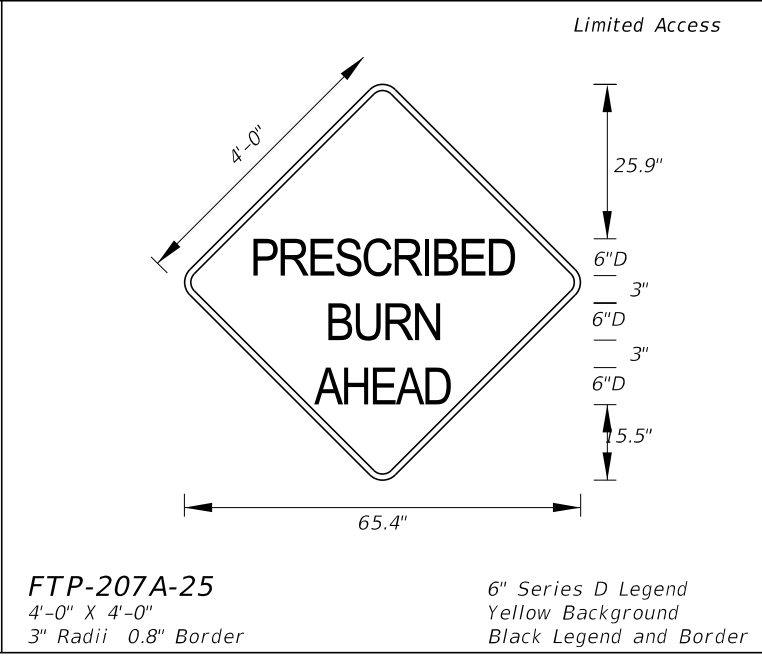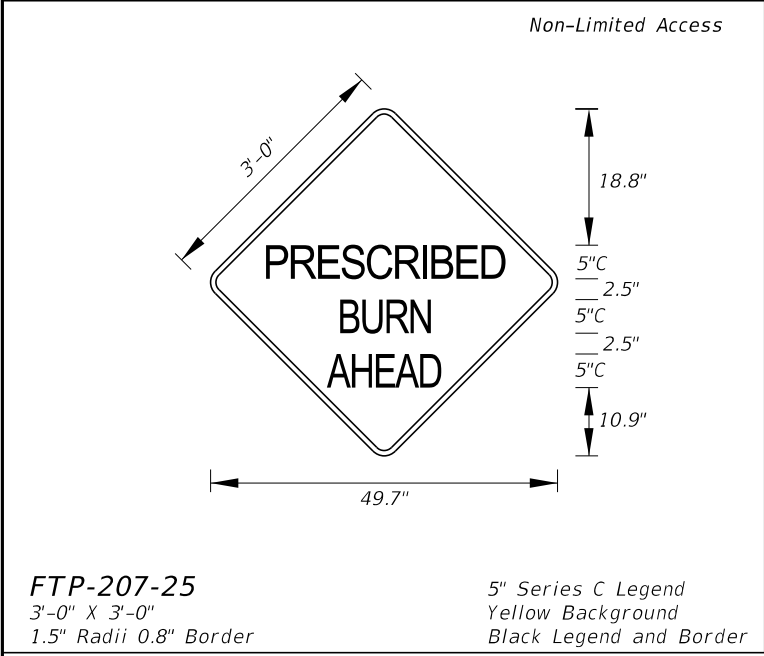

9/18/2025 10:15:08 AM
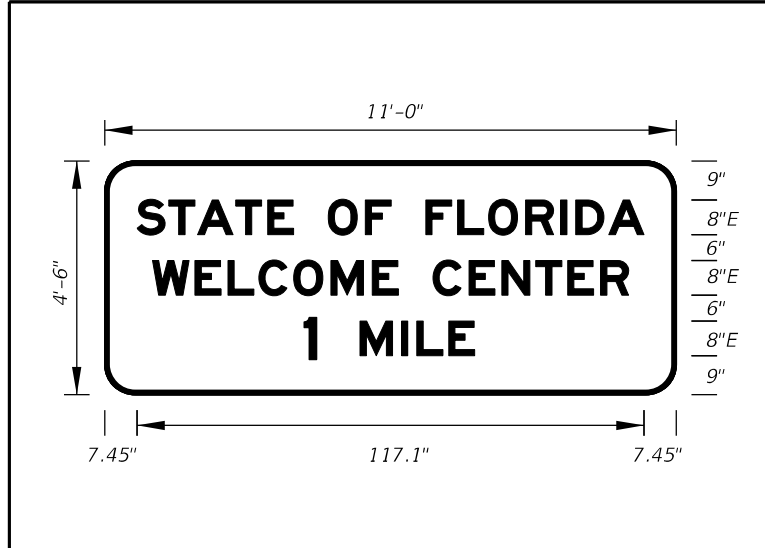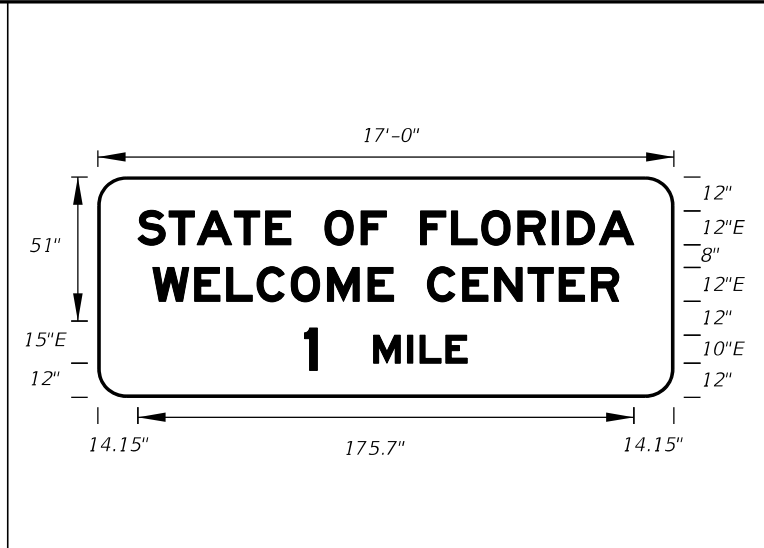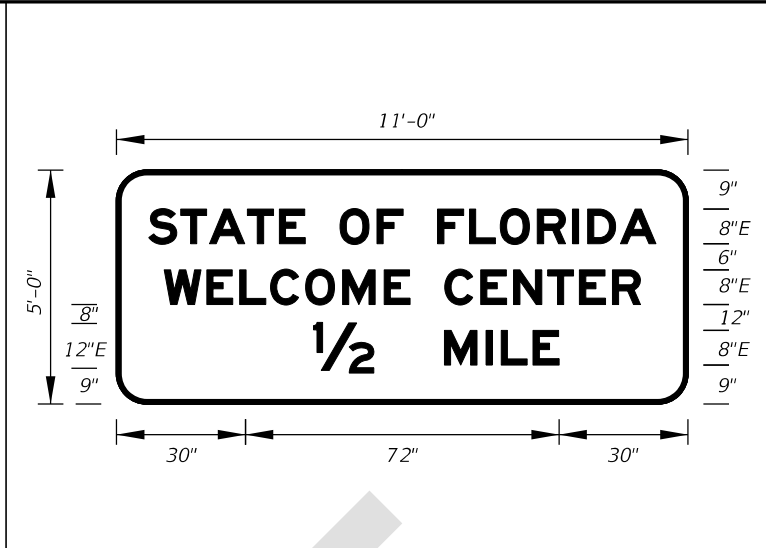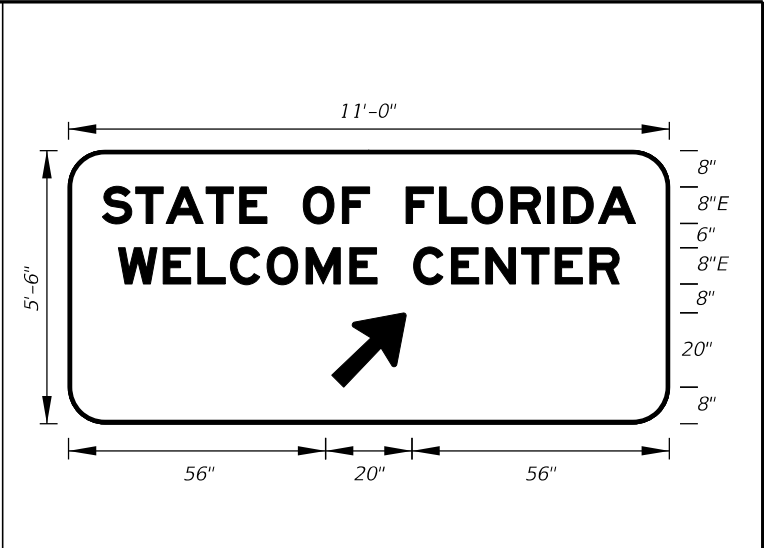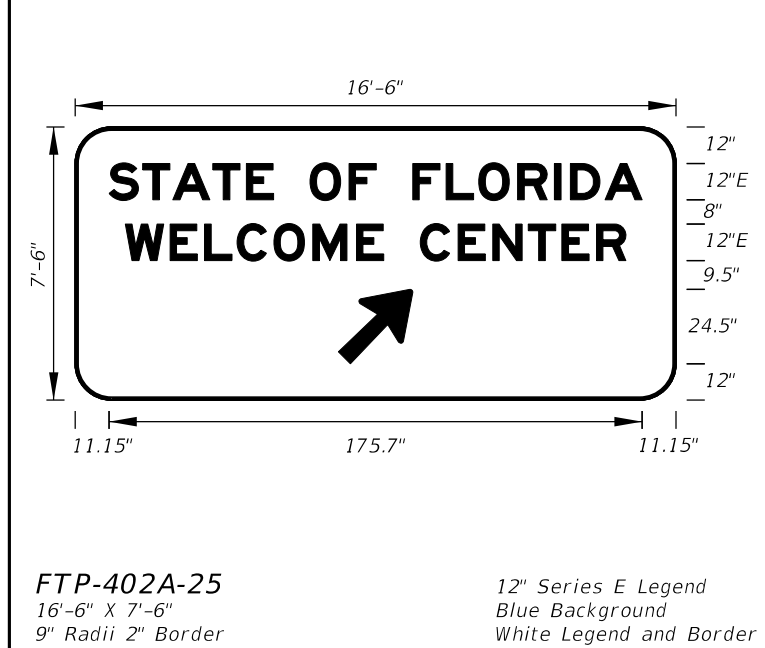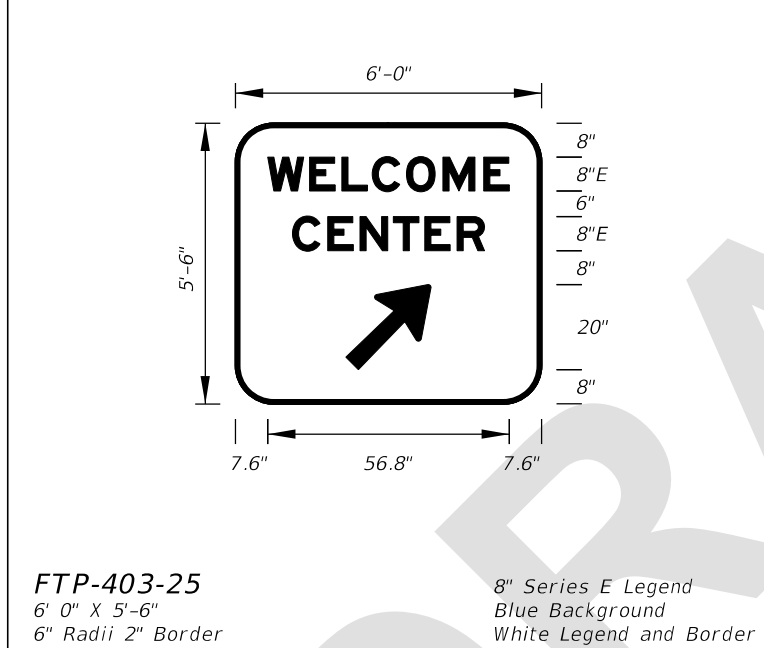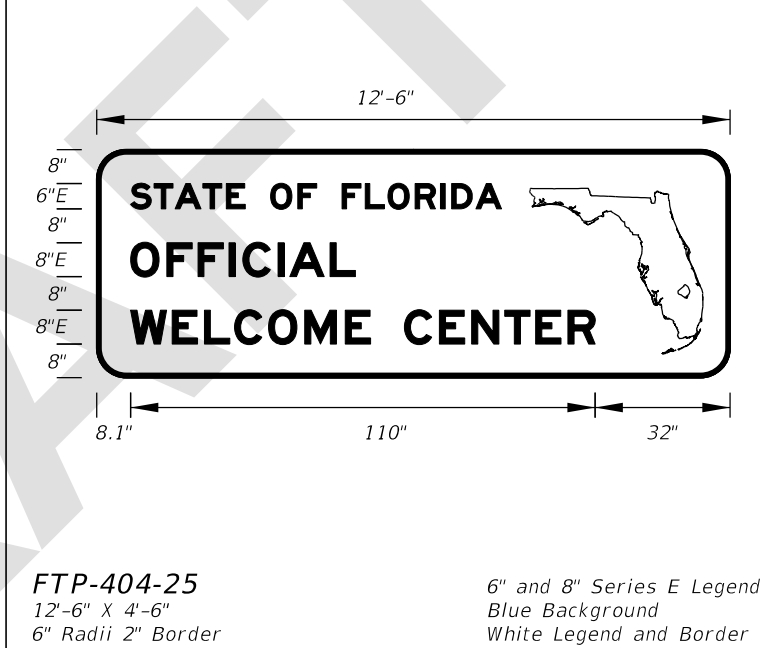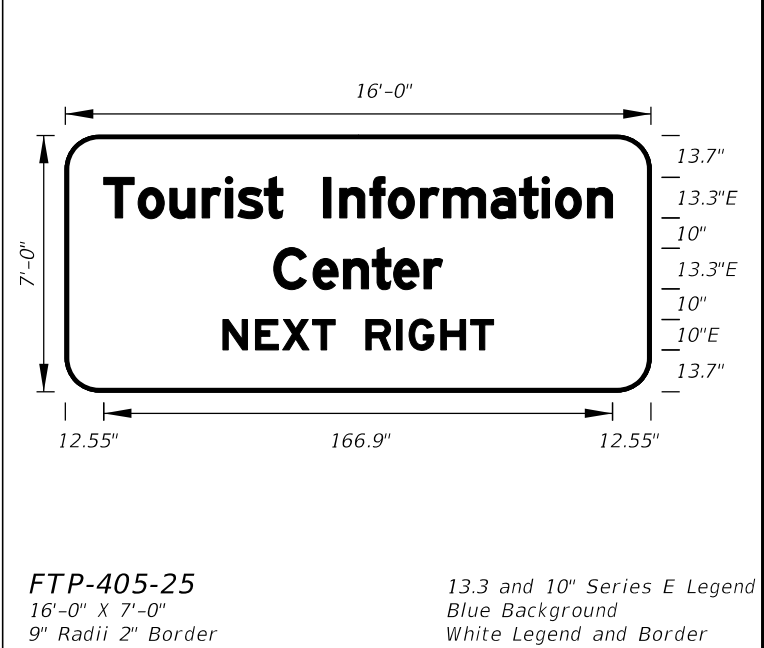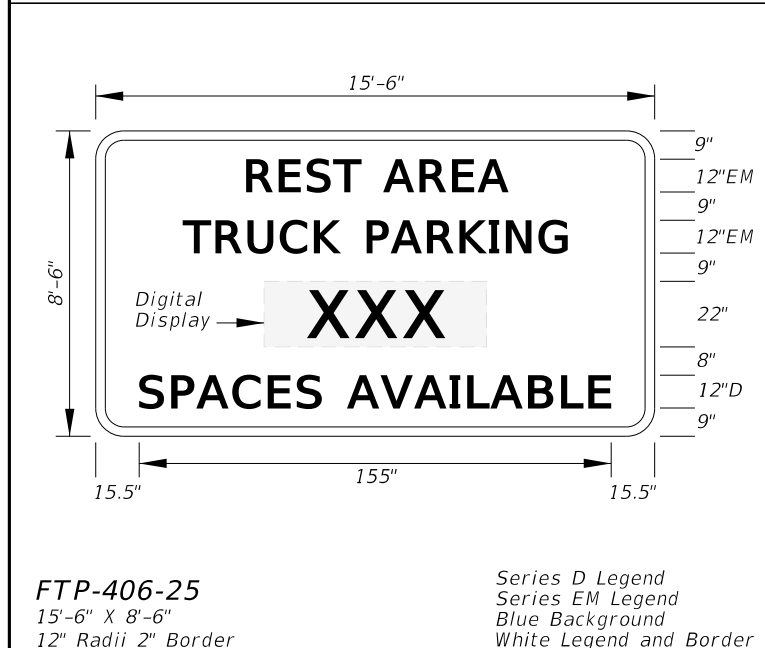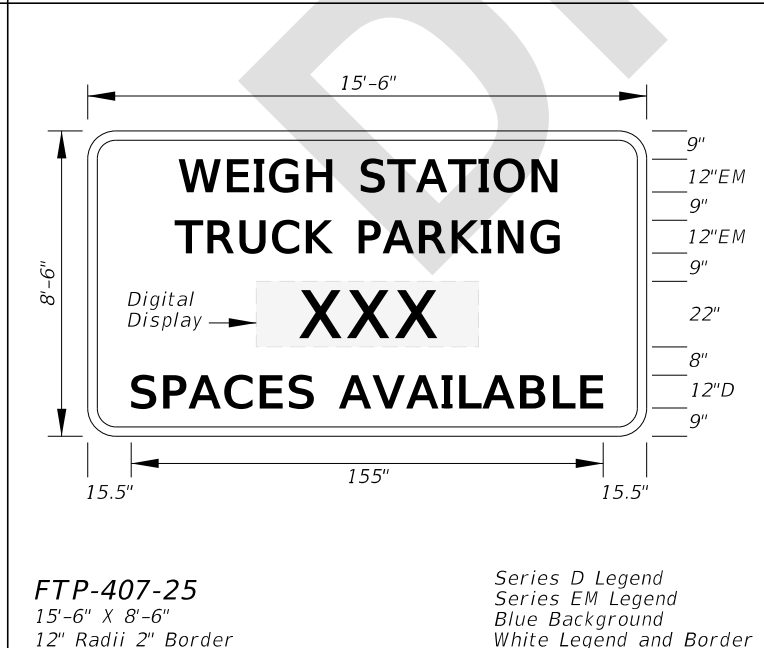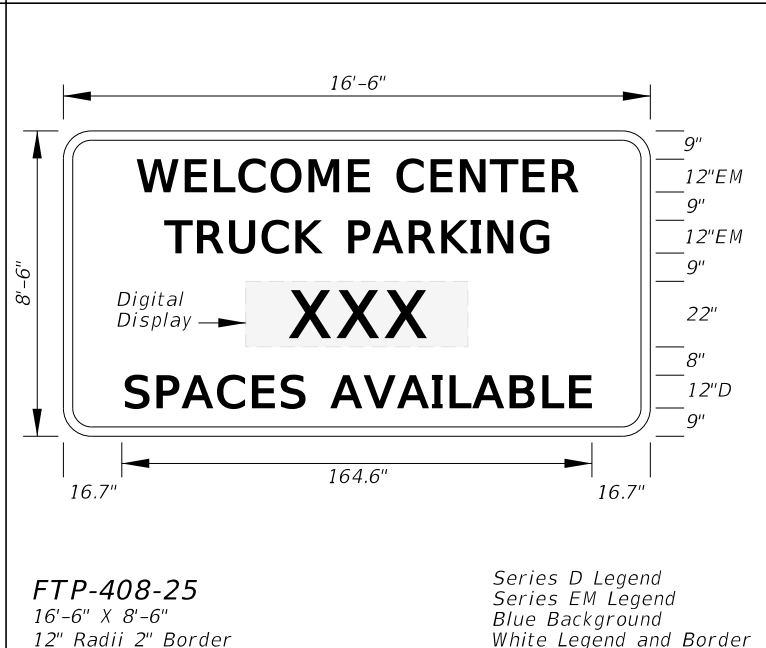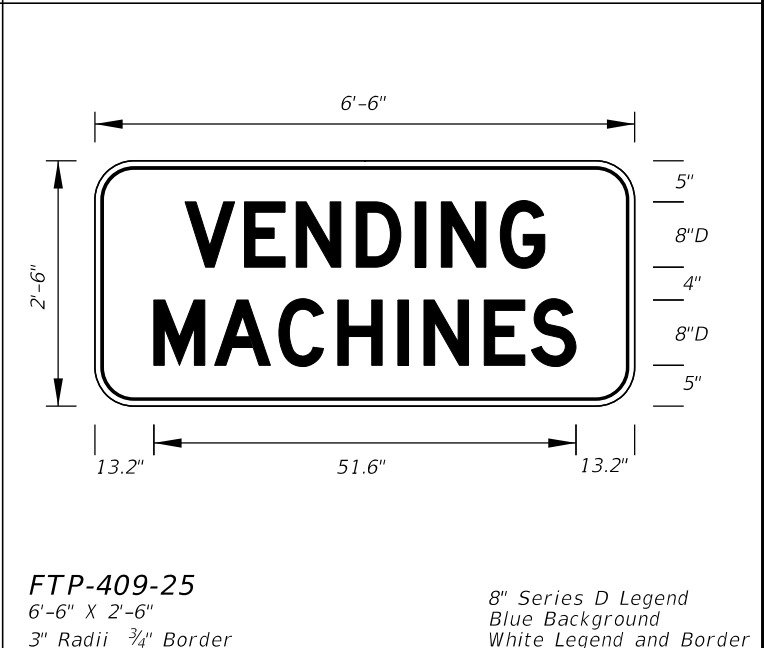
|   |  |   |  |   |  |   |  |                  |                  |
|---|--|---|--|---|--|---|--|------------------|------------------|
|  <p><b>FTP-400-25</b><br/>11'-0" X 4'-6"<br/>6" Radii 2" Border</p> <p>8" Series E Legend<br/>Blue Background<br/>White Legend and Border</p>                       |  |  <p><b>FTP-400A-25</b><br/>17'-0" X 6'-6"<br/>9" Radii 2" Border</p> <p>12", 10" and 15" Series E Legend<br/>Blue Background<br/>White Legend and Border</p>        |  |  <p><b>FTP-401-25</b><br/>11'-0" X 5'-0"<br/>9" Radii 2" Border</p> <p>8" and 12" Series E Legend<br/>Blue Background<br/>White Legend and Border</p>               |  |  <p><b>FTP-402-25</b><br/>11'-0" X 5'-6"<br/>9" Radii 2" Border</p> <p>8" Series E Legend<br/>Blue Background<br/>White Legend and Border</p>             |  |                  |                  |
|  <p><b>FTP-402A-25</b><br/>16'-6" X 7'-6"<br/>9" Radii 2" Border</p> <p>12" Series E Legend<br/>Blue Background<br/>White Legend and Border</p>                   |  |  <p><b>FTP-403-25</b><br/>6' 0" X 5'-6"<br/>6" Radii 2" Border</p> <p>8" Series E Legend<br/>Blue Background<br/>White Legend and Border</p>                      |  |  <p><b>FTP-404-25</b><br/>12'-6" X 4'-6"<br/>6" Radii 2" Border</p> <p>6" and 8" Series E Legend<br/>Blue Background<br/>White Legend and Border</p>              |  |  <p><b>FTP-405-25</b><br/>16'-0" X 7'-0"<br/>9" Radii 2" Border</p> <p>13.3 and 10" Series E Legend<br/>Blue Background<br/>White Legend and Border</p> |  |                  |                  |
|  <p><b>FTP-406-25</b><br/>15'-6" X 8'-6"<br/>12" Radii 2" Border</p> <p>Series D Legend<br/>Series EM Legend<br/>Blue Background<br/>White Legend and Border</p> |  |  <p><b>FTP-407-25</b><br/>15'-6" X 8'-6"<br/>12" Radii 2" Border</p> <p>Series D Legend<br/>Series EM Legend<br/>Blue Background<br/>White Legend and Border</p> |  |  <p><b>FTP-408-25</b><br/>16'-6" X 8'-6"<br/>12" Radii 2" Border</p> <p>Series D Legend<br/>Series EM Legend<br/>Blue Background<br/>White Legend and Border</p> |  |  <p><b>FTP-409-25</b><br/>6'-6" X 2'-6"<br/>3" Radii 3/4" Border</p> <p>8" Series D Legend<br/>Blue Background<br/>White Legend and Border</p>         |  |                  |                  |
| <div>LAST REVISION<br/>11/01/25</div> <div>REVISION</div>   |  | DESCRIPTION:   |  | <div> <b>FY 2026-27</b><br/>STANDARD PLANS</div>   |  | SPECIAL SIGN DETAILS   |  | INDEX<br>700-102 | SHEET<br>9 of 21 |

9/18/2025 10:15:16 AM



6'-6"

2'-6"

5"

8"D

6"

6"D

5"

12.65"

52.7"

12.65"

**FTP-410-25**  
6'-6" X 2'-6"  
3" Radii ¾" Border

6" Series D Legend  
Blue Background  
White Legend and Border



6'-6"

1'-3"

9.4"

59.2"

9.4"

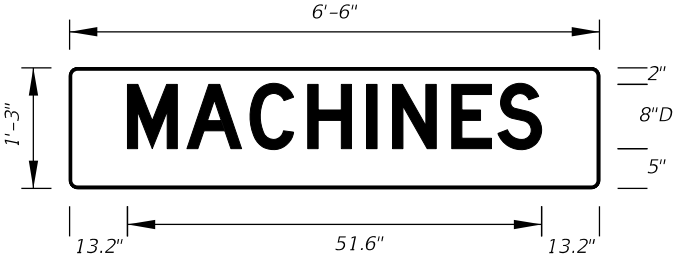
6"

6"D

3"

**FTP-411-25**  
6'-6" X 1'-3"  
1.5" Radii

6" Series D Legend  
Blue Background  
White Legend



6'-6"

1'-3"

13.2"

51.6"

13.2"

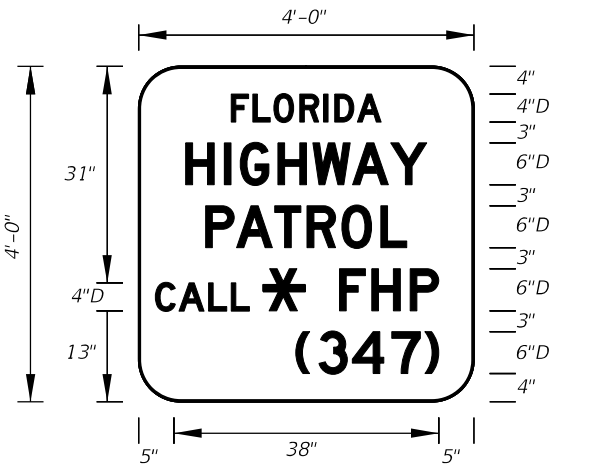
2"

8"D

5"

**FTP-412-25**  
6'-6" X 1'-3"  
1.5" Radii

8" Series D Legend  
Blue Background  
White Legend



4'-0"

31"

4"D

13"

5"

38"

5"

4"

4"D

3"

6"D

3"

6"D

3"

6"D

3"

6"D

4"

**FTP-413-25**  
4'-0" X 4'-0"  
3" Radii 1" Border

4" and 6" Series D Legend  
Blue Background  
White Legend and Border



4'-0"

5'-0"

6.5"

14"

5"

6"D

5"

6"D

5"

6"D

6.5"

6.6"

34.8"

6.6"

**FTP-414-25**  
4'-0" X 5'-0"  
3" Radii 1" Border

6" Series D Legend  
Blue Background  
White Legend and Border



5'-6"

6'-0"

7"

16"

6"

8"D

6"

8"D

6"

8"D

7"

16.5"

53"

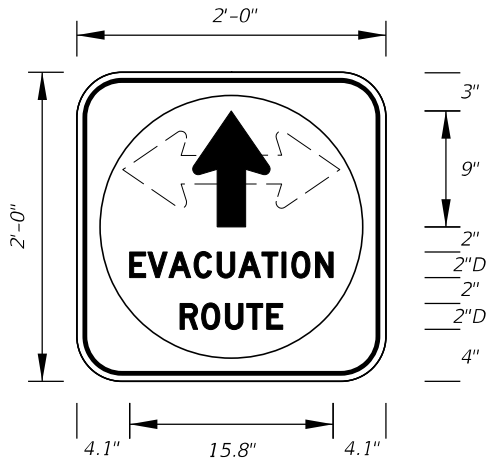
16.5"

**FTP-414A-25**  
5'-6" X 6'-0"  
3" Radii 1" Border

8" Series D Legend  
Blue Background  
White Legend and Border



DETAIL for **FTP-414-25** AND **FTP-414A-25**



2'-0"

2'-0"

4.1"

15.8"

4.1"

3"

9"

2"

2"D

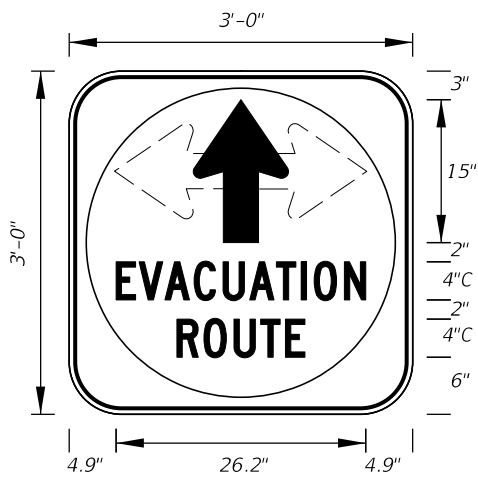
2"

2"D

4"

**FTP-415-25**  
2'-0" X 2'-0"  
1.5" Radii ¾" Border

2" Series D Legend  
White Background with Blue Circle  
Background  
White Legend and Black Border



3'-0"

3'-0"

4.9"

26.2"

4.9"

3"

15"

2"

4"C

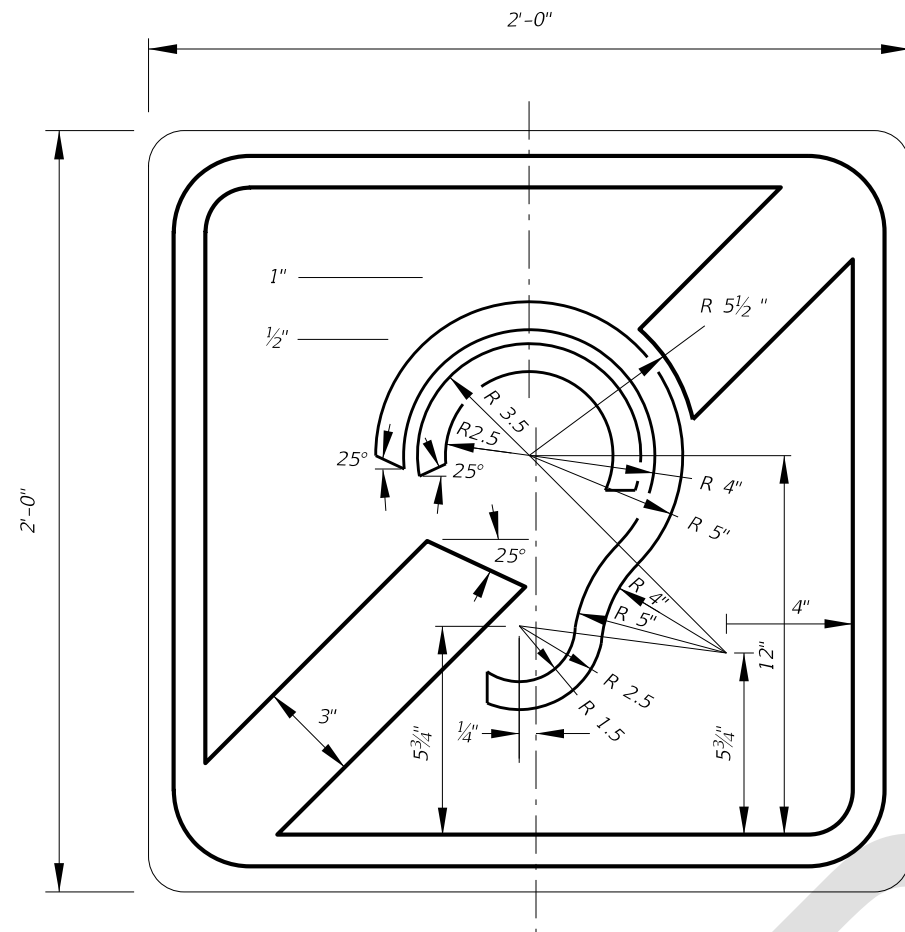
2"

4"C

6"

**FTP-415A-25**  
3'-0" X 3'-0"  
1.5" Radii ¾" Border


4" Series C Legend  
White Background with Blue Circle  
Background  
White Legend and Black Border



INTERNATIONAL SYMBOL OF  
ACCESS FOR HEARING LOSS

FTP-416-25  
2'-0" X 2'-0"  
1.5" Radii 5/8" Border

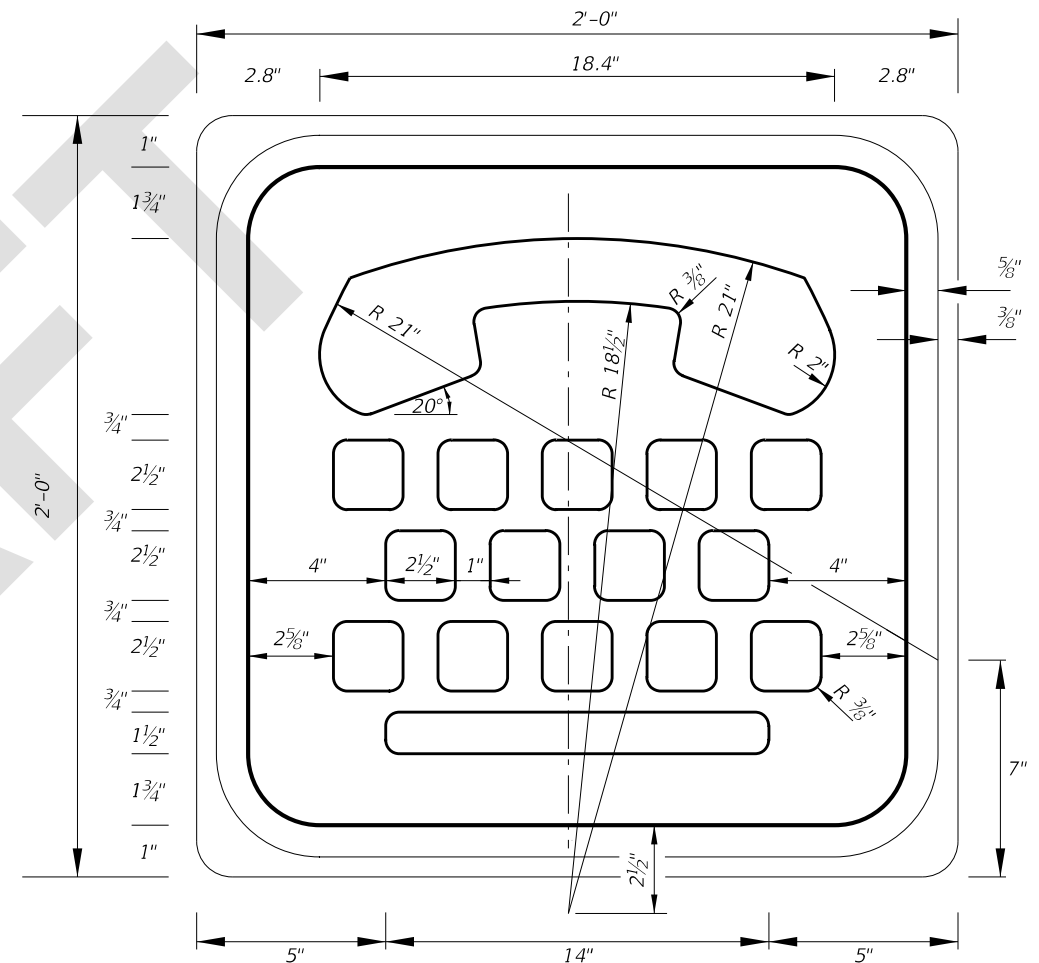Blue Background  
White Legend and Border



INTERNATIONAL TDD SYMBOL

FTP-417-25  
2'-0" X 2'-0"  
1.5" Radii 5/8" Border

Blue Background  
White Legend and Border

9/18/2025 10:15:40 AM

Non-Limited Access

FTP-418-25

3'-0" X 2'-0"

1.5" Radii

4" and 3" Series C Legend  
Blue Background  
White Legend and Border

Limited Access

FTP-418A-25

6'-6" X 4'-0"

3" Radii 3/4" Border

8" and 6" Series D Legend  
Blue Background  
White Legend and Border

Non-Limited Access

FTP-419-25

3'-0" X 2'-0"

1.5" Radii

4" and 3" Series C Legend  
Blue Background  
White Legend and Border

Limited Access

FTP-419A-25

6'-6" X 4'-0"

3" Radii 3/4" Border

8" and 6" Series D Legend  
Blue Background  
White Legend and Border

Non-Limited Access

FTP-420-25

3'-0" X 2'-0"

1.5" Radii

4" and 3" Series C Legend  
Blue Background  
White Legend and Border

Limited Access

FTP-420A-25

6'-6" X 4'-0"

3" Radii 3/4" Border

8" and 6" Series D Legend  
Blue Background  
White Legend and Border

Non-Limited Access

FTP-421-25

3'-0" X 2'-6"

1.5" Radii 0.8" Border

3" Series D Legend  
Blue Background  
White Legend and Border

Limited Access

FTP-421A-25

6'-0" X 3'-6"

1.5" Radii 0.8" Border

4" Series D Legend  
Blue Background  
White Legend and Border

FTP-421B-25

12'-0" X 6'-0"

9" Radii 1.5" Border

8" Series D Legend  
Blue Background  
White Legend and Border

FTP-422-25

2'-0" X 1'-6"

1.5" Radii 0.5" Border

3" and 4" Series C Legend  
Blue Background  
White Legend and Border

FTP-422A-25

3'-0" X 2'-0"

1.5" Radii 0.8" Border

4.5" and 6" Series C Legend  
Blue Background  
White Legend and Border

FTP-422B-25

3'-6" X 2'-6"

1.5" Radii 3/4" Border

5" and 7" Series C Legend  
Blue Background  
White Legend and Border

TRAFFIC INFO  
TUNE RADIO TO  
0000 AM

8'-0"

4'-0"

16.3"34.4"11.2"17.8"16.3"

6.9"8"D5.1"6"D3"10"D6.9"

TRAFFIC INFO  
TUNE RADIO TO  
0000 AM

10'-0"

5'-0"

21.9"41.3"13.5"21.4"21.9"

8.7"10"D6.7"7"D6.8"12"D8.7"

FTP-423-25  
8'-0" X 4'-0"  
3" Radii 3/4" Border

6", 8" and 10" Series D Legend  
Blue Background  
White Legend and Border

FTP-423A-25  
10'-0" X 5'-0"  
9" Radii 2" Border

7", 10" and 12" Series D Legend  
Blue Background  
White Legend and Border

LAST  
REVISION  
11/01/25

REVISION

DESCRIPTION:





FY 2026-27  
STANDARD PLANS

SPECIAL SIGN DETAILS


INDEX  
700-102

SHEET  
13 of 21

|   |  |   |  |   |  |   |  |
|---|--|---|--|---|--|---|--|
| <div>Other Than Freeway Use</div> <div> <div>FTP-600-25</div> <div>4'-0" X 3'-6"</div> <div>1.5" Radii 2" Border</div> </div> <div> <div>6" Series E Legend</div> <div>Green Background</div> <div>White Legend and Border</div> </div> |  | <div>Other Than Freeway Use</div> <div> <div>FTP-601-25</div> <div>14'-0" X 8'-0"</div> <div>9" Radii 2" Border</div> </div> <div> <div>12" and 10" Series E Legend</div> <div>Green Background</div> <div>White Legend and Border</div> </div>                                     |  | <div>Other Than Freeway Use</div> <div> <div>FTP-602-25</div> <div>4'-0" X 1'-6"</div> <div>1.5" Radii 2" Border</div> </div> <div> <div>6" Series E Legend</div> <div>Green Background</div> <div>White Legend and Border</div> </div> <div>NOTE:<br/>FTP-602-25 to be used with FTP-600-25</div> |  | <div>Freeway Use</div> <div> <div>FTP-602A-25</div> <div>6'-6" X 2'-0"</div> <div>1.5" Radii 2" Border</div> </div> <div> <div>10" Series E Legend</div> <div>Green Background</div> <div>White Legend and Border</div> </div> <div>NOTE:<br/>FTP-620A-25 to be used with FTP-604R-25</div> |  |
| <div> <div>FTP-603R-25</div> <div>FTP-603L-25</div> <div>14'-6" X 7'-0"</div> <div>9" Radii 2" Border</div> </div> <div> <div>10" Series E Legend</div> <div>Green Background</div> <div>White Legend and Border</div> </div>           |  | <div> <div>FTP-604R-25</div> <div>FTP-604L-25</div> <div>12'-0" X 7'-0"</div> <div>9" Radii 2" Border</div> </div> <div> <div>10" Series E Legend</div> <div>Green Background</div> <div>White Legend and Border</div> </div> <div>NOTE:<br/>Use FTP-604L-25 for "NEXT LEFT".</div> |  | <div> <div>FTP-605R-25</div> <div>10'-0" X 5'-0"</div> <div>9" Radii</div> </div> <div> <div>10" Series E Legend</div> <div>Green Background</div> <div>White Legend</div> </div> <div>NOTE:<br/>Use FTP-605L-25 for LEFT ARROW.</div>                                                             |  | <div> <div>FTP-606-25</div> <div>3'-0" X 3'-0"</div> <div>1.5" Radii</div> </div> <div> <div>4" Series D Legend</div> <div>Green Background</div> <div>White Legend and Border</div> </div>                                                                                                 |  |
| <div> <div>FTP-607-25</div> <div>3'-6" X 5'-0"</div> <div>1.5" Radii</div> </div> <div> <div>4" Series C Legend</div> <div>Green Background</div> <div>White Legend, Border and Symbol</div> </div>                                     |  | <div> <div>FTP-608-25</div> <div>3'-6" X 5'-6"</div> <div>3" Radii</div> </div> <div> <div>4" Series C Legend</div> <div>Green Background</div> <div>Municipality Name Optional</div> <div>White Legend, Border and Symbol</div> </div>                                             |  | <div>Detail for FTP-607-25 and FTP-608-25</div>   |  | <div> <div>FTP-609-25</div> <div>1'-6" X 5'-0"</div> <div>1.5" Radii 0.8" Border</div> </div> <div> <div>6" Series B, 6" series C</div> <div>8" Series B, and 8" Series C</div> <div>Green Background</div> <div>White Legend and Border</div> </div>                                       |  |
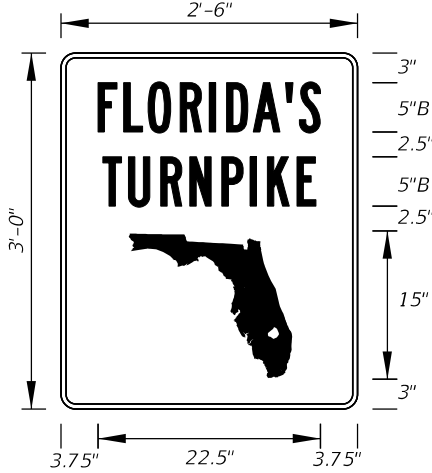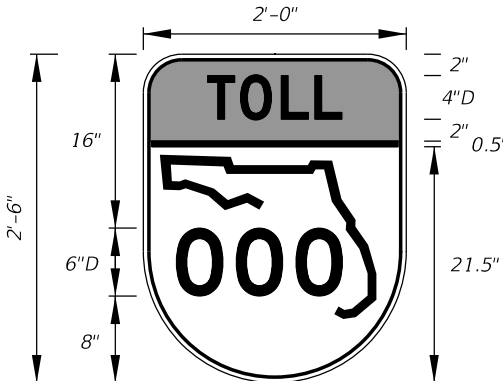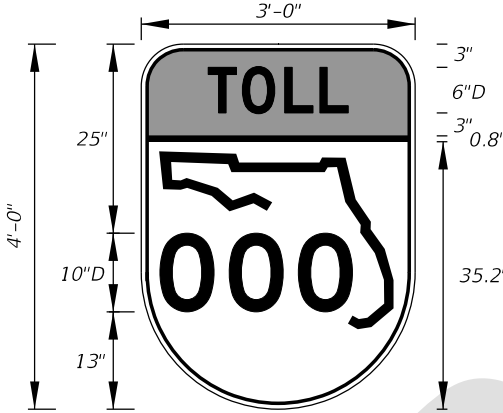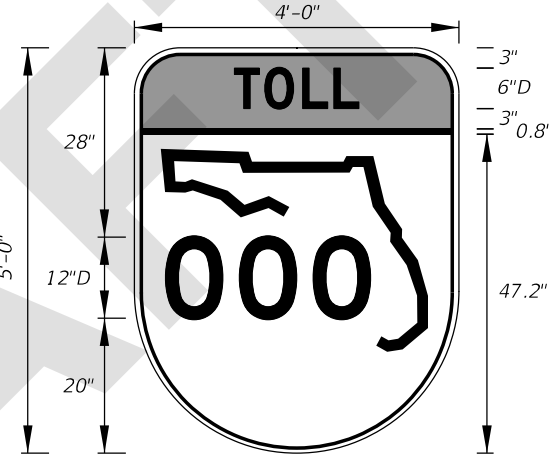
|   |   |   |
|---|---|---|
|  <p><b>FTP-610-25</b><br/>2'-6" X 3'-0"<br/>1.5" Radii <math>\frac{3}{4}</math>" Border</p> <p>5" Series B Legend<br/>Green Background<br/>White Legend, Border,<br/>and Florida Symbol</p>                                                                            |  <p><b>FTP-610A-25</b><br/>3'-0" X 4'-0"<br/>1.5" Radii <math>\frac{3}{4}</math>" Border</p> <p>7" Series B Legned<br/>Green Background<br/>White Legend, Border,<br/>and Florida Symbol</p>                                                                           |  <p><b>FTP-610B-25</b><br/>4'-0" X 5'-0"<br/>3" Radii <math>1\frac{1}{4}</math>" Border</p> <p>8" Series B Legend<br/>Green Background<br/>White Legend, Border,<br/>and Florida Symbol</p>                                                                            |
|  <p><b>FTP-611-25</b><br/>2'-0" X 2'-6"<br/>1.5" Radii <math>\frac{3}{4}</math>" Border</p> <p>TOP:<br/>4" Series D Legend<br/>Yellow Background<br/>Black Legend and Border<br/>BOTTOM:<br/>6" Series D Legend<br/>White Background<br/>Black Legend and Border</p> |  <p><b>FTP-611A-25</b><br/>3'-0" X 4'-0"<br/>3" Radii <math>\frac{3}{4}</math>" Border</p> <p>TOP:<br/>6" Series D Legend<br/>Yellow Background<br/>Black Legend and Border<br/>BOTTOM:<br/>10" Series D Legend<br/>White Background<br/>Black Legend and Border</p> |  <p><b>FTP-611B-25</b><br/>4'-0" X 5'-0"<br/>3" Radii <math>\frac{3}{4}</math>" Border</p> <p>TOP:<br/>6" Series D Legend<br/>Yellow Background<br/>Black Legend and Border<br/>BOTTOM:<br/>12" Series D Legend<br/>White Background<br/>Black Legend and Border</p> |

|                              |              |   |                      |                  |                   |
|------------------------------|--------------|---|----------------------|------------------|-------------------|
| LAST<br>REVISION<br>11/01/25 | DESCRIPTION: | <div></div> <div>FY 2026-27<br/>STANDARD PLANS</div> | SPECIAL SIGN DETAILS | INDEX<br>700-102 | SHEET<br>15 of 21 |
|------------------------------|--------------|---|----------------------|------------------|-------------------|

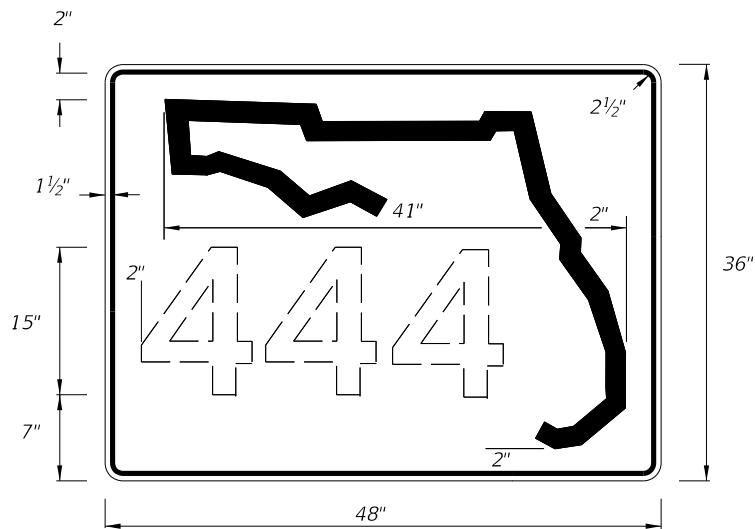


| DIGITS | NUMERAL SIZE | SERIES LEGEND | PANEL SIZE |
|--------|--------------|---------------|------------|
| 1-3    | 15"          | C             | 48" x 36"  |
| 4      | 12"          | C             | 48" x 36"  |


**NOTES:**

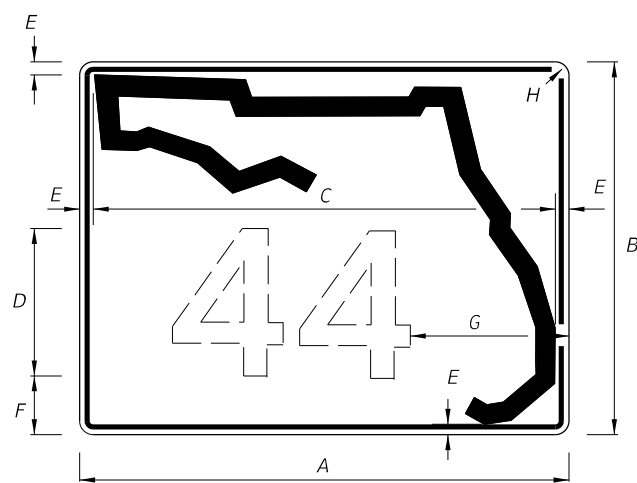- Stroke width of State Outline shall be 1".
- 2 1/2" Radii

**INDEPENDENT USE FOR FREEWAY**



**1 OR 2 DIGITS**

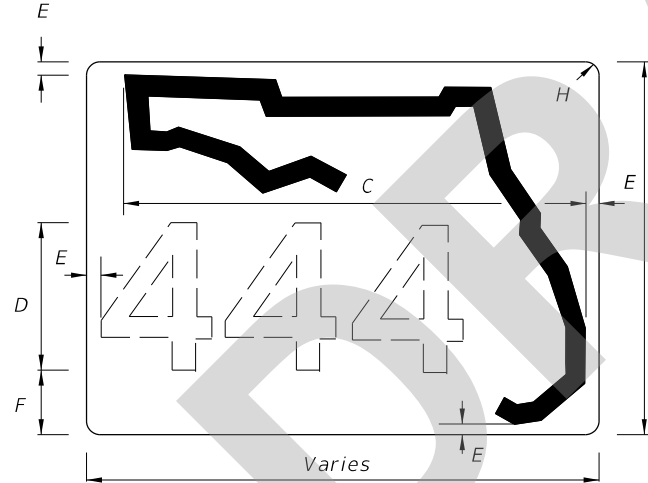

**3 OR MORE DIGITS**

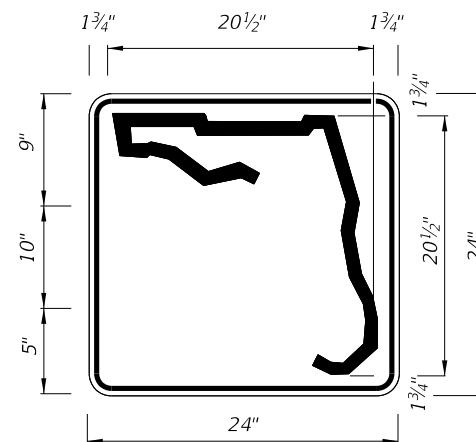
**NOTES:**

- Florida marker shall have Black Legend with White Background.
- Stroke width of State outline shall be 1 3/4" for Guide Sign.
- Series D Legend.
- Width varies with the number scheme combination, within a range of 48"-58."

| A   | B   | C   | D   | E      | F      | G      | H      |
|-----|-----|-----|-----|--------|--------|--------|--------|
| 30" | 24" | 26" | 12" | 1 1/4" | 2 3/4" | 8 1/4" | 1 1/4" |
| 36" | 30" | 32" | 15" | 1 1/4" | 3 1/4" | 8 3/4" | 1 1/4" |
| 42" | 36" | 38" | 15" | 1 1/4" | 6 1/4" | 11"    | 1 1/4" |


**GUIDE SIGN USE**

**FTP-612-25 - FLORIDA ROUTE MARKER**



**1 or 2 DIGITS**
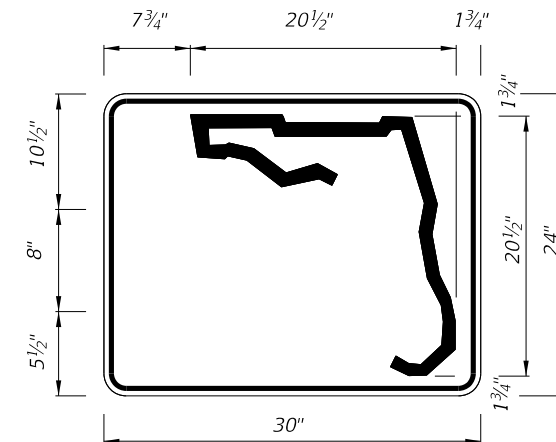
| DIGITS | NUMERAL SIZE | SERIES LEGEND | PANEL SIZE |
|--------|--------------|---------------|------------|
| 1-2    | 10"          | D             | 24" x 24"  |



**3 or 4 DIGITS**

| DIGITS | NUMERAL SIZE | SERIES LEGEND | PANEL SIZE |
|--------|--------------|---------------|------------|
| 3      | 8"           | D             | 30" x 24"  |
| 4      | 8"           | C             | 30" x 24"  |

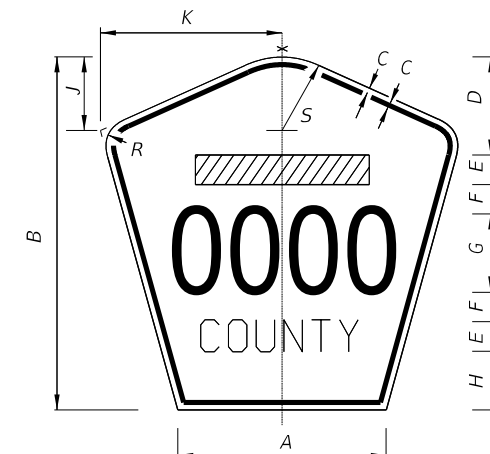
**NOTES:**

- Stroke width of State Outline shall be 1".
- The 24" X 24" panel shall only be used for a 3 digit route when the panel is to be used on a sign cluster with other 24" X 24" panels.
- 1 1/2" Radii

**INDEPENDENT USE OTHER THAN FREEWAY**

**NOTES:**

- Series D Legend, all upper case.
- Color: Yellow Legend and Border on Blue Background.
- When used on a guide sign, marker must be overlaid on a square Yellow Background as shown in chart.
- When two or more County Route Markers are mounted together, use the dimensions of the largest marker for all other markers.



| SIGN                 | DIMENSIONS |     |      |        |    |    |     |        |        |         |        |         | Rectangular Yellow Background Dimensions (See Note 3) |
|----------------------|------------|-----|------|--------|----|----|-----|--------|--------|---------|--------|---------|-------------------------------------------------------|
|                      | A          | B   | C    | D      | E  | F  | G   | H      | J      | K       | R      | S       |                                                       |
| 4 DIGIT POST MOUNTED | 25 1/8"    | 42" | 3/4" | 10"    | 4" | 4" | 8"  | 8"     | 8 3/8" | 22"     | 5"     | 8 3/4"  |                                                       |
| 2 DIGIT OVERHEAD     | 21 1/2"    | 36" | 1/2" | 7 1/2" | 3" | 3" | 12" | 4 1/2" | 7 1/8" | 18 7/8" | 4 1/4" | 7 1/2"  | 42"x 42"                                              |
| 3 DIGIT OVERHEAD     | 25 1/8"    | 42" | 3/4" | 8"     | 4" | 4" | 12" | 6"     | 8 3/8" | 22"     | 5"     | 8 3/4"  | 48"x 48"                                              |
| 4 DIGIT OVERHEAD     | 29 7/8"    | 48" | 3/4" | 8"     | 5" | 5" | 12" | 8"     | 9 3/4" | 25 5/8" | 5 3/4" | 10 1/4" | 52"x 52"                                              |

**FTP-613-25 - COUNTY ROUTE MARKER (M1-6)**

|   |  |   |  |   |  |   |  |
|---|--|---|--|---|--|---|--|
| <div><div>Non-Limited Access</div><div><div><div>FTP-614-25</div><div>2'-0" X 2'-0"</div><div>1.5" Radii 0.75" Border</div></div><div><div>Green Background</div><div>White Legend, Border and Symbol</div></div></div></div> |  | <div><div>Limited Access</div><div><div><div>FTP-614A-25</div><div>2'-6" X 2'-6"</div><div>1.5" Radii 0.75" Border</div></div><div><div>Green Background</div><div>White Legend, Border and Symbol</div></div></div></div> |  | <div><div>Non-Limited Access</div><div><div><div>FTP-615-25</div><div>2'-0" X 2'-0"</div><div>1.5" Radii 0.5" Border</div></div><div><div>Green Background</div><div>White Legend, Border and Symbol</div></div></div></div> |  | <div><div>Limited Access</div><div><div><div>FTP-615A-25</div><div>2'-6" X 2'-6"</div><div>1.5" Radii 0.75" Border</div></div><div><div>Green Background</div><div>White Legend, Border and Symbol</div></div></div></div> |  |
| <div><div>Non-Limited Access</div><div><div><div>FTP-616-25</div><div>2'-0" X 2'-0"</div><div>1.5" Radii 0.75" Border</div></div><div><div>Green Background</div><div>White Legend, Border and Symbol</div></div></div></div> |  | <div><div>Limited Access</div><div><div><div>FTP-616A-25</div><div>2'-6" X 2'-6"</div><div>1.5" Radii 0.75" Border</div></div><div><div>Green Background</div><div>White Legend, Border and Symbol</div></div></div></div> |  |   |  |   |  |

|                           |  |          |              |                                                                                                |                      |  |                  |                   |
|---------------------------|--|----------|--------------|------------------------------------------------------------------------------------------------|----------------------|--|------------------|-------------------|
| LAST REVISION<br>11/01/25 |  | REVISION | DESCRIPTION: | <div><div><div><div>FDOT</div><div>FY 2026-27</div><div>STANDARD PLANS</div></div></div></div> | SPECIAL SIGN DETAILS |  | INDEX<br>700-102 | SHEET<br>17 of 21 |
|---------------------------|--|----------|--------------|------------------------------------------------------------------------------------------------|----------------------|--|------------------|-------------------|

**FTP-800-25**  
4'-6" X 2'-0"  
1.5" Radii 0.5" Border

5" Series B Legend  
2" Series C Legned  
Brown Background  
Yellow Legend and Border

**FTP-800A-25**  
4'-6" X 2'-6"  
1.5" Radii 0.5" Border

5" Series B Legend  
2" Series C Legned  
Brown Background  
Yellow Legend and Border

**FTP-801-25**  
4'-0" X 2'-6"  
1.5" Radii

4" Series C Legend and  
2" Series EM Legend  
White Background  
Blue Legend and Border

**FTP-802-25**  
2'-0" X 1'-4"

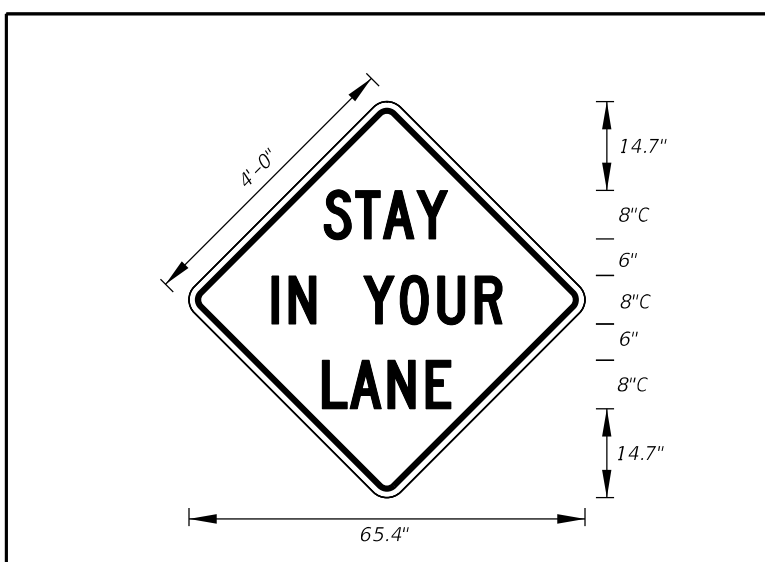
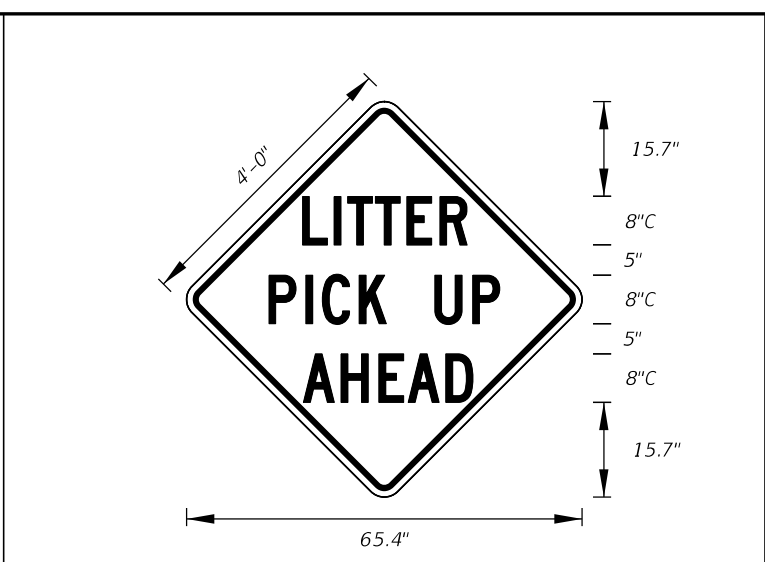
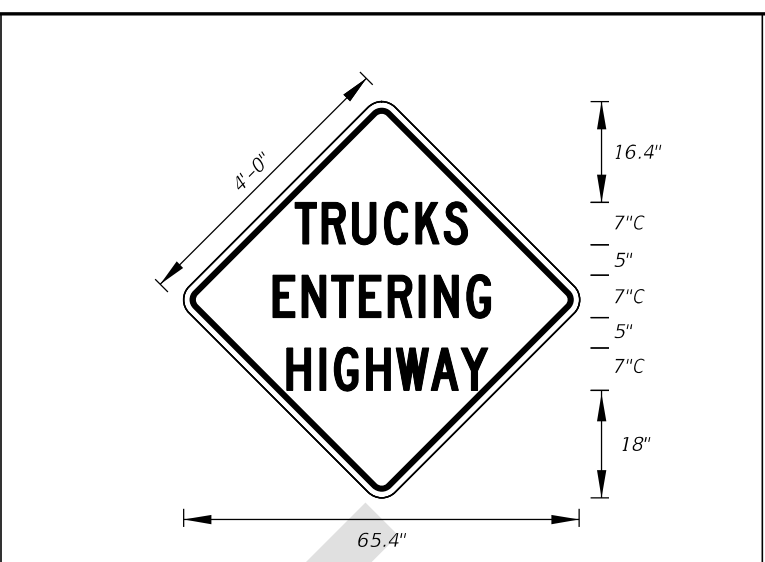
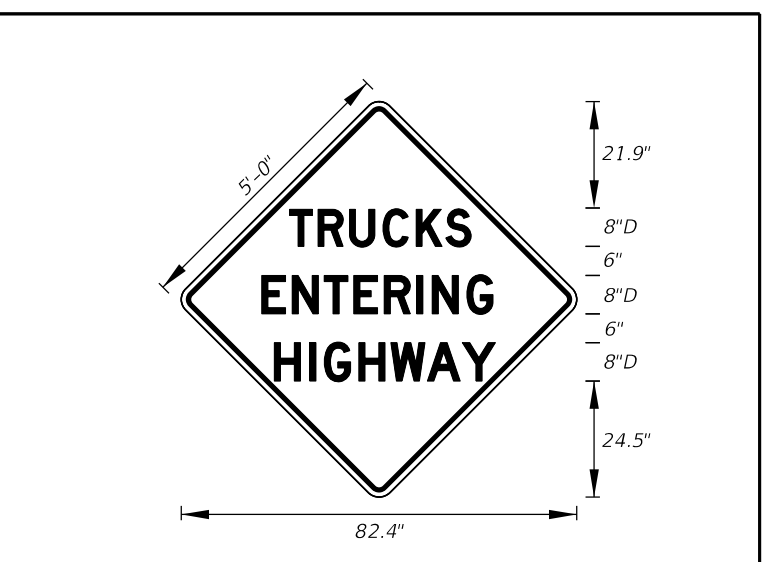
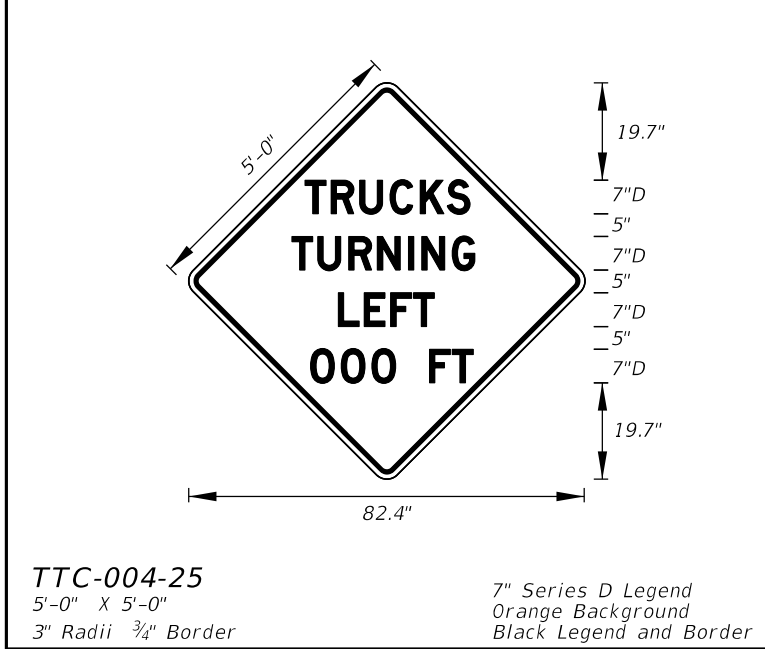
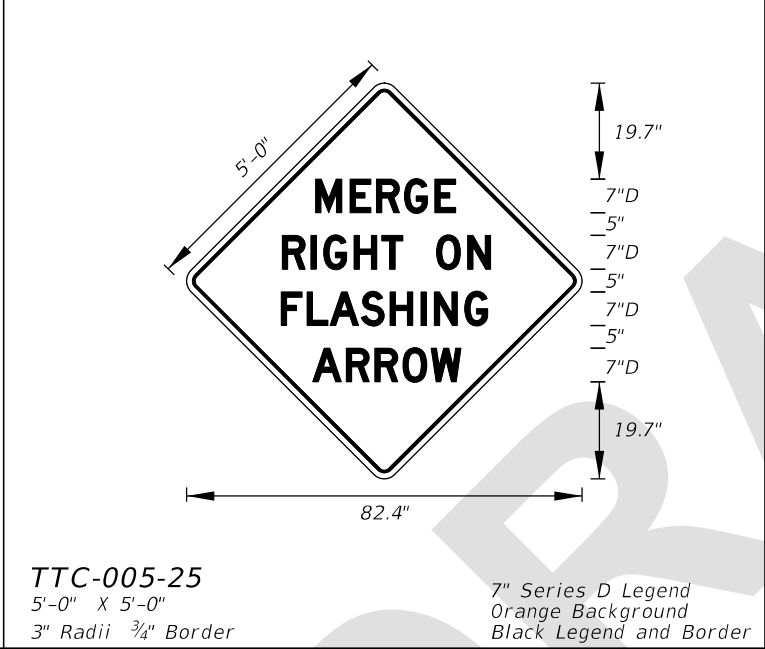
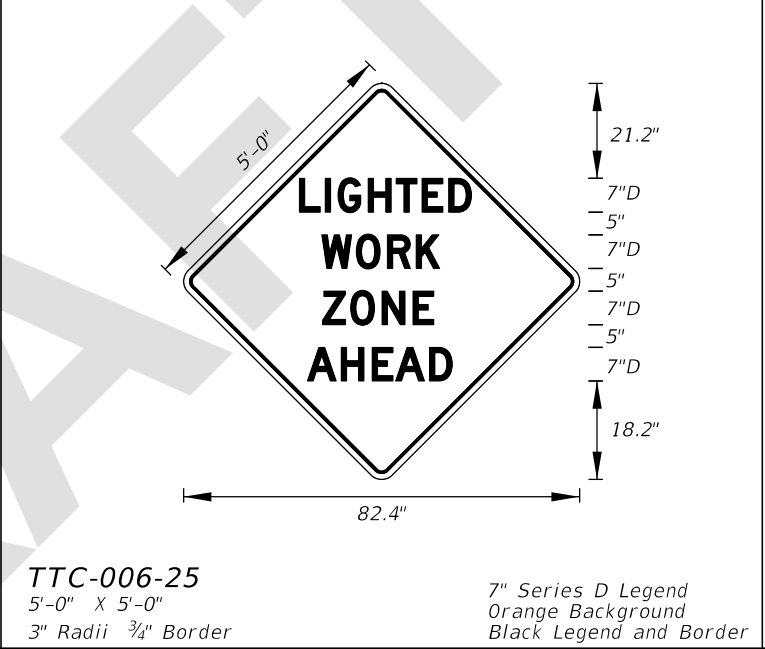
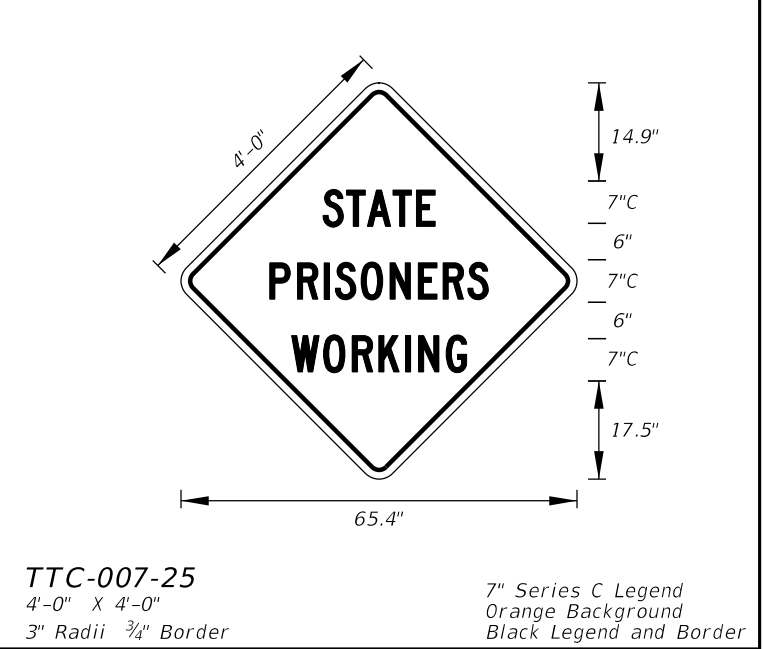
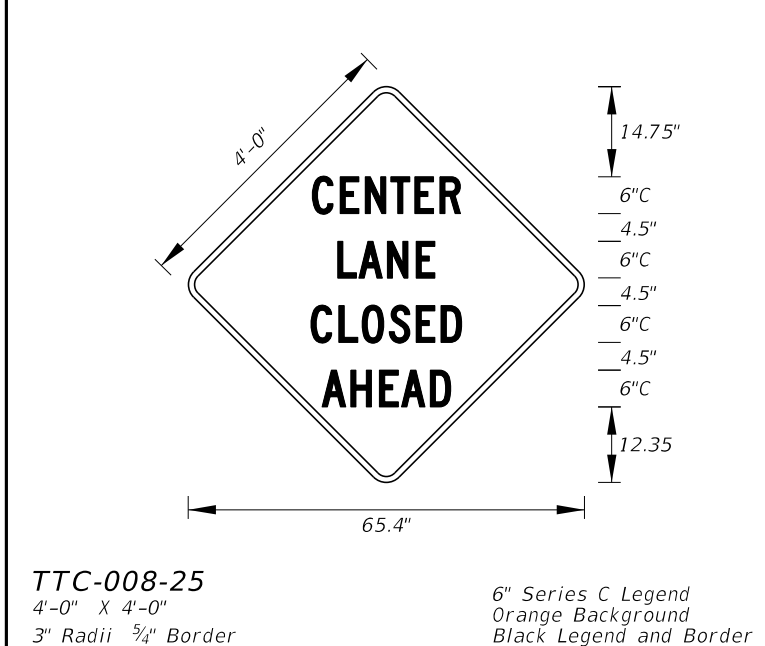
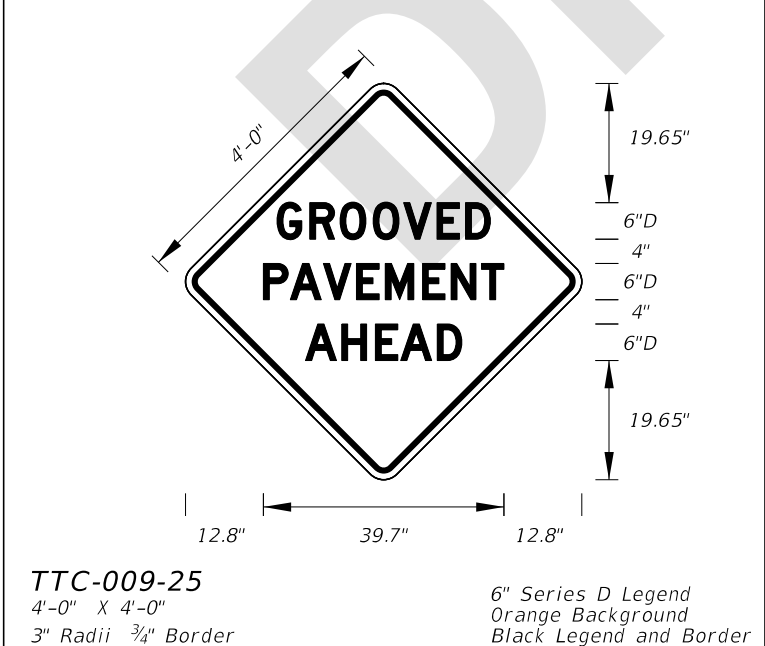
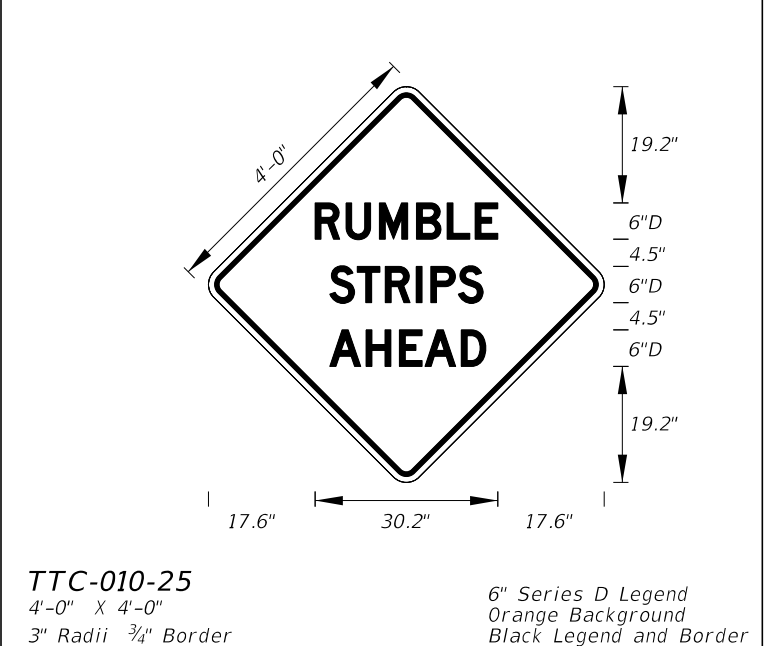
NOTE:  
To be installed with Co-location  
of route Confirmation Marker

**FTP-802A-25**  
3'-0" X 2'-0"










NOTE:  
Install at the Florida Scenic  
Highway Entrance Points


9/18/2025 10:16:42 AM

9/18/2025


|   |   |   |   |
|---|---|---|---|
|  <p><b>TTC-001-25</b><br/>4'-0" X 4'-0"<br/>3" Radii 3/4" Border</p> <p>8" Series C Legend<br/>Orange Background<br/>Black Legend and Border</p>     |  <p><b>TTC-002-25</b><br/>4'-0" X 4'-0"<br/>3" Radii 3/4" Border</p> <p>8" Series C Legend<br/>Orange Background<br/>Black Legend and Border</p>     |  <p><b>TTC-003-25</b><br/>4'-0" X 4'-0"<br/>3" Radii 3/4" Border</p> <p>7" Series C Legend<br/>Orange Background<br/>Black Legend and Border</p>     |  <p><b>TTC-003A-25</b><br/>5'-0" X 5'-0"<br/>3" Radii 3/4" Border</p> <p>8" Series D Legend<br/>Orange Background<br/>Black Legend and Border</p>   |
|  <p><b>TTC-004-25</b><br/>5'-0" X 5'-0"<br/>3" Radii 3/4" Border</p> <p>7" Series D Legend<br/>Orange Background<br/>Black Legend and Border</p>  |  <p><b>TTC-005-25</b><br/>5'-0" X 5'-0"<br/>3" Radii 3/4" Border</p> <p>7" Series D Legend<br/>Orange Background<br/>Black Legend and Border</p>  |  <p><b>TTC-006-25</b><br/>5'-0" X 5'-0"<br/>3" Radii 3/4" Border</p> <p>7" Series D Legend<br/>Orange Background<br/>Black Legend and Border</p>  |  <p><b>TTC-007-25</b><br/>4'-0" X 4'-0"<br/>3" Radii 3/4" Border</p> <p>7" Series C Legend<br/>Orange Background<br/>Black Legend and Border</p> |
|  <p><b>TTC-008-25</b><br/>4'-0" X 4'-0"<br/>3" Radii 3/4" Border</p> <p>6" Series C Legend<br/>Orange Background<br/>Black Legend and Border</p> |  <p><b>TTC-009-25</b><br/>4'-0" X 4'-0"<br/>3" Radii 3/4" Border</p> <p>6" Series D Legend<br/>Orange Background<br/>Black Legend and Border</p> |  <p><b>TTC-010-25</b><br/>4'-0" X 4'-0"<br/>3" Radii 3/4" Border</p> <p>6" Series D Legend<br/>Orange Background<br/>Black Legend and Border</p> |   |

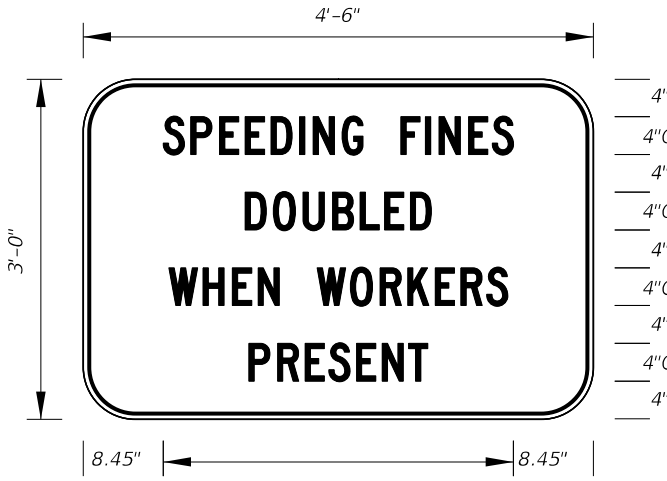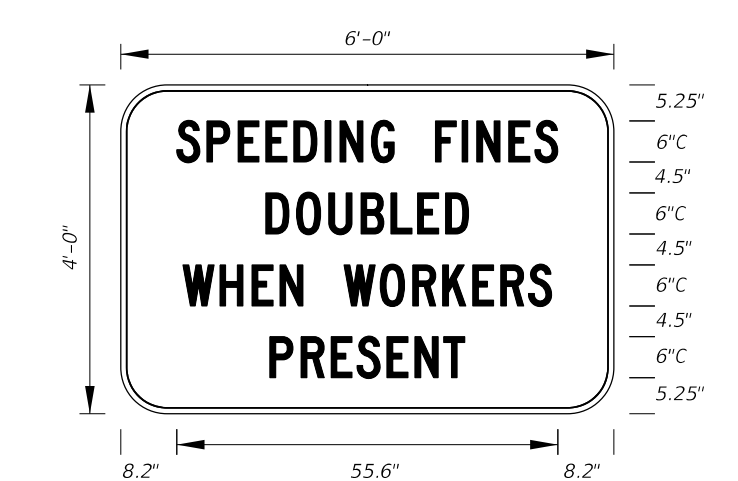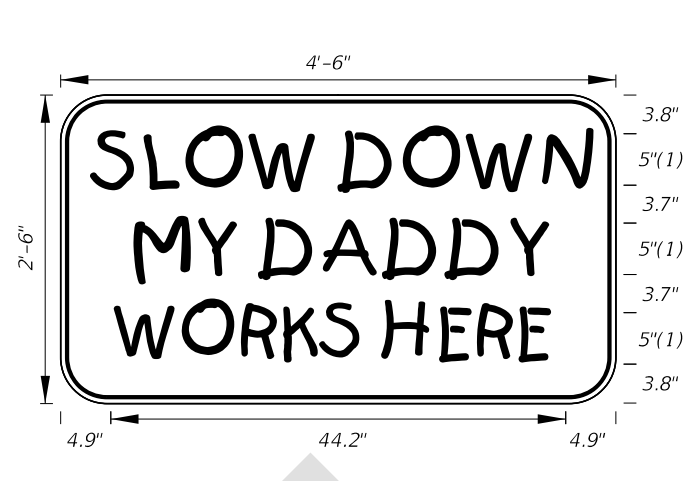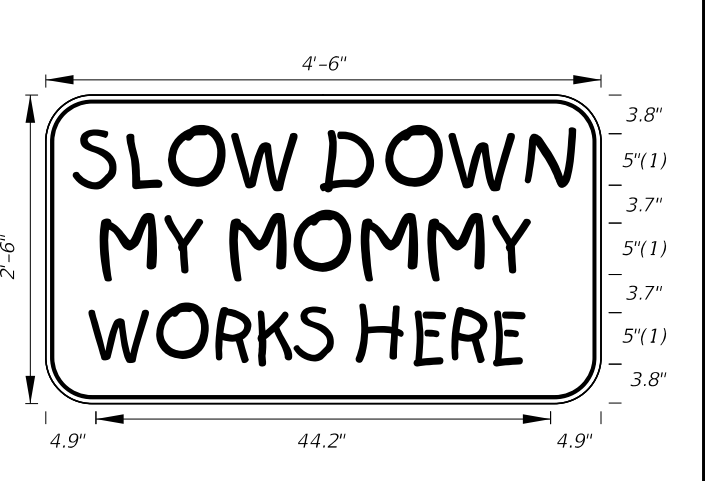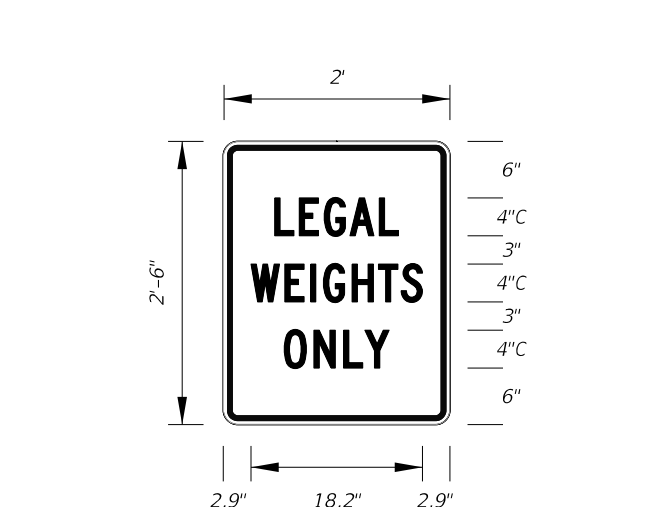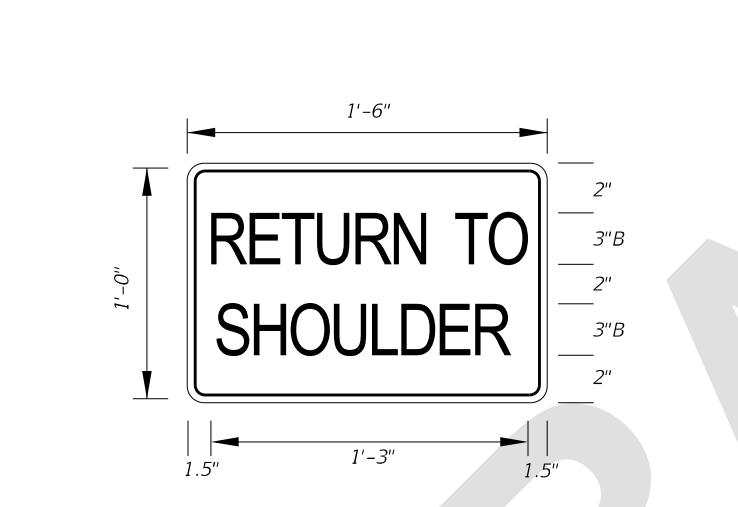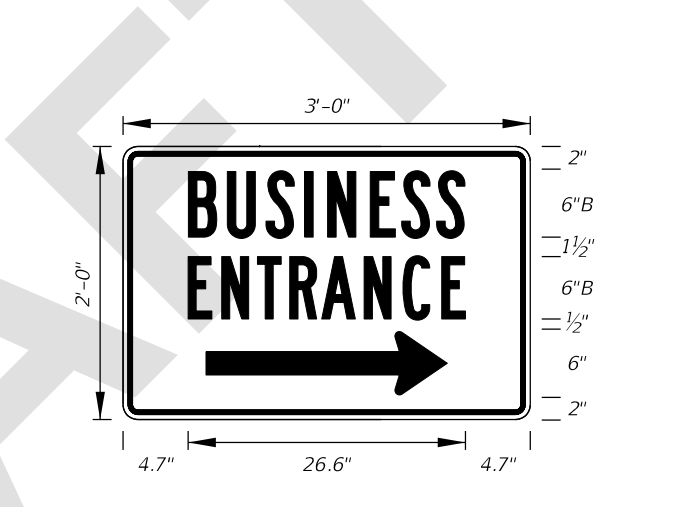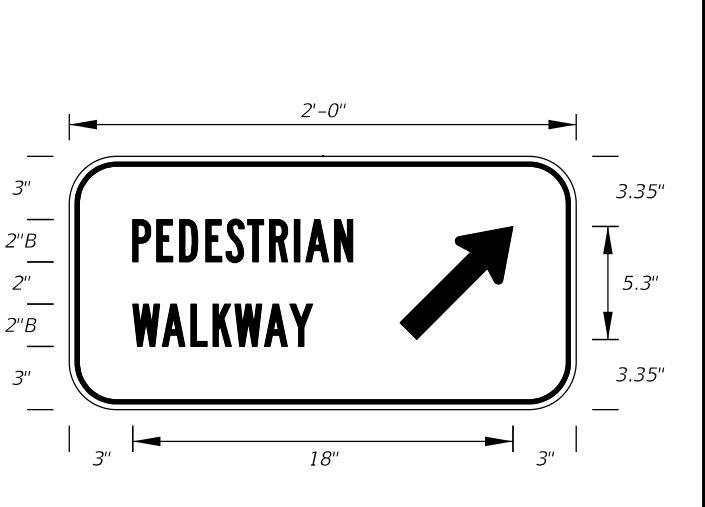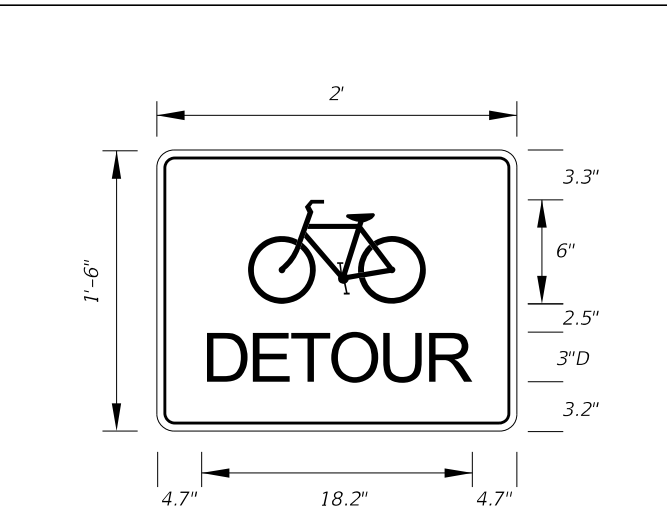9/18/2025 10:16:50 AM


|   |  |   |  |   |  |   |  |                  |                   |
|---|--|---|--|---|--|---|--|------------------|-------------------|
|  <p><b>TTC-011-25</b><br/>Arterial Sign<br/>4'-6" X 3'-0"<br/>1.5" Radii 3/4" Border</p> <p>4" Series C Legend<br/>White Background<br/>Black Legend and Border</p> |  |  <p><b>TTC-011A-25</b><br/>Freeway Sign<br/>6'-0" X 4'-0"<br/>3" Radii 3/4" Border</p> <p>6" Series C Legend<br/>White Background<br/>Black Legend and Border</p> |  |  <p><b>TTC-012-25</b><br/>4'-6" X 2'-6"<br/>3" Radii 3/4" Border</p> <p>5" Kids Series Legend<br/>Orange Background<br/>Black Legend and Border</p>                        |  |  <p><b>TTC-013-25</b><br/>4'-6" X 2'-6"<br/>3" Radii 3/4" Border</p> <p>5" Kids Series Legend<br/>Orange Background<br/>Black Legend and Border</p>                         |  |                  |                   |
|  <p><b>TTC-014-25</b><br/>2'-0" X 2'-6"<br/>1.5" Radii 3/4" Border</p> <p>4" Series C Legend<br/>White Background<br/>Red Legend and Border</p>                   |  |  <p><b>TTC-015-25</b><br/>1'-6" X 1'-0"<br/>1.5" Radii 1/4" Border</p> <p>3" Series B Legend<br/>Orange Background<br/>Black Legend and Border</p>              |  |  <p><b>TTC-016R-25</b><br/><b>TTC-016L-25</b><br/>3'-0" X 2'-0"<br/>1.5" Radii 3/4" Border</p> <p>6" Series B Legend<br/>Blue Background<br/>White Legend and Border</p> |  |  <p><b>TTC-017R-25</b><br/><b>TTC-017L-25</b><br/>2'-0" X 1'-0"<br/>1.5" Radii 3/4" Border</p> <p>2" Series B Legend<br/>White Background<br/>Black Legend and Border</p> |  |                  |                   |
|  <p><b>TTC-018-25</b><br/>2'-0" X 1'-6"<br/>1.5" Radii 1/2" Border</p> <p>3" Series D Legend<br/>Orange Background<br/>Black Legend and Border</p>               |  |   |  |   |  |   |  |                  |                   |
| LAST REVISION<br>11/01/25   |  | DESCRIPTION:   |  | FDOT<br>FY 2026-27<br>STANDARD PLANS   |  | SPECIAL SIGN DETAILS   |  | INDEX<br>700-102 | SHEET<br>20 of 21 |

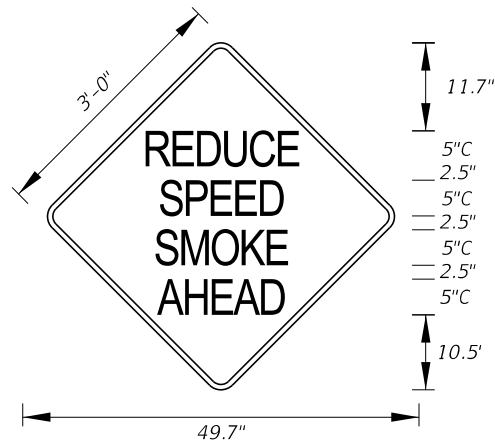

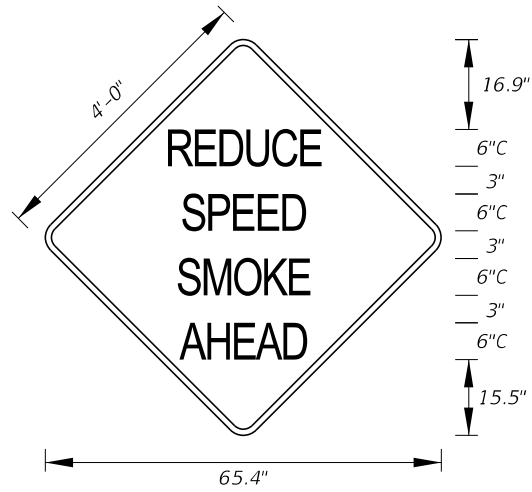
**TTC-019-25**  
3'-0" x 3'-0"  
1.5" Radii 0.8" Border  
5" Series C Legend  
Pink Background  
Black Legend and Border



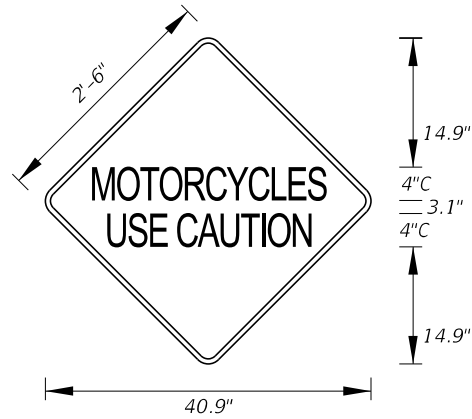
**TTC-019A-25**  
3'-0" x 3'-0"  
3" Radii 0.8" Border  
6" Series C Legend  
Pink Background  
Black Legend and Border



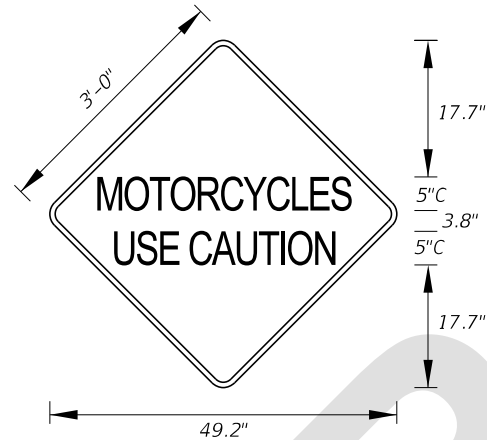**TTC-020-25**  
2'-6" x 2'-6"  
1.5" Radii 0.75" Border  
4" Series C Legend  
Yellow Background  
Black Legend and Border



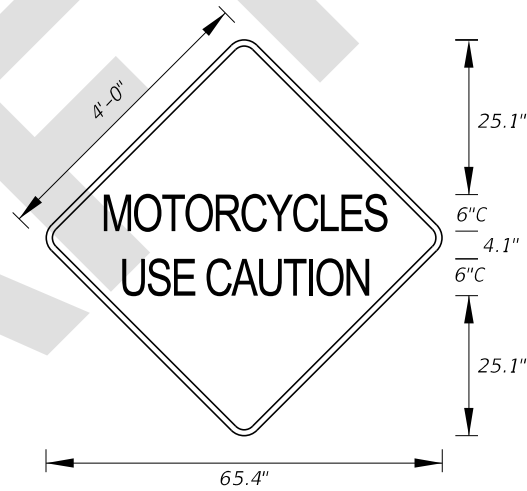**TTC-020A-25**  
3'-0" x 3'-0"  
1.5" Radii 0.8" Border  
5" Series C Legend  
Pink Background  
Black Legend and Border



**TTC-020B-25**  
3'-0" x 3'-0"  
1.5" Radii 0.8" Border  
6" Series C Legend  
Pink Background  
Black Legend and Border

9/18/2025 10:16:58 AM

SPECIAL SIGN DETAILS CROSSWALK

| Previous Sign Number | Current Sign Number | Sign Description                                | Previous Sign Number | Current Sign Number | Sign Description                                                   |
|----------------------|---------------------|-------------------------------------------------|----------------------|---------------------|--------------------------------------------------------------------|
| FTP-2-06             | FTP-001-25          | ALL TRUCKS ENTER WEIGH STATION (NON-FREEWAY)    | FTP-90-22            | FTP-025-25          | ALL TRAFFIC BOTH DIRECTIONS STOP WHILE SCHOOL BUSES LOAD OR UNLOAD |
| FTP-1-06             | FTP-001A-25         | ALL TRUCKS ENTER WEIGH STATION (FREEWAY)        | FTP-91-22            | FTP-026-25          | STOP WHILE SCHOOL BUSES LOAD OR UNLOAD THIS ROADWAY                |
| FTP-6B-06            | FTP-002L-25         | ALL TRUCKS - TRAILERS PICKUPS - VANS NEXT LEFT  | NEW                  | FTP-027-25          | STATE LAW STOP FOR PEDESTRIANS IN CROSSWALKS                       |
| FTP-6A-06            | FTP-002R-25         | ALL TRUCKS - TRAILERS PICKUPS - VANS NEXT RIGHT | NEW                  | FTP-027A-25         | STATE LAW STOP FOR PEDESTRIANS IN CROSSWALKS                       |
| FTP-51-06            | FTP-003-25          | WEIGHT LIMIT LAST EXIT                          | NEW                  | FTP-028-25          | CROSSWALK   STOP ON RED   PROCEED ON FLASHING RED WHEN CLEAR       |
| FTP-44A-25           | FTP-004-25          | SAFETY BELT CHILD RESTRAINT USE REQUIRED BY LAW | FTP-86-21            | FTP-029-25          | STATE LAW STOP FOR [PED] WITHIN CROSSWALK                          |
| FTP-44-06            | FTP-004A-25         | SAFETY BELT CHILD RESTRAINT USE REQUIRED BY LAW | FTP-25-06            | FTP-030-25          | PUSH BUTTON TO CROSS ST NAME                                       |
| FTP-47-06            | FTP-005-25          | BUCKLE UP IT'S THE LAW                          | FTP-68A-06           | FTP-031-25          | PEDISTRIAN CROSSING PUSH BUTTON                                    |
| FTP-46-06            | FTP-005A-25         | BUCKLE UP IT'S THE LAW                          | FTP-68B-06           | FTP-032-25          | PEDISTRIAN CROSSING PUSH BUTTON                                    |
| FTP-45-25            | FTP-006-25          | FLORIDA LAW SAFETY BELT USE CHILD RESTRAINT USE | FTP-68C-21           | FTP-033-25          | PUSH BUTTON FOR WARNING LIGHTS                                     |
| NEW                  | FTP-007-25          | FENDER BENDER MOVE VEHICLES FROM TRAVEL LANES   | FTP-54L-06           | FTP-034L-25         | [LEFT ARROW] ONLY (FTP-037AR-25 FOR RIGHT ARROW)                   |
| NEW                  | FTP-007A-25         | FENDER BENDER MOVE VEHICLES FROM TRAVEL LANES   | FTP-55L-06           | FTP-034AL-25        | [LEFT ARROW] ONLY (FTP-037R-25 FOR RIGHT ARROW)                    |
| NEW                  | FTP-007B-25         | FENDER BENDER MOVE VEHICLES FROM TRAVEL LANES   | FTP-82-08            | FTP-034U-25         | [U-TURN] ONLY                                                      |
| NEW                  | FTP-008-25          | STATE LAW MOVE OVER                             | FTP-53-06            | FTP-035L-25         | LEFT TURN ONLY                                                     |
| NEW                  | FTP-009-25          | TWO-AXLE VEHICLES ONLY BUSES ALLOWED            | FTP-52-06            | FTP-035R-25         | RIGHT TURN ONLY                                                    |
| FDM ESS-R1           | FTP-010-25          | EMERGENCY STOPPING SITE                         | NEW                  | FTP-036-25          | NO PEDESTRIANS OR BICYCLES BEYOND GATE                             |
| FDM ESS-R2           | FTP-011-25          | EMERGENCY STOPPING SITE X MILE                  | FTP-100-25           | FTP-037-25          | FLORIDA LAW                                                        |
| FDM ESS-R3           | FTP-012-25          | EMERGENCY STOPPING SITE X MILES                 | FTP-69-06            | DELETED             | NO PEDESTRIANS BICYCLES MOTOR VEHICLES LESS THAN 5 BHP             |
| FTP-65-06            | FTP-013-25          | OFFICIAL USE ONLY                               | FTP-50-06            | FTP-200-25          | WEIGHT LIMIT RESTRICTION AHEAD                                     |
| FTP-29-06            | FTP-014-25          | GROOVED                                         | FTP-33-06            | FTP-201-25          | SCHOOL ENTRANCE                                                    |
| FTP-41-21            | FTP-015-25          | FLORIDA LITTER LAW \$150 MIN FINE FOR LITTERING | FTP-84-09            | FTP-202-25          | DRAW BRIDGE AHEAD                                                  |
| FTP-40-21            | FTP-015A-25         | FLORIDA LITTER LAW \$150 MIN FINE FOR LITTERING | FTP-61-06            | FTP-203-25          | NO TRAIN HORN 10 PM - 6 AM                                         |
| FTP-19-06            | FTP-016-25          | 24 HOUR PARKING                                 | FTP-62-06            | FTP-203A-25         | NO TRAIN HORN 10 PM - 6 AM                                         |
| FTP-20-06            | FTP-017-25          | PARKING BY DISABLED PERMIT ONLY                 | NEW                  | FTP-204-25          | X-ING                                                              |
| FTP-21-06            | FTP-018-25          | PARKING BY DISABLED PERMIT ONLY                 | NEW                  | FTP-205-25          | ON SIDEWALK                                                        |
| FTP-22-06            | FTP-019-25          | FINE \$250 MAX                                  | NEW                  | FTP-206-25          | MOTORCYCLES USE CAUTION                                            |
| NEW                  | FTP-019A-25         | FINE \$250 MAX                                  | NEW                  | FTP-206A-25         | MOTORCYCLES USE CAUTION                                            |
| FTP-37-06            | FTP-020-25          | SPEEDING FINES DOUBLED WORK ZONES SCHOOL ZONES  | NEW                  | FTP-206B-25         | MOTORCYCLES USE CAUTION                                            |
| FTP-38-22            | FTP-021-25          | SPEEDING FINES DOUBLED                          | NEW                  | FTP-207-25          | PRESCRIBED BURN AHEAD                                              |
| FTP-39-06            | FTP-021A-25         | SPEEDING FINES DOUBLED                          | NEW                  | FTP-207A-25         | PRESCRIBED BURN AHEAD                                              |
| FTP-35-06            | FTP-022-25          | SCHOOL SPEED LIMIT XX                           | FTP-72-06            | FTP-208-25          | FIRE SMOKE AREA                                                    |
| FTP-31-06            | FTP-023-25          | SCHOOL ZONE XX [FLASHER] MPH WHEN FLASHING      | FTP-71-06            | FTP-208A-25         | FIRE SMOKE AREA                                                    |
| FTP-31-06            | FTP-023A-25         | SCHOOL ZONE XX [FLASHER] MPH WHEN FLASHING      | FTP-15A-06           | FTP-400-25          | STATE OF FLORIDA WELCOME CENTER 1 MILE                             |
| FTP-34-06            | FTP-024-25          | END SCHOOL ZONE                                 | FTP-10-06            | FTP-400A-25         | STATE OF FLORIDA WELCOME CENTER 1 MILE                             |
| FTP-32-06            | FTP-024A-25         | END SCHOOL ZONE                                 | FTP-15B-06           | FTP-401-25          | 1/2 MILE                                                           |

CROSSWALK

SPECIAL SIGN DETAILS CROSSWALK

| Previous Sign Number | Current Sign Number | Sign Description                                   | Previous Sign Number | Current Sign Number | Sign Description                                 |
|----------------------|---------------------|----------------------------------------------------|----------------------|---------------------|--------------------------------------------------|
| FTP-15C-06           | FTP-402-25          | RIGHT ARROW                                        | FTP-9A-06            | FTP-603-25          | TRUCKS - TRAILERS PICKUPS - VANS [RIGHT ARROW]   |
| FTP-11-06            | FTP-402A-25         | STATE OF FLORIDA WELCOME CENTER [RIGHT ARROW]      | FTP-7B-06            | FTP-604L-25         | WEIGH STATION AGRICULTURAL INSPECTION NEXT LEFT  |
| FTP-13-06            | FTP-403-25          | WELCOME CENTER [RIGHT ARROW]                       | FTP-7A-06            | FTP-604R-25         | WEIGH STATION AGRICULTURAL INSPECTION NEXT RIGHT |
| FTP-12-06            | FTP-404-25          | STATE OF FLORIDA OFFICIAL WELCOME CENTER [FLORIDA] | FTP-83-08            | FTP-605-25          | ALL TRUCKS [RIGHT ARROW]                         |
| FTP-14-06            | FTP-405-25          | Tourist Information Center NEXT RIGHT              | FTP-36-06            | FTP-606-25          | ONE - STOP CAREER CENTER [RIGHT ARROW]           |
| FTP-87-21            | FTP-406-25          | REST AREA TRUCK PARKING XXX SPACES AVAILABLE       | FTP-48-06            | FTP-607-25          | RECYCLING [SYMBOL] COLLECTION CENTER             |
| FTP-88-21            | FTP-407-25          | WEIGH STATION TRUCK PARKING XXX SPACES AVAILABLE   | FTP-49-06            | FTP-608-25          | RECYCLING [SYMBOL] COLLECTION CENTER             |
| FTP-89-21            | FTP-408-25          | WELCOME CENTER TRUCK PARKING XXX SPACES AVAILABLE  | NEW                  | FTP-609-25          | [DIRECTION] [U.S. HWY NO.] MILE [MILE MARK]      |
| FTP-73-06            | FTP-409-25          | VENDING MACHINES                                   | FTP-16-10            | FTP-610-25          | FLORIDA'S TURNPIKE                               |
| FTP-74-06            | FTP-410-25          | VENDING FREE COFFEE                                | FTP-17-10            | FTP-610A-25         | FLORIDA'S TURNPIKE                               |
| FTP-75-06            | FTP-411-25          | SAFETY BREAK                                       | FTP-18-10            | FTP-610B-25         | FLORIDA'S TURNPIKE                               |
| FTP-76-06            | FTP-412-25          | MACHINES                                           | FTP-81-06            | FTP-611-25          | TOLL [FLORIDA]                                   |
| FTP-43-06            | FTP-413-25          | FLORIDA HIGHWAY PATROL DIAL * FHP (347)            | FTP-80-06            | FTP-611A-25         | TOLL [FLORIDA]                                   |
| FTP-66-21            | FTP-414-25          | FLORIDA 511 TRAVEL INFO CALL 511                   | FTP-79-06            | FTP-611B-25         | TOLL [FLORIDA]                                   |
| FTP-67-21            | FTP-414A-25         | FLORIDA 511 TRAVEL INFO CALL 511                   | FTP-17-06            | FTP-612-25          | FLORIDA ROUTE MARKER                             |
| FTP-78-06            | FTP-415-25          | EVACUATION ROUTE                                   | FTP-18-06            | FTP-613-25          | [ROUTE] COUNTY                                   |
| FTP-77-06            | FTP-415A-25         | EVACUATION ROUTE                                   | NEW                  | FTP-614-25          | AMTRAK                                           |
| FTP-23-06            | FTP-416-25          | INTERNATIONAL SYMBOL OF ACCESS FOR HEARING LOSS    | NEW                  | FTP-614A-25         | AMTRAK                                           |
| FTP-24-06            | FTP-417-25          | INTERNATIONAL TDD SYMBOL                           | NEW                  | FTP-615-25          | GREYHOUND                                        |
| FTP-56A-06           | FTP-418-25          | TRY CARPOOLING                                     | NEW                  | FTP-615A-25         | GREYHOUND                                        |
| FTP-56-06            | FTP-418A-25         | TRY CARPOOLING                                     | NEW                  | FTP-618-25          | SHIP                                             |
| FTP-58-06            | FTP-419-25          | TRY VANPOOLING                                     | NEW                  | FTP-618A-25         | SHIP                                             |
| FTP-57-06            | FTP-419A-25         | TRY VANPOOLING                                     | NEW                  | FTP-800-25          | MEMORIAL HIGHWAY                                 |
| FTP-60-06            | FTP-420-25          | TRY TRANSIT                                        | NEW                  | FTP-800A-25         | MEMORIAL HIGHWAY                                 |
| FTP-59-06            | FTP-420A-25         | TRY TRANSIT                                        | FTP-42-06            | FTP-801-25          | ADOPT - A - HIGHWAY                              |
| NEW                  | FTP-421-25          | FLORIDA SHARE-A-RIDE                               | NEW                  | FTP-802-25          | FLORIDA SCENIC HIGHWAY                           |
| NEW                  | FTP-421A-25         | FLORIDA SHARE-A-RIDE                               | NEW                  | FTP-802A-25         | FLORIDA SCENIC HIGHWAY                           |
| NEW                  | FTP-421B-25         | FLORIDA SHARE-A-RIDE                               |                      |                     |                                                  |
| NEW                  | FTP-422-25          | EMERGENCY INFO XX.X FM                             |                      |                     |                                                  |
| NEW                  | FTP-422A-25         | EMERGENCY INFO XX.X FM                             |                      |                     |                                                  |
| FTP-70-06            | FTP-422B-25         | EMERGENCY INFO XX.X FM                             |                      |                     |                                                  |
| FTP-3-06             | FTP-600-25          | WEIGH STATION 1000 FT                              |                      |                     |                                                  |
| FTP-5-06             | FTP-601-25          | WEIGH STATION AGRICULTURAL INSPECTION 1 MILE       |                      |                     |                                                  |
| FTP-4-06             | FTP-602-25          | CLOSED                                             |                      |                     |                                                  |
| FTP-8-06             | FTP-602A-25         | CLOSED                                             |                      |                     |                                                  |

CROSSWALK

SPECIAL SIGN DETAILS CROSSWALK

| Previous Sign Number | Current Sign Number | Sign Description                            | Previous Sign Number | Current Sign Number | Sign Description |
|----------------------|---------------------|---------------------------------------------|----------------------|---------------------|------------------|
| MOT-1-22             | TTC-001-25          | STAY IN YOUR LANE                           |                      |                     |                  |
| MOT-4-22             | TTC-002-25          | LITTER PICK UP AHEAD                        |                      |                     |                  |
| MOT-5-22             | TTC-003-25          | TRUCKS ENTERING HIGHWAY                     |                      |                     |                  |
| MOT-6-22             | TTC-003A-25         | TRUCKS ENTERING HIGHWAY                     |                      |                     |                  |
| MOT-7-22             | TTC-004-25          | TRUCKS TURNING LEFT XXX FT                  |                      |                     |                  |
| MOT-8-22             | TTC-005-25          | MERGE RIGHT ON FLASHING ARROW               |                      |                     |                  |
| MOT-9-22             | TTC-006-25          | LIGHTED WORK ZONE AHEAD                     |                      |                     |                  |
| MOT-10-22            | TTC-007-25          | STATE PRISONERS WORKING                     |                      |                     |                  |
| MOT-27-25            | TTC-008-25          | CENTER LANE CLOSED AHEAD                    |                      |                     |                  |
| MOT-15-06            | TTC-009-25          | GROOVED PAVEMENT AHEAD                      |                      |                     |                  |
| MOT-18-10            | TTC-010-25          | RUMBLE STRIPS AHEAD                         |                      |                     |                  |
| MOT-14-06            | TTC-011-25          | SPEEDING FINES DOUBLED WHEN WORKERS PRESENT |                      |                     |                  |
| MOT-13-06            | TTC-011A-25         | SPEEDING FINES DOUBLED WHEN WORKERS PRESENT |                      |                     |                  |
| MOT-16-06            | TTC-012-25          | SLOW DOWN MY DADDY WORKS HERE               |                      |                     |                  |
| MOT-17-06            | TTC-013-25          | SLOW DOWN MY MOMMY WORKS HERE               |                      |                     |                  |
| MOT-19-11            | TTC-014-25          | LEGAL WEIGHTS ONLY                          |                      |                     |                  |
| MOT-23-21            | TTC-015-25          | RETURN TO SHOULDER                          |                      |                     |                  |
| MOT-11-06            | TTC-016-25          | BUSINESS ENTRANCE [RIGHT ARROW]             |                      |                     |                  |
| MOT-12R-06           | TTC-017-25          | PEDESTRIAN WALKWAY [RIGHT ARROW]            |                      |                     |                  |
| MOT-21-21            | TTC-018-25          | BICYCLE DETOUR                              |                      |                     |                  |
| NEW                  | TTC-019-25          | REDUCE SPEED SMOKE AHEAD                    |                      |                     |                  |
| NEW                  | TTC-019A-25         | REDUCE SPEED SMOKE AHEAD                    |                      |                     |                  |
| NEW                  | TTC-020-25          | MOTORCYCLES USE CAUTION                     |                      |                     |                  |
| NEW                  | TTC-020A-25         | MOTORCYCLES USE CAUTION                     |                      |                     |                  |
| NEW                  | TTC-020B-25         | MOTORCYCLES USE CAUTION                     |                      |                     |                  |