
Index 700-102 Special Sign Details

ORIGINATION

Date: 7/1/2025

Name: Benazir Portal

Phone: 954-903-8107

Email: Benazir.portal@dot.state.fl.us

COMMENTARY

Updated naming convention for all signs. Changed all MOT signs to TTC signs. Worked details to clean up inconsistencies, add structure to sign assignment, and allow for an easier addition of new signs. The requested Index updates reflect consistency with MUTCD, TEM, Sign Library and Highway Signing Program.

FTP-85-13 removed because it is already covered in the MUTCD.

MOT Signs G20-1 and G20-2 removed because they are already covered in the MUTCD.

Radii updates based on sign shop direction to better reflect what is done currently.

Any Indexes with references to these FTP and MOT numbers have also been updated accordingly.

COMMENTS AND RESPONSES

BLACK = Industry Review Comments **BLUE** = Standard Plans Response **GREEN** = Change Made to Index

Name: Yael Rivera

Date: 9/2/25

COMMENT: Consider removing FTP-85-13 from index since MUTCD 11th Edition now has sign R10-12a. Would have to revise TEM and FDM to remove mention FTP-85-13.

RESPONSE: Agreed. The Index, TEM & FDM will be updated accordingly.

CHANGE MADE TO INDEX: Yes. Sign was removed.

Response Date: 9/17/25

Name: Bobir Maksudov

Date: 9/3/25

COMMENT: Would the department consider adding details for R8-1 (NO PARKING ON RIGHT OF WAY) with "BY ORDER OF D.O.T." there is a standard cell in the cell library R8-1 FDOT. Also if there are any other no Florida specific sign that the Department prefers to use, it would be great if we can add them

RESPONSE: Thank you for your comment. That is outside the scope of this change, but will be considered for future cycles.

CHANGE MADE TO INDEX: No.

Response Date: 9/17/25

Name: Bobir Maksudov

Date: 9/3/25

COMMENT: R18-18A (Photo enforcement) sign is supposed to be used with " INCLUDES RIGHT TURN" plaque. Attachment A of "Traffic Infraction Detector Placement and Installation Specifications" shows details but when there are no details in the Standard plans. Would FDOT consider adding the plaque details inside index 700-102?

RESPONSE: Thank you for your comment. The signs were removed to avoid duplication; please refer to the *Traffic Infraction Detector Placement and Installation Specifications* for details on these signs

CHANGE MADE TO INDEX: Yes. Signs were removed.

Response Date: 9/17/25

Name: Bobir Maksudov

Date: 9/3/25

COMMENT: Would FDOT consider adding details on how design overhead street name sign with block numbers (including signs with arrows) which are installed on mast arms and strain poles?

RESPONSE: Thank you for your comment. Refer to the TEM Chapter 2 and MUTCD Section 2D.45 for additional guidance. That is outside the scope of this change, but will be considered for future cycles.

CHANGE MADE TO INDEX: No.

Response Date: 9/17/25

Name: Bobir Maksudov

Date: 9/3/25

COMMENT: Would FDOT consider adding details for express lane ingress signing, which is show in the TEM? (including Toll amount sign, vehicle eligibility signs, R3-44 with SunPass pictogram, NO TRUCKS, EXPRESS LANE ENDS, EXPRESS LANE ENDS 1/2 Mile)

RESPONSE: Thank you for your comment. That is out of scope for this change but will be considered for future cycles.

CHANGE MADE TO INDEX: No.

Response Date: 9/17/25

Name: Anu Weerasuriya

Date: 9/3/25


COMMENT: It's not clear the total number of yellow flashers to be installed in FTP-022-25 and FTP-022A-25 signs.

RESPONSE: Thank you for your comment. These signs have been updated to remove the middle flashing beacons.

CHANGE MADE TO INDEX: Yes.


Response Date: 9/17/25

NOTE:
Supplemental Panel for the
FTP-016-25 sign

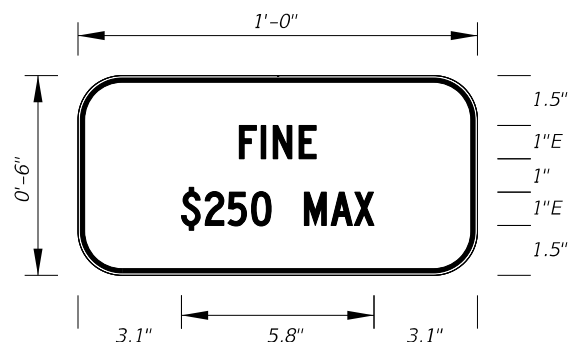


FTP-019-25
1'-0" X 6"
1.5" Radii $\frac{3}{8}$ " Border
1" Series E Legend
White Background
Black Legend and Border


NOTE:
Supplemental Panel for the
FTP-017-25 sign

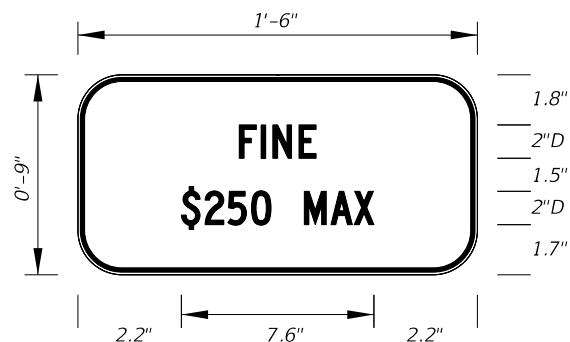

FTP-019A-25
1'-6" X 9"
1.5" Radii $\frac{3}{8}$ " Border
2" Series D Legend
White Background
Black Legend and Border

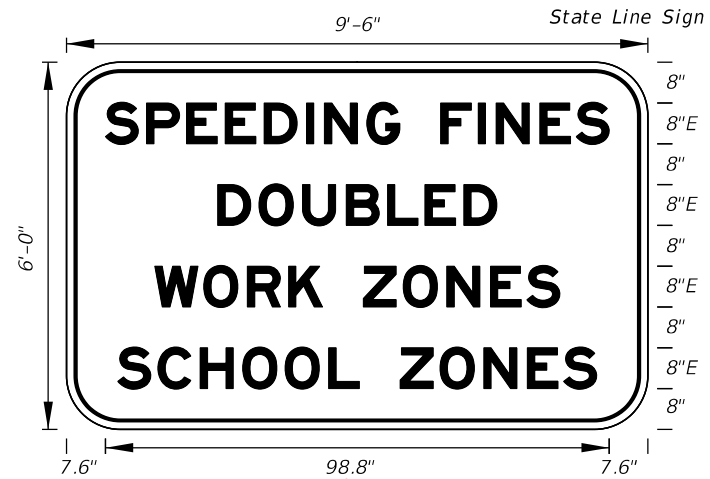


FTP-020-25
9'-6" X 6'-0"
9" Radii 2" Border
8" Series E Legend
White Background
Black Legend and Border

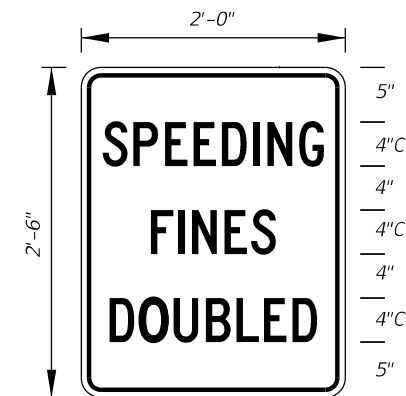


FTP-021-25
2'-0" X 2'-6"
1.5" Radii $\frac{1}{2}$ " Border
4" Series C Legend 80% Spacing
White Background
Black Legend and Border


Freeway Sign

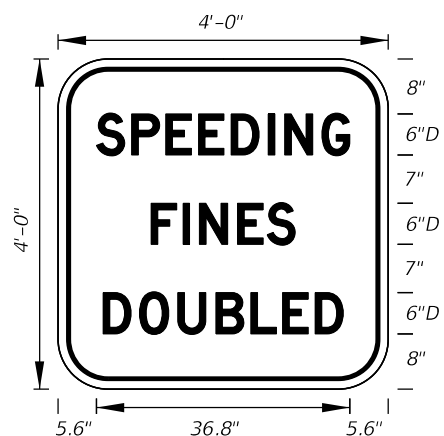


FTP-021A-25
4'-0" X 4'-0"
3" Radii $\frac{3}{4}$ " Border
6" Series D Legend
White Background
Black Legend and Border

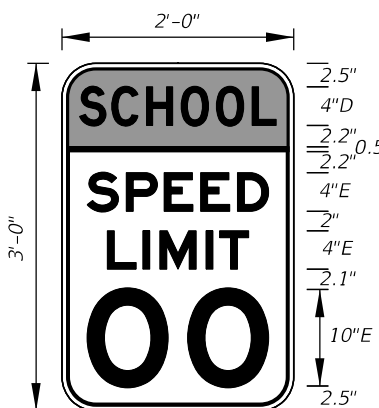


FTP-022-25
2'-0" X 3'-0"
1.5" Radii $\frac{5}{8}$ " Border
TOP:
4" Series D Legend
Fluorescent Yellow-Green
Background
Black Legend and Border
BOTTOM:
4" and 10" Series E Legend
White Background
Black Legend and Border

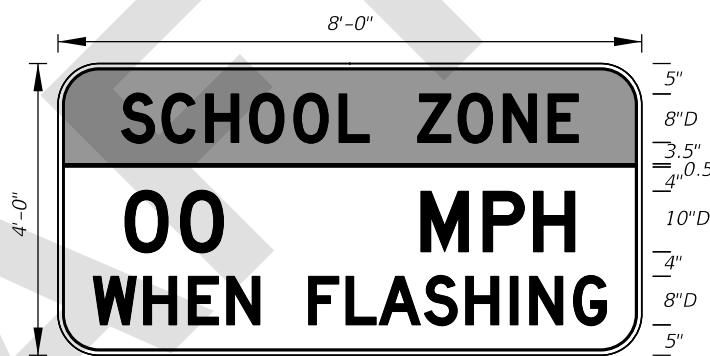


FTP-023-25
8'-0" X 4'-0"
3" Radii $\frac{3}{4}$ " Border
Span Wire Placement
of 12" Yellow Signal
TOP:
8" Series D Legend
Fluorescent Yellow-Green
Background
Black Legend and Border
BOTTOM:
8" and 10" Series D Legend
White Background
Black Legend and Border

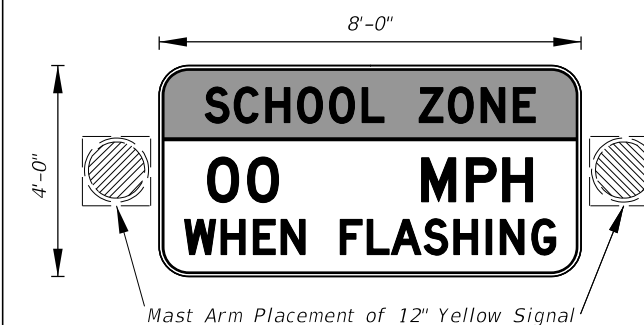


FTP-023A-25
8'-0" X 4'-0"
3" Radii $\frac{3}{4}$ " Border
Mast Arm Placement of 12" Yellow Signal
TOP:
8" Series D Legend
Fluorescent Yellow-Green
Background
Black Legend and Border
BOTTOM:
8" and 10" Series D Legend
White Background
Black Legend and Border

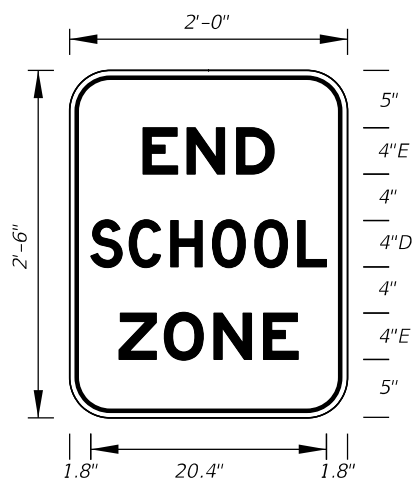


FTP-024-25
2'-0" X 2'-6"
1.5" Radii $\frac{5}{8}$ " Border
4" Series D and E Legend
White Background
Black Legend and Border

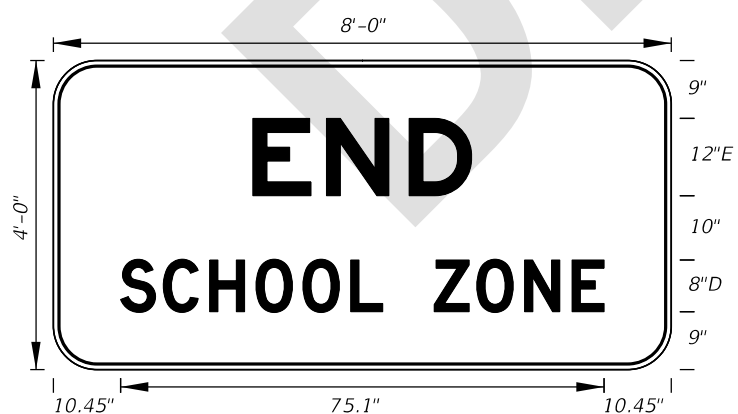

FTP-024A-25
8'-0" X 4'-0"
3" Radii $\frac{3}{4}$ " Border
12" Series E and
8" Series D Legend
White Background
Black Legend and Border

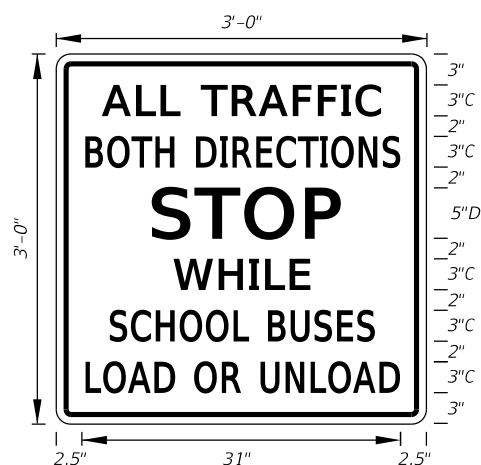

FTP-025-25
3'-0" X 3'-0"
1.5" Radii $\frac{3}{4}$ " Border
3" Series C Legend and
5" Series D Legend
White Background
Black Legend and Border

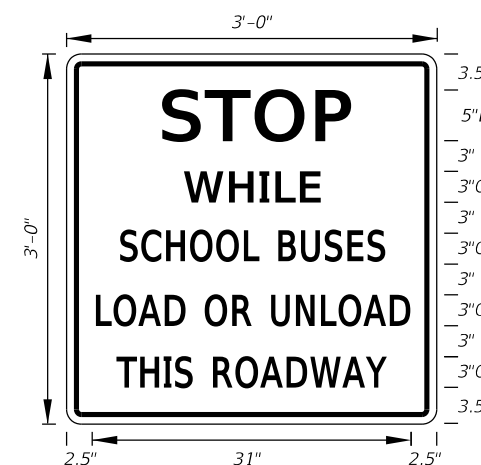

FTP-026-25
3'-0" X 3'-0"
1.5" Radii $\frac{3}{4}$ " Border
3" Series C Legend
5" Series D Legend
White Background
Black Legend and Border

9/18/2025 10:14:27 AM