

Origination Form
Proposed Revisions to a Standard Plans Index

Originator:	Portal, Benazir	Index Number:	700-102
Date:	7/1/2025	Sheet Number(s):	ALL
E-mail:	Benazir.Portal@dot.state.fl.us	Index Title:	Special Sign Details

Summary of the changes:

ALL SHEETS: All FTP and MOT signs were renumbered by sign type and organized numerically; All MOT Signs were updated to TTC Signs

Sheet 1: NEW Cover Sheet with Table of Contents and General Notes

Sheet 2: Added NEW Fender Bender Signs

Sheet 3: Added NEW Emergency Stopping Site Signs

Sheet 5: Added NEW Crosswalk Signs

Sheet 6: Updated dimensions on Florida Law Sign

Sheet 7: Added NEW "X-ING", "ON SIDEWALK", and "MOTORCYCLES USE CAUTION" Signs

Sheet 8: Added NEW "PRESCRIBED BURN AHEAD" Signs

Sheet 12: Added NEW Share-A-Ride Signs, Added 2 additional sizes of signs for Emergency Info

Sheet 13: Added NEW Traffic Info Signs

Sheet 14: Added NEW Location Reference Marker Sign

Sheet 15: Removed line through FL symbol on Turnpike Signs

Sheet 17: Added NEW Guide Signs

Sheet 18: Added NEW Guide Signs

Sheet 19: Added NEW Recreational and Culture Signs

Sheet 21: Removed G20-1 and G20-2 Signs

Sheet 22: Added NEW "REDUCE SPEED SMOKE AHEAD" and "MOTORCYCLES USE CAUTION" Signs

Commentary/Background:

Updated naming convention for all signs. Changed all MOT signs to TTC signs. Worked details to clean up inconsistencies, add structure to sign assignment, and allow for an easier addition of new signs. The requested Index updates reflect consistency with MUTCD, TEM, Sign Library and Highway Signing Program.

MOT Signs G20-1 and G20-2 removed because they are already covered in the MUTCD.

Any Indexes with references to these FTP and MOT numbers have also been updated accordingly.

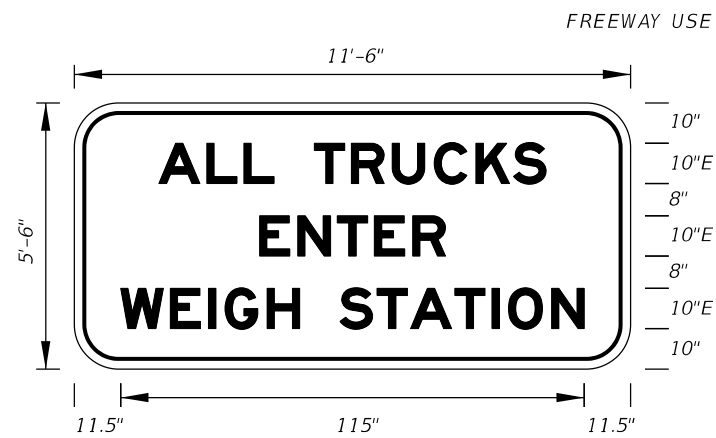
Other Affected Documents/Offices	Person Contacted	Affected (Yes/No)
Other Standard Plans	Rick Jenkins & Shae Gibbs	Yes
FDOT Design Manual	Mark Musselman	Yes
Standard Specifications	Daniel Strickland	No
Basis of Estimates Manual		No
Approved Product List		No

Construction Office	Ryan Buck	Yes
Maintenance Office		No
Implementation		
["FY-Standard Plans (Next Release)"]		

NEW Cover Sheet


ADDED: Table of Contents and
General Notes

REDEVELOPED: Renumbered Signs by
Sign Type and Organized Numerically




FTP-001A-25
~~FTP-106~~
11"-6" X 5'-6"
9" Radii 2" Border

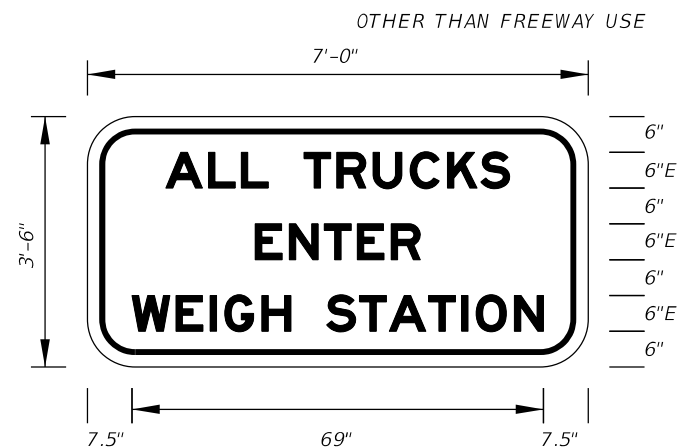
10" Series E Legend
White Background
Black Legend and Border



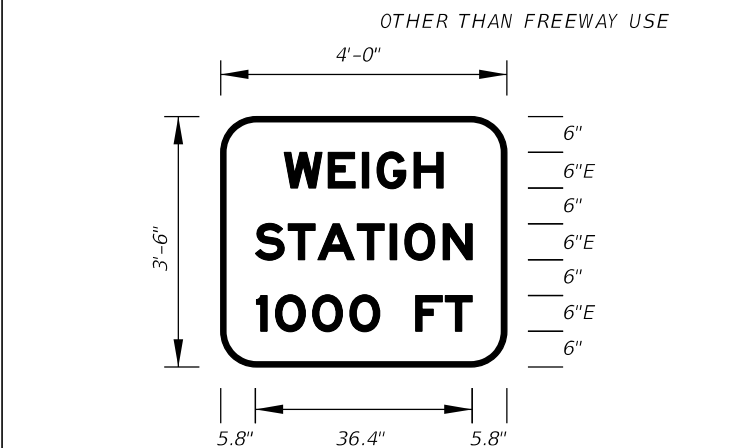FTP-001-25
~~FTP-2-06~~
7' X 3'-6"
6" Radii 2" Border
6" Series E Legend
White Background
Black Legend and Border



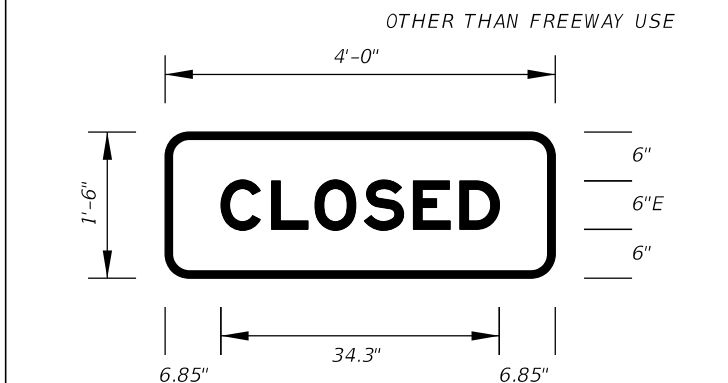
FTP-600-25
~~FTP-3-06~~
4' X 3'-6"
6" Radii 2" Border
6" Series E Legend
Green Background
White Legend and Border



FTP-602-25
~~FTP-4-06~~
4' X 1'-6"
3" Radii 2" Border


6" Series E Legend
Green Background
White Legend and Border

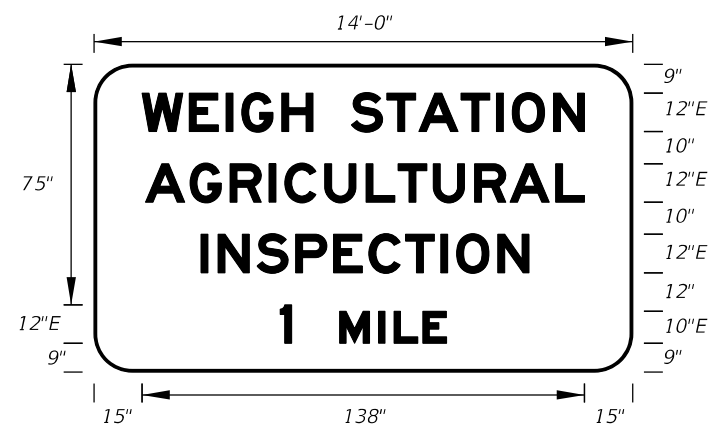Note:
~~FTP 4-06 to be~~
~~used with FTP 3-06~~



FTP-601-25
~~FTP-5-06~~
14' X 8'
12" Radii 2" Border

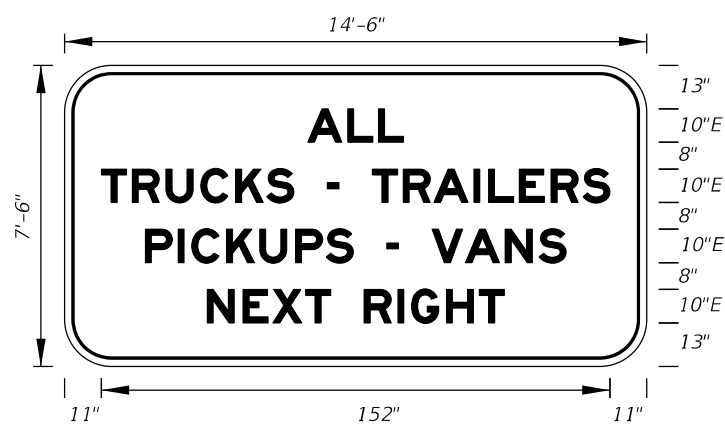12" and 10" Series E Legend
Green Background
White Legend and Border





FTP-002R-25
~~FTP 6A 06~~
14'-6" X 7'-6"
12" Radii 2" Border

FTP-002L-25 for
"NEXT LEFT"

10" Series E Legend
White Background
Black Legend and Border

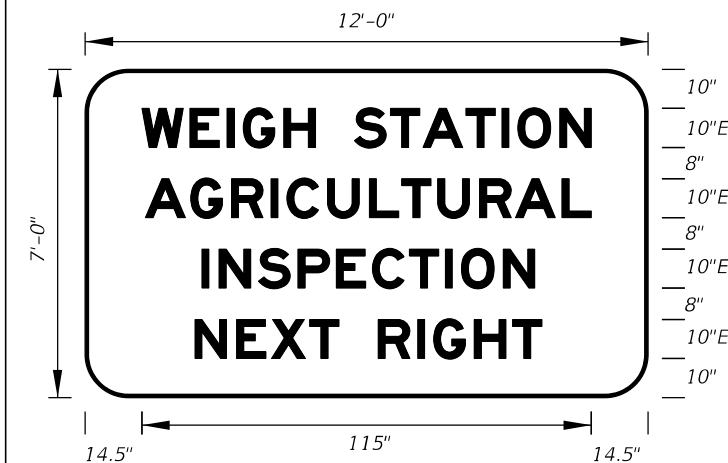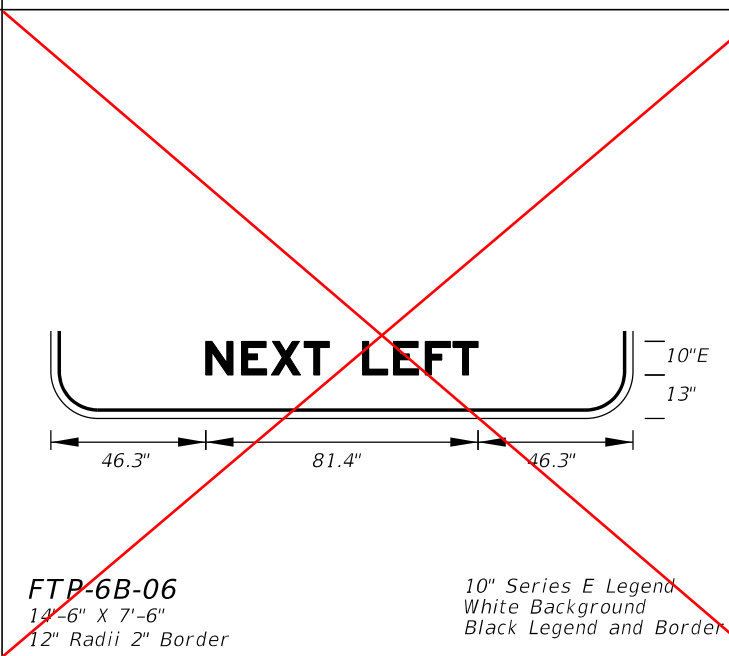
On Interstate Station
Delete Pickups-Vans,
and reduce Sign height
accordingly.




FTP-604R-25
~~FTP-7A-06~~
12' X 7'
11" Radii 2" Border

FTP-604L-25 for
"NEXT LEFT"

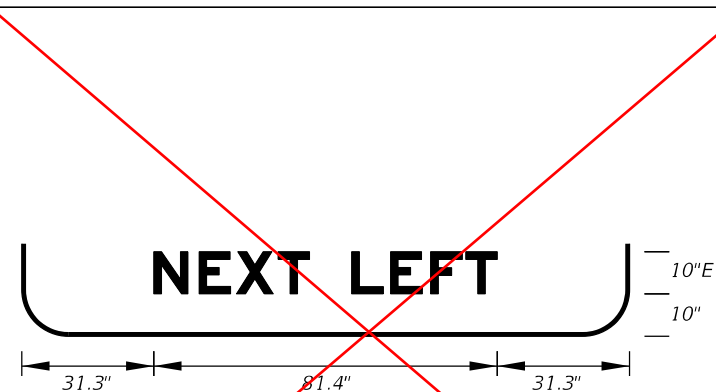10" Series E Legend
Green Background
White Legend and Border



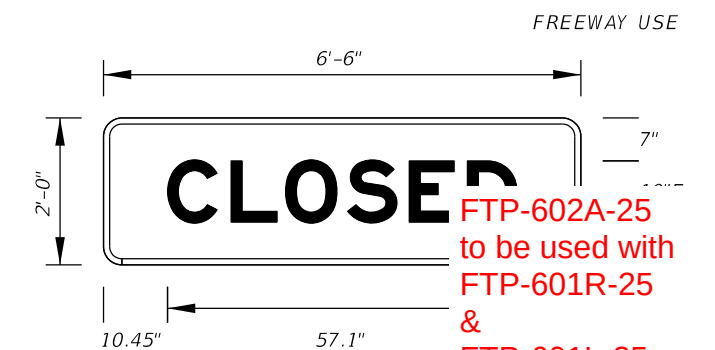
~~FTP-7B-06~~
~~12' X 7'~~
~~11" Radii 2" Border~~
~~10" Series E Legend~~
~~Green Background~~
~~White Legend and Border~~




FTP-602A-25
~~FTP-8-06~~
6'-6" X 2'
3" Radii 2" Border
10" Series E Legend
Green Background
White Legend and Border

FTP-601E-25

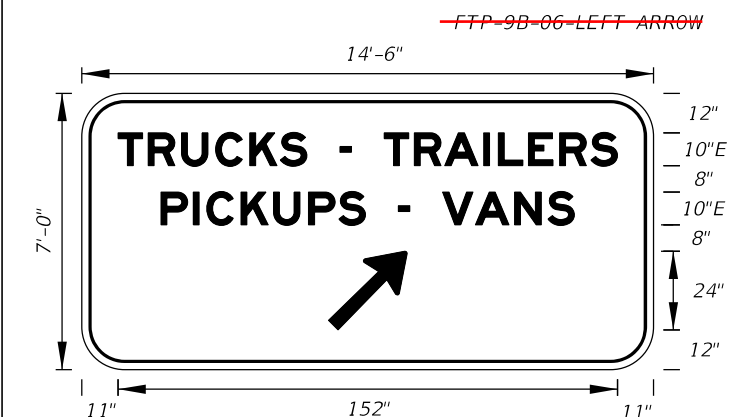Note:
FTP-8-06 to be
used with FTP-7A-06
& FTP-7B-06.




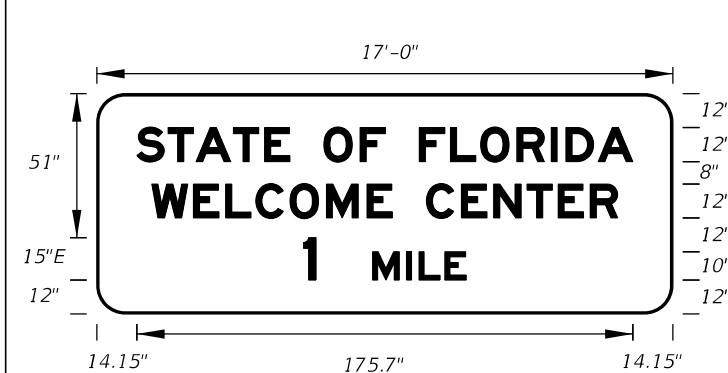FTP-603R-25 **FTP-603L-25 for LEFT ARROW**
~~FTP-9A-06~~ 10" Series E Legend
 14'-6" X 7' Green Background
 11" Radii 2" Border White Legend and Border




FTP-400A-26
~~FTP-10-06~~
17" X 6'-6"
10" Radji 2" Border

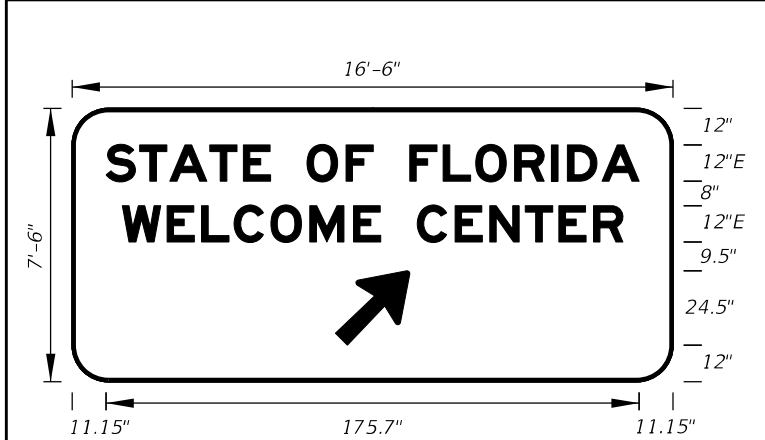
12", 10" and 15" Series E Legend
Blue Background
White Legend and Border



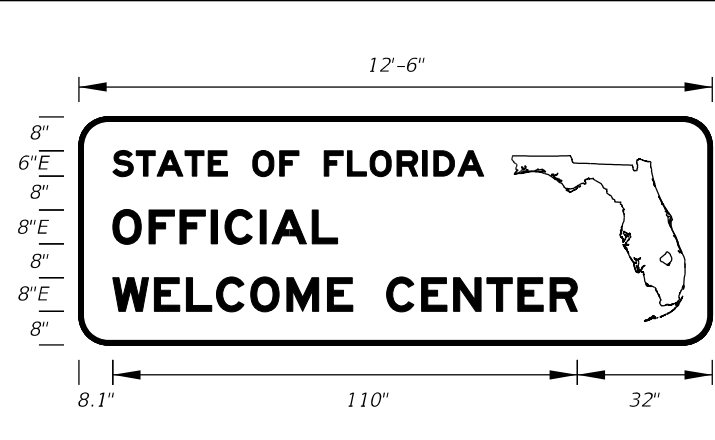
FTP-402A-25
~~FTP-11-06~~
16'-6" X 7'-6"
12" Radii 2" Border
12" Series E Legend
Blue Background
White Legend and Border



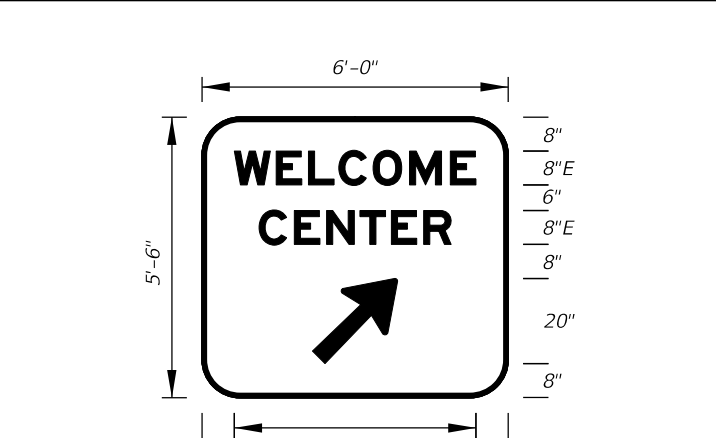
FTP-404-25
~~FTP-12-06~~
12'-6" X 4'-6"
7" Radii 2" Border
6" and 8" Series E Legend
Blue Background
White Legend and Border



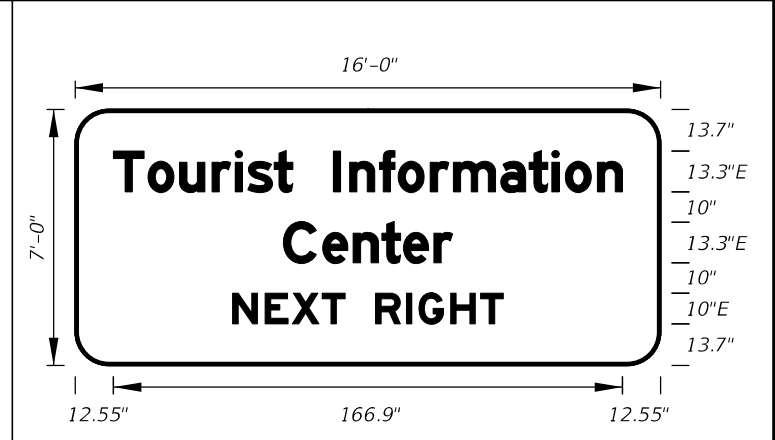
FTP-403-25
~~FTP-13-06~~
6' 0" X 5'-6"
9" Radii 2" Border
8" Series E Legend
Blue Background
White Legend and Border



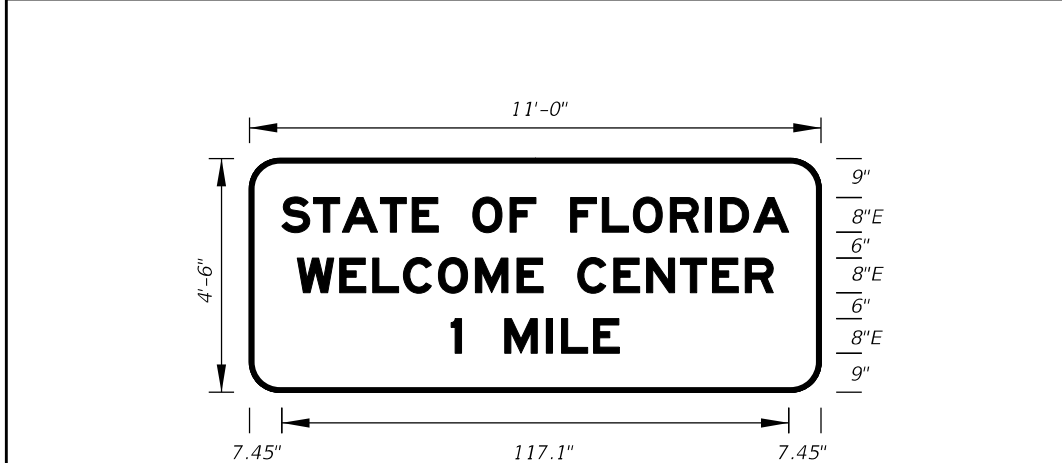
FTP-405-25
~~FTP-14-06~~
16'-0" X 7'-0"
11" Radii 2" Border
13.3 and 10" Series E Legend
Blue Background
White Legend and Border



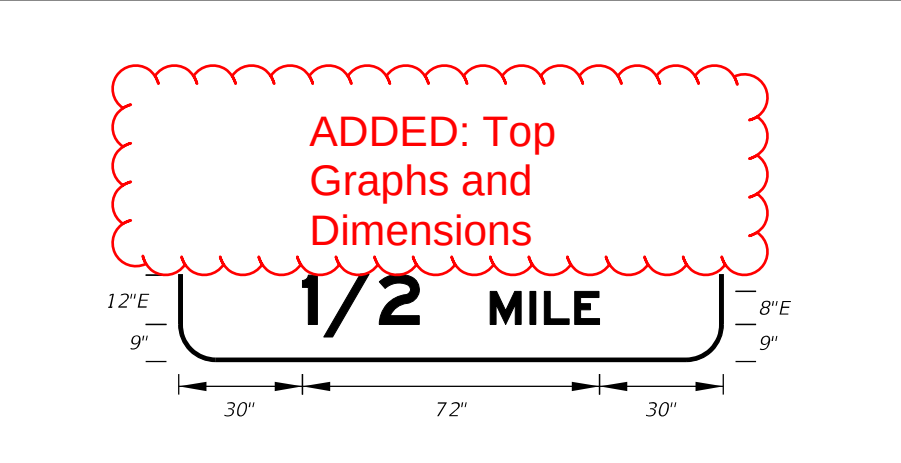
FTP-400-25
~~FTP-15A-06~~
11'-0" X 4'-6"
7" Radii 2" Border
8" Series E Legend
Blue Background
White Legend and Border



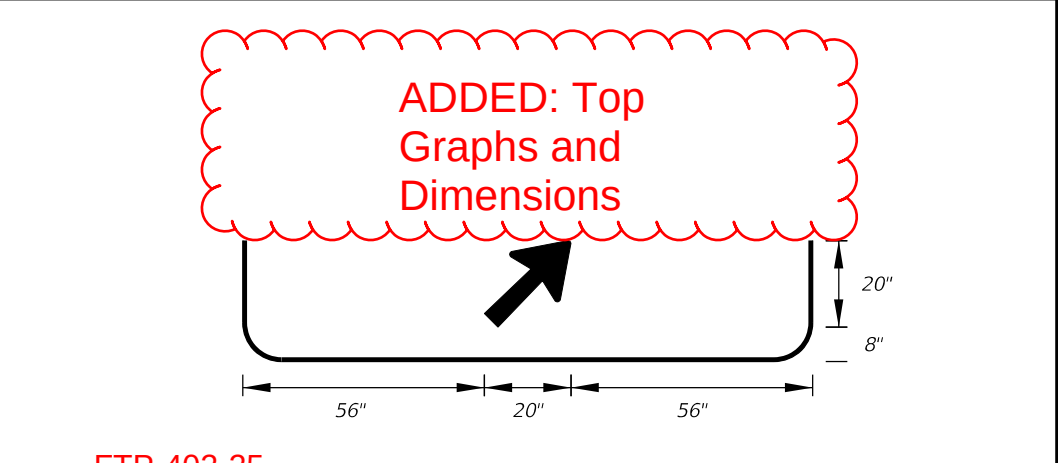
FTP-401-25
~~FTP-15B-06~~
11'-0" X 5'-6"
8" Radii 2" Border
8" and 12" Series E Legend
Blue Background
White Legend and Border



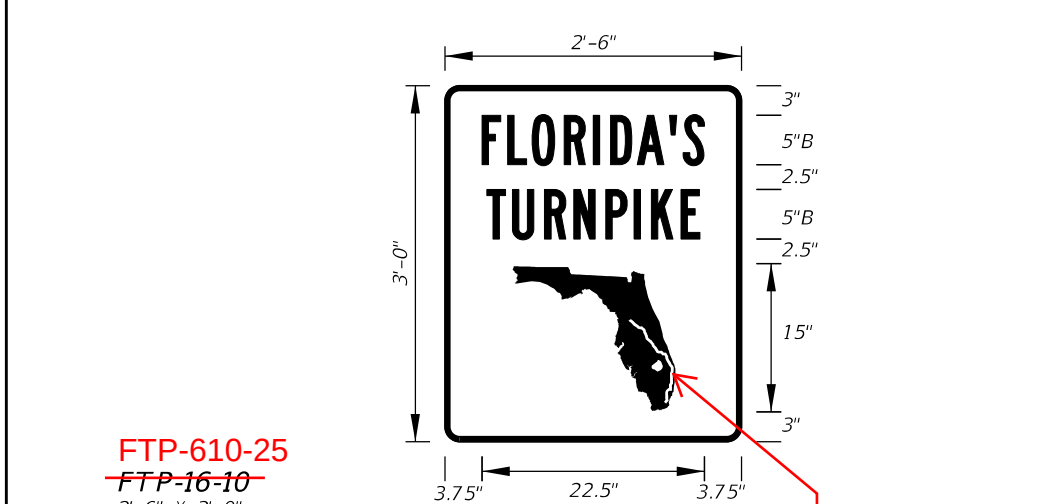
FTP-402-25
~~FTP-15C-06~~
11'-0" X 5'-6"
9" Radii 2" Border
8" Series E Legend
Blue Background
White Legend and Border



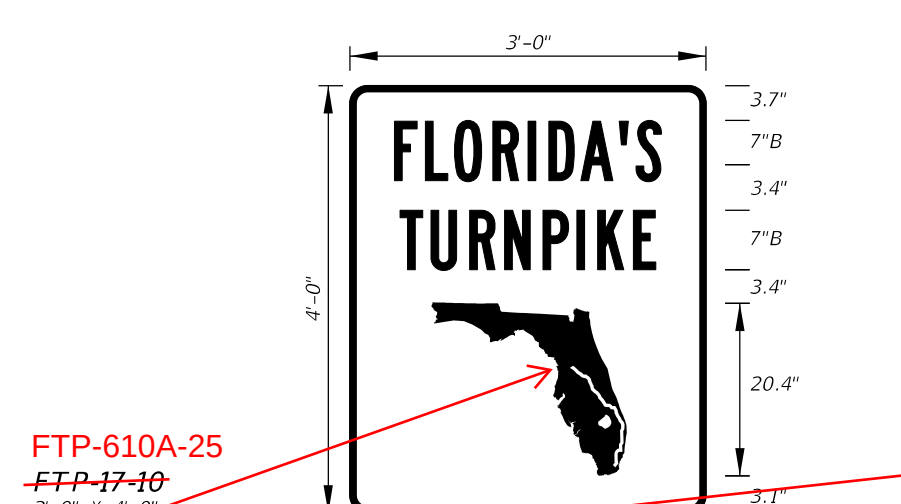
FTP-610-25
~~FTP-16-10~~
2'-6" X 3'-0"
1.5" Radii 3/4" Border
5" Series B Legend
Green Background
White Legend, Border, and Florida Symbol



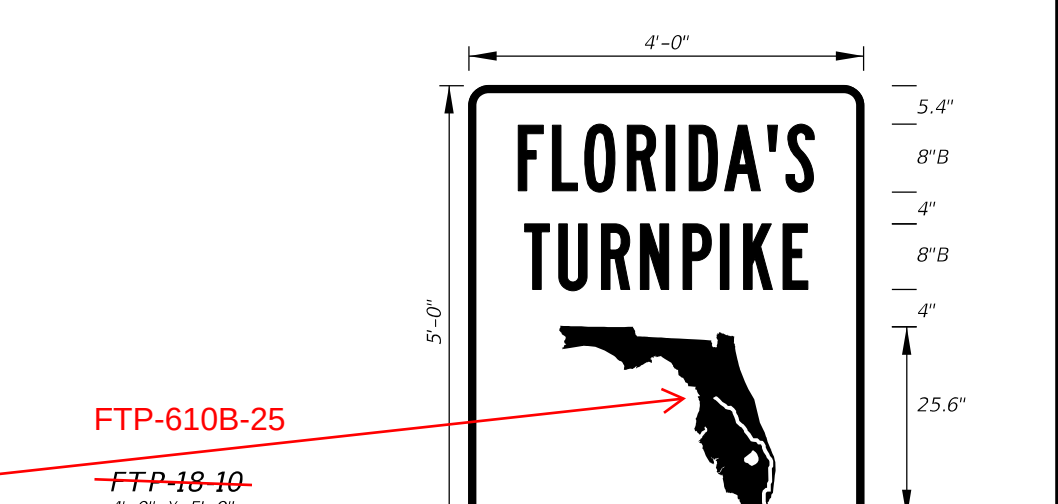FTP-610A-25
~~FTP-17-10~~
3'-0" X 4'-0"
1.5" Radii 3/4" Border
7" Series B Legend
Green Background
White Legend, Border, and Florida Symbol



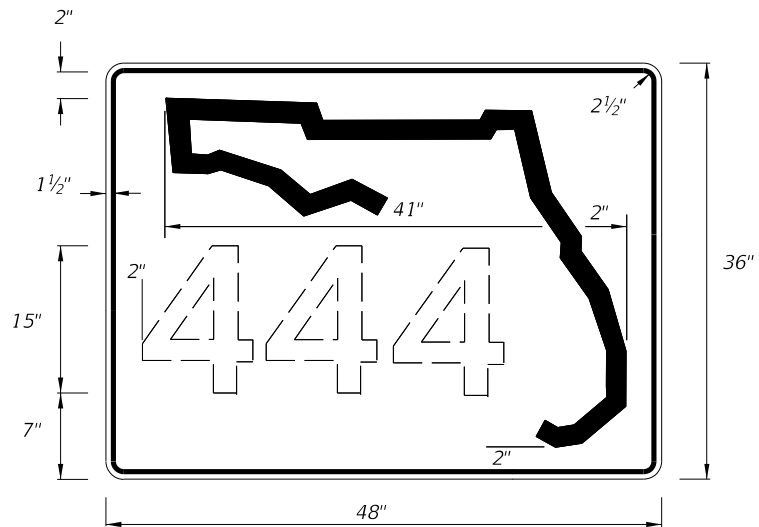
FTP-610B-25
~~FTP-18-10~~
4'-0" X 5'-0"
3" Radii 1 1/4" Border
8" Series B Legend
Green Background
White Legend, Border, and Florida Symbol




DIGITS	NUMERAL SIZE	SERIES LEGEND	PANEL SIZE
1-3	15"	C	48" x 36"
4	12"	C	48" x 36"

- NOTES:
- Stroke width of State Outline shall be 1".
 - 2 1/2" Radii

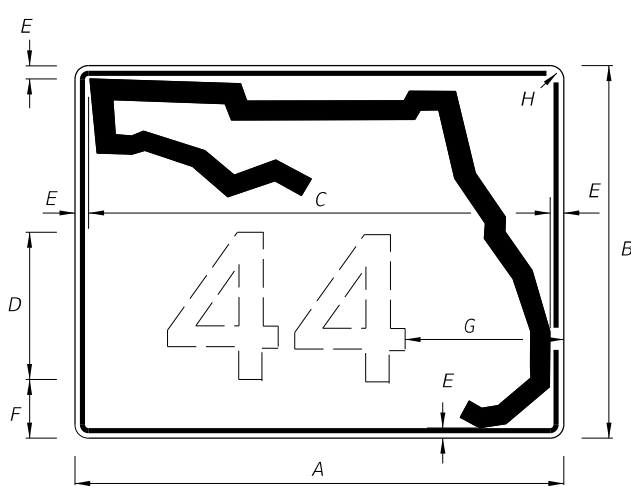INDEPENDENT USE FOR FREEWAY



1 OR 2 DIGITS

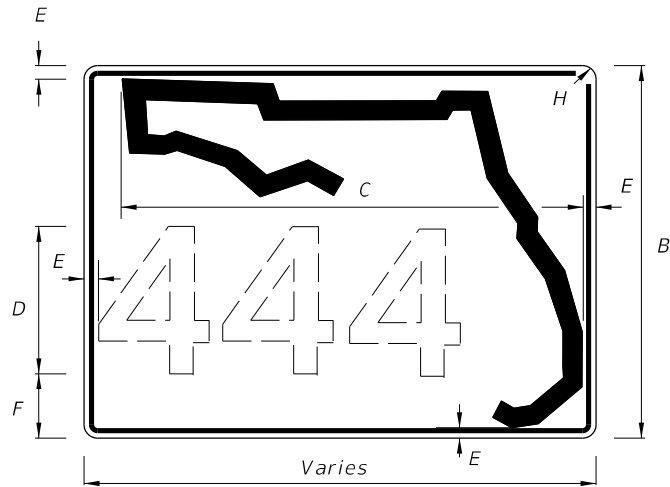


3 OR MORE DIGITS

- NOTES:
- Florida marker shall have Black Legend with White Background.
 - Stroke width of State outline shall be 3/4" for Guide Sign.
 - Series D Legend.
 - 5/8" Border

A	B	C	D	E	F	G	H
30"	24"	26"	12"	1 1/4"	2 3/4"	8 1/4"	1 1/4"
36"	30"	32"	15"	1 1/4"	3 1/4"	8 3/4"	1 1/4"
42"	36"	38"	15"	1 1/4"	6 1/4"	11"	1 1/4"


FTP-612-25 GUIDE SIGN USE

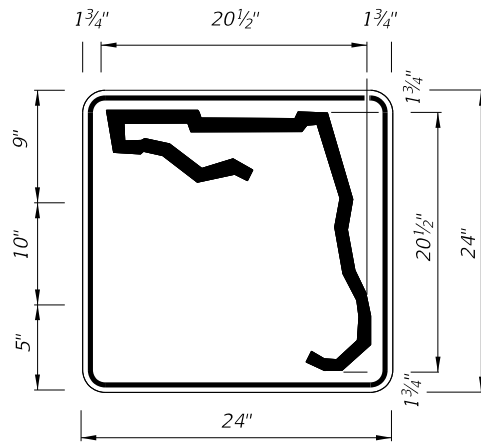~~FTP-17-06~~ - FLORIDA ROUTE MARKER



1 or 2 DIGITS

DIGITS	NUMERAL SIZE	SERIES LEGEND	PANEL SIZE
1-2	10"	D	24" x 24"

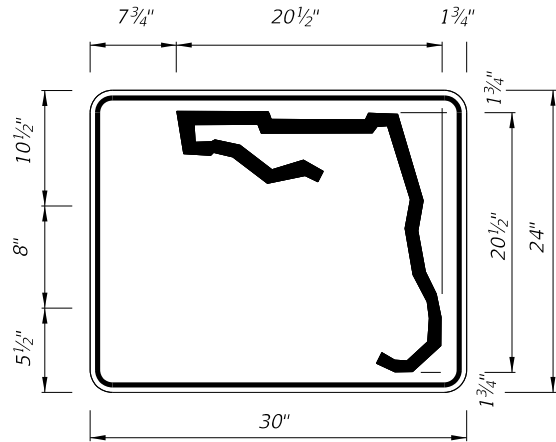


3 or 4 DIGITS

DIGITS	NUMERAL SIZE	SERIES LEGEND	PANEL SIZE
3	8"	D	30" x 24"
4	8"	C	30" x 24"

- NOTES:
- Stroke width of State Outline shall be 1".
 - The 24" X 24" panel shall only be used for a 3 digit route when the panel is to be used on a sign cluster with other 24" X 24" panels.
 - 1 1/2" Radii

INDEPENDENT USE OTHER THAN FREEWAY

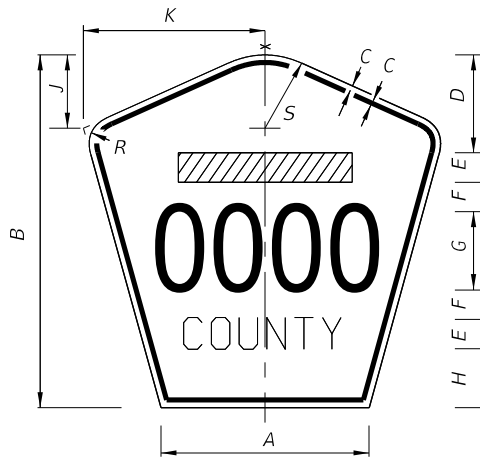- NOTES:
- Series D Legend.
 - Color: Yellow Legend and Border on Blue Background.
 - When used on a guide sign, marker must be overlaid on a rectangular Yellow Background as shown in chart.
 - When two or more County Route Markers are mounted together, use the dimensions of the largest marker for all other markers.













SIGN	DIMENSIONS												Rectangular Yellow Background Dimensions (See Note 3)
	A	B	C	D	E	F	G	H	J	K	R	S	
4 DIGIT POST MOUNTED	25 1/8"	42"	3/4"	10"	4"	4"	8"	8"	8 3/8"	22"	5"	8 3/4"	
2 DIGIT OVERHEAD	21 1/2"	36"	1/2"	7 1/2"	3"	3"	12"	4 1/2"	7 1/8"	18 1/8"	4 1/4"	7 1/2"	42"x 42"
3 DIGIT OVERHEAD	25 1/8"	42"	3/4"	8"	4"	4"	12"	6"	8 3/8"	22"	5"	8 3/4"	48"x 48"
4 DIGIT OVERHEAD	29 7/8"	48"	3/4"	8"	5"	5"	12"	8"	9 3/4"	25 5/8"	5 3/4"	10 1/4"	52"x 52"

FTP-613-25

~~FTP-18-06~~ - COUNTY ROUTE MARKER (M1-6)

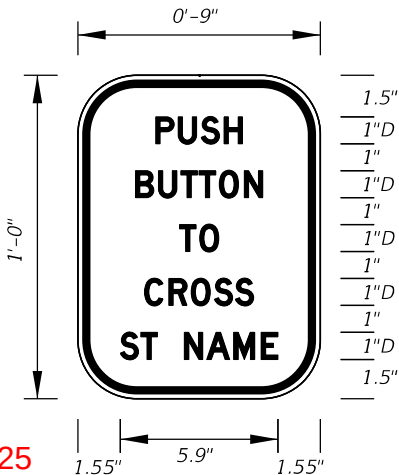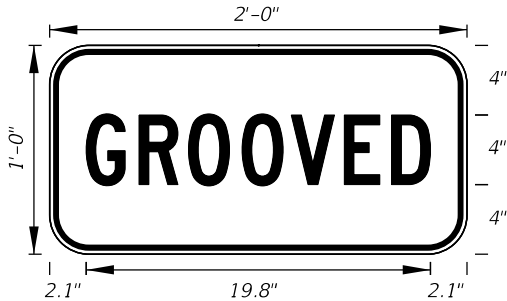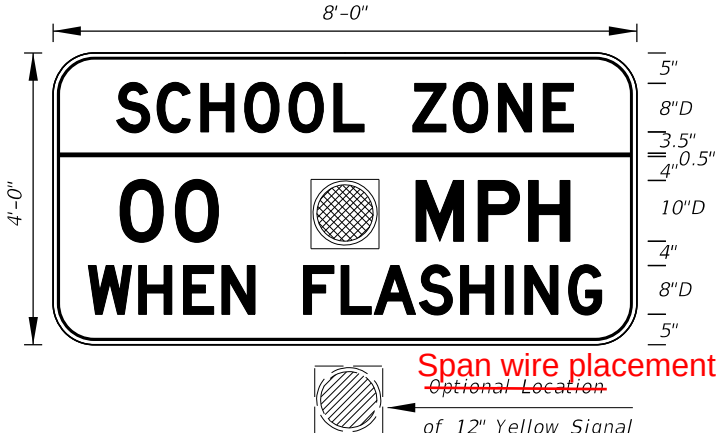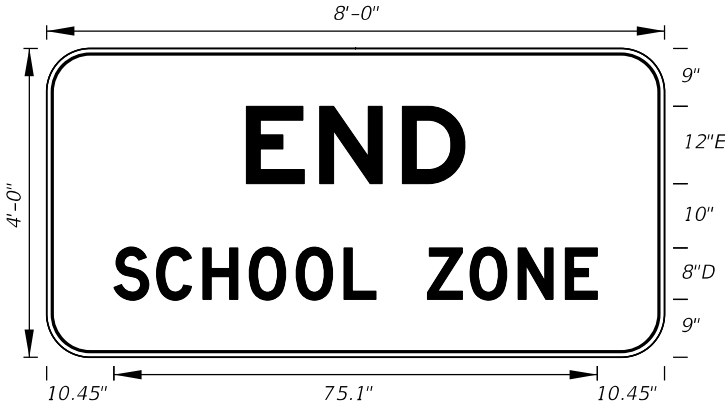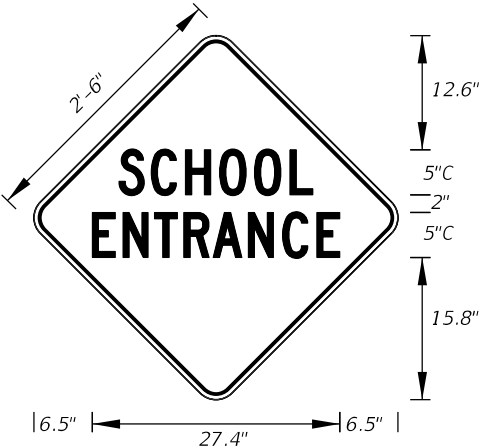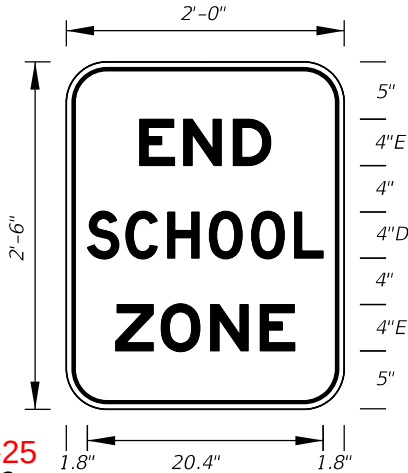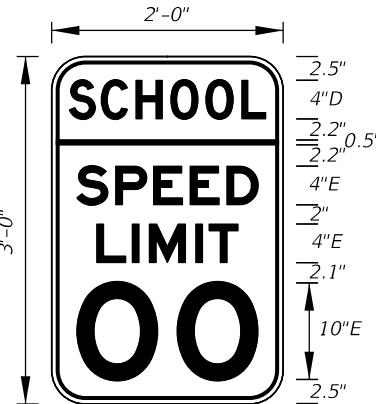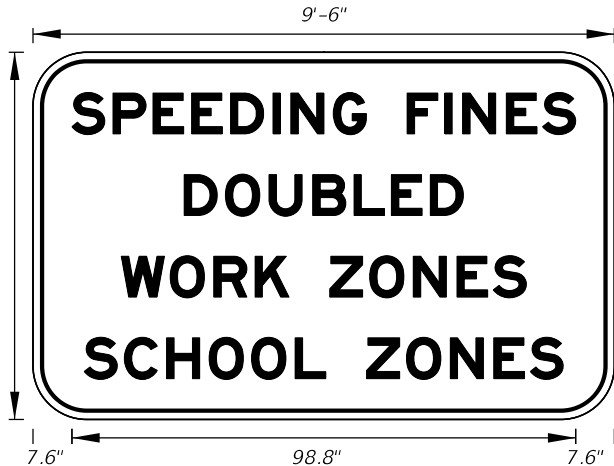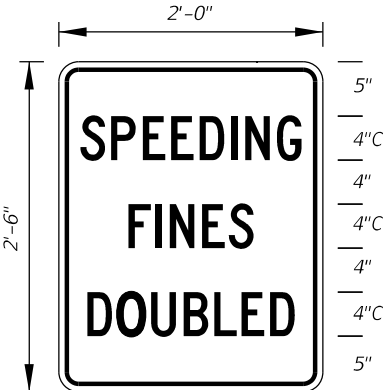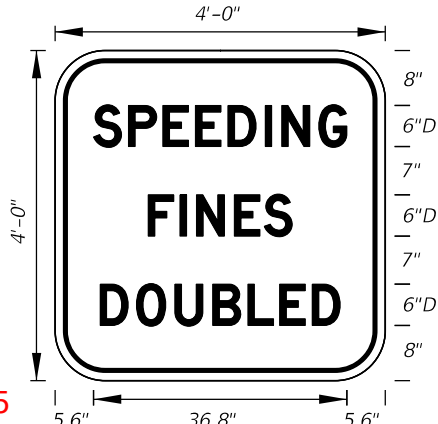9/10/2024 2:49:56 PM

 FTP-033-25 FTP-25-06 9" X 1'-0" 2" Radii $\frac{3}{8}$" Border 1" Series D Legend White Background Black Legend and Border		 FTP-013-25 FTP-29-06 2'-0" X 1'-0" 2" Radii $\frac{5}{8}$" Border 4" Series C Legend Yellow Background Black Legend and Border		 FTP-022-25 FTP-31-06 8' X 4' 6" Radii $\frac{3}{4}$" Border Series D Legend Fluorescent Yellow-Green Background Top White Background Bottom Black Legend and Border Span wire placement Optional Location of 12" Yellow Signal		 FTP-023A-25 FTP-32-06 8' X 4' 6" Radii $\frac{3}{4}$" Border 12" Series E and 8" Series D Legend White Background Black Legend and Border			
 FTP-201-25 FTP-33-06 2'-6" X 2'-6" 2" Radii $\frac{3}{4}$" Border 5" Series C Legend Fluorescent Yellow-Green Background Black Legend and Border		 FTP-023-25 FTP-34-06 2' X 2'-6" 3" Radii $\frac{5}{8}$" Border Top 4" Series D Legend Bottom 4" and 10" Series E Legend Fluorescent Yellow-Green Background Top White Background Bottom Black Legend and Border		 FTP-021-25 FTP-35-06 2' X 3' 3" Radii $\frac{5}{8}$" Border Top 4" Series D Legend Bottom 4" and 10" Series E Legend Fluorescent Yellow-Green Background Top White Background Bottom Black Legend and Border		 FTP-606-25 FTP-36-06 3' X 3' 5" Radii 4" Series D Legend Green Background White Legend and Border			
 FTP-019-25 FTP-37-06 9'-6" X 6' 9" Radii 2" Border 8" Series E Legend White Background Black Legend and Border State Line Sign		 FTP-020-25 FTP-38-22 2' X 2'-6" 1.5" Radii $\frac{1}{2}$" Border 4" Series C Legend 80% Spacing White Background Black Legend and Border		 FTP-020A-25 FTP-39-06 4' X 4' 6" Radii $\frac{3}{4}$" Border 6" Series D Legend White Background Black Legend and Border Freeway Sign		 FTP-014A-25 FTP-40-21 3'-6" X 4' 6" Radii $\frac{3}{4}$" Border 3" and 6" Series C Legend White Background Black Legend and Border			
LAST REVISION 11/01/21 11/01/25		DESCRIPTION:		FY 2025-26 2026-27 STANDARD PLANS		SPECIAL SIGN DETAILS		INDEX 700-102	SHEET 22 5 of 12

9/10/2024 2:50:06 PM

FTP-014-25
~~FTP-41-21~~

2" and 4" Series C Legend
White Background
Black Legend and Border

FTP-803-25
~~FTP-42-06~~

Bottom 2" Series EM Legend
White Background
Blue Legend and Border

FTP-413-25
~~FTP-43-06~~

Bottom 6" Series D Legend
Blue Background
White Legend and Border

FTP-004A-25
~~FTP-44-06~~

8" Series D Legend
White Background
Black Legend and Border

FTP-004-25
~~FTP-44A-25~~

4" Series C Legend
White Background
Black Legend and Border

~~FTP-45-25~~ **FTP-006-25**

2.5" Series C Legend
2" Series C Legend
1.5" Series C Legend and
White Background
Black Legend and Border

FTP-005A-25
~~FTP-46-06~~

3" X 4"
5" Radii 3/4" Border
3" Series D Legend
White Background
Green Florida Symbol
Black Legend, Border and Man Belt Symbol

FTP-005-25
~~FTP-47-06~~

2' X 2'-6"
3" Radii 5/8" Border
2" Series D Legend
White Background
Green Florida Symbol
Black Legend, Border and Man Belt Symbol

FTP-607-25
~~FTP-48-06~~

3'-6" X 5'
6" Radii
4" Series C Legend
Green Background
White Legend, Border and Symbol

FTP-608-25
~~FTP-49-06~~

3'-6" X 5'-6"
6" Radii
4" Series C Legend
Green Background
Municipality Name Optional
White Legend, Border and Symbol

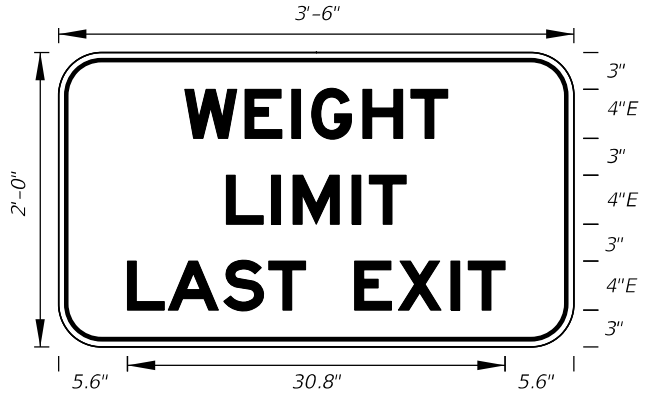
FTP-607-25 **FTP-608-25**

Detail for ~~FTP-48-06~~ and ~~FTP-49-06~~

~~FTP-50-06~~ **FTP-200-25**

4'-6" X 2'
3" Radii 3/4" Border
4" Series C Legend
Yellow Background
Black Legend and Border

9/10/2024 2:50:13 PM



3'-6"

2'-0"

3"

4"E

3"

4"E

3"

4"E

3"

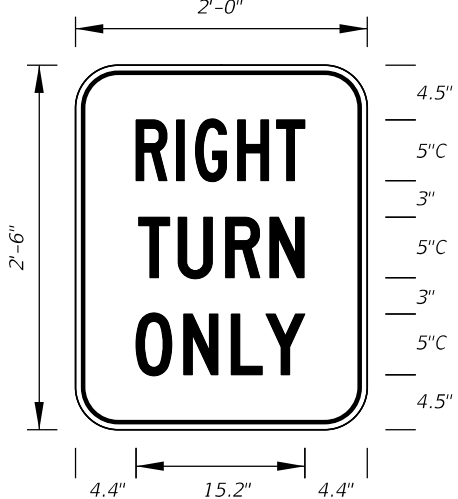
5.6"

30.8"

5.6"

FTP-003-25
~~FTP-51-06~~
3' X 2'
3" Radii 3/4" Border

4" Series E Legend
White Background
Black Legend and Border



2'-0"

2'-6"

4.5"

5"C

3"

5"C

3"

5"C

3"

5"C

4.5"

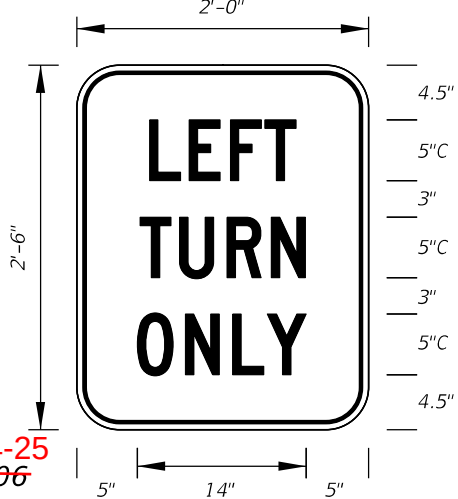
4.4"

15.2"

4.4"

FTP-043-25
~~FTP-52-06~~
2' X 2'-6"
3" Radii 5/8" Border

5" Series C Legend
White Background
Black Legend and Border



2'-0"

2'-6"

4.5"

5"C

3"

5"C

3"

5"C

3"

5"C

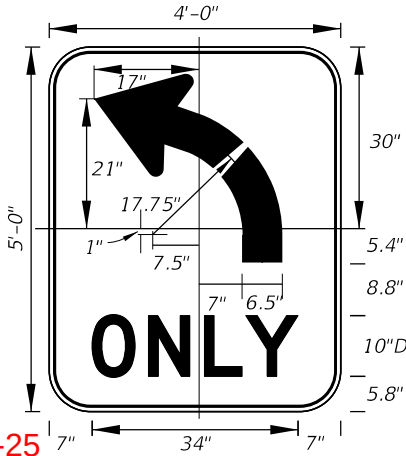
4.5"

5"

14"

5"

FTP-044-25
~~FTP-53-06~~
2' X 2'-6"
3" Radii 5/8" Border
5" Series C Legend
White Background
Black Legend and Border



4'-0"

5'-0"

30"

5.4"

8.8"

10"D

5.8"

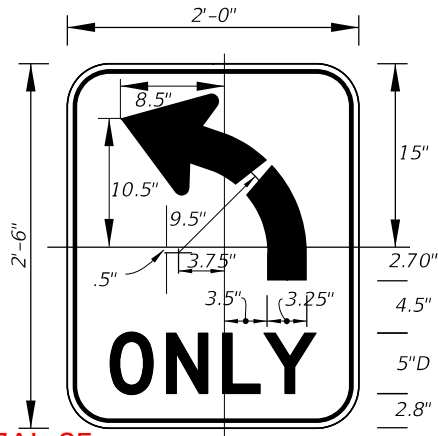
7"

34"

7"

FTP-037L-25
~~FTP-54L-06~~
4' X 5'
6" Radii 3/4" Border
10" Series D Legend
White Background
Black Legend and Border

FTP-037R-25
~~FTP-54R-06~~ for
(Right Turn Arrow)



2'-0"

2'-6"

15"

2.70"

4.5"

5"D

2.8"

3.5"

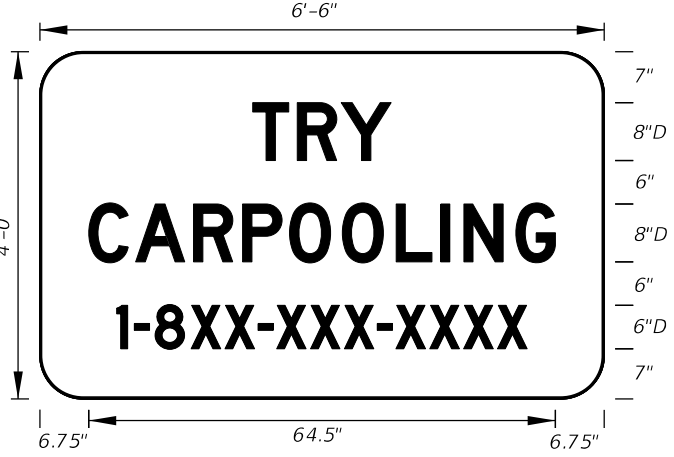
17"

3.5"

FTP-037AL-25
~~FTP-55L-06~~
2' X 2'-6"
3" Radii 3/8" Border
5" Series D Legend
White Background
Black Legend and Border

FTP-037A-R-25
~~FTP-55R-06~~ for
(Right Turn Arrow)

FTP-037A-U-25 for (U-Turn Arrow)



6'-6"

4'-0"

7"

8"D

6"

8"D

6"

6"D

7"

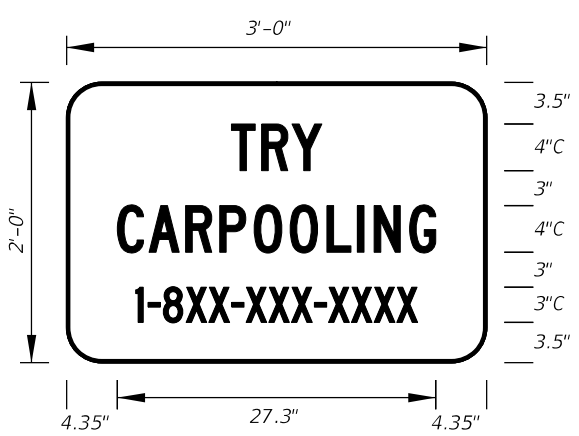
6.75"

64.5"

6.75"

FTP-56-06 **FTP-418A-25**
6'-6" X 4'
6" Radii 3/4" Border
8" and 6" Series D Legend
Blue Background
White Legend and Border

Design Project Manager
or Transit Administrator
will supply correct 1-8XX
number.



3'-0"

2'-0"

3.5"

4"C

3"

4"C

3"

3"C

3.5"

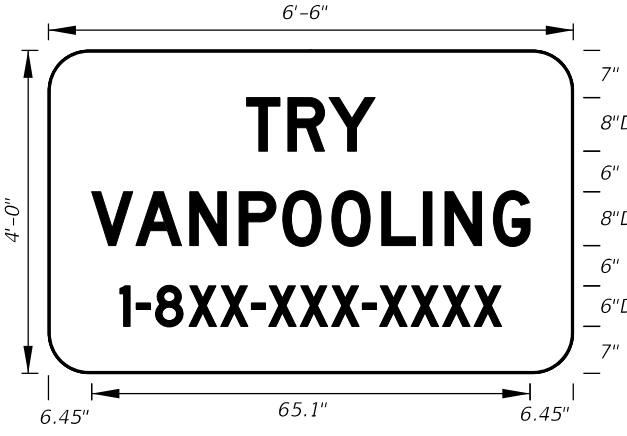
4.35"

27.3"

4.35"

FTP-56A-06 **FTP-418-25**
3' X 2'
3" Radii
4" and 3" Series C Legend
Blue Background
White Legend and Border

Design Project Manager
or Transit Administrator
will supply correct 1-8XX
number.



6'-6"

4'-0"

7"

8"D

6"

8"D

6"

6"D

7"

6.45"

65.1"

6.45"

FTP-57-06 **FTP-419A-25**
6'-6" X 4'
6" Radii
8" and 6" Series D Legend
Blue Background
White Legend and Border

Design Project Manager
or Transit Administrator
will supply correct 1-8XX
number.



3'-0"

2'-0"

3.5"

4"C

3"

4"C

3"

3"C

3.5"

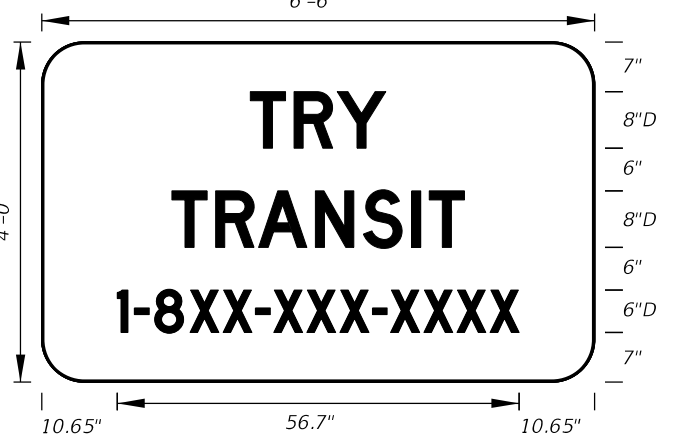
4.25"

27.5"

4.25"

FTP-58-06 **FTP-419-25**
3' X 2'
3" Radii
4" and 3" Series C Legend
Blue Background
White Legend and Border

Design Project Manager
or Transit Administrator
will supply correct 1-8XX
number.



6'-6"

4'-0"

7"

8"D

6"

8"D

6"

6"D

7"

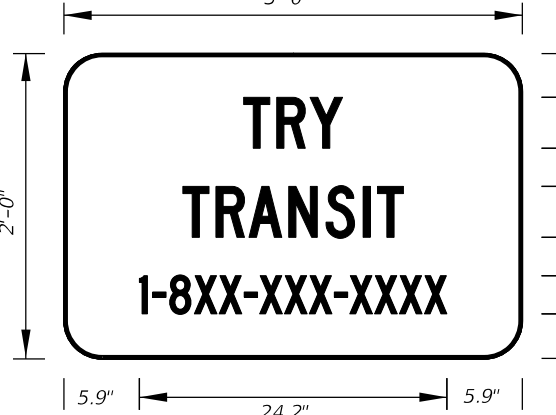
10.65"

56.7"

10.65"

FTP-59-06 **FTP-420A-25**
6'-6" X 4'
6" Radii
8" and 6" Series D Legend
Blue Background
White Legend and Border

Design Project Manager
or Transit Administrator
will supply correct 1-8XX
number.



3'-0"

2'-0"

3.5"

4"C

3"

4"C

3"

3"C

3.5"

5.9"

24.2"

5.9"

FTP-60-06 **FTP-420-25**
3' X 2'
3" Radii
4" and 3" Series C Legend
Blue Background
White Legend and Border

Design Project Manager
or Transit Administrator
will supply correct 1-8XX
number.



3'-0"

2'-0"

4.5"

4"C

2"

4"C

2"

3"C

4.5"

4.3"

27.4"

4.3"

FTP-61-06 **FTP-203-25**
3' X 2'
3" Radii 3/4" Border
4" and 3" Series C Legend
Yellow Background
Black Legend and Border

FTP-203A-25
~~FTP-62-06~~
3' X 3'
2" Radii 3/4" Border 4"and 5" Series C Legend
Yellow Background Black Legend and Border

FTP-012-25
~~FTP-65-06~~
3' X 1'-6"
2" Radii 3/4" Border
4" Series D Legend
White Background
Black Legend and Border

FTP-414-25
~~FTP-66-21~~
4'X5'
3" Radii 1" Border
6" Series D Legend
Blue Background
White Legend and Border

FTP-414A-25
~~FTP-67-21~~
5.5' X 6'
3" Radii 1" Border
8" Series D Legend
Blue Background
White Legend and Border

FTP-414-25 FTP-414A-25
~~FTP-66-21~~ AND ~~FTP-67-21~~
DETAIL for ~~FTP-66-21~~ AND ~~FTP-67-21~~

Sign Mounting Holes Can Be Punched Or Field Drilled With No Obstruction To Text Or Symbols From Holes Or Bolts.

FTP-034-25
~~FTP-68A-06~~
9" X 1'-3"
1.5" Radii 3/4" Border
Series B Legend
White Background
Black Legend and Border

See MUTCD R10-3f for for Letter Size, Spacing, and Symbol Sizes and Color

Sign Mounting Holes Can Be Punched Or Field Drilled With No Obstruction To Text Or Symbols From Holes Or Bolts.

FTP-035-25
~~FTP-68B-06~~
9" X 1'-6"
1.5" Radii 3/4" Border
Series B Legend
White Background
Black Legend and Border

See MUTCD R10-3i for for Letter Size, Spacing, and Symbol Sizes and Color

FTP-036-25
~~FTP-68C-21~~
9" X 1'-6"
1.5" Radii 1/4" Border
Series D Legend
White Background
Black Legend and Border

FTP-69-06
2'-6" X 2'-6"
4" Radii 3/4" Border
2" and 3" Series D Legend
White Background
Black Legend and Border

FTP-422B-25
~~FTP-70-06~~
3'-6" X 2'-6"
2.25" Radii 3/4" Border
5" Series C and 7" Series C Legend
Blue Background
White Legend and Border

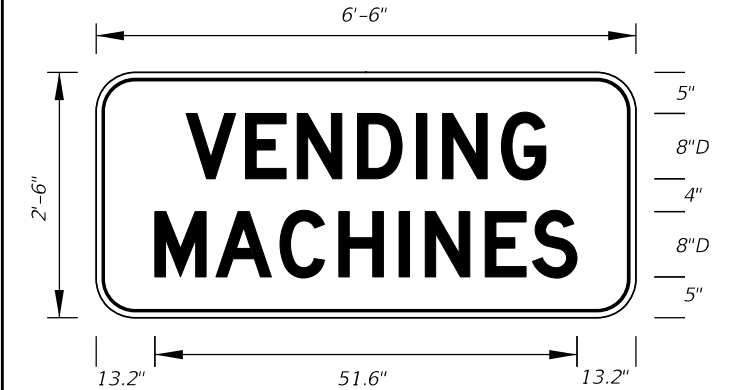
FTP-208A-25
~~FTP-71-06~~
4' X 4'
2" Radii 3/4" Border
8" Series C Legend
Yellow Background
Black Legend and Border

FTP-208-25
~~FTP-72-06~~
3' X 3'
2" Radii 3/4" Border
6" Series C Legend
Yellow Background
Black Legend and Border

NEW Sheet 13 of 22:

ADDED NEW Traffic Info Tune
Radio Signs


9/10/2024 2:50:26 PM




FTP-409-25
~~FTP-73-06~~
6'-6" X 2'-6"
4" Radii 3/4" Border
8" Series D Legend
Blue Background
White Legend and Border



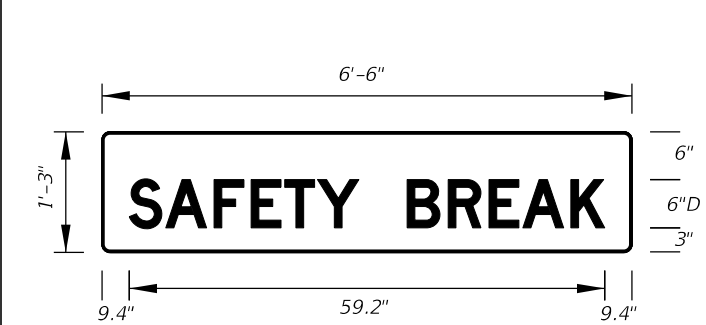
~~FTP-74-06~~ FTP-410-25
6'-6" X 2'-6"
4" Radii 3/4" Border
6" Series D Legend
Blue Background
White Legend and Border



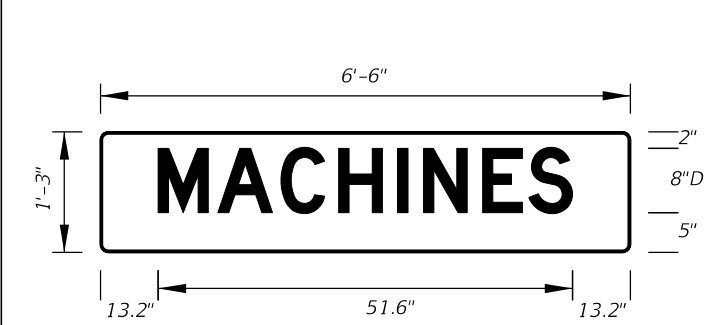
FTP-411-25
~~FTP-75-06~~
6'-6" X 1'-3"
1" Radii
6" Series D Legend
Blue Background
White Legend



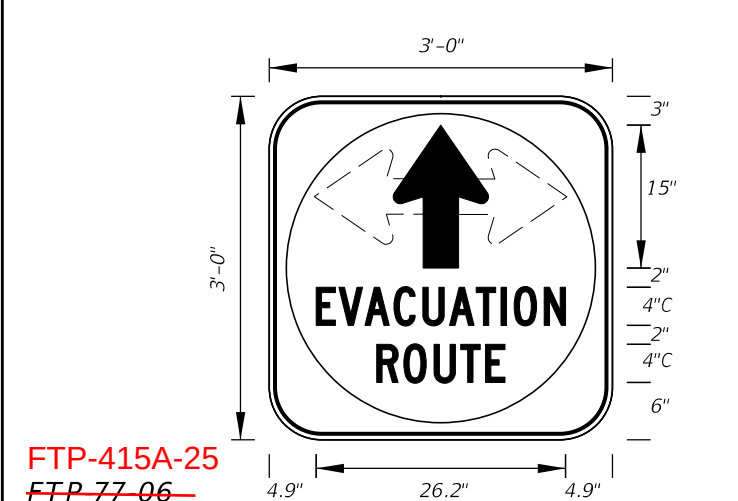
FTP-412-25
~~FTP-76-06~~
6'-6" X 1'-3"
1" Radii
8" Series D Legend
Blue Background
White Legend



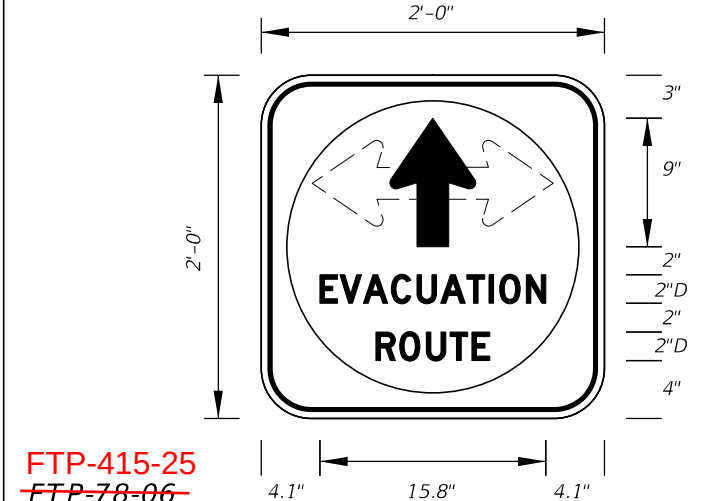
FTP-415A-25
~~FTP-77-06~~
3' X 3'
5" Radii 3/4" Border
4" Series C Legend
White Background with Blue Circle Background
White Legend and Black Border



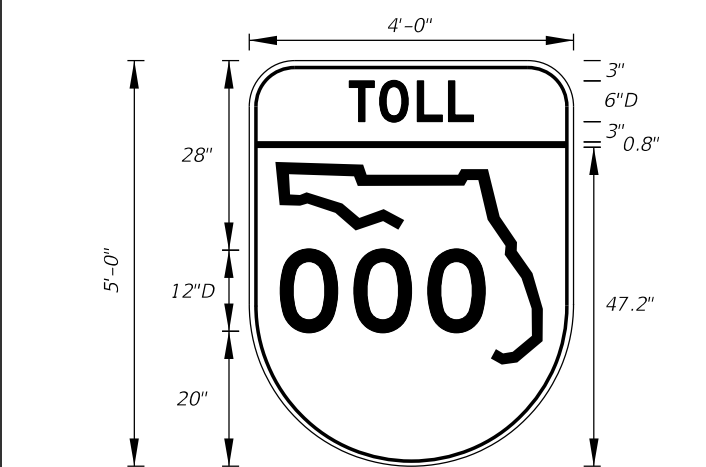
FTP-415-25
~~FTP-78-06~~
2' X 2'
3" Radii 3/4" Border
2" Series D Legend
White Background with Blue Circle Background
White Legend and Black Border



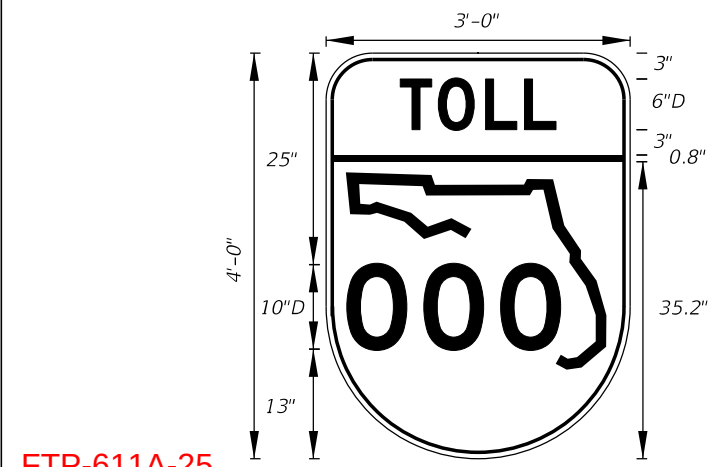
~~FTP-79-06~~ FTP-611B-25
4' X 5'
6" Radii 3/4" Border
6" and 12" Series D Legend
Top Yellow Background with Black Legend and Black Border
Bottom White Background with Black Legend and Border



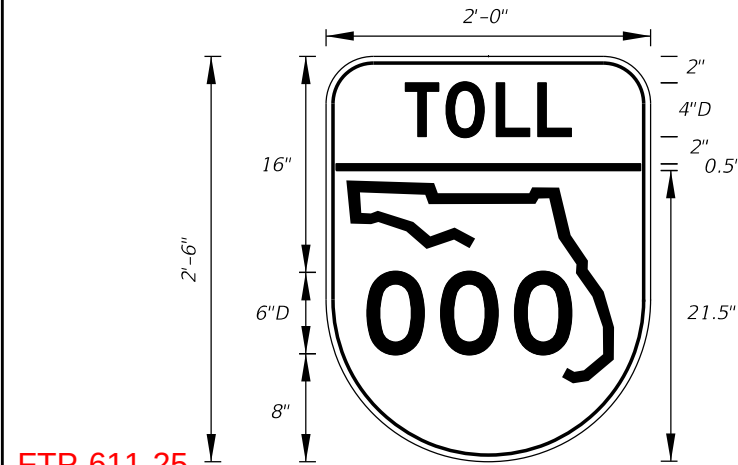
FTP-611A-25
~~FTP-80-06~~
3' X 4'
5" Radii 3/4" Border
6" and 10" Series D Legend
Top Yellow Background with Black Legend and Black Border
Bottom White Background with Black Legend and Border



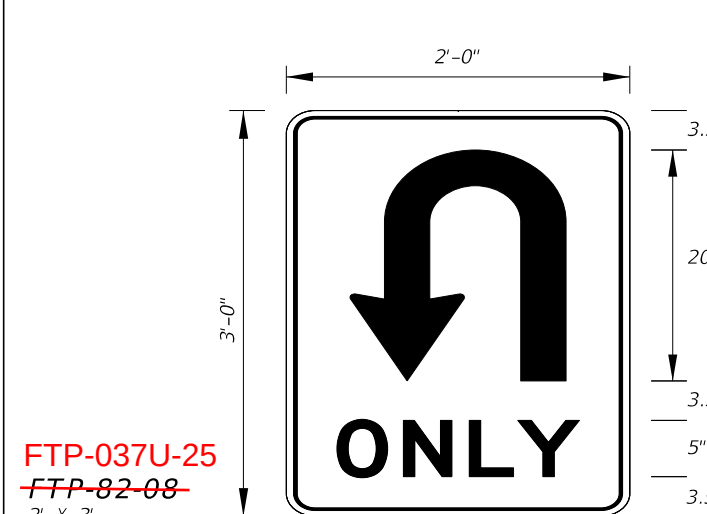
FTP-611-25
~~FTP-81-06~~
2' X 2'-6"
3" Radii 3/4" Border
4" and 6" Series D Legend
Top Yellow Background with Black Legend and Black Border
Bottom White Background with Black Legend and Border



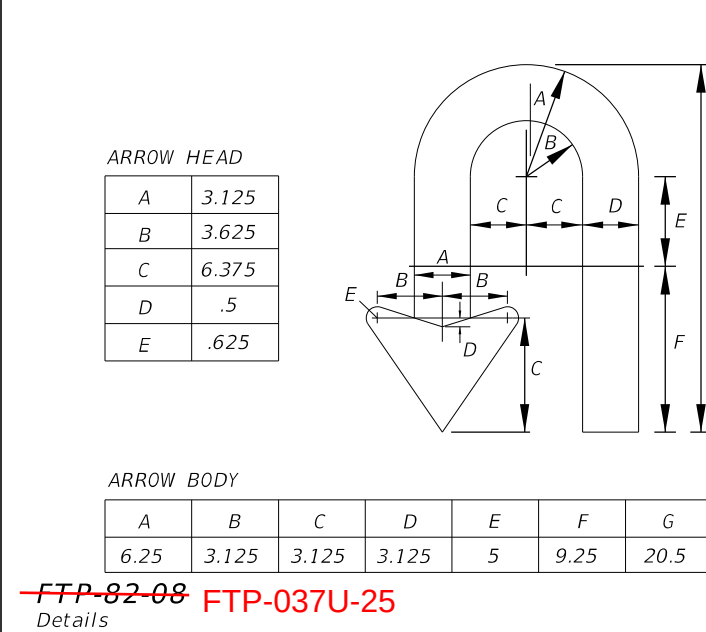
FTP-037U-25
~~FTP-82-08~~
2' X 3'
1.5" Radii
5" Series D Legend
White Background
Black Legend and Border



~~FTP-82-08~~ FTP-037U-25
Details

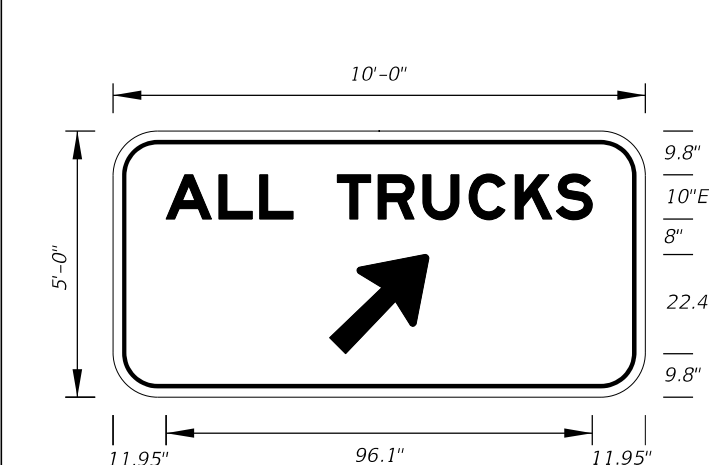

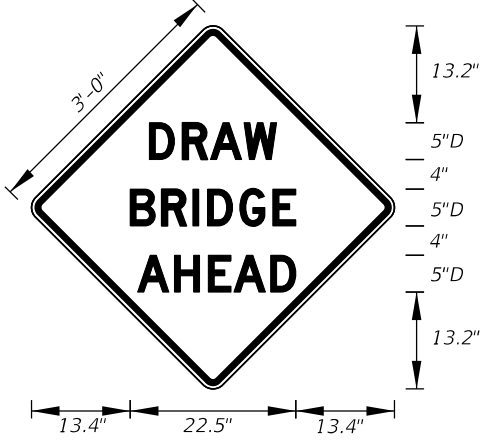FTP-605R-25
~~FTP-83-08~~
10'-0" X 5'-0"
8" Radii
10" Series E Legend
Green Background
White Legend
FTP-606L-25 for LEFT ARROW



3'-0"

13.2"

5"D

4"

5"D

4"

5"D

13.2"

13.4"

22.5"

13.4"

FTP-202-25

~~FTP-84-09~~

3' X 3'
1.5" Radii

5" Series D Legend
Yellow Background
Black Legend and
Border



2'-6"

3'-0"

3.75"

3.5" C

2.75"

3.5" C

2.75"

3.5" C

2.75"

3.5" C

2.75"

3.5" C

3.75"

23.18"

FTP-026-25

~~FTP-85-13~~

2'-6" X 3'
1.875" Radii ¾" Border

3.5" Series C Legend
White Background
Black Legend and Border



STATE LAW

STOP

FOR

WITHIN CROSSWALK

1'-6"

9"

1.5" D

0.5"

1.5" D

0.6"

0.7"

0.7"

1.3" C

0.5"

1.2" C

0.5"

FTP-032-25

~~FTP-86-21~~

9' X 2'-3"
1.5" Radii No Border

Series C Legend and
Series D Legend
White on Yellow
Black Legend and Border



15'-6"

8'-6"

15.5"

155"

15.5"

9"

12"EM

9"

12"EM

9"

22"

8"

12"D

9"

FTP-406-25

~~FTP-87-21~~

15'-6" X 8'-6"
12" Radii 2" Border

Series D Legend
Series EM Legend
Blue Background
White Legend and Border



15'-6"

8'-6"

15.5"

155"

15.5"

9"

12"EM

9"

12"EM

9"

22"

8"

12"D

9"

FTP-407-25

~~FTP-88-21~~

15'-6" X 8'-6"
12" Radii 2" Border

Series D Legend
Series EM Legend
Blue Background
White Legend and Border



16'-6"

8'-6"

16.7"

164.6"

16.7"

9"

12"EM

9"

12"EM

9"

22"

8"

12"D

9"

FTP-408-25

~~FTP-89-21~~

16'-6" X 8'-6"
12" Radii 2" Border

Series D Legend
Series EM Legend
Blue Background
White Legend and Border



3'-0"

3'-0"

2.5"

31"

2.5"

3"

3"C

2"

3"C

2"

5"D

2"

3"C

2"

3"C

2"

3"C

2"

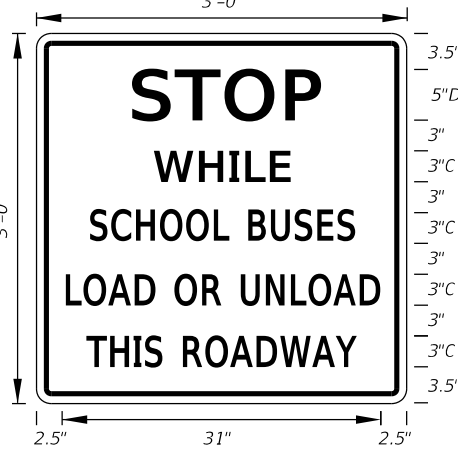
3"

FTP-024-25

~~FTP-90-22~~

3'-0" X 3'-0"
1.5" Radii ¾" Border

3" Series C Legend and
5" Series D Legend
White Background
Black Legend and Border



3'-0"

3'-0"

2.5"

31"

2.5"

3.5"

5"D

3"

3"C

3"

3"C

3"

3"C

3"

3"C

3"

3.5"

FTP-025-25

~~FTP-91-22~~

3'-0" X 3'-0"
1.5" Radii ¾" Border

3" Series C Legend and
5" Series D Legend
White Background
Black Legend and Border



2'-0"

6"

1.5"

3"

1.5"

1.6"

1.28"

2"

6"

1.6"

FTP-040-25

~~FTP-100-25~~

2'-0" X 6"
1.5" Radii
0.4" Border
0.4" Indent

3" Series C Legend and
Bright Yellow Green Background
Black Legend and Border

NEW Sheet 17 of 22:

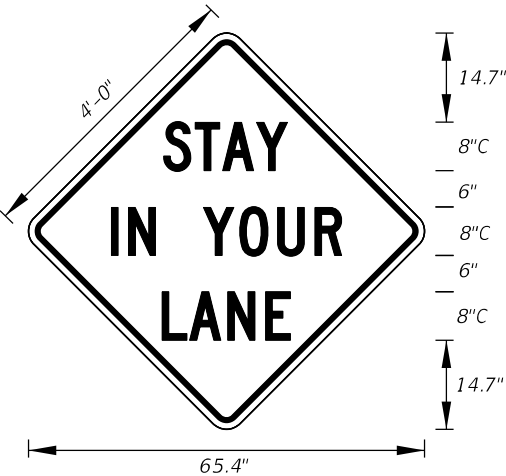
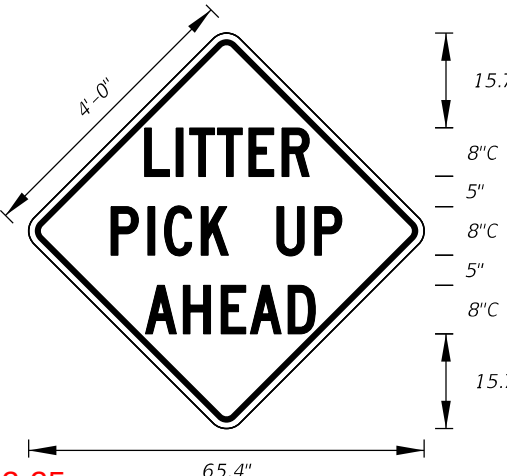
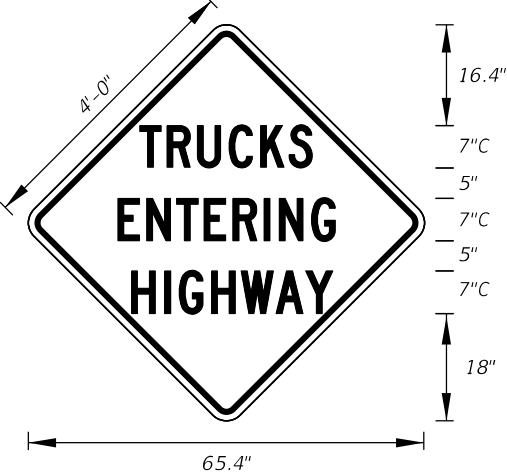
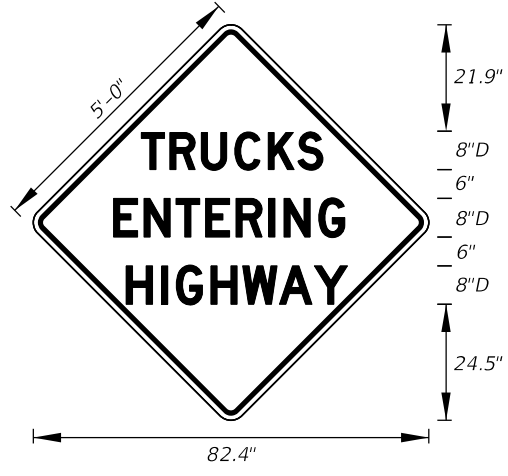
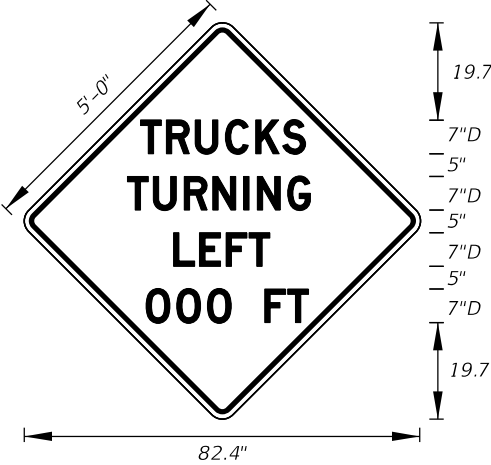
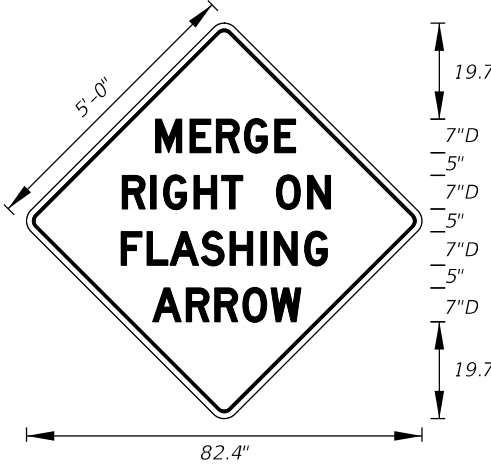
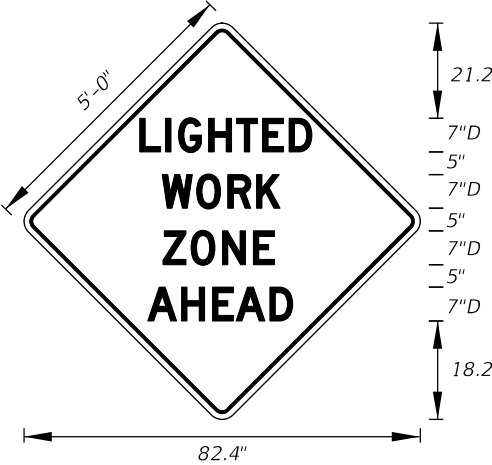
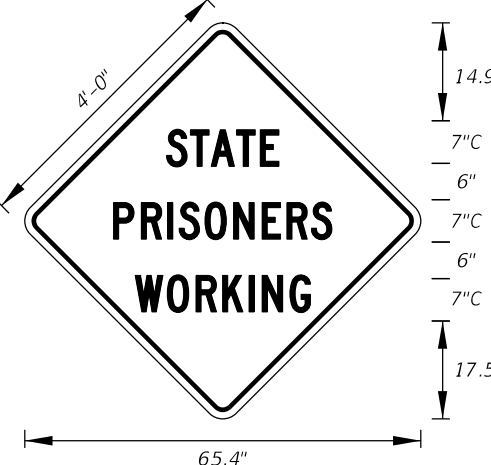
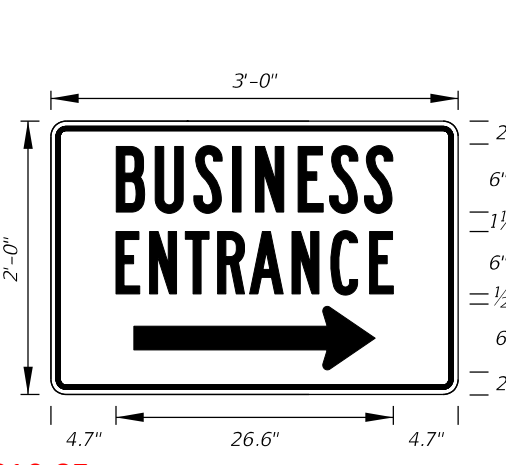
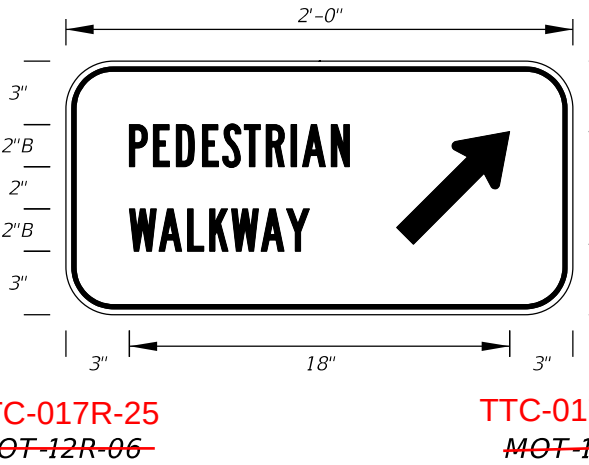
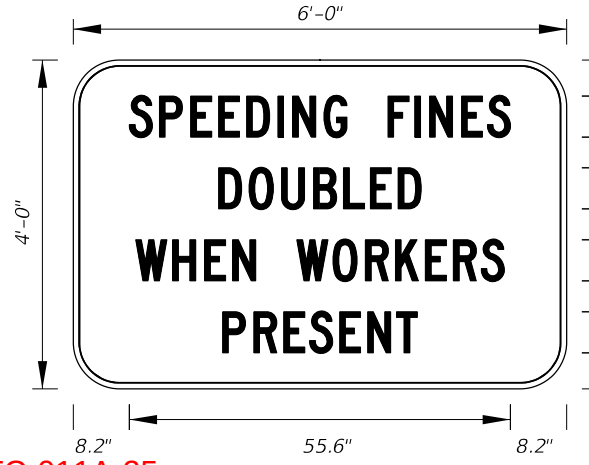
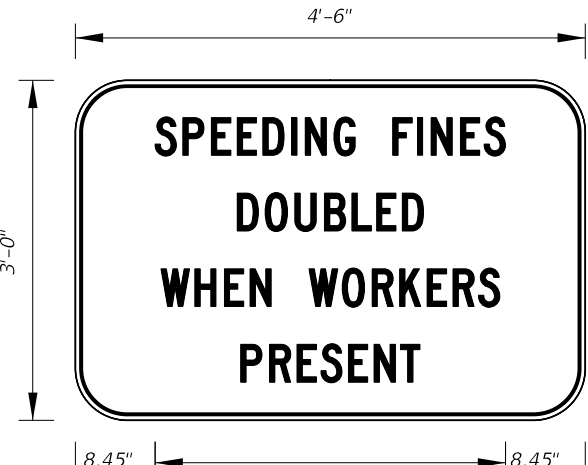
NEW Guide Signs











NEW Sheet 18 of 22:

NEW Guide Signs

NEW Sheet 19 of 22:

NEW Recreational and Culture
Signs

 TTC-001-25 MOT-1-22 8" Series C Legend Orange Background Black Legend and Border 4' X 4' 3" Radii ¾" Border	 TTC-002-25 MOT-4-22 8" Series C Legend Orange Background Black Legend and Border 4' X 4' 3" Radii ¾" Border	 TTC-003-25 MOT-5-22 7" Series C Legend Orange Background Black Legend and Border 4' X 4' 3" Radii ¾" Border	 TTC-003A-25 MOT-6-22 8" Series D Legend Orange Background Black Legend and Border 5' X 5' 3" Radii ¾" Border
 TTC-004-25 MOT-7-22 7" Series D Legend Orange Background Black Legend and Border 5' X 5' 3" Radii ¾" Border	 TTC-005-25 MOT-8-22 7" Series D Legend Orange Background Black Legend and Border 5' X 5' 3" Radii ¾" Border	 TTC-006-25 MOT-9-22 7" Series D Legend Orange Background Black Legend and Border 5' X 5' 3" Radii ¾" Border	 TTC-007-25 MOT-10-22 7" Series C Legend Orange Background Black Legend and Border 4' X 4' 3" Radii ¾" Border
 TTC-016-25 MOT-11-06 6" Series B Legend Blue Background White Legend and Border 3' X 2' 2" Radii ¾" Border	 TTC-017R-25 MOT-12R-06 2" X 1' 2" Radii ¾" Border 2" Series B Legend White Background Black Legend and Border TTC-017L-25 MOT-12L-06 For Diversion to the left	 TTC-011A-25 MOT-13-06 Freeway Sign 6' X 4' 6" Radii ¾" Border 6" Series C Legend White Background Black Legend and Border	 TTC-011-25 MOT-14-06 Arterial Sign 4'-6" X 3' 5" Radii ¾" Border 4" Series C Legend White Background Black Legend and Border

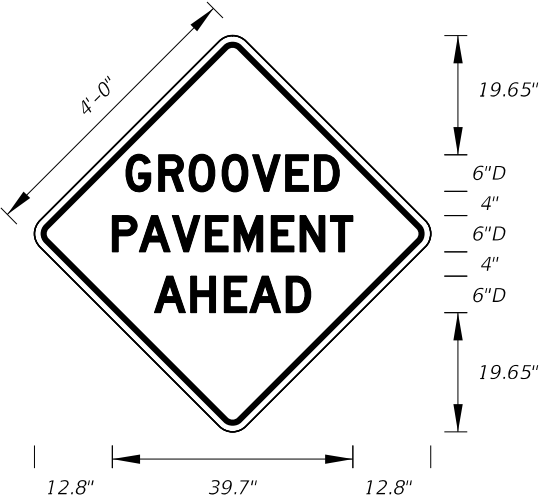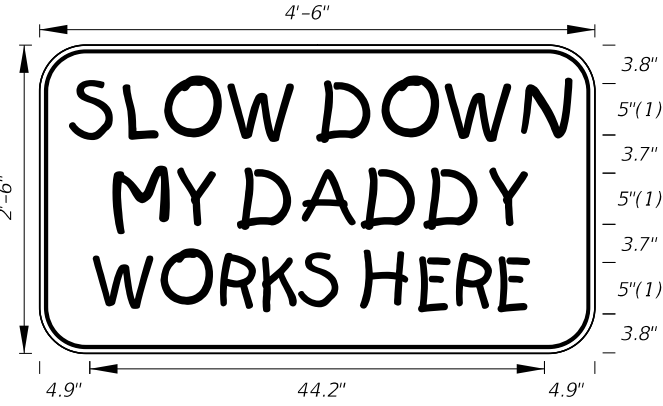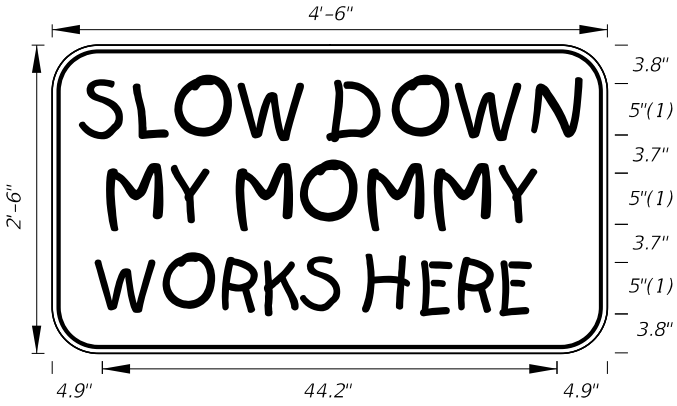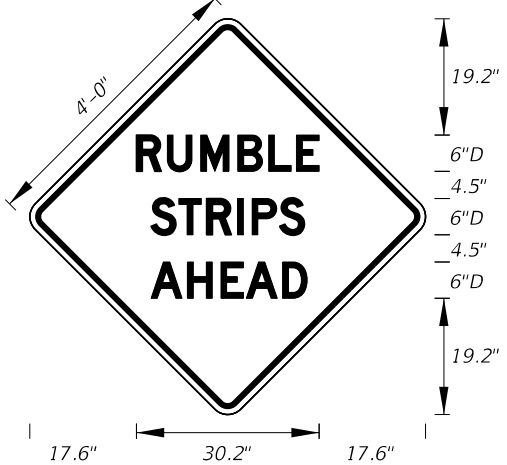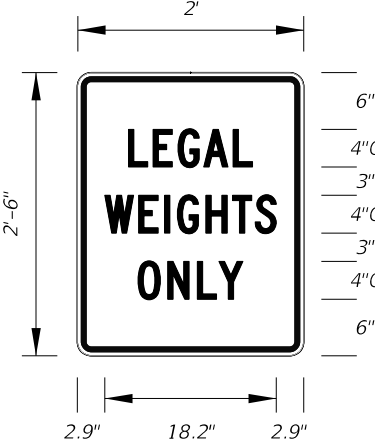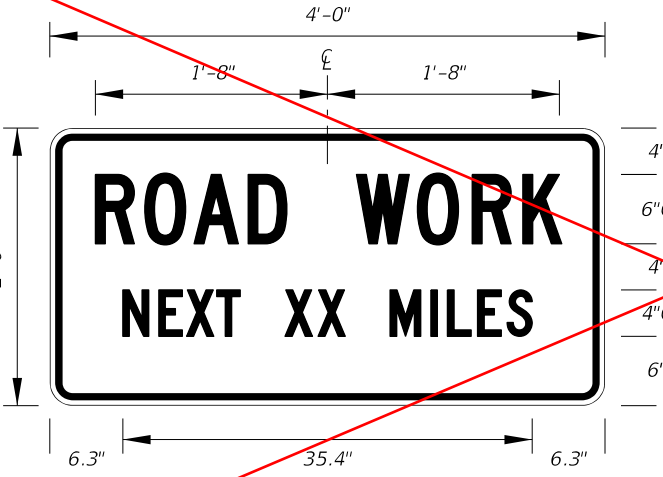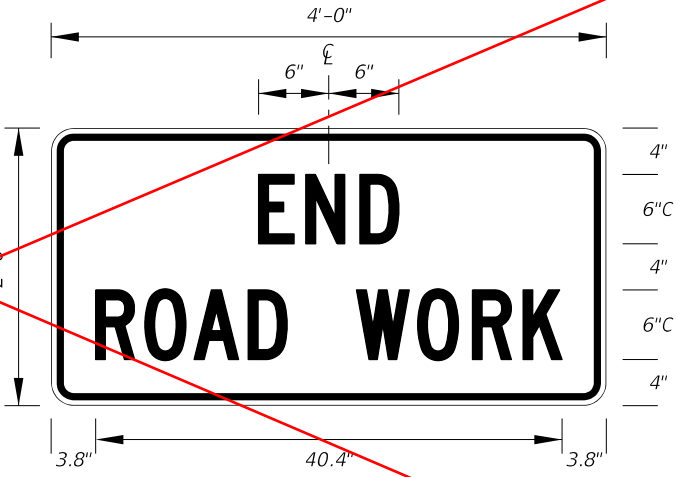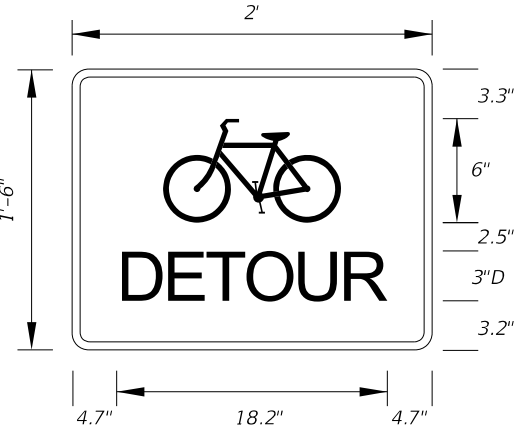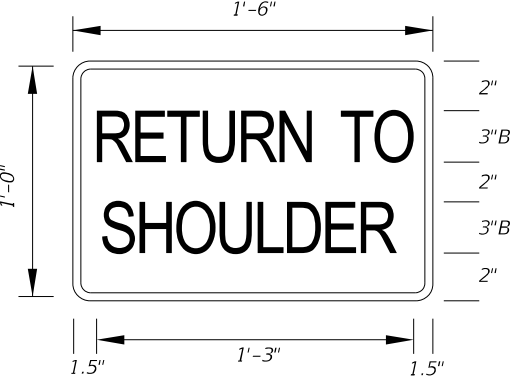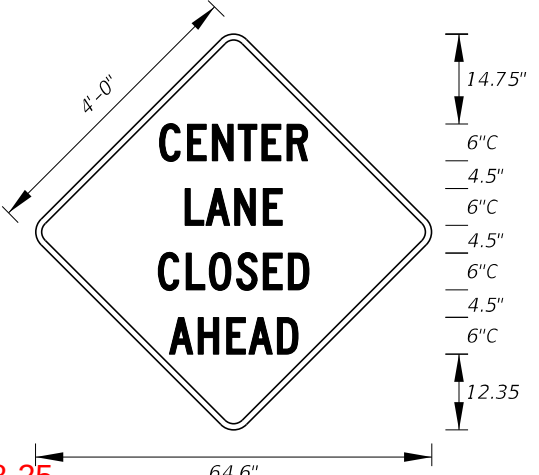 MOT-15-06 TTC-009-25 6" Series D Legend Orange Background Black Legend and Border	 TTC-012-25 MOT-16-06 5" Kids Series Legend Orange Background Black Legend and Border	 TTC-013-25 MOT-17-06 5" Kids Series Legend Orange Background Black Legend and Border	 TTC-010-25 MOT-18-10 6" Series D Legend Orange Background Black Legend and Border
 TTC-014-25 MOT-19-11 4" Series C Legend White Background Red Legend and Border	 G20-1 DELETED Orange Background Black Legend and Border	 G20-2 DELETED Orange Background Black Legend and Border	 TTC-018-25 MOT-21-21 3" Series D Legend Orange Background Black Legend and Border
 TTC-015-25 MOT-23-21 3" Series B Legend Orange Background Black Legend and Border	 TTC-008-25 MOT-27-25 6" Series C Legend Orange Background Black Legend and Border		

NEW Sheet 22 of 22:

NEW Signs Added for
REDUCE SPEED SMOKE
AHEAD and MOTORCYCLES
USE CAUTION

8/14/2025 1:27:42 PM

GENERAL NOTES:

1. Sign dimensions are shown in width by height (W x H) throughout the Index.

2. Numbering Convention:
FTP-AAA B/C-DD or TTC-AAA B/C-DD

FTP = Florida Traffic Plans
TTC = Temporary Traffic Control













AAA = Sign Type
B = Size Adjustments to Smallest Available Sign Size (A,B,C)
C = Left or Right (L or R)
DD = Year of update

Example 1: Size Adjustment - FTP-001A-25
Example 2: Direction Application - FTP-103R-25
Example 3: Size and Direction - FTP-037AR-25

Sign Types (AAA):
FTP-001-199: Regulatory
FTP-200-399: Warning & Advisory
FTP-400-599: Motorist Service
FTP-600-799: Guide
FTP-800-899: Recreational & Cultural
FTP-900-999: Miscellaneous
FTP-1000-1199: Tolls
TTC-001-199: Temporary Traffic Control

TABLE OF CONTENTS:	
Sheet	Description
1	General Notes and Table of Contents
2	Sign Details FTP-001-25 through FTP-007B-25
3	Sign Details FTP-008-25 through FTP-018-25
4	Sign Details FTP-019-25 through FTP-027-25
5	Sign Details FTP-028-25 through FTP-036-25
6	Sign Details FTP-037L-25 through FTP-040-25
7	Sign Details FTP-200-25 through FTP-206B-25
8	Sign Details FTP-207-25 through FTP-208A-25
9	Sign Details FTP-400-25 through FTP-409-25
10	Sign Details FTP-410-25 through FTP-415A-25
11	Sign Details FTP-416-25 through FTP-417-25
12	Sign Details FTP-411-25 through FTP-422B-25
12	Sign Details FTP-423-25 through FTP-423A-25
14	Sign Details FTP-600-25 through FTP-609-25
15	Sign Details FTP-610 through FTP-611B-25
16	Sign Details FTP-612-25 through FTP-613-25
17	Sign Details FTP-614-25 through FTP-618A-25
18	Sign Details FTP-619-25 through FTP-622-25
19	Sign Details FTP-800-25 through FTP-804A-25
20	Sign Details TTC-001-25 through TTC-010-25
21	Sign Details TTC-011-25 through TTC-018-25
22	Sign Details TTC-001-25 through TTC-010-25
APPENDIX	Crosswalk













OTHER THAN FREEWAY USE FTP-001-25 7'-0" X 3'-6" 6" Radii 2" Border 6" Series E Legend White Background Black Legend and Border		FREEWAY USE FTP-001A-25 11'-6" X 5'-6" 9" Radii 2" Border 10" Series E Legend White Background Black Legend and Border		FTP-002R-25 FTP-002L-25 14'-6" X 7'-6" 12" Radii 2" Border 10" Series E Legend White Background Black Legend and Border NOTES: 1. Use FTP-002L-25 for "NEXT LEFT". 2. On Interstate Station, delete PICKUPS-VANS, and reduce sign height accordingly.		FTP-003-25 3'-0" X 2'-0" 3" Radii ¾" Border 4" Series E Legend White Background Black Legend and Border
FTP-004-25 4'-0" X 3'-0" 5" Radii ¾" Border 4" Series C Legend White Background Black Legend and Border		FTP-004A-25 9'-0" X 6'-0" 9" Radii ¾" Border 8" Series D Legend White Background Black Legend and Border		FTP-005-25 2'-0" X 2'-6" 3" Radii ⅝" Border 2" Series D Legend White Background - Green Florida Symbol Black Legend, Border and Man Belt Symbol		FTP-005A-25 3'-0" X 4'-0" 5" Radii ¾" Border 3" Series D Legend White Background - Green Florida Symbol Black Legend, Border and Man Belt Symbol
FTP-006-25 4'-0" X 4'-0" 1.5" Radii 0.4" Border 2.5" Series C Legend 2" Series C Legend 1.5" Series C Legend and White Background Black Legend and Border		Non-Limited Access FTP-007-25 4'-4" X 2'-0" 1.5" Radii 0.6" Border TOP: 4" Series D Legend Yellow Background Black Legend and Border Bottom: 4" Series D Legend White Background Black Legend and Border		Non-Limited Access FTP-007A-25 7'-0" X 3'-6" 2.25" Radii 0.9" Border TOP: 6" Series D Legend Yellow Background Black Legend and Border Bottom: 6" Series D Legend White Background Black Legend and Border		FTP-007B-25 10'-0" X 4'-6" 3" Radii X 0.8" Border TOP: 8" Series D Legend Yellow Background Black Legend and Border Bottom: 8" Series D Legend White Background Black Legend and Border

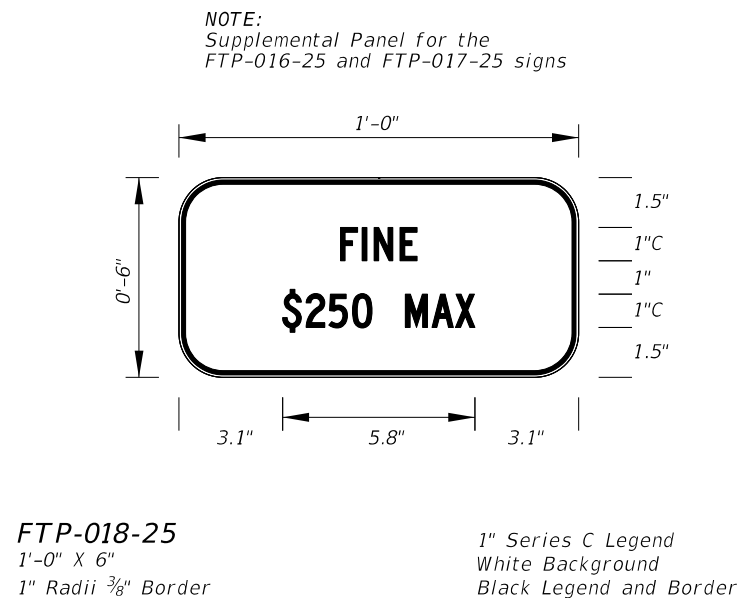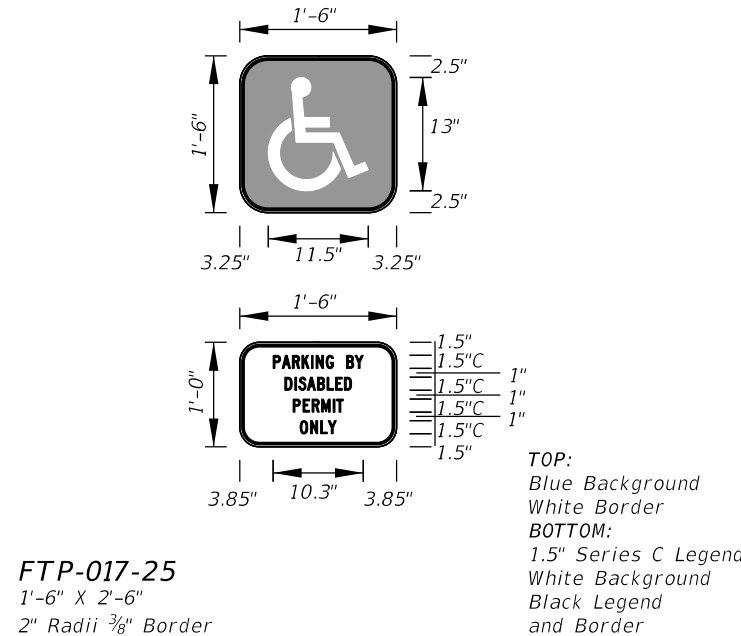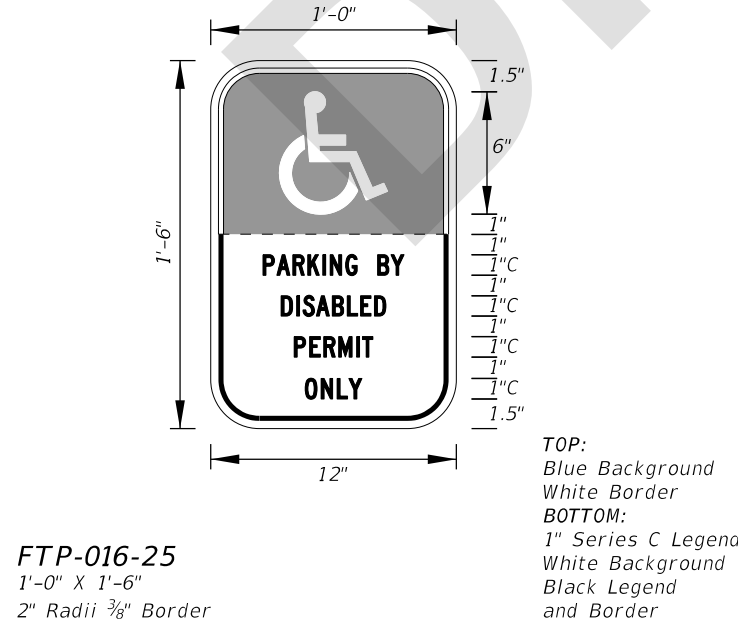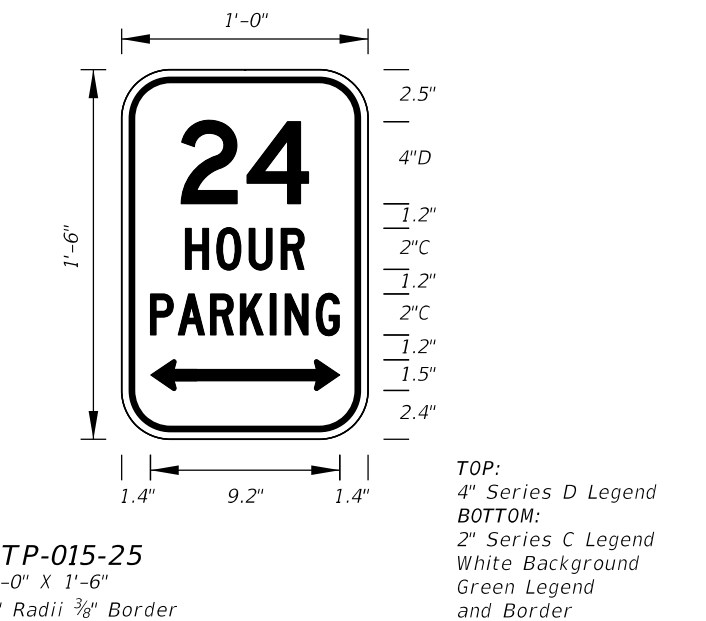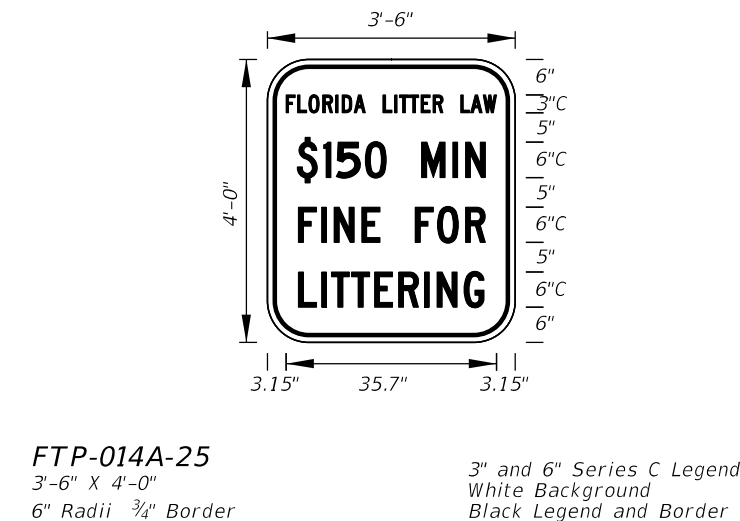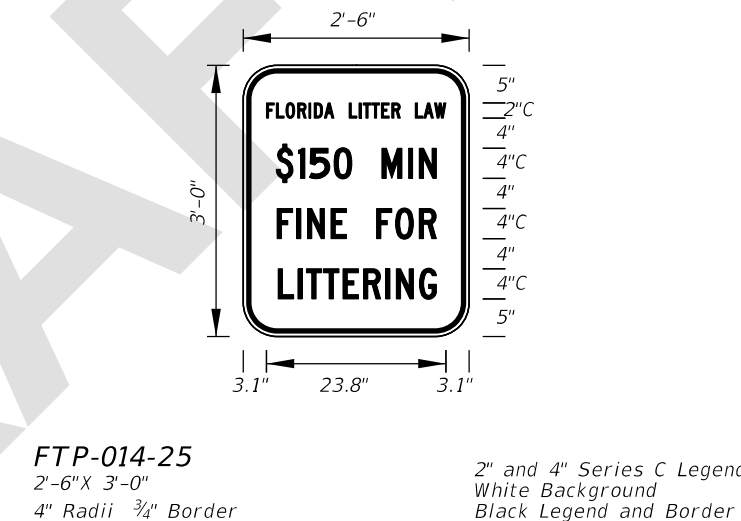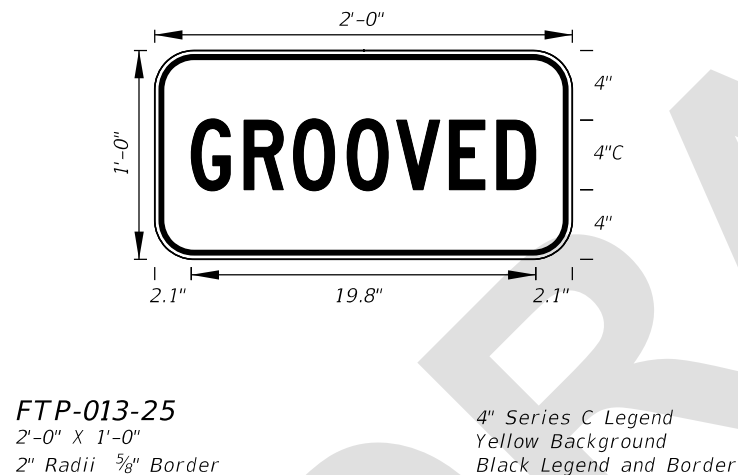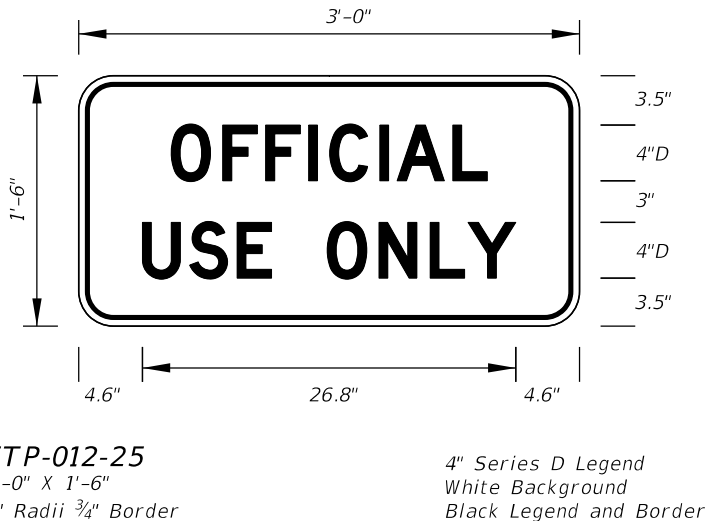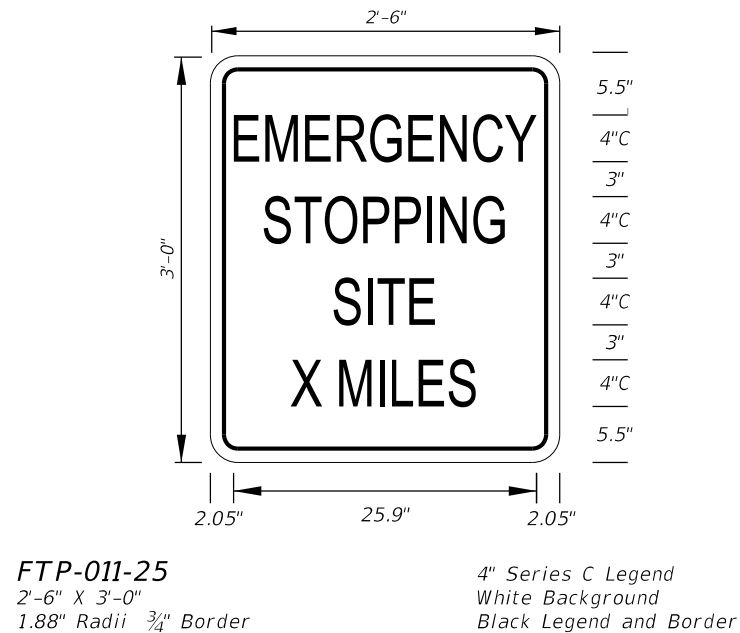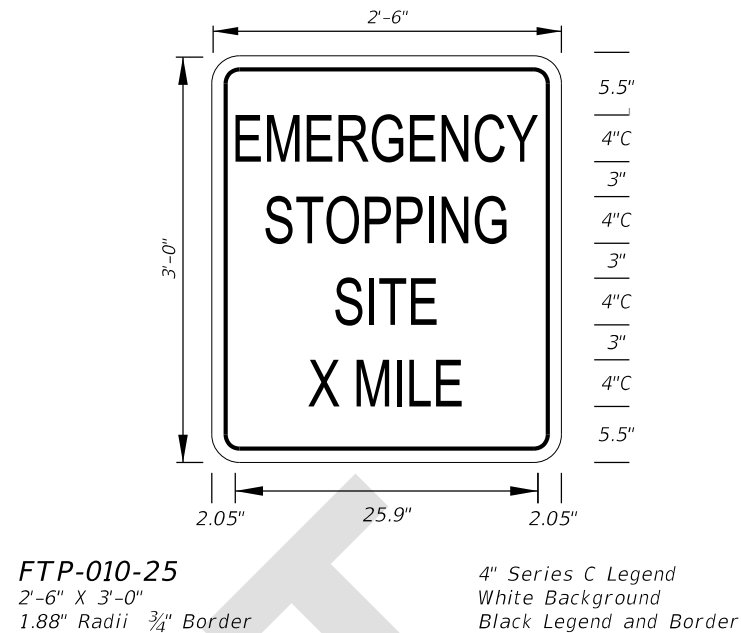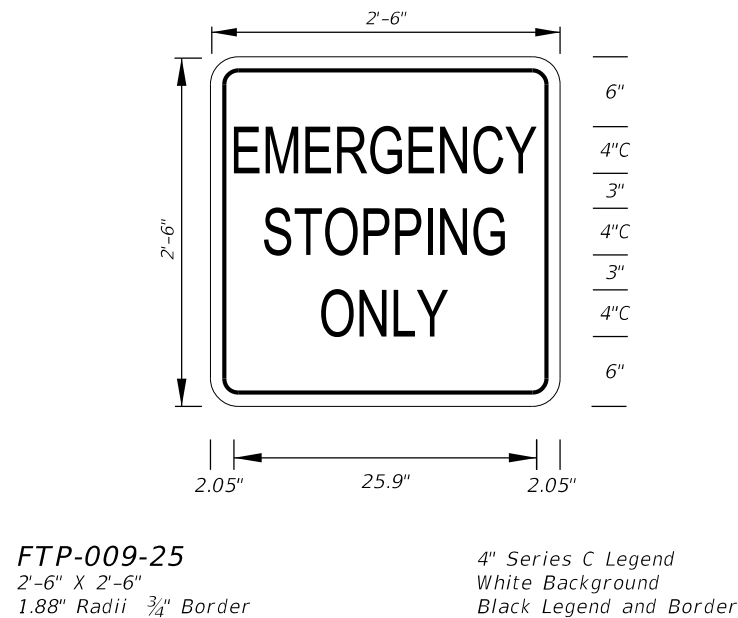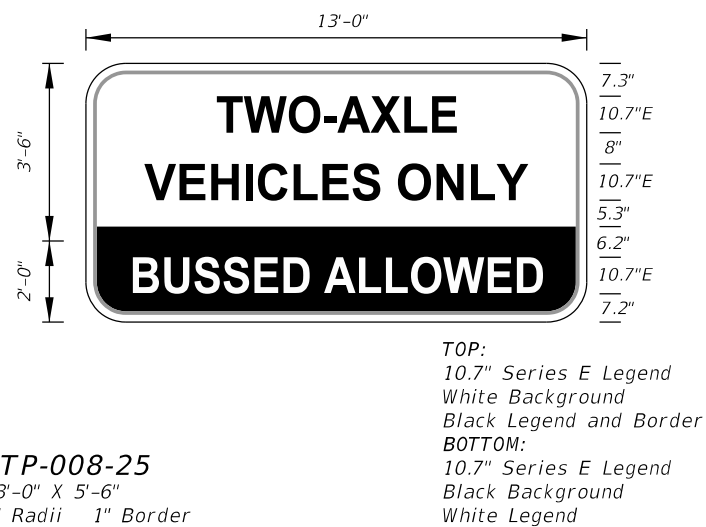


FTP-019-25 9'-6" X 6'-0" 9" Radii 2" Border 8" Series E Legend White Background Black Legend and Border		FTP-020-25 2'-0" X 2'-6" 1.5" Radii 1½" Border 4" Series C Legend 80% Spacing White Background Black Legend and Border		FTP-020A-25 4'-0" X 4'-0" 6" Radii ¾" Border 6" Series D Legend White Background Black Legend and Border		FTP-021-25 2'-0" X 3'-0" 3" Radii ⅝" Border TOP: 4" Series D Legend Fluorescent Yellow-Green Background Black Legend and Border BOTTOM: 4" and 10" Series E Legend White Background Black Legend and Border
FTP-022-25 8'-0" X 4'-0" 6" Radii ¾" Border TOP: 8" Series D Legend Fluorescent Yellow-Green Background Black Legend and Border BOTTOM: 8" and 10" Series D Legend White Background Black Legend and Border		FTP-022A-25 8'-0" X 4'-0" 6" Radii ¾" Border TOP: 8" Series D Legend Fluorescent Yellow-Green Background Black Legend and Border BOTTOM: 8" and 10" Series D Legend White Background Black Legend and Border		FTP-023-25 2'-0" X 2'-6" 3" Radii ⅝" Border 4" Series D and E Legend White Background Black Legend and Border		FTP-023A-25 8'-0" X 4'-0" 6" Radii ¾" Border 12" Series E and 8" Series D Legend White Background Black Legend and Border
FTP-024-25 3'-0" X 3'-0" 1.5" Radii ¾" Border 3" Series C Legend and 5" Series D Legend White Background Black Legend and Border		FTP-025-25 3'-0" X 3'-0" 1.5" Radii ¾" Border 3" Series C Legend 5" Series D Legend White Background Black Legend and Border		FTP-026-25 2'-6" X 3'-0" 1.875" Radii ¾" Border 3.5" Series C Legend White Background Black Legend and Border		FTP-027-25 2'-0" X 4'-0" 1.5" Radii 0.5" Border 3.5" Series C Legend 3" Series C Legend White Background Black Legend and Border

8/14/2025 1:28:04 PM

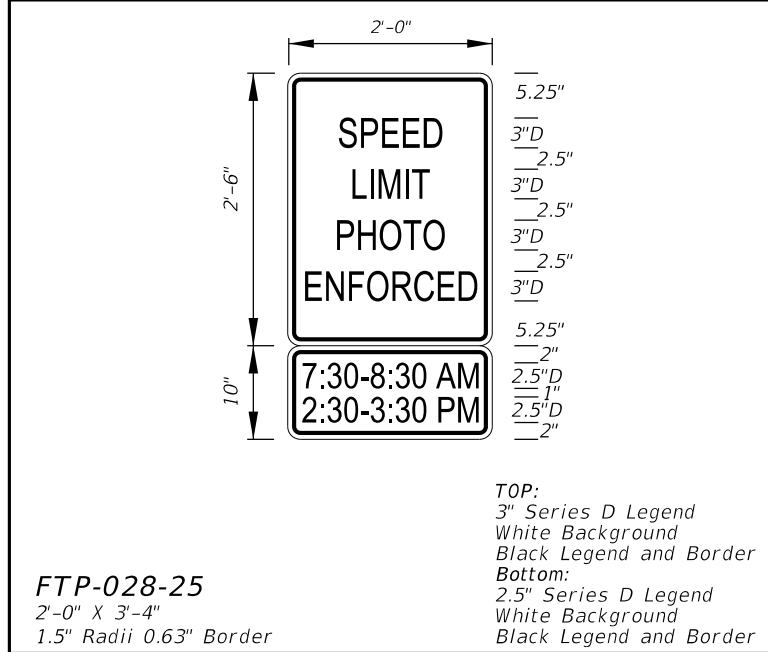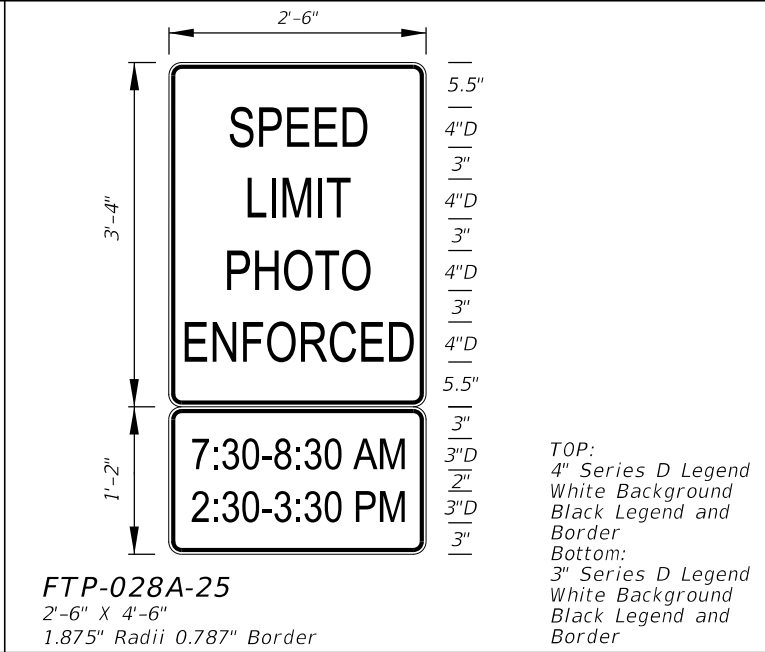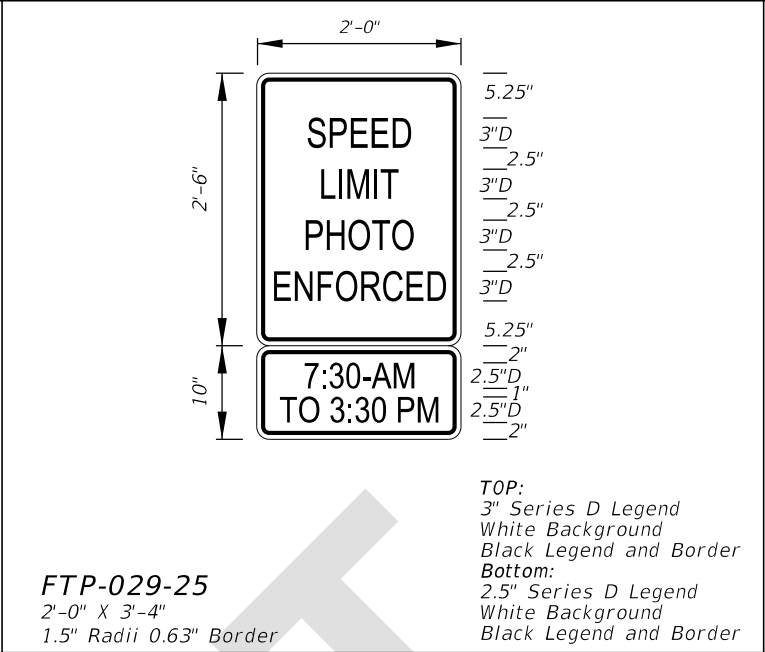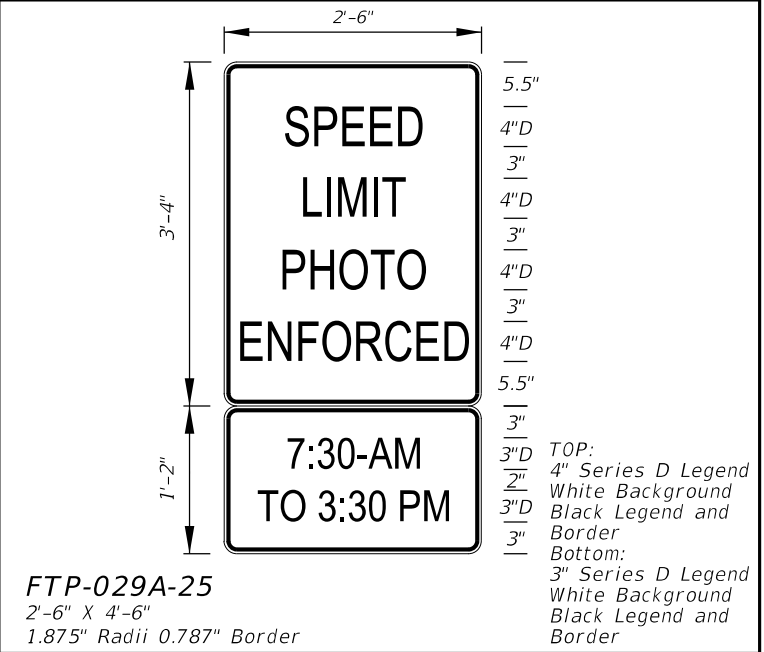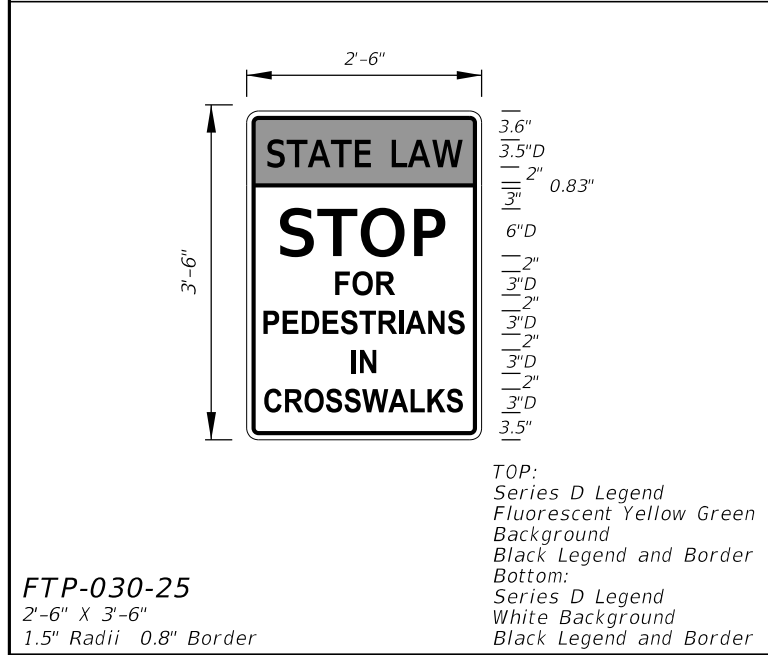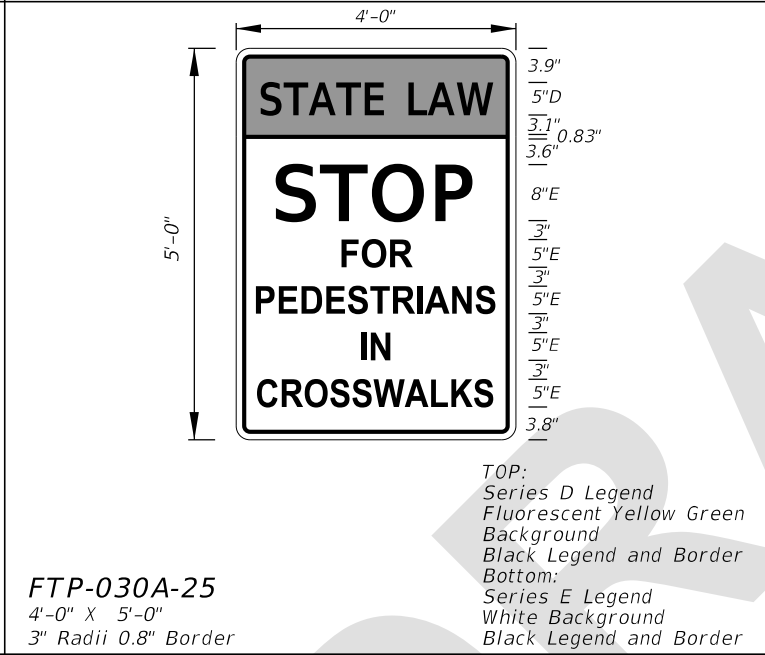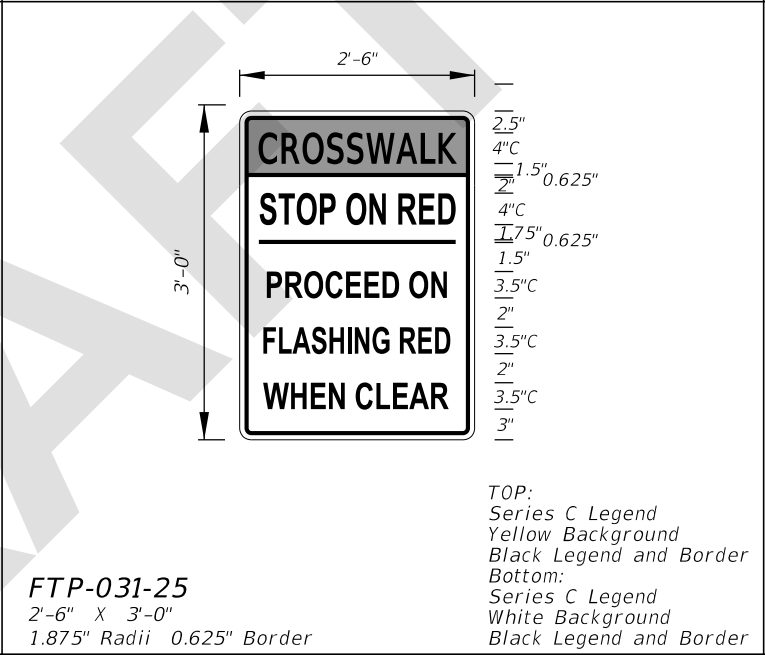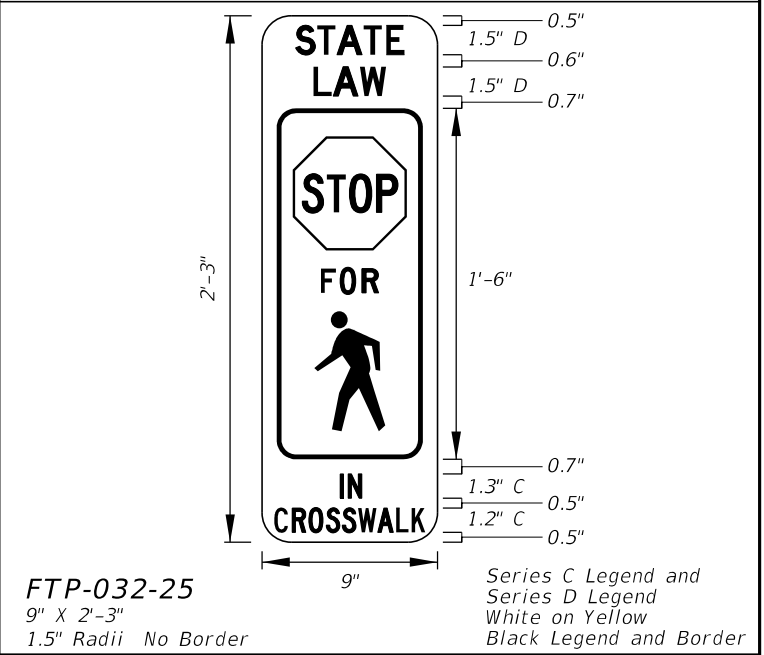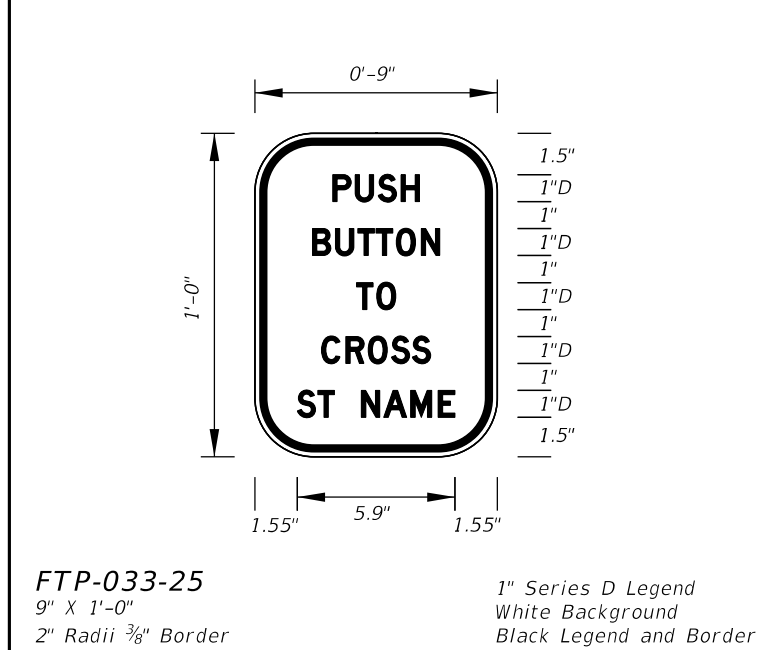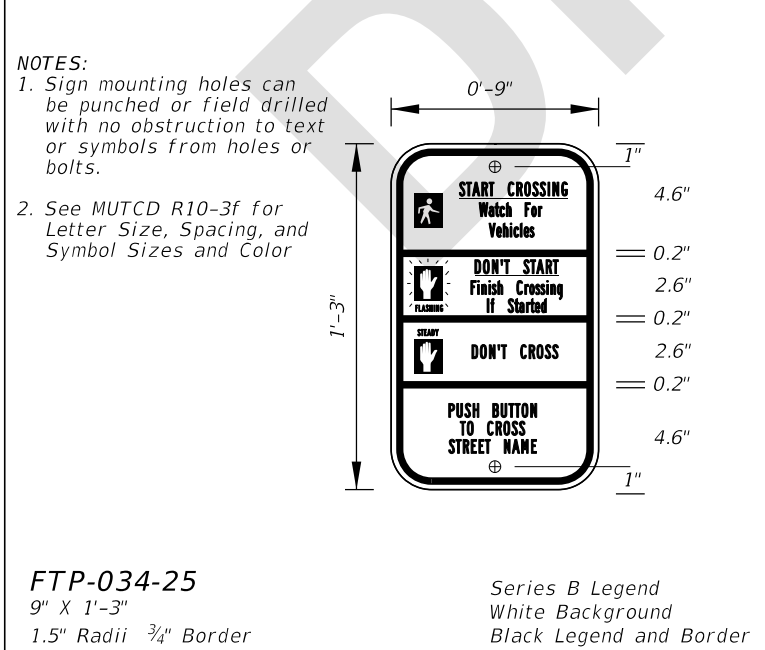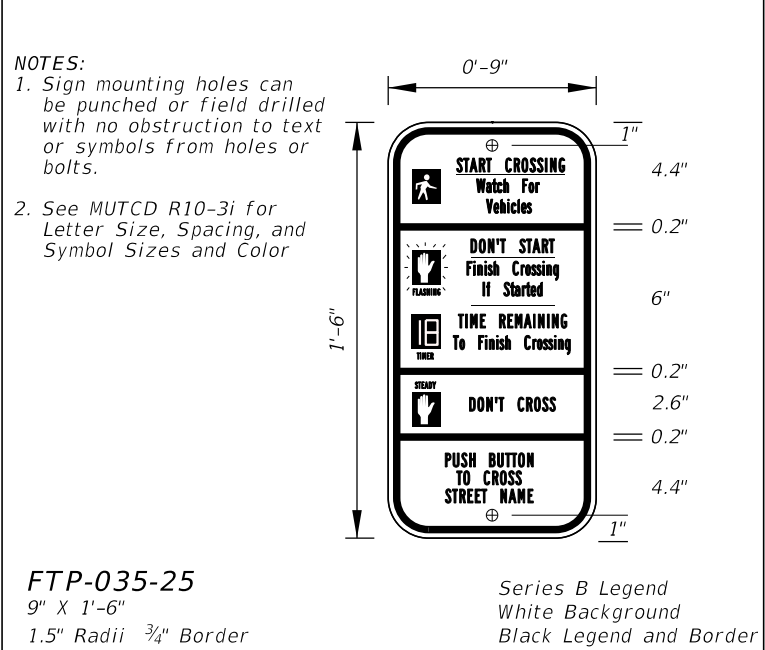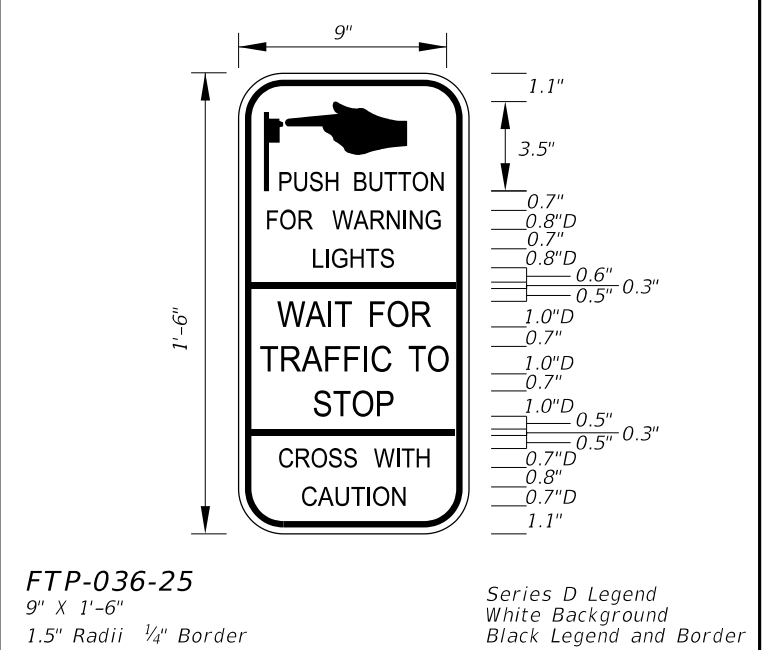
8/14/2025 1:28:10 PM

 FTP-028-25 2'-0" X 3'-4" 1.5" Radii 0.63" Border		 FTP-028A-25 2'-6" X 4'-6" 1.875" Radii 0.787" Border		 FTP-029-25 2'-0" X 3'-4" 1.5" Radii 0.63" Border		 FTP-029A-25 2'-6" X 4'-6" 1.875" Radii 0.787" Border	
 FTP-030-25 2'-6" X 3'-6" 1.5" Radii 0.8" Border		 FTP-030A-25 4'-0" X 5'-0" 3" Radii 0.8" Border		 FTP-031-25 2'-6" X 3'-0" 1.875" Radii 0.625" Border		 FTP-032-25 9" X 2'-3" 1.5" Radii No Border	
 FTP-033-25 9" X 1'-0" 2" Radii 3/8" Border		NOTES: 1. Sign mounting holes can be punched or field drilled with no obstruction to text or symbols from holes or bolts. 2. See MUTCD R10-3f for Letter Size, Spacing, and Symbol Sizes and Color  FTP-034-25 9" X 1'-3" 1.5" Radii 3/4" Border		NOTES: 1. Sign mounting holes can be punched or field drilled with no obstruction to text or symbols from holes or bolts. 2. See MUTCD R10-3i for Letter Size, Spacing, and Symbol Sizes and Color  FTP-035-25 9" X 1'-6" 1.5" Radii 3/4" Border		 FTP-036-25 9" X 1'-6" 1.5" Radii 1/4" Border	

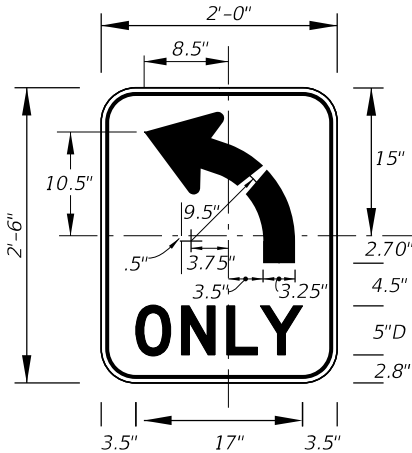


FTP-037L-25
FTP-37R-25
2'-0" X 2'-6"
3" Radii 3/8" Border

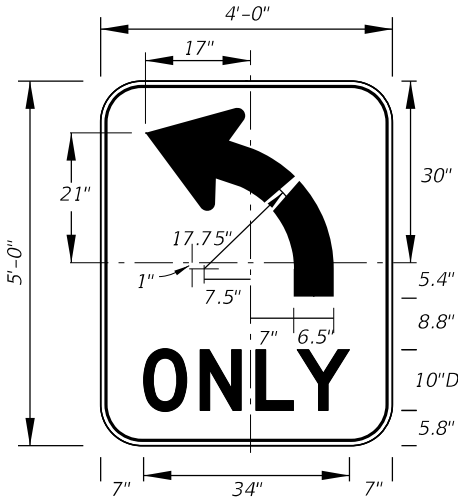5" Series D Legend
White Background
Black Legend and Border




FTP-037AL-25
FTP-037AR-25
4'-0" X 5'-0"
6" Radii 3/4" Border

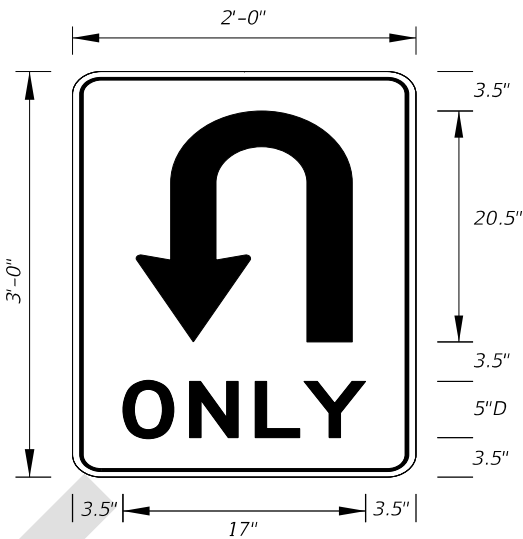10" Series D Legend
White Background
Black Legend and Border




FTP-037U-25
2'-0" X 3'-0"
1.5" Radii
5" Series D Legend
White Background
Black Legend and Border

ARROW HEAD	
A	3.125
B	3.625
C	6.375
D	.5
E	.625

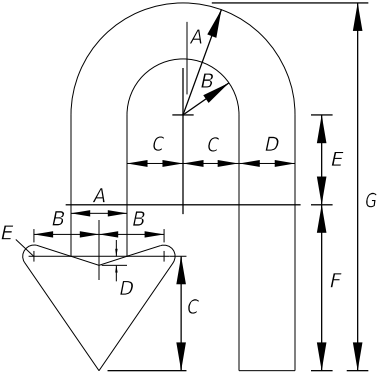


ARROW BODY						
A	B	C	D	E	F	G
6.25	3.125	3.125	3.125	5	9.25	20.5

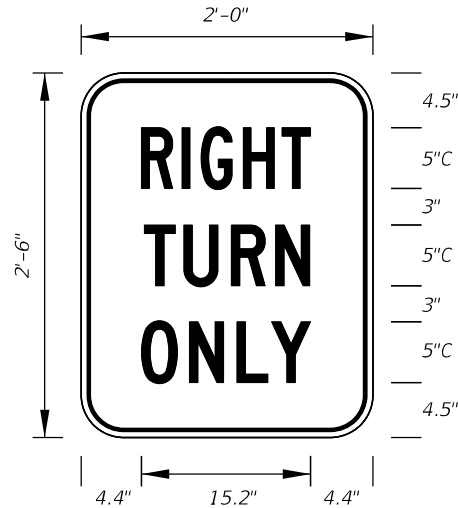DETAILS




FTP-038L-25
2'-0" X 2'-6"
3" Radii 5/8" Border

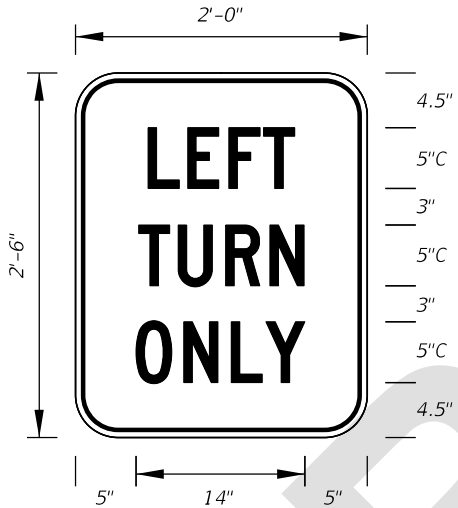5" Series C Legend
White Background
Black Legend and Border




FTP-038R-25
2'-0" X 2'-6"
3" Radii 5/8" Border

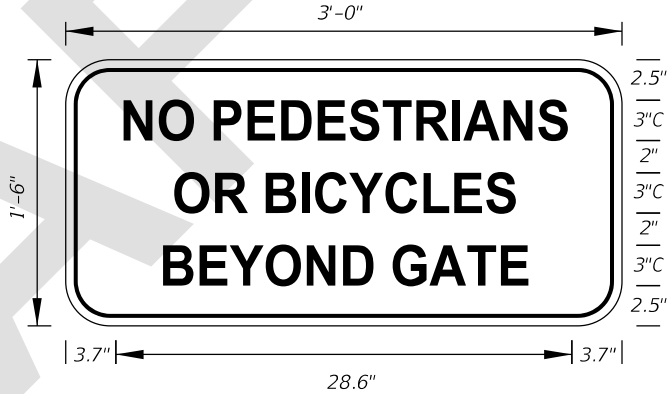5" Series C Legend
White Background
Black Legend and Border



FTP-039-25
3'-0" X 1'-6"
1.5" Radii 0.5" Border








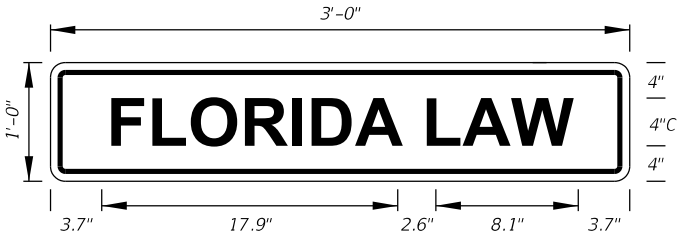
3" Series C Legend and
White Background
Black Legend and Border







FTP-040-25
3'-0" X 1'-0"
1.5" Radii 0.4" Border












4" Series C Legend
Fluorescent Yellow Green
Background
Black Legend and Border

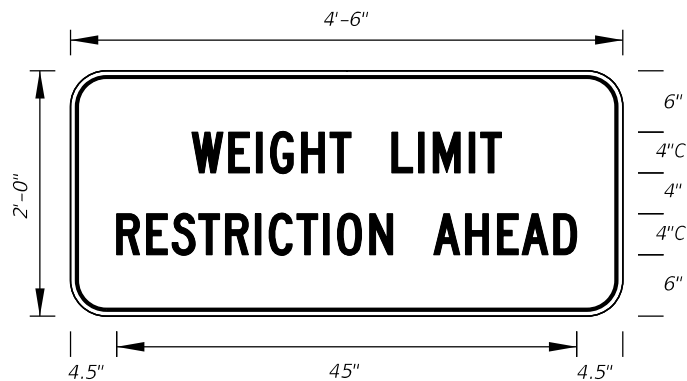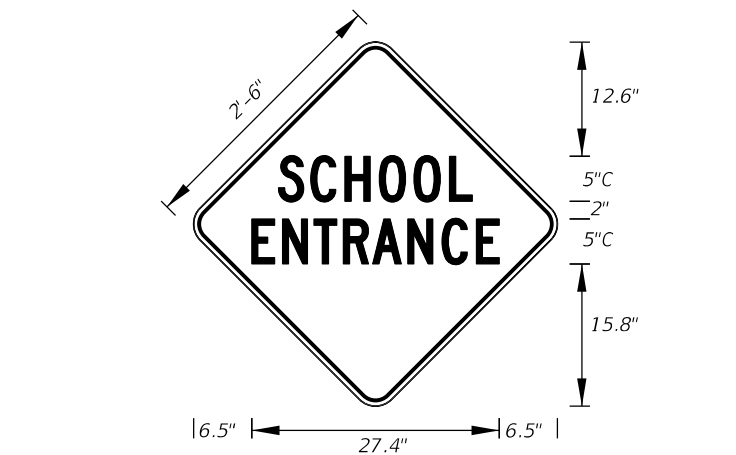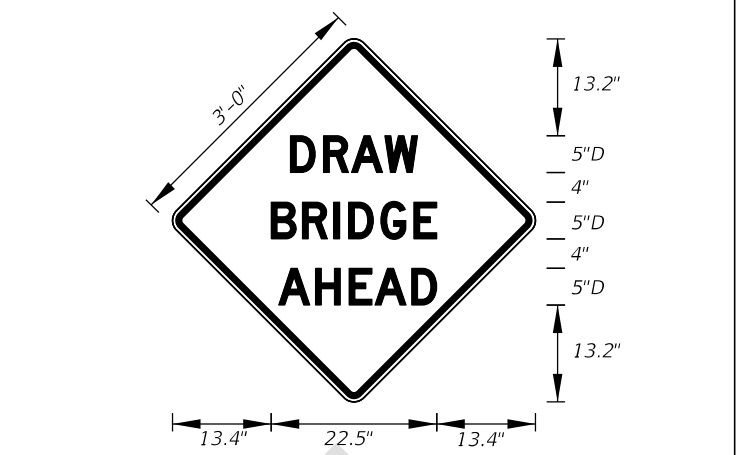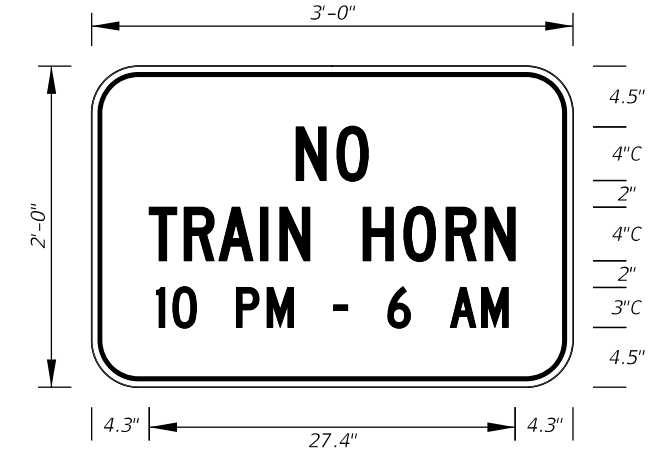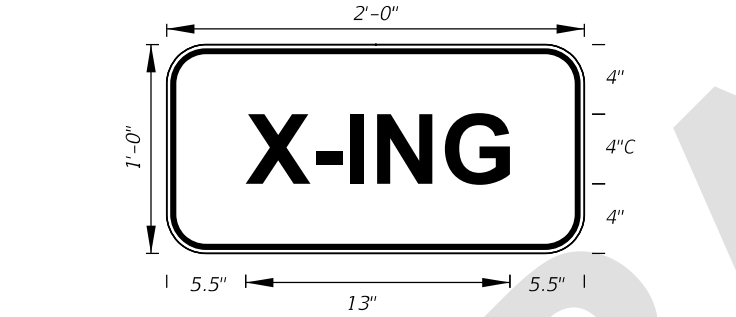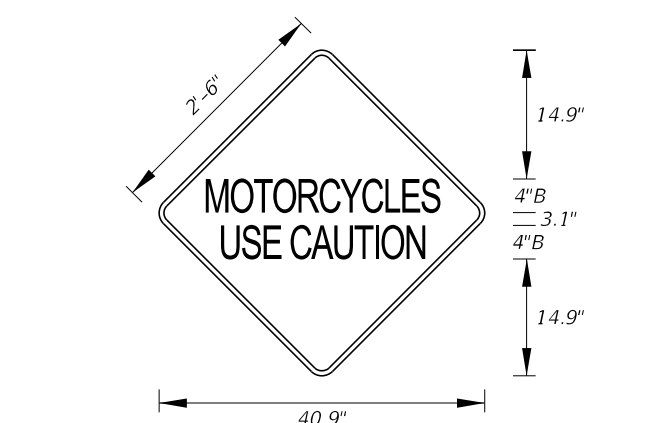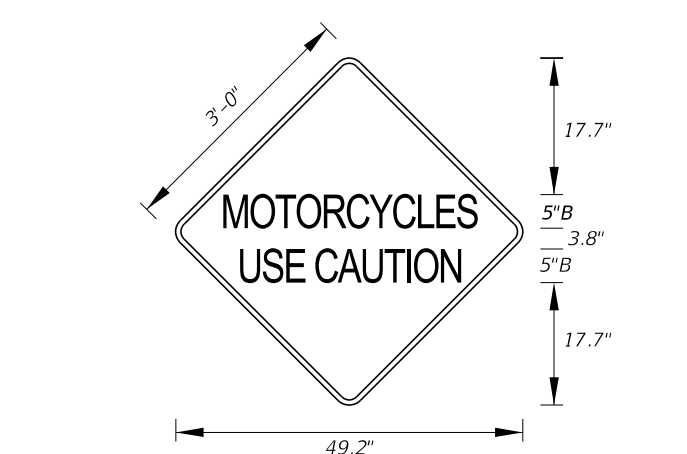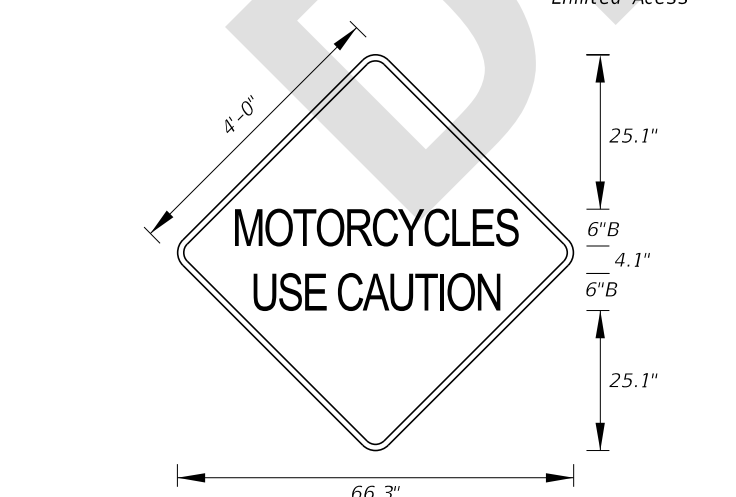8/14/2025 1:28:23 PM

 FTP-200-25 4'-6" X 2'-0" 3" Radii 3/4" Border 4" Series C Legend Yellow Background Black Legend and Border	 FTP-201-25 2'-6" X 2'-6" 2" Radii 3/4" Border 5" Series C Legend Fluorescent Yellow-Green Background Black Legend and Border	 FTP-202-25 3'-0" X 3'-0" 1.5" Radii 5" Series D Legend Yellow Background Black Legend and Border	 FTP-203-25 3'-0" X 2'-0" 3" Radii 3/4" Border 4" and 3" Series C Legend Yellow Background Black Legend and Border
 FTP-203A-25 3'-0" X 3'-0" 2" Radii 3/4" Border 4" and 5" Series C Legend Yellow Background Black Legend and Border	 FTP-204-25 2'-0" X 1'-0" 1.5" Radii 3/4" Border 4" Series C Legend Yellow Background Black Legend and Border	 FTP-205-25 3'-6" X 1'-0" 1.5" Radii 3/4" Border 4" Series C Legend Yellow Background Black Legend and Border	Single-Lane  FTP-206-25 2'-6" X 2'-6" 1.5" Radii 3/4" Border 4" Series B Legend Yellow Background Black Legend and Border
Multi-Lane  FTP-206A-25 3'-0" X 3'-0" 1.5" Radii 3/4" Border 5" Series B Legend Yellow Background Black Legend and Border	Limited Access  FTP-206B-25 4'-0" X 4'-0" 1.5" Radii 3/4" Border 6" Series B Legend Yellow Background Black Legend and Border		

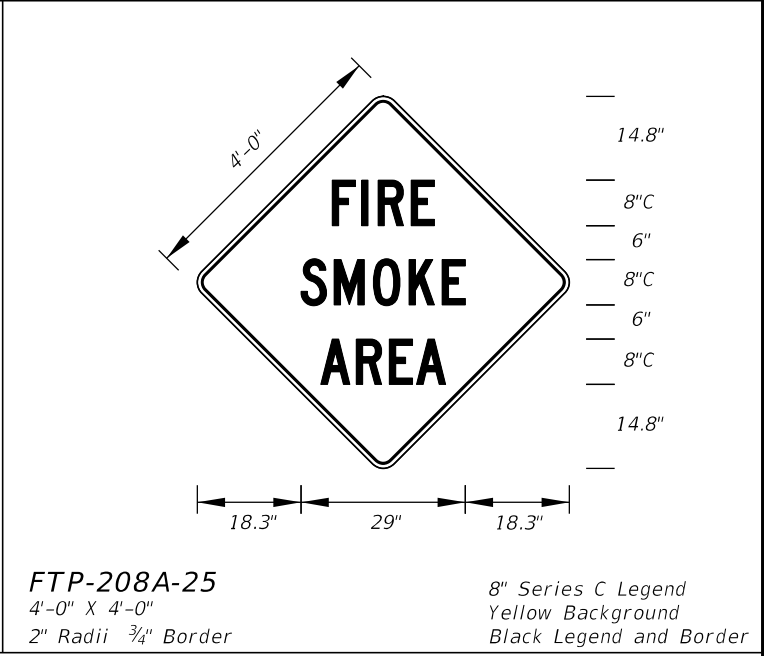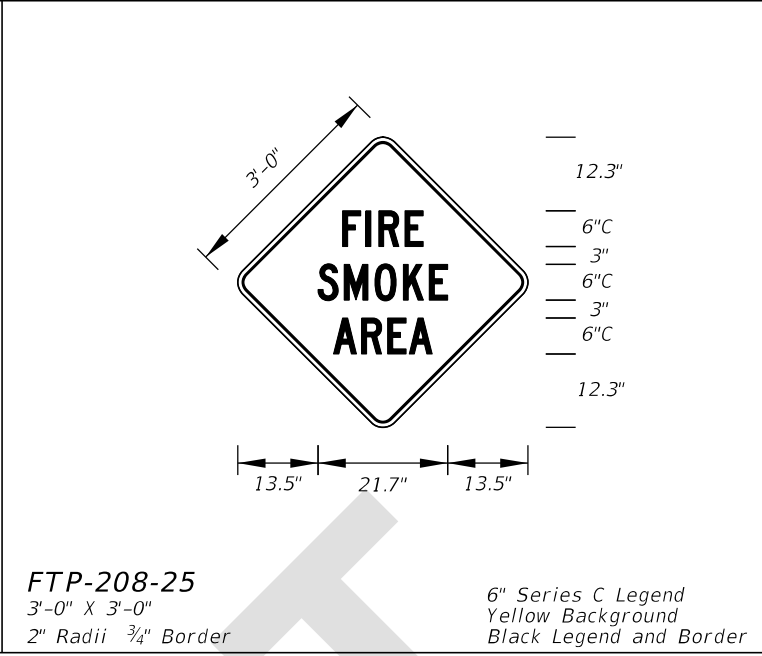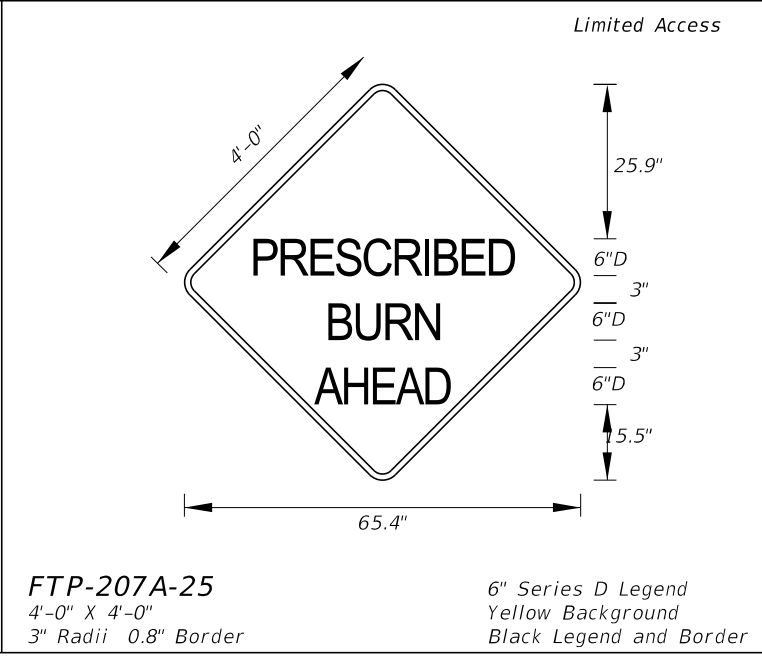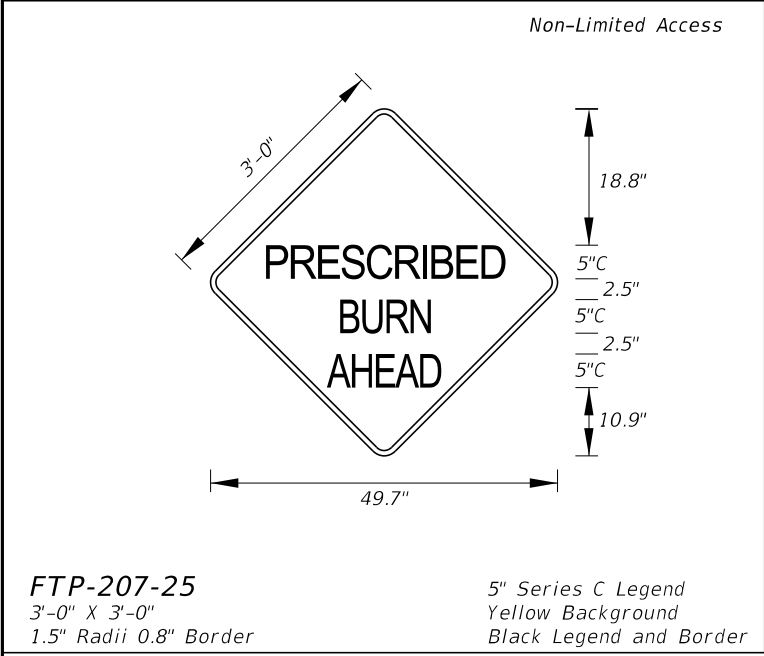

8/14/2025 1:28:35 PM

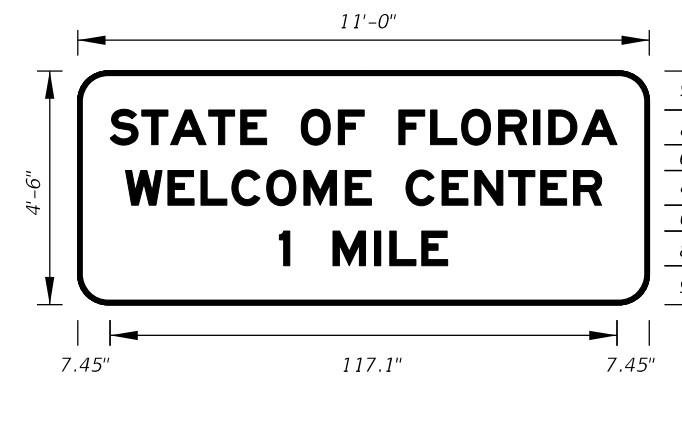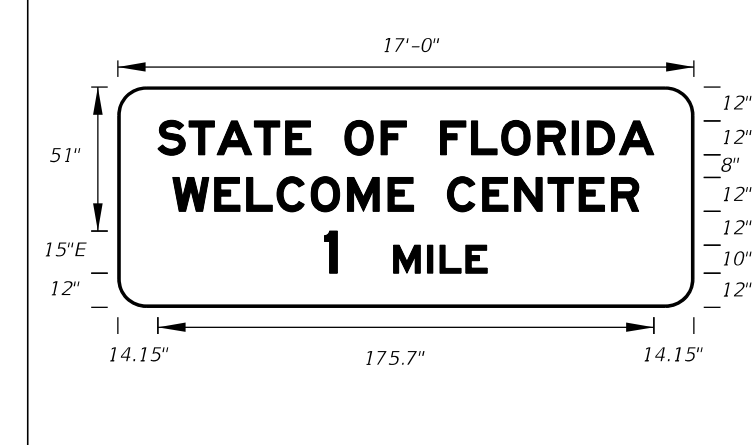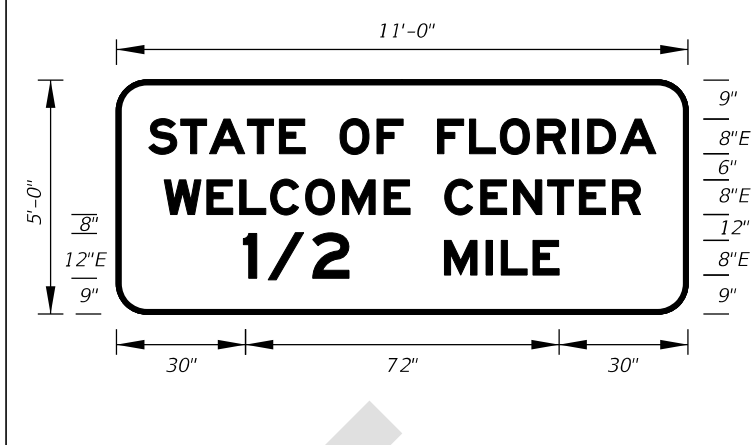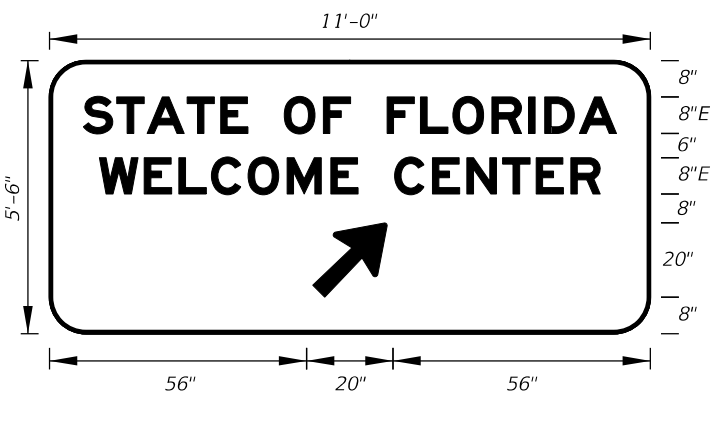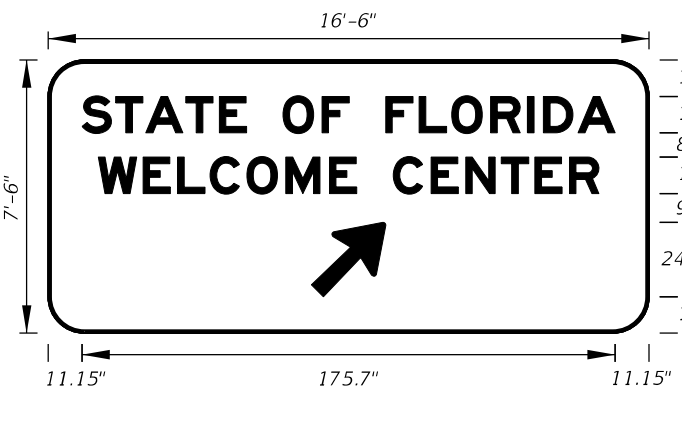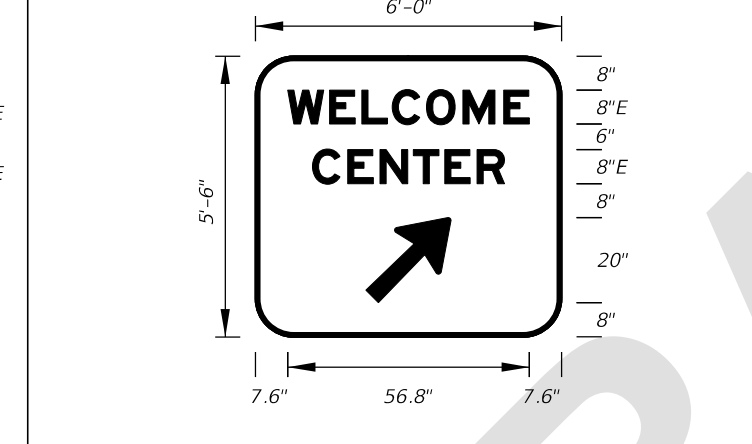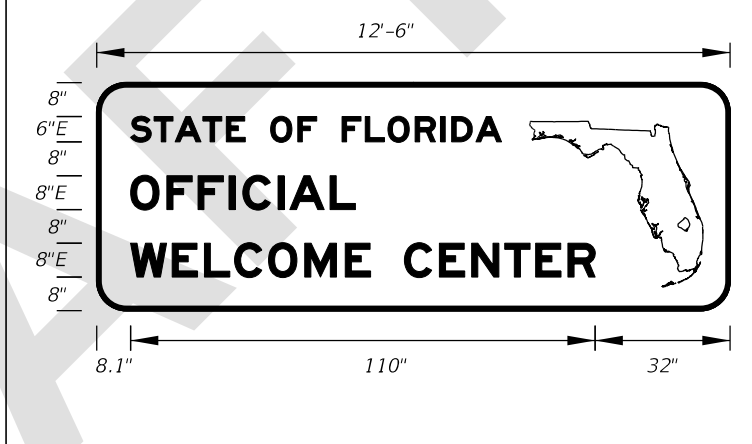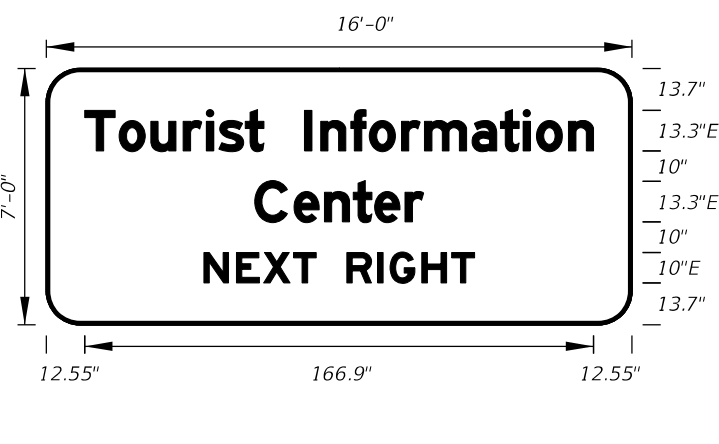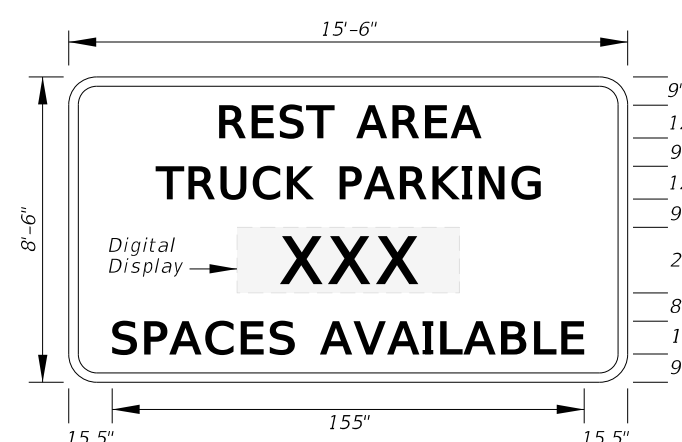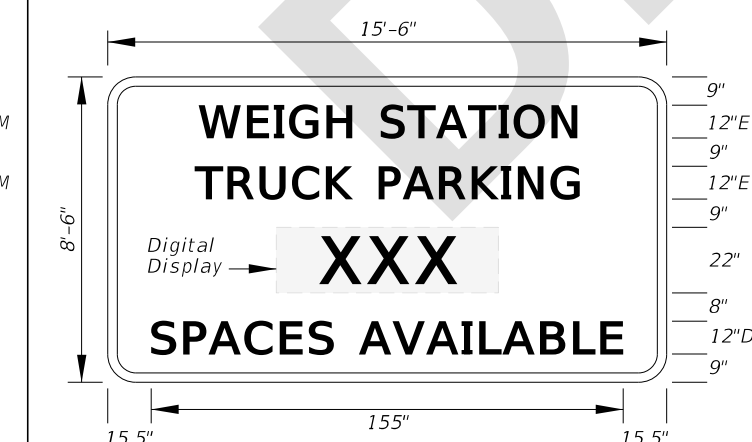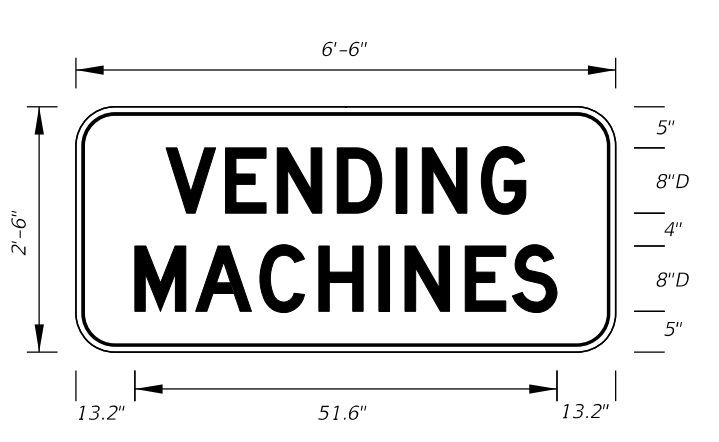 FTP-400-25 11'-0" X 4'-6" 7" Radii 2" Border 8" Series E Legend Blue Background White Legend and Border		 FTP-400A-25 17'-0" X 6'-6" 10" Radii 2" Border 12", 10" and 15" Series E Legend Blue Background White Legend and Border		 FTP-401-25 11'-0" X 5'-0" 8" Radii 2" Border 8" and 12" Series E Legend Blue Background White Legend and Border		 FTP-402-25 11'-0" X 5'-6" 9" Radii 2" Border 8" Series E Legend Blue Background White Legend and Border			
 FTP-402A-25 16'-6" X 7'-6" 12" Radii 2" Border 12" Series E Legend Blue Background White Legend and Border		 FTP-403-25 6' 0" X 5'-6" 9" Radii 2" Border 8" Series E Legend Blue Background White Legend and Border		 FTP-404-25 12'-6" X 4'-6" 7" Radii 2" Border 6" and 8" Series E Legend Blue Background White Legend and Border		 FTP-405-25 16'-0" X 7'-0" 11" Radii 2" Border 13.3 and 10" Series E Legend Blue Background White Legend and Border			
 FTP-406-25 15'-6" X 8'-6" 12" Radii 2" Border Series D Legend Series EM Legend Blue Background White Legend and Border		 FTP-407-25 15'-6" X 8'-6" 12" Radii 2" Border Series D Legend Series EM Legend Blue Background White Legend and Border		 FTP-408-25 16'-6" X 8'-6" 12" Radii 2" Border Series D Legend Series EM Legend Blue Background White Legend and Border		 FTP-409-25 6'-6" X 2'-6" 4" Radii 3/4" Border 8" Series D Legend Blue Background White Legend and Border			
LAST REVISION 11/01/25	REVISION	DESCRIPTION:		FDOT FY 2026-27 STANDARD PLANS		SPECIAL SIGN DETAILS		INDEX 700-102	SHEET 9 of 22

8/14/2025 1:28:42 PM



6'-6"

2'-6"

5"

8"D

6"

6"D

5"

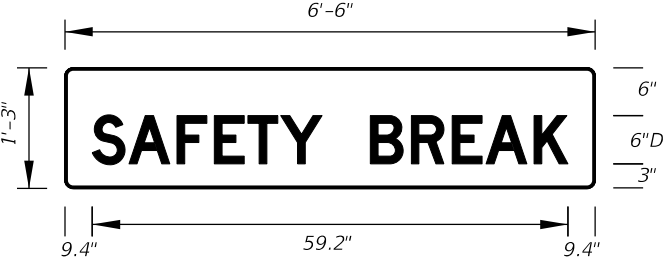
12.65"

52.7"

12.65"

FTP-410-25
6'-6" X 2'-6"
4" Radii ¾" Border

6" Series D Legend
Blue Background
White Legend and Border



6'-6"

1'-3"

9.4"

59.2"

9.4"

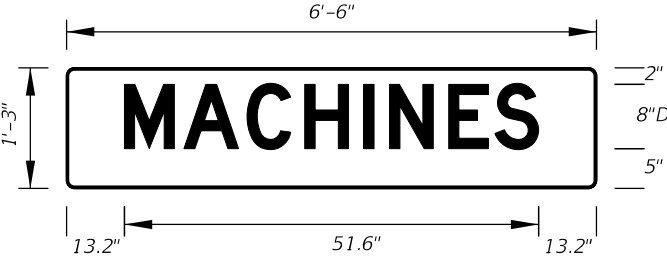
6"

6"D

3"

FTP-411-25
6'-6" X 1'-3"
1" Radii

6" Series D Legend
Blue Background
White Legend



6'-6"

1'-3"

13.2"

51.6"

13.2"

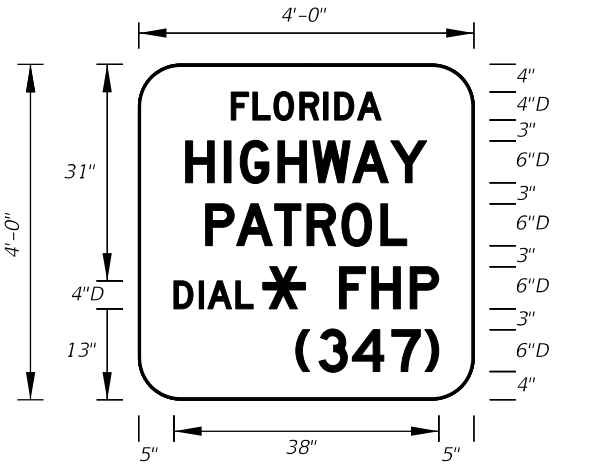
2"

8"D

5"

FTP-412-25
6'-6" X 1'-3"
1" Radii

8" Series D Legend
Blue Background
White Legend



4'-0"

31"

4"D

13"

5"

38"

5"

4"

4"D

3"

6"D

3"

6"D

3"

6"D

3"

6"D

4"

FTP-413-25
4'-0" X 4'-0"
6" Radii 1" Border

4" and 6" Series D Legend
Blue Background
White Legend and Border



4'-0"

5'-0"

6.5"

14"

5"

6"D

5"

6"D

5"

6"D

6.5"

6.6"

34.8"

6.6"

FTP-414-25
4'-0" X 5'-0"
3" Radii 1" Border

6" Series D Legend
Blue Background
White Legend and Border



5'-6"

6'-0"

7"

16"

6"

8"D

6"

8"D

6"

8"D

7"

16.5"

53"

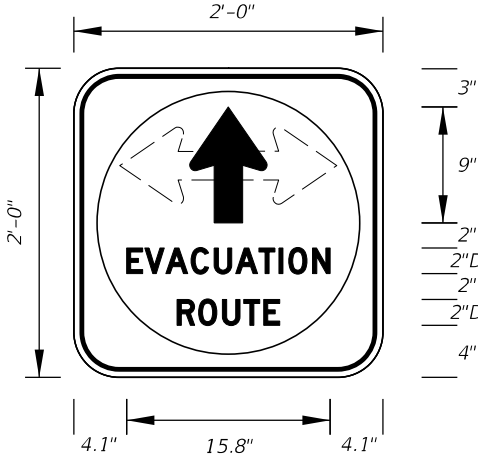
16.5"

FTP-414A-25
5'-6" X 6'-0"
3" Radii 1" Border

8" Series D Legend
Blue Background
White Legend and Border



DETAIL for **FTP-414-25** AND **FTP-414A-25**



2'-0"

2'-0"

4.1"

15.8"

4.1"

3"

9"

2"

2"D

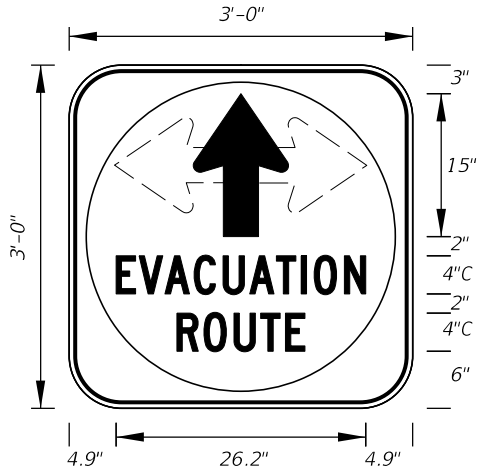
2"

2"D

4"

FTP-415-25
2'-0" X 2'-0"
3" Radii ¾" Border

2" Series D Legend
White Background with Blue Circle
Background
White Legend and Black Border



3'-0"

3'-0"

4.9"

26.2"

4.9"

3"

15"

2"

4"C

2"

4"C

6"

FTP-415A-25
3'-0" X 3'-0"
5" Radii ¾" Border

4" Series C Legend
White Background with Blue Circle
Background
White Legend and Black Border

Non-Limited Access

TRY
CARPOOLING
1-8XX-XXX-XXXX

3'-0"

2'-0"

4.35"27.3"4.35"

3.5"
4"C
3"
4"C
3"
3"C
3.5"

NOTE:
Design Project Manager or Transit Administrator
will supply correct 1-8XX number.

FTP-418-25
3'-0" X 2'-0"
3" Radii

4" and 3" Series C Legend
Blue Background
White Legend and Border

Limited Access

TRY
CARPOOLING
1-8XX-XXX-XXXX

6'-6"

4'-0"

6.75"64.5"6.75"

7"
8"D
6"
8"D
6"
6"D
7"

NOTE:
Design Project Manager or Transit Administrator
will supply correct 1-8XX number.

FTP-418A-25
6'-6" X 4'-0"
6" Radii 2" Border

8" and 6" Series D Legend
Blue Background
White Legend and Border

Non-Limited Access

TRY
VANPOOLING
1-8XX-XXX-XXXX

3'-0"

2'-0"

4.25"27.5"4.25"

3.5"
4"C
3"
4"C
3"
3"C
3.5"

NOTE:
Design Project Manager or Transit Administrator
will supply correct 1-8XX number.

FTP-419-25
3'-0" X 2'-0"
3" Radii

4" and 3" Series C Legend
Blue Background
White Legend and Border

Limited Access

TRY
VANPOOLING
1-8XX-XXX-XXXX

6'-6"

4'-0"

6.45"65.1"6.45"

7"
8"D
6"
8"D
6"
6"D
7"

NOTE:
Design Project Manager or Transit Administrator
will supply correct 1-8XX number.

FTP-419A-25
6'-6" X 4'-0"
6" Radii

8"and 6" Series D Legend
Blue Background
White Legend and Border

Non-Limited Access

TRY
TRANSIT
1-8XX-XXX-XXXX

3'-0"

2'-0"

5.9"24.2"5.9"

3.5"
4"C
3"
4"C
3"
3"C
3.5"

NOTE:
Design Project Manager or Transit Administrator
will supply correct 1-8XX number.

FTP-420-25
3'-0" X 2'-0"
3" Radii

4"and 3" Series C Legend
Blue Background
White Legend and Border

Limited Access

TRY
TRANSIT
1-8XX-XXX-XXXX

6'-6"

4'-0"

10.65"56.7"10.65"

7"
8"D
6"
8"D
6"
6"D
7"

NOTE:
Design Project Manager or Transit Administrator
will supply correct 1-8XX number.

FTP-420A-25
6'-6" X 4'-0"
6" Radii

8" and 6" Series D Legend
Blue Background
White Legend and Border

Non-Limited Access

FLORIDA

SHARE-A-RIDE

X-XXX-XXX-XXXX

3'-0"

2'-6"

3.8"15.6"4"3"D3"

FTP-421-25
3'-0" X 2'-6"
1.5" Radii 0.8" Border

3" Series D Legend
Blue Background
White Legend and Border

Limited Access

FLORIDA

SHARE-A-RIDE

X-XXX-XXX-XXXX

6'-6"

3'-6"

6"23"4"4"D5"

FTP-421A-25
6'-0" X 3'-6"
1.5" Radii 0.8" Border

4" Series D Legend
Blue Background
White Legend and Border

EMERGENCY
INFO
XX.X FM

2'-0"

1'-6"

2.4"19.2"2.4"

2"
3"C
2"
3"C
2"
4"C
2"

FTP-422-25
2'-0" X 1'-6"
1.5" Radii 0.5" Border

3" and 4" Series C Legend
Blue Background
White Legend and Border

EMERGENCY
INFO
XX.X FM

3'-0"

2'-0"

3.6"28.8"3.6"

2.5"
4.5"C
2"
4.5"C
2"
6"
2.5"

FTP-422A-25
3'-0" X 2'-0"
1.5" Radii 0.8" Border

4.5" and 6" Series C Legend
Blue Background
White Legend and Border

EMERGENCY
INFO
XX.X FM

3'-6"

2'-6"

4.85"32.3"4.85"

3.5"
5"C
3"
5"C
3"
7"C
3.5"

FTP-422B-25
3'-6" X 2'-6"
2.25" Radii ¾" Border

5" and 7" Series C Legend
Blue Background
White Legend and Border

LAST REVISION 11/01/25	REVISION	DESCRIPTION:	FDOT FY 2026-27 STANDARD PLANS	SPECIAL SIGN DETAILS		INDEX 700-102	SHEET 12 of 22
------------------------------	----------	--------------	---	----------------------	--	------------------	-------------------

TRAFFIC INFO

TUNE RADIO TO

0000 AM

8'-0"

4'-0"

16.3"

34.4"

11.2"

17.8"

16.3"

6.9"

8"D

5.1"

6"D

3"

10"D

6.9"

FTP-423-25

8'-0" X 4'-0"

6" Radii 1.6" Border

6", 8" and 10" Series D Legend

Blue Background

White Legend and Border

TRAFFIC INFO

TUNE RADIO TO

0000 AM

10'-0"

5'-0"

21.9"

41.3"

13.5"

21.4"

21.9"

8.7"

10"D

6.7"

7"D

6.8"

12"D

8.7"

FTP-423A-25

10'-0" X 5'-0"

8" Radii 2" Border

7", 10" and 12" Series D Legend

Blue Background

White Legend and Border

8/14/20251:29:03 PM

LAST REVISION

11/01/25

REVISION

DESCRIPTION:

FDOT

FY 2026-27
STANDARD PLANS

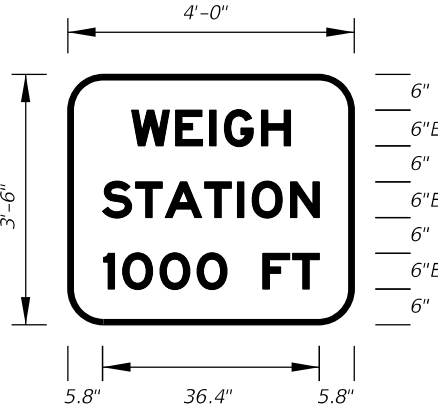
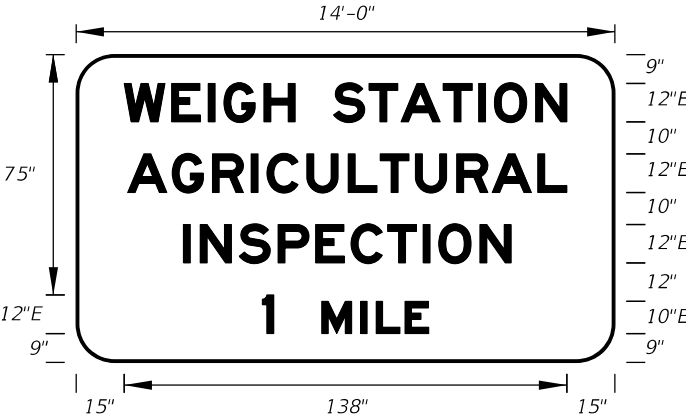
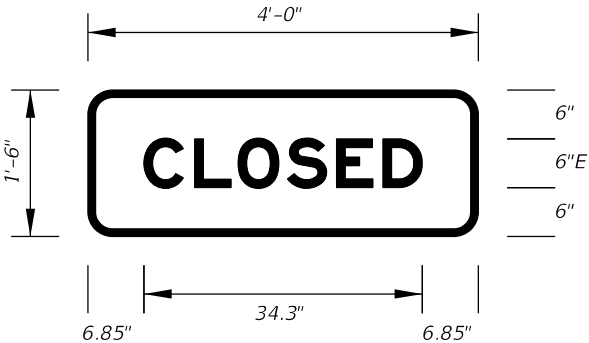
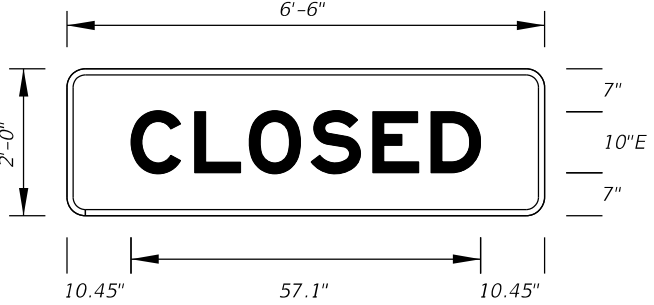
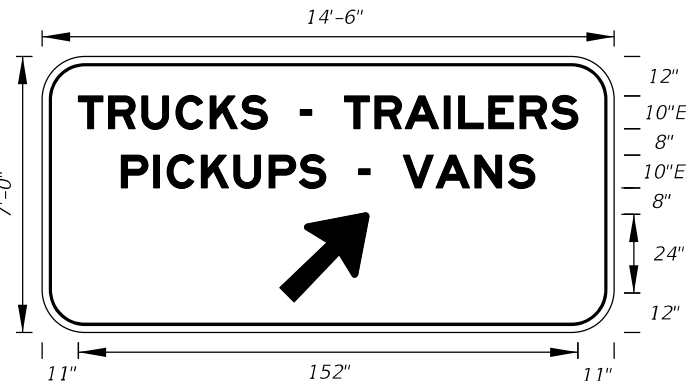
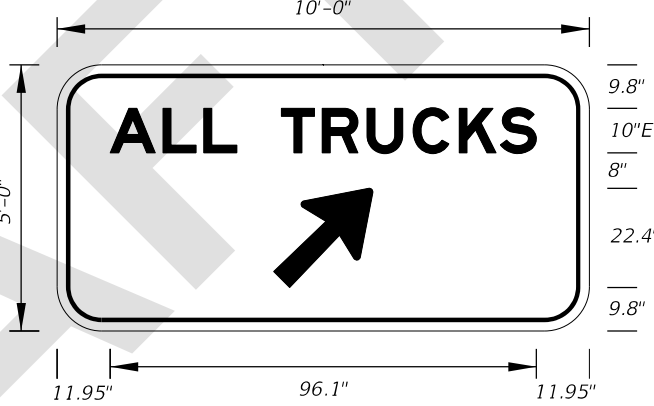
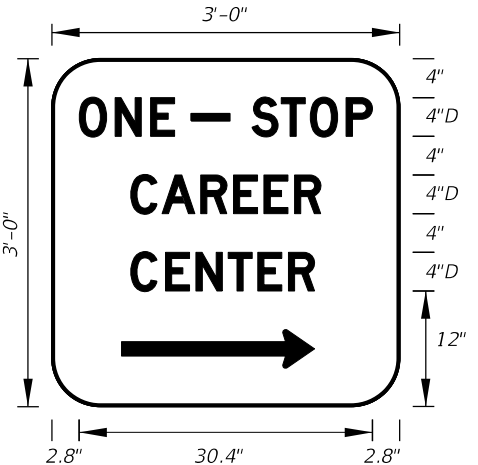
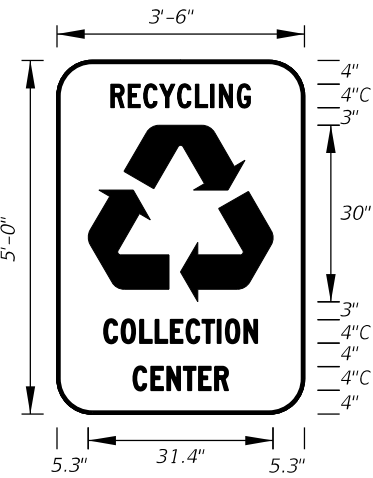
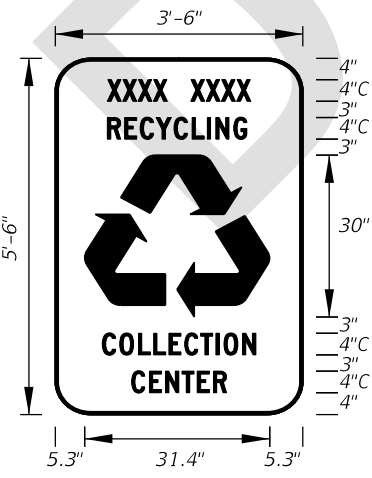
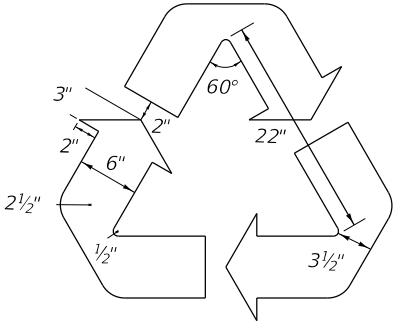
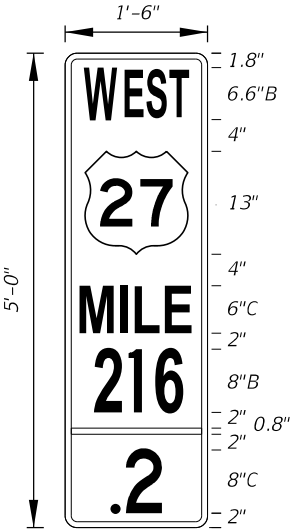
SPECIAL SIGN DETAILS

INDEX

700-102

SHEET

13 of 22

Other Than Freeway Use  FTP-600-25 4'-0" X 3'-6" 6" Radii 2" Border 6" Series E Legend Green Background White Legend and Border	Other Than Freeway Use  FTP-601-25 14'-0" X 8'-0" 12" Radii 2" Border 12" and 10" Series E Legend Green Background White Legend and Border	Other Than Freeway Use  FTP-602-25 4'-0" X 1'-6" 3" Radii 2" Border 6" Series E Legend Green Background White Legend and Border NOTE: FTP-602-25 to be used with FTP-600-25	Freeway Use  FTP-602A-25 6'-6" X 2'-0" 3" Radii 2" Border 10" Series E Legend Green Background White Legend and Border NOTE: FTP-620A-25 to be used with FTP-604R-25
 FTP-603R-25 FTP-603L-25 14'-6" X 7'-0" 11" Radii 2" Border 10" Series E Legend Green Background White Legend and Border	 FTP-604R-25 FTP-604L-25 12'-0" X 7'-0" 11" Radii 2" Border 10" Series E Legend Green Background White Legend and Border NOTE: Use FTP-604L-25 for "NEXT LEFT".	 FTP-605R-25 10'-0" X 5'-0" 8" Radii 10" Series E Legend Green Background White Legend NOTE: Use FTP-605L-25 for LEFT ARROW.	 FTP-606-25 3'-0" X 3'-0" 5" Radii 4" Series D Legend Green Background White Legend and Border
 FTP-607-25 3'-6" X 5'-0" 6" Radii 4" Series C Legend Green Background White Legend, Border and Symbol	 FTP-608-25 3'-6" X 5'-6" 6" Radii 4" Series C Legend Green Background Municipality Name Optional White Legend, Border and Symbol	 Detail for FTP-607-25 and FTP-608-25	 FTP-609-25 1'-6" X 5'-0" 1.5" Radii 0.8" Border 6" Series B, 6" series C 8" Series B, and 8" Series C Green Background White Legend and Border

FTP-610-25
2'-6" X 3'-0"
1.5" Radii 3/4" Border

5" Series B Legend
Green Background
White Legend, Border,
and Florida Symbol

FTP-610A-25
3'-0" X 4'-0"
1.5" Radii 3/4" Border

7" Series B Legned
Green Background
White Legend, Border,
and Florida Symbol

FTP-610B-25
4'-0" X 5'-0"
3" Radii 1 1/4" Border

8" Series B Legend
Green Background
White Legend, Border,
and Florida Symbol

FTP-611-25
2'-0" X 2'-6"
3" Radii 3/4" Border

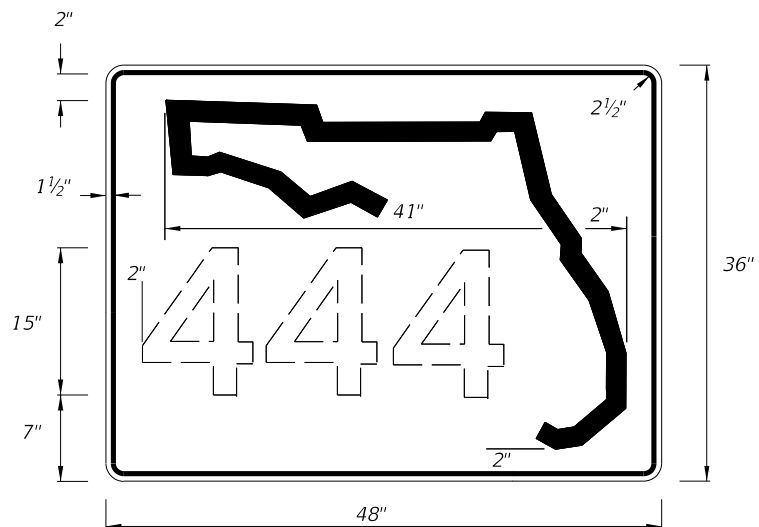
TOP:
4" Series D Legend
Yellow Background
Black Legend and Border
BOTTOM:
6" Series D Legend
White Background
Black Legend and Border

FTP-611A-25
3'-0" X 4'-0"
5" Radii 3/4" Border

TOP:
6" Series D Legend
Yellow Background
Black Legend and Border
BOTTOM:
10" Series D Legend
White Background
Black Legend and Border

FTP-611B-25
4'-0" X 5'-0"
6" Radii 3/4" Border

TOP:
6" Series D Legend
Yellow Background
Black Legend and Border
BOTTOM:
12" Series D Legend
White Background
Black Legend and Border




DIGITS	NUMERAL SIZE	SERIES LEGEND	PANEL SIZE
1-3	15"	C	48" x 36"
4	12"	C	48" x 36"


NOTES:

- Stroke width of State Outline shall be 1".
- 2 1/2" Radii

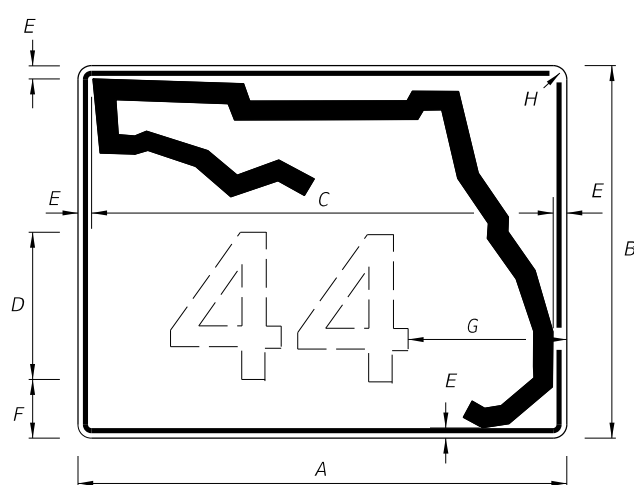INDEPENDENT USE FOR FREEWAY



1 OR 2 DIGITS

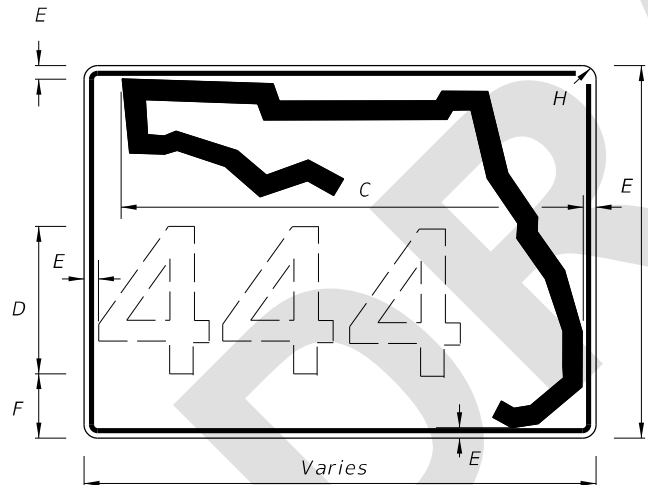

3 OR MORE DIGITS


NOTES:

- Florida marker shall have Black Legend with White Background.
- Stroke width of State outline shall be 3/4" for Guide Sign.
- Series D Legend.
- 5/8" Border

A	B	C	D	E	F	G	H
30"	24"	26"	12"	1 1/4"	2 3/4"	8 1/4"	1 1/4"
36"	30"	32"	15"	1 1/4"	3 1/4"	8 3/4"	1 1/4"
42"	36"	38"	15"	1 1/4"	6 1/4"	11"	1 1/4"


GUIDE SIGN USE

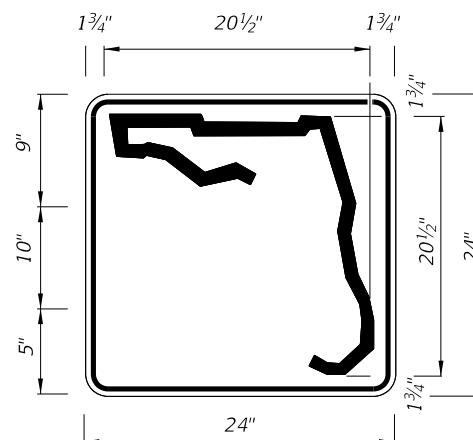FTP-612-25 - FLORIDA ROUTE MARKER



1 or 2 DIGITS

DIGITS	NUMERAL SIZE	SERIES LEGEND	PANEL SIZE
1-2	10"	D	24" x 24"

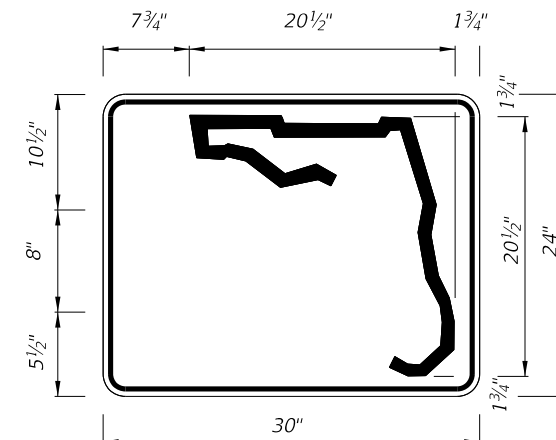

3 or 4 DIGITS

DIGITS	NUMERAL SIZE	SERIES LEGEND	PANEL SIZE
3	8"	D	30" x 24"
4	8"	C	30" x 24"

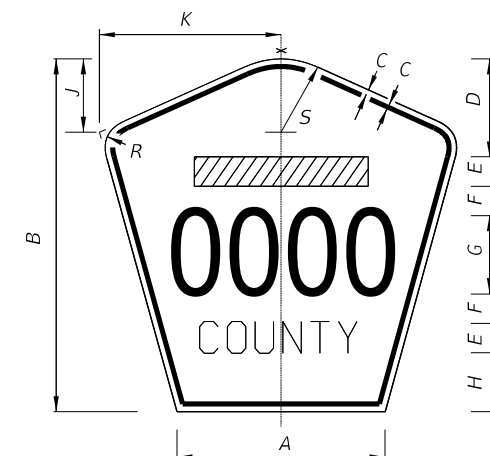
NOTES:

- Stroke width of State Outline shall be 1".
- The 24" X 24" panel shall only be used for a 3 digit route when the panel is to be used on a sign cluster with other 24" X 24" panels.
- 1 1/2" Radii

INDEPENDENT USE OTHER THAN FREEWAY






NOTES:

- Series D Legend.
- Color: Yellow Legend and Border on Blue Background.
- When used on a guide sign, marker must be overlaid on a rectangular Yellow Background as shown in chart.
- When two or more County Route Markers are mounted together, use the dimensions of the largest marker for all other markers.






















SIGN	DIMENSIONS												Rectangular Yellow Background Dimensions (See Note 3)
	A	B	C	D	E	F	G	H	J	K	R	S	
4 DIGIT POST MOUNTED	25 1/8"	42"	3/4"	10"	4"	4"	8"	8"	8 3/8"	22"	5"	8 3/4"	
2 DIGIT OVERHEAD	21 1/2"	36"	1/2"	7 1/2"	3"	3"	12"	4 1/2"	7 1/8"	18 7/8"	4 1/4"	7 1/2"	42"x 42"
3 DIGIT OVERHEAD	25 1/8"	42"	3/4"	8"	4"	4"	12"	6"	8 3/8"	22"	5"	8 3/4"	48"x 48"
4 DIGIT OVERHEAD	29 7/8"	48"	3/4"	8"	5"	5"	12"	8"	9 3/4"	25 5/8"	5 3/4"	10 1/4"	52"x 52"

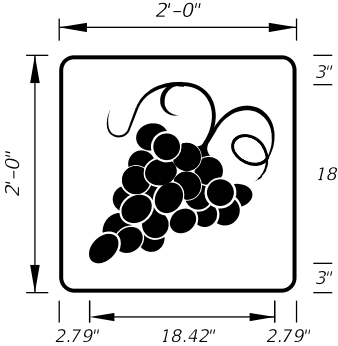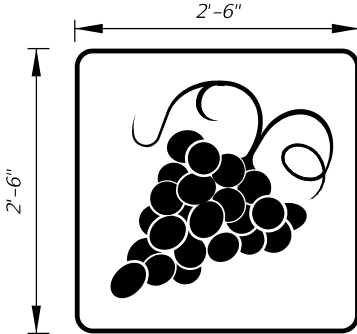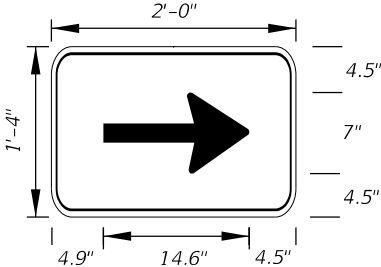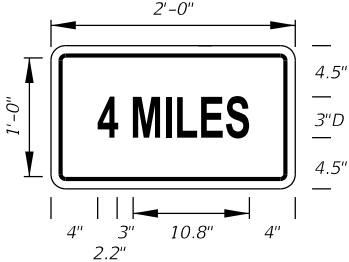
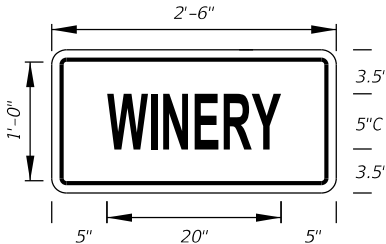
FTP-613-25 - COUNTY ROUTE MARKER (M1-6)

Non-Limited Access  FTP-619-25 2'-0" X 2'-0" 1.5" Radii 0.5" Border Green Background White Legend, Border and Symbol		Limited Access  NOTE: FTP-619A-25 to be used with FTP-622-25 FTP-619A-25 2'-6" X 2'-6" 1.5" Radii 0.5" Border Green Background White Legend, Border and Symbol		Non-Limited Access  NOTE: FTP-620-25 to be used with FTP-619-25 FTP-620-25 2'-0" X 1'-4" 1.5" Radii 0.5" Border Green Background White Legend, Border and Symbol		Non-Limited Access  NOTE: FTP-621-25 to be used with FTP-619-25 FTP-621-25 2'-6" X 1'-0" 1.5" Radii 0.5" Border 3" Series D Legned Green Background White Legend, Border and Symbol			
Limited Access  NOTE: FTP-622-25 to be used with FTP-619A-25 FTP-622-25 2'-6" X 1'-0" 1.5" Radii 0.5" Border 5" Series C Legend Green Background White Legend, Border and Symbol		DRAFT							
LAST REVISION 11/01/25		DESCRIPTION:		FDOT FY 2026-27 STANDARD PLANS		SPECIAL SIGN DETAILS		INDEX 700-102	SHEET 18 of 22

Non-Limited Access FTP-800-25 2'-0" X 2'-0" 1.5" Radii 0.75" Border 2" Series C Legend Brown Background Brown and White Symbol White Legend and Border		Limited Access FTP-801-25 2'-0" X 2'-0" 1.2" Radii 0.4" Border 4" Series C Legend Brown Background White Symbol White Legend and Border		Limited Access FTP-801A-25 2'-6" X 2'-6" 1.5" Radii 0.5" Border 5" Series C Legend Brown Background White Symbol White Legend and Border		FTP-802-25 4'-6" X 2'-0" 1.5" Radii 0.5" Border 5" Series B Legend 2" Series C Legend Brown Background Yellow Legend and Border	
FTP-803-25 4'-0" X 2'-6" 3" Radii 4" Series C Legend and 2" Series EM Legend White Background Blue Legend and Border		FTP-804-25 2'-0" X 1'-4" NOTE: To be installed with Co-location of route Confirmation Marker		FTP-804A-25 3'-0" X 2'-0" NOTE: Install at the Florida Scenic Highway Entrance Points			
LAST REVISION 11/01/25 REVISION DESCRIPTION:		FDOT FY 2026-27 STANDARD PLANS		SPECIAL SIGN DETAILS		INDEX 700-102	SHEET 19 of 22

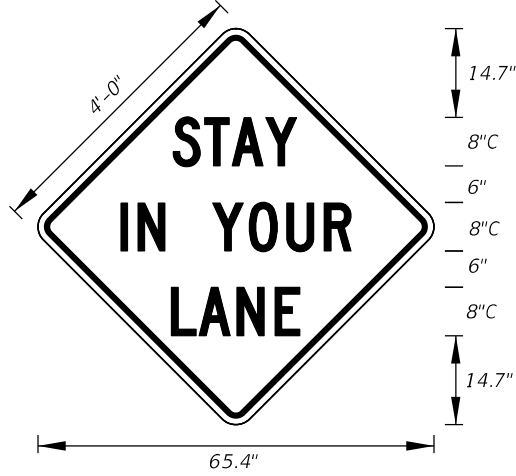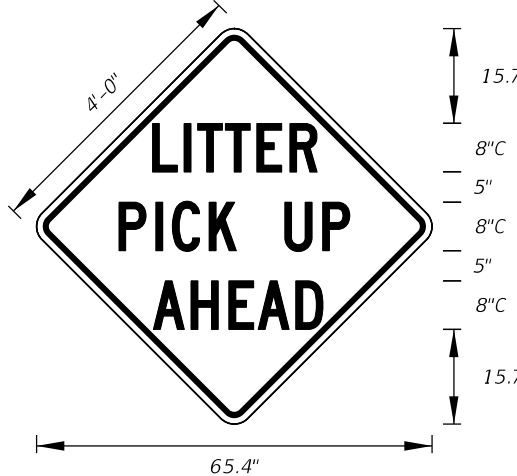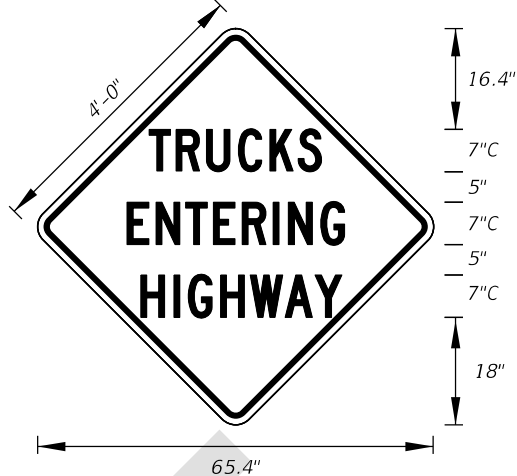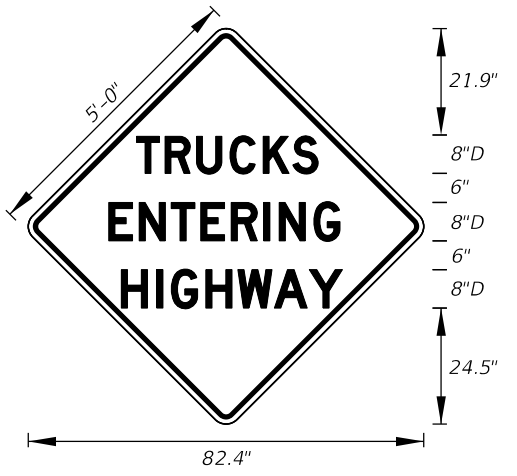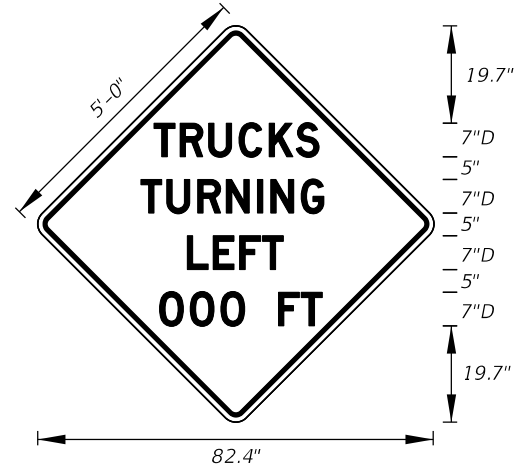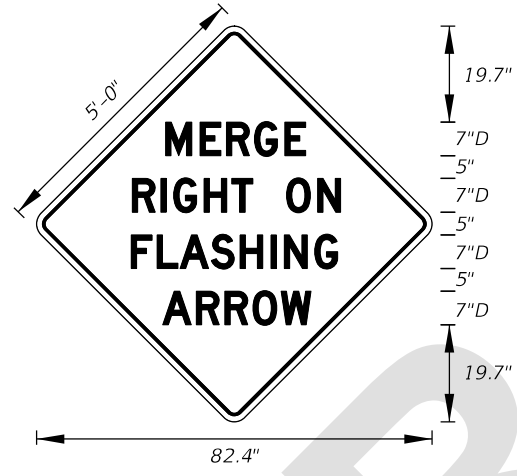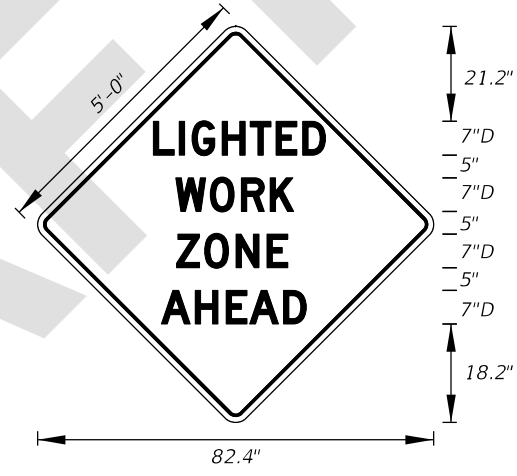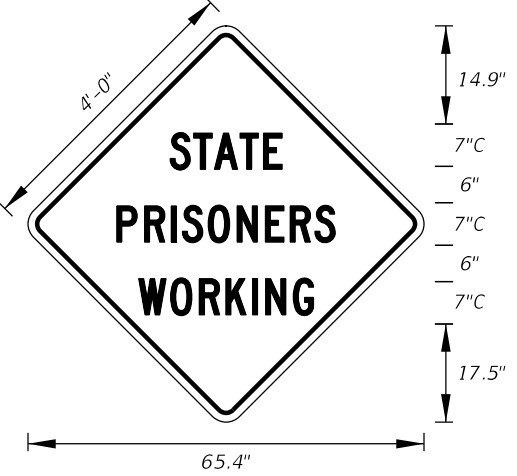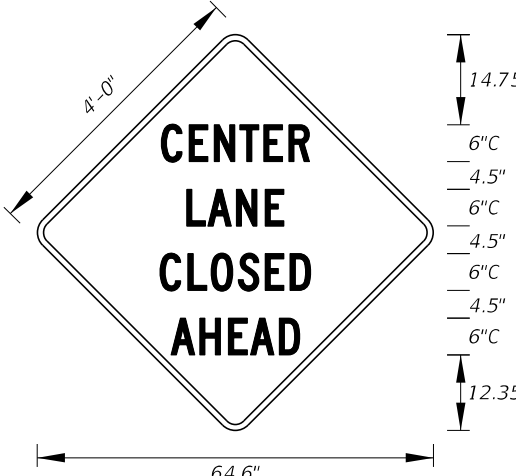
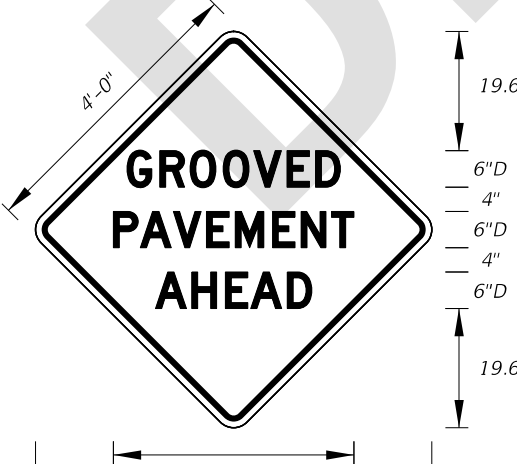
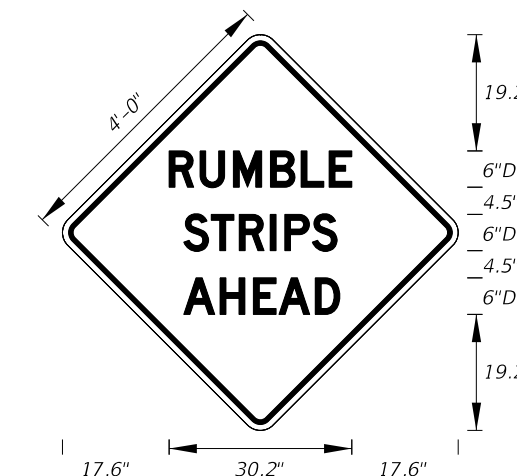
 TTC-001-25 4'-0" X 4'-0" 3" Radii ¾" Border 8" Series C Legend Orange Background Black Legend and Border	 TTC-002-25 4'-0" X 4'-0" 3" Radii ¾" Border 8" Series C Legend Orange Background Black Legend and Border	 TTC-003-25 4'-0" X 4'-0" 3" Radii ¾" Border 7" Series C Legend Orange Background Black Legend and Border	 TTC-003A-25 5'-0" X 5'-0" 3" Radii ¾" Border 8" Series D Legend Orange Background Black Legend and Border
 TTC-004-25 5'-0" X 5'-0" 3" Radii ¾" Border 7" Series D Legend Orange Background Black Legend and Border	 TTC-005-25 5'-0" X 5'-0" 3" Radii ¾" Border 7" Series D Legend Orange Background Black Legend and Border	 TTC-006-25 5'-0" X 5'-0" 3" Radii ¾" Border 7" Series D Legend Orange Background Black Legend and Border	 TTC-007-25 4'-0" X 4'-0" 3" Radii ¾" Border 7" Series C Legend Orange Background Black Legend and Border
 TTC-008-25 4'-0" X 4'-0" 3" Radii ¾" Border 6" Series C Legend Orange Background Black Legend and Border	 TTC-009-25 4'-0" X 4'-0" 2" Radii ¾" Border 6" Series D Legend Orange Background Black Legend and Border	 TTC-010-25 4'-0" X 4'-0" 2" Radii ¾" Border 6" Series D Legend Orange Background Black Legend and Border	

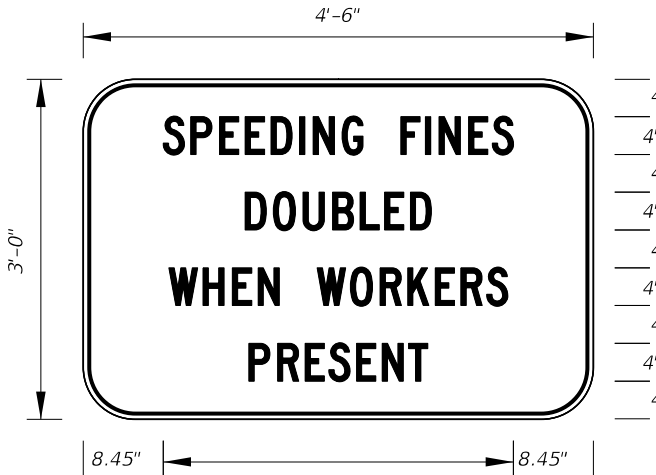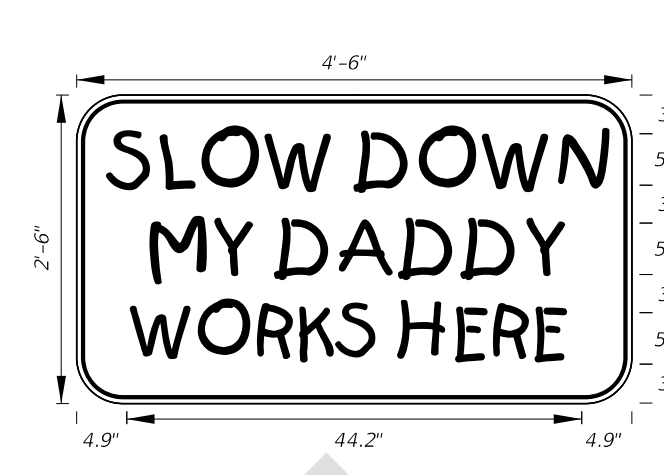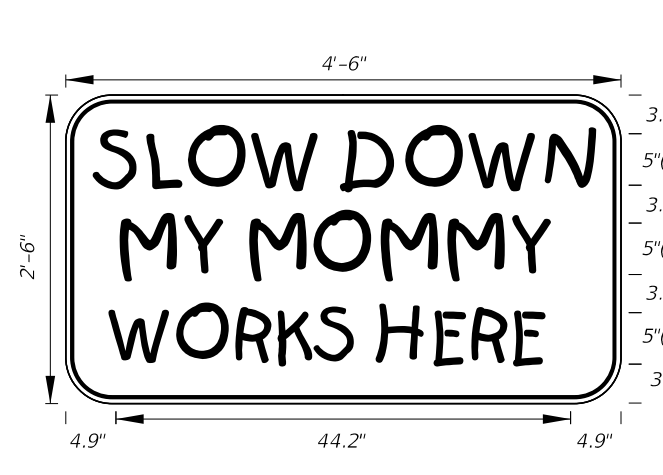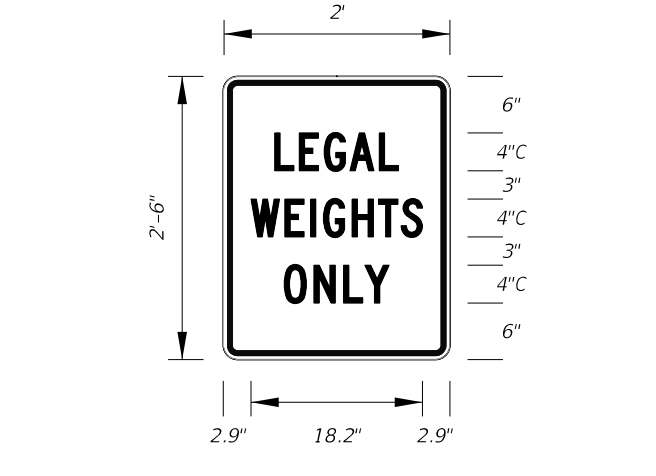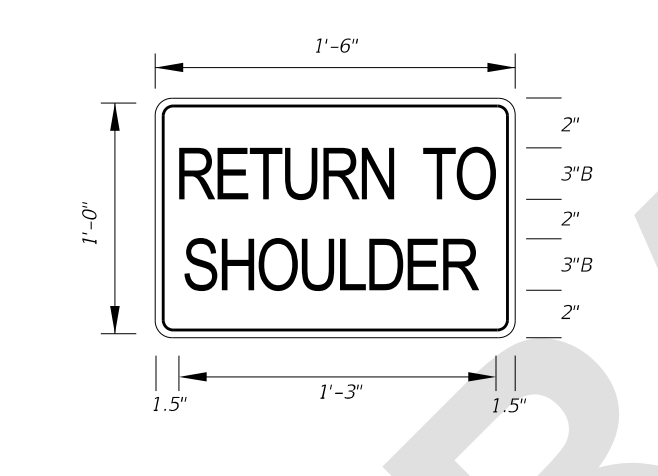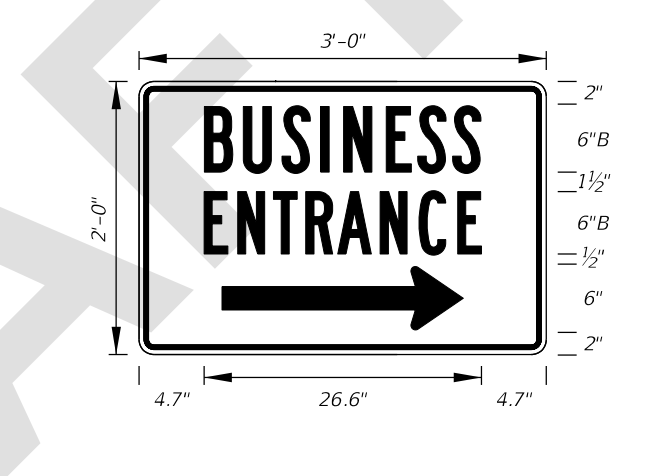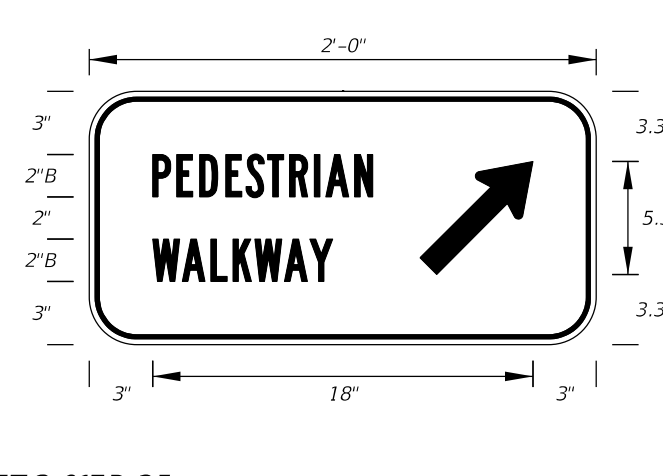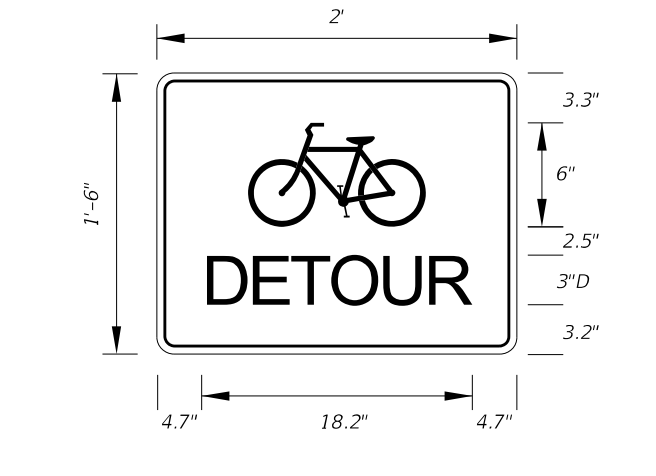 TTC-011-25 Arterial Sign 4'-6" X 3'-0" 5" Radii ¾" Border 4" Series C Legend White Background Black Legend and Border		 TTC-011A-25 Freeway Sign 6'-0" X 4'-0" 6" Radii ¾" Border 6" Series C Legend White Background Black Legend and Border		 TTC-012-25 4'-6" X 2'-6" 4" Radii ¾" Border 5" Kids Series Legend Orange Background Black Legend and Border		 TTC-013-25 4'-6" X 2'-6" 4" Radii ¾" Border 5" Kids Series Legend Orange Background Black Legend and Border					
 TTC-014-25 2'-0" X 2'-6" 1.13" Radii ¾" Border 4" Series C Legend White Background Red Legend and Border		 TTC-015-25 1'-6" X 1'-0" 1.5" Radii ¼" Border 3" Series B Legend Orange Background Black Legend and Border		 TTC-016-25 3'-0" X 2'-0" 2" Radii ¾" Border 6" Series B Legend Blue Background White Legend and Border		 TTC-017R-25 TTC-017L-25 2'-0" X 1'-0" 2" Radii ¾" Border 2" Series B Legend White Background Black Legend and Border					
 TTC-018-25 2'-0" X 1'-6" 1.5" Radii ½" Border 3" Series D Legend Orange Background Black Legend and Border											
LAST REVISION 11/01/25		DESCRIPTION:		FDOT FY 2026-27 STANDARD PLANS		SPECIAL SIGN DETAILS		INDEX 700-102		SHEET 21 of 22	

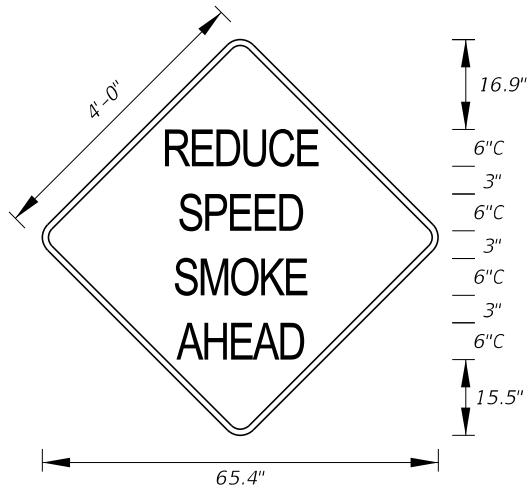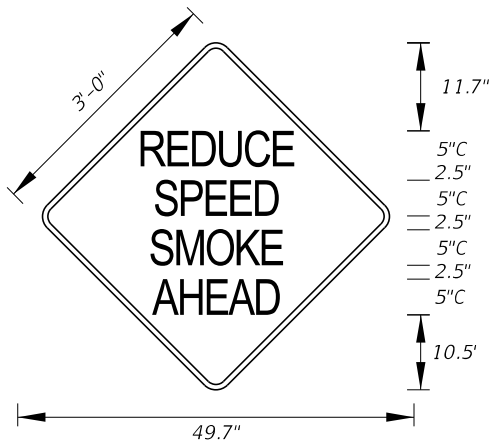

TTC-019-25
3'-0" x 3'-0"
1.5" Radii 0.8" Border
5" Series C Legend
Pink Background
Black Legend and Border

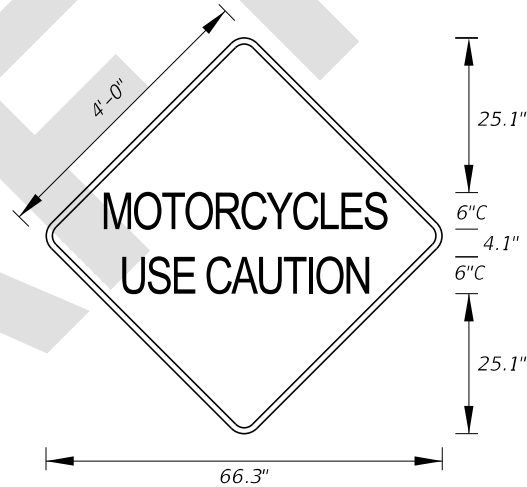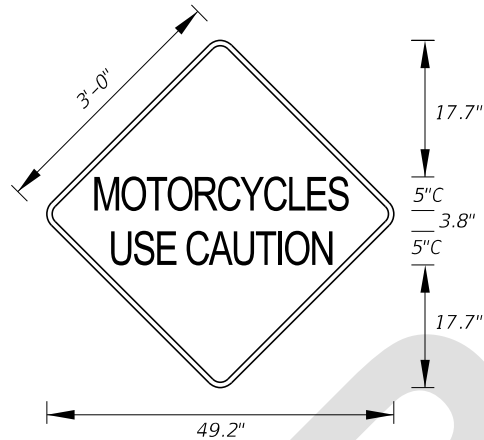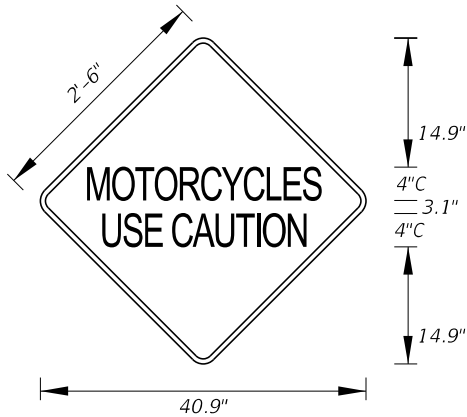TTC-019A-25
3'-0" x 3'-0"
3" Radii 0.8" Border
6" Series C Legend
Pink Background
Black Legend and Border



TTC-020-25
2'-6" x 2'-6"
1.5" Radii 0.75" Border
4" Series C Legend
Yellow Background
Black Legend and Border

TTC-020A-25
3'-0" x 3'-0"
1.5" Radii 0.8" Border
5" Series C Legend
Pink Background
Black Legend and Border

TTC-020B-25
3'-0" x 3'-0"
3" Radii 0.8" Border
6" Series C Legend
Pink Background
Black Legend and Border

8/14/2025 1:30:00 PM

SPECIAL SIGN DETAILS CROSSWALK

Previous Sign Name	Current Sign Name	Sign Description	Previous Sign Name	Current Sign Name	Sign Description
FTP-2-06	FTP-001-25	ALL TRUCKS ENTER WEIGH STATION (NON-FREEWAY)	FTP-85-13	FTP-026-25	LEFT TURN YIELD ON FLASHING YELLOW ARROW
FTP-1-06	FTP-001A-25	ALL TRUCKS ENTER WEIGH STATION (FREEWAY)	N/A	FTP-027-25	[TRAFFIC LIGHT] PHOTO ENFORCED INCLUDES RIGHT TURN
FTP-6B-06	FTP-002L-25	ALL TRUCKS - TRAILERS PICKUPS - VANS NEXT LEFT	N/A	FTP-028-25	SCHOOL ZONE PHOTO ENFORCED (MORNING AND AFTERNOON)
FTP-6A-06	FTP-002R-25	ALL TRUCKS - TRAILERS PICKUPS - VANS NEXT RIGHT	N/A	FTP-028A-25	SCHOOL ZONE PHOTO ENFORCED (ALL DAY)
FTP-51-06	FTP-003-25	WEIGHT LIMIT LAST EXIT	N/A	FTP-029-25	SCHOOL ZONE PHOTO ENFORCED (MORNING AND AFTERNOON)
FTP-44A-25	FTP-004-25	SAFETY BELT CHILD RESTRAINT USE REQUIRED BY LAW	N/A	FTP-029A-25	SCHOOL ZONE PHOTO ENFORCED (ALL DAY)
FTP-44-06	FTP-004A-25	SAFETY BELT CHILD RESTRAINT USE REQUIRED BY LAW	N/A	FTP-030-25	STATE LAW STOP FOR PEDESTRIANS IN CROSSWALKS
FTP-47-06	FTP-005-25	BUCKLE UP IT'S THE LAW	N/A	FTP-030A-25	STATE LAW STOP FOR PEDESTRIANS IN CROSSWALKS
FTP-46-06	FTP-005A-25	BUCKLE UP IT'S THE LAW	N/A	FTP-031-25	CROSSWALK STOP ON RED PROCEED ON FLASHING RED WHEN CLEAR
FTP-45-25	FTP-006-25	FLORIDA LAW SAFETY BELT USE CHILD RESTRAINT USE	FTP-86-21	FTP-032-25	STATE LAW STOP FOR [PED] WITHIN CROSSWALK
N/A	FTP-007-25	FENDER BENDER MOVE VEHICLES FROM TRAVEL LANES	FTP-25-06	FTP-033-25	PUSH BUTTON TO CROSS ST NAME
N/A	FTP-007A-25	FENDER BENDER MOVE VEHICLES FROM TRAVEL LANES	FTP-68A-06	FTP-034-25	PEDISTRIAN CROSSING PUSH BUTTON
N/A	FTP-007B-25	FENDER BENDER MOVE VEHICLES FROM TRAVEL LANES	FTP-68B-06	FTP-035-25	PEDISTRIAN CROSSING PUSH BUTTON
N/A	FTP-008-25	TWO-AXLE VEHICLES ONLY BUSES ALLOWED	FTP-68C-21	FTP-036-25	PUSH BUTTON FOR WARNING LIGHTS
FDM ESS-R1	FTP-009-25	EMERGENCY STOPPING SITE	FTP-54L-06	FTP-037AL-25	[LEFT ARROW] ONLY (FTP-037AR-25 FOR RIGHT ARROW)
FDM ESS-R2	FTP-010-25	EMERGENCY STOPPING SITE X MILE	FTP-55L-06	FTP-037L-25	[LEFT ARROW] ONLY (FTP-037R-25 FOR RIGHT ARROW)
FDM ESS-R3	FTP-011-25	EMERGENCY STOPPING SITE X MILES	FTP-82-08	FTP-037U-25	[U-TURN] ONLY
FTP-65-06	FTP-012-25	OFFICIAL USE ONLY	FTP-53-06	FTP-038L-25	LEFT TURN ONLY
FTP-29-06	FTP-013-25	GROOVED	FTP-52-06	FTP-038R-25	RIGHT TURN ONLY
FTP-41-21	FTP-014-25	FLORIDA LITTER LAW \$150 MIN FINE FOR LITTERING	N/A	FTP-039-25	NO PEDESTRIANS OR BICYCLES BEYOND GATE
FTP-40-21	FTP-014A-25	FLORIDA LITTER LAW \$150 MIN FINE FOR LITTERING	FTP-100-25	FTP-040-25	FLORIDA LAW
FTP-19-06	FTP-015-25	24 HOUR PARKING	FTP-69-06	DELETED	NO PEDESTRIANS BICYCLES MOTOR VEHICLES LESS THAN 5 BHP
FTP-20-06	FTP-016-25	PARKING BY DISABLED PERMIT ONLY	FTP-50-06	FTP-200-25	WEIGHT LIMIT RESTRICTION AHEAD
FTP-21-06	FTP-017-25	PARKING BY DISABLED PERMIT ONLY	FTP-33-06	FTP-201-25	SCHOOL ENTRANCE
FTP-22-06	FTP-018-25	FINE \$250 MAX	FTP-84-09	FTP-202-25	DRAW BRIDGE AHEAD
FTP-37-06	FTP-019-25	SPEEDING FINES DOUBLED WORK ZONES SCHOOL ZONES	FTP-61-06	FTP-203-25	NO TRAIN HORN 10 PM - 6 AM
FTP-38-22	FTP-020-25	SPEEDING FINES DOUBLED	FTP-62-06	FTP-203A-25	NO TRAIN HORN 10 PM - 6 AM
FTP-39-06	FTP-020A-25	SPEEDING FINES DOUBLED	N/A	FTP-204-25	X-ING
FTP-35-06	FTP-021-25	SCHOOL SPEED LIMIT XX	N/A	FTP-205-25	ON SIDEWALK
FTP-31-06	FTP-022-25	SCHOOL ZONE XX [FLASHER] MPH WHEN FLASHING	N/A	FTP-206-25	MOTORCYCLES USE CAUTION
FTP-31-06	FTP-022A-25	SCHOOL ZONE XX [FLASHER] MPH WHEN FLASHING	N/A	FTP-206A-25	MOTORCYCLES USE CAUTION
FTP-34-06	FTP-023-25	END SCHOOL ZONE	N/A	FTP-206B-25	MOTORCYCLES USE CAUTION
FTP-32-06	FTP-023A-25	END SCHOOL ZONE	N/A	FTP-207-25	PRESCRIBED BURN AHEAD
FTP-90-22	FTP-024-25	ALL TRAFFIC BOTH DIRECTIONS STOP WHILE SCHOOL BUSES LOAD OR UNLOAD	N/A	FTP-207A-25	PRESCRIBED BURN AHEAD
FTP-91-22	FTP-025-25	STOP WHILE SCHOOL BUSES LOAD OR UNLOAD THIS ROADWAY	FTP-72-06	FTP-208-25	FIRE SMOKE AREA

SPECIAL SIGN DETAILS CROSSWALK

Previous Sign Name	Current Sign Name	Sign Description	Previous Sign Name	Current Sign Name	Sign Description
FTP-71-06	FTP-208A-25	FIRE SMOKE AREA	FTP-5-06	FTP-601-25	WEIGH STATION AGRICULTURAL INSPECTION 1 MILE
FTP-15A-06	FTP-400-25	STATE OF FLORIDA WELCOME CENTER 1 MILE	FTP-4-06	FTP-602-25	CLOSED
FTP-10-06	FTP-400A-25	STATE OF FLORIDA WELCOME CENTER 1 MILE	FTP-8-06	FTP-602A-25	CLOSED
FTP-15B-06	FTP-401-25	1/2 MILE	FTP-9A-06	FTP-603-25	TRUCKS - TRAILERS PICKUPS - VANS [RIGHT ARROW]
FTP-15C-06	FTP-402-25	RIGHT ARROW	FTP-7B-06	FTP-604L-25	WEIGH STATION AGRICULTURAL INSPECTION NEXT LEFT
FTP-11-06	FTP-402A-25	STATE OF FLORIDA WELCOME CENTER [RIGHT ARROW]	FTP-7A-06	FTP-604R-25	WEIGH STATION AGRICULTURAL INSPECTION NEXT RIGHT
FTP-13-06	FTP-403-25	WELCOME CENTER [RIGHT ARROW]	FTP-83-08	FTP-605-25	ALL TRUCKS [RIGHT ARROW]
FTP-12-06	FTP-404-25	STATE OF FLORIDA OFFICIAL WELCOME CENTER [FLORIDA]	FTP-36-06	FTP-606-25	ONE - STOP CAREER CENTER [RIGHT ARROW]
FTP-14-06	FTP-405-25	Tourist Information Center NEXT RIGHT	FTP-48-06	FTP-607-25	RECYCLING [SYMBOL] COLLECTION CENTER
FTP-87-21	FTP-406-25	REST AREA TRUCK PARKING XXX SPACES AVAILABLE	FTP-49-06	FTP-608-25	RECYCLING [SYMBOL] COLLECTION CENTER
FTP-88-21	FTP-407-25	WEIGH STATION TRUCK PARKING XXX SPACES AVAILABLE	N/A	FTP-609-25	[DIRECTION] [U.S. HWY NO.] MILE [MILE MARK]
FTP-89-21	FTP-408-25	WELCOME CENTER TRUCK PARKING XXX SPACES AVAILABLE	FTP-16-10	FTP-610-25	FLORIDA'S TURNPIKE
FTP-73-06	FTP-409-25	VENDING MACHINES	FTP-17-10	FTP-610A-25	FLORIDA'S TURNPIKE
FTP-74-06	FTP-410-25	VENDING FREE COFFEE	FTP-18-10	FTP-610B-25	FLORIDA'S TURNPIKE
FTP-75-06	FTP-411-25	SAFETY BREAK	FTP-81-06	FTP-611-25	TOLL [FLORIDA]
FTP-76-06	FTP-412-25	MACHINES	FTP-80-06	FTP-611A-25	TOLL [FLORIDA]
FTP-43-06	FTP-413-25	FLORIDA HIGHWAY PATROL DIAL * FHP (347)	FTP-79-06	FTP-611B-25	TOLL [FLORIDA]
FTP-66-21	FTP-414-25	FLORIDA 511 TRAVEL INFO CALL 511	FTP-17-06	FTP-612-25	FLORIDA ROUTE MARKER
FTP-67-21	FTP-414A-25	FLORIDA 511 TRAVEL INFO CALL 511	FTP-18-06	FTP-613-25	[ROUTE] COUNTY
FTP-78-06	FTP-415-25	EVACUATION ROUTE	N/A	FTP-614-25	AMTRAK
FTP-77-06	FTP-415A-25	EVACUATION ROUTE	N/A	FTP-614A-25	AMTRAK
FTP-23-06	FTP-416-25	INTERNATIONAL SYMBOL OF ACCESS FOR HEARING LOSS	N/A	FTP-615-25	GREYHOUND
FTP-24-06	FTP-417-25	INTERNATIONAL TDD SYMBOL	N/A	FTP-615A-25	GREYHOUND
FTP-56A-06	FTP-418-25	TRY CARPOOLING	N/A	FTP-616-25	JOCKEY ON HORSEBACK
FTP-56-06	FTP-418A-25	TRY CARPOOLING	N/A	FTP-616A-25	JOCKEY ON HORSEBACK
FTP-58-06	FTP-419-25	TRY VANPOOLING	N/A	FTP-617-25	JAI ALAI PLAYER
FTP-57-06	FTP-419A-25	TRY VANPOOLING	N/A	FTP-617A-25	JAI ALAI PLAYER
FTP-60-06	FTP-420-25	TRY TRANSIT	N/A	FTP-618-25	SHIP
FTP-59-06	FTP-420A-25	TRY TRANSIT	N/A	FTP-618A-25	SHIP
N/A	FTP-421-25	FLORIDA SHARE-A-RIDE	N/A	FTP-619-25	GRAPES
N/A	FTP-421A-25	FLORIDA SHARE-A-RIDE	N/A	FTP-619A-25	GRAPES
N/A	FTP-422-25	EMERGENCY INFO XX.X FM	N/A	FTP-620-25	RIGHT ARROW
N/A	FTP-422A-25	EMERGENCY INFO XX.X FM	N/A	FTP-621-25	4 MILES
FTP-70-06	FTP-422B-25	EMERGENCY INFO XX.X FM	N/A	FTP-622-25	WINERY
FTP-3-06	FTP-600-25	WEIGH STATION 1000 FT			

SPECIAL SIGN DETAILS CROSSWALK

Previous Sign Name	Current Sign Name	Sign Description	Previous Sign Name	Current Sign Name	Sign Description
N/A	FTP-800-25	GREAT FLORIDA [BIRD] BIRDING TRAIL			
N/A	FTP-801-25	FLORIDA HERITAGE			
N/A	FTP-802-25	MEMORIAL HIGHWAY			
FTP-42-06	FTP-803-25	ADOPT - A - HIGHWAY			
N/A	FTP-804-25	FLORIDA SCENIC HIGHWAY			
N/A	FTP-804A-25	FLORIDA SCENIC HIGHWAY			
MOT-1-22	TTC-001-25	STAY IN YOUR LANE			
MOT-4-22	TTC-002-25	LITTER PICK UP AHEAD			
MOT-5-22	TTC-003-25	TRUCKS ENTERING HIGHWAY			
MOT-6-22	TTC-003A-25	TRUCKS ENTERING HIGHWAY			
MOT-7-22	TTC-004-25	TRUCKS TURNING LEFT XXX FT			
MOT-8-22	TTC-005-25	MERGE RIGHT ON FLASHING ARROW			
MOT-9-22	TTC-006-25	LIGHTED WORK ZONE AHEAD			
MOT-10-22	TTC-007-25	STATE PRISONERS WORKING			
MOT-27-25	TTC-008-25	CENTER LANE CLOSED AHEAD			
MOT-15-06	TTC-009-25	GROOVED PAVEMENT AHEAD			
MOT-18-10	TTC-010-25	RUMBLE STRIPS AHEAD			
MOT-14-06	TTC-011-25	SPEEDING FINES DOUBLED WHEN WORKERS PRESENT			
MOT-13-06	TTC-011A-25	SPEEDING FINES DOUBLED WHEN WORKERS PRESENT			
MOT-16-06	TTC-012-25	SLOW DOWN MY DADDY WORKS HERE			
MOT-17-06	TTC-013-25	SLOW DOWN MY MOMMY WORKS HERE			
MOT-19-11	TTC-014-25	LEGAL WEIGHTS ONLY			
MOT-23-21	TTC-015-25	RETURN TO SHOULDER			
MOT-11-06	TTC-016-25	BUSINESS ENTRANCE [RIGHT ARROW]			
MOT-12R-06	TTC-017-25	PEDESTRIAN WALKWAY [RIGHT ARROW]			
MOT-21-21	TTC-018-25	BICYCLE DETOUR			
N/A	TTC-019-25	REDUCE SPEED SMOKE AHEAD			
N/A	TTC-019A-25	REDUCE SPEED SMOKE AHEAD			
N/A	TTC-020-25	MOTORCYCLES USE CAUTION			
N/A	TTC-020A-25	MOTORCYCLES USE CAUTION			
N/A	TTC-020B-25	MOTORCYCLES USE CAUTION			