

Origination Form
Proposed Revisions to a Standard Plans Index

Originator:	Gray, Ryan	Index Number:	711-001
Date:	4/30/2025	Sheet Number(s):	7
E-mail:	ryan.gray@dot.state.fl.us	Index Title:	PAVEMENT MARKINGS

Summary of the changes:

Added Drivable Base option to Detail "A"; Updated Notes 1 and 2

Commentary/Background:




Additional attachment types for Tubular Markers in grassed medians are being requested by Industry.

Other Affected Documents/Offices	Person Contacted	Affected (Yes/No)
Other Standard Plans		No
FDOT Design Manual		No
Standard Specifications		No
Basis of Estimates Manual		No
Approved Product List		No
Construction Office		No
Maintenance Office		No



Implementation

FY 2026-27

SHEET
7 of 13

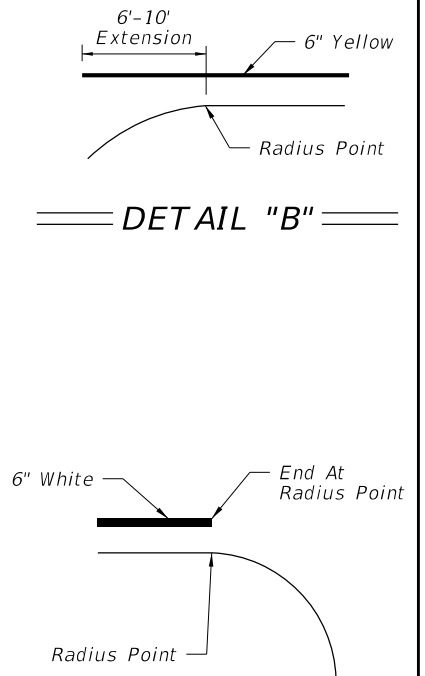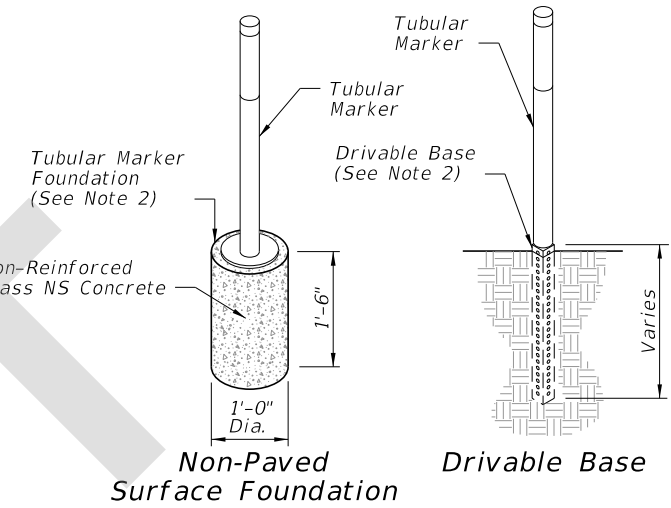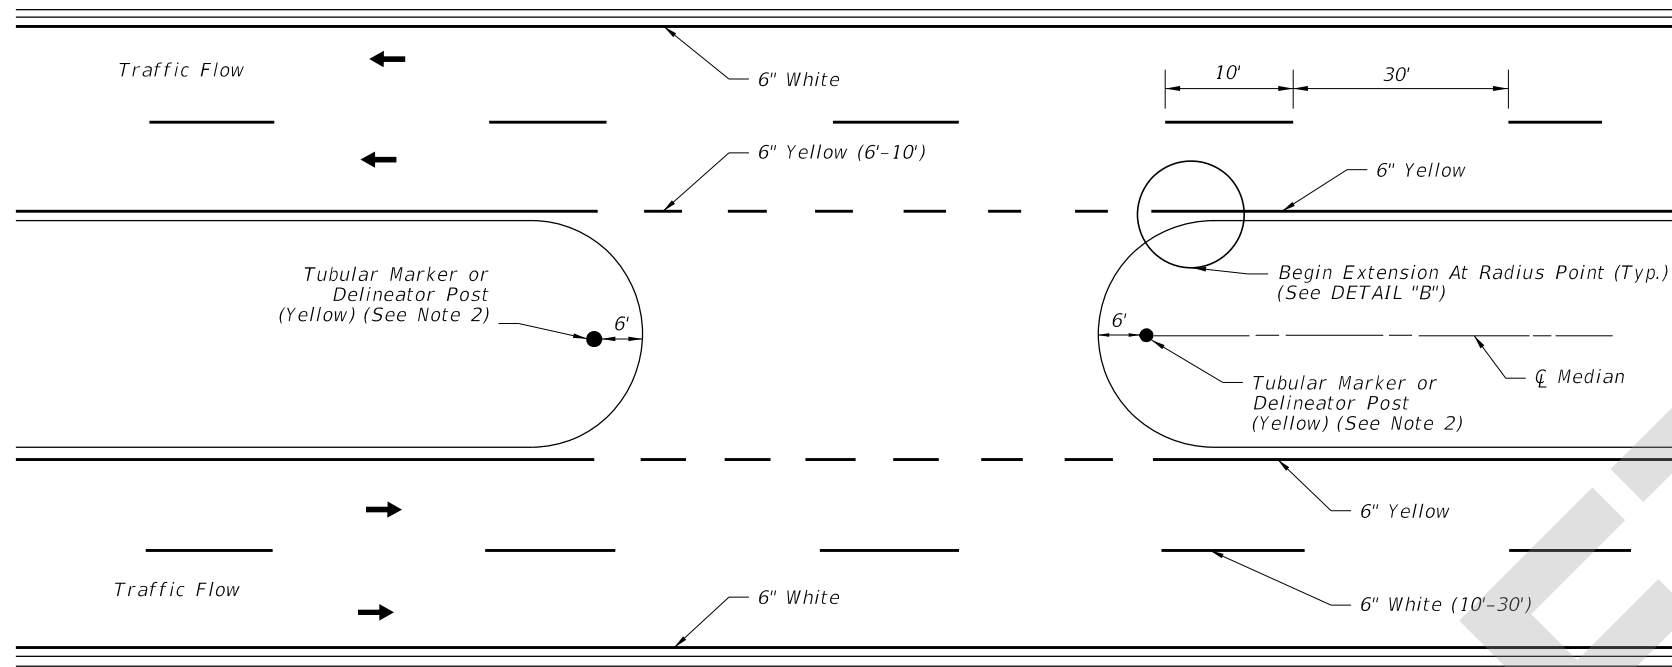


PAVEMENT MARKINGS AND DELINEATORS FOR MEDIAN CROSSOVER

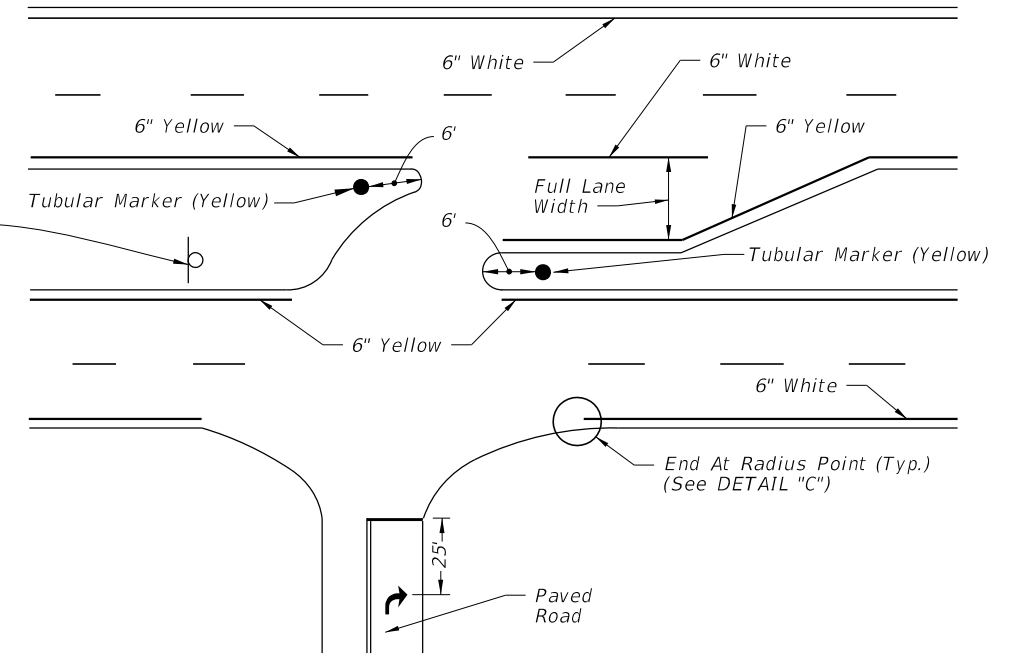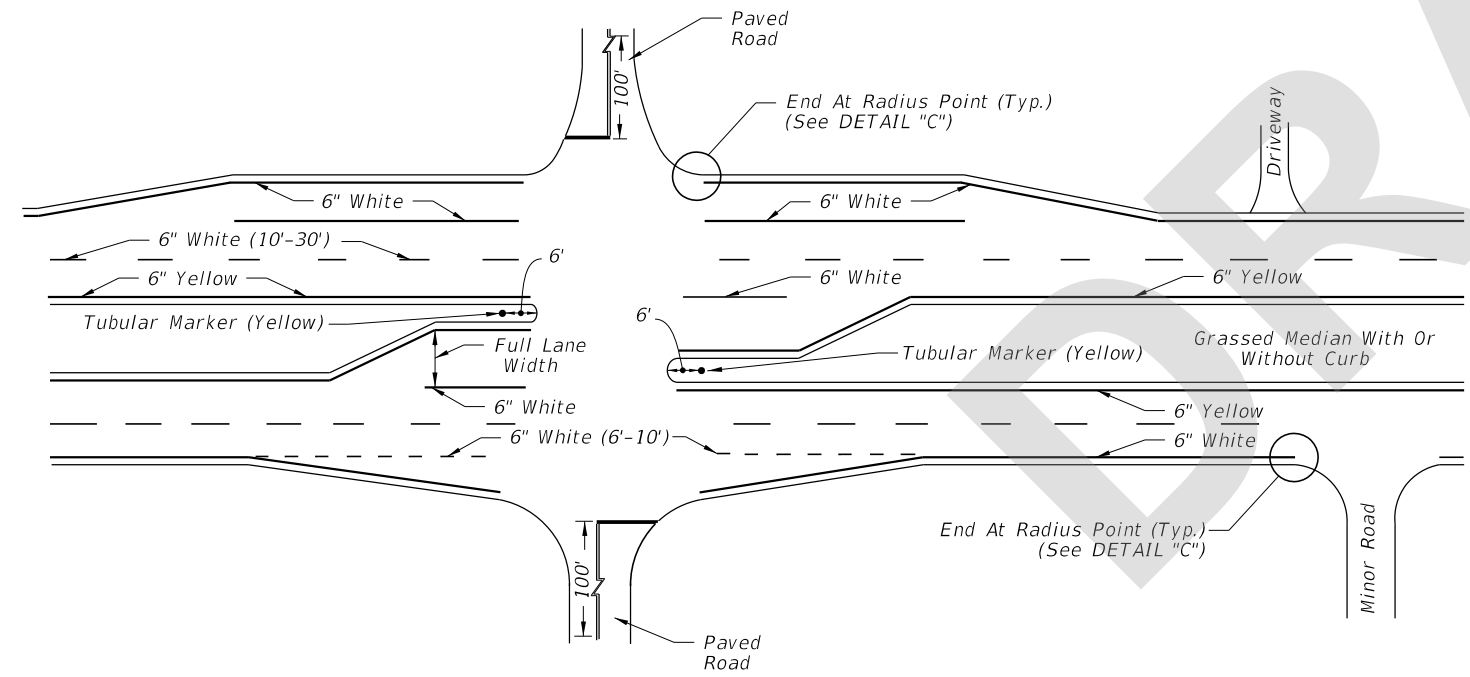

NOTES:

1. Apply yellow retroreflective durable paint to the noses of curbed medians, traffic separators, and raised islands; When applying yellow retroreflective paint in conjunction with Raised Pavement Markers, see Index 706-001.
2. Options for grassed medians:
 - A. Option 1: Tubular Marker (Yellow). Attach Tubular Marker according to manufacturer's instructions. For grassed medians without a suitable mounting surface, use either a drivable base type, or provide a Non-Paved Surface Foundation (See Detail "A"). Install Non-Paved Surface Foundation flush with the surrounding ground surface.
 - B. Option 2: Delineator Post. Use yellow retroreflective sheeting on both sides of the delineator. Install the post so that the top is 4'-0" above the grade at the edge of the pavement.
3. Extend double yellow centerlines 100' back from intersection on all approaches or 50' for unmarked cross roads.

PAVEMENT MARKINGS FOR INTERSECTIONS WITH MAJOR AND MINOR ROADS

LAST REVISION 11/01/25	REVISION	DESCRIPTION:	 FY 2026-27 STANDARD PLANS	PAVEMENT MARKINGS	INDEX 711-001	SHEET 7 of 13
------------------------------	----------	--------------	--	-------------------	------------------	------------------

5/7/2025 9:52:36 AM