
Index 711-003 Interchange Markings

ORIGINATION

Date: 5/5/25

Name: Shae Gibbs

Phone: 414-4314

Email: shae.gibbs@dot.state.fl.us

COMMENTARY

Sheet 2: Due to ongoing confusion on what striping to use in Parallel-Type Entrances, a detail was added for SINGLE-LANE PARALLEL-TYPE ENTRANCE WITHOUT ADDED LANE for clarification

Sheets 5, 6, and 7: Update WWD Arrows to match proposed revision to 706-001

COMMENTS AND RESPONSES

BLACK = Industry Review Comments **BLUE** = Standard Plans Response **GREEN** = Change Made to Index

Name: Keith Krieger

Date: 6/26/25


COMMENT: Is the new detail (SINGLE-LANE PARALLEL-TYPE ENTRANCE WITHOUT ADDED LANE) missing "MERGE" pavement markings?
What is the 1000'-0" measured to?

RESPONSE: Note 3 covers that only the "Two-Lane Entrance" uses the Merge Pavement Message and Arrow.


The 1000' Dimension in the Single-Lane Entrance should be deleted.

CHANGE MADE TO INDEX: Yes. The 1000' Dimension was deleted.


Response Date: 7/11/25

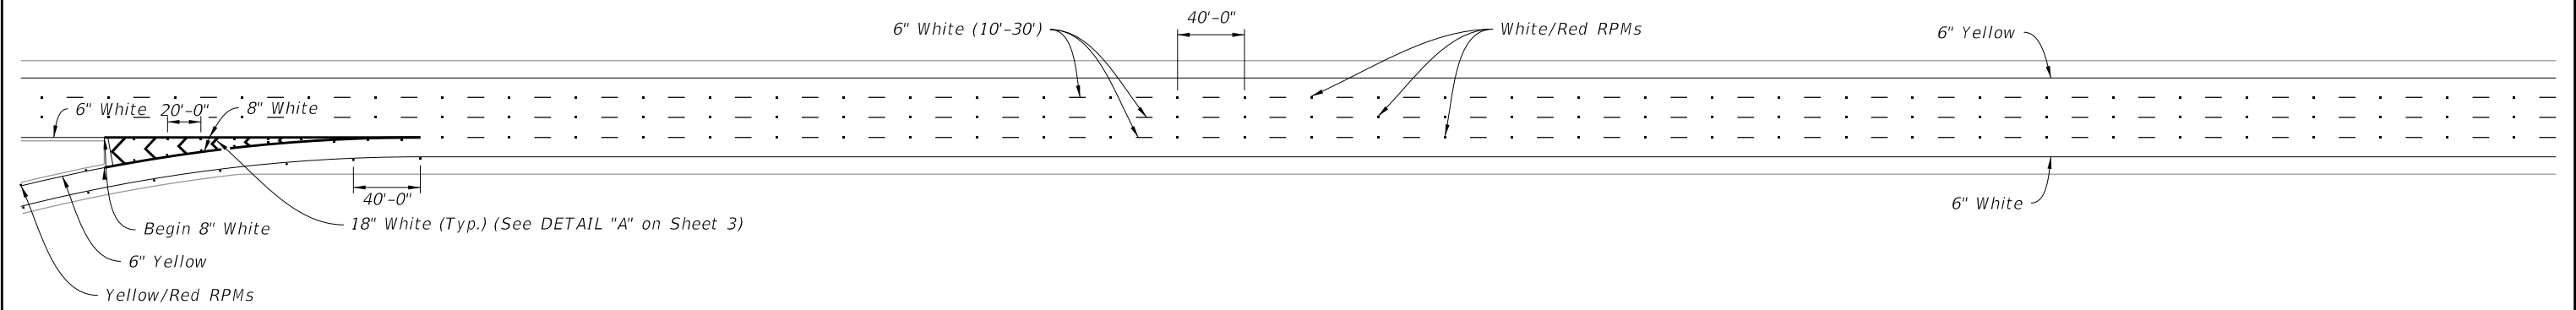

PARALLEL-TYPE ENTRANCE WITH ADDED LANE

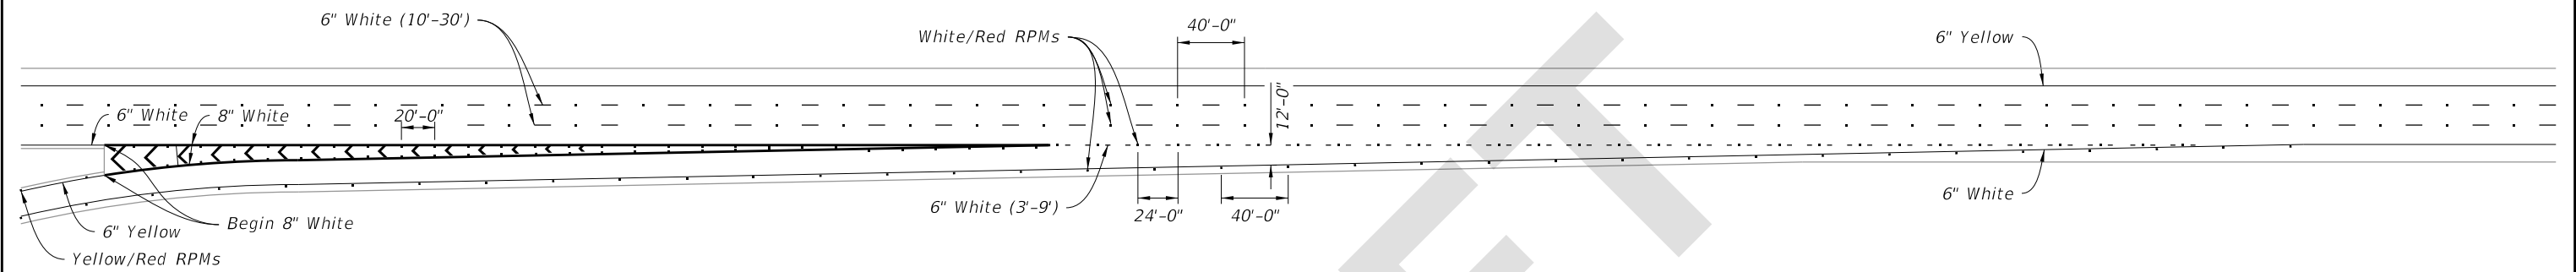


TAPER-TYPE ENTRANCE

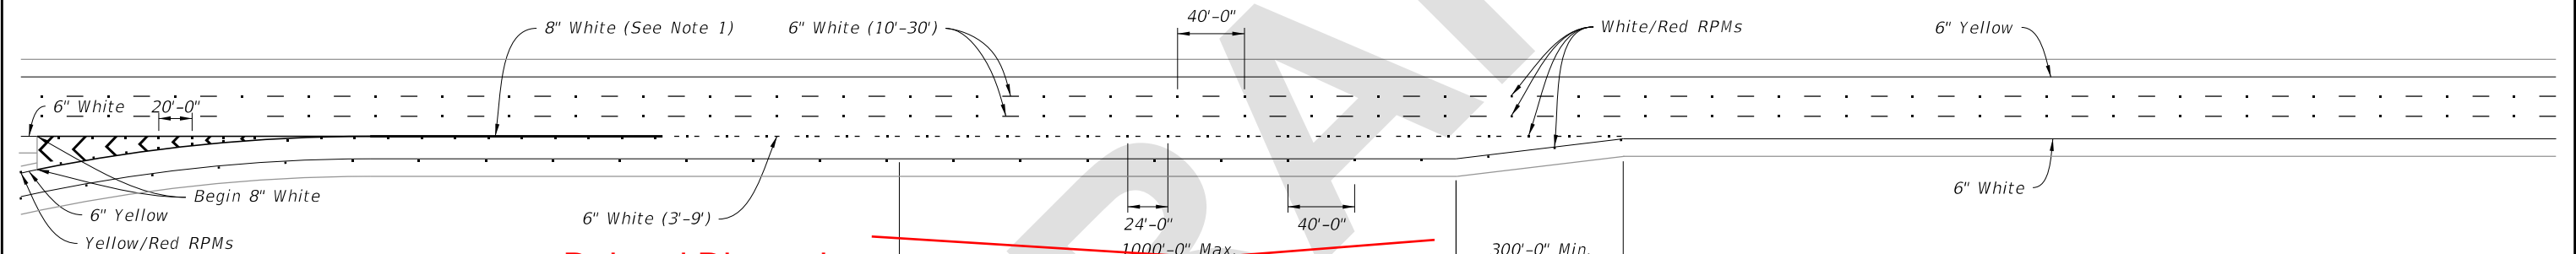

Deleted Dimension

SINGLE-LANE PARALLEL-TYPE ENTRANCE WITHOUT ADDED LANE

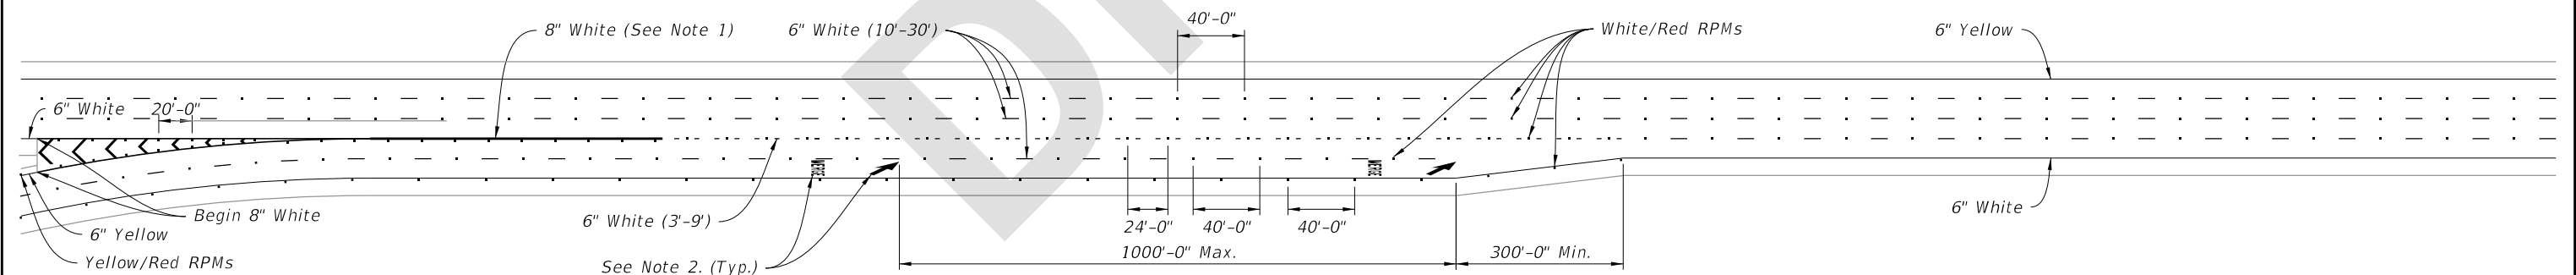

TWO-LANE PARALLEL-TYPE ENTRANCE WITH ADDED LANE

NOTES:

- Extend this 8" white Pavement Marker one-fourth the length of the acceleration lane from the gore markings.
- See Index 711-001 for pavement message dimensions and details.
- Merge Pavement Message and Arrow only used for Two-Lane Entrances.

TYPICAL PAVEMENT MARKINGS AT ENTRANCE RAMPS

LAST REVISION	DESCRIPTION:	FDOT	FY 2026-27 STANDARD PLANS	INTERCHANGE MARKINGS	INDEX	SHEET
11/01/25					711-003	2 of 8

6/16/2025 11:34:21 AM