

Origination Form
Proposed Revisions to a Standard Plans Index

Originator:	Frimmel, James	Index Number:	700-102
Date:	5/12/26	Sheet Number(s):	All
E-mail:	james.frimmel@dot.state.fl.us	Index Title:	Special Sign Details

Summary of the changes:

ALL Sheets: Renumbered; Updating Index to accommodate changes to the Sign Library and revising dimensions for clarity.

Sheet 1: Added Note 3 "Center text within the sign horizontally, unless otherwise noted" ; Updated the Table of Contents.

Sheet 2: FTP-007A-25 Remove 6" Series C Legend

Sheet 4: FTP-019-25 Determine if Supplemental Panel reference is FTP-017-25 or 018-25, FTP-021-25, 80% Spacing; Deleted the horizontal dimensions for FTP-019-26 and FTP-019A-26.

Sheet 5: FTP-031 & 032 changed border from 3/4" to 1/4"; FTP-034U-25 Updated Detail and Table.

Sheet 6: Deleted FTP-035R-25 and FTP-035L-25 -These signs are in the MUCTD.

Sheet 10: FTP-415-25 changed border to 1/2".

Sheet 12: FTP-615-25 changed border to 3/4"

Sheet 15: FTP-610B-25 Shown correct sign width (4'-0").

Sheet 16: Various notes updates/revisions.

Sheet 17: FTP-615-25 Clarify border dimension.

Sheet 20: TTC-018-25 Corrected dimension.

Sheets 22-29: Added sheets to in Toll Signs from GTR, updated naming convention for all signs, various dimension cleanup

Commentary/Background:

Index was updated to clarify dimensions and other sign details. All tolling-related signage formerly in the GTR was also added and the sign naming conventions updated for consistency throughout the index. These changes coincide and have been coordinated with updates to the Sign Library and TEM.

Other Affected Documents/Offices	Person Contacted	Affected (Yes/No)
Other Standard Plans		
FDOT Design Manual		
Standard Specifications		
Basis of Estimates Manual		
Approved Product List		
Construction Office		
Maintenance Office		

Implementation

FY 2027-28

GENERAL NOTES:

- 1. Sign dimensions are shown in width by height (W x H) throughout the Index.
- 2. See APPENDIX for previous sign numbering crosswalk.

ADDED NOTE 3: Center text within the sign horizontally, unless otherwise noted.

EDITORIAL: Rearranged

NUMBERING CONVENTION:

FTP-AAA B/C-DD or TTC-AAA B/C-DD

- AAA = Sign Type
- B = Size Adjustments to Smallest Available Sign Size (A,B,C)
- C = Left or Right (L or R)
- DD = Year of update

- Example 1: Size Adjustment - FTP-001A-25
- Example 2: Direction Application - FTP-103R-25
- Example 3: Size and Direction - FTP-037AR-25

SIGN TYPES (AAA):

- FTP-001-199: Regulatory
- FTP-200-399: Warning & Advisory
- FTP-400-599: Motorist Service
- FTP-600-799: Guide
- FTP-800-899: Recreational & Cultural
- FTP-900-999: Miscellaneous
- TTC-001-199: Temporary Traffic Control

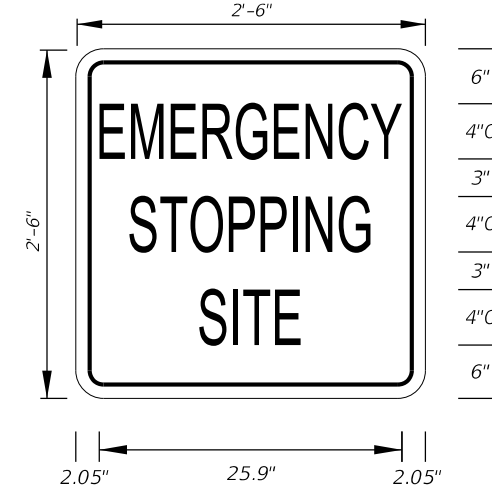
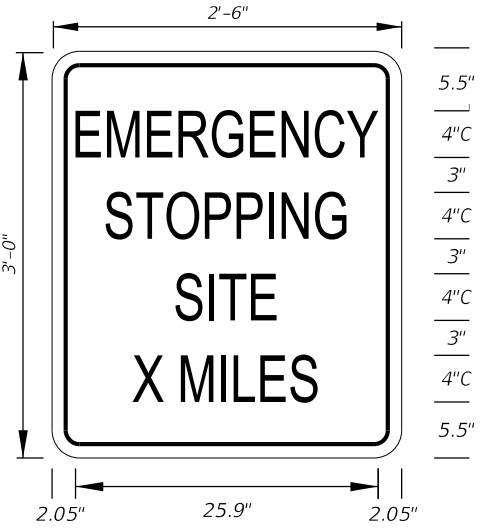
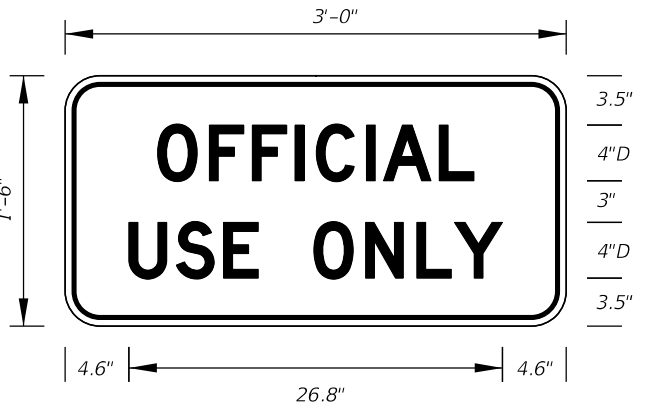
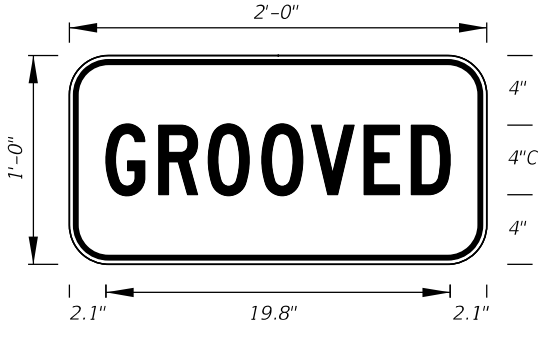
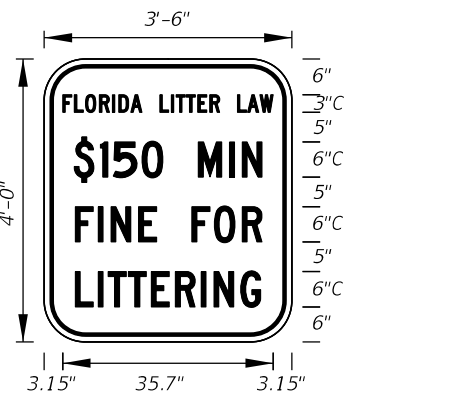
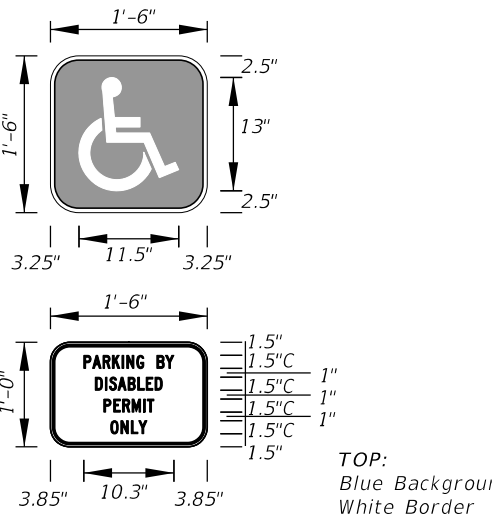
UPDATED: Table to show new Sheets.

TABLE OF CONTENTS:	
Sheet	Description
1	General Notes and Table of Contents
2	Sign Details FTP-001-25 through FTP-007B-25
3	Sign Details FTP-008-25 through FTP-018-25
4	Sign Details FTP-019-25 through FTP-026-25
5	Sign Details FTP-027-25 through FTP-034U-25
6	Sign Details FTP-035L-25 through FTP-037-25
7	Sign Details FTP-200-25 through FTP-206B-25
8	Sign Details FTP-207-25 through FTP-208A-25
9	Sign Details FTP-400-25 through FTP-409-25
10	Sign Details FTP-410-25 through FTP-415A-25
11	Sign Details FTP-416-25 through FTP-417-25
12	Sign Details FTP-418-25 through FTP-422B-25
13	Sign Details FTP-423-25 through FTP-423A-25
14	Sign Details FTP-600-25 through FTP-609-25
15	Sign Details FTP-610 through FTP-611B-25
16	Sign Details FTP-612-25 through FTP-613-25
17	Sign Details FTP-614-25 through FTP-616A-25
18	Sign Details FTP-800-25 through FTP-802A-25
19	Sign Details TTC-001-25 through TTC-010-25
20	Sign Details TTC-011-25 through TTC-018-25
21	Sign Details TTC-019-25 through TTC-020B-25
APPENDIX	Crosswalk


Renumbered

OTHER THAN FREEWAY USE FTP-001-25 7'-0" X 3'-6" 3" Radii 1" Border		FREEWAY USE FTP-001A-25 11'-6" X 5'-6" 9" Radii 2" Border		FTP-002R-25 FTP-002L-25 14'-6" X 7'-6" 9" Radii 2" Border		FTP-003-25 3'-6" X 2'-0" 1.5" Radii 3/4" Border	
FTP-004-25 4'-0" X 3'-0" 1.5" Radii 3/4" Border		FTP-004A-25 9'-0" X 6'-0" 9" Radii 3/4" Border		FTP-005-25 2'-0" X 2'-6" 1.5" Radii 5/8" Border		FTP-005A-25 3'-0" X 4'-0" 1.5" Radii 3/4" Border	
FTP-006-25 4'-0" X 4'-0" 1.5" Radii 0.4" Border		Non-Limited Access FTP-007-25 4'-0" X 2'-0" 1.5" Radii 0.75" Border		Non-Limited Access FTP-007A-25 6'-6" X 3'-0" 3" Radii 1" Border		FTP-007B-25 10'-0" X 4'-6" 6" Radii X 1" Border	

LAST REVISION	DESCRIPTION:	FDOT FY 2026-27 STANDARD PLANS	SPECIAL SIGN DETAILS	INDEX	SHEET
11/01/25	11/01/26			700-102	2 of 21


 FTP-008-25 15'-0" X 8'-6" 9" Radii 1.5" Border TOP: 10.7" Series E Legend Yellow Background Black Legend and Border BOTTOM: 16" and 10.7" Series E Legend White Background Black Legend and Border	Limited Access  FTP-009-25 13'-0" X 5'-6" 6" Radii 1" Border TOP: 10.7" Series E Legend White Background Black Legend and Border BOTTOM: 10.7" Series E Legend Black Background White Legend	 FTP-010-25 2'-6" X 2'-6" 1.5" Radii 0.625" Border 4" Series C Legend White Background Black Legend and Border	 FTP-011-25 2'-6" X 3'-0" 1.5" Radii 3/4" Border 4" Series C Legend White Background Black Legend and Border
 FTP-012-25 2'-6" X 3'-0" 1.5" Radii 3/4" Border 4" Series C Legend White Background Black Legend and Border	 FTP-013-25 3'-0" X 1'-6" 1.5" Radii 3/4" Border 4" Series D Legend White Background Black Legend and Border	 FTP-014-25 2'-0" X 1'-0" 1.5" Radii 5/8" Border 4" Series C Legend Yellow Background Black Legend and Border	 FTP-015-25 2'-6" X 3'-0" 1.5" Radii 3/4" Border 2" and 4" Series C Legend White Background Black Legend and Border
 FTP-015A-25 3'-6" X 4'-0" 1.5" Radii 3/4" Border 3" and 6" Series C Legend White Background Black Legend and Border	 FTP-016-25 1'-0" X 1'-6" 1.5" Radii 3/8" Border 4" Series D and 2" Series C Legend White Background Green Legend and Border	 FTP-017-25 1'-0" X 1'-6" 1.5" Radii 3/8" Border TOP: Blue Background White Border BOTTOM: 1" Series C Legend White Background Black Legend and Border	 FTP-018-25 1'-6" X 2'-6" 1.5" Radii 3/8" Border TOP: Blue Background White Border BOTTOM: 1.5" Series C Legend White Background Black Legend and Border Renumbered
LAST REVISION 11/01/25 DESCRIPTION: 11/01/26	FDOT FY 2026-27 STANDARD PLANS	SPECIAL SIGN DETAILS	INDEX 700-102 SHEET 3 of 21

NOTE: Supplemental Panel for the FTP-018-25 sign CHANGED TO: FTP-017-25 DELETED: Dimensions FTP-019-25 1'-0" X 6" 1.5" Radii 3/8" Border 1" Series E Legend White Background Black Legend and Border		NOTE: Supplemental Panel for the FTP-018-25 sign DELETED: Dimensions FTP-019A-25 1'-6" X 9" 1.5" Radii 3/8" Border 2" Series D Legend White Background Black Legend and Border		State Line Sign FTP-020-25 9'-6" X 6'-0" 9" Radii 2" Border 8" Series E Legend White Background Black Legend and Border		DELETED: Spacing FTP-021-25 2'-0" X 2'-6" 1.5" Radii 1/2" Border 4" Series C Legend 80% Spacing White Background Black Legend and Border			
Freeway Sign FTP-021A-25 4'-0" X 4'-0" 3" Radii 3/4" Border 6" Series D Legend White Background Black Legend and Border		TOP: 4" Series D Legend Fluorescent Yellow-Green Background Black Legend and Border BOTTOM: 4" and 10" Series E Legend White Background Black Legend and Border FTP-022-25 2'-0" X 3'-0" 1.5" Radii 5/8" Border		Span Wire Placement of 12" Yellow Signal FTP-023-25 8'-0" X 4'-0" 3" Radii 3/4" Border TOP: 8" Series D Legend Fluorescent Yellow-Green Background Black Legend and Border BOTTOM: 8" and 10" Series D Legend White Background Black Legend and Border		Mast Arm Placement of 12" Yellow Signal FTP-023A-25 8'-0" X 4'-0" 3" Radii 3/4" Border TOP: 8" Series D Legend Fluorescent Yellow-Green Background Black Legend and Border BOTTOM: 8" and 10" Series D Legend White Background Black Legend and Border			
FTP-024-25 2'-0" X 2'-6" 1.5" Radii 5/8" Border 4" Series D and E Legend White Background Black Legend and Border		FTP-024A-25 8'-0" X 4'-0" 3" Radii 3/4" Border 12" Series E and 8" Series D Legend White Background Black Legend and Border		FTP-025-25 3'-0" X 3'-0" 1.5" Radii 3/4" Border 3" Series C Legend and 5" Series D Legend White Background Black Legend and Border		Renumbered FTP-026-25 3'-0" X 3'-0" 1.5" Radii 3/4" Border 3" Series C Legend 5" Series D Legend White Background Black Legend and Border			
LAST REVISION 11/01/25		DESCRIPTION: 11/01/26		FY 2026-27 STANDARD PLANS		SPECIAL SIGN DETAILS		INDEX 700-102	SHEET 4 of 21

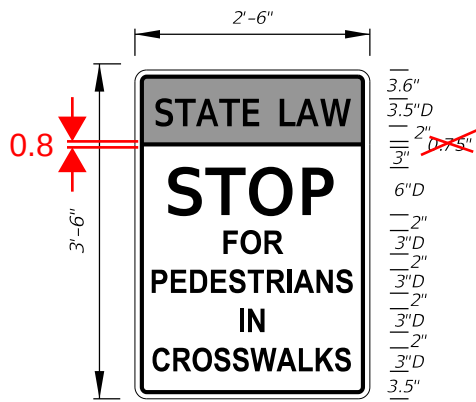


FTP-027-25
2'-6" X 3'-6"
1.5" Radii $\frac{3}{4}$ " Border

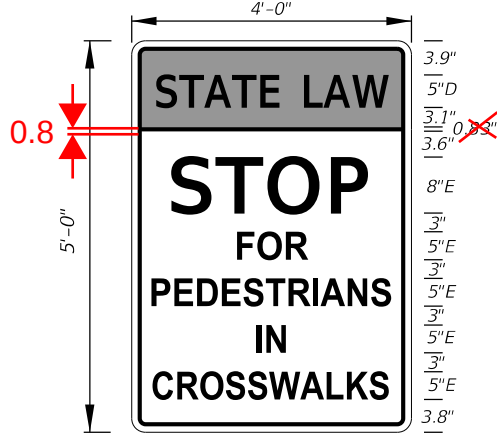TOP:
3.5" Series D Legend
Fluorescent Yellow Green
Background
Black Legend and Border
Bottom:
6" and 3" Series D Legend
White Background
Black Legend and Border




FTP-027A-25
4'-0" X 5'-0"
3" Radii $\frac{3}{4}$ " Border

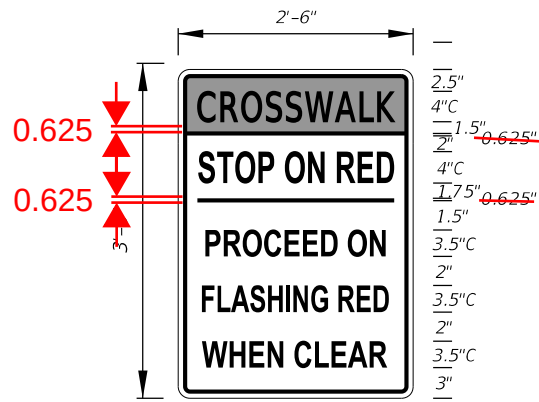TOP:
5" Series D Legend
Fluorescent Yellow Green
Background
Black Legend and Border
Bottom:
8" and 5" Series E Legend
White Background
Black Legend and Border




FTP-028-25
2'-6" X 3'-0"
1.5" Radii $\frac{3}{8}$ " Border

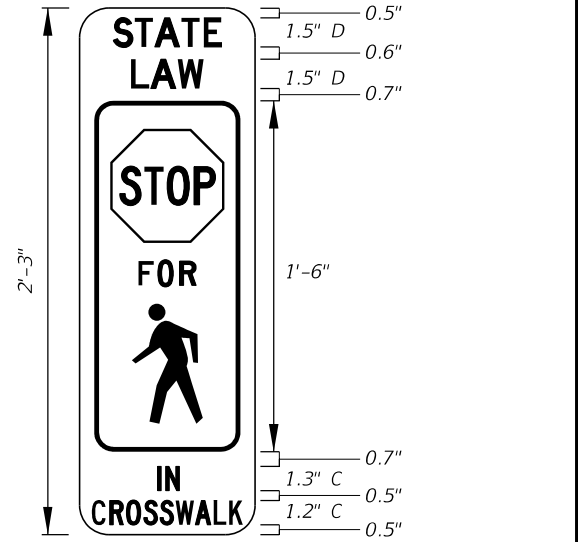TOP:
4" Series C Legend
Yellow Background
Black Legend and Border
Bottom:
3.5" Series C Legend
White Background
Black Legend and Border




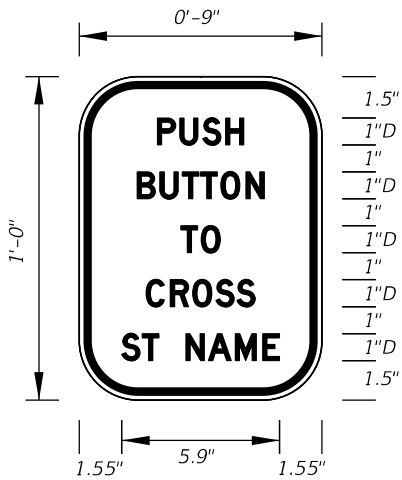FTP-029-25
0'-9" X 2'-3"
1.5" Radii No Border




FTP-030-25
0'-9" X 1'-0"
1.5" Radii $\frac{3}{8}$ " Border

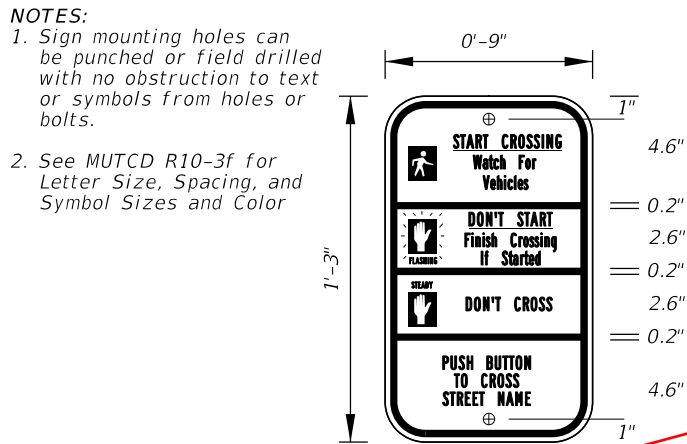1" Series D Legend
White Background
Black Legend and Border




FTP-031-25
0'-9" X 1'-3"
1.5" Radii $\frac{3}{8}$ " Border

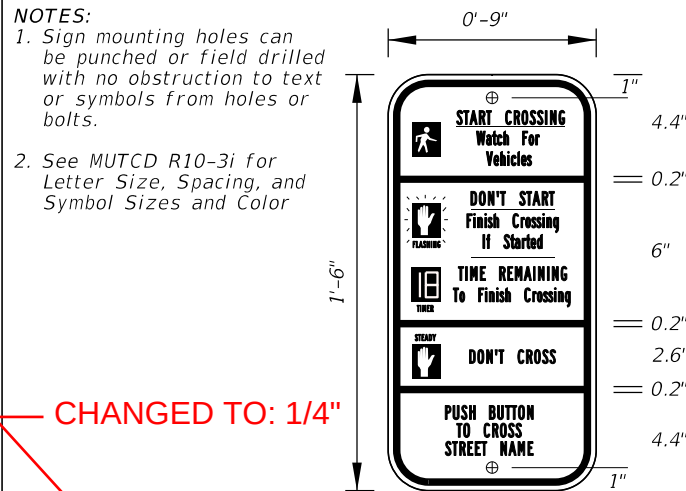Series B Legend
White Background
Black Legend and Border




FTP-032-25
0'-9" X 1'-6"
1.5" Radii $\frac{3}{8}$ " Border

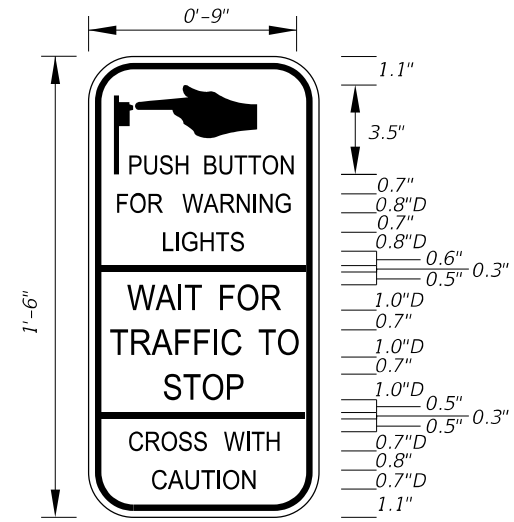Series B Legend
White Background
Black Legend and Border



FTP-033-25
0'-9" X 1'-6"
1.5" Radii $\frac{1}{4}$ " Border

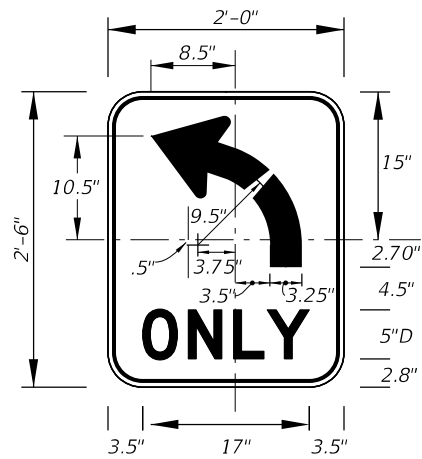
Series D Legend
White Background
Black Legend and Border



FTP-034L-25
2'-0" X 2'-6"
1.5" Radii $\frac{3}{8}$ " Border

5" Series D Legend
White Background
Black Legend and Border

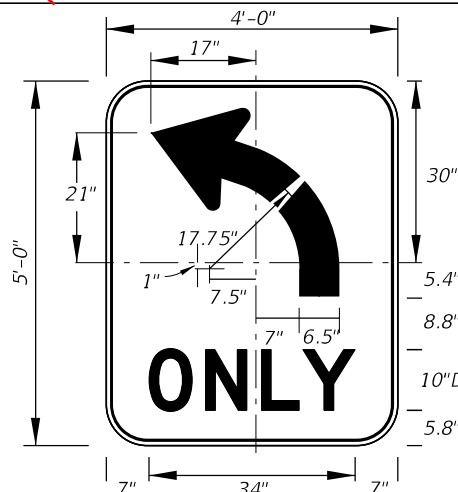
Note: Use FTP-034R for RIGHT TURN ONLY



FTP-034AL-25
4'-0" X 5'-0"
3" Radii $\frac{3}{4}$ " Border

10" Series D Legend
White Background
Black Legend and Border

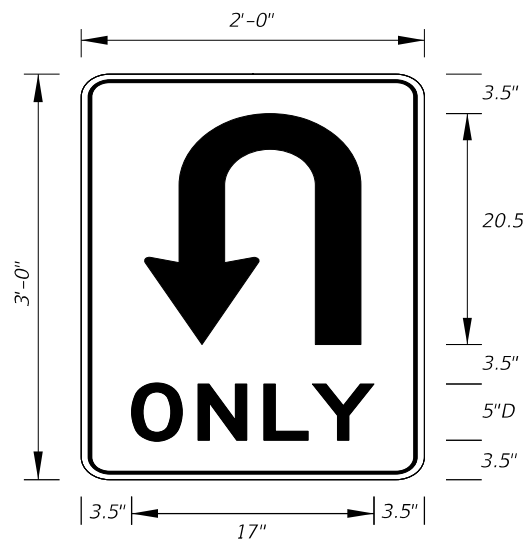Note: Use FTP-034AR for RIGHT TURN ONLY



FTP-034U-25
2'-0" X 3'-0"
1.5" Radii
5" Series D Legend
White Background
Black Legend and Border

UPDATED: Detail and Tables

ARROW HEAD						
A	B	C	D	E	F	G
3.125	3.625	6.375	.5	.625		

ARROW BODY						
A	B	C	D	E	F	G
6.25	3.125	3.125	3.125	5	9.25	20.5

DETAILS

Renumbered

FTP-035R-25
2'-0" X 2'-6"
1.5" Radii 5/8" Border

5" Series C Legend
White Background
Black Legend and Border

FTP-035L-25
2'-0" X 2'-6"
1.5" Radii 5/8" Border

5" Series C Legend
White Background
Black Legend and Border

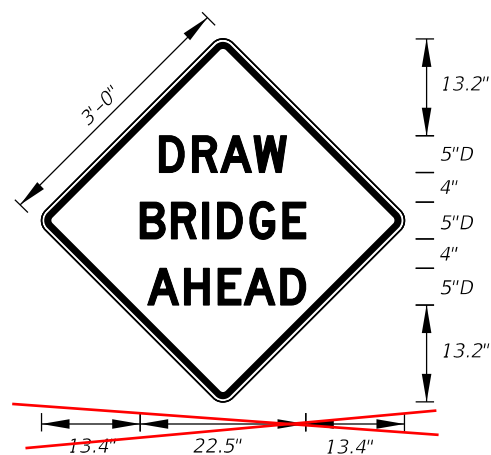
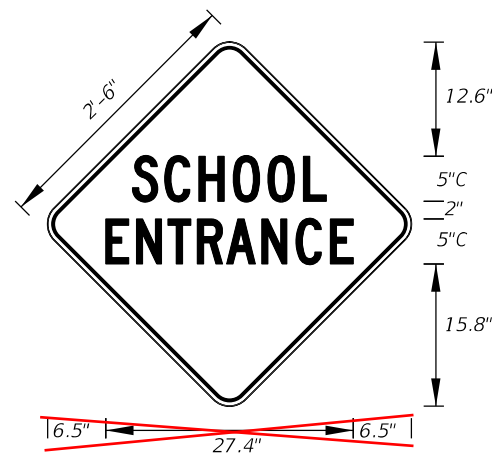
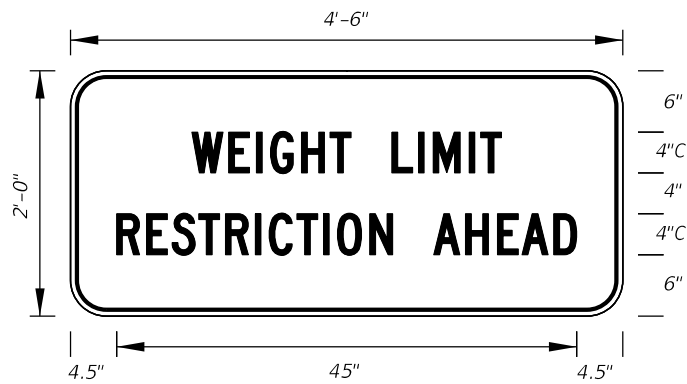
FTP-036-25
3'-0" X 1'-6"
1.5" Radii 0.5" Border

3" Series C Legend and
White Background
Black Legend and Border

FTP-037-25
3'-0" X 1'-0"
1.5" Radii 0.4" Border

4" Series C Legend
Fluorescent Yellow Green
Background
Black Legend and Border

DELETED SINGS: These signs are in the MUCTD







FTP-200-25
4'-6" X 2'-0"
1.5" Radii 3/4" Border
4" Series C Legend
Yellow Background
Black Legend and Border

FTP-201-25
2'-6" X 2'-6"
1.5" Radii 3/4" Border
5" Series C Legend
Fluorescent Yellow-Green
Background
Black Legend and Border

FTP-202-25
3'-0" X 3'-0"
1.5" Radii 3/4" Border
5" Series D Legend
Yellow Background
Black Legend and Border

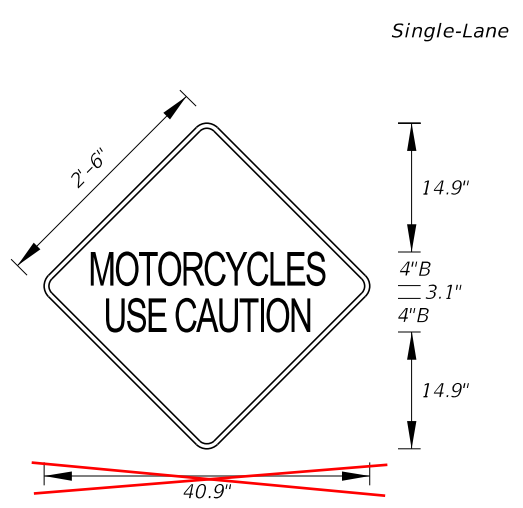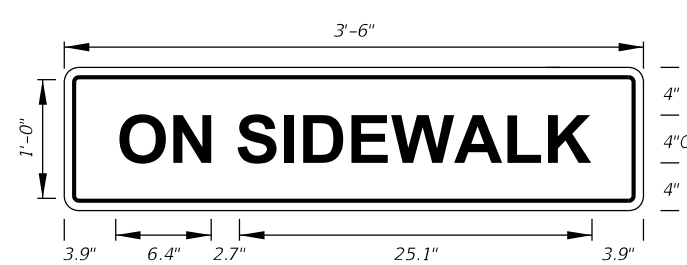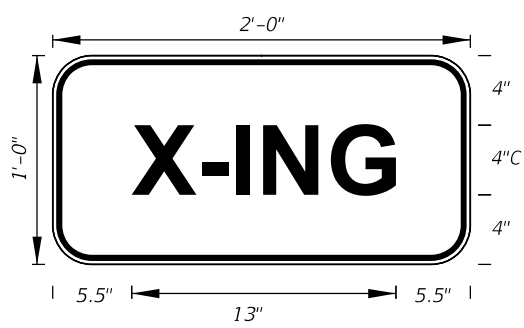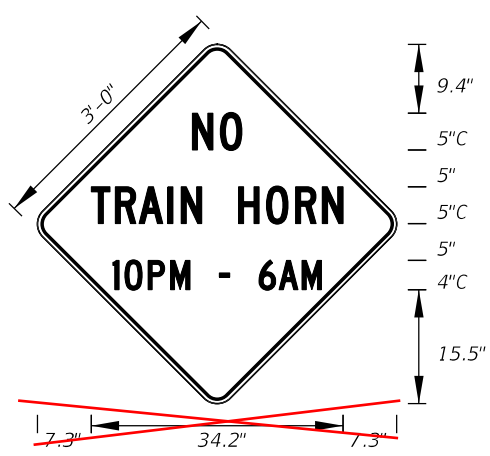FTP-203-25
3'-0" X 2'-0"
1.5" Radii 3/4" Border
4" and 3" Series C Legend
Yellow Background
Black Legend and Border





FTP-203A-25
3'-0" X 3'-0"
1.5" Radii 3/4" Border
4" and 5" Series C Legend
Yellow Background
Black Legend and Border

FTP-204-25
2'-0" X 1'-0"
1.5" Radii 3/4" Border
4" Series C Legend
Yellow Background
Black Legend and Border

FTP-205-25
3'-6" X 1'-0"
1.5" Radii 3/4" Border
4" Series C Legend
Yellow Background
Black Legend and Border

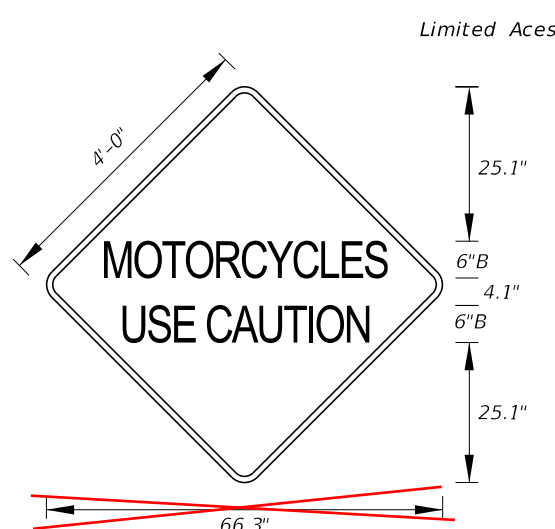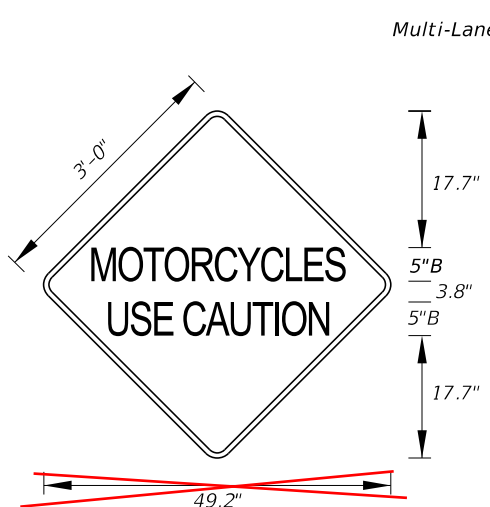FTP-206-25
2'-6" X 2'-6"
1.5" Radii 3/4" Border
4" Series B Legend
Yellow Background
Black Legend and Border



FTP-206A-25
3'-0" X 3'-0"
1.5" Radii 3/4" Border
5" Series B Legend
Yellow Background
Black Legend and Border

FTP-206B-25
4'-0" X 4'-0"
3" Radii 3/4" Border
6" Series B Legend
Yellow Background
Black Legend and Border

1/14/2026 7:16:13 AM

Non-Limited Access

FTP-207-25

3'-0" X 3'-0"

1.5" Radii 3/4" Border

5" Series C Legend

Yellow Background

Black Legend and Border

Limited Access

FTP-207A-25

4'-0" X 4'-0"

3" Radii 3/4" Border

6" Series D Legend

Yellow Background

Black Legend and Border

FTP-208-25

3'-0" X 3'-0"

1.5" Radii 3/4" Border

6" Series C Legend

Yellow Background

Black Legend and Border

FTP-208A-25

4'-0" X 4'-0"

1.5" Radii 3/4" Border

8" Series C Legend

Yellow Background

Black Legend and Border

LAST REVISION

11/01/25

DESCRIPTION:

11/01/26

FY 2026-27
STANDARD PLANS

SPECIAL SIGN DETAILS

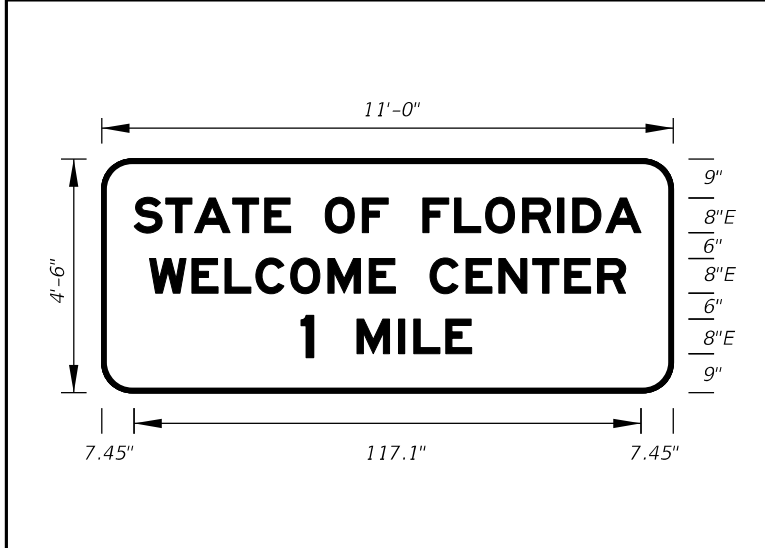
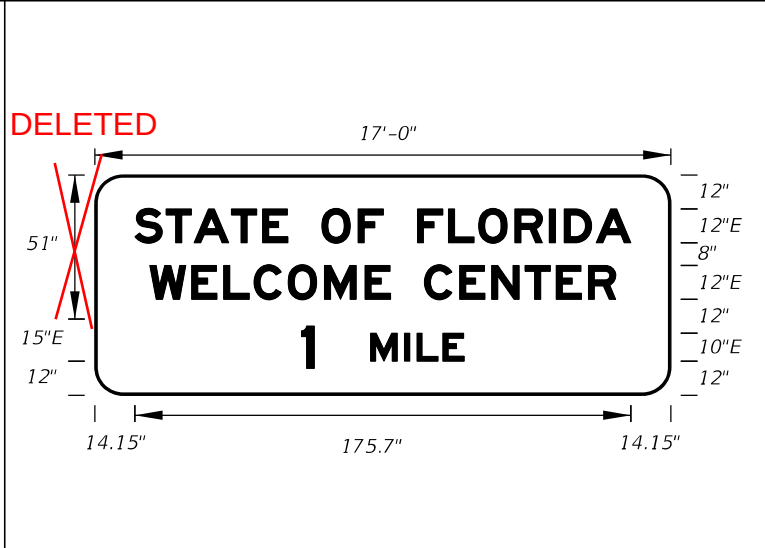
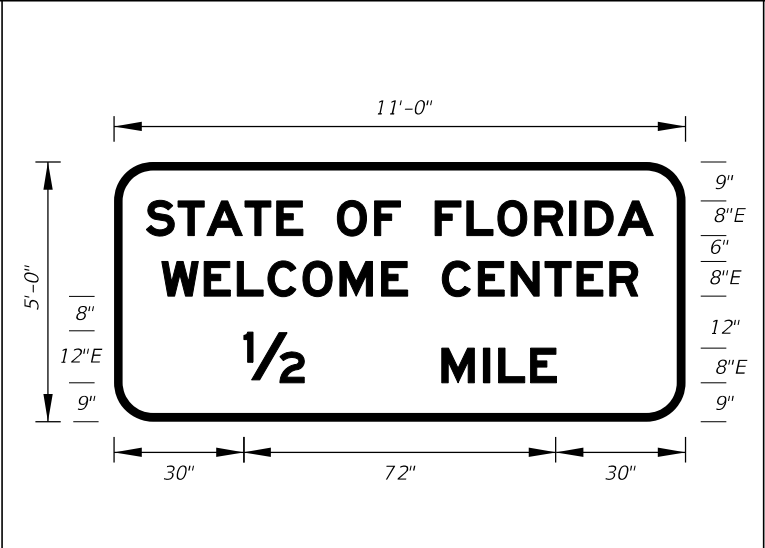
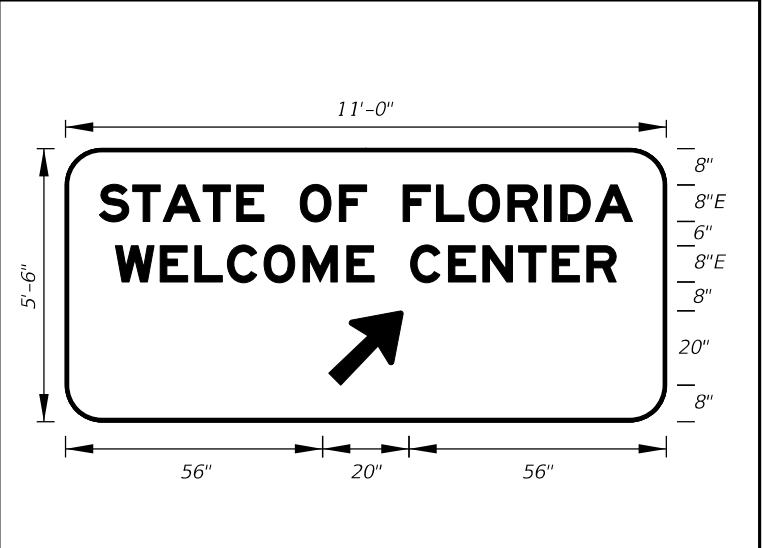
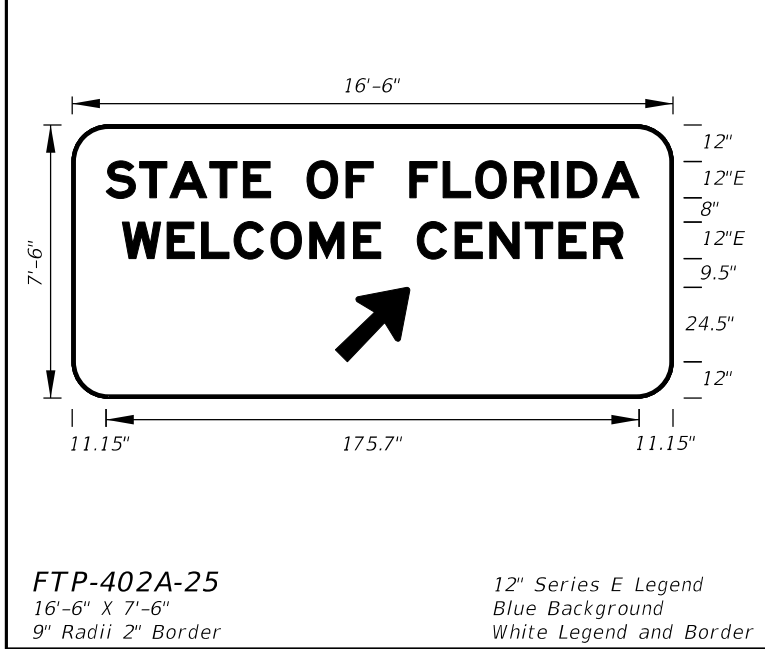
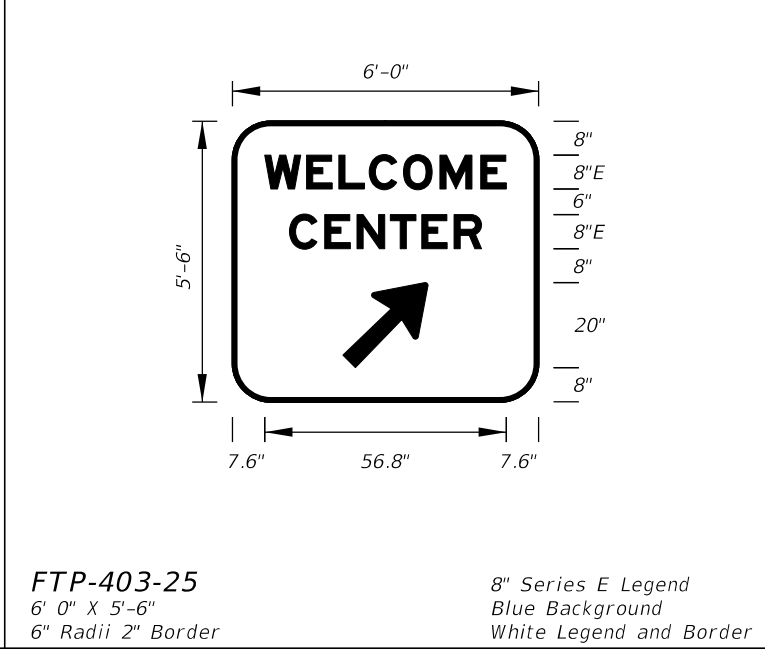
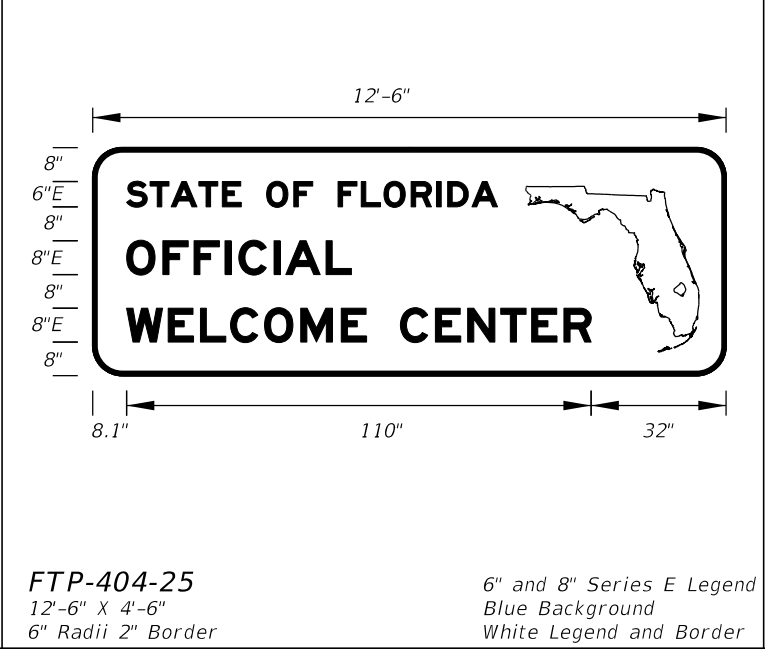
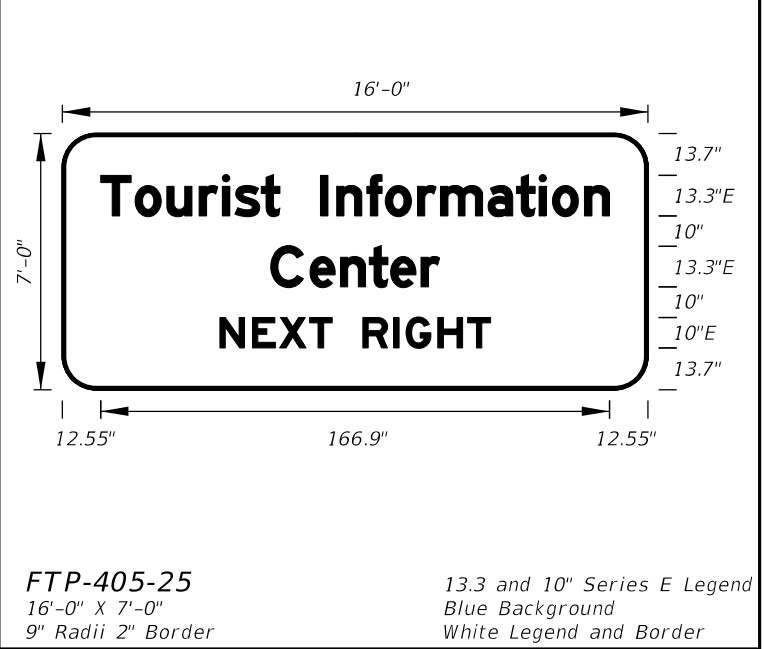
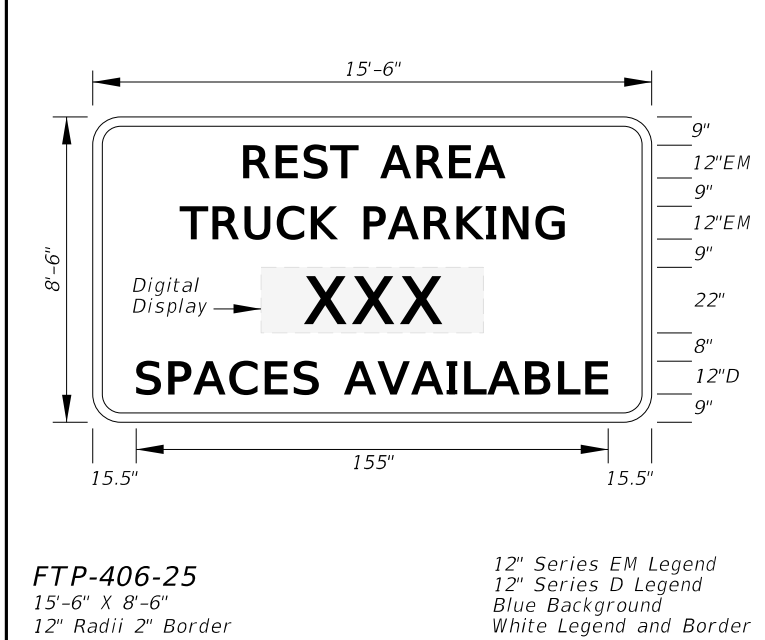
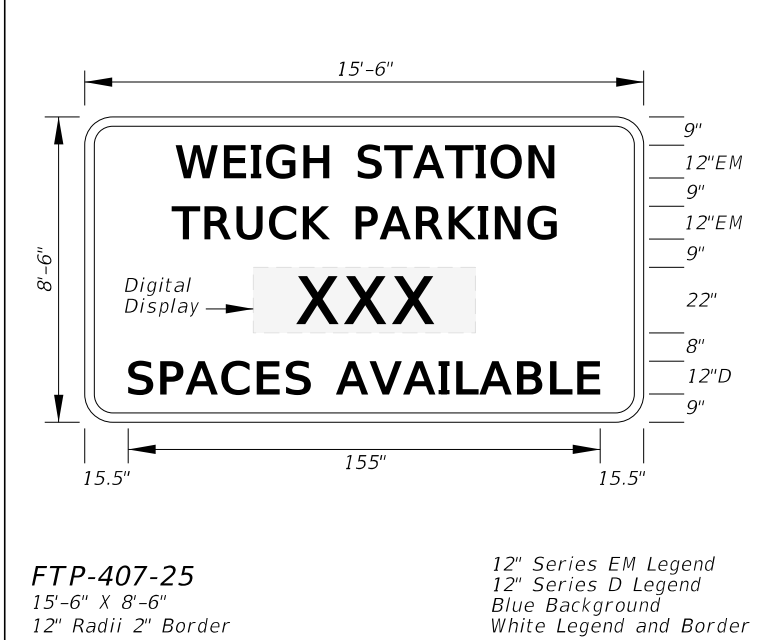
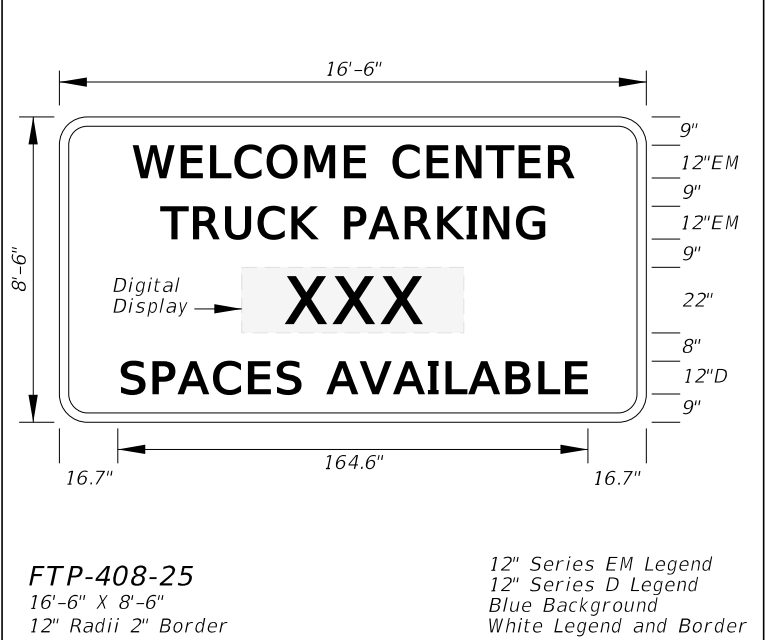
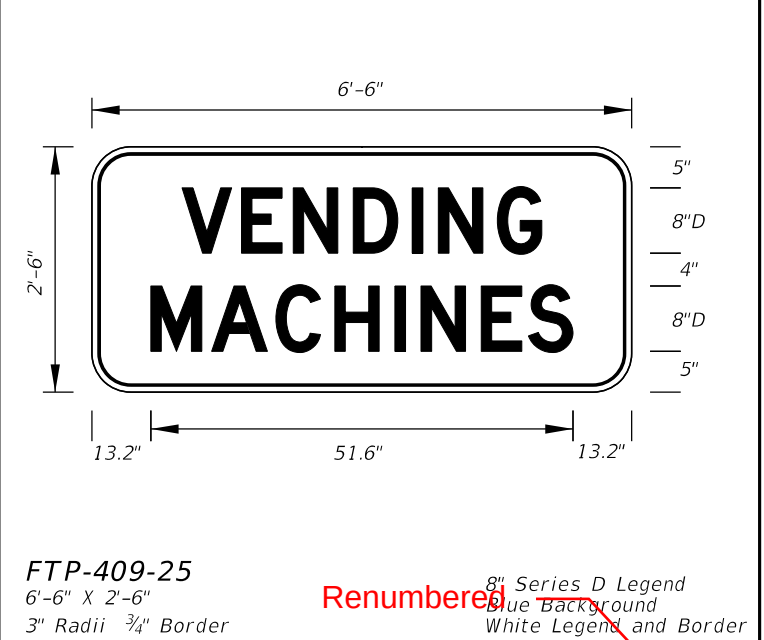
INDEX

700-102

SHEET

8 of 21

Renumbered


 FTP-400-25 11'-0" X 4'-6" 6" Radii 2" Border 8" Series E Legend Blue Background White Legend and Border		DELETED  FTP-400A-25 17'-0" X 6'-6" 9" Radii 2" Border 12", 10" and 15" Series E Legend Blue Background White Legend and Border		 FTP-401-25 11'-0" X 5'-0" 9" Radii 2" Border 8" and 12" Series E Legend Blue Background White Legend and Border		 FTP-402-25 11'-0" X 5'-6" 9" Radii 2" Border 8" Series E Legend Blue Background White Legend and Border	
 FTP-402A-25 16'-6" X 7'-6" 9" Radii 2" Border 12" Series E Legend Blue Background White Legend and Border		 FTP-403-25 6' 0" X 5'-6" 6" Radii 2" Border 8" Series E Legend Blue Background White Legend and Border		 FTP-404-25 12'-6" X 4'-6" 6" Radii 2" Border 6" and 8" Series E Legend Blue Background White Legend and Border		 FTP-405-25 16'-0" X 7'-0" 9" Radii 2" Border 13.3 and 10" Series E Legend Blue Background White Legend and Border	
 FTP-406-25 15'-6" X 8'-6" 12" Radii 2" Border 12" Series EM Legend 12" Series D Legend Blue Background White Legend and Border		 FTP-407-25 15'-6" X 8'-6" 12" Radii 2" Border 12" Series EM Legend 12" Series D Legend Blue Background White Legend and Border		 FTP-408-25 16'-6" X 8'-6" 12" Radii 2" Border 12" Series EM Legend 12" Series D Legend Blue Background White Legend and Border		 FTP-409-25 6'-6" X 2'-6" 3" Radii 3/4" Border 8" Series D Legend Blue Background White Legend and Border	
LAST REVISION 11/01/25 DESCRIPTION: 11/01/26		 FY 2026-27 STANDARD PLANS		SPECIAL SIGN DETAILS		INDEX 700-102	SHEET 9 of 21

1/14/2026 7:16:17 AM


1/14/2026 7:16:19 AM



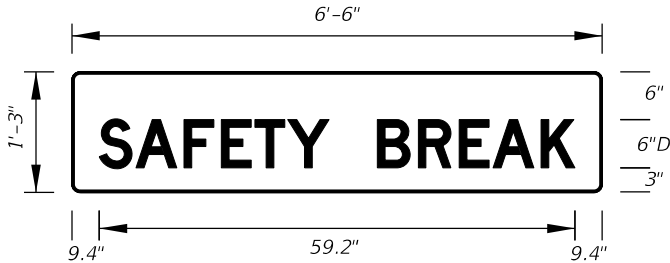
FTP-410-25
6'-6" X 2'-6"
3" Radii 3/4" Border
8" and 6" Series D Legend
Blue Background
White Legend and Border



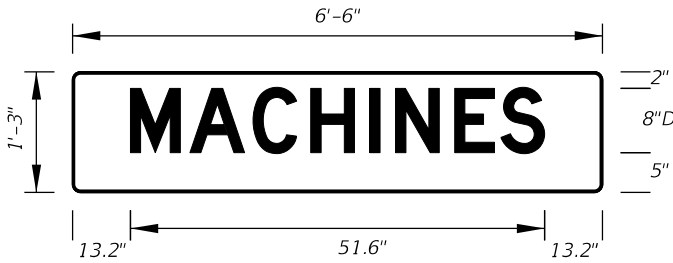FTP-411-25
6'-6" X 1'-3"
1.5" Radii
6" Series D Legend
Blue Background
White Legend



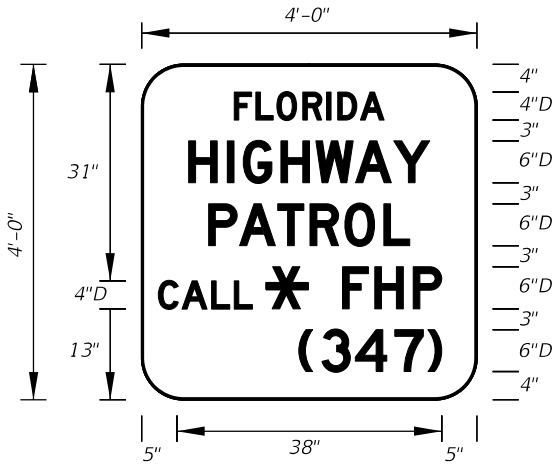FTP-412-25
6'-6" X 1'-3"
1.5" Radii
8" Series D Legend
Blue Background
White Legend



FTP-413-25
4'-0" X 4'-0"
3" Radii 1" Border
4" and 6" Series D Legend
Blue Background
White Legend and Border



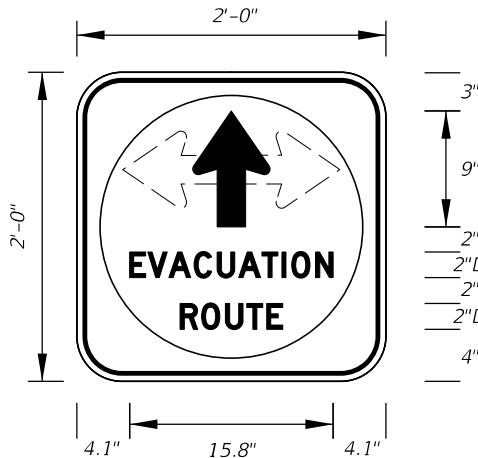
FTP-414-25
4'-0" X 5'-0"
3" Radii 1" Border
6" Series D Legend
Blue Background
White Legend and Border




FTP-414A-25
5'-6" X 6'-0"
3" Radii 1" Border
8" Series D Legend
Blue Background
White Legend and Border



DETAIL for FTP-414-25 AND FTP-414A-25



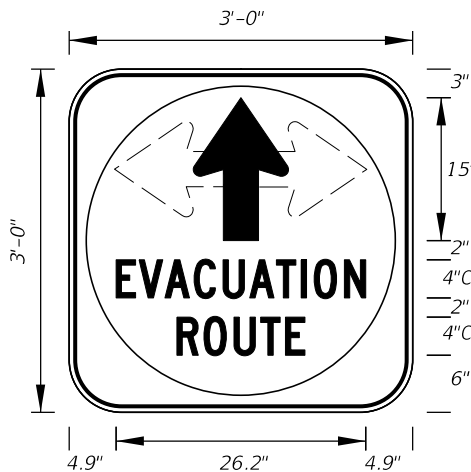FTP-415-25
2'-0" X 2'-0"
1.5" Radii 3/4" Border
2" Series D Legend
White Background with Blue Circle
Background
White Legend and Black Border



FTP-415A-25
3'-0" X 3'-0"
1.5" Radii 3/4" Border
4" Series C Legend
White Background with Blue Circle
Background
White Legend and Black Border

CHANGED TO: 1/2"

Renumbered




FY 2026-27
STANDARD PLANS

SPECIAL SIGN DETAILS

INDEX
700-102

SHEET
10 of 21

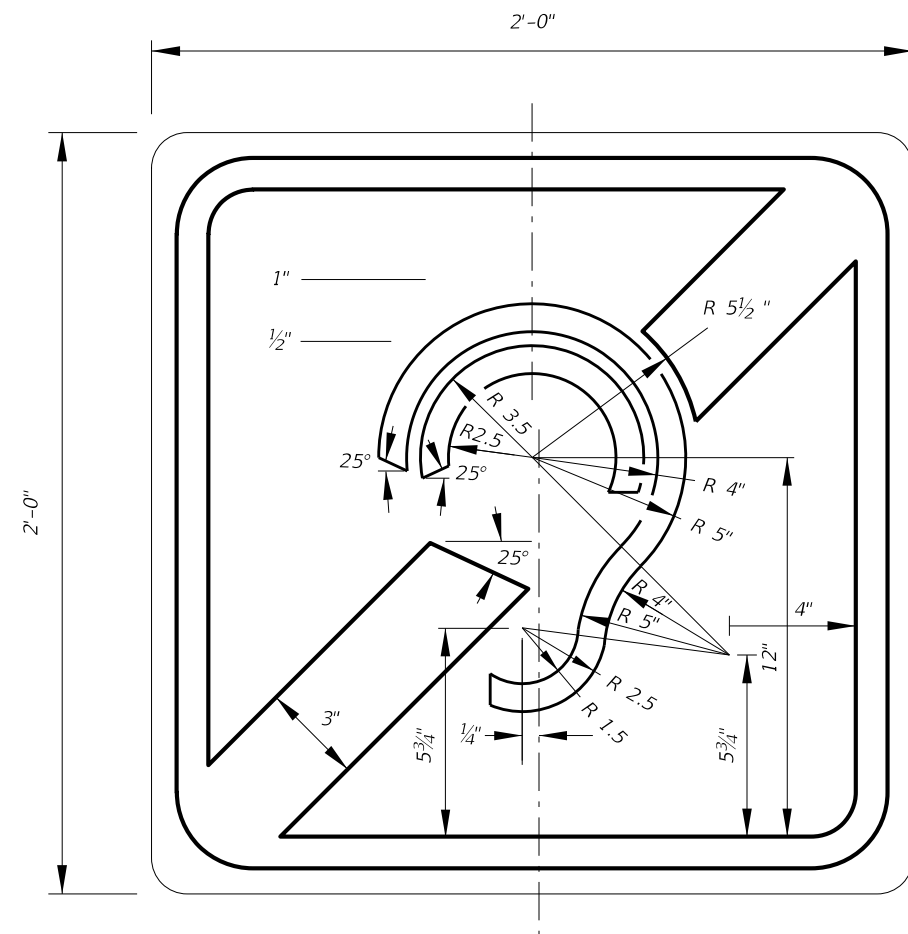LAST REVISION
11/01/25 11/01/26




FTP-416-25

2'-0" X 2'-0"
1.5" Radii $\frac{5}{8}$ " Border

INTERNATIONAL SYMBOL OF
ACCESS FOR HEARING LOSS

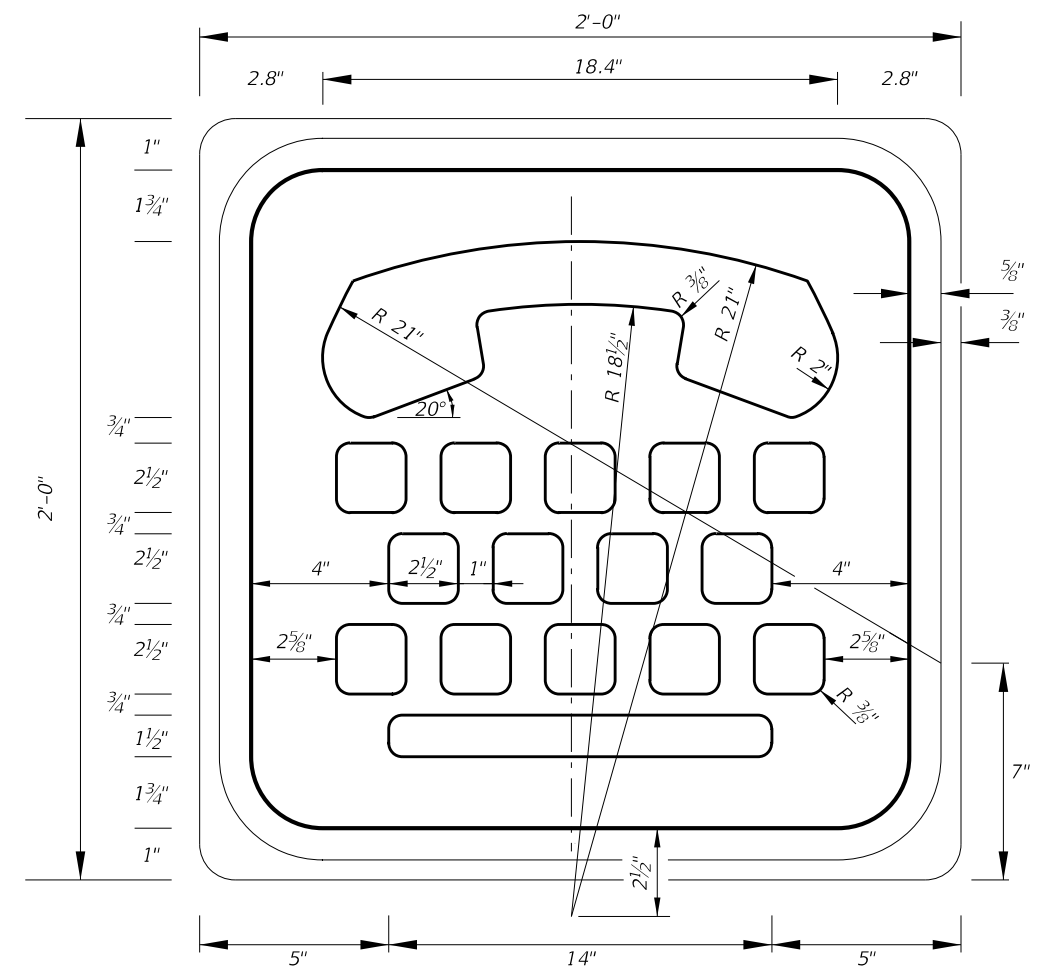Blue Background
White Legend and Border



FTP-417-25

2'-0" X 2'-0"
1.5" Radii $\frac{5}{8}$ " Border


INTERNATIONAL TDD SYMBOL

Blue Background
White Legend and Border


Non-Limited Access NOTE: Design Project Manager or Transit Administrator will supply correct 1-8XX number. FTP-418-25 3'-0" X 2'-0" 1.5" Radii 3/4" Border		Limited Access NOTE: Design Project Manager or Transit Administrator will supply correct 1-8XX number. FTP-418A-25 6'-6" X 4'-0" 3" Radii 3/4" Border		Non-Limited Access NOTE: Design Project Manager or Transit Administrator will supply correct 1-8XX number. FTP-419-25 3'-0" X 2'-0" 1.5" Radii 3/4" Border		Limited Access NOTE: Design Project Manager or Transit Administrator will supply correct 1-8XX number. FTP-419A-25 6'-6" X 4'-0" 3" Radii 3/4" Border			
Non-Limited Access NOTE: Design Project Manager or Transit Administrator will supply correct 1-8XX number. FTP-420-25 3'-0" X 2'-0" 1.5" Radii 3/4" Border		Limited Access NOTE: Design Project Manager or Transit Administrator will supply correct 1-8XX number. FTP-420A-25 6'-6" X 4'-0" 3" Radii 3/4" Border		Non-Limited Access FTP-421-25 3'-0" X 2'-6" 1.5" Radii 3/4" Border		Limited Access FTP-421A-25 6'-0" X 3'-6" 1.5" Radii 3/4" Border			
FTP-421B-25 12'-0" X 6'-0" 9" Radii 1.5" Border		FTP-422-25 2'-0" X 1'-6" 1.5" Radii 3/4" Border		FTP-422A-25 3'-0" X 2'-0" 1.5" Radii 3/4" Border		FTP-422B-25 3'-6" X 2'-6" 1.5" Radii 3/4" Border			
LAST REVISION 11/01/25		DESCRIPTION: 11/01/26		FY 2026-27 STANDARD PLANS		SPECIAL SIGN DETAILS		INDEX 700-102	SHEET 12 of 21

1/14/2026 7:16:23 AM

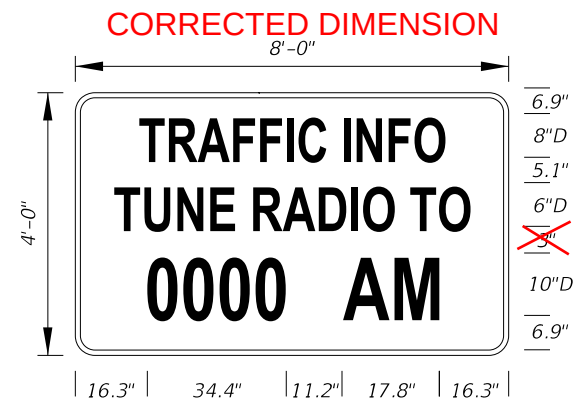1/14/2026 7:16:25 AM








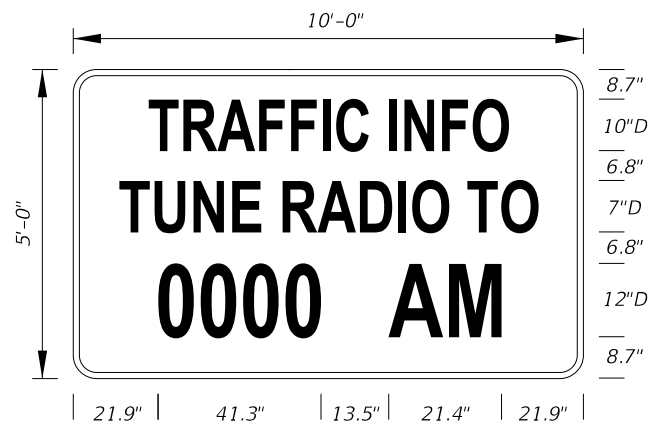
FTP-423-25
8'-0" X 4'-0"
3" Radii 3/4" Border
6", 8" and 10" Series D Legend
Blue Background
White Legend and Border




FTP-423A-25
10'-0" X 5'-0"
9" Radii 2" Border
7", 10" and 12" Series D Legend
Blue Background
White Legend and Border

LAST REVISION	DESCRIPTION:
11/01/25	11/01/26

Other Than Freeway Use FTP-600-25 4'-0" X 3'-6" 1.5" Radii 2" Border 6" Series E Legend Green Background White Legend and Border	Other Than Freeway Use DELETED FTP-601-25 14'-0" X 8'-0" 9" Radii 2" Border 12" and 10" Series E Legend Green Background White Legend and Border	Other Than Freeway Use FTP-602-25 4'-0" X 1'-6" 1.5" Radii 2" Border 6" Series E Legend Green Background White Legend and Border NOTE: FTP-602-25 to be used with FTP-600-25	Freeway Use FTP-602A-25 6'-6" X 2'-0" 1.5" Radii 2" Border 10" Series E Legend Green Background White Legend and Border NOTE: FTP-620A-25 to be used with FTP-604R-25
FTP-603R-25 FTP-603L-25 14'-6" X 7'-0" 9" Radii 2" Border 10" Series E Legend Green Background White Legend and Border NOTE: Use FTP-603L-25 for "LEFT ARROW".	FTP-604R-25 FTP-604L-25 12'-0" X 7'-0" 9" Radii 2" Border 10" Series E Legend Green Background White Legend and Border NOTE: Use FTP-604L-25 for "NEXT LEFT".	FTP-605R-25 FTP-605L-25 10'-0" X 5'-0" 9" Radii 2" Border 10" Series E Legend Green Background White Legend and Border NOTE: Use FTP-605L-25 for "LEFT ARROW".	FTP-606-25 3'-0" X 3'-0" 1.5" Radii 2" Border 4" Series D Legend Green Background White Legend and Border
FTP-607-25 3'-6" X 5'-0" 1.5" Radii 2" Border 4" Series C Legend Green Background White Legend, Border and Symbol	FTP-608-25 3'-6" X 5'-6" 3" Radii 2" Border 4" Series C Legend Green Background Municipality Name Optional White Legend, Border and Symbol	Detail for FTP-607-25 and FTP-608-25	FTP-609-25 1'-6" X 5'-0" 1.5" Radii 3/4" Border 6" and 8" Series B, 6" Series C Legend Green Background White Legend and Border TOP: 6" and 8" Series B, 6" Series C Legend Green Background White Legend and Border Bottom: 8" Series C Legend Green Background White Legend and Border Renumbered

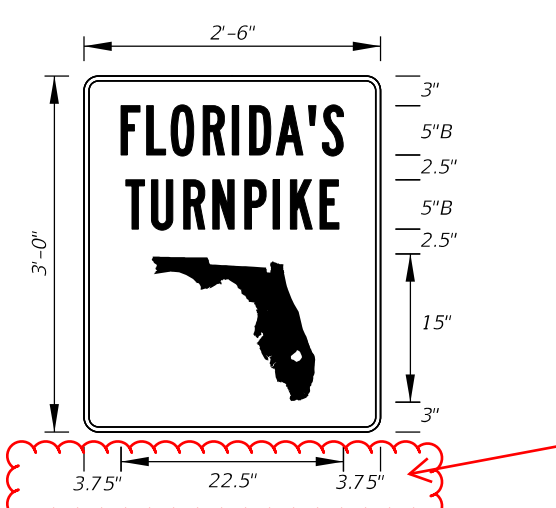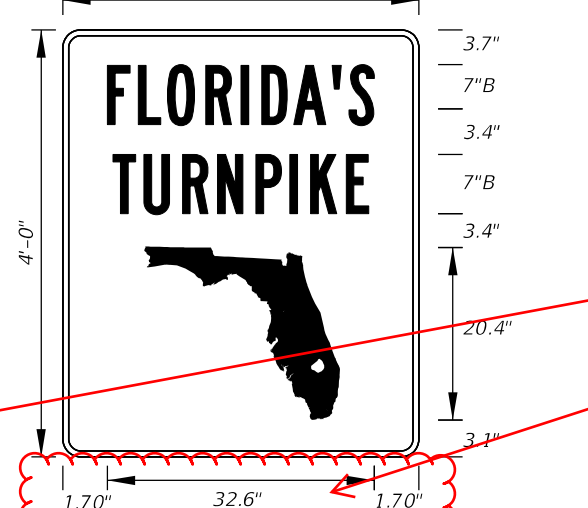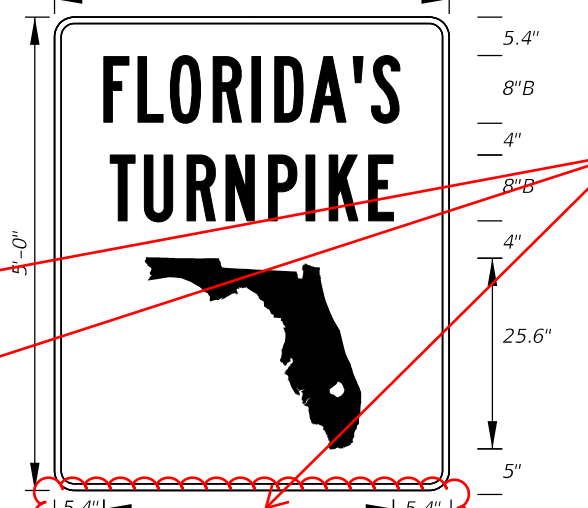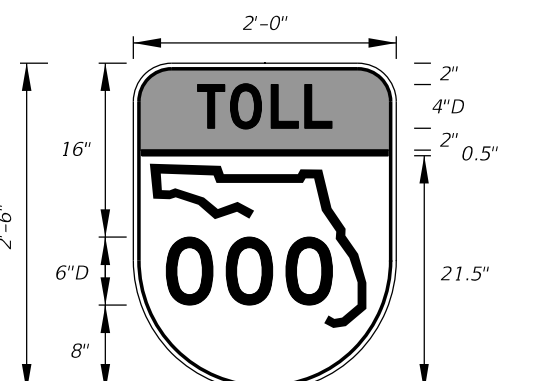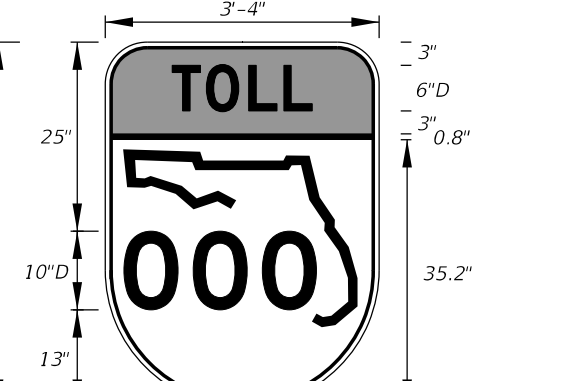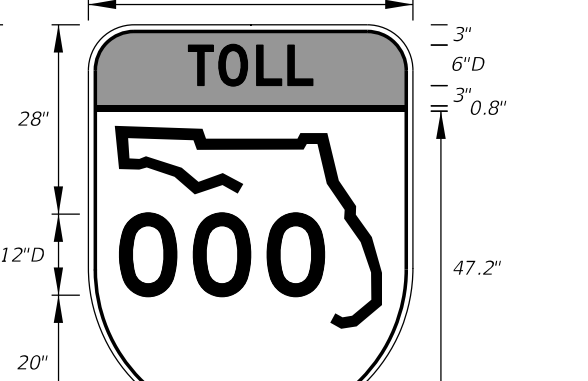 FTP-610-25 2'-6" X 3'-0" 1.5" Radii 3/4" Border	 FTP-610A-25 3'-4" X 4'-0" 1.5" Radii 3/4" Border	 FTP-610B-25 4'-0" X 5'-0" 3" Radii 1 1/4" Border	CORRECTED DIMENSIONS
 FTP-611-25 2'-0" X 2'-6" 1.5" Radii 3/4" Border	 FTP-611A-25 3'-4" X 4'-0" 3" Radii 3/4" Border	 FTP-611B-25 4'-0" X 5'-0" 3" Radii 3/4" Border	
LAST REVISION: 11/01/25 DESCRIPTION: 11/01/26	FDOT FY 2026-27 STANDARD PLANS	SPECIAL SIGN DETAILS	INDEX: 700-102 SHEET: 15 of 21

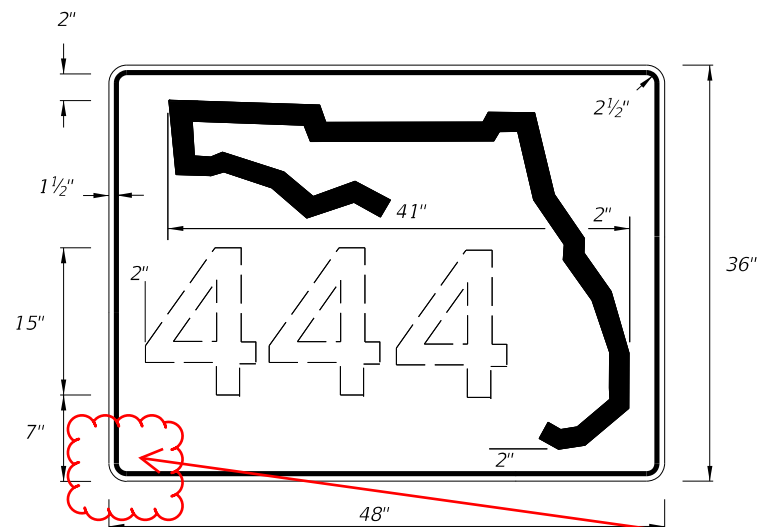Renumbered




DIGITS	NUMERAL SIZE	SERIES LEGEND	PANEL SIZE
1-3	15"	C	48" x 36"
4	12"	C	48" x 36"

NOTES:

- Stroke width of State Outline shall be 1"
- ~~2 1/2" Radii~~


ADDED: Dimension to the Detail

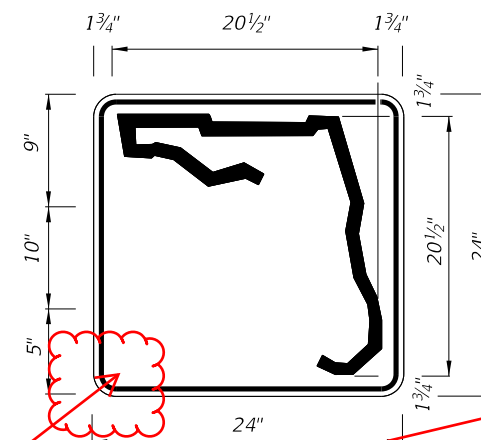DELETED: Dimension from the Note



1 or 2 DIGITS

DIGITS	NUMERAL SIZE	SERIES LEGEND	PANEL SIZE
1-2	10"	D	24" x 24"

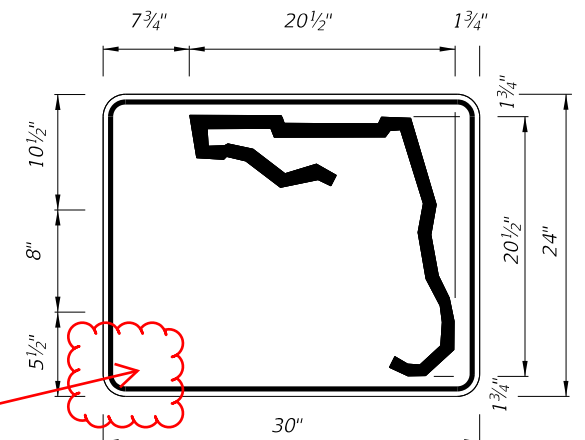


3 or 4 DIGITS

DIGITS	NUMERAL SIZE	SERIES LEGEND	PANEL SIZE
3	8"	D	30" x 24"
4	8"	C	30" x 24"

NOTES:

- Stroke width of State Outline shall be 1".
- The 24" X 24" panel shall only be used for a 3 digit route when the panel is to be used on a sign cluster with other 24" X 24" panels.
- ~~1 1/2" Radii~~

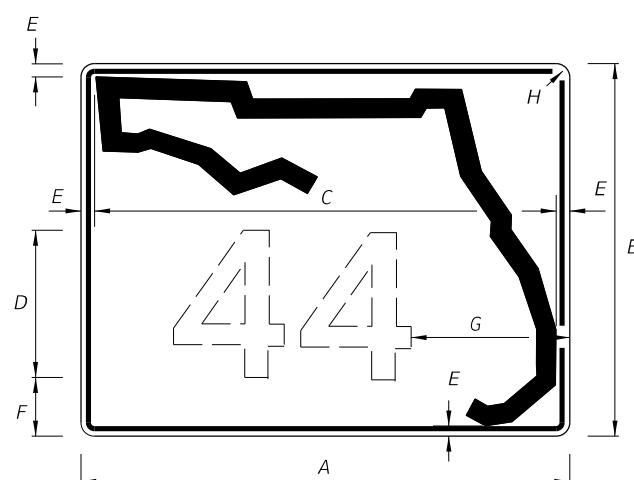INDEPENDENT USE FOR FREEWAY




1 OR 2 DIGITS

UPDATED NOTES

NOTES:

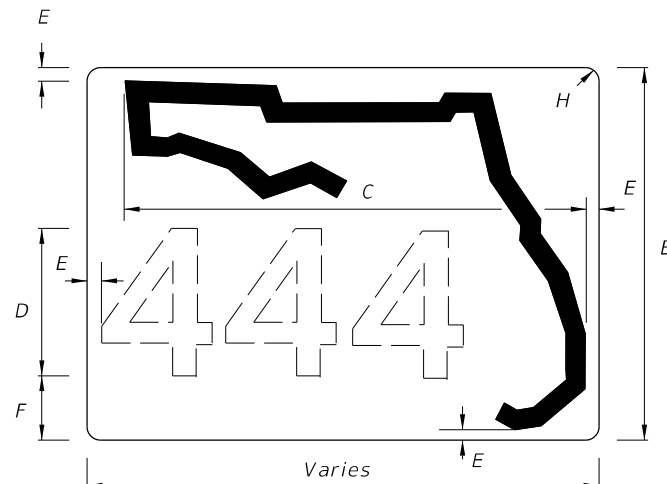- Florida marker shall have Black Legend with White Background.
- Stroke width of State outline shall be 1 3/4" for Guide Sign.
- Series D Legend.
- Width varies with the number scheme combination, within a range of 48"-58".



3 OR MORE DIGITS

A	B	C	D	E	F	G	H
30"	24"	26"	12"	1 1/4"	2 3/4"	8 1/4"	1 1/4"
36"	30"	32"	15"	1 1/4"	3 1/4"	8 3/4"	1 1/4"
42"	36"	38"	15"	1 1/4"	6 1/4"	11"	1 1/4"

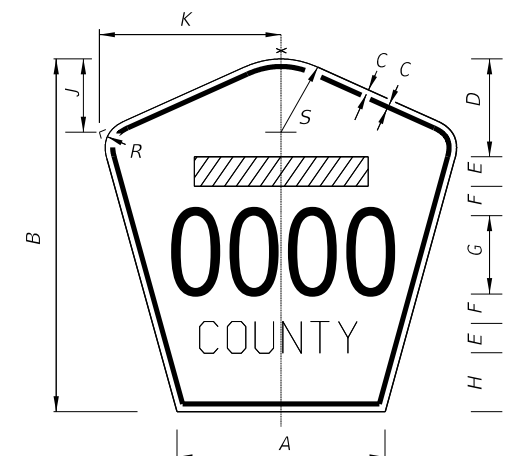
GUIDE SIGN USE

FTP-612-25 - FLORIDA ROUTE MARKER

INDEPENDENT USE OTHER THAN FREEWAY

NOTES:

- Series D Legend, all upper case.
- Color: Yellow Legend and Border on Blue Background.
- When used on a guide sign, marker must be overlaid on a square Yellow Background as shown in chart.
- When two or more County Route Markers are mounted together, use the dimensions of the largest marker for all other markers.






SIGN	DIMENSIONS												Rectangular Yellow Background Dimensions (See Note 3)
	A	B	C	D	E	F	G	H	I	J	K	L	
4 DIGIT POST MOUNTED	25 1/8"	42"	3/4"	10"	4"	4"	8"	8"	8 3/8"	22"	5"	8 3/4"	
2 DIGIT OVERHEAD	21 1/2"	36"	1/2"	7 1/2"	3"	3"	12"	4 1/2"	7 1/8"	18 7/8"	4 1/4"	7 1/2"	42"x 42"
3 DIGIT OVERHEAD	25 1/8"	42"	3/4"	8"	4"	4"	12"	6"	8 3/8"	22"	5"	8 3/4"	48"x 48"
4 DIGIT OVERHEAD	29 7/8"	48"	3/4"	8"	5"	5"	12"	8"	9 3/4"	25 5/8"	5 3/4"	10 1/4"	52"x 52"

FTP-613-25 - COUNTY ROUTE MARKER (M1-6)

Renumbered

Non-Limited Access FTP-614-25 2'-0" X 2'-0" 1.5" Radii $\frac{3}{4}$" Border Green Background White Legend, Border and Symbol	Limited Access FTP-614A-25 2'-6" X 2'-6" 1.5" Radii $\frac{3}{4}$" Border Green Background White Legend, Border and Symbol	Non-Limited Access FTP-615-25 2'-0" X 2'-0" 1.5" Radii $\frac{1}{2}$" Border Green Background White Legend, Border and Symbol	Limited Access FTP-615A-25 2'-6" X 2'-6" 1.5" Radii $\frac{3}{4}$" Border Green Background White Legend, Border and Symbol
--	---	--	---

Non-Limited Access FTP-616-25 2'-0" X 2'-0" 1.5" Radii $\frac{3}{4}$" Border Green Background White Legend, Border and Symbol	Limited Access FTP-616A-25 2'-6" X 2'-6" 1.5" Radii $\frac{3}{4}$" Border Green Background White Legend, Border and Symbol	← CHANGED DIMENSION TO: 3/4"
--	---	-------------------------------------

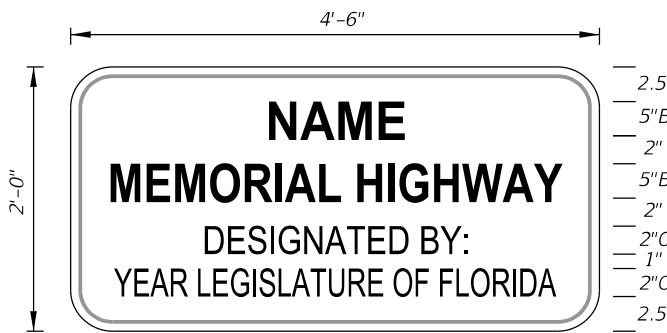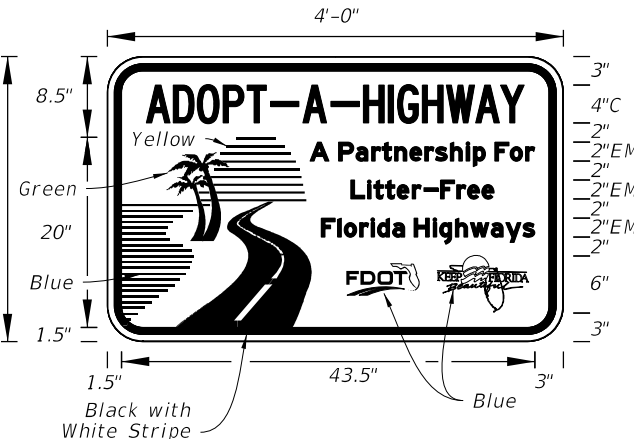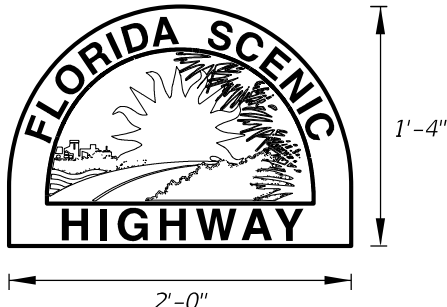 FTP-800-25 4'-6" X 2'-0" 1.5" Radii 1/2" Border 5" Series B Legend 2" Series C Legned Brown Background Yellow Legend and Border	 FTP-800A-25 4'-6" X 2'-6" 1.5" Radii 1/2" Border 5" Series B Legend 2" Series C Legned Brown Background Yellow Legend and Border	 FTP-801-25 4'-0" X 2'-6" 1.5" Radii 3/4" Border 4" Series C Legend and 2" Series EM Legend White Background Blue Legend and Border	 FTP-802-25 2'-0" X 1'-4" NOTE: To be installed with Co-location of route Confirmation Marker.
---	---	--	---


 FTP-802A-25 3'-0" X 2'-0" NOTE: Install at the Florida Scenic Highway Entrance Points.

Renumbered


1/14/2026 7:16:37 AM

TTC-001-25 4'-0" X 4'-0" 3" Radii 3/4" Border DELETED 8" Series C Legend Orange Background Black Legend and Border	TTC-002-25 4'-0" X 4'-0" 3" Radii 3/4" Border DELETED 8" Series C Legend Orange Background Black Legend and Border	TTC-003-25 4'-0" X 4'-0" 3" Radii 3/4" Border DELETED 7" Series C Legend Orange Background Black Legend and Border	TTC-003A-25 5'-0" X 5'-0" 3" Radii 3/4" Border DELETED 8" Series D Legend Orange Background Black Legend and Border
TTC-004-25 5'-0" X 5'-0" 3" Radii 3/4" Border DELETED 7" Series D Legend Orange Background Black Legend and Border	TTC-005-25 5'-0" X 5'-0" 3" Radii 3/4" Border DELETED 7" Series D Legend Orange Background Black Legend and Border	TTC-006-25 5'-0" X 5'-0" 3" Radii 3/4" Border DELETED 7" Series D Legend Orange Background Black Legend and Border	TTC-007-25 4'-0" X 4'-0" 3" Radii 3/4" Border DELETED 7" Series C Legend Orange Background Black Legend and Border
TTC-008-25 4'-0" X 4'-0" 3" Radii 3/4" Border DELETED 6" Series C Legend Orange Background Black Legend and Border	TTC-009-25 4'-0" X 4'-0" 3" Radii 3/4" Border DELETED 6" Series D Legend Orange Background Black Legend and Border	TTC-010-25 4'-0" X 4'-0" 3" Radii 3/4" Border DELETED 6" Series D Legend Orange Background Black Legend and Border	Renumbered


TTC-011-25 Arterial Sign 4'-6" X 3'-0" 1.5" Radii 3/4" Border 4" Series C Legend White Background Black Legend and Border	TTC-011A-25 Freeway Sign 6'-0" X 4'-0" 3" Radii 3/4" Border 6" Series C Legend White Background Black Legend and Border	TTC-012-25 4'-6" X 2'-6" 3" Radii 3/4" Border 5" Kids Series Legend Orange Background Black Legend and Border	TTC-013-25 4'-6" X 2'-6" 3" Radii 3/4" Border 5" Kids Series Legend Orange Background Black Legend and Border		
TTC-014-25 2'-0" X 2'-6" 1.5" Radii 3/4" Border 4" Series C Legend White Background Red Legend and Border	TTC-015-25 1'-6" X 1'-0" 1.5" Radii 1/4" Border 3" Series B Legend Orange Background Black Legend and Border	TTC-016R-25 TTC-016L-25 3'-0" X 2'-0" 1.5" Radii 3/4" Border 6" Series B Legend Blue Background White Legend and Border NOTE: Use TTC-016L-25 for "LEFT ARROW".	TTC-017R-25 TTC-017L-25 2'-0" X 1'-0" 1.5" Radii 3/4" Border 2" Series B Legend White Background Black Legend and Border NOTE: Use TTC-017L-25 for "LEFT ARROW".		
TTC-018-25 2'-0" X 1'-6" 1.5" Radii 1/2" Border 3" Series D Legend Orange Background Black Legend and Border	CORRECTED DIMENSION Renumbered				
LAST REVISION 11/01/25 11/01/26	FDOT FY 2026-27 STANDARD PLANS	SPECIAL SIGN DETAILS		INDEX 700-102	SHEET 20 of 21

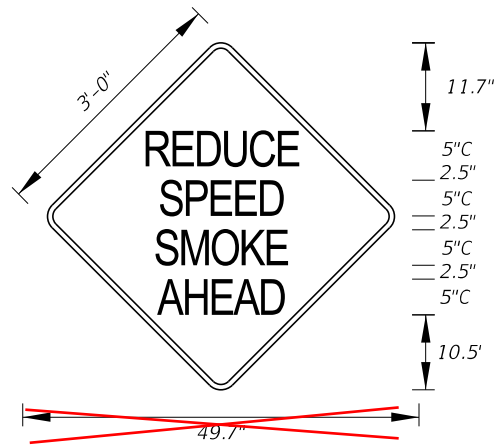

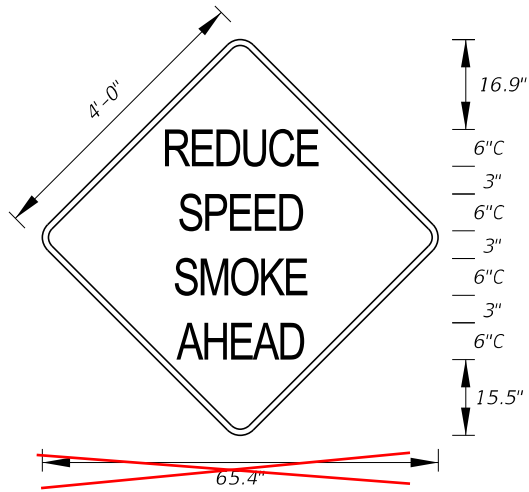
TTC-019-25
3'-0" x 3'-0"
1.5" Radii $\frac{3}{4}$ " Border
5" Series C Legend
Pink Background
Black Legend and Border



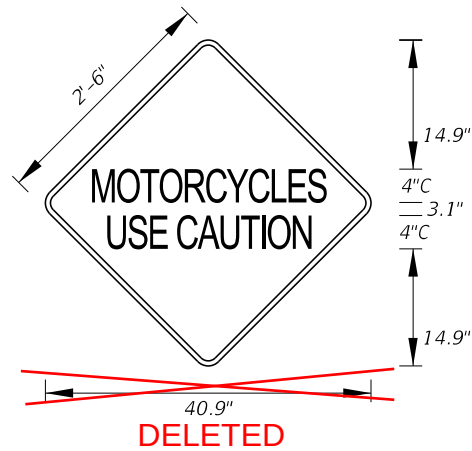
TTC-019A-25
4'-0" x 4'-0"
3" Radii $\frac{3}{4}$ " Border
6" Series C Legend
Pink Background
Black Legend and Border



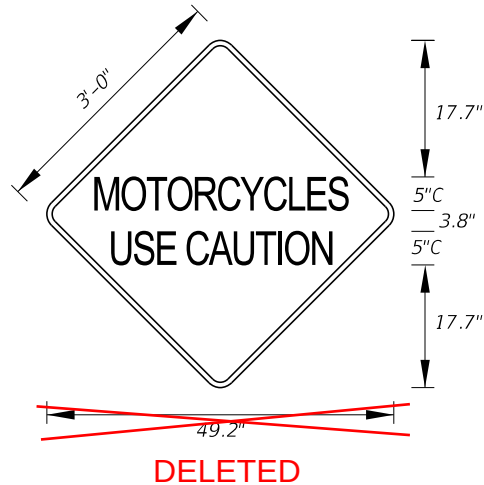TTC-020-25
2'-6" x 2'-6"
1.5" Radii $\frac{3}{4}$ " Border
4" Series C Legend
Pink Background
Black Legend and Border



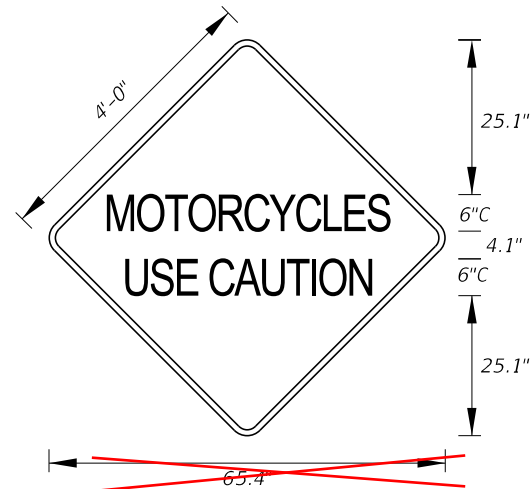TTC-020A-25
3'-0" x 3'-0"
1.5" Radii $\frac{3}{4}$ " Border
5" Series C Legend
Pink Background
Black Legend and Border



TTC-020B-25
4'-0" x 4'-0"
1.5" Radii $\frac{3}{4}$ " Border
6" Series C Legend
Pink Background
Black Legend and Border

Renumbered

NEW SHEET 22

AET-001-26 Through AET-002A-26

NEW SHEET 23

TOL-001-26 Through TOL-011-26

NEW SHEET 24

TOL-012-26 Through TOL-020-26

NEW SHEET 25

TOL-021-26 Through TOL-024B-26

NEW SHEET 26

TOL-025-26 Through TOL-033-26

NEW SHEET 27

TOL-034-26 Through TOL-044-26

NEW SHEET 28

TOL-045-26 Through TOL-051-26

NEW SHEET 29

SUNPASS Shield, Toll Attendant Shield, EPASS Shield, Additional Shields

GENERAL NOTES:

- 1. Sign dimensions are shown in width by height (W x H) throughout the Index.
- 2. See APPENDIX for previous sign numbering crosswalk.
- 3. Center text within the sign horizontally unless otherwise noted.

NUMBERING CONVENTION:

FTP-AAA B/C-DD or TTC-AAA B/C-DD

- AAA = Sign Type
- B = Size Adjustments to Smallest Available Sign Size (A,B,C)
- C = Left or Right (L or R)
- DD = Year of update

- Example 1: Size Adjustment - FTP-001A-25
- Example 2: Direction Application - FTP-103R-25
- Example 3: Size and Direction - FTP-037AR-25

SIGN TYPES (AAA):

- FTP-001-199: Regulatory
- FTP-200-399: Warning & Advisory
- FTP-400-599: Motorist Service
- FTP-600-799: Guide
- FTP-800-899: Recreational & Cultural
- FTP-900-999: Miscellaneous
- TTC-001-199: Temporary Traffic Control
- AET-001-199: All Electronic Tolling
- TOL-001-199: Toll Road

TABLE OF CONTENTS:

Sheet	Description
1	General Notes and Table of Contents
2	Sign Details FTP-001-25 through FTP-007B-25
3	Sign Details FTP-008-25 through FTP-018-25
4	Sign Details FTP-019-25 through FTP-026-25
5	Sign Details FTP-027-25 through FTP-034U-25
6	Sign Details FTP-035L-25 through FTP-037-25
7	Sign Details FTP-200-25 through FTP-206B-25
8	Sign Details FTP-207-25 through FTP-208A-25
9	Sign Details FTP-400-25 through FTP-409-25
10	Sign Details FTP-410-25 through FTP-415A-25
11	Sign Details FTP-416-25 through FTP-417-25
12	Sign Details FTP-418-25 through FTP-422B-25
13	Sign Details FTP-423-25 through FTP-423A-25
14	Sign Details FTP-600-25 through FTP-609-25
15	Sign Details FTP-610-25 through FTP-611B-25
16	Sign Details FTP-612-25 through FTP-613-25
17	Sign Details FTP-614-25 through FTP-616A-25
18	Sign Details FTP-800-25 through FTP-802A-25
19	Sign Details TTC-001-25 through TTC-010-25
20	Sign Details TTC-011-25 through TTC-018-25
21	Sign Details TTC-019-25 through TTC-020B-25
22	Sign Details AET-001-26 through AET-002A1-26
23	Sign Details TOL-001-26 through TOL-011-26
24	Sign Details TOL-012-26 through TOL-020-26
25	Sign Details TOL-021-26 through TOL-024B-26
26	Sign Details TOL-025-26 through TOL-033-26
27	Sign Details TOL-034-26 through TOL-043B-26
28	Sign Details TOL-044-26 through TOL-052A-26
29	Sunpass Shield, Toll Attendant Shield, Epass Shield, and Additions Shields














8/12/2026 11:24:36 AM

OTHER THAN FREEWAY USE		FREEWAY USE			
FTP-001-25 7'-0" X 3'-6" 3" Radii 1" Border		FTP-001A-25 11'-6" X 5'-6" 9" Radii 2" Border		FTP-002R-25 FTP-002L-25 14'-6" X 7'-6" 9" Radii 2" Border	
6" Series E Legend White Background Black Legend and Border		10" Series E Legend White Background Black Legend and Border		10" Series E Legend White Background Black Legend and Border	
				NOTES: 1. Use FTP-002L-25 for "NEXT LEFT". 2. On Interstate Station, delete PICKUPS-VANS, and reduce sign height accordingly.	
FTP-003-25 3'-6" X 2'-0" 1.5" Radii 3/4" Border		FTP-004-25 4'-0" X 3'-0" 1.5" Radii 3/4" Border			
4" Series E Legend White Background Black Legend and Border		FTP-004A-25 9'-0" X 6'-0" 9" Radii 3/4" Border		FTP-005-25 2'-0" X 2'-6" 1.5" Radii 5/8" Border	
		8" Series D Legend White Background Black Legend and Border		2" Series D Legend White Background - Green Florida Symbol Black Legend, Border and Man Belt Symbol	
FTP-006-25 4'-0" X 4'-0" 1.5" Radii 0.4" Border		FTP-007-25 4'-0" X 2'-0" 1.5" Radii 0.8" Border		FTP-007A-25 6'-6" X 3'-0" 3" Radii 1" Border	
2.5" Series C Legend 2" Series C Legend 1.5" Series C Legend White Background Black Legend and Border		NON-LIMITED ACCESS		NON-LIMITED ACCESS	
		NON-LIMITED ACCESS		NON-LIMITED ACCESS	
				TOP: 8" Series D Legend Yellow Background Black Legend and Border BOTTOM: 8" Series D Legend White Background Black Legend and Border	
LAST REVISION 11/01/26		DESCRIPTION:			
REVISION		FY 2027-28 STANDARD PLANS		SPECIAL SIGN DETAILS	
		INDEX		SHEET	
		700-102		2 of 29	

8/12/2026 11:24:38 AM

15'-0" 8'-6" 6'-0" 2'-6" FLORIDA LAW MOVE OVER FOR STOPPED EMERGENCY VEHICLES 10.9" 10.7"E 8.4" 8.4" 16"E 8" 10.7"E 8" 10.7"E 10.8" FTP-008-25 15'-0" X 8'-6" 9" Radii 1.5" Border TOP: 10.7" Series E Legend Yellow Background Black Legend and Border BOTTOM: 10.7" and 16" Series E Legend White Background Black Legend and Border		13'-0" 5'-6" 3'-6" 2'-0" TWO - AXLE VEHICLES ONLY BUSES ALLOWED 7.3" 10.7"E 8" 10.7"E 5.3" 6.1" 10.7"E 7.2" FTP-009-25 13'-0" X 5'-6" 6" Radii 1" Border TOP: 10.7" Series E Legend White Background Black Legend and Border BOTTOM: 10.7" Series E Legend Black Background White Legend		2'-6" 2'-6" 2'-6" EMERGENCY STOPPING SITE 2.05" 25.9" 2.05" 6" 4"C 3" 4"C 3" 4"C 6" FTP-010-25 2'-6" X 2'-6" 1.5" Radii 0.625" Border 4" Series C Legend White Background Black Legend and Border		2'-6" 3'-0" EMERGENCY STOPPING SITE 1 MILE 2.05" 25.9" 2.05" 5.5" 4"C 3" 4"C 3" 4"C 3" 4"C 5.5" FTP-011-25 2'-6" X 3'-0" 1.5" Radii ¾" Border 4" Series C Legend White Background Black Legend and Border	
2'-6" 3'-0" 3'-0" EMERGENCY STOPPING SITE X MILES 2.05" 25.9" 2.05" 5.5" 4"C 3" 4"C 3" 4"C 3" 4"C 5.5" FTP-012-25 2'-6" X 3'-0" 1.5" Radii ¾" Border 4" Series C Legend White Background Black Legend and Border		3'-0" 1'-6" 1'-6" OFFICIAL USE ONLY 4.6" 26.8" 4.6" 3.5" 4"D 3" 4"D 3.5" FTP-013-25 3'-0" X 1'-6" 1.5" Radii ¾" Border 4" Series D Legend White Background Black Legend and Border		2'-0" 1'-0" 1'-0" GROOVED 2.1" 19.8" 2.1" 4" 4"C 4" FTP-014-25 2'-0" X 1'-0" 1.5" Radii ⅝" Border 4" Series C Legend Yellow Background Black Legend and Border		2'-6" 3'-0" FLORIDA LITTER LAW \$150 MIN FINE FOR LITTERING 3.1" 23.8" 3.1" 5" 2" C 4" 4"C 4" 4"C 4" 4"C 5" FTP-015-25 2'-6"X 3'-0" 1.5" Radii ¾" Border 2" and 4" Series C Legend White Background Black Legend and Border	
3'-6" 4'-0" 4'-0" FLORIDA LITTER LAW \$150 MIN FINE FOR LITTERING 3.15" 35.7" 3.15" 6" 3"C 5" 6"C 5" 6"C 5" 6"C 6" FTP-015A-25 3'-6" X 4'-0" 1.5" Radii ¾" Border 3" and 6" Series C Legend White Background Black Legend and Border		1'-0" 1'-6" 1'-6" 24 HOUR PARKING 1.4" 9.2" 1.4" 2.5" 4"C 1.2" 2"C 1.2" 2"C 1.2" 1.5" 2.4" FTP-016-25 1'-0" X 1'-6" 1.5" Radii ⅜" Border 4" Series D and 2" Series C Legend White Background Green Legend and Border		1'-0" 1'-6" 1'-6" PARKING BY DISABLED PERMIT ONLY 1.5" 6" 1" 1" 1"C 1" 1"C 1" 1" 1"C 1.5" TOP: Blue Background White Border BOTTOM: 1" Series C Legend White Background Black Legend and Border FTP-017-25 1'-0" X 1'-6" 1.5" Radii ⅜" Border		1'-6" 1'-6" 1'-6" FLORIDA LITTER LAW \$150 MIN FINE FOR LITTERING 3.

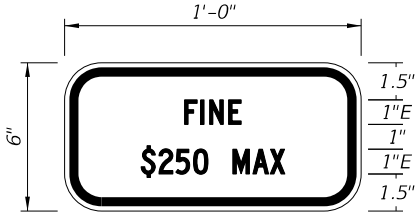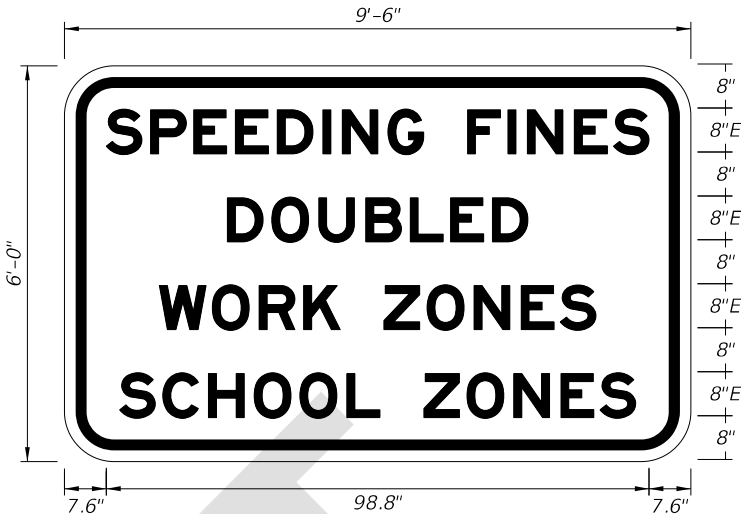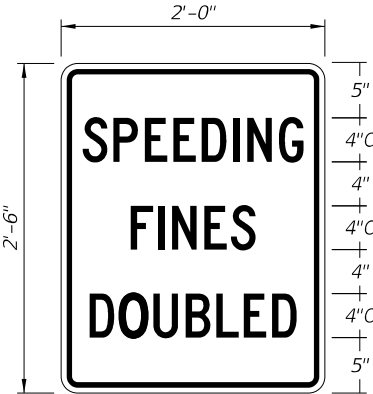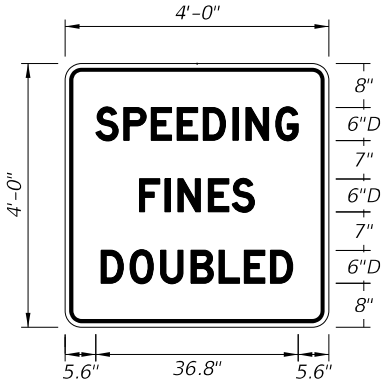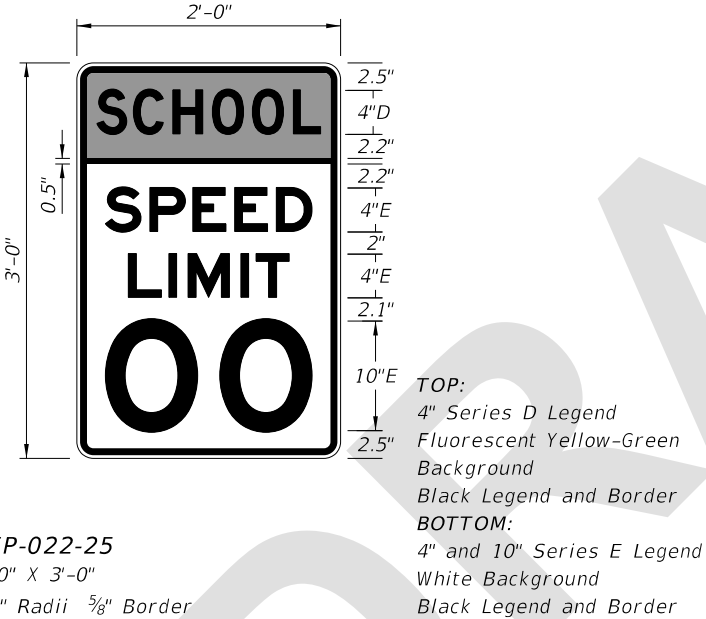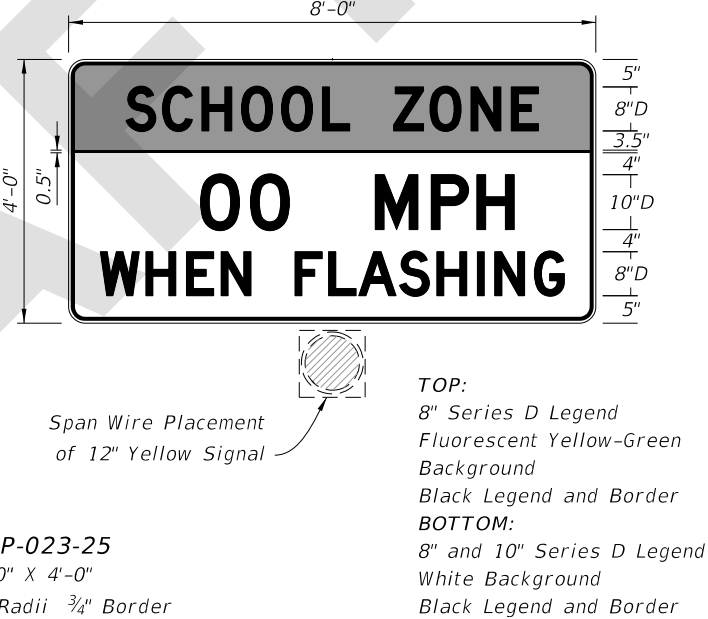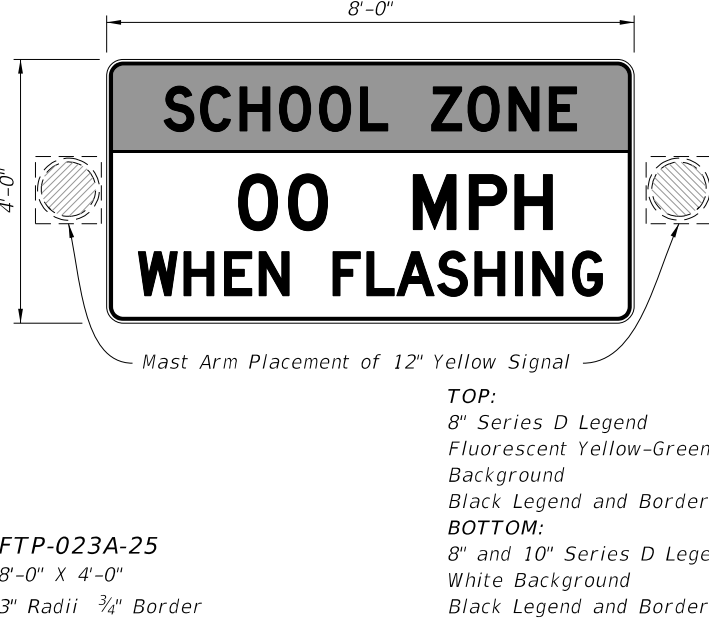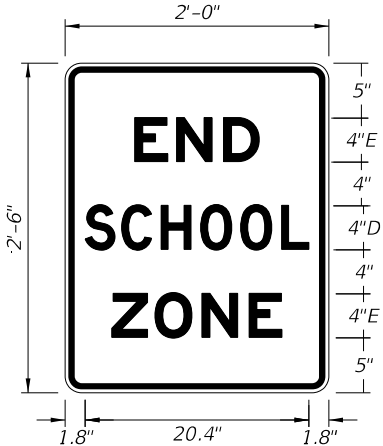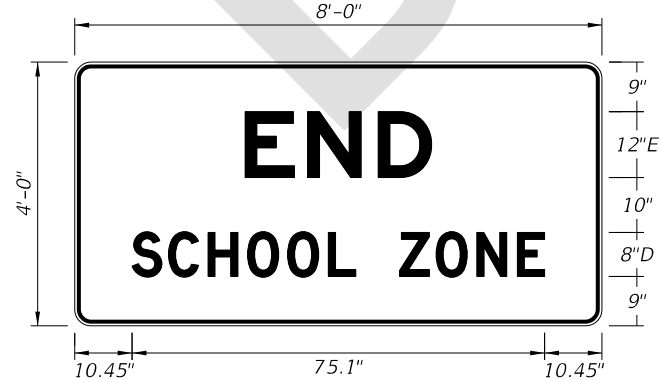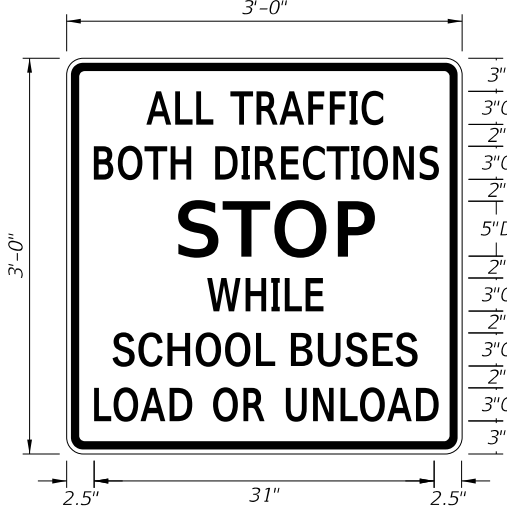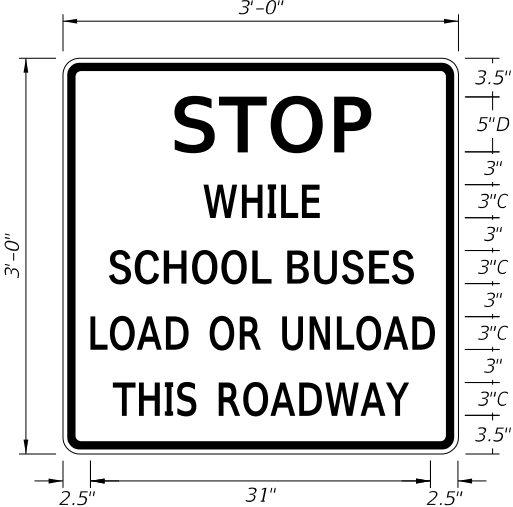8/12/2026 11:24:40 AM

 NOTE: Supplemental Panel for the FTP-017-25 sign. FTP-019-25 1'-0" X 6" 1.5" Radii $\frac{3}{8}$" Border 1" Series E Legend White Background Black Legend and Border		 NOTE: Supplemental Panel for the FTP-018-25 sign. FTP-019A-25 1'-6" X 9" 1.5" Radii $\frac{3}{8}$" Border 2" Series D Legend White Background Black Legend and Border		 FTP-020-25 9'-6" X 6'-0" 9" Radii 2" Border 8" Series E Legend White Background Black Legend and Border		 FTP-021-25 2'-0" X 2'-6" 1.5" Radii $\frac{1}{2}$" Border 4" Series C Legend White Background Black Legend and Border	
 FTP-021A-25 4'-0" X 4'-0" 3" Radii $\frac{3}{4}$" Border 6" Series D Legend White Background Black Legend and Border		 FTP-022-25 2'-0" X 3'-0" 1.5" Radii $\frac{5}{8}$" Border TOP: 4" Series D Legend Fluorescent Yellow-Green Background Black Legend and Border BOTTOM: 4" and 10" Series E Legend White Background Black Legend and Border		 FTP-023-25 8'-0" X 4'-0" 3" Radii $\frac{3}{4}$" Border TOP: 8" Series D Legend Fluorescent Yellow-Green Background Black Legend and Border BOTTOM: 8" and 10" Series D Legend White Background Black Legend and Border		 FTP-023A-25 8'-0" X 4'-0" 3" Radii $\frac{3}{4}$" Border TOP: 8" Series D Legend Fluorescent Yellow-Green Background Black Legend and Border BOTTOM: 8" and 10" Series D Legend White Background Black Legend and Border	
 FTP-024-25 2'-0" X 2'-6" 1.5" Radii $\frac{5}{8}$" Border 4" Series D and E Legend White Background Black Legend and Border		 FTP-024A-25 8'-0" X 4'-0" 3" Radii $\frac{3}{4}$" Border 12" Series E and 8" Series D Legend White Background Black Legend and Border		 FTP-025-25 3'-0" X 3'-0" 1.5" Radii $\frac{3}{4}$" Border 3" Series C Legend and 5" Series D Legend White Background Black Legend and Border		 FTP-026-25 3'-0" X 3'-0" 1.5" Radii $\frac{3}{4}$" Border 3" Series C Legend 5" Series D Legend White Background Black Legend and Border	

LAST REVISION	DESCRIPTION:	FY 2027-28 STANDARD PLANS		SPECIAL SIGN DETAILS		INDEX	SHEET
11/01/26		FDOT				700-102	4 of 29

8/12/2026 11:24:42 AM

FTP-027-25
2'-6" X 3'-6"
1.5" Radii $\frac{3}{4}$ " Border

TOP:
3.5" Series D Legend
Flourescent Yellow
Background
Black Legend and Border
BOTTOM:
6" and 3" Series D Legend
White Background
Black Legend and Border

FTP-027A-25
4'-0" X 5'-0"
3" Radii $\frac{3}{4}$ " Border

TOP:
5" Series D Legend
Fluorescent Yellow Green
Background
Black Legend and Border
BOTTOM:
5" and 8" Series E Legend
White Background
Black Legend and Border

FTP-028-25
2'-6" X 3'-0"
1.5" Radii $\frac{3}{8}$ " Border

TOP:
4"Series C Legend
Yellow Background
Black Legend and Border
BOTTOM:
3.5" Series C Legend
White Background
Black Legend and Border

FTP-029-25
9" X 2'-3"
1.5" Radii No Border

1.5" Series D Legend and
1.2" and 1.3" Series C Legend
White on Yellow
Black Legend and Border

FTP-030-25
9" X 1'-0"
1.5" Radii $\frac{3}{8}$ " Border

1" Series D Legend
White Background
Black Legend and Border

NOTES:
1. Sign mounting holes can be punched or field drilled with no obstruction to text or symbols from holes or bolts.
2. See MUTCD R10-3f for Letter Size, Spacing, and Symbol Sizes and Color

FTP-031-25
9" X 1'-3"
1.5" Radii $\frac{1}{4}$ " Border

Series B Legend
White Background
Black Legend and Border

NOTES:
1. Sign mounting holes can be punched or field drilled with no obstruction to text or symbols from holes or bolts.
2. See MUTCD R10-3i for Letter Size, Spacing, and Symbol Sizes and Color

FTP-032-25
9" X 1'-6"
1.5" Radii $\frac{1}{4}$ " Border

Series B Legend
White Background
Black Legend and Border

FTP-033-25
9" X 1'-6"
1.5" Radii $\frac{1}{4}$ " Border

0.7", 0.8", and 1" Series D Legend
White Background
Black Legend and Border

FTP-034L-25
2'-0" X 2'-6"
1.5" Radii $\frac{3}{8}$ " Border

5" Series D Legend
White Background
Black Legend and Border

NOTE: Use FTP-034R-25 for RIGHT TURN ONLY

FTP-034AL-25
4'-0" X 5'-0"
3" Radii $\frac{3}{4}$ " Border


10" Series D Legend
White Background
Black Legend and Border










NOTE: Use FTP-034AR-25 for RIGHT TURN ONLY



FTP-034U-25
2'-0" X 3'-0"
1.5" Radii $\frac{3}{4}$ " Border
5" Series D Legend
White Background
Black Legend and Border

ARROW DIMENSIONS	
A	6.25"
B	3.125"
C	3.125"
D	3.125"
E	5"
F	9.25"
G	20.5"
H	3.125"
I	3.625"
J	6.375"
K	0.5"
L	0.625"

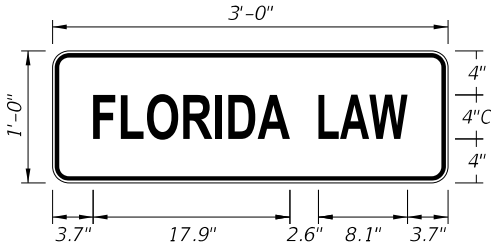DETAILS










 <i>FTP-036-25</i> 3'-0" X 1'-6" 1.5" Radii 0.5" Border 3" Series C Legend White Background Black Legend and Border		 <i>FTP-037-25</i> 3'-0" X 1'-0" 1.5" Radii 0.4" Border 4" Series C Legend Fluorescent Yellow Green Background Black Legend and Border		DRAFT								
<table><tr><th>LAST REVISION</th><th>DESCRIPTION:</th></tr><tr><td>11/01/26</td><td></td></tr></table>		LAST REVISION	DESCRIPTION:	11/01/26		 FY 2027-28 STANDARD PLANS		SPECIAL SIGN DETAILS			INDEX 700-102	SHEET 6 of 29
LAST REVISION	DESCRIPTION:											
11/01/26												

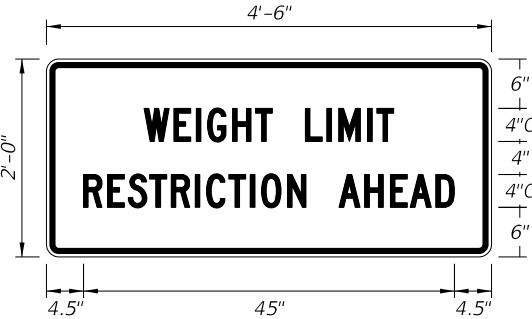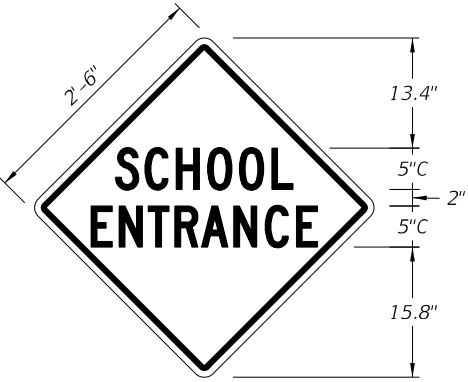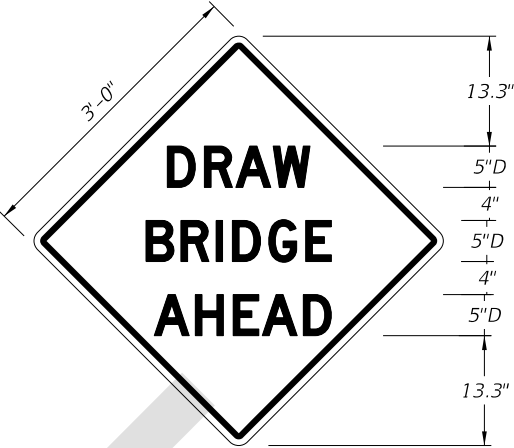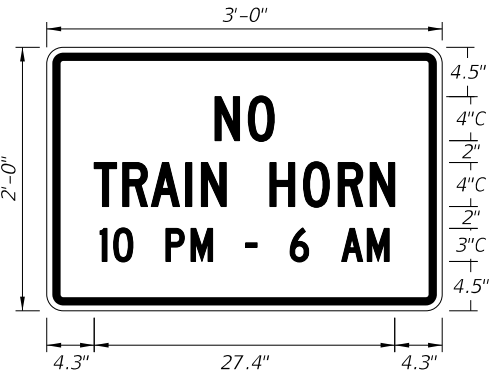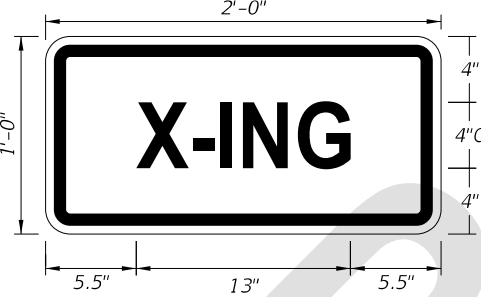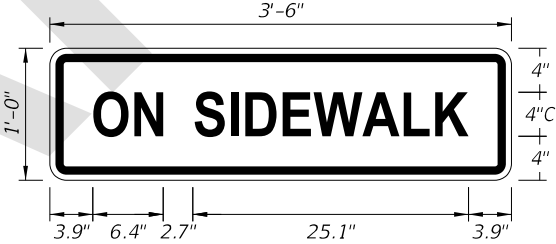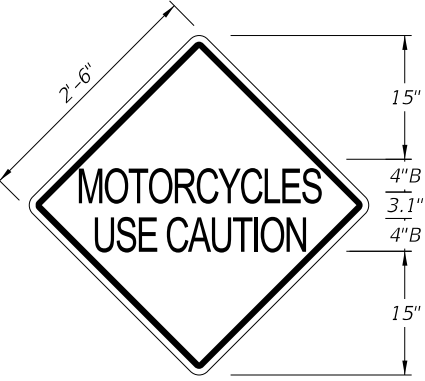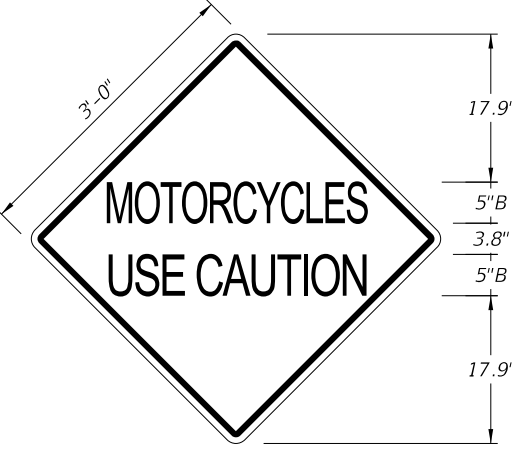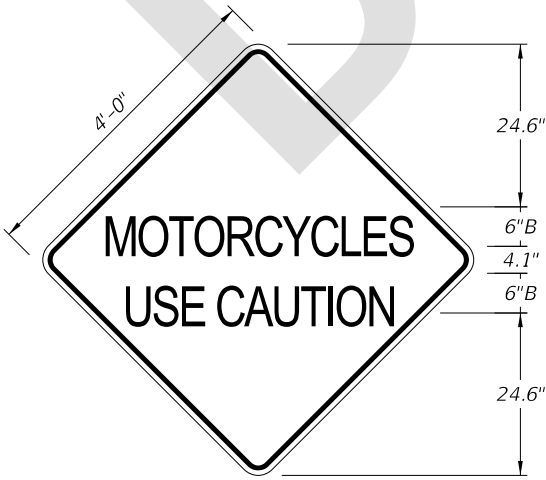 FTP-200-25 4'-6" X 2'-0" 1.5" Radii ¾" Border 4" Series C Legend Yellow Background Black Legend and Border	 FTP-201-25 2'-6" X 2'-6" 1.5" Radii ¾" Border 5" Series C Legend Fluorescent Yellow-Green Background Black Legend and Border	 FTP-202-25 3'-0" X 3'-0" 1.5" Radii ¾" Border 5" Series D Legend Yellow Background Black Legend and Border	 FTP-203-25 3'-0" X 2'-0" 1.5" Radii ¾" Border 4" and 3" Series C Legend Yellow Background Black Legend and Border
 FTP-203A-25 3'-0" X 3'-0" 1.5" Radii ¾" Border 4" and 5" Series C Legend Yellow Background Black Legend and Border	 FTP-204-25 2'-0" X 1'-0" 1.5" Radii ¾" Border 4" Series C Legend Yellow Background Black Legend and Border	 FTP-205-25 3'-6" X 1'-0" 1.5" Radii ¾" Border 4" Series C Legend Yellow Background Black Legend and Border	SINGLE-LANE  FTP-206-25 2'-6" X 2'-6" 1.5" Radii ¾" Border 4" Series B Legend Yellow Background Black Legend and Border
MULTI-LANE  FTP-206A-25 3'-0" X 3'-0" 1.5" Radii ¾" Border 5" Series B Legend Yellow Background Black Legend and Border	 FTP-206B-25 4'-0" X 4'-0" 3" Radii ¾" Border 6" Series B Legend Yellow Background Black Legend and Border		
LAST REVISION 11/01/26 REVISION DESCRIPTION:	FDOT FY 2027-28 STANDARD PLANS	SPECIAL SIGN DETAILS	INDEX 700-102 SHEET 7 of 29

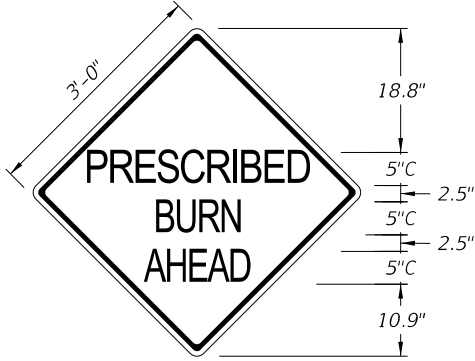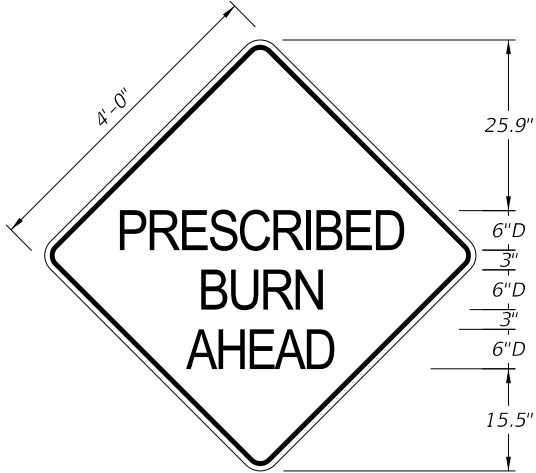NON-LIMITED ACCESS  FTP-207-25 3'-0" X 3'-0" 1.5" Radii $\frac{3}{4}$" Border 5" Series C Legend Yellow Background Black Legend and Border	LIMITED ACCESS  FTP-207A-25 4'-0" X 4'-0" 3" Radii $\frac{3}{4}$" Border 6" Series D Legend Yellow Background Black Legend and Border	 FTP-208-25 3'-0" X 3'-0" 3" Radii $\frac{3}{4}$" Border 6" Series C Legend Yellow Background Black Legend and Border	 FTP-208A-25 4'-0" X 4'-0" 1.5" Radii $\frac{3}{4}$" Border 8" Series C Legend Yellow Background Black Legend and Border
--	---	--	--



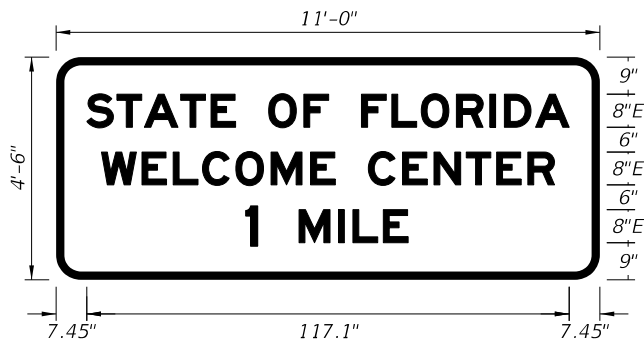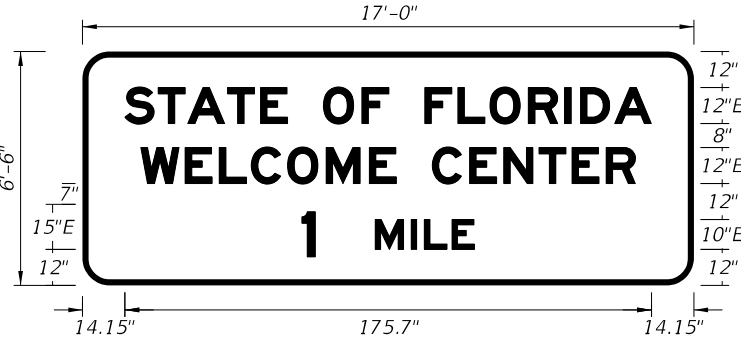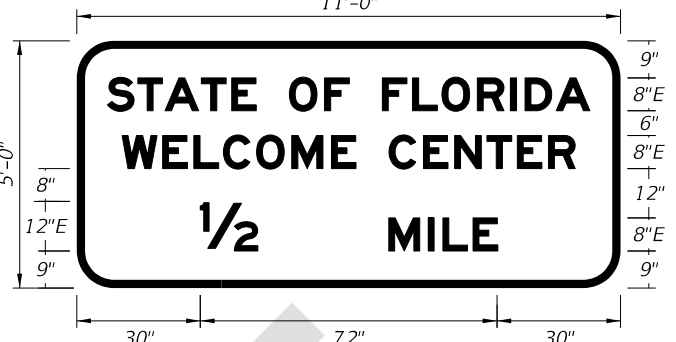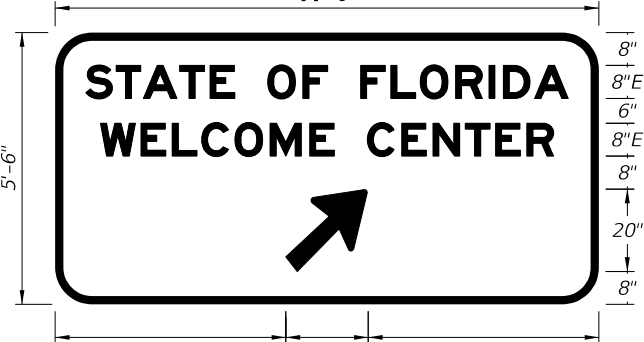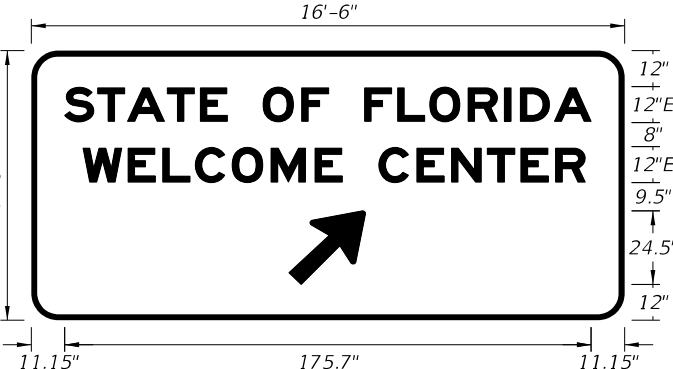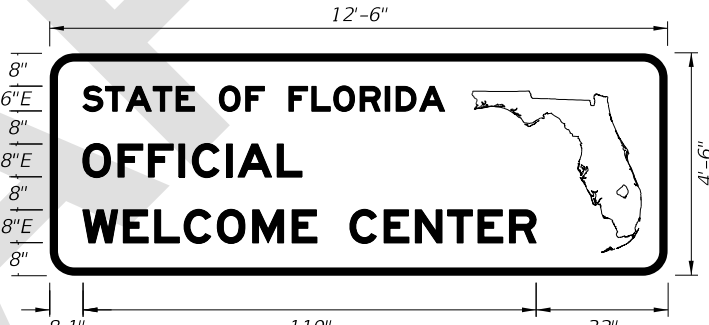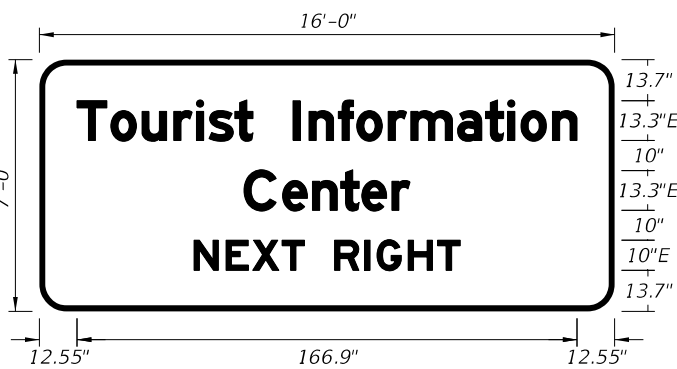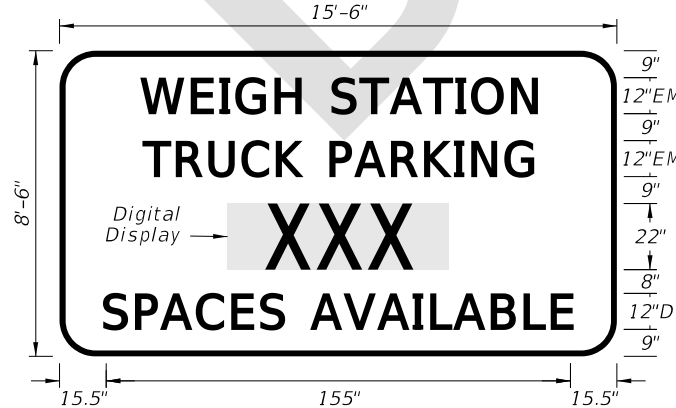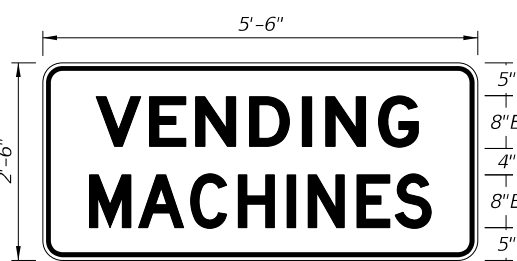8/12/2026 11:24:53 AM

 FTP-400-25 11'-0" X 4'-6" 6" Radii 2" Border 8" Series E Legend Blue Background White Legend and Border		 FTP-400A-25 17'-0" X 6'-6" 9" Radii 2" Border 10", 12" and 15" Series E Legend Blue Background White Legend and Border		 FTP-401-25 11'-0" X 5'-0" 9" Radii 2" Border 8" and 12" Series E Legend Blue Background White Legend and Border		 FTP-402-25 11'-0" X 5'-6" 9" Radii 2" Border 8" Series E Legend Blue Background White Legend and Border			
 FTP-402A-25 16'-6" X 7'-6" 9" Radii 2" Border 12" Series E Legend Blue Background White Legend and Border		 FTP-403-25 6' 0" X 5'-6" 6" Radii 2" Border 8" Series E Legend Blue Background White Legend and Border		 FTP-404-25 12'-6" X 4'-6" 6" Radii 2" Border 6" and 8" Series E Legend Blue Background White Legend and Border		 FTP-405-25 16'-0" X 7'-0" 9" Radii 2" Border 10" and 13.3" Series E Legend Blue Background White Legend and Border			
 FTP-406-25 15'-6" X 8'-6" 12" Radii 2" Border 12" Series D Legend 12" Series EM Legend Blue Background White Legend and Border		 FTP-407-25 15'-6" X 8'-6" 12" Radii 2" Border 12" Series D Legend 12" Series EM Legend Blue Background White Legend and Border		 FTP-408-25 16'-6" X 8'-6" 12" Radii 2" Border 12" Series D Legend 12" Series EM Legend Blue Background White Legend and Border		 FTP-409-25 5' 6" X 2'-6" 3" Radii 3/4" Border 8" Series E Legend Blue Background White Legend and Border			
LAST REVISION 11/01/26		DESCRIPTION:		FDOT FY 2027-28 STANDARD PLANS		SPECIAL SIGN DETAILS		INDEX 700-102	SHEET 9 of 29



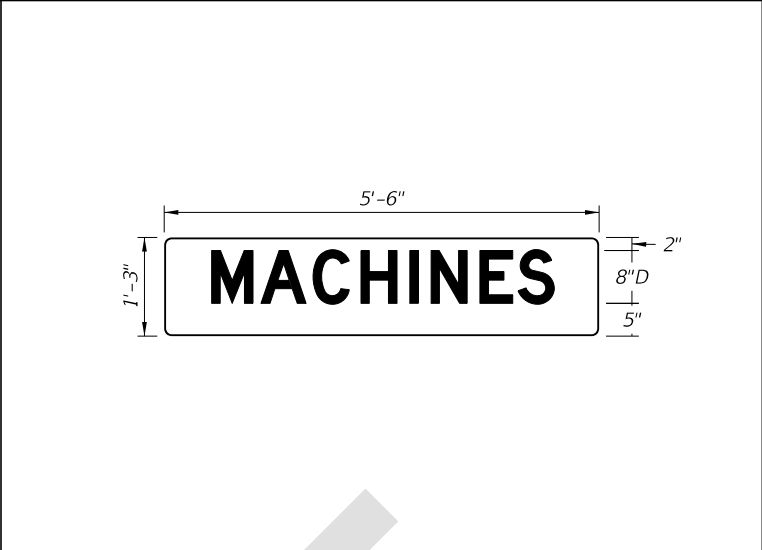
FTP-410-25
5'-6" X 2'-6"
3" Radii ¾" Border

8" and 6" Series D Legend
Blue Background
White Legend and Border




FTP-411-25
5'-6" X 1'-3"
3" Radii ¾" Border

6" Series D Legend
Blue Background
White Legend and Border



FTP-412-25
5'-6" X 1'-3"
3" Radii ¾" Border

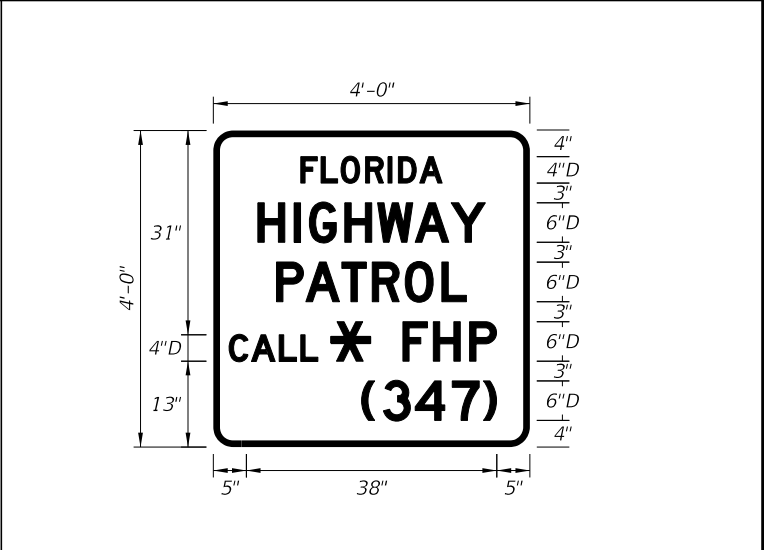8" Series D Legend
Blue Background
White Legend and Border



FTP-413-25
4'-0" X 4'-0"
3" Radii 1" Border

4" and 6" Series D Legend
Blue Background
White Legend and Border



FTP-414-25
4'-0" X 5'-0"
3" Radii 1" Border

6" Series D Legend
Blue Background
White Legend and Border

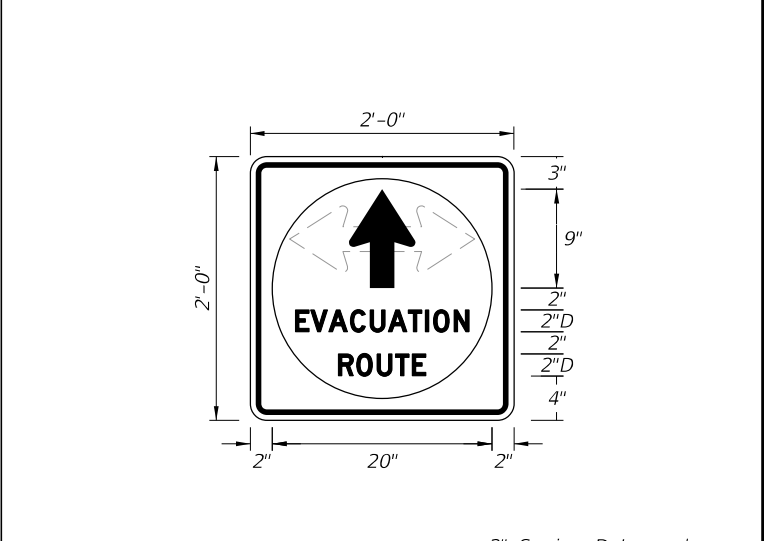


FTP-414A-25
5'-6" X 6'-0"
3" Radii 1" Border

8" Series D Legend
Blue Background
White Legend and Border




DETAIL for FTP-414-25 and FTP-414A-25



FTP-415-25
2'-0" X 2'-0"
1.5" Radii ½" Border

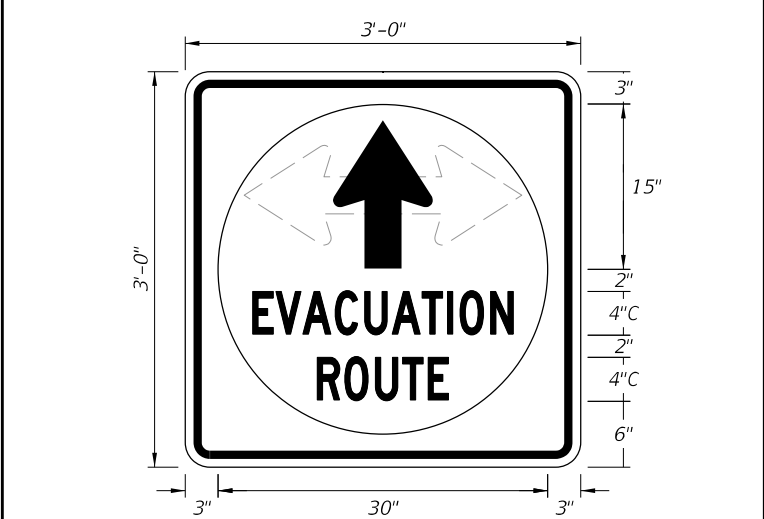
2" Series D Legend
White Background with
Blue Circle Background
White Legend and Border



FTP-415A-25
3'-0" X 3'-0"
1.5" Radii ½" Border











4" Series C Legend
White Background with
Blue Circle Background
White Legend and Border

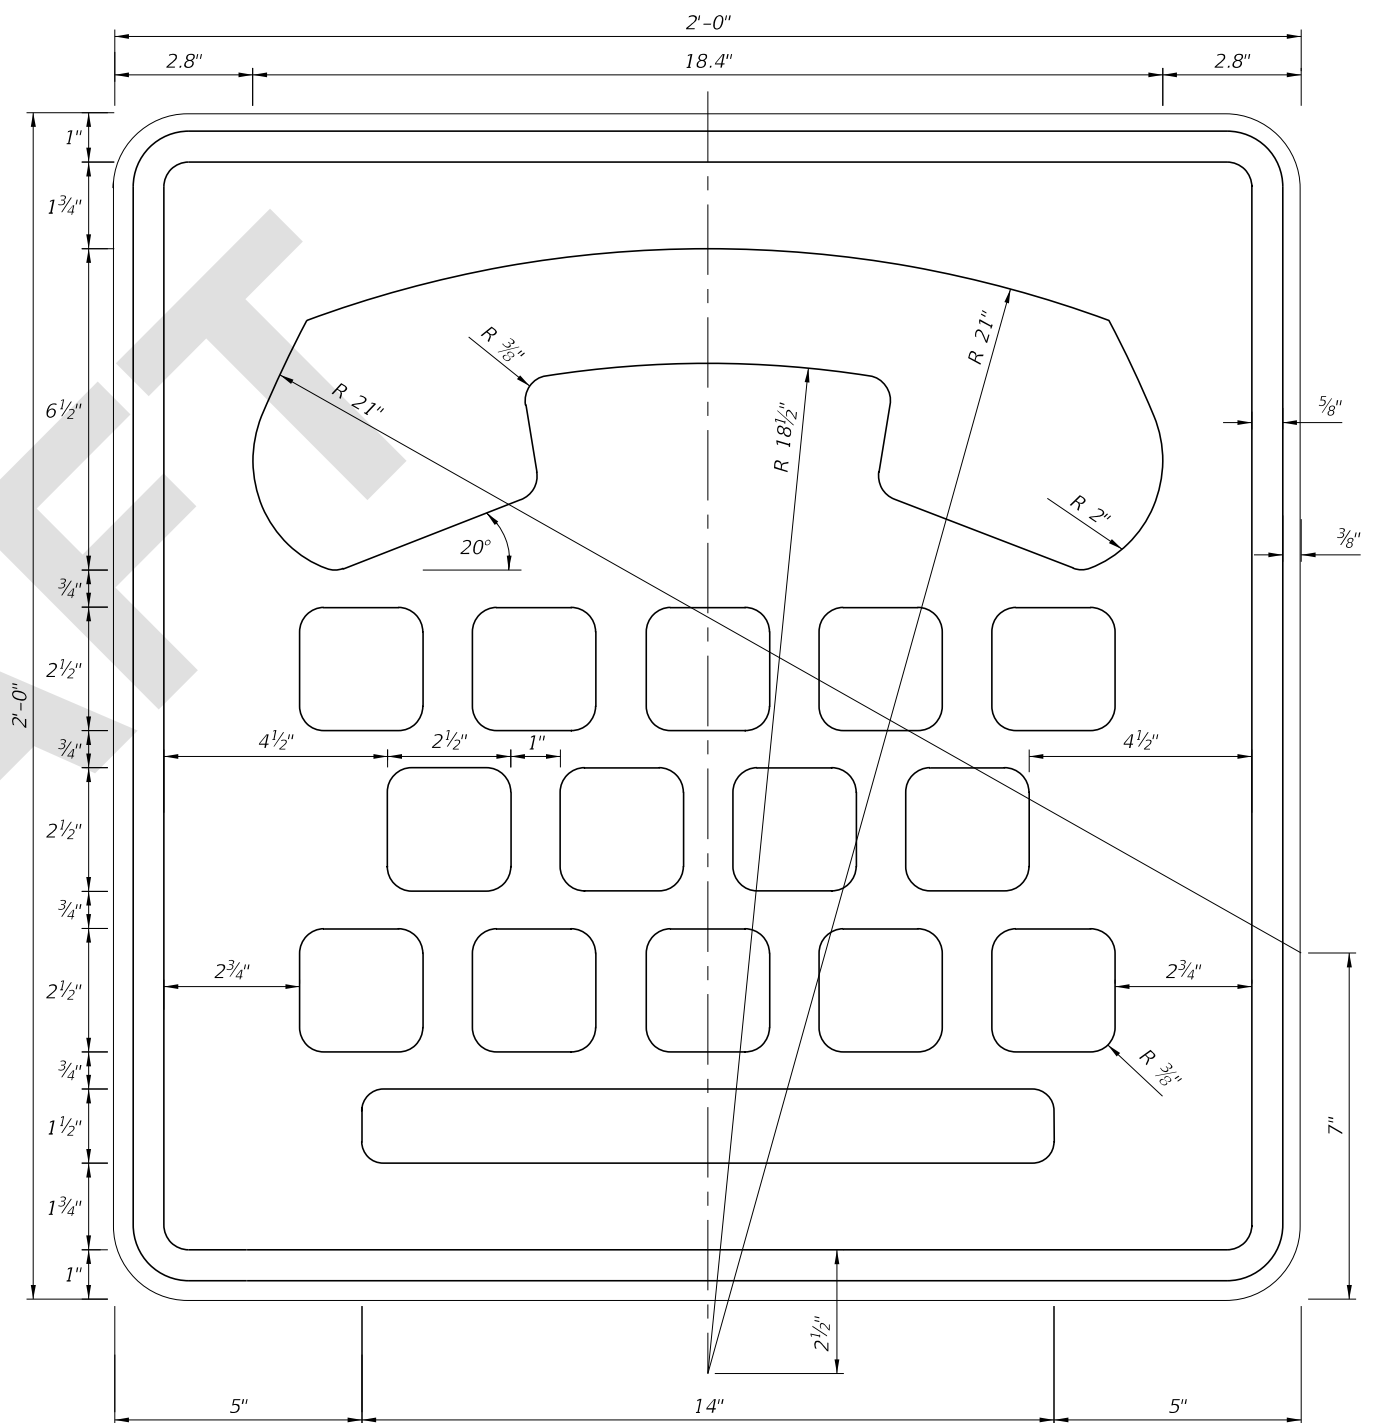Blue Background
White Legend and Border








Blue Background
White Legend and Border

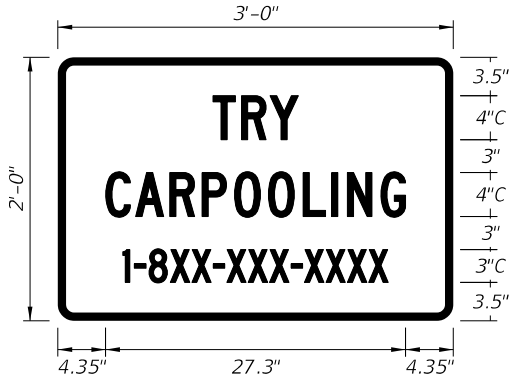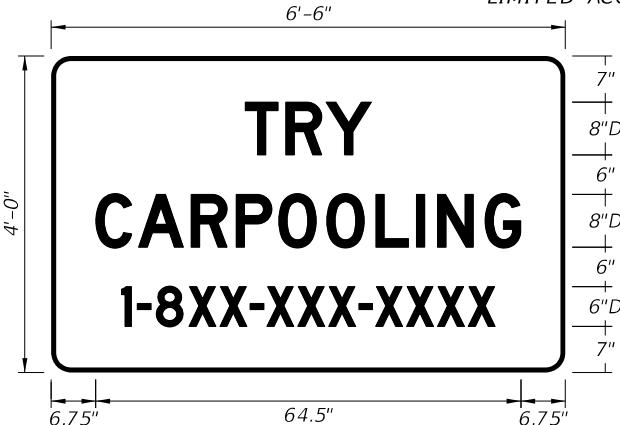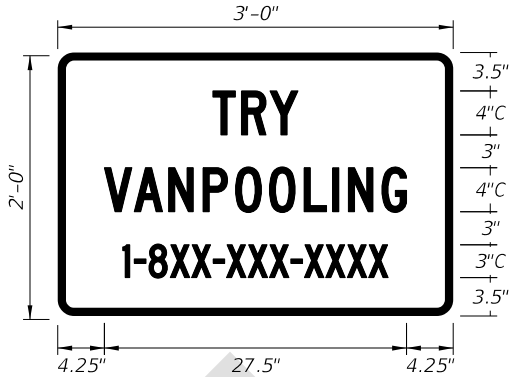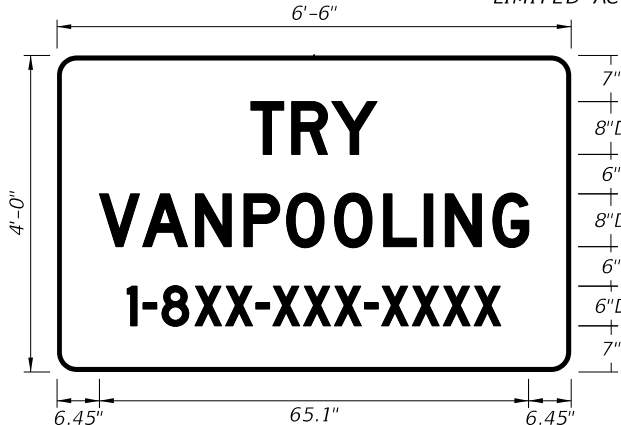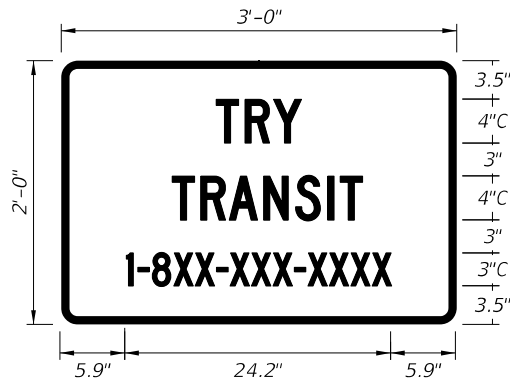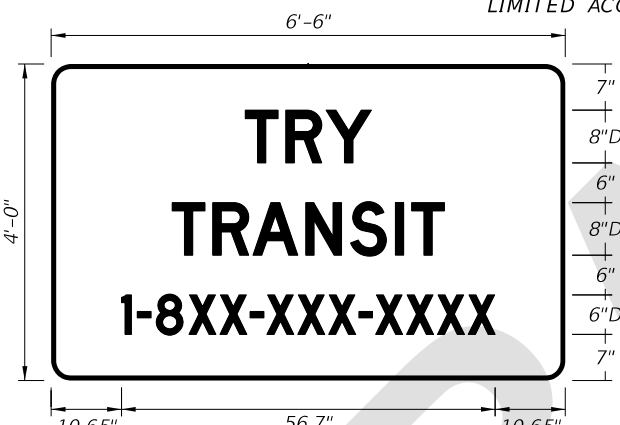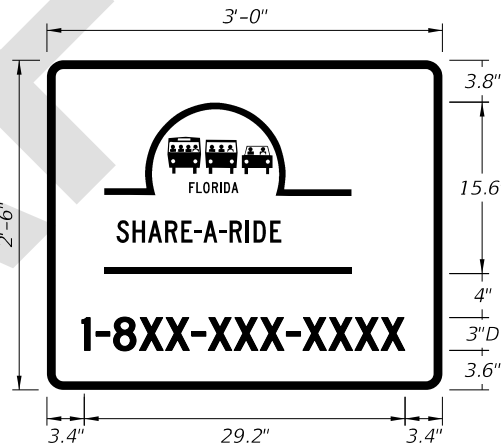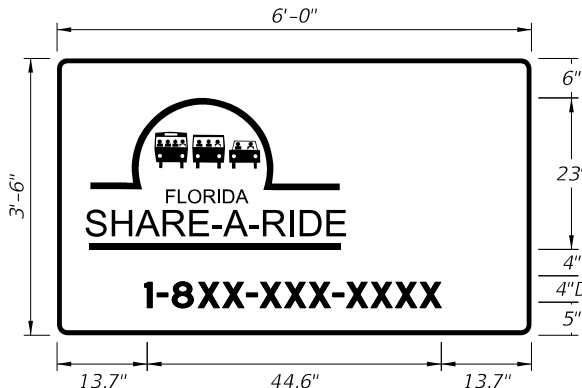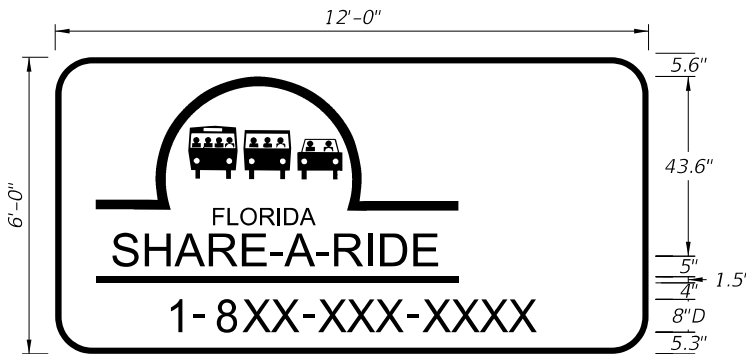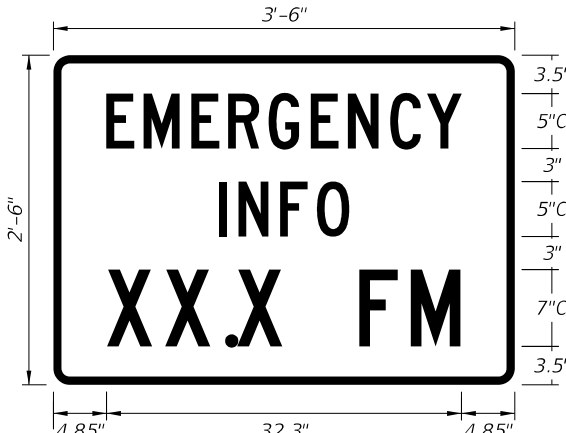8/12/2026 11:25:00 AM


NON-LIMITED ACCESS  NOTE: Design Project Manager or Transit Administrator will supply correct 1-8XX number. FTP-418-25 3'-0" X 2'-0" 1.5" Radii 3/4" Border 3" and 4" Series C Legend Blue Background White Legend and Border		LIMITED ACCESS  NOTE: Design Project Manager or Transit Administrator will supply correct 1-8XX number. FTP-418A-25 6'-6" X 4'-0" 3" Radii 3/4" Border 6" and 8" Series D Legend Blue Background White Legend and Border		NON-LIMITED ACCESS  NOTE: Design Project Manager or Transit Administrator will supply correct 1-8XX number. FTP-419-25 3'-0" X 2'-0" 1.5" Radii 3/4" Border 3" and 4" Series C Legend Blue Background White Legend and Border		LIMITED ACCESS  NOTE: Design Project Manager or Transit Administrator will supply correct 1-8XX number. FTP-419A-25 6'-6" X 4'-0" 3" Radii 3/4" Border 6" and 8" Series D Legend Blue Background White Legend and Border					
NON-LIMITED ACCESS  NOTE: Design Project Manager or Transit Administrator will supply correct 1-8XX number. FTP-420-25 3'-0" X 2'-0" 1.5" Radii 3/4" Border 3" and 4" Series C Legend Blue Background White Legend and Border		LIMITED ACCESS  NOTE: Design Project Manager or Transit Administrator will supply correct 1-8XX number. FTP-420A-25 6'-6" X 4'-0" 3" Radii 3/4" Border 6" and 8" Series D Legend Blue Background White Legend and Border		NON-LIMITED ACCESS  NOTE: Design Project Manager or Transit Administrator will supply correct 1-8XX number. FTP-421-25 3'-0" X 2'-6" 1.5" Radii 3/4" Border 3" Series D Legend Blue Background White Legend and Border		LIMITED ACCESS  NOTE: Design Project Manager or Transit Administrator will supply correct 1-8XX number. FTP-421A-25 6'-0" X 3'-6" 1.5" Radii 3/4" Border 4" Series D Legend Blue Background White Legend and Border					
 NOTE: Design Project Manager or Transit Administrator will supply correct 1-8XX number. FTP-421B-25 12'-0" X 6'-0" 9" Radii 1.5" Border 8" Series D Legend Blue Background White Legend and Border		 NOTE: Design Project Manager or Transit Administrator will supply correct 1-8XX number. FTP-422-25 2'-0" X 1'-6" 1.5" Radii 3/4" Border 3" and 4" Series C Legend Blue Background White Legend and Border		 NOTE: Design Project Manager or Transit Administrator will supply correct 1-8XX number. FTP-422A-25 3'-0" X 2'-0" 1.5" Radii 3/4" Border 4.5" and 6" Series C Legend Blue Background White Legend and Border		 NOTE: Design Project Manager or Transit Administrator will supply correct 1-8XX number. FTP-422B-25 3'-6" X 2'-6" 1.5" Radii 3/4" Border 5" and 7" Series C Legend Blue Background White Legend and Border					
LAST REVISION 11/01/26		DESCRIPTION:		FY 2027-28 STANDARD PLANS		SPECIAL SIGN DETAILS		INDEX 700-102		SHEET 12 of 29	

8/12/2026 11:25:04 AM

OTHER THAN FREEWAY USE		OTHER THAN FREEWAY USE		FREEWAY USE	
	FTP-600-25 4'-0" X 3'-6" 1.5" Radii 2" Border		FTP-601-25 14'-0" X 8'-0" 9" Radii 2" Border		FTP-602-25 4'-0" X 1'-6" 1.5" Radii 2" Border
6" Series E Legend Green Background White Legend and Border		10" and 12" Series E Legend Green Background White Legend and Border		6" Series E Legend Green Background White Legend and Border	
FTP-603R-25 FTP-603L-25 14'-6" X 7'-0" 9" Radii 2" Border		FTP-604R-25 FTP-604L-25 12'-0" X 7'-0" 9" Radii 2" Border		FTP-605R-25 FTP-605L-25 10'-0" X 5'-0" 9" Radii 2" Border	
10" Series E Legend Green Background White Legend and Border		10" Series E Legend Green Background White Legend and Border		10" Series E Legend Green Background White Legend and Border	
	FTP-607-25 3'-6" X 5'-0" 1.5" Radii 2" Border		FTP-608-25 3'-6" X 5'-6" 3" Radii 2" Border		
4" Series C Legend Green Background White Legend, Border and Symbol		4" Series C Legend Green Background Municipality Name Optional White Legend, Border and Symbol		Detail for FTP-607-25 and FTP-608-25	
FTP-609-25 1'-6" X 5'-0" 1.5" Radii 3/4" Border		FTP-606-25 3'-0" X 3'-0" 1.5" Radii 2" Border			
TOP: 6" and 6.6" and 8" Series B Legend 6" Series C Legend Green Background White Legend and Border BOTTOM: 8" Series C Legend Green Background White Legend and Border		4" Series D Legend Green Background White Legend and Border			

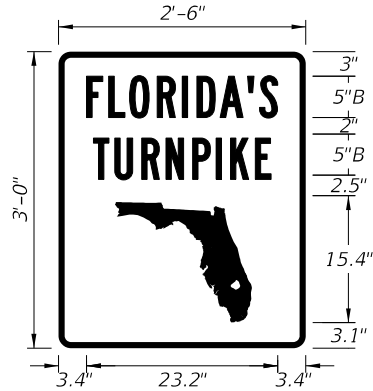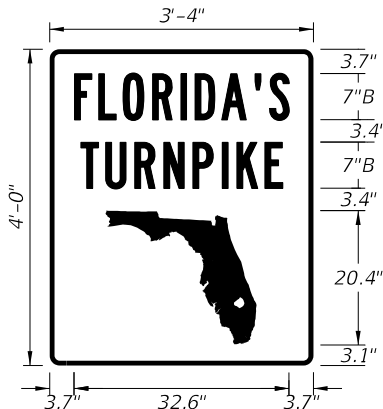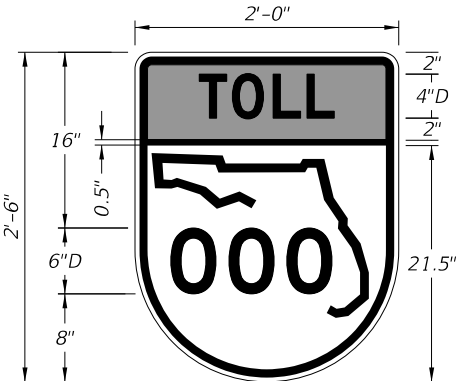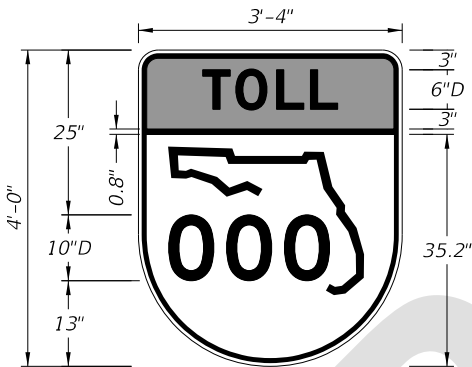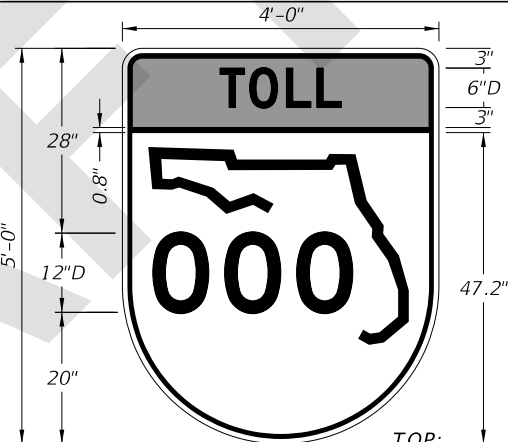 FTP-610-25 2'-6" X 3'-0" 1.5" Radii $\frac{3}{4}$" Border 5" Series B Legend Green Background White Legend, Border, and Florida Symbol	 FTP-610A-25 3'-4" X 4'-0" 1.5" Radii $\frac{3}{4}$" Border 7" Series B Legend Green Background White Legend, Border, and Florida Symbol	 FTP-610B-25 4'-0" X 5'-0" 3" Radii $1\frac{1}{4}$" Border 8" Series B Legend Green Background White Legend, Border, and Florida Symbol	
 FTP-611-25 2'-0" X 2'-6" 1.5" Radii $\frac{3}{4}$" Border TOP: 4" Series D Legend Yellow Background Black Legend and Border BOTTOM: 6" Series D Legend White Background Black Legend and Border	 FTP-611A-25 3'-4" X 4'-0" 3" Radii $\frac{3}{4}$" Border TOP: 6" Series D Legend Yellow Background Black Legend and Border BOTTOM: 10" Series D Legend White Background Black Legend and Border	 FTP-611B-25 4'-0" X 5'-0" 3" Radii $\frac{3}{4}$" Border TOP: 6" Series D Legend Yellow Background Black Legend and Border BOTTOM: 12" Series D Legend White Background Black Legend and Border	
LAST REVISION 11/01/26 REVISION DESCRIPTION:	FDOT FY 2027-28 STANDARD PLANS	SPECIAL SIGN DETAILS	INDEX 700-102 SHEET 15 of 29

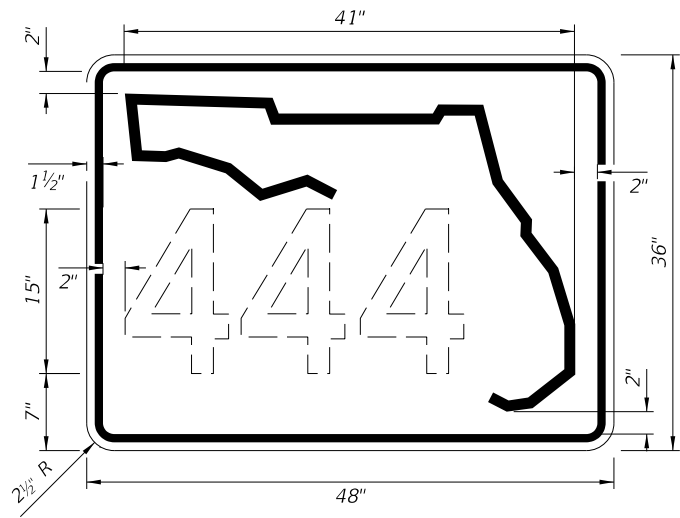
8/12/2026 11:25:07 AM




DIGITS	NUMERAL SIZE	SERIES LEGEND	PANEL SIZE
1-3	15"	C	48" x 36"
4	12"	C	48" x 36"

NOTE:
1. Stroke width of State Outline shall be 1".

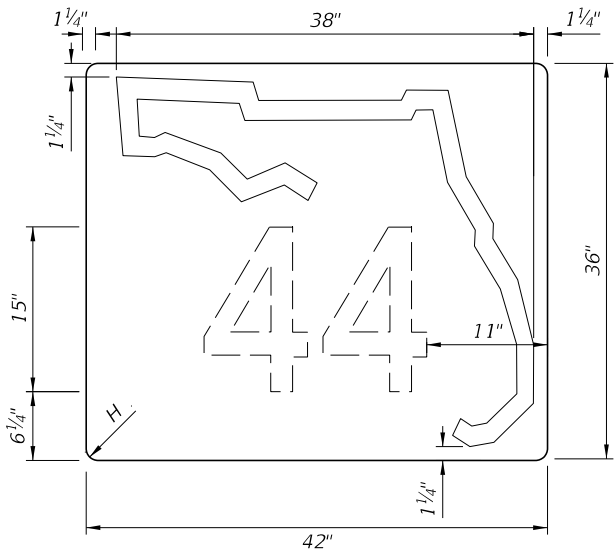INDEPENDENT USE FOR FREEWAY



1 OR 2 DIGITS

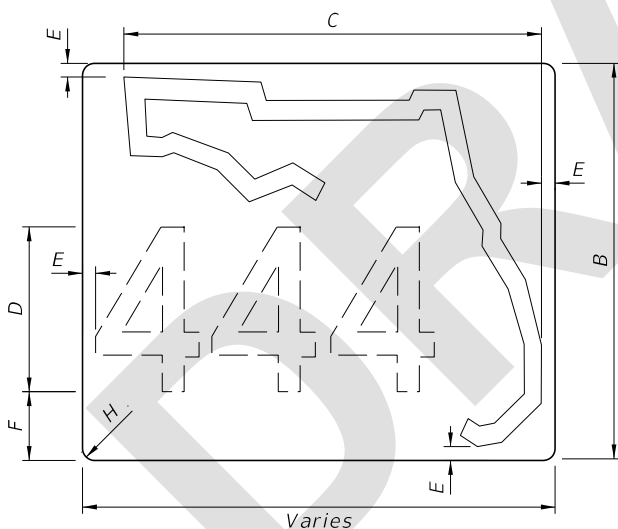


(See Note 4)
3 OR MORE DIGITS

NOTES:
1. Florida marker is Black Legend with White Background.
2. Stroke width of State outline is 1 3/4".
3. Series D Legend.
4. Width varies with the number scheme combination, within a range of 48"-58".


A	B	C	D	E	F	G	H
30"	24"	26"	12"	1 1/4"	2 3/4"	8 1/4"	1 1/4"
36"	30"	32"	15"	1 1/4"	3 1/4"	8 3/4"	1 1/4"
42"	36"	38"	15"	1 1/4"	6 1/4"	11"	1 1/4"

GUIDE SIGN USE

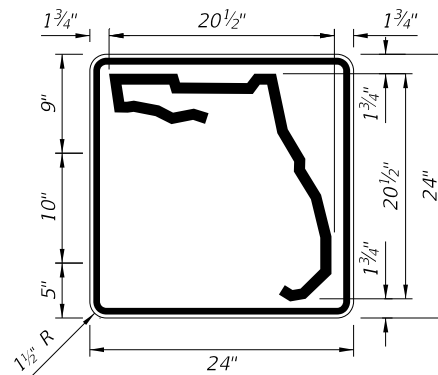FTP-612-25 - FLORIDA ROUTE MARKER



1 or 2 DIGITS

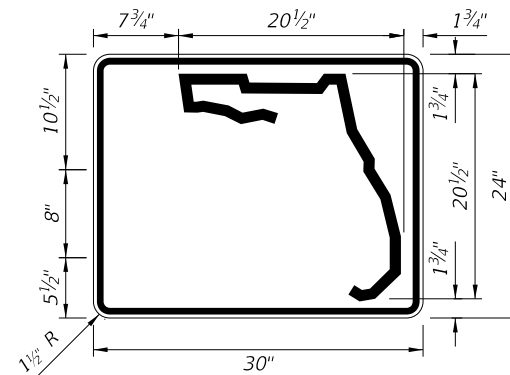

3 or 4 DIGITS


DIGITS	NUMERAL SIZE	SERIES LEGEND	PANEL SIZE
1-2	10"	D	24" x 24"

DIGITS	NUMERAL SIZE	SERIES LEGEND	PANEL SIZE
3	8"	D	30" x 24"
4	8"	C	30" x 24"

NOTES:
1. Stroke width of State Outline shall be 1".
2. The 24" X 24" panel shall only be used for a 3 digit route when the panel is to be used on a sign cluster with other 24" X 24" panels.







INDEPENDENT USE OTHER THAN FREEWAY

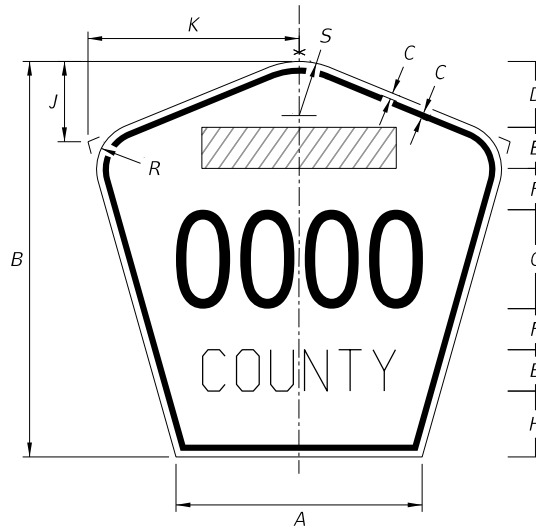NOTES:
1. Series D Legend, all upper case.
2. Color: Yellow Legend and Border on Blue Background.
3. When used on a guide sign, marker must be overlaid on a square Yellow Background as shown in chart.
4. When two or more County Route Markers are mounted together, use the dimensions of the largest marker for all other markers.



SIGN	DIMENSIONS												Square Yellow Background Dimensions (See Note 3)
	A	B	C	D	E	F	G	H	J	K	R	S	
4 DIGIT POST MOUNTED	25 1/8"	42"	3/4"	10"	4"	4"	8"	8"	8 3/8"	22"	5"	8 3/4"	
2 DIGIT OVERHEAD	21 1/2"	36"	1/2"	7 1/2"	3"	3"	12"	4 1/2"	7 1/8"	18 7/8"	4 1/4"	7 1/2"	42" x 42"
3 DIGIT OVERHEAD	25 1/8"	42"	3/4"	8"	4"	4"	12"	6"	8 3/8"	22"	5"	8 3/4"	48" x 48"
4 DIGIT OVERHEAD	29 7/8"	48"	3/4"	8"	5"	5"	12"	8"	9 3/4"	25 5/8"	5 3/4"	10 1/4"	52" x 52"

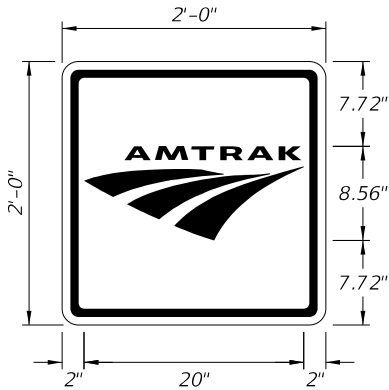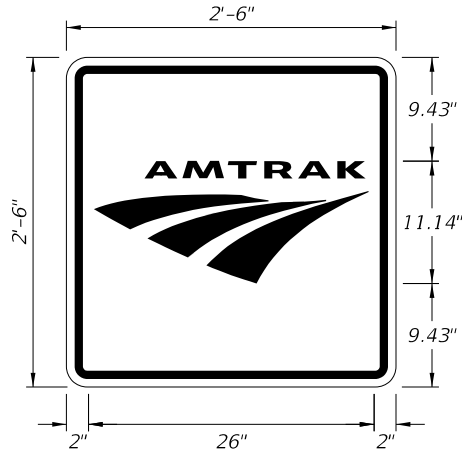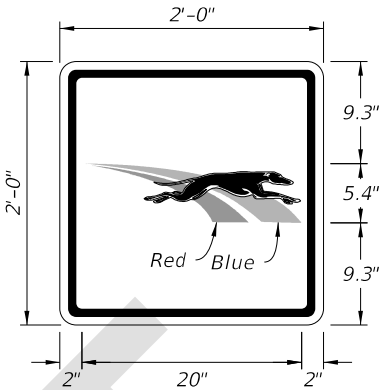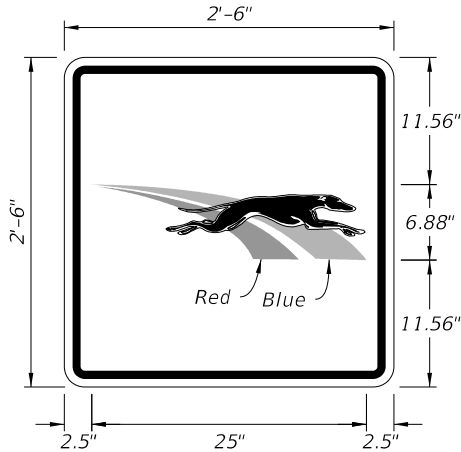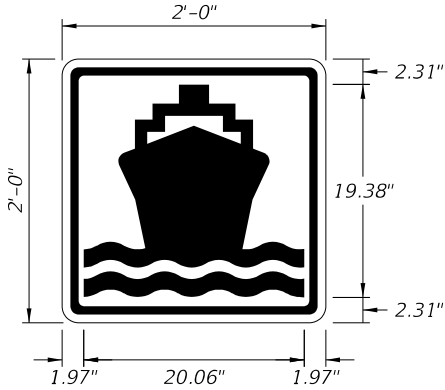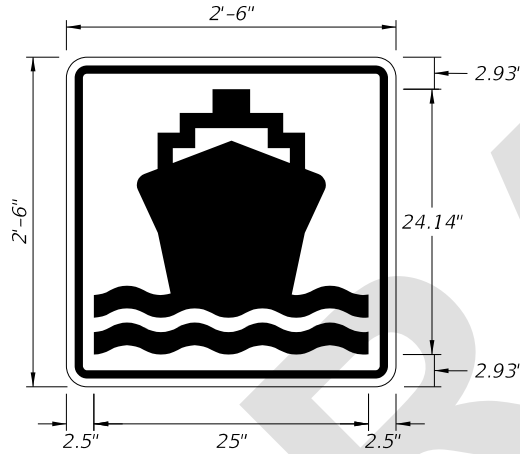FTP-613-25 - COUNTY ROUTE MARKER (M1-6)

NON-LIMITED ACCESS  FTP-614-25 2'-0" X 2'-0" 1.5" Radii 3/4" Border Green Background White Legend, Border and Symbol		LIMITED ACCESS  FTP-614A-25 2'-6" X 2'-6" 1.5" Radii 3/4" Border Green Background White Legend, Border and Symbol		NON-LIMITED ACCESS  FTP-615-25 2'-0" X 2'-0" 1.5" Radii 3/4" Border Green Background White Legend, Border and Symbol		LIMITED ACCESS  FTP-615A-25 2'-6" X 2'-6" 1.5" Radii 3/4" Border Green Background White Legend, Border and Symbol	
NON-LIMITED ACCESS  FTP-616-25 2'-0" X 2'-0" 1.5" Radii 3/4" Border Green Background White Legend, Border and Symbol		LIMITED ACCESS  FTP-616A-25 2'-6" X 2'-6" 1.5" Radii 3/4" Border Green Background White Legend, Border and Symbol					

LAST REVISION 11/01/26		DESCRIPTION:	FDOT FY 2027-28 STANDARD PLANS	SPECIAL SIGN DETAILS		INDEX 700-102	SHEET 17 of 29
--	--	-------------------------	--	---------------------------------	--	-------------------------------------	--------------------------------------

FTP-800-25
4'-6" X 2'-0"
1.5" Radii 1/2" Border

5" Series B Legend
2" Series C Legend
Brown Background
Yellow Legend and Border

FTP-800A-25
4'-6" X 2'-6"
1.5" Radii 1/2" Border

5" Series B Legend
2" Series C Legend
Brown Background
Yellow Legend and Border

FTP-801-25
4'-0" X 2'-6"
1.5" Radii 3/4" Border

4" Series C Legend
2" Series EM Legend
White Background
Blue Legend and Border

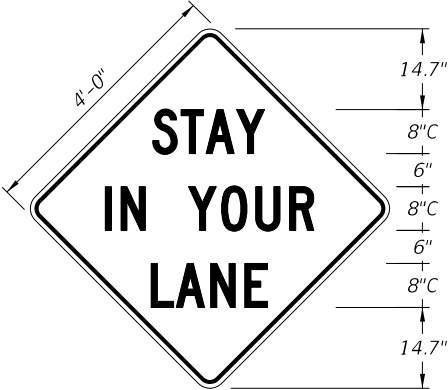
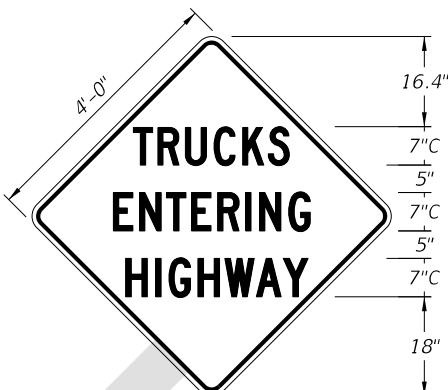
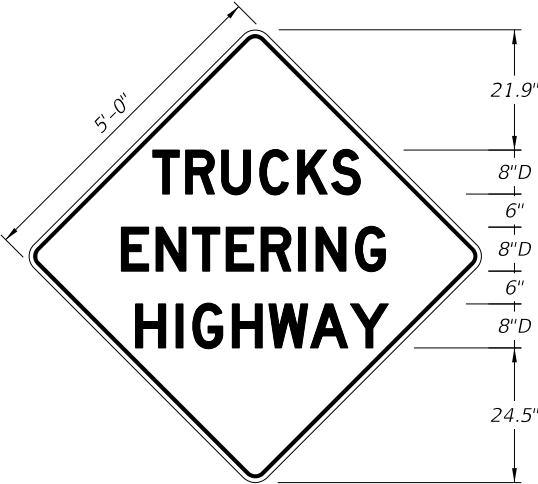
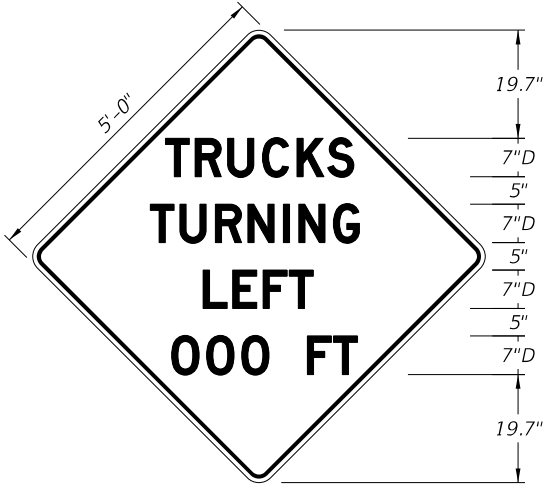
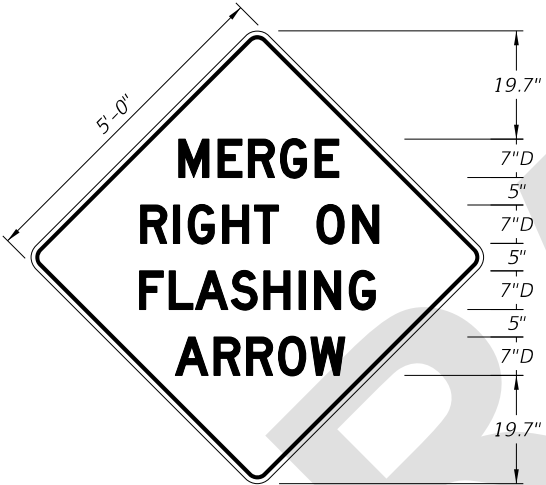
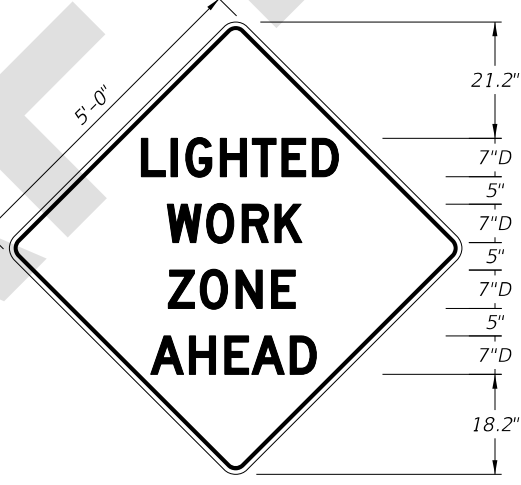
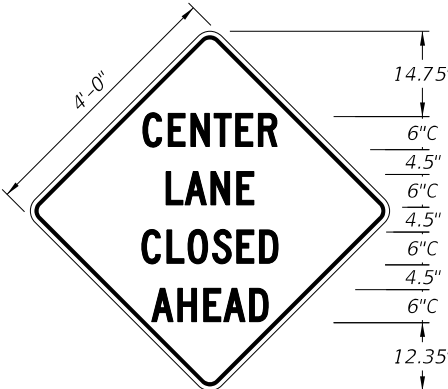
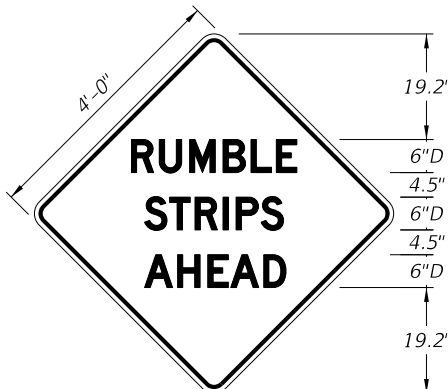
FTP-802-25
2'-0" X 1'-4"

NOTE:
To be installed with Co-location
of route Confirmation Marker

FTP-802A-25
3'-0" X 2'-0"

NOTE:
Install at the Florida Scenic Highway Entrance Points

8/12/2026 11:25:13 AM

 TTC-001-25 4'-0" X 4'-0" 3" Radii ¾" Border 8" Series C Legend Orange Background Black Legend and Border		 TTC-002-25 4'-0" X 4'-0" 3" Radii ¾" Border 8" Series C Legend Orange Background Black Legend and Border		 TTC-003-25 4'-0" X 4'-0" 3" Radii ¾" Border 7" Series C Legend Orange Background Black Legend and Border		 TTC-003A-25 5'-0" X 5'-0" 3" Radii ¾" Border 8" Series D Legend Orange Background Black Legend and Border	
 TTC-004-25 5'-0" X 5'-0" 3" Radii ¾" Border 7" Series D Legend Orange Background Black Legend and Border		 TTC-005-25 5'-0" X 5'-0" 3" Radii ¾" Border 7" Series D Legend Orange Background Black Legend and Border		 TTC-006-25 5'-0" X 5'-0" 3" Radii ¾" Border 7" Series D Legend Orange Background Black Legend and Border		 TTC-007-25 4'-0" X 4'-0" 3" Radii ¾" Border 7" Series C Legend Orange Background Black Legend and Border	
 TTC-008-25 4'-0" X 4'-0" 3" Radii ¾" Border 6" Series C Legend Orange Background Black Legend and Border		 TTC-009-25 4'-0" X 4'-0" 3" Radii ¾" Border 6" Series D Legend Orange Background Black Legend and Border		 TTC-010-25 4'-0" X 4'-0" 3" Radii ¾" Border 6" Series D Legend Orange Background Black Legend and Border			

<

TTC-019-25
3'-0" x 3'-0"
1.5" Radii $\frac{3}{4}$ " Border

5" Series C Legend
Pink Background
Black Legend and Border

TTC-019A-25
4'-0" x 4'-0"
3" Radii $\frac{3}{4}$ " Border

6" Series C Legend
Pink Background
Black Legend and Border

TTC-020-25
2'-6" x 2'-6"
1.5" Radii $\frac{3}{4}$ " Border

4" Series C Legend
Pink Background
Black Legend and Border

TTC-020A-25
3'-0" x 3'-0"
1.5" Radii $\frac{3}{4}$ " Border

5" Series C Legend
Pink Background
Black Legend and Border

TTC-020B-25
4'-0" x 4'-0"
1.5" Radii $\frac{3}{4}$ " Border

6" Series C Legend
Pink Background
Black Legend and Border

8/12/2026 11:25:19 AM

RAMP APPLICATIONS

AET-001-26
14'-6" X 6'-0"
9" Radii 2" Border

8" Series C and
10" Series E Legend
White Background
Black Legend and Border

MAINLINE APPLICATIONS

AET-001A-26
18'-0" X 6'-6"
9" Radii 2" Border

8" Series D and
12" Series E Legend
White Background
Black Legend and Border

RAMP APPLICATIONS

AET-002-26
17'-0" X 8'-0"
12" Radii 2" Border

8" Series C and
12" Series E Legend
White Background
Black Legend and Border

MAINLINE APPLICATIONS

AET-002A-26
21'-0" X 9'-6"
12" Radii 2" Border













8" and 10" Series C and
15" Series E Legend
White Background
Black Legend and Border

8/12/2026 11:25:22 AM













TOL-001-26 12'-6" X 7'-6" 12" Radii 2" Border		15" Series E Legend Green Background White Legend and Border	
		15" Series E Legend Blue Background White Legend and Border	
TOL-003-26 16'-6" X 11'-0" 12" Radii 2" Border		15" Series E Legend Black Legend with White Background Green Background White Border	
TOL-004-26 16'-6" X 9'-0" 12" Radii 2" Border		15" Series E Legend Black Legend with White Background Green Background White Border	
TOL-005-26 29'-0" X 10'-6" 12" Radii 2" Border		15" Series E Legend Black Legend with White Background Green Background White Border	
TOL-006-26 16'-6" X 9'-0" 12" Radii 2" Border		15" Series E Legend Black Legend with White Background Green Background White Border	
		8" Series E Legend White Background Black Legend and Border	
		12" Series E Legend White Background Black Legend and Border	
		6" Series D Legend Yellow Background Black Legend and Border	
		10", 12", and 15" Series E Legend Yellow Background Black Legend and Border	
		10", 12", and 15" Series E Legend Yellow Background Black Legend and Border	
		10" and 15" Series E Legend Yellow Background Black Legend and Border	

LAST REVISION 11/01/26	REVISION	DESCRIPTION:	 FY 2027-28 STANDARD PLANS	SPECIAL SIGN DETAILS		INDEX 700-102	SHEET 23 of 29
------------------------------	----------	--------------	---	----------------------	--	------------------	-------------------

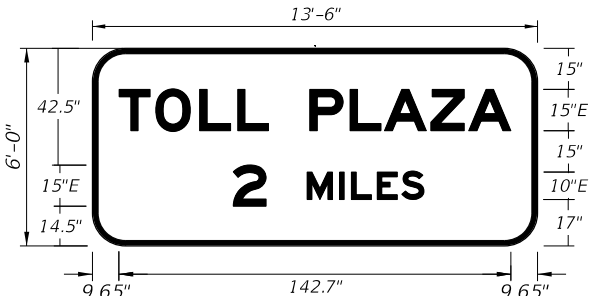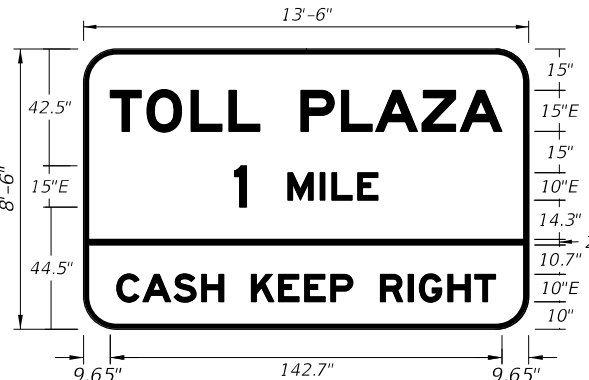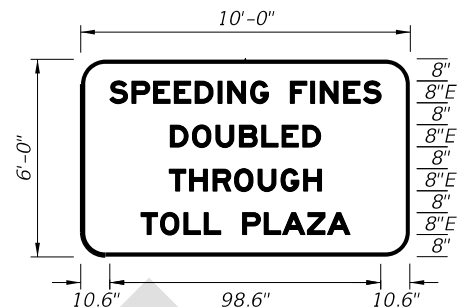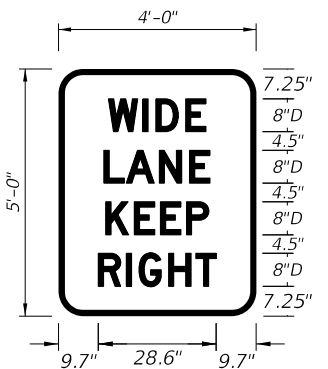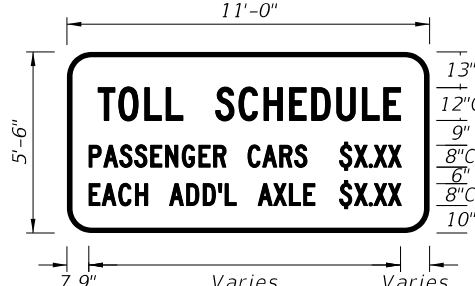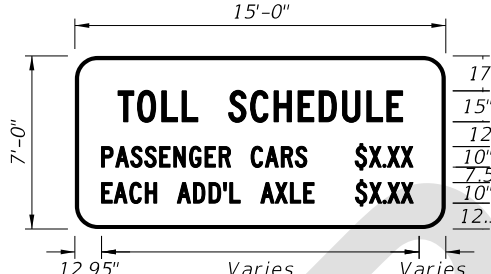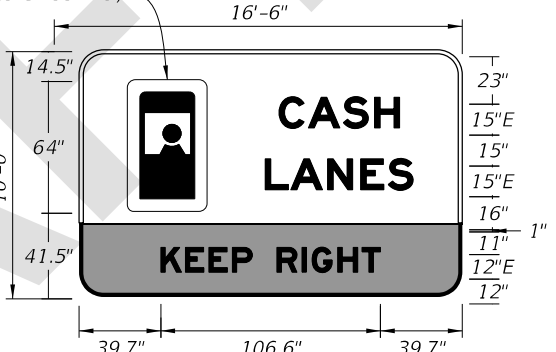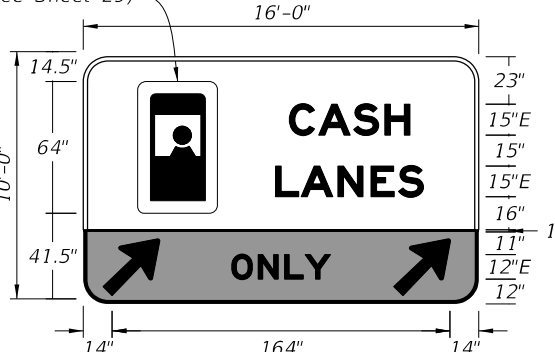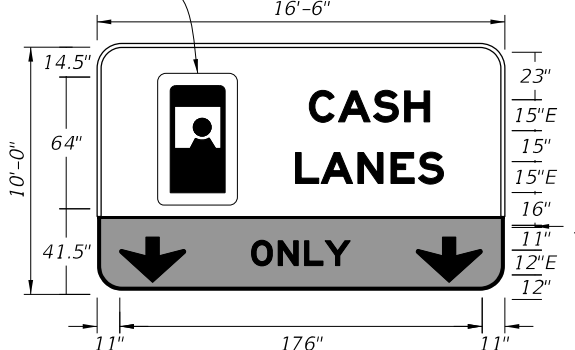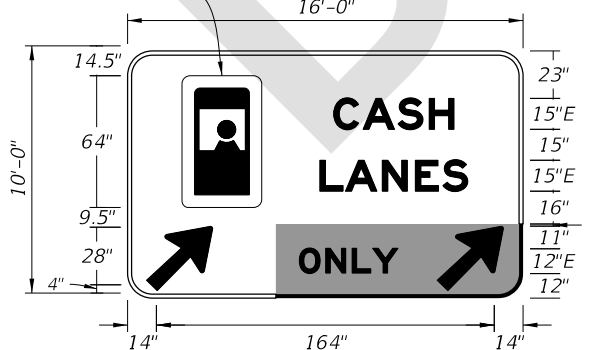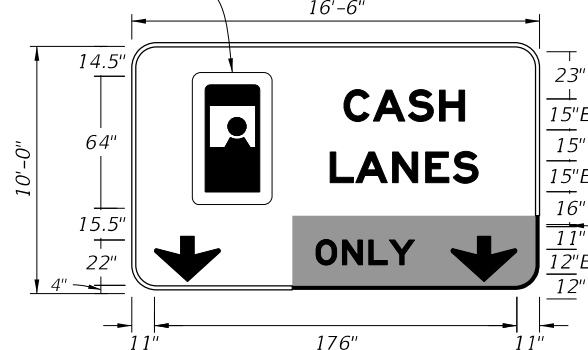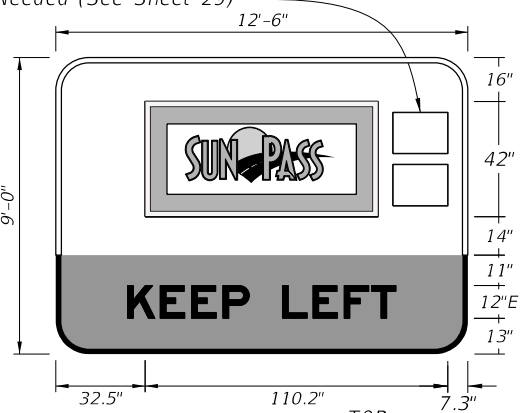8/12/2026 11:25:24 AM

 TOL-012-26 13'-6" X 6'-0" 9" Radii 2" Border 10" and 15" Series E Legend Yellow Background Black Legend and Border		 TOL-013-26 13'-6" X 8'-6" 12" Radii 2" Border 10" and 15" Series E Legend Yellow Background Black Legend and Border		MAINLINE AND RAMP USE  TOL-014-26 10'-0" X 6'-0" 9" Radii 1.5" Border 8" Series E Legend White Background Black Legend and Border		 TOL-015-26 4'-0" X 5'-0" 6" Radii 1.5" Border 8" Series D Legend Yellow Background Black Legend and Border	
USE ON RAMP  TOL-016-26 11'-0" X 5'-6" 9" Radii 2" Border 8" and 12" Series C Legend White Background Black Legend and Border		MAINLINE USE  TOL-016A-26 15'-0" X 7'-0" 11" Radii 2" Border 10" and 15" Series C Legend White Background Black Legend and Border		Toll Attendant Shield (See Sheet 29)  TOL-017-26 15'-6" X 10'-0" 12" Radii 2" Border TOP: 15" Series E Legend Green Background White Legend and Border BOTTOM: 12" Series E Legend Yellow Background Black Legend and Border		Toll Attendant Shield (See Sheet 29)  TOL-018-26 16'-0" X 10'-0" 12" Radii 2" Border TOP: 15" Series E Legend Green Background White Legend and Border BOTTOM: 12" Series E Legend Yellow Background Black Legend and Border	
Toll Attendant Shield (See Sheet 29)  TOL-018A-26 16'-6" X 10'-0" 12" Radii 2" Border TOP: 15" Series E Legend Green Background White Legend and Border BOTTOM: 12" Series E Legend Yellow Background Black Legend and Border		Toll Attendant Shield (See Sheet 29)  TOL-019-26 16'-0" X 10'-0" 12" Radii 2" Border TOP: 15" Series E Legend Green Background White Legend and Border BOTTOM RIGHT: 12" Series E Legend Yellow Background Black Legend and Border		Toll Attendant Shield (See Sheet 29)  TOL-019A-26 16'-6" X 10'-0" 12" Radii 2" Border TOP: 15" Series E Legend Green Background White Legend and Border BOTTOM RIGHT: 12" Series E Legend Yellow Background Black Legend and Border		Additional 24"x18" Logo or Symbol as Needed (See Sheet 29)  TOL-020-26 12'-6" X 9'-0" 12" Radii 2" Border TOP: Sun Pass Symbol Green Background White Border BOTTOM: 12" Series E Legend Yellow Background Black Legend and Border	
LAST REVISION 11/01/26	REVISION	DESCRIPTION:	 FY 2027-28 STANDARD PLANS	SPECIAL SIGN DETAILS		INDEX 700-102	SHEET 24 of 29

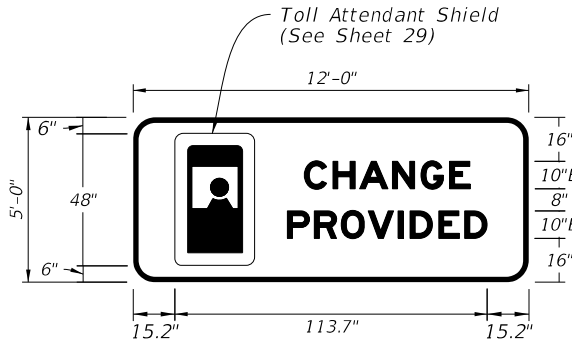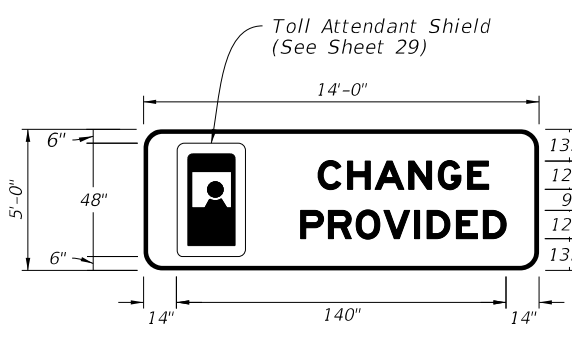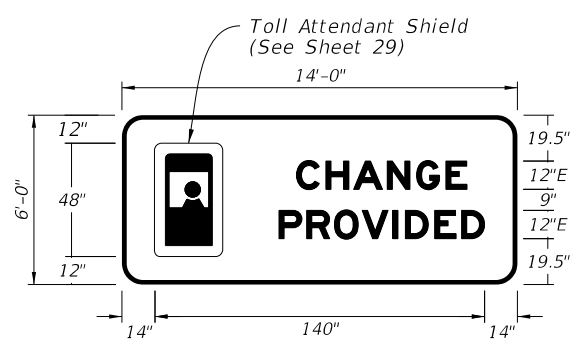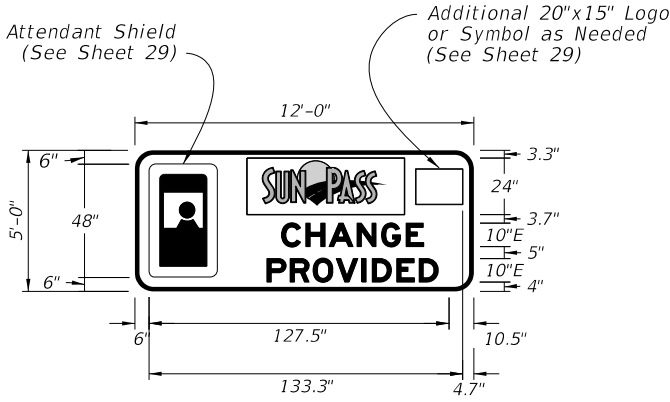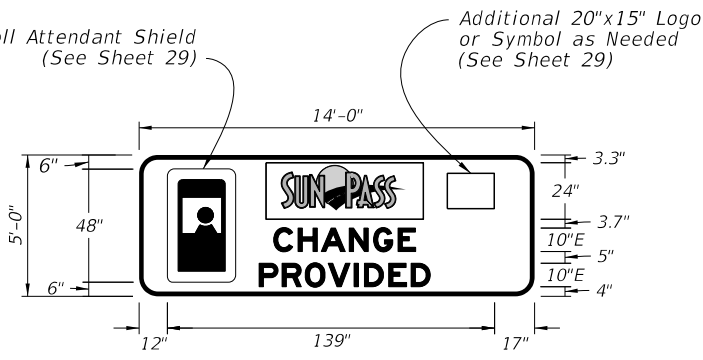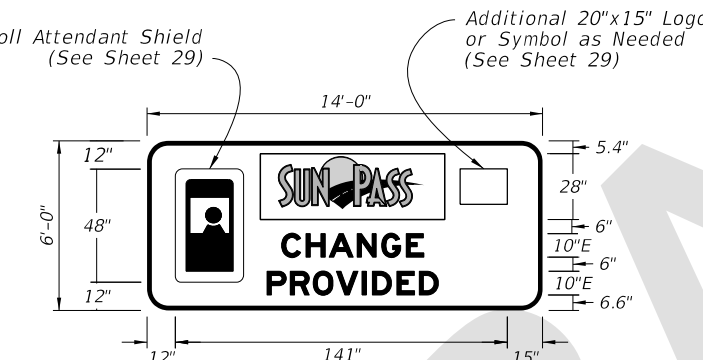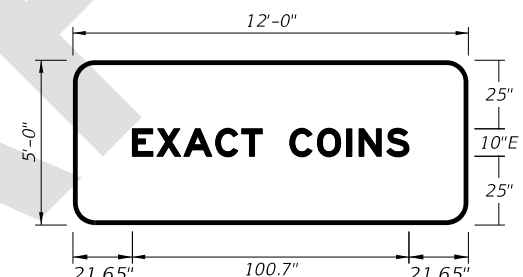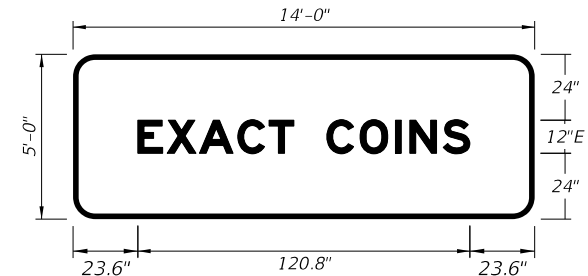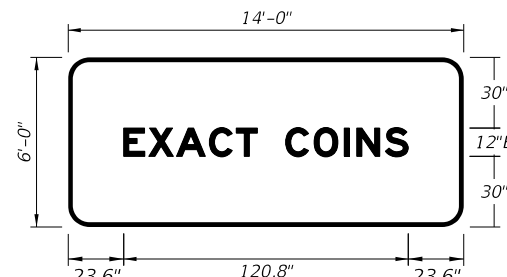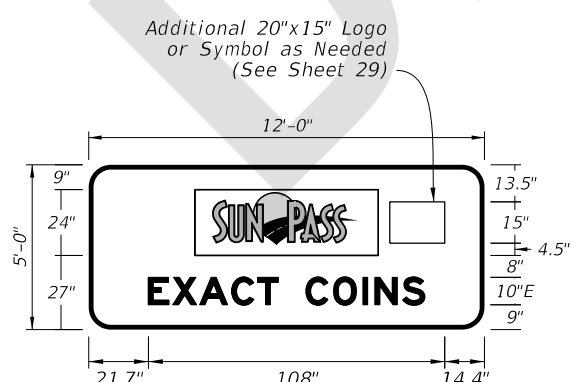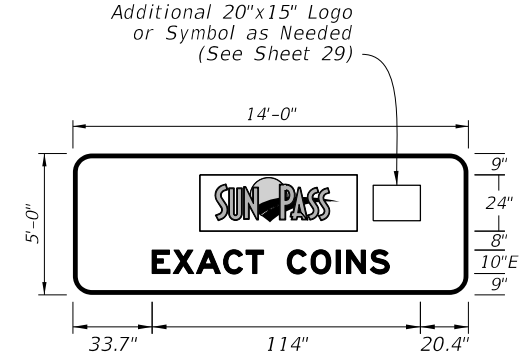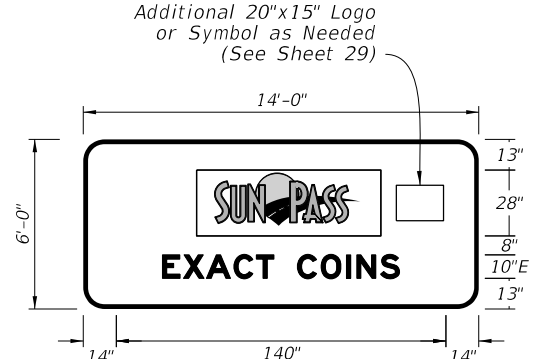8/12/2026 11:25:27 AM

 <i>Toll Attendant Shield (See Sheet 29)</i>		 <i>Toll Attendant Shield (See Sheet 29)</i>		 <i>Toll Attendant Shield (See Sheet 29)</i>		 <i>Toll Attendant Shield (See Sheet 29)</i> <i>Additional 20"x15" Logo or Symbol as Needed (See Sheet 29)</i>	
TOL-021-26 12'-0" X 5'-0" 8" Radii 2" Border		TOL-021A-26 14'-0" X 5'-0" 8" Radii 2" Border		TOL-021B-26 14'-0" X 6'-0" 9" Radii 2" Border		TOL-022-26 12'-0" X 5'-0" 8" Radii 1.75" Border	
 <i>Toll Attendant Shield (See Sheet 29)</i> <i>Additional 20"x15" Logo or Symbol as Needed (See Sheet 29)</i>		 <i>Toll Attendant Shield (See Sheet 29)</i> <i>Additional 20"x15" Logo or Symbol as Needed (See Sheet 29)</i>					
TOL-022A-26 14'-0" X 5'-0" 8" Radii 1.75" Border		TOL-022B-26 14'-0" X 6'-0" 9" Radii 1.75 Border		TOL-023-26 12'-0" X 5'-0" 8" Radii 1.75" Border		TOL-023A-26 14'-0" X 5'-0" 8" Radii 2" Border	
		 <i>Additional 20"x15" Logo or Symbol as Needed (See Sheet 29)</i>		 <i>Additional 20"x15" Logo or Symbol as Needed (See Sheet 29)</i>		 <i>Additional 20"x15" Logo or Symbol as Needed (See Sheet 29)</i>	
TOL-023B-26 14'-0" X 6'-0" 9" Radii 2" Border		TOL-024-26 12'-0" X 5'-0" 8" Radii 1.75" Border		TOL-024A-26 14'-0" X 5'-0" 8" Radii 1.75" Border		TOL-024B-26 14'-0" X 6'-0" 9" Radii 1.75" Border	
LAST REVISION 11/01/26		DESCRIPTION:		FY 2027-28 STANDARD PLANS		SPECIAL SIGN DETAILS	
INDEX 700-102		SHEET 25 of 29					

8/12/2026 11:25:30 AM

TOL-025-26
3'-0" X 3'-0"
3" Radii 3/4" Border

6" Series E Legend
Black Legend with
White Background
Purple Background
White Border

TOL-026-26
12'-0" X 5'-0"
8" Radii 2" Border

10" Series E Legend
Black Legend with
White Background
Purple Background
White Border

TOL-026A-26
14'-0" X 5'-0"
8" Radii 2" Border

10" Series E Legend
Black Legend with
White Background
Purple Background
White Border

TOL-026B-26
14'-0" X 6'-0"
9" Radii 2" Border

10" Series E Legend
Black Legend with
White Background
Purple Background
White Border

TOL-027-26
10'-6" X 12'-6"
12" Radii 2" Border

12" and 15" Series E Legend
White Background
Black Legend and Border

TOL-028-26
15'-0" X 12'-6"
12" Radii 2" Border

12" and 16" Series E Legend
16" Series EM Legend
White, Purple, Green, and
Yellow Background
Black and White Legend and Border

TOL-029-26
15'-0" X 14'-6"
12" Radii 2" Border

10" and 12" Series E Legend
16" Series EM Legend
White, Purple, Green, and
Yellow Background
Black and White Legend and Border

TOL-030-26
21'-6" X 13'-0"
12" Radii 2" Border

16" Series E and
13.5" Series EM Legend
White Legend and
White, Purple, and
Green Background
White Border

TOL-031-26
10'-6" X 9'-0"
12" Radii 1.5" Border

8" Series D Legend
White Background
Black Legend and Border

TOL-031A-26
14'-6" X 12'-0"
12" Radii 1.75" Border

10" Series D Legend
White Background
Black Legend and Border




TOL-032-26
17'-6" X 9'-0"
12" Radii 2" Border

10" and 12" Series E Legend
16" Series EM Legend
Green Background
White Legend and Border

TOL-033-26
17'-6" X 9'-0"
12" Radii 2" Border

10" Series E Legend
16" Series EM Legend
Purple and Green Background
White Legend and Border

4'-0" 4'-0" RONALD REAGAN TURNPIKE DESIGNATED BY 1998 LEGISLATURE OF FLORIDA TOL-034-26 4'-0" X 4'-0" 4" Radii 1" Border 2" and 5" Series E Legend Green Background White Legend and Border		4'-0" 2'-0" SEMINOLE EXPRESSWAY TOL-035-26 4'-0" X 2'-0" 2" Radii 1" Border 5" Series C Legend Green Background White Legend and Border		20'-0" 14'-0" POMPANO BCH SERVICE PLAZA X MILES NEXT PLAZA XX MILES TOL-036-26 20'-0" X 14'-0" 12" Radii 2" Border 10" Series D Legend and 10" Series E Legend Blue Background White Legend and Border		20'-0" 10'-0" Highway Advisory Radio 1640 AM URGENT MESSAGE WHEN FLASHING TOL-037-26 20'-0" X 10'-0" 12" Radii 2" Border TOP: 13.3" Series EM Legend Blue Background White Legend and Border BOTTOM: 8" Series E Legend Yellow Background Black Legend and Border	
4'-0" 3'-6" TANDEM STAGING AREA ONLY FDOT RULE 14-61 TURNPIKE CERTIFIED VEHICLES ONLY ALL OTHERS TOWED AT OWNERS EXPENSE TOL-038-26 4'-0" X 3'-6" 1.13" Radii 0.63" Border 2" and 3" Series D Legend White Background Black Legend and Border		4'-0" 2'-0" NO TRUCKS LEFT LANE TOL-039-26 4'-0" X 2'-0" 3" Radii 1" Border 6" Series C Legend White Background Black Legend and Border		9'-0" 3'-6" NO TRUCKS LEFT LANE TOL-039A-26 9'-0" X 3'-6" 6" Radii 1.25" Border 10" Series E Legend White Background Black Legend and Border		9'-6" 5'-6" BEGIN NO TRUCKS LEFT LANE TOL-040-26 9'-6" X 5'-6" 9" Radii 2" Border TOP: 10" Series E Legend Yellow Background Black Legend and Border BOTTOM: 10" Series E Legend White Background Black Legend and Border	
9'-6" 5'-6" END TRUCK LANE RESTRICTION TOL-041-26 9'-6" X 5'-6" 9" Radii 2" Border TOP: 10" Series E Legend Yellow Background Black Legend and Border BOTTOM: 10" Series E Legend White Background Black Legend and Border		14'-0" 7'-0" DO NOT CROSS DOUBLE SOLID WHITE LINES TOL-042-26 14'-0" X 7'-0" 11" Radii 2" Border 12" Series E Legend White Background Black Legend and Border		13'-0" 8'-0" LANE RESTRICTION ENDS TOL-043-26 13'-0" X 8'-0" 12" Radii 2" Border 13.5" Series E Legend White Background Black Legend and Border		13'-0" 9'-6" LANE RESTRICTION ENDS X MILE TOL-044-26 13'-0" X 9'-6" 12" Radii 2" Border 10" and 13.5" Series E Legend White Background Black Legend and Border	
LAST REVISION 11/01/26 DESCRIPTION:		FDOT FY 2027-28 STANDARD PLANS		SPECIAL SIGN DETAILS		INDEX 700-102	SHEET 27 of 29

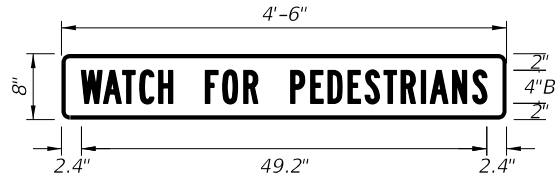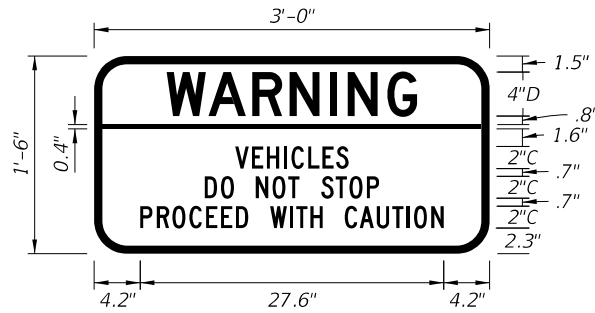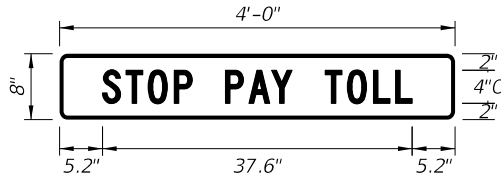

TOL-045-26
1'-6" X 1'-0"
1.5" Radii 1/2" Border

3" Series C Legend
Fluorescent Yellow Background
Black Legend and Border

TOL-046-26
4'-0" X 8"
1" Radii 1/2" Border

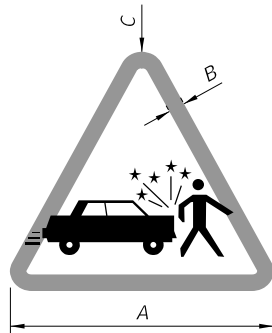
4" Series C Legend
Red Background
White Legend and Border

TOL-047-26
3'-0" X 1'-6"
3" Radii 3/4" Border

TOP:
4" Series D Legend
White Legend
Red Background
BOTTOM:
2" Series D Legend
White Background
Black Legend

TOL-048-26
4'-6" X 8"
1" Radii 1/2" Border

4" Series B Legend
Fluorescent Yellow Background
Black Legend and Border





TOLL ATTENDANT WARNING SYMBOL

SYMBOL DIMENSIONS

Size	A	B	C
8"	8"	0.6"	0.6"
14"	1"	1"	1"

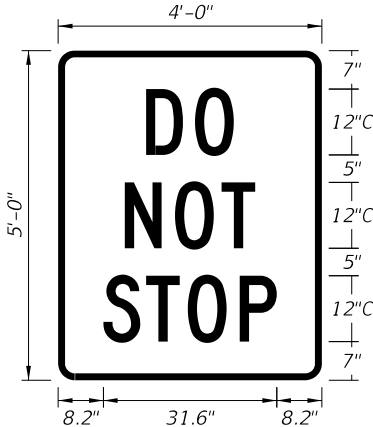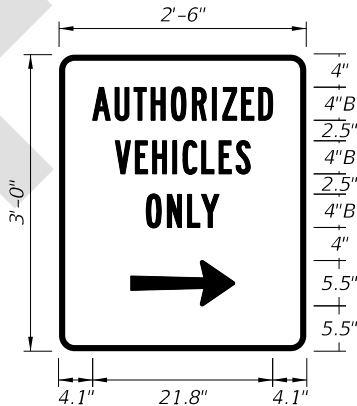- NOTE:
1. Place symbols in booth doorways and walkway as shown in the Plans.
 2. Clean surfaces thoroughly prior to application.



TOL-049-26
Yellow Background
Black Legend
Red Border

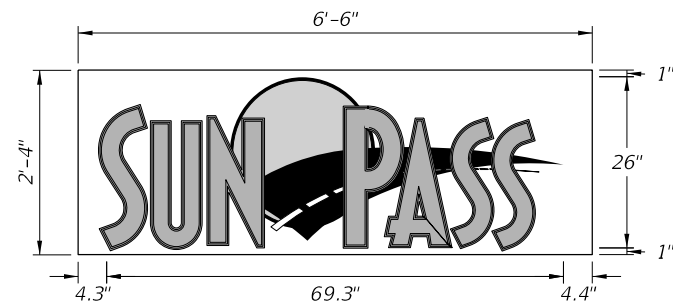
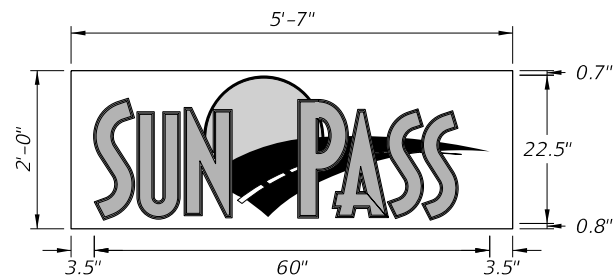
TOL-050-26
2'-6" X 3'-0"
1.875" Radii 3/4" Border

4" Series B Legend
White Background
Black Legend and Border

TOL-051-26
4'-0" X 5'-0"
1.5" Radii 1/2" Border



12" Series C Legend
White Background
Black Legend and Border

DRAFT









- NOTES:
1. See FDOT Highway Sign Library for Microstation formatted logos.
 2. Logos are not to be fabricated by hand cut out method.
 3. Use colors as specified in the MUTCD.

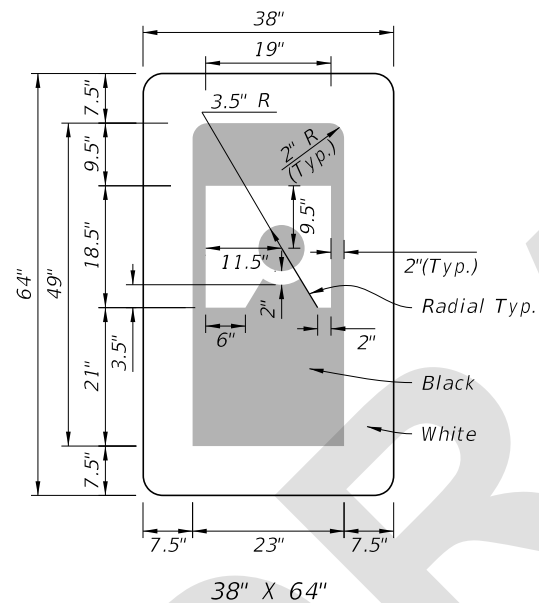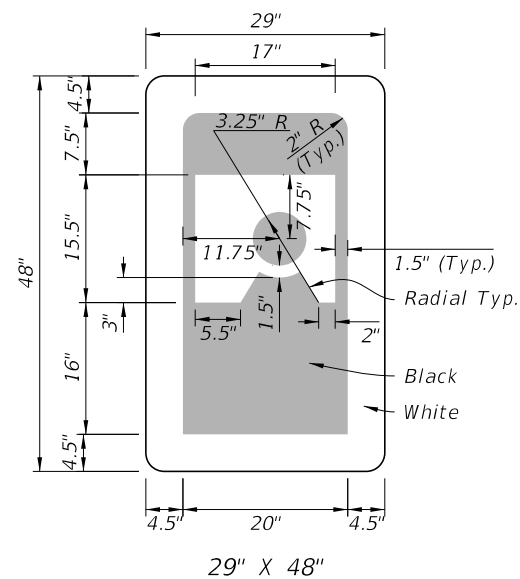
SUNPASS SHIELD




TOLL ATTENDANT SHIELD

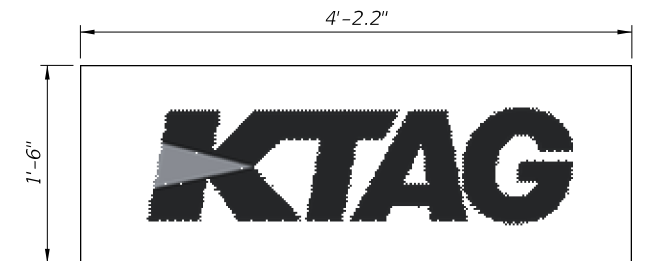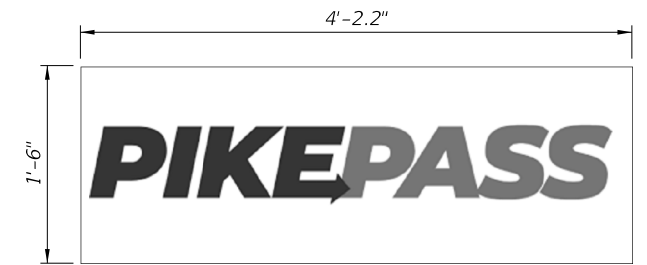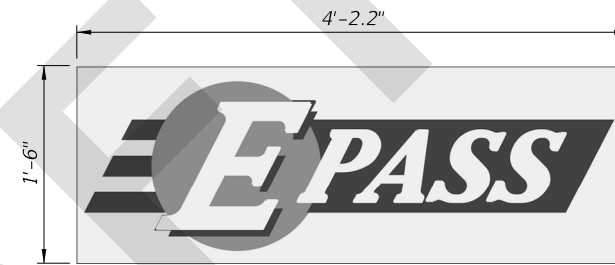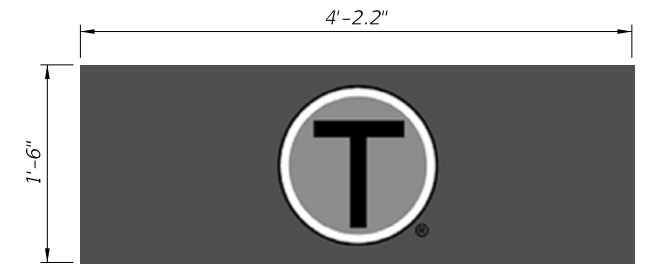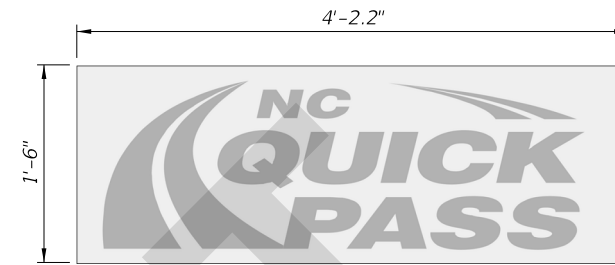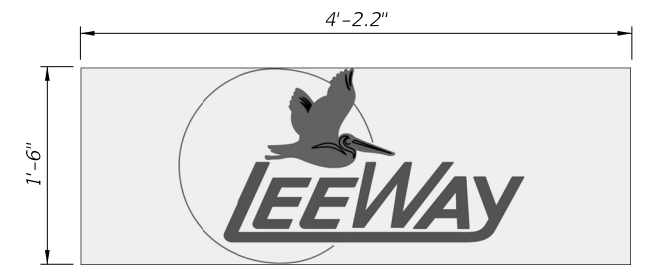

ADDITIONAL SHIELDS

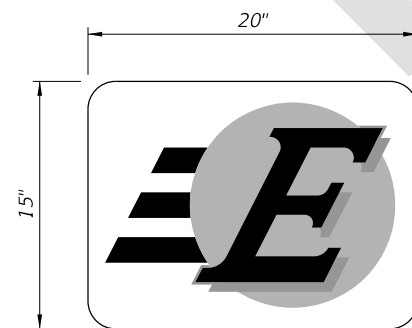

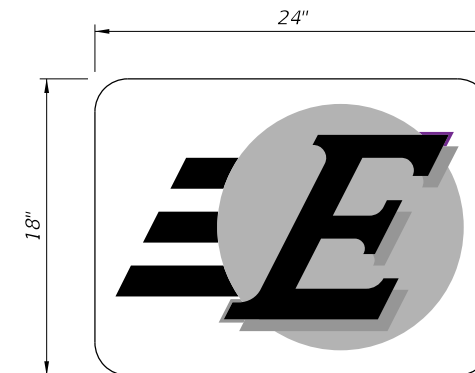- NOTES:
1. EPASS logo colors:
White
Purple, 3M Violet No. 893 or approved equal.
Orange, 3M Orange No. 886 or approved equal.
 2. Narrow portions of special design copy in EPASS logo have a minimum thickness of 1.00 inch.
 3. Attached shield by riveting method only. No adhesives or other means are allowed.



EPASS SHIELD