

Origination Form
Proposed Revisions to a Standard Plans Index

Originator:	Frimmel, James	Index Number:	700-102
Date:	5/12/26	Sheet Number(s):	All
E-mail:	james.frimmel@dot.state.fl.us	Index Title:	Special Sign Details

Summary of the changes:

ALL Sheets: Renumbered; Updating Index to accommodate changes to the Sign Library and revising dimensions for clarity.

Sheet 1: Added Note 3 "Center text within the sign horizontally, unless otherwise noted" ; Updated the Table of Contents.

Sheet 2: FTP-007A-25 Remove 6" Series C Legend

Sheet 4: FTP-019-25 Determine if Supplemental Panel reference is FTP-017-25 or 018-25, FTP-021-25, 80% Spacing; Deleted the horizontal dimensions for FTP-019-26 and FTP-019A-26.

Sheet 5: FTP-031 & 032 changed border from 3/4" to 1/4"; FTP-034U-25 Updated Detail and Table.

Sheet 10: FTP-415-25 changed border to 1/2".

Sheet 12: FTP-615-25 changed border to 3/4"

Sheet 15: FTP-610B-25 Shown correct sign width (4'-0").

Sheet 16: Various notes updates/revisions.

Sheet 17: FTP-615-25 Clarify border dimension.

Sheet 20: TTC-018-25 Corrected dimension.

Sheets 22-29: Added sheets to in Toll Signs from GTR, updated naming convention for all signs, various dimension cleanup

Commentary/Background:

Index was updated to clarify dimensions and other sign details. All tolling-related signage formerly in the GTR was also added and the sign naming conventions updated for consistency throughout the index. These changes coincide and have been coordinated with updates to the Sign Library and TEM.

Other Affected Documents/Offices	Person Contacted	Affected (Yes/No)
Other Standard Plans		
FDOT Design Manual		
Standard Specifications		
Basis of Estimates Manual		
Approved Product List		
Construction Office		
Maintenance Office		

Implementation

FY 2027-28

GENERAL NOTES:

- 1. Sign dimensions are shown in width by height (W x H) throughout the Index.
- 2. See APPENDIX for previous sign numbering crosswalk.

ADDED NOTE 3: Center text within the sign horizontally, unless otherwise noted.

EDITORIAL: Rearranged

NUMBERING CONVENTION:

FTP-AAA B/C-DD or TTC-AAA B/C-DD

- AAA = Sign Type
- B = Size Adjustments to Smallest Available Sign Size (A,B,C)
- C = Left or Right (L or R)
- DD = Year of update

- Example 1: Size Adjustment - FTP-001A-25
- Example 2: Direction Application - FTP-103R-25
- Example 3: Size and Direction - FTP-037AR-25

SIGN TYPES (AAA):

- FTP-001-199: Regulatory
- FTP-200-399: Warning & Advisory
- FTP-400-599: Motorist Service
- FTP-600-799: Guide
- FTP-800-899: Recreational & Cultural
- FTP-900-999: Miscellaneous
- TTC-001-199: Temporary Traffic Control

UPDATED: Table to show new Sheets.

TABLE OF CONTENTS:	
Sheet	Description
1	General Notes and Table of Contents
2	Sign Details FTP-001-25 through FTP-007B-25
3	Sign Details FTP-008-25 through FTP-018-25
4	Sign Details FTP-019-25 through FTP-026-25
5	Sign Details FTP-027-25 through FTP-034U-25
6	Sign Details FTP-035L-25 through FTP-037-25
7	Sign Details FTP-200-25 through FTP-206B-25
8	Sign Details FTP-207-25 through FTP-208A-25
9	Sign Details FTP-400-25 through FTP-409-25
10	Sign Details FTP-410-25 through FTP-415A-25
11	Sign Details FTP-416-25 through FTP-417-25
12	Sign Details FTP-418-25 through FTP-422B-25
13	Sign Details FTP-423-25 through FTP-423A-25
14	Sign Details FTP-600-25 through FTP-609-25
15	Sign Details FTP-610 through FTP-611B-25
16	Sign Details FTP-612-25 through FTP-613-25
17	Sign Details FTP-614-25 through FTP-616A-25
18	Sign Details FTP-800-25 through FTP-802A-25
19	Sign Details TTC-001-25 through TTC-010-25
20	Sign Details TTC-011-25 through TTC-018-25
21	Sign Details TTC-019-25 through TTC-020B-25
APPENDIX	Crosswalk

Renumbered

OTHER THAN FREEWAY USE FTP-001-25 7'-0" X 3'-6" 3" Radii 1" Border		FREEWAY USE FTP-001A-25 11'-6" X 5'-6" 9" Radii 2" Border		FTP-002R-25 FTP-002L-25 14'-6" X 7'-6" 9" Radii 2" Border		FTP-003-25 3'-6" X 2'-0" 1.5" Radii ¾" Border					
FTP-004-25 4'-0" X 3'-0" 1.5" Radii ¾" Border		FTP-004A-25 9'-0" X 6'-0" 9" Radii ¾" Border		FTP-005-25 2'-0" X 2'-6" 1.5" Radii ⅝" Border		FTP-005A-25 3'-0" X 4'-0" 1.5" Radii ¾" Border					
FTP-006-25 4'-0" X 4'-0" 1.5" Radii 0.4" Border		Non-Limited Access FTP-007-25 4'-0" X 2'-0" 1.5" Radii 0.75" Border		Non-Limited Access FTP-007A-25 6'-6" X 3'-0" 3" Radii 1" Border		FTP-007B-25 10'-0" X 4'-6" 6" Radii X 1" Border					
LAST REVISION 11/01/25		DESCRIPTION: 11/01/26		FDOT FY 2026-27 STANDARD PLANS		SPECIAL SIGN DETAILS		INDEX 700-102		SHEET 2 of 21	





FTP-035R-25 2'-0" X 2'-6" 1.5" Radii 5/8" Border 5" Series C Legend White Background Black Legend and Border	FTP-035L-25 2'-0" X 2'-6" 1.5" Radii 5/8" Border 5" Series C Legend White Background Black Legend and Border	FTP-036-25 3'-0" X 1'-6" 1.5" Radii 0.5" Border 3" Series C Legend and White Background Black Legend and Border	FTP-037-25 3'-0" X 1'-0" 1.5" Radii 0.4" Border 4" Series C Legend Fluorescent Yellow Green Background Black Legend and Border
--	--	---	--


--	--	--	--	--

LAST REVISION	DESCRIPTION:	 FY 2026-27 STANDARD PLANS	SPECIAL SIGN DETAILS	INDEX 700-102	SHEET 6 of 21

1/14/2026 7:16:11 AM

Renumbered

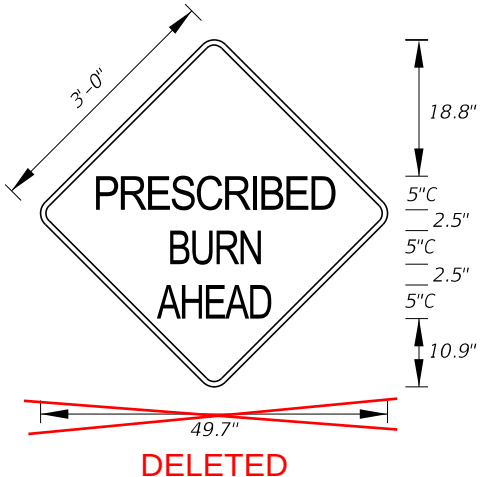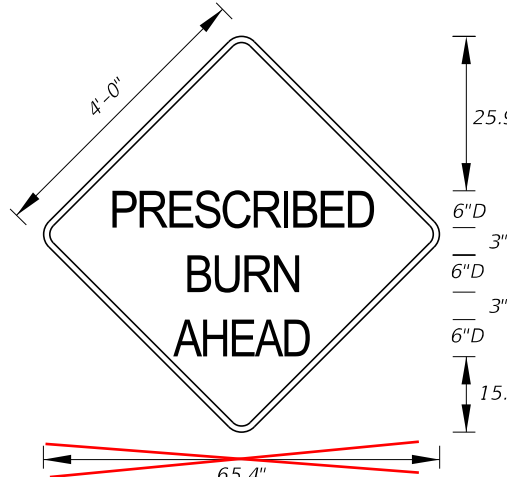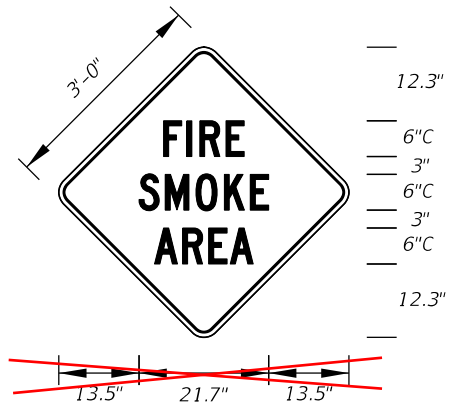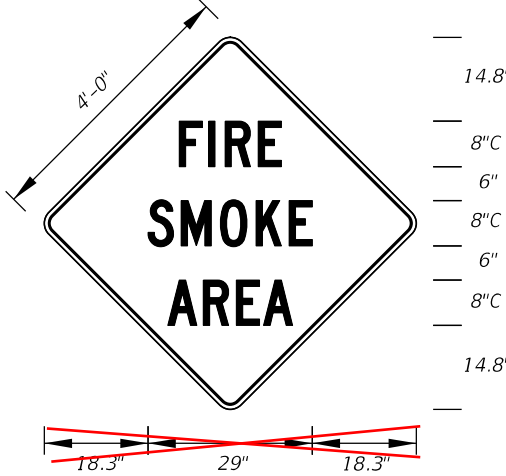
<i>Non-Limited Access</i>  FTP-207-25 3'-0" X 3'-0" 1.5" Radii $\frac{3}{4}$" Border 5" Series C Legend Yellow Background Black Legend and Border	<i>Limited Access</i>  FTP-207A-25 4'-0" X 4'-0" 3" Radii $\frac{3}{4}$" Border 6" Series D Legend Yellow Background Black Legend and Border	 FTP-208-25 3'-0" X 3'-0" 1.5" Radii $\frac{3}{4}$" Border 6" Series C Legend Yellow Background Black Legend and Border	 FTP-208A-25 4'-0" X 4'-0" 1.5" Radii $\frac{3}{4}$" Border 8" Series C Legend Yellow Background Black Legend and Border
---	---	--	--

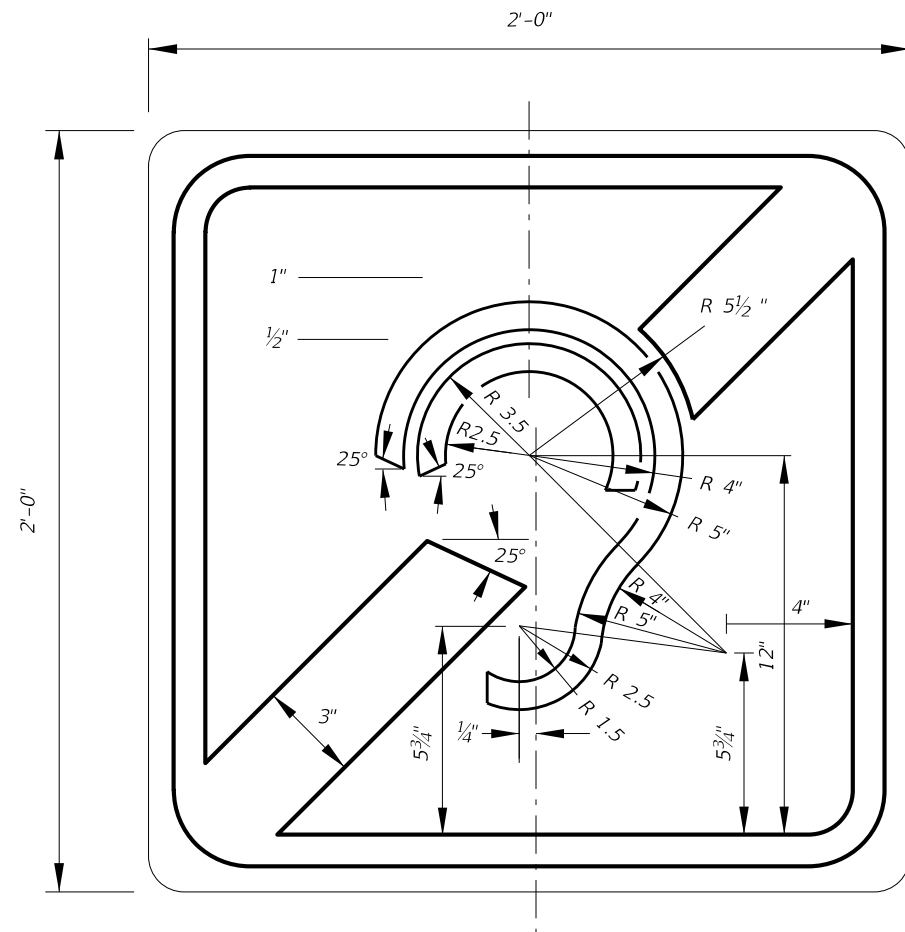

INTERNATIONAL SYMBOL OF
ACCESS FOR HEARING LOSS

FTP-416-25
2'-0" X 2'-0"
1.5" Radii $\frac{5}{8}$ " Border

Blue Background
White Legend and Border

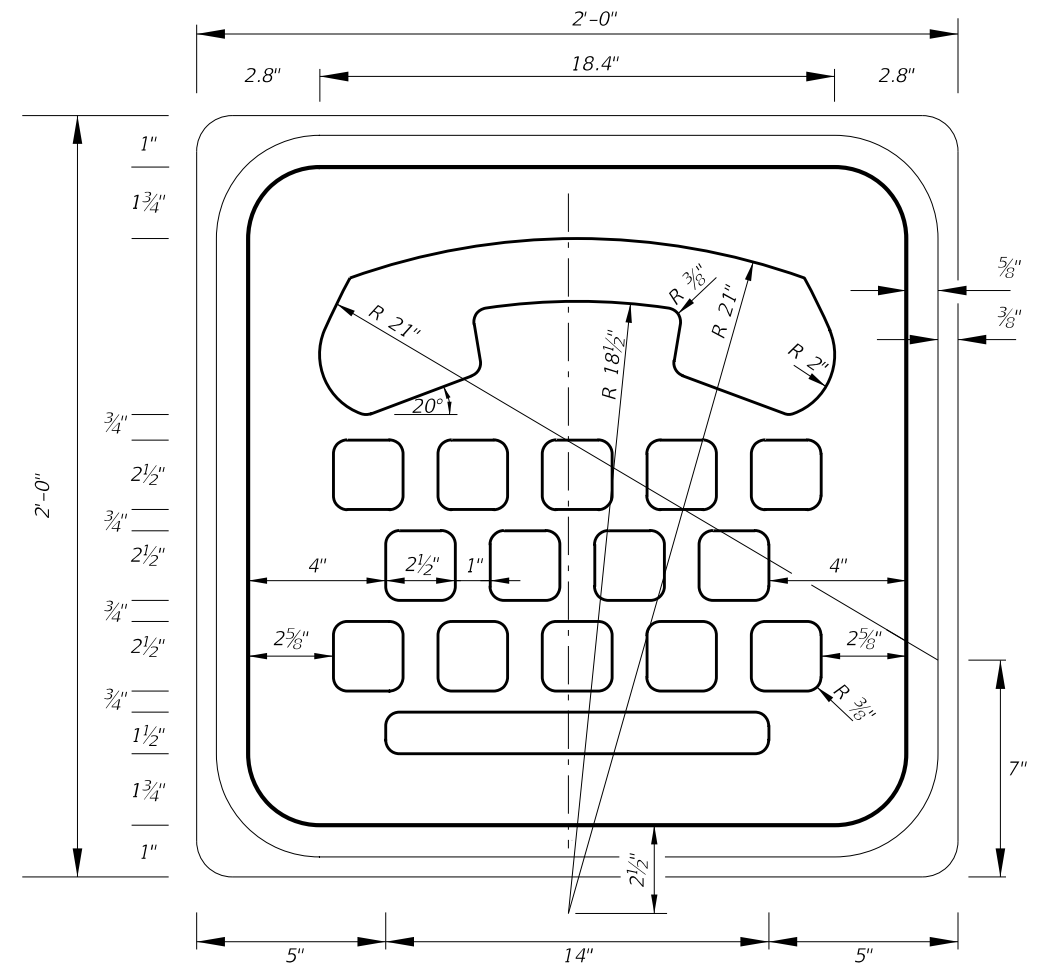


INTERNATIONAL TDD SYMBOL

FTP-417-25
2'-0" X 2'-0"
1.5" Radii $\frac{5}{8}$ " Border


Blue Background
White Legend and Border

Renumbered

1/14/2026 7:16:25 AM

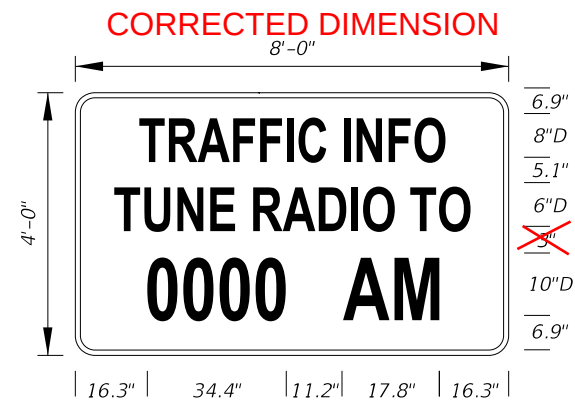

FTP-423-25
8'-0" X 4'-0"
3" Radii 3/4" Border
6", 8" and 10" Series D Legend
Blue Background
White Legend and Border

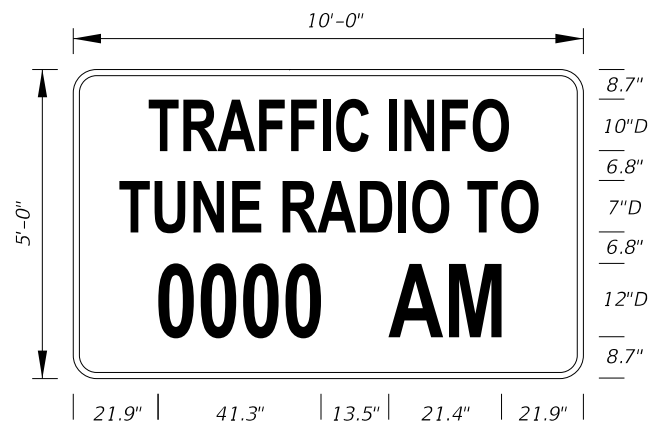

FTP-423A-25
10'-0" X 5'-0"
9" Radii 2" Border
7", 10" and 12" Series D Legend
Blue Background
White Legend and Border

LAST REVISION	DESCRIPTION:
11/01/25	11/01/26



NEW SHEET 22

AET-001-26 Through AET-002A-26

NEW SHEET 23

TOL-001-26 Through TOL-011-26

NEW SHEET 24

TOL-012-26 Through TOL-020-26

NEW SHEET 25

TOL-021-26 Through TOL-024B-26

NEW SHEET 26

TOL-025-26 Through TOL-033-26

NEW SHEET 27

TOL-034-26 Through TOL-044-26

NEW SHEET 28

TOL-045-26 Through TOL-051-26

NEW SHEET 29

SUNPASS Shield, Toll Attendant Shield, EPASS Shield, Additional Shields

