

Origination Form
Proposed Revisions to a Standard Plans Index

Originator:	Gray, Ryan	Index Number:	711-001
Date:	9/4/2025	Sheet Number(s):	2 and 7
E-mail:	ryan.gray@dot.state.fl.us	Index Title:	Pavement Markings

Summary of the changes:

Sheet 2: Deleted "Lane" line restrictions for solid line contrast.
 Sheet 7: Updated "Delineator Post" to "Type 2 Object Marker" in callouts. Updated Note 2B to "Option 2: Type 2 Object Marker. Use two OM2-2V panels back to back on single post."



Commentary/Background:

Sheet 2: Allowing contrast markings on all longitudinal solid lines will assist autonomous vehicles with lane recognition.
 Sheet 7: The function and perception of what delineators are (and do) has evolved over the years - Nomenclature in the Index needs to be updated to align with current device descriptions.

Other Affected Documents/Offices	Person Contacted	Affected (Yes/No)
Other Standard Plans		No
FDOT Design Manual		FDM
Standard Specifications		No
Basis of Estimates Manual		Yes
Approved Product List		No
Construction Office		No
Maintenance Office		No

Implementation


FY 2027-28

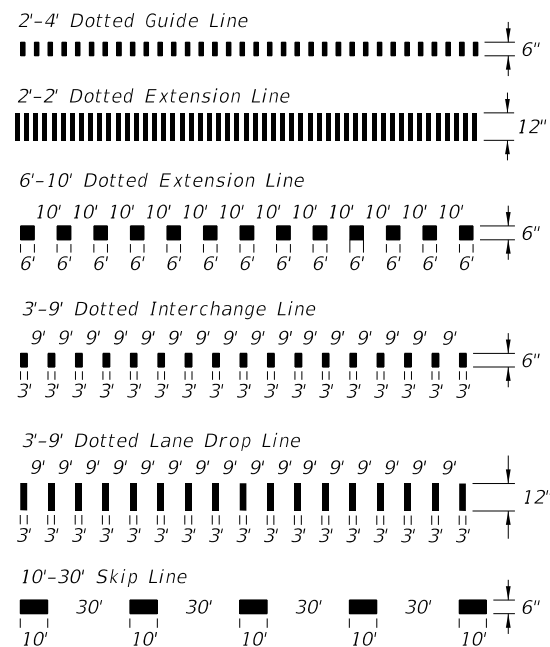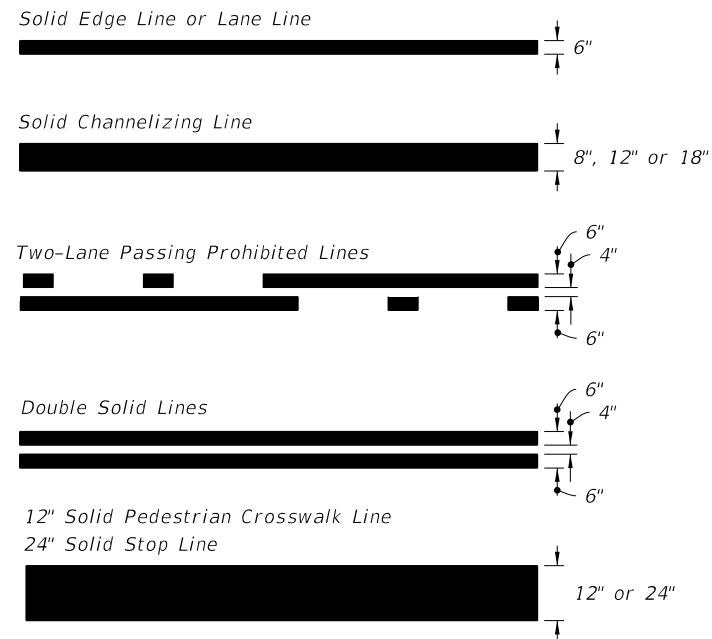

PAVEMENT MARKING LINES




10'-30' SKIP LINE WITH CONTRAST MARKINGS

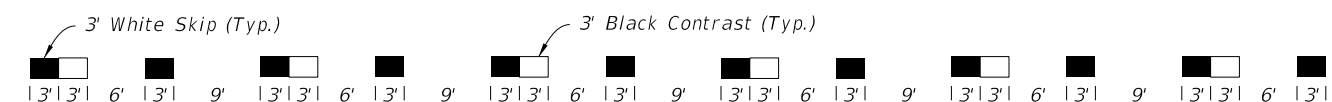

DOTTED LINE WITH ALTERNATING CONTRAST MARKINGS


(3'-9' Dotted Line Shown, Other Dotted Lines Similar)

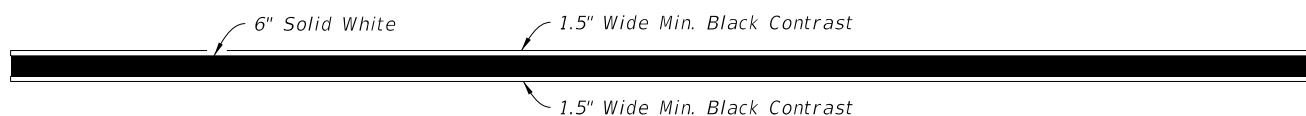


LONGITUDINAL SOLID LANE LINE WITH CONTRAST MARKINGS

(Not For Use On Edge Lines)

DELETED Lane line restriction


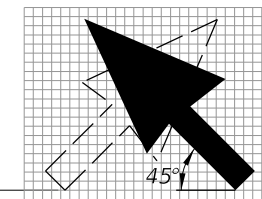


25'-0"

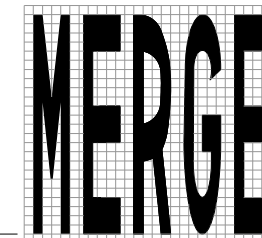

MARKINGS FOR MERGE

Direction of Traffic

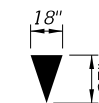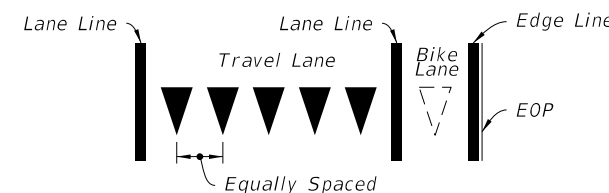






Yield Lines consist of five - 18" X 27" white triangles which face traffic. Equally space triangles within traffic lane. When a bike lane is present, add one additional triangle in the center of the bike lane.

YIELD LINES

3:38:05 PM
4/22/2026

LAST REVISION	DESCRIPTION:		FY 2027-28 STANDARD PLANS	PAVEMENT MARKINGS	INDEX	SHEET
11/01/22	11/01/26				711-001	2 of 13

General Redevelopment

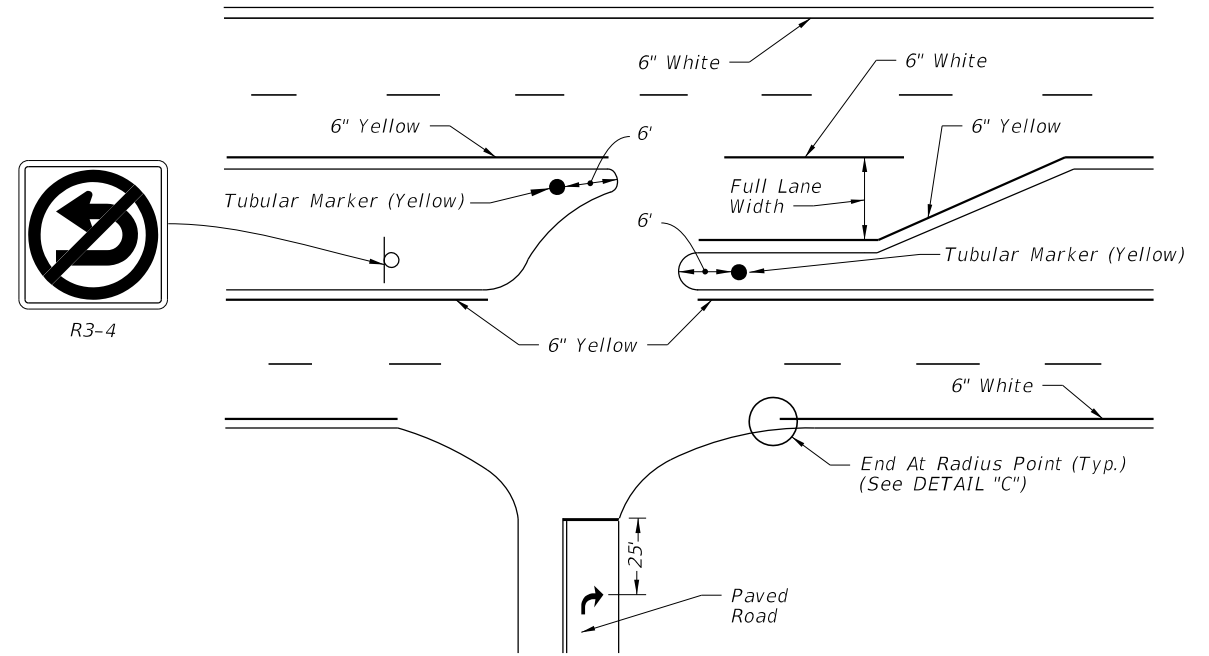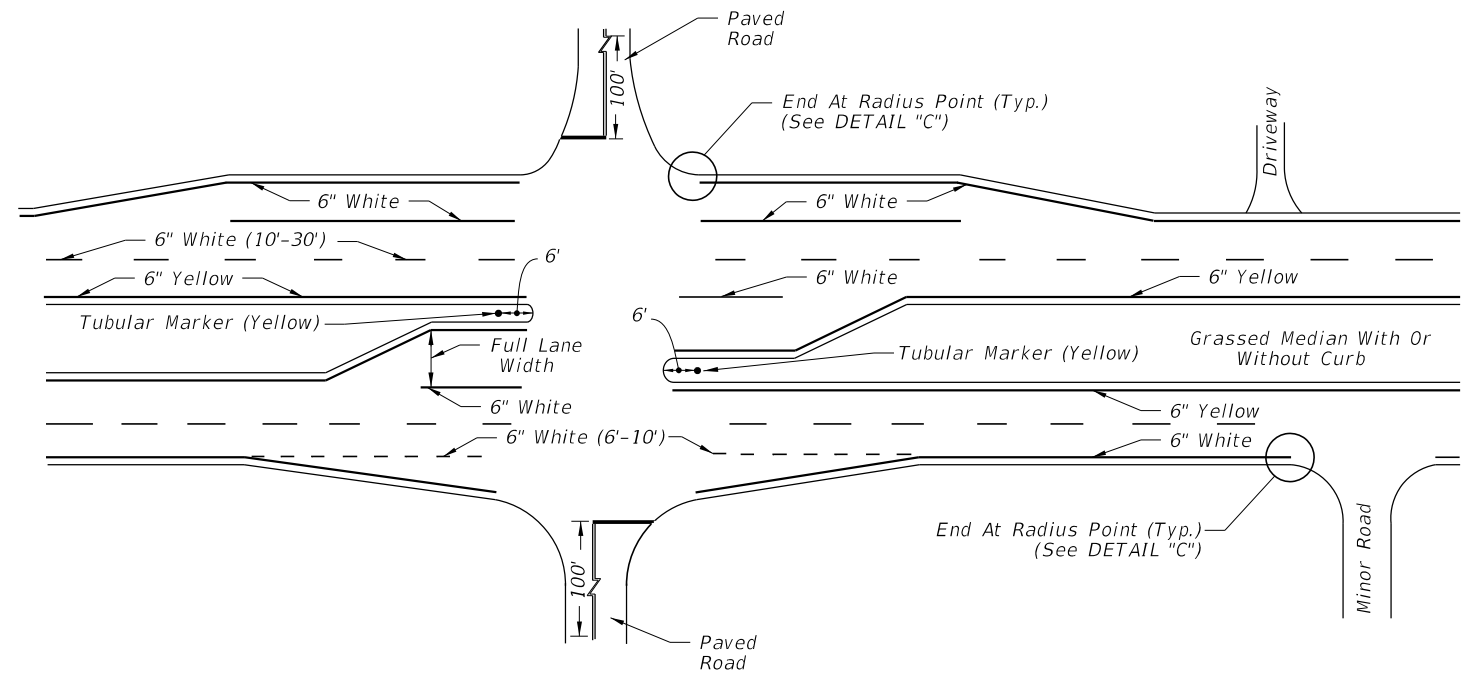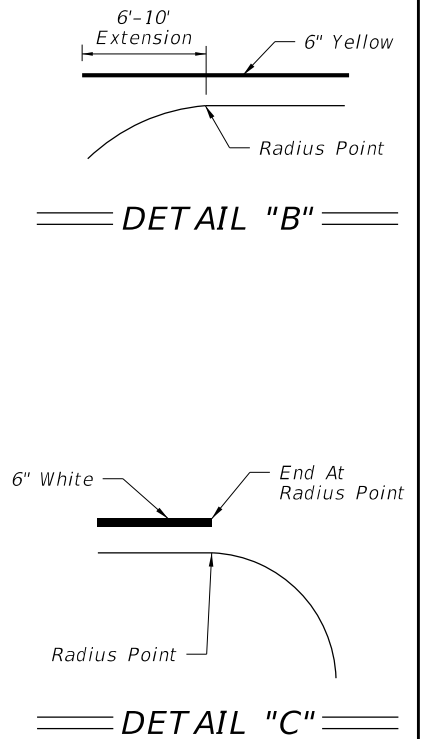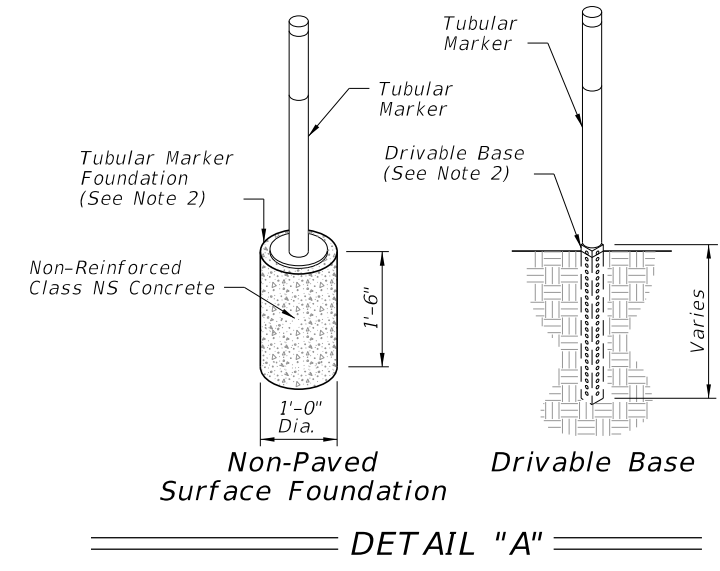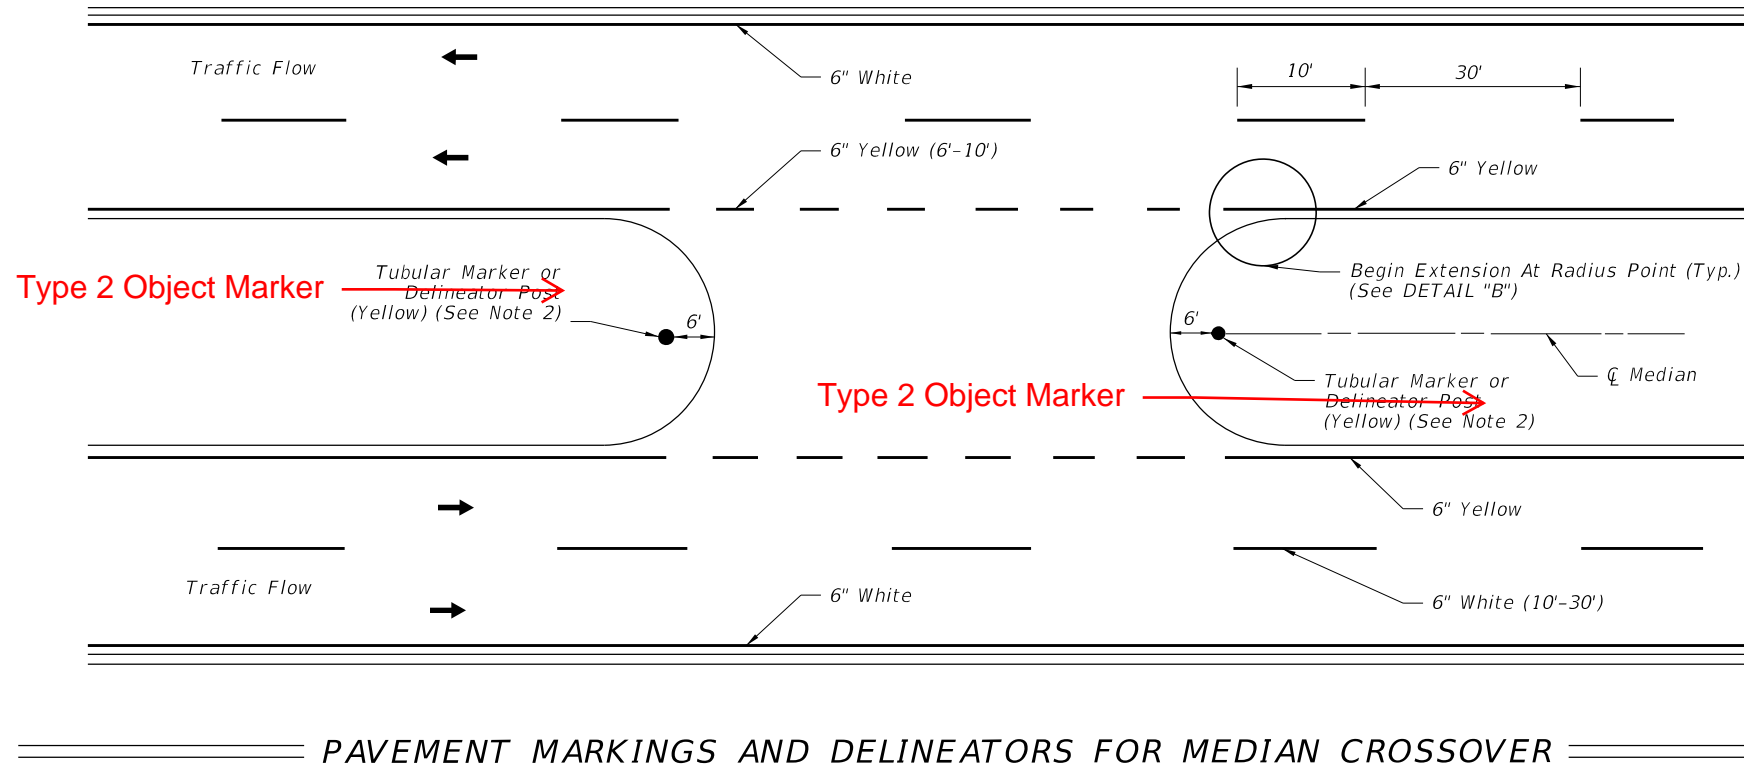

NOTES:



1. Apply yellow retroreflective durable paint to the noses of curbed medians, traffic separators, and raised islands; When applying yellow retroreflective paint in conjunction with Raised Pavement Markers, see Index 706-001.
2. Options for grassed medians:
 - A. Option 1: Tubular Marker (Yellow). Attach Tubular Marker according to manufacturer's instructions. For grassed medians without a suitable mounting surface, use either a drivable base type, or provide a Non-Paved Surface Foundation (See Detail "A"). Install Non-Paved Surface Foundation flush with the surrounding ground surface.
 - B. Option 2: Delineator Post. Use yellow retroreflective sheeting on both sides of the delineator. Install the post so that the top is 4'-0" above the grade at the edge of the pavement.
3. Extend double yellow centerlines 100' back from intersection on all approaches or 50' for unmarked cross roads.

B. Option 2: Type 2 Object Marker. Use two OM2-2V panels back to back on single post.

PAVEMENT MARKINGS FOR INTERSECTIONS WITH MAJOR AND MINOR ROADS

9/4/2025 3:49:11 PM


LAST REVISION	REVISION	DESCRIPTION:		FY 2026-27 2027-28 STANDARD PLANS	PAVEMENT MARKINGS	INDEX 711-001	SHEET 7 of 13
11/01/25	11/1/26						

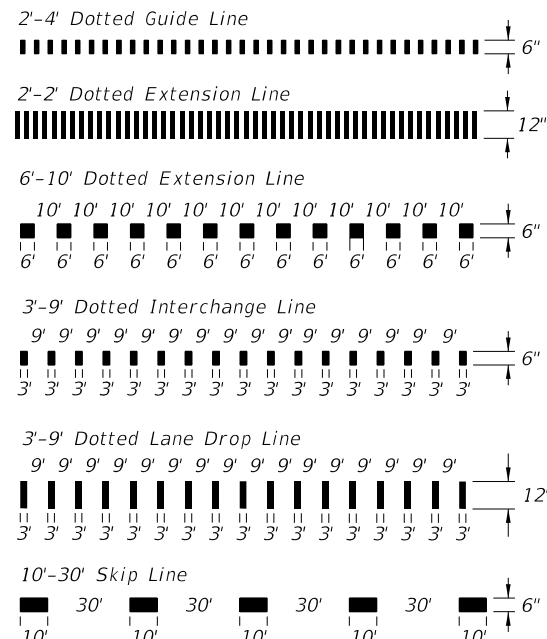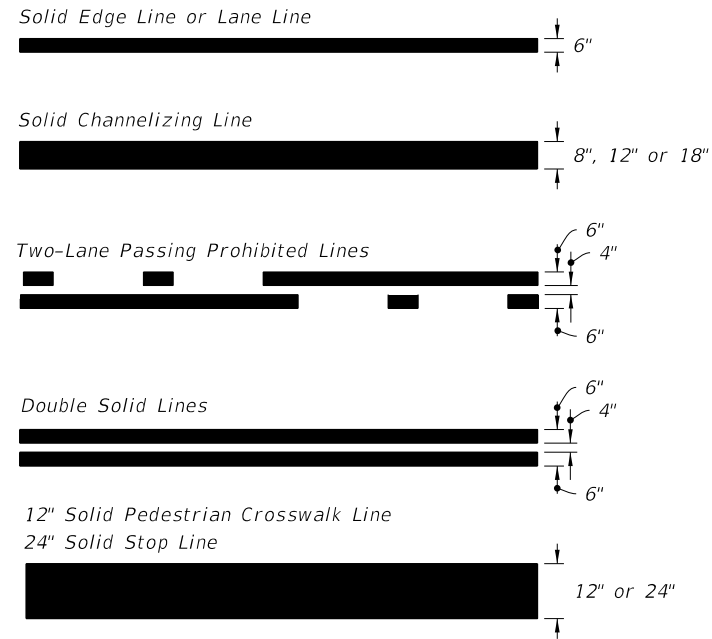

PAVEMENT MARKING LINES




10'-30' SKIP LINE WITH CONTRAST MARKINGS

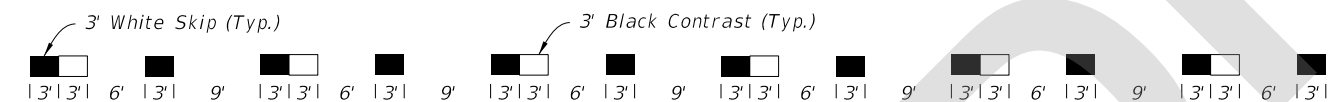


DOTTED LINE WITH ALTERNATING CONTRAST MARKINGS


(3'-9' Dotted Line Shown, Other Dotted Lines Similar)

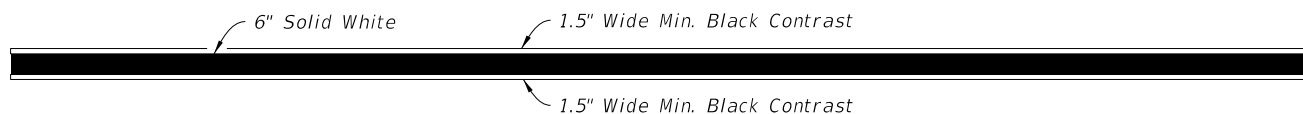

LONGITUDINAL SOLID LINE WITH CONTRAST MARKINGS

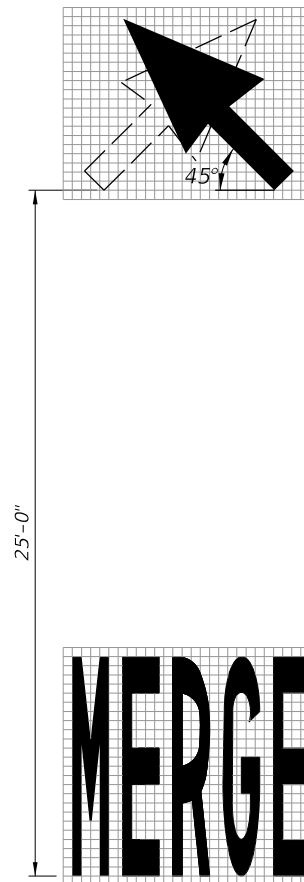

MARKINGS FOR MERGE



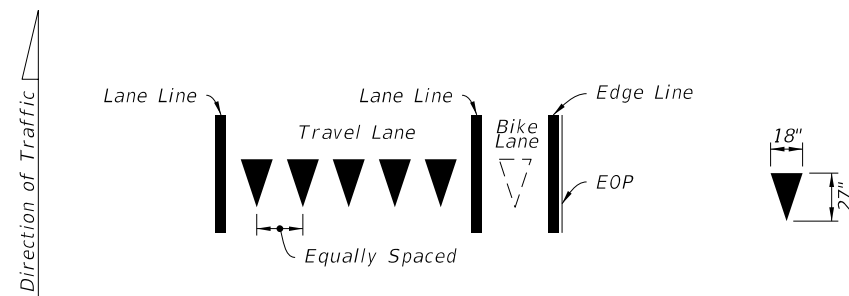


Yield Lines consist of five - 18" X 27" white triangles which face traffic. Equally space triangles within traffic lane. When a bike lane is present, add one additional triangle in the center of the bike lane.

YIELD LINES

3:46:33 PM 4/22/2026



LAST REVISION 11/01/26	DESCRIPTION:		FY 2027-28 STANDARD PLANS	PAVEMENT MARKINGS	INDEX	SHEET
			711-001		2 of 13	

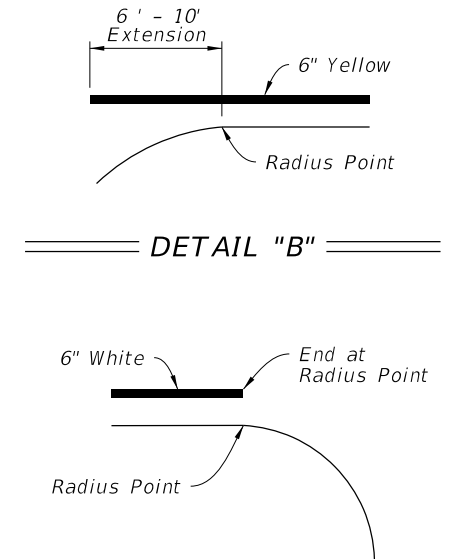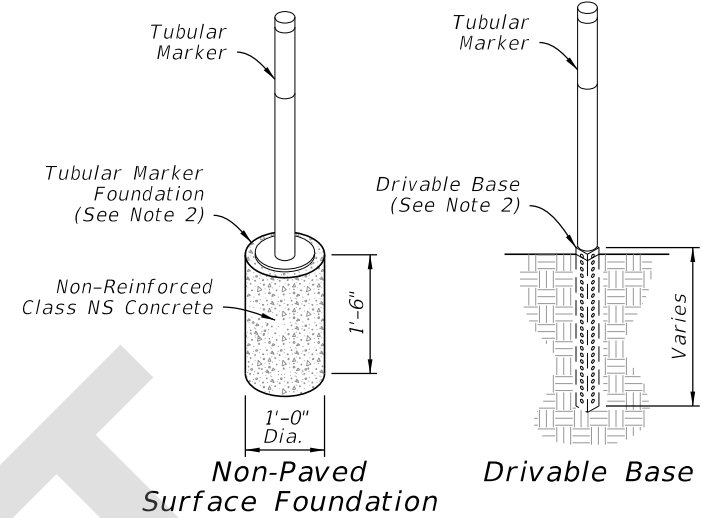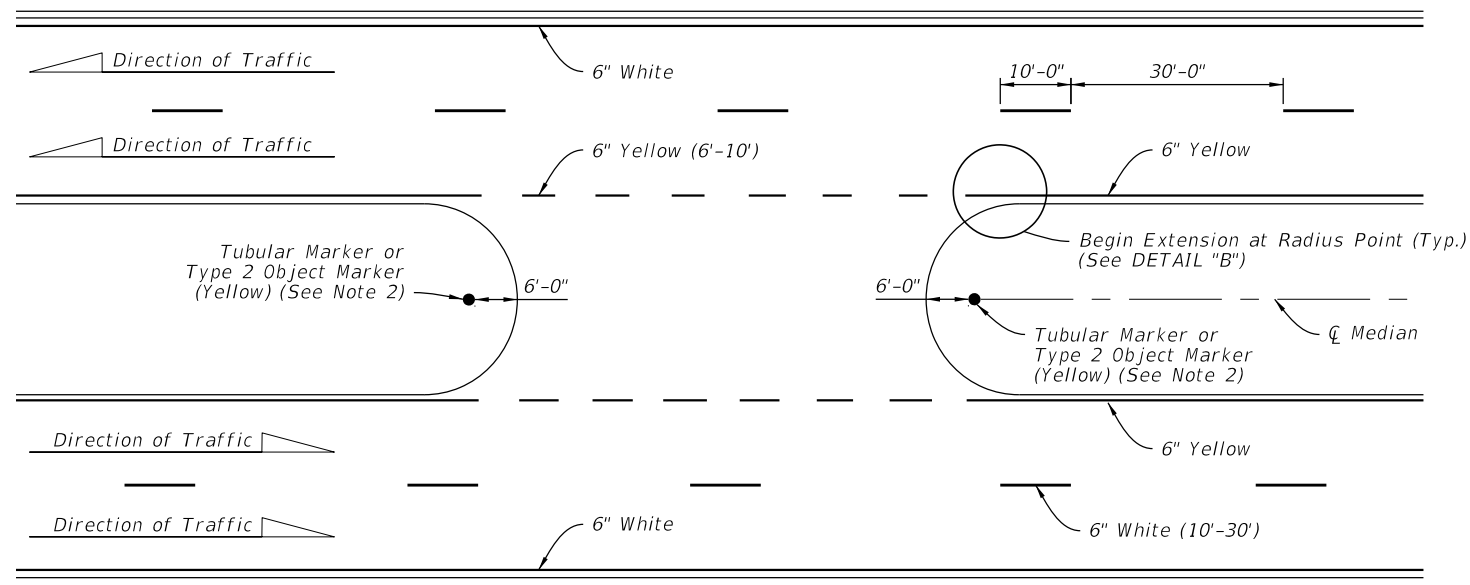

PAVEMENT MARKINGS AND DELINEATORS FOR MEDIAN CROSSOVER

DETAIL "A"

DETAIL "C"

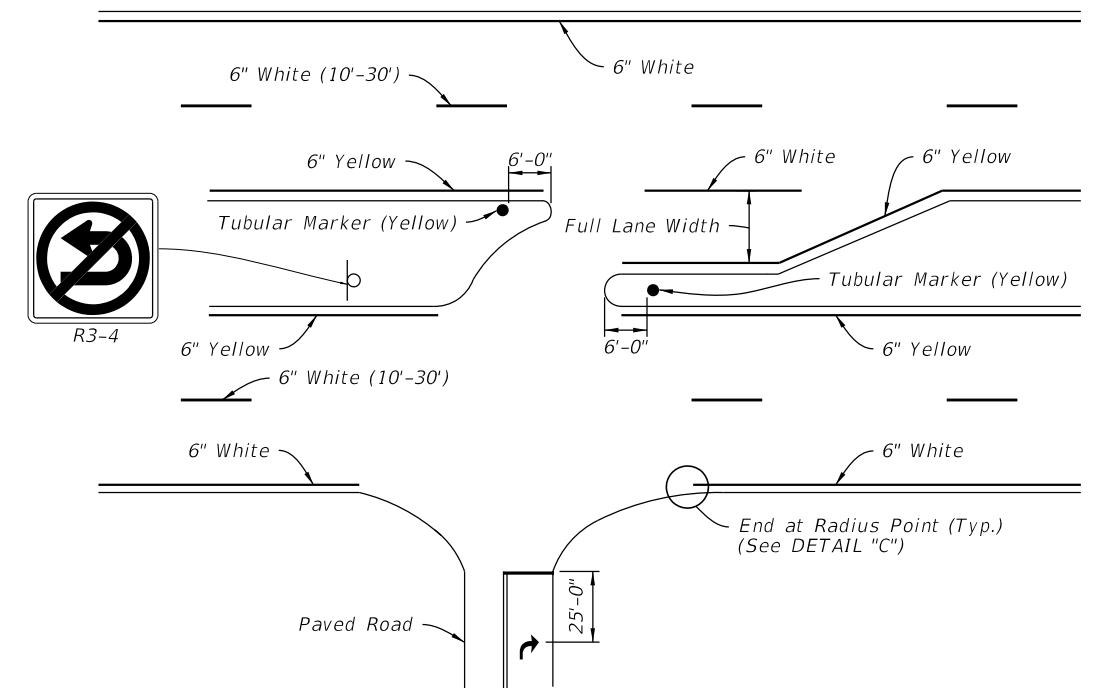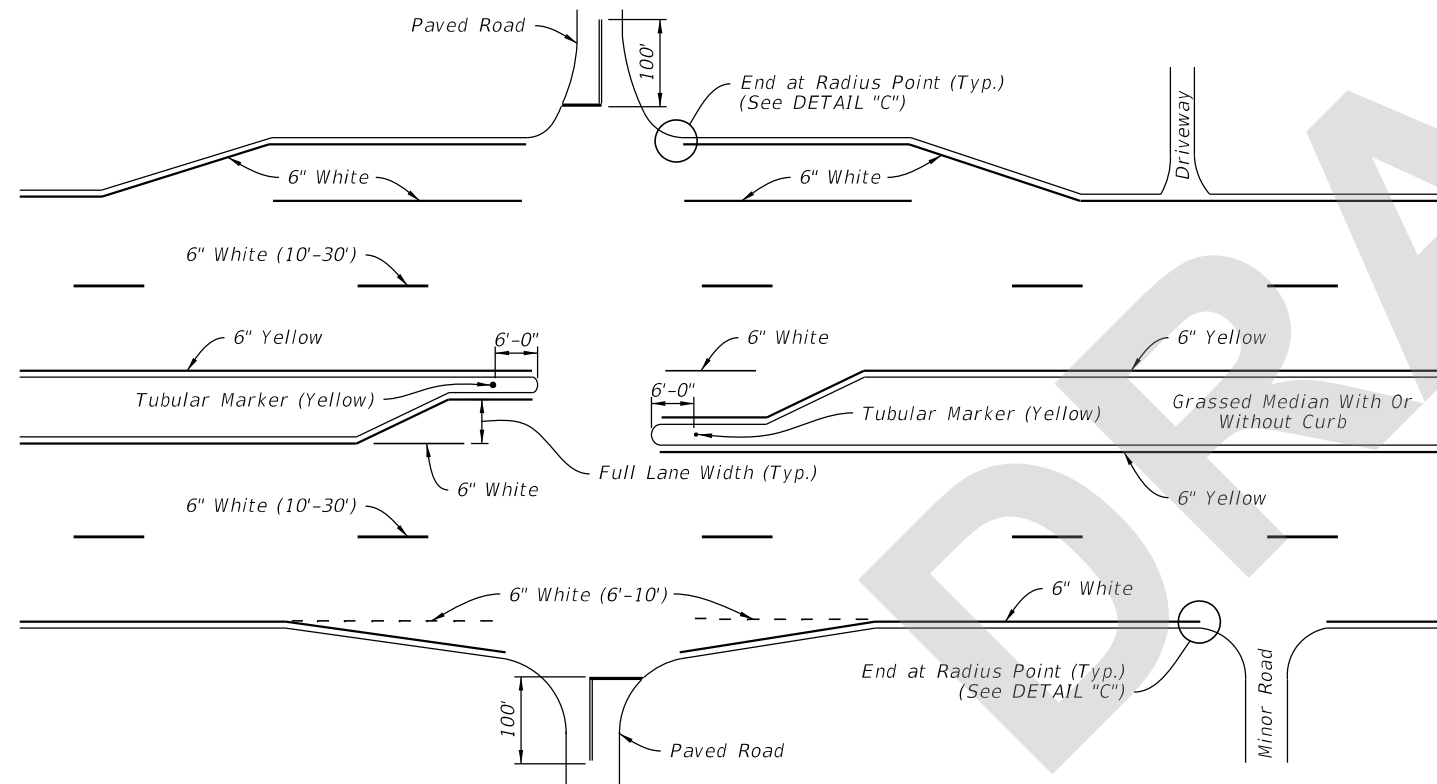

PAVEMENT MARKINGS FOR INTERSECTIONS WITH MAJOR AND MINOR ROADS

NOTES:

1. Apply yellow retroreflective durable paint to the noses of curbed medians, traffic separators, and raised islands; When applying yellow retroreflective paint in conjunction with Raised Pavement Markers, see Index 706-001.

2. Options for grassed medians:

A. Option 1: Tubular Marker (Yellow). Attach Tubular Marker according to manufacturer's instructions. For grassed medians without a suitable mounting surface, use either a Drivable Base type, or provide a Non-Paved Surface Foundation (See Detail "A"). Install Non-Paved Surface Foundation flush with the surrounding ground surface.

B. Option 2: Type 2 Object Marker. Use two OM2-2V panels back to back on single post. Install the post so that the top is 4'-0" above the grade at the edge of the pavement.

3. Extend double yellow centerlines 100' back from intersection on all approaches or 50' for unmarked cross roads.

4/17/2026 7:53:53 AM

LAST REVISION 11/01/26	REVISION	DESCRIPTION:	 FY 2027-28 STANDARD PLANS	PAVEMENT MARKINGS	INDEX 711-001	SHEET 7 of 13
---------------------------	----------	--------------	--	--------------------------	-------------------------	-------------------------