

Origination Form
Proposed Revisions to a Standard Plans Index

Originator:	Caldwell, Carey Allie	Index Number:	711-002
Date:	5/6/2026	Sheet Number(s):	1, 2
E-mail:	carey.caldwell@dot.state.fl.us	Index Title:	Bicycle Markings

Summary of the changes:

All: Updated bike lane symbols


Commentary/Background:

MUTCD 11th Edition has removed the helmeted bicyclist symbol and therefore all FDOT Standards and Criteria must be updated accordingly.

Other Affected Documents/Offices	Person Contacted	Affected (Yes/No)
Other Standard Plans	Rick Jenkins	Yes
FDOT Design Manual		No
Standard Specifications		No
Basis of Estimates Manual		No
Approved Product List		No
Construction Office		No
Maintenance Office		No

Implementation

FY 2027-28

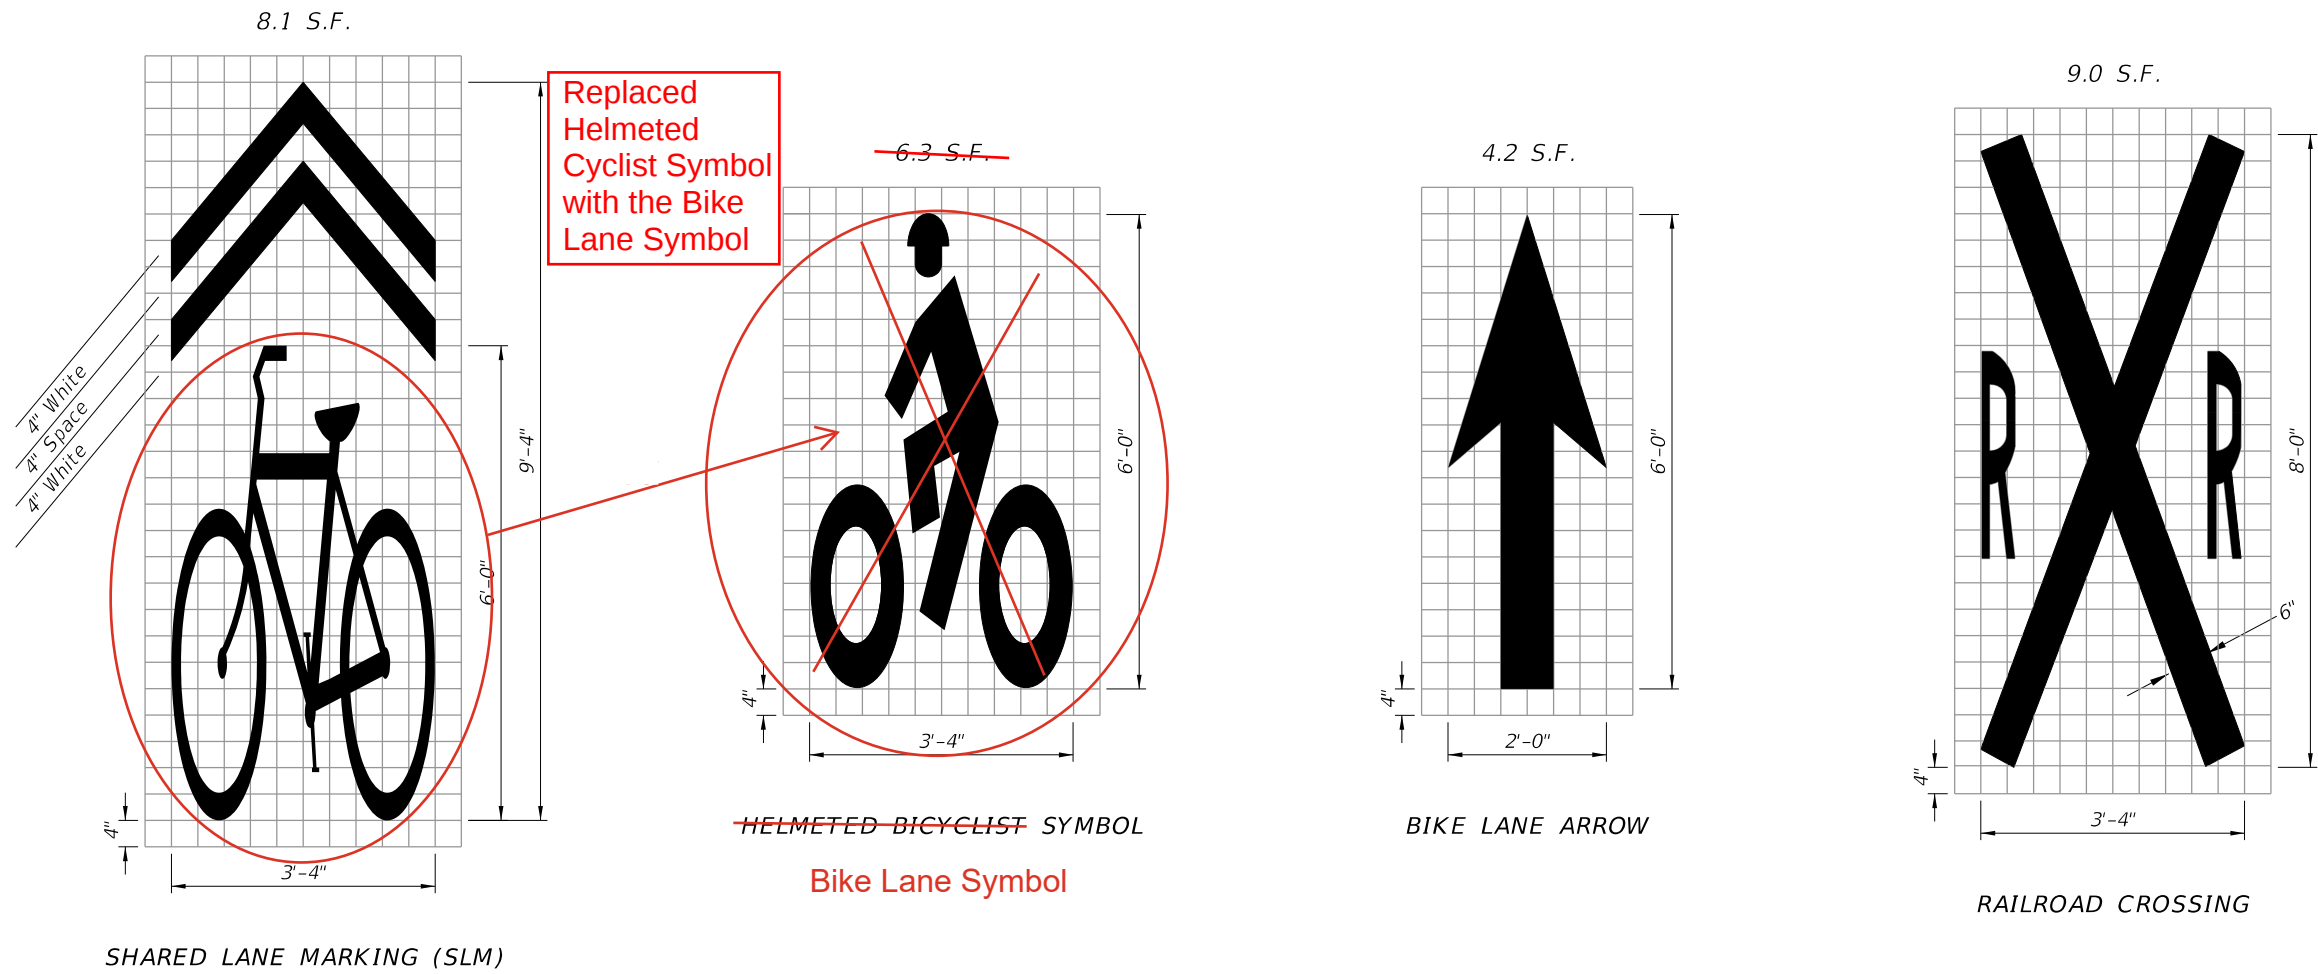

NOTES:


1. All bicycle markings and pavement messages shall be White.
2. All bicycle markings shall be preformed thermoplastic.
3. All grids are 4" x 4".

STANDARD PAVEMENT MARKING MESSAGE LAYOUTS

2027-28

LAST REVISION 11/01/17 11/01/26	REVISION DESCRIPTION:	 FY 2026-27 STANDARD PLANS	BICYCLE MARKINGS	INDEX 711-002	SHEET 1 of 2
--	--------------------------	---	------------------	------------------	-----------------





9/29/2025 8:12:14 AM

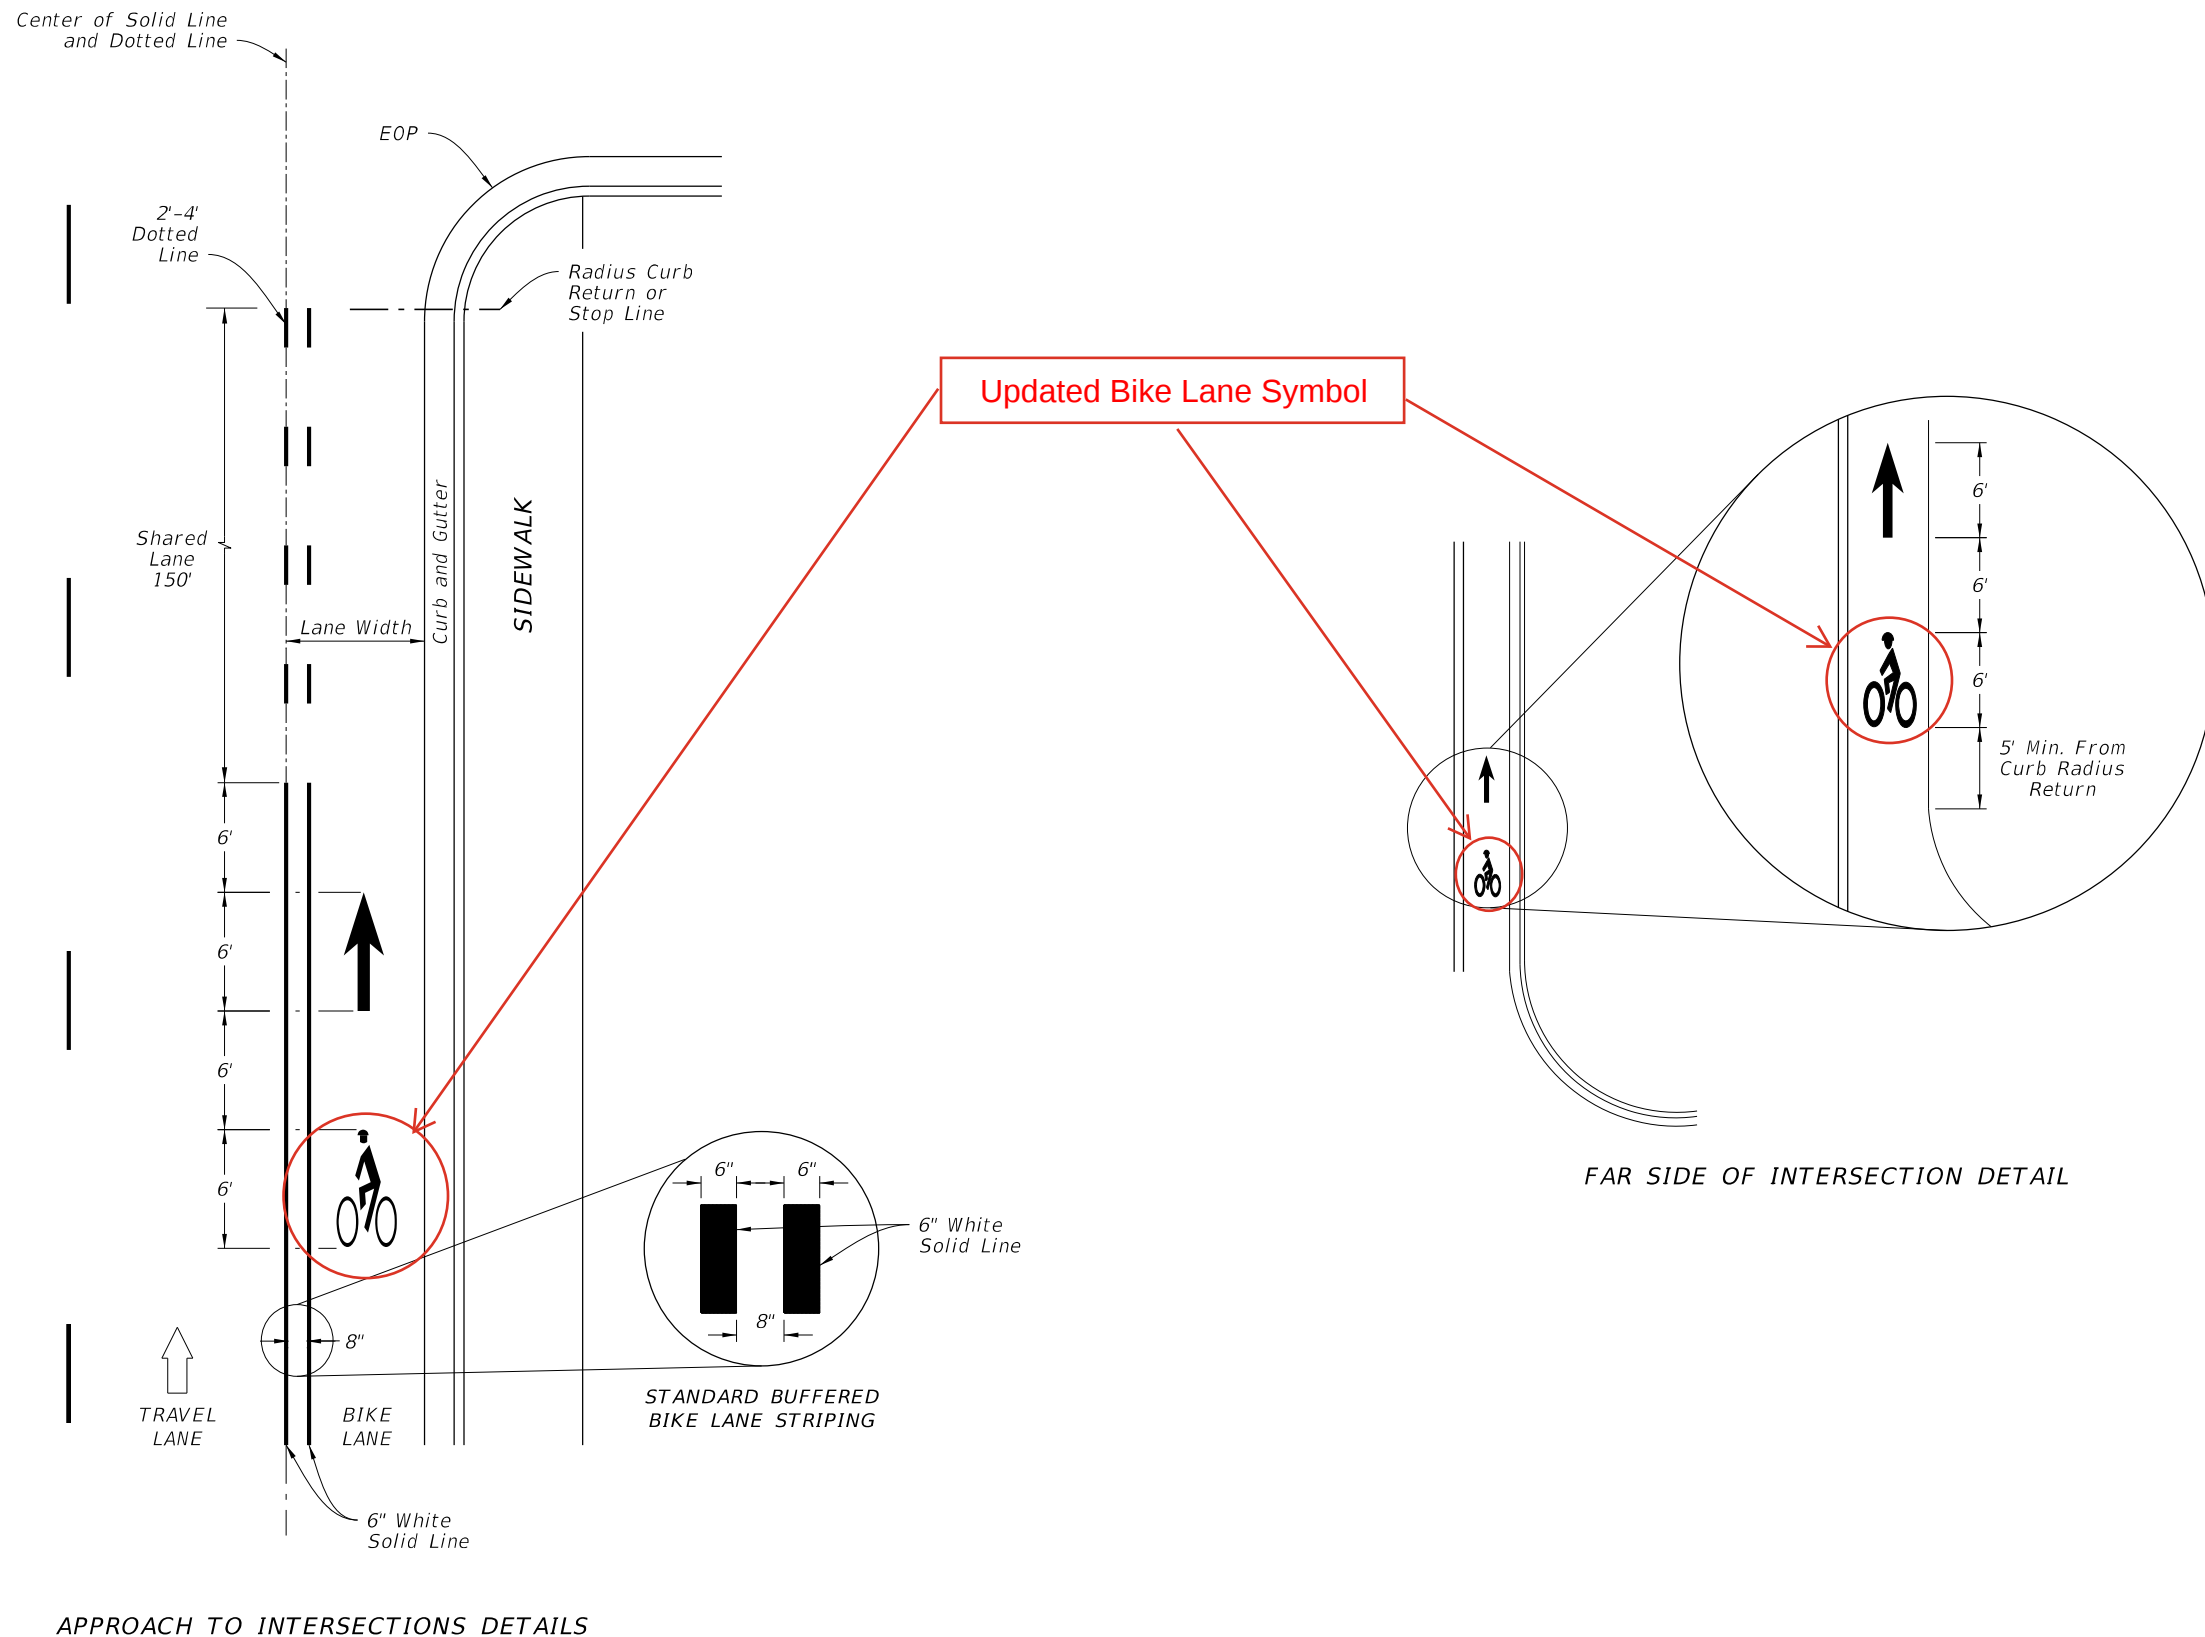

===== BUFFERED BIKE LANES =====

2027-28

LAST REVISION 11/01/17 11/01/26	REVISION	DESCRIPTION:	FDOT FY 2026-27 STANDARD PLANS	BICYCLE MARKINGS	INDEX 711-002	SHEET 2 of 2
---	----------	--------------	---	------------------	------------------	-----------------

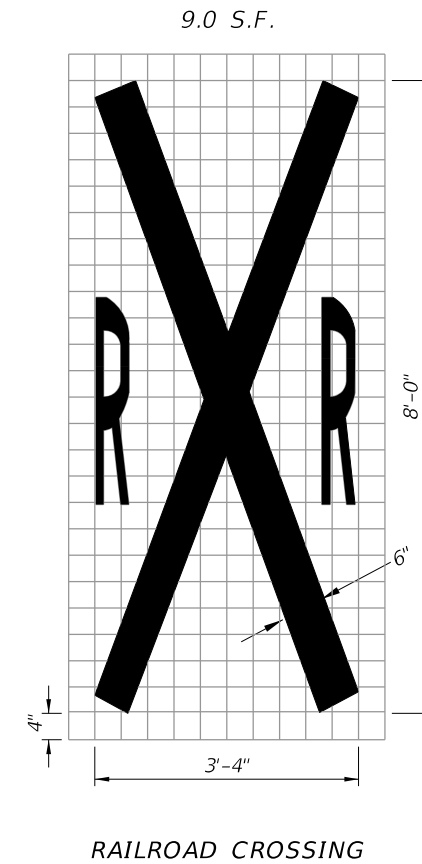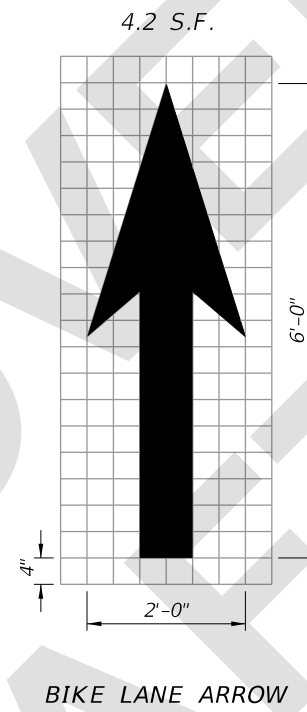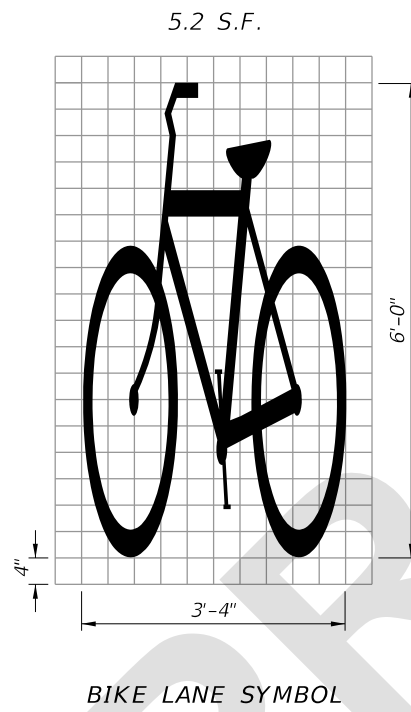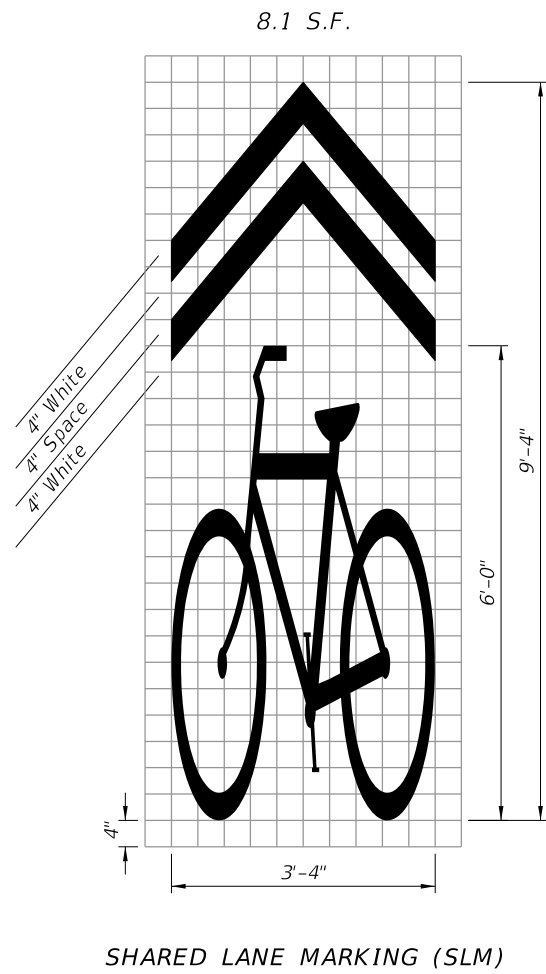

NOTES:


1. All bicycle markings and pavement messages shall be White.
2. All bicycle markings shall be preformed thermoplastic.
3. All grids are 4" x 4".

STANDARD PAVEMENT MARKING MESSAGE LAYOUTS

7/20/2026 10:42:41 AM

LAST REVISION 11/01/26	REVISION	DESCRIPTION:	 FY 2027-28 STANDARD PLANS	BICYCLE MARKINGS	INDEX 711-002	SHEET 1 of 2
------------------------------	----------	--------------	--	------------------	------------------	-----------------

7/20/2026 10:42:42 AM

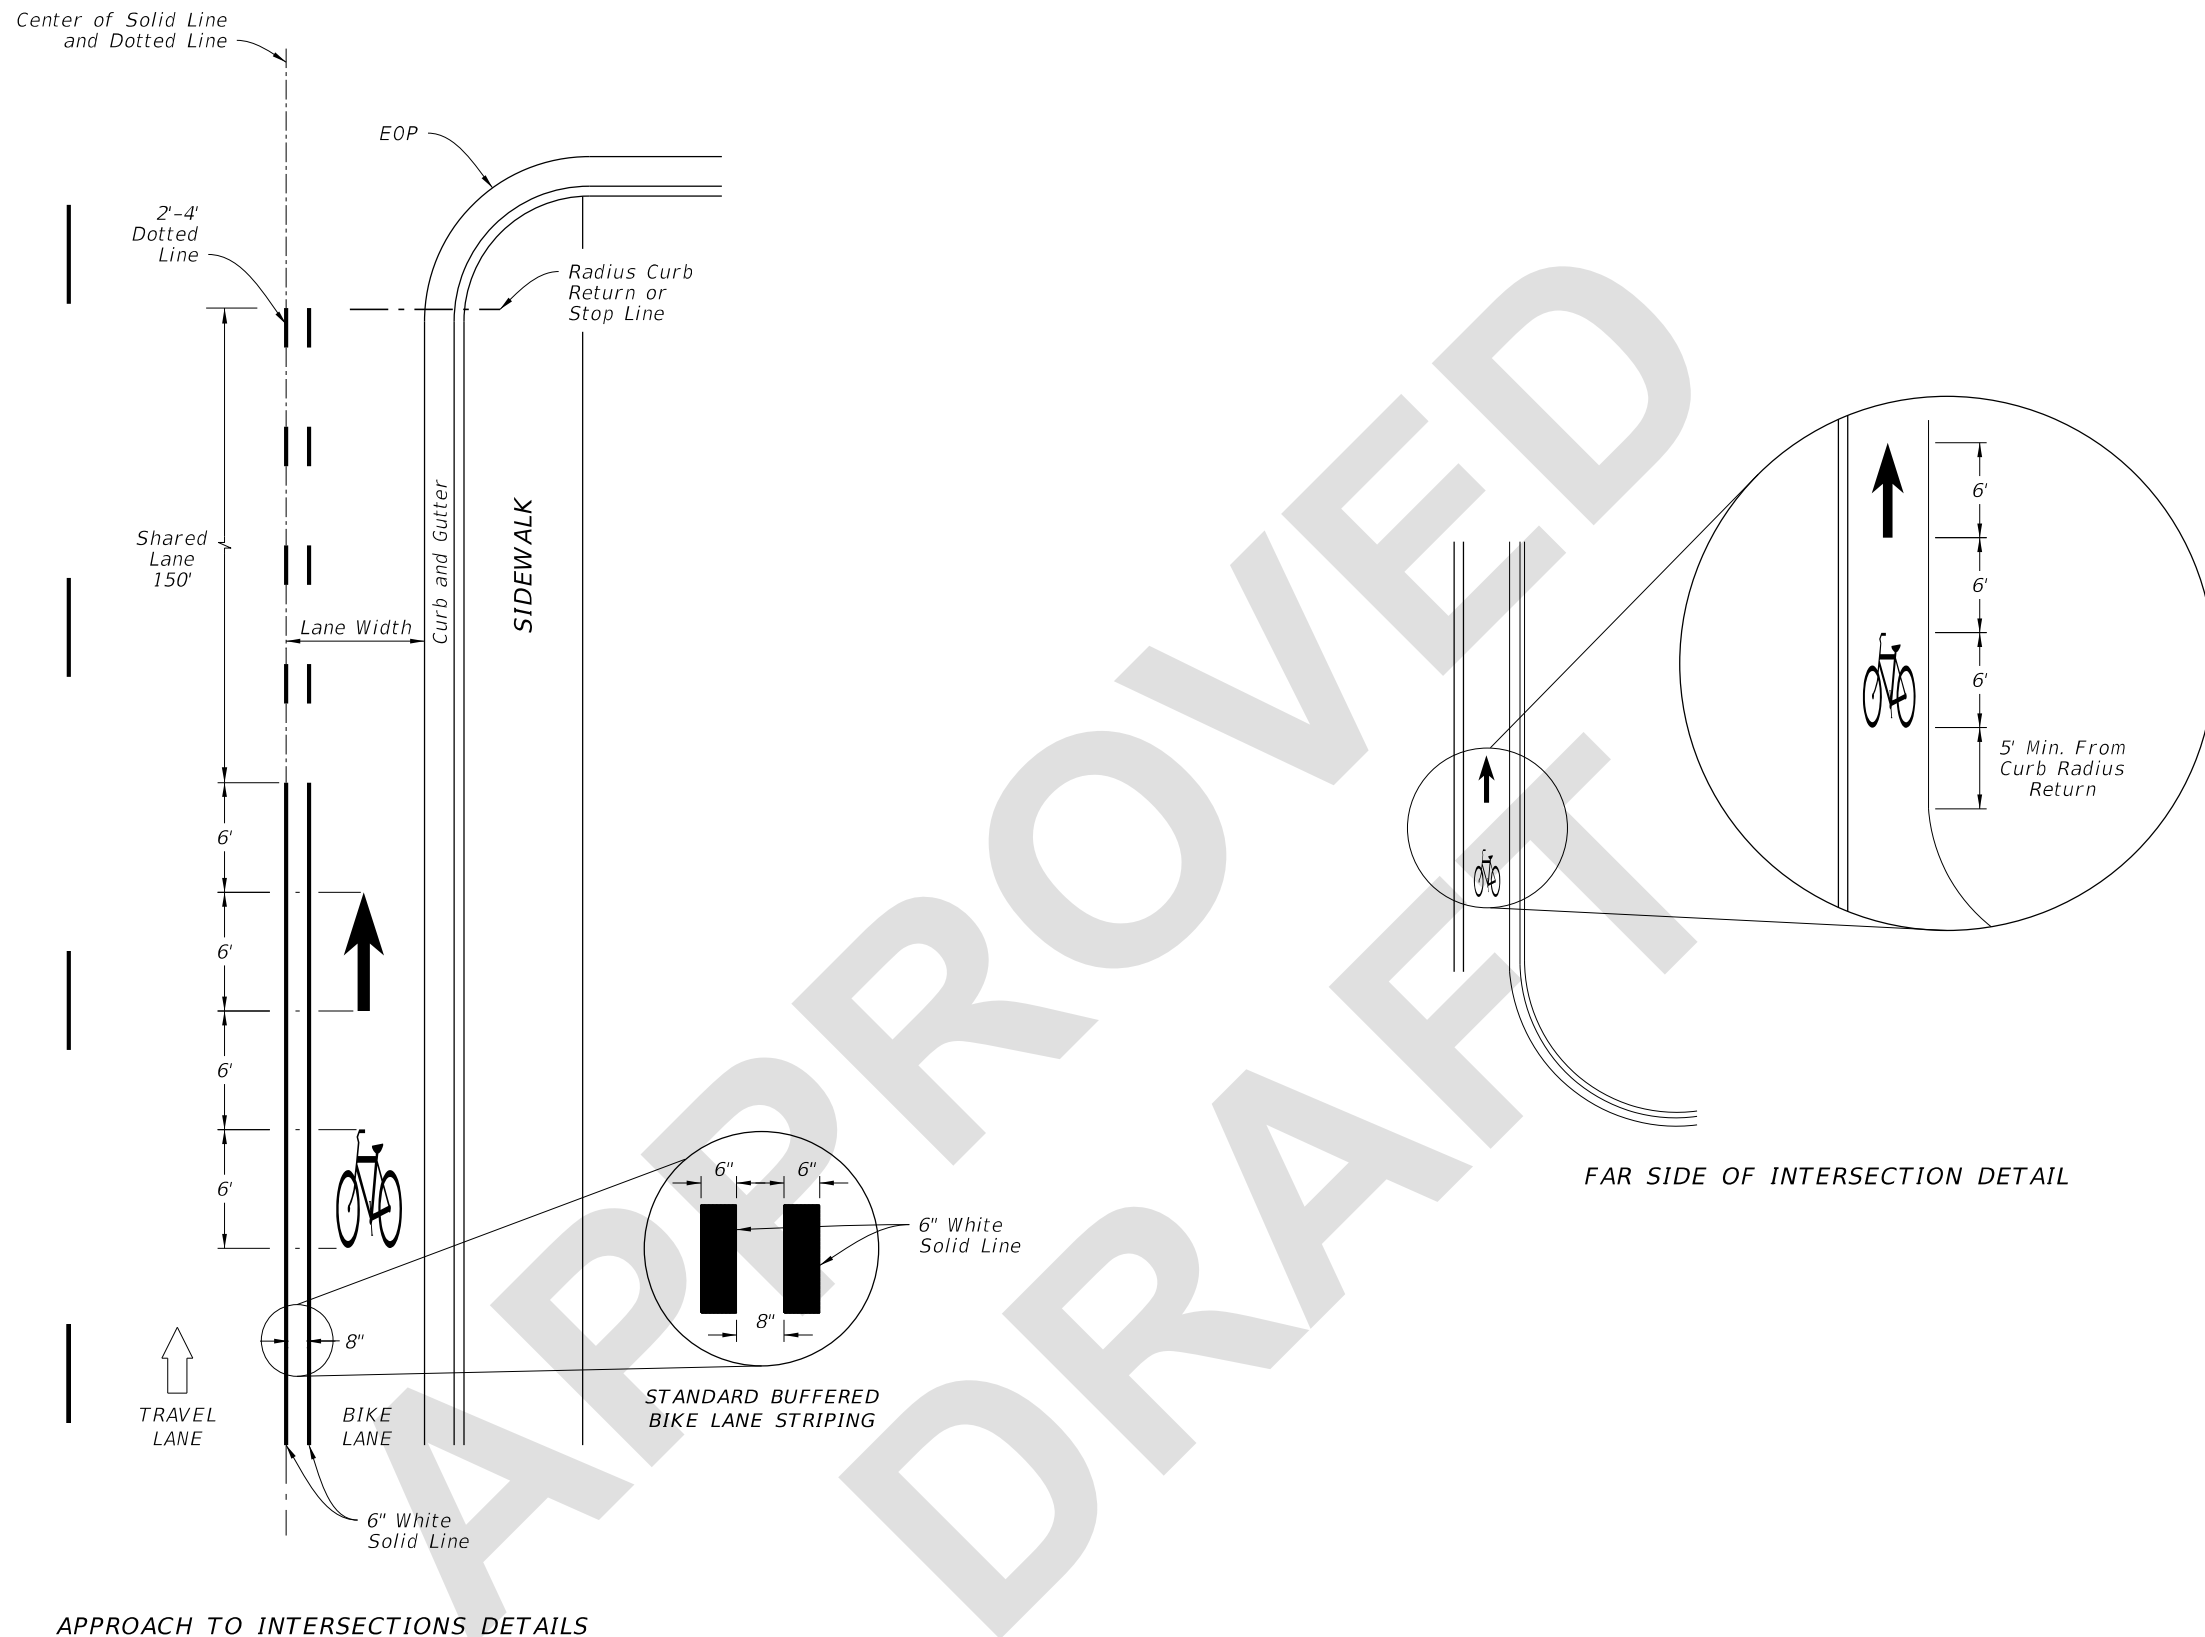

===== BUFFERED BIKE LANES =====

LAST REVISION 11/01/26	REVISION	DESCRIPTION:	 FY 2027-28 STANDARD PLANS	BICYCLE MARKINGS	INDEX 711-002	SHEET 2 of 2
------------------------------	----------	--------------	--	------------------	------------------	-----------------