SURVEYOR'S NOTES

1. THE INTERNED PURPOSE OF THIS DOCUMENT IS TO CONVEY INFORMATION SPECIFIC TO THE LOCATION OF NEWLY CONSTRUCTED TRAFFIC AND SIGNALIZATION SYSTEMS IN THE VICINITY OF THE INTERSECTION OF HIGHWAY 27 AND HIGHWAY 64, LOCATED IN AVON PARK, FLORIDA.
2. BEARINGS SHOWN ARE ASSUMED AND BASED ON INFORMATION PROVIDED WITHIN CONSTRUCTION PLANS.
3. SHADED BACKGROUND AND/OR PLAN SHEETS SHOWN FOR REFERENCE ONLY AND MAY NOT DEPICT CURRENT SITE CONDITIONS. NO LIABILITY IS ASSUMED BY THIS OFFICE FOR ANY SHADED OR PLAN INFORMATION. AS-BUILT INFORMATION SHOWN IN DARK BLUE INK.
4. UNDERGROUND, NON-VISIBLE IMPROVEMENTS (OTHER THAN ANY SHOWN) WERE NOT LOCATED AS PART OF THIS SURVEY.
5. THIS SURVEY WAS PREPARED FOR THE EXCLUSIVE USE OF THOSE PARTIES LISTED UNDER THE CERTIFICATIONS OF THIS DOCUMENT. USE BY ANY ENTITY OTHER THAN THOSE LISTED IS SUBJECT TO THE WRITTEN APPROVAL OF THE SIGNATORY BELOW.
6. SYMBOLOGY MAY BE PLOTTED AT AN EXAGGERATED SCALE OR LOCATION FOR VISUAL CLARITY.
7. SURVEY BASELINE BEARINGS, ROADWAY STATIONING AND COORDINATES SHOWN ARE BASED ON INFORMATION AS PROVIDED WITHIN CONSTRUCTION PLANS.
8. COORDINATES SHOWN ARE RELATIVE TO THE FLORIDA STATE PLANE EAST COORDINATE SYSTEM.
9. MEASUREMENT DATA SHOWN IS IN UNITS OF UNITED STATES SURVEY FEET.
10. AERIAL IMAGERY SHOWN DOES NOT NECESSARILY DEPICT CURRENT SITE CONDITIONS AND IS ONLY SHOWN FOR VISUAL ORIENTATION PURPOSES.
11. IT IS UNLAWFUL TO REPRODUCE THIS DOCUMENT. REPRODUCTIONS ARE STRICTLY PER THE WRITTEN APPROVAL OF THE SIGNATORY BELOW.

STRUCTURE STATIONING REFERENCE LOCATIONS

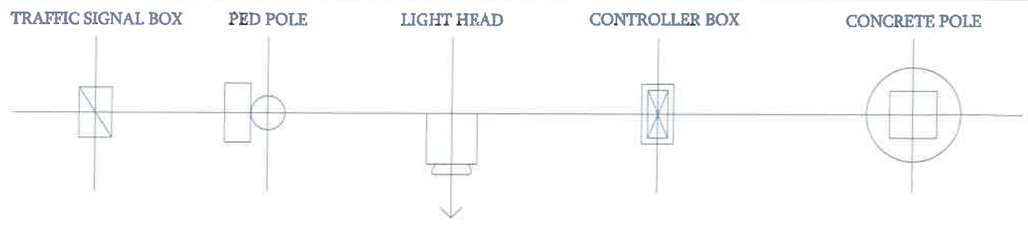

CERTIFICATIONS

CERTIFIED TO AND FOR THE EXCLUSIVE USE OF: (3 OF 3)

1) CONCRETE SERVICES, LLC
2) JOHN WOOD GROUP, PLC
3) FLORIDA DEPARTMENT OF TRANSPORTATION (FDOT)

LEGEND

LT	LEFT
RT	RIGHT
PED	PEDESTRIAN
TJB	TRAFFIC SIGNAL JUNCTION BOX (IN GROUND)
	TRAFFIC SIGNAL JUNCTION BOX AND ROTATION
	PEDESTRIAN SIGNAL POLE AND ROTATION
	TRAFFIC SIGNAL HEAD AND ROTATION
	CONTROLLER BOX (ABOVE GROUND)
	CONCRETE SIGNAL WIRE POLE AND ROTATION
	CONCRETE POST AND ELECTRIC METER

Whisler & Associates, P.A.
- Professional Land Surveyors -

6364 US Highway 27 North
Sebring, Florida 33870
Phone: 863.873.4522
Web: www.WhislerPA.Com
Email: RWhisler4@WhislerPA.com
Florida Licensed Business Number 8138

NOT VALID WITHOUT THE SIGNATURE AND THE ORIGINAL RAISED SEAL OF A FLORIDA LICENSED SURVEYOR AND MAPPER.

10/1/2019

Ralph H. Whisler IV, PSM
Florida Registration Number 7031

DATE

PROJECT NUMBER	SP-2764-02
FIELD SURVEY COMPLETION DATE	09-22-2019
FIELD CREW	RHW4, DK
DRAFTSPERSON	RHW4
DATE OF DRAWING	09-24-2019
DRAWING SCALE	-VARIES-
SURVEY EDITION	FIRST RELEASE