

DISTRICT USE:

SIS: CORRIDOR


FUN CLASS: URBAN PRIN ART INT.

Adjacent project
446344-1 M 0-13.882
2023

Begin 13.882

12175009 (100 ft)

12175008 (115 ft)

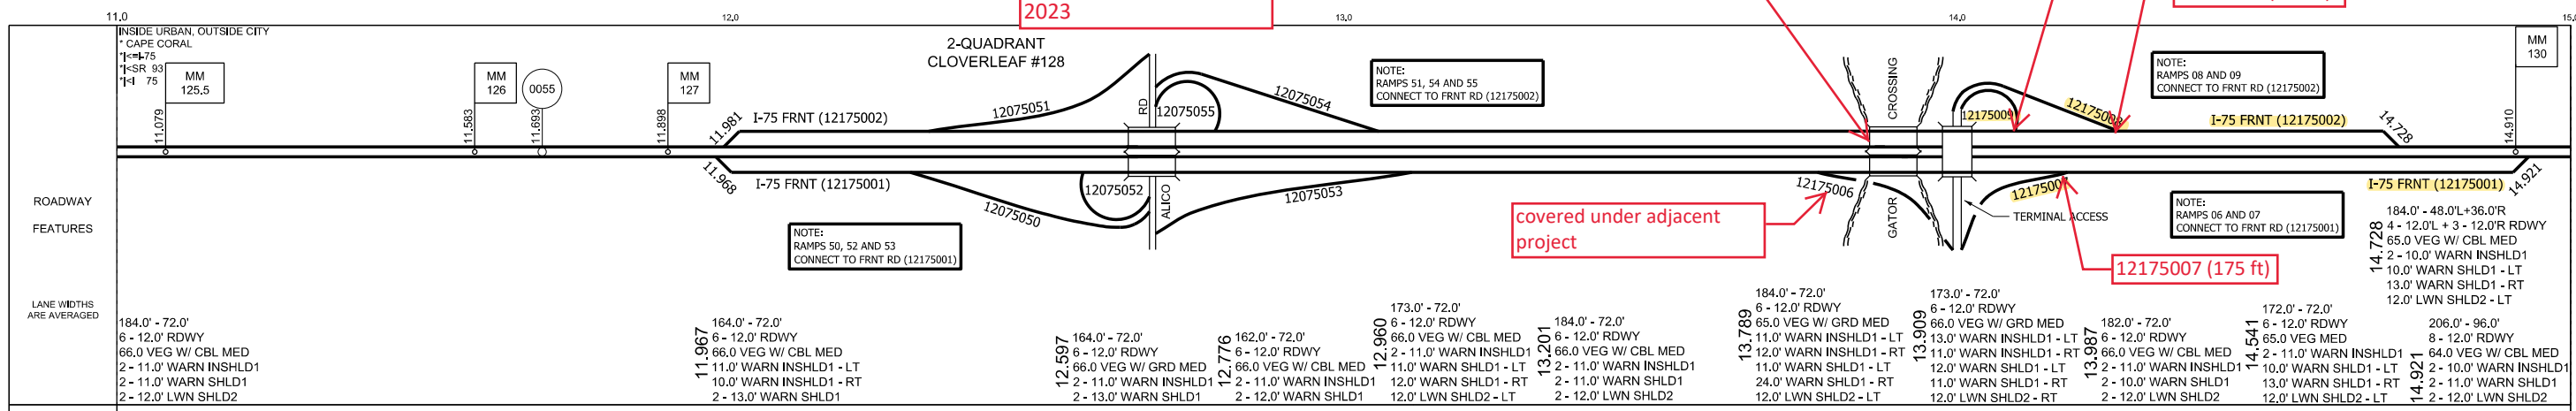


NOTE: RAMP 51, 54 AND 55 CONNECT TO FRNT RD (12175002)

NOTE: RAMP 50, 52 AND 53 CONNECT TO FRNT RD (12175001)

covered under adjacent project



NOTE: RAMP 08 AND 09 CONNECT TO FRNT RD (12175002)

NOTE: RAMP 06 AND 07 CONNECT TO FRNT RD (12175001)

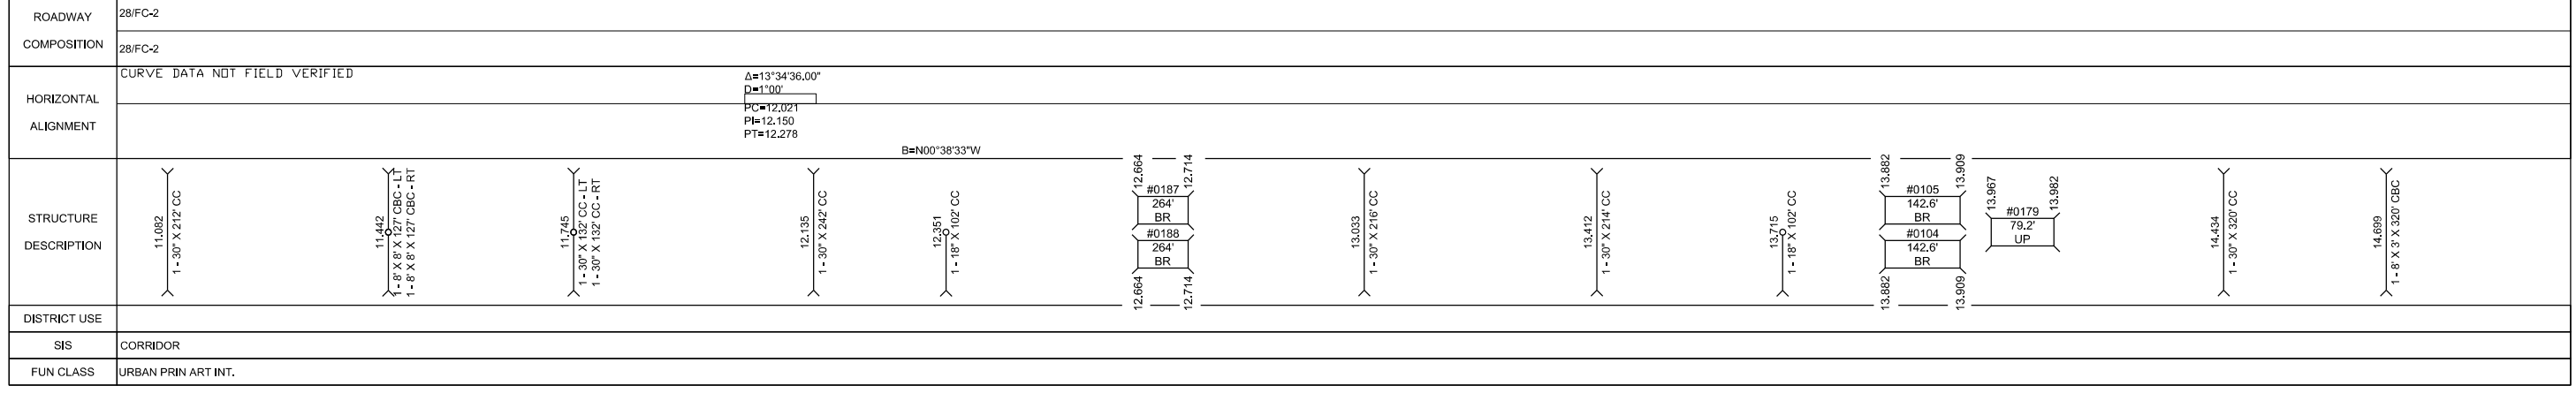

446296-1 and -2
MP 16.1-16.9
Reconstruct DDI
2024

End 16.100

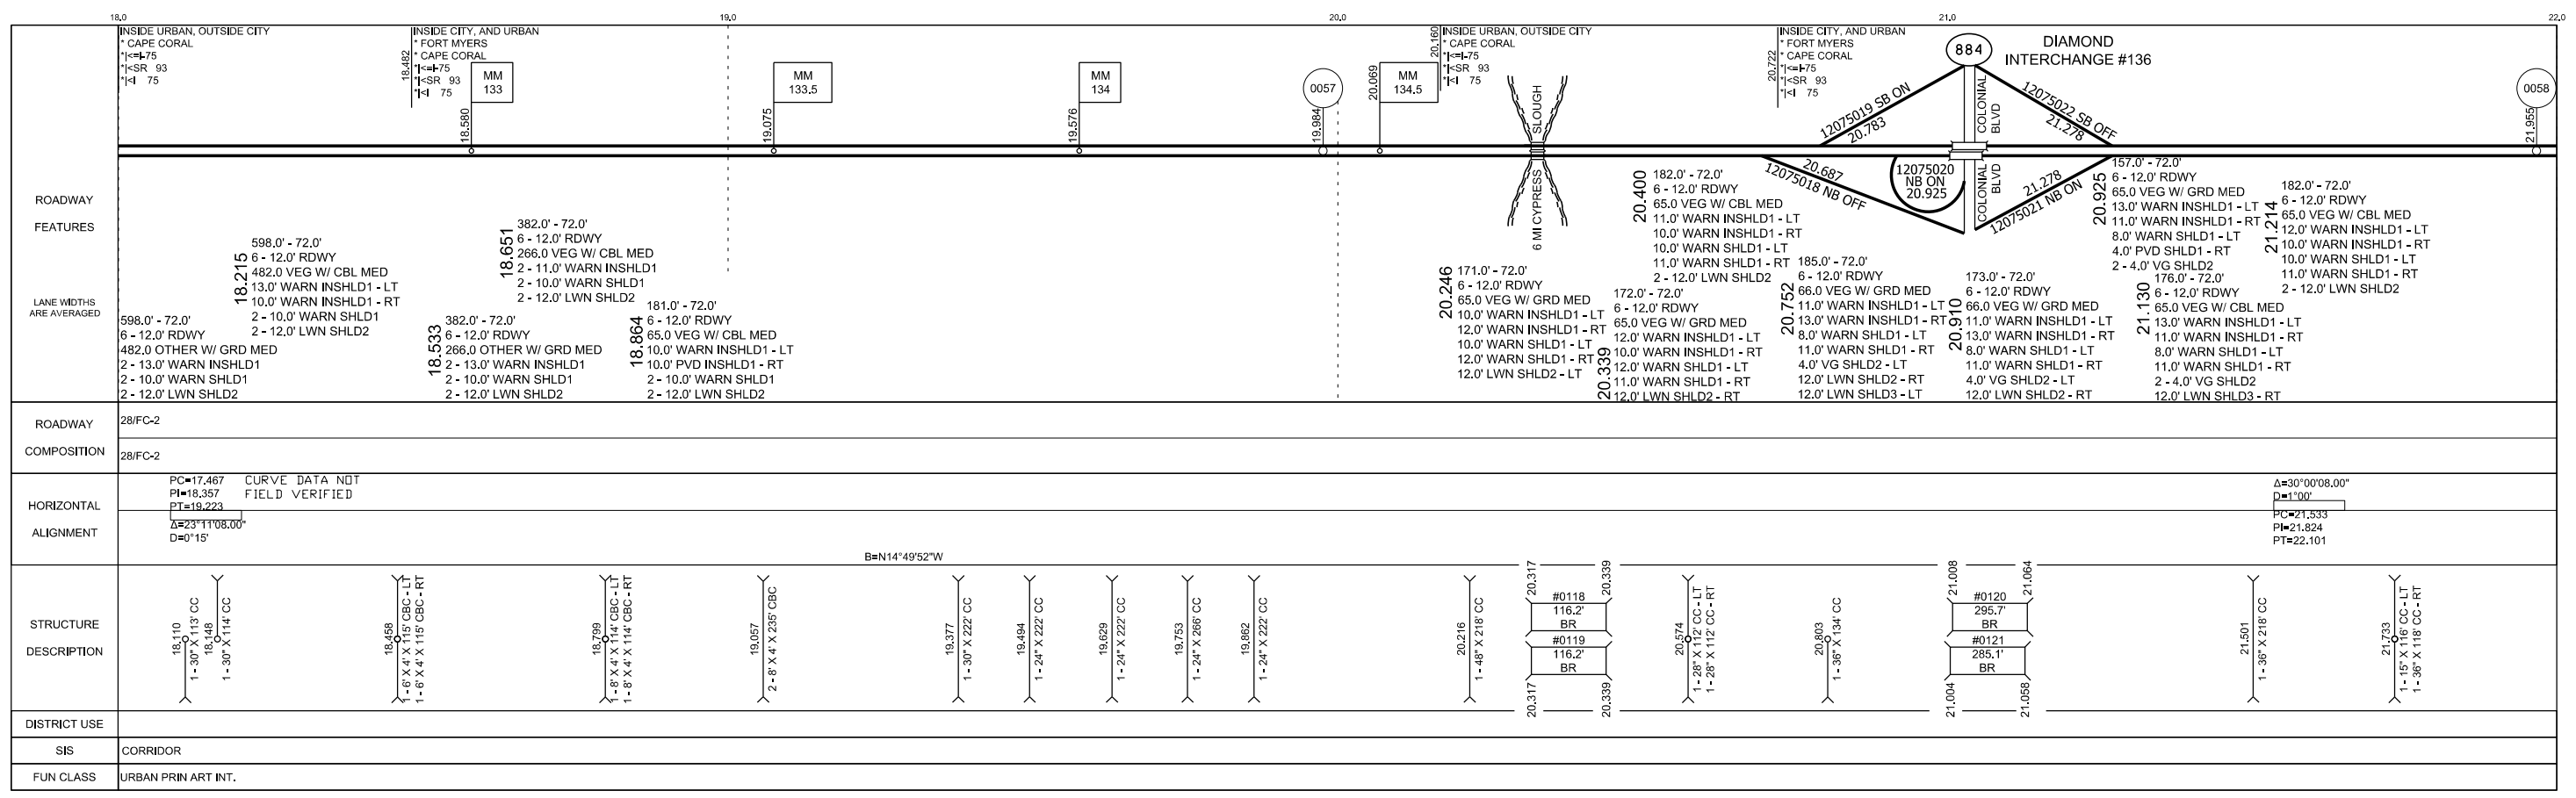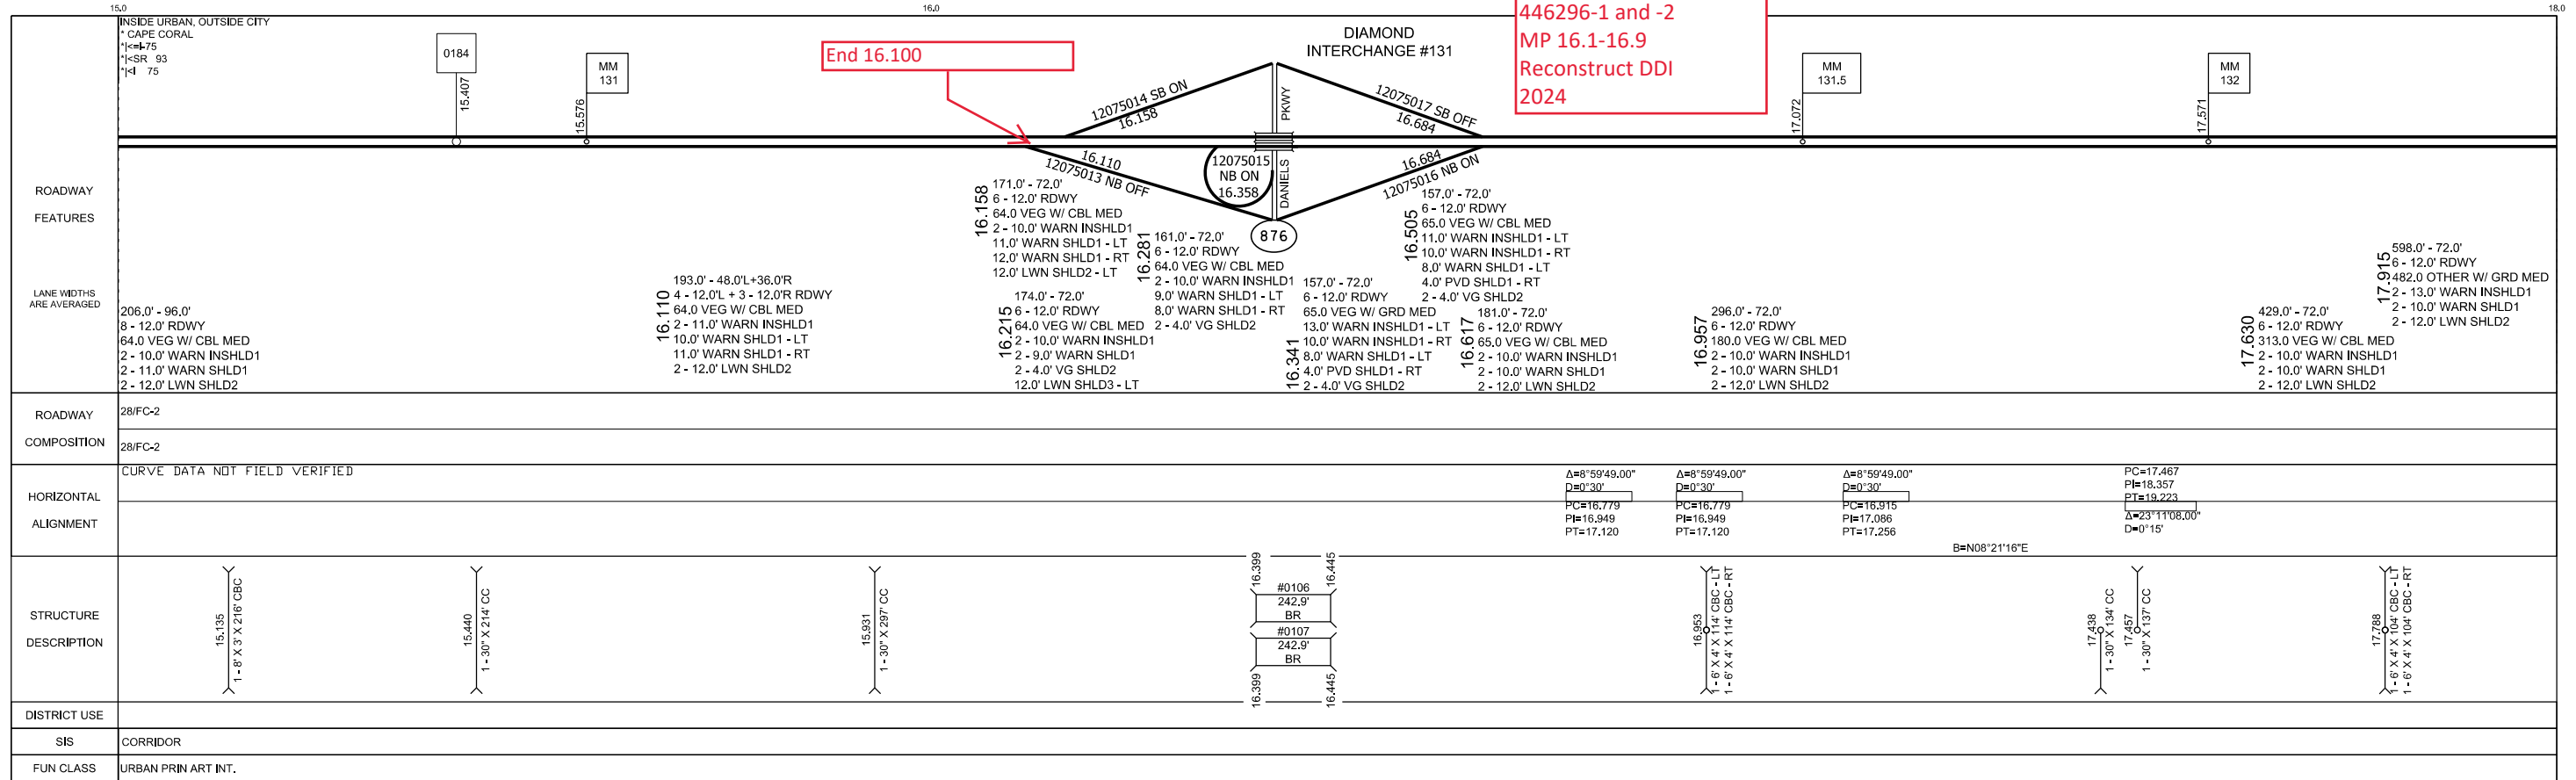

FLORIDA DEPARTMENT OF TRANSPORTATION
STRAIGHT LINE DIAGRAM OF ROAD INVENTORY

