

**SURVEYOR'S NOTES**


1. The purpose of this Specific Purpose Survey was to locate and identify underground utility lines that may be in conflict with proposed highway/roadway design elements. This is not a boundary survey.
2. Field survey data collection was collected between February 22nd, 2023, May 16th, 2024, as recorded in field book 1832, pages 28, 51-52, 54-58, 60-61; field book 1865, pages 14, 16, 18, 21, 28-31, 33-34; field book 1922, pages 12-49, 58-63; field book 1925, page 27; and field book 1948, pages 31-32.
3. Horizontal positions were tied to the Baseline Survey monumentation depicted on FDOT 447379-1-52-01 SR 55 Roadway Plans "Project Control" sheets and compared and related to the MicroStation file ALGNRD01.DGN. The horizontal positions have been tested and found to be accurate to 0.1' +/-.
4. Elevations were tied to project Benchmarks depicted on FDOT 447379-1-52-01 SR 55 Roadway Plans "Project Control" sheets. The Vertical Datum reported thereon is North American Vertical Datum of 1988 (NAVD 88). The elevations have been tested and found to be accurate to 0.05' +/-.
5. The station and offsets are relative to the baselines depicted on the FDOT 447379-1-52-01 SR 55 Roadway Plans.
6. All measurements are in U.S. Survey Feet or decimals thereof unless otherwise stated.
7. Project field survey data was collected using a combination of RTK GPS and conventional instrumentation (Total Station & Automatic level) with hand held data collectors. Subsurface locations and elevations were determined either by direct readings on vacuum exposed utility lines or through the use of Ground Penetrating Radar (GPR) and passive or inductive electromagnetic scanning equipment. These electronically designated lines may deviate from the actual utility location and should be considered approximate.
8. Utilization of the above equipment and methods is the industry recognized standard for finding and locating underground utilities. Although effective and reliable, there is a possibility that all utilities may not be detected due to environmental conditions, soil conditions, water table, excessive depth, and/or feature makeup.
9. Surface elevations and measure downs (depth of cover) are valid at the date of this survey only as surface grade conditions may change over time.
10. Utility size reflects the approximate outside diameter unless otherwise specified. Utility size and material composition was collected by field observation under adverse conditions and should be considered approximate.
11. Utility owners' names reflect information obtained from field observations, field meetings, and utility research and may not reflect actual ownership.
12. Measurements described as "Electronic Depth Only", if any, have been obtained by electronic designating equipment.
13. The 3-dimensional position of electronically designated utilities has not been physically measured and should be considered approximate.
14. The surrounding utilities shown as electronic designation and other Vvh holes must be carefully considered prior to the design and/or placement of proposed structures.

**LEGEND**

+/-	More or less	Inc.	Incorporated
⊕	Baseline	LB	Florida Licensed Business Number
⊕	Centerline	LT	Left
CIP	Cast Iron Pipe	N/A	Not Applicable
DBC	Direct Buried Cable	No. or #	Number
DIP	Ductile Iron Pipe	PSM	Professional Surveyor and Mapper
F.A.C.	Florida Administrative Code	PVC	Polyvinyl Chloride
FDOT	Florida Department of Transportation	RT	Right
ft or '	Foot or Feet	RTK	Real-time Kinematic
GPR	Ground Penetrating Radar	SR	State Road
GPS	Global Positioning System	U.S.	United States of America
HDPE	High-Density Polyethylene	Vvh	Verified Vertical Horizontal Utility Location
ID	Identification	"	Inch or Inches

SURVEY LIMITS: SR 55 FROM 23RD AVE W TO 39TH ST E.

THIS ITEM HAS BEEN DIGITALLY SIGNED AND SEALED BY:

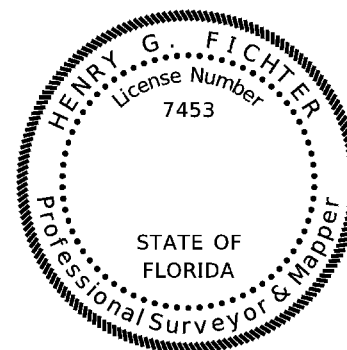

ON THE DATE ADJACENT TO THE SEAL.

PRINTED COPIES OF THIS DOCUMENT ARE NOT CONSIDERED SIGNED AND SEALED AND THE SIGNATURE MUST BE VERIFIED ON ANY ELECTRONIC COPIES.

AIM ENGINEERING AND SURVEYING, INC.  
 2161 FOWLER ST., SUITE 100  
 FORT MYERS, FLORIDA 33901  
 CERTIFICATE OF AUTHORIZATION NO. 3114  
 HENRY G. FICHTER, PSM 7453

THE ABOVE NAMED PROFESSIONAL SURVEYOR & MAPPER SHALL BE RESPONSIBLE FOR THE FOLLOWING SHEETS IN ACCORDANCE WITH RULE 5J-17.062, F.A.C.

<b>SHEET NO.</b>	<b>SHEET DESCRIPTION</b>
UTV-1 - UTV-3	VERIFIED UTILITY LOCATE SHEET

5/20/2024 11:43:22 AM bbeard J:\Active\22-1566 5855 PGA\447379-1-52-01\utils\SBVHRD01.dgn

REVISIONS				AIM ENGINEERING & SURVEYING, INC. 2161 FOWLER STREET, SUITE 100 FORT MYERS, FLORIDA 33901 TELEPHONE (239) 332-4569 HENRY G. FICHTER, PSM NO. 7453	STATE OF FLORIDA DEPARTMENT OF TRANSPORTATION			VERIFIED UTILITY LOCATE SHEET	SHEET NO. UTV-1
DATE	DESCRIPTION	DATE	DESCRIPTION		ROAD NO.	COUNTY	FINANCIAL PROJECT ID		
					SR 55	MANATEE	447379-1-52-01		

**SUMMARY OF VERIFIED UTILITIES**

Vvh #	UTILITY DESCRIPTION (Owner, type)	SIZE	MATERIALS	Ø and/or Ɔ			EXISTING GROUND ELEVATION	TOP ELEVATION	COMMENTS
				STATION	OFFSET	LT/RT			
Vvh 1	COMCAST, FIBER OPTIC	2"	HDPE	106+93.8	56.2'	LT	37.0'	31.0'	
Vvh 2	EXPLORATORY	N/A	N/A	106+96.5	58.1'	LT	37.0'	27.0'	
Vvh 3	EXPLORATORY	N/A	N/A	106+94.2	53.9'	LT	36.8'	26.8'	
Vvh 4	FRONTIER, FIBER OPTIC/TELEPHONE	3-4"	PVC	118+72.7	118.1'	RT	19.6'	16.8'	
Vvh 5	EXPLORATORY	N/A	N/A	118+72.9	115.3'	RT	19.6'	9.6'	
Vvh 6	EXPLORATORY	N/A	N/A	118+73.1	119.0'	RT	19.5'	9.5'	
Vvh 7	FRONTIER, FIBER OPTIC/TELEPHONE	2-4"	METAL	120+54.0	117.5'	RT	18.8'	15.4'	
Vvh 8	FRONTIER, FIBER OPTIC/TELEPHONE	2-2"	METAL	120+54.0	117.2'	RT	18.8'	15.0'	
Vvh 9	MANATEE COUNTY, STORM DRAINAGE	8"	PVC	120+53.7	115.2'	RT	18.9'	14.2'	
Vvh 10	EXPLORATORY	N/A	N/A	120+54.1	114.5'	RT	19.0'	9.0'	
Vvh 11	EXPLORATORY	N/A	N/A	120+53.4	119.6'	RT	18.8'	8.8'	
Vvh 12	FRONTIER, FIBER OPTIC/TELEPHONE	3-4"	PVC	124+22.0	111.1'	RT	18.2'	13.5'	
Vvh 13	EXPLORATORY	N/A	N/A	124+22.1	110.1'	RT	18.2'	8.2'	
Vvh 14	EXPLORATORY	N/A	N/A	124+21.8	113.4'	RT	18.1'	8.1'	
Vvh 15	FRONTIER, FIBER OPTIC/TELEPHONE	4"	PVC	122+35.3	115.4'	RT	18.5'	16.9'	
Vvh 16	FRONTIER, FIBER OPTIC/TELEPHONE	3-4"	PVC	122+35.1	113.6'	RT	18.5'	16.8'	
Vvh 17	EXPLORATORY	N/A	N/A	122+35.2	112.9'	RT	18.4'	16.1'	
Vvh 18	EXPLORATORY	N/A	N/A	122+33.9	116.7'	RT	18.4'	8.4'	
Vvh 19	EXPLORATORY	N/A	N/A	125+94.9	110.9'	RT	18.0'	8.0'	
Vvh 20	MANATEE COUNTY, STORM DRAINAGE	8"	PVC	125+95.2	109.3'	RT	18.1'	13.8'	
Vvh 21	FRONTIER, FIBER OPTIC/TELEPHONE	3-4"	PVC	125+94.8	107.1'	RT	18.0'	15.2'	
Vvh 23	EXPLORATORY	N/A	N/A	125+95.1	106.1'	RT	18.0'	8.0'	
Vvh 50	FRONTIER, FIBER OPTIC/TELEPHONE	3-4"	PVC	127+75.6	106.4'	RT	18.2'	14.2'	
Vvh 51	MANATEE COUNTY, STORM DRAINAGE	6"	PVC	127+77.6	104.6'	RT	18.0'	14.0'	
Vvh 52	EXPLORATORY	N/A	N/A	127+75.9	103.8'	RT	18.0'	8.0'	
Vvh 53	EXPLORATORY	N/A	N/A	127+76.3	107.8'	RT	18.1'	8.1'	
Vvh 54	FRONTIER, FIBER OPTIC/TELEPHONE	3-4"	PVC	129+54.3	103.8'	RT	18.2'	13.6'	
Vvh 55	EXPLORATORY	N/A	N/A	129+54.6	104.9'	RT	18.0'	8.0'	
Vvh 56	EXPLORATORY	N/A	N/A	129+54.5	101.1'	RT	18.2'	8.2'	
Vvh 57	EXPLORATORY	N/A	N/A	131+24.3	102.1'	RT	17.9'	7.9'	
Vvh 58	FRONTIER, FIBER OPTIC/TELEPHONE	3-4"	PVC	131+24.3	102.5'	RT	17.9'	10.0'	LOCATED BY PROBE ONLY
Vvh 59	EXPLORATORY	N/A	N/A	131+23.1	99.5'	RT	18.1'	13.6'	HIT CONCRETE FOOTER
Vvh 60	EXPLORATORY	N/A	N/A	131+23.5	98.1'	RT	18.1'	8.1'	
Vvh 61	EXPLORATORY	N/A	N/A	127+00.6	60.0'	LT	18.8'	8.8'	
Vvh 62	MANATEE COUNTY, STORM DRAINAGE	6"	PVC	127+00.4	60.5'	LT	18.8'	14.0'	LOCATED BY PROBE ONLY
Vvh 63	MANATEE COUNTY, FIBER OPTIC	3-2"	HDPE	127+00.8	64.0'	LT	18.8'	14.4'	
Vvh 64	EXPLORATORY	N/A	N/A	127+00.8	65.4'	LT	18.7'	8.7'	
Vvh 65	EXPLORATORY	N/A	N/A	124+82.8	80.0'	LT	19.7'	9.7'	
Vvh 66	MANATEE COUNTY, FIBER OPTIC	3-2"	HDPE	124+83.0	83.5'	LT	19.3'	15.2'	
Vvh 67	EXPLORATORY	N/A	N/A	124+82.6	83.9'	LT	19.3'	9.3'	
Vvh 68	FDOT, TRAFFIC SIGNAL	2-2"	PVC	150+41.8	35.8'	LT	15.0'	13.2'	
Vvh 69	EXPLORATORY	N/A	N/A	150+44.3	37.6'	LT	15.5'	9.5'	
Vvh 70	EXPLORATORY	N/A	N/A	150+40.8	35.4'	LT	15.0'	9.0'	
Vvh 71	MANATEE COUNTY, FIBER OPTIC	2-1.25"	PVC	150+65.6	19.4'	LT	15.1'	13.5'	
Vvh 72	CITY OF BRADENTON, WATER MAIN	6"	DIP	150+66.6	22.2'	LT	15.3'	12.8'	
Vvh 73	EXPLORATORY	N/A	N/A	150+66.2	22.1'	LT	15.3'	9.3'	
Vvh 74	EXPLORATORY	N/A	N/A	150+65.7	18.9'	LT	15.0'	9.0'	
Vvh 75	CITY OF BRADENTON, WATER MAIN	6"	CIP	147+53.3	97.4'	RT	16.4'	13.8'	
Vvh 76	EXPLORATORY	N/A	N/A	147+53.4	98.9'	RT	16.8'	6.8'	
Vvh 77	EXPLORATORY	N/A	N/A	147+53.1	95.6'	RT	16.4'	6.4'	
Vvh 78	EXPLORATORY	N/A	N/A	157+10.7	57.9'	RT	15.8'	5.8'	
Vvh 79	EXPLORATORY	N/A	N/A	157+10.0	61.7'	RT	16.0'	6.0'	
Vvh 80	EXPLORATORY	N/A	N/A	162+33.1	55.2'	LT	14.4'	8.4'	
Vvh 81	EXPLORATORY	N/A	N/A	162+33.1	51.5'	LT	14.3'	8.3'	
Vvh 82	EXPLORATORY	N/A	N/A	162+52.3	63.0'	LT	14.7'	8.7'	
Vvh 83	EXPLORATORY	N/A	N/A	162+52.2	59.4'	LT	14.7'	8.7'	
Vvh 84	FDOT, TRAFFIC SIGNAL	2"	PVC	162+51.4	62.7'	LT	14.7'	11.5'	
Vvh 85	FDOT, TRAFFIC SIGNAL	2"	PVC	285+37.3	44.1'	LT	12.5'	10.5'	
Vvh 86	EXPLORATORY	N/A	N/A	285+38.9	46.0'	LT	12.6'	2.6'	
Vvh 87	EXPLORATORY	N/A	N/A	285+38.5	41.3'	LT	12.3'	2.3'	
Vvh 88	FDOT, TRAFFIC SIGNAL	2"	STEEL	158+58.6	54.0'	LT	15.3'	12.9'	
Vvh 89	EXPLORATORY	N/A	N/A	158+58.2	52.9'	LT	15.3'	5.3'	
Vvh 90	EXPLORATORY	N/A	N/A	158+59.5	57.2'	LT	15.3'	5.3'	
Vvh 91	EXPLORATORY	N/A	N/A	128+19.8	110.6'	RT	18.1'	8.1'	
Vvh 92	FRONTIER, FIBER OPTIC/TELEPHONE	3-4"	PVC	128+18.3	104.8'	RT	18.4'	14.4'	LOCATED BY PROBE ONLY

1/26/2024 11:03:23 AM solver J:\Active\22-1566\_S855\_PGA\Working\2312\_50\_Sue\PLANSHEETS\SBVHR002.dgn

THE OFFICIAL RECORD OF THIS SHEET IS THE ELECTRONIC FILE DIGITALLY SIGNED AND SEALED UNDER RULE 5J-17.062, F.A.C.

<table border="1"> <thead> <tr> <th colspan="2">REVISIONS</th> </tr> <tr> <th>DATE</th> <th>DESCRIPTION</th> </tr> </thead> <tbody> <tr> <td> </td> <td> </td> </tr> </tbody> </table>				REVISIONS		DATE	DESCRIPTION			AIM ENGINEERING & SURVEYING, INC.  2161 FOWLER STREET, SUITE 100 FORT MYERS, FLORIDA 33901 TELEPHONE (239) 332-4569 HENRY G. FICHTER, PSM NO. 7453	STATE OF FLORIDA DEPARTMENT OF TRANSPORTATION			VERIFIED UTILITY LOCATE SHEET	SHEET NO.  UTV-2
REVISIONS															
DATE	DESCRIPTION														
		<table border="1"> <tr> <th>ROAD NO.</th> <th>COUNTY</th> <th>FINANCIAL PROJECT ID</th> </tr> <tr> <td>SR 55</td> <td>MANATEE</td> <td>447379-1-52-01</td> </tr> </table>	ROAD NO.	COUNTY	FINANCIAL PROJECT ID	SR 55	MANATEE	447379-1-52-01							
ROAD NO.	COUNTY	FINANCIAL PROJECT ID													
SR 55	MANATEE	447379-1-52-01													

**SUMMARY OF VERIFIED UTILITIES**

Vvh #	UTILITY DESCRIPTION (Owner, type)	SIZE	MATERIALS	E and/or C			EXISTING GROUND ELEVATION	TOP ELEVATION	COMMENTS
				STATION	OFFSET	LT/RT			
Vvh 93	EXPLORATORY	N/A	N/A	128+19.8	106.7'	RT	18.1'	8.1'	
Vvh 94	EXPLORATORY	N/A	N/A	141+38.7	89.4'	RT	16.6'	8.6'	
Vvh 95	FRONTIER, FIBER OPTIC/TELEPHONE	3-4"	PVC	141+38.5	88.8'	RT	16.5'	14.0'	
Vvh 96	CITY OF BRADENTON, WATER MAIN	6"	CIP	141+38.7	92.9'	RT	16.6'	13.3'	
Vvh 97	EXPLORATORY	N/A	N/A	141+38.8	92.1'	RT	16.6'	8.6'	
Vvh 98	EXPLORATORY	N/A	N/A	223+39.2	52.6'	RT	6.1'	-1.9'	
Vvh 99	EXPLORATORY	N/A	N/A	223+38.8	56.6'	RT	6.1'	-1.9'	
Vvh 100	TECO, GAS MAIN	4"	HDPE	223+39.2	55.6'	RT	6.1'	3.2'	
Vvh 101	FDOT, STREET LIGHT	1.25"	PVC	223+38.8	59.5'	RT	6.0'	2.0'	LOCATED BY PROBE ONLY
Vvh 102	EXPLORATORY	N/A	N/A	244+10.3	68.4'	LT	5.6'	-4.4'	
Vvh 103	MANATEE COUNTY, FIBER OPTIC	1.25"	HDPE	244+10.4	67.3'	LT	5.6'	0.1'	LOCATED BY PROBE ONLY
Vvh 104	EXPLORATORY	N/A	N/A	244+09.9	63.9'	LT	5.9'	-4.1'	
Vvh 105	ZAYO, FIBER OPTIC	3-1.25"	HDPE	244+11.9	69.5'	LT	5.6'	-1.3'	LOCATED BY PROBE ONLY
Vvh 106	EXPLORATORY	N/A	N/A	242+41.1	78.7'	LT	5.5'	-4.5'	
Vvh 107	FPL, ELECTRIC	6"	HDPE	242+41.2	76.9'	LT	5.5'	1.9'	
Vvh 108	CROWN CASTLE, FIBER OPTIC	3-2"	HDPE	242+41.0	77.4'	LT	5.5'	2.7'	
Vvh 109	EXPLORATORY	N/A	N/A	242+40.9	74.3'	LT	5.9'	-4.1'	
Vvh 110	TECO, GAS MAIN	4"	HDPE	247+80.0	77.2'	RT	5.9'	3.3'	
Vvh 111	FRONTIER, FIBER OPTIC/TELEPHONE	1-4", 1-2"	HDPE, DBC	247+79.4	82.7'	RT	4.6'	1.7'	
Vvh 112	EXPLORATORY	N/A	N/A	247+79.4	84.9'	RT	4.1'	-5.9'	
Vvh 113	EXPLORATORY	N/A	N/A	247+80.1	80.8'	RT	5.2'	-4.8'	
Vvh 114	EXPLORATORY	N/A	N/A	163+32.9	74.4'	LT	13.7'	3.7'	
Vvh 115	EXPLORATORY	N/A	N/A	163+34.9	78.6'	LT	13.8'	8.0'	HIT ROCK
Vvh 116	MCI, FIBER OPTIC	2-2"	HDPE	163+34.2	78.3'	LT	13.7'	11.8'	
Vvh 117	EXPLORATORY	N/A	N/A	162+01.9	54.7'	RT	14.3'	4.3'	
Vvh 118	EXPLORATORY	N/A	N/A	162+01.6	50.2'	RT	14.1'	4.1'	
Vvh 119	ZAYO, FIBER OPTIC	2"	HDPE	286+58.9	47.8'	LT	12.9'	10.4'	
Vvh 120	FDOT, STREET LIGHT	2"	PVC	250+49.8	50.3'	LT	13.9'	11.2'	
Vvh 121	FDOT, TRAFFIC SIGNAL	2"	PVC	250+50.6	44.2'	LT	15.0'	12.8'	
Vvh 122	MANATEE COUNTY, FIBER OPTIC	1.25"	HDPE	238+70.6	59.8'	LT	5.9'	0.0'	
Vvh 123	MANATEE COUNTY, FIBER OPTIC	1.25"	HDPE	235+55.6	62.7'	LT	6.1'	1.3'	
Vvh 124	MCI, FIBER OPTIC	2-2"	HDPE	235+55.0	66.3'	LT	6.0'	1.5'	
Vvh 125	FDOT, STREET LIGHT	1.25"	PVC	232+74.8	53.6'	RT	5.5'	3.5'	
Vvh 126	TECO, GAS MAIN	4"	HDPE	232+74.6	51.0'	RT	5.4'	1.6'	
Vvh 127	FDOT, STREET LIGHT	1.25"	PVC	233+78.4	54.7'	RT	5.7'	3.5'	
Vvh 128	TECO, GAS MAIN	4"	HDPE	233+76.5	52.1'	RT	5.6'	2.7'	
Vvh 129	FDOT, ELECTRIC	2"	PVC	233+78.4	58.2'	RT	5.8'	3.8'	
Vvh 130	CHARTER COMMUNICATIONS, CABLE TELEVISION	2-2"	PVC	233+77.6	60.9'	RT	5.7'	3.3'	UNABLE TO TRACE
Vvh 131	CROWN CASTLE, FIBER OPTIC	2"	HDPE	171+59.2	43.8'	LT	7.8'	1.8'	LOCATED BY PROBE ONLY
Vvh 132	FDOT, STREET LIGHT	1.25"	PVC	171+58.5	50.4'	LT	7.5'	6.4'	
Vvh 133	CROWN CASTLE, FIBER OPTIC	2"	HDPE	170+60.7	46.8'	LT	8.1'	2.8'	LOCATED BY PROBE ONLY
Vvh 134	UNITI, FIBER OPTIC	2"	HDPE	170+58.8	50.7'	LT	7.8'	3.7'	
Vvh 135	UNITI, FIBER OPTIC	2"	HDPE	171+58.3	50.0'	LT	7.5'	1.6'	LOCATED BY PROBE ONLY
Vvh 136	TECO, GAS MAIN	1"	HDPE	161+38.6	55.2'	LT	14.0'	12.0'	
Vvh 137	MANATEE COUNTY, FIBER OPTIC	2-2"	HDPE	161+40.6	50.6'	LT	13.8'	9.4'	
Vvh 138	FDOT, TRAFFIC SIGNAL	2"	PVC	161+39.6	47.0'	LT	13.9'	11.0'	
Vvh 139	ZAYO, FIBER OPTIC	2"	HDPE	161+38.1	54.3'	LT	14.0'	10.0'	LOCATED BY PROBE ONLY
Vvh 140	MANATEE COUNTY, FIBER OPTIC	3-1.25"	HDPE	106+94.3	54.8'	LT	36.9'	30.6'	LOCATED BY PROBE ONLY
Vvh 141	CHARTER COMMUNICATIONS, FIBER OPTIC	2-2"	PVC	171+59.2	40.6'	LT	8.1'	3.0'	LOCATED BY PROBE ONLY
Vvh 142	UNITI, FIBER OPTIC	2"	HDPE	161+40.7	49.8'	LT	13.9'	7.9'	LOCATED BY PROBE ONLY
Vvh 143	MCI, FIBER OPTIC	2"	HDPE	238+70.7	65.2'	LT	5.3'	0.1'	LOCATED BY PROBE ONLY
Vvh 144	MANATEE COUNTY, FIBER OPTIC	2"	HDPE	238+70.9	64.0'	LT	5.4'	-1.4'	LOCATED BY PROBE ONLY
Vvh 145	FDOT, STREET LIGHT	2"	PVC	238+70.7	50.9'	LT	6.0'	3.6'	
Vvh 146	FDOT, STREET LIGHT	2"	PVC	247+81.6	71.9'	RT	6.4'	4.0'	
Vvh 147	EXPLORATORY	N/A	N/A	269+75.1	37.7'	LT	39.4'	29.4'	
Vvh 148	FDOT, STREET LIGHT	2"	PVC	269+74.3	40.3'	LT	38.8'	36.8'	
Vvh 149	EXPLORATORY	N/A	N/A	269+74.2	42.1'	LT	37.6'	27.6'	
Vvh 150	FDOT, STREET LIGHT	2"	PVC	275+80.2	43.3'	RT	19.4'	16.4'	
Vvh 151	FDOT, STREET LIGHT	2"	PVC	277+66.0	45.6'	RT	14.3'	11.5'	
Vvh 152	CHARTER COMMUNICATIONS, FIBER OPTIC	2-2"	PVC	170+60.9	43.8'	LT	8.4'	1.4'	LOCATED BY PROBE ONLY
Vvh 153	FRONTIER, FIBER OPTIC/TELEPHONE	3-4"	PVC	157+13.0	57.1'	RT	15.7'	10.1'	LOCATED BY PROBE ONLY
Vvh 154	FDOT, TRAFFIC SIGNAL	2"	PVC	157+16.2	58.6'	RT	16.1'	12.2'	LOCATED BY PROBE ONLY
Vvh 155	MANATEE COUNTY, FIBER OPTIC	4"	HDPE	134+90.9	25.0'	LT	17.8'	7.8'	LOCATED BY PROBE ONLY
Vvh 156	EXPLORATORY	N/A	N/A	134+90.2	22.9'	LT	17.8'	7.8'	
Vvh 157	EXPLORATORY	N/A	N/A	134+91.3	28.1'	LT	18.2'	8.2'	

5/20/2024 2:12:49 PM bbeard J:\Active\22-1566 5855 PGA 447379-1-52-01\utils\SBV\HRD03.dgn

THE OFFICIAL RECORD OF THIS SHEET IS THE ELECTRONIC FILE DIGITALLY SIGNED AND SEALED UNDER RULE 5J-37.062, F.A.C.

<table border="1"> <thead> <tr> <th colspan="2">REVISIONS</th> </tr> <tr> <th>DATE</th> <th>DESCRIPTION</th> </tr> </thead> <tbody> <tr> <td> </td> <td> </td> </tr> </tbody> </table>				REVISIONS		DATE	DESCRIPTION			AIM ENGINEERING & SURVEYING, INC.  2161 FOWLER STREET, SUITE 100 FORT MYERS, FLORIDA 33901 TELEPHONE (239) 332-4569 HENRY G. FICHTER, PSM NO. 7453	STATE OF FLORIDA DEPARTMENT OF TRANSPORTATION			VERIFIED UTILITY LOCATE SHEET	SHEET NO.  UTV-3
REVISIONS															
DATE	DESCRIPTION														
		ROAD NO.	COUNTY	FINANCIAL PROJECT ID											
		SR 55	MANATEE	447379-1-52-01											