

SPECIFIC PURPOSE SURVEY VERIFIED UTILITY LOCATE SHEET

SUMMARY OF VERIFIED UTILITIES

Vvh #	UTILITY DESCRIPTION (Owner, type)	SIZE	MATERIALS	STATIONS DERIVED FROM \mathbb{B} SR25(US27) (TYP.)			EXISTING GROUND ELEVATION	TOP ELEVATION	COMMENTS
				STATION	OFFSET	LT/RT			
1	CENTURY LINK/LUMEN, BURIED TELEPHONE	2"	PEP	229+51.96	56.06	LT	19.6	13.6	
2	CENTURY LINK/LUMEN, BURIED FIBER OPTIC	2"	PEP	234+68.08	90.09	RT	18.8	14.7	POSSIBLE FIBER OPTIC
2A	FLORIDA CITY GAS/FP&L, GAS MAIN	6"	STEEL	234+68.60	74.92	RT	19.7	15.1	COATED STEEL GREEN
3	SOUTH SHORE WATER ASSOCIATION, WATER MAIN	6"	PVC	237+96.81	98.90	RT	17.3	14.1	
4	EXPLORATORY, NO UTILITY FOUND	N/A	N/A	258+42.18	62.40	LT	19.3	N/A	TEST HOLE PERFORMED ON REQUESTED WM
									DUG TO 5' PROBED TO $\pm 10'$ NO UTILITY FOUND
5	CENTURY LINK/LUMEN, BURIED TELEPHONE	0.5"	DBC	258+67.51	79.37	LT	18.2	15.4	
6	CENTURY LINK/LUMEN, BURIED TELEPHONE	2" / 0.5"	CONDUIT CASING/DBC	258+84.54	50.91	LT	19.4	11.2	
7	EXPLORATORY, NO UTILITY FOUND	N/A	N/A	258+84.22	11.19	RT	19.4	N/A	TEST HOLE PERFORMED ON EM SIGNAL TO A DEPTH
									OF $\pm 10.0'$ NO UTILITY FOUND. EM SIGNAL READS $\pm 15.3'$
8	CENTURY LINK/LUMEN, BURIED FIBER OPTIC	(3)2"	PEP	270+02.89	87.18	RT	18.9	14.7	
9	NO UTILITY FOUND	N/A	N/A	276+52.82	78.89	LT	19.0	17.0	UNCOVERED CONCRETE AT 3.5'. DID NOT BREAK.
									FEAR OF DAMAGE UTILITY. UNABLE TO CONFIRM UTILITY
10	EXPLORATORY, NO UTILITY FOUND	N/A	N/A	275+87.49	82.91	RT	19.3	N/A	REQUESTED GAS LINE DUG 1' x 3' x 5' DEEP
									PROBED $\pm 10'$ NO UTILITY FOUND
11	CENTURY LINK/LUMEN, BURIED FIBER OPTIC	2"	PEP	276+67.67	85.61	RT	19.0	15.3	
12	CENTURY LINK/LUMEN, BURIED FIBER OPTIC	(3)2"	PEP	280+00.56	84.95	RT	19.0	14.4	
13	SOUTH SHORE WATER ASSOCIATION, WATER MAIN	6"	PVC	279+63.18	94.00	RT	18.1	15.0	
14	CENTURY LINK/LUMEN, BURIED TELEPHONE	0.5"	DBC	286+92.50	97.98	LT	17.7	14.7	

SURVEYOR'S NOTES:

SUBSURFACE UTILITY ENGINEERING NOTES:

- OWNERSHIP IS BASED UPON OBSERVING ABOVE GROUND UTILITY FEATURES, SUNSHINE 811 DIG TICKET AND PROFESSIONAL JUDGEMENT. NO RECORDS RESEARCH WAS PERFORMED BY DRMP.

SURVEYOR'S NOTES:

- SURVEY OF UTILITIES WAS PERFORMED BY DRMP.
- VERTICAL INFORMATION IS RELATIVE TO NORTH AMERICAN VERTICAL DATUM OF 1988 (NAVD 88).
- BEARINGS AND COORDINATES ARE RELATIVE TO THE STATE PLANE COORDINATES FLORIDA EAST ZONE, NORTH AMERICAN DATUM OF 1983 (NAD 83) ADJUSTMENT 2011.
- STATION AND OFFSET DERIVED FROM THE BASELINE OF SURVEY OF SR 25 AS PROVIDED BY FDOT PROJECT NETWORK CONTROL (PNC) FINANCIAL PROJECT ID 448938-1-52-01.
- PROJECT UNITS IN U.S SURVEY FEET
- THE SPECIFIC PURPOSE OF THIS SURVEY IS TO DETERMINE THE HORIZONTAL AND VERTICAL LOCATION OF VACUUM TEST HOLES AS MARKED ON THE SURFACE BY THE SUBSURFACE UTILITY ENGINEERING DEPARTMENT OF DRMP INC.
- DRMP PROJECT # 20-0146.012

LEGEND:

ACP	TRANSITE PIPE
\mathbb{B}	BASELINE
\mathbb{C}	CENTERLINE
CONC	CONCRETE COVERED UTILITY
CI	CAST IRON
CP	CONCRETE PIPE
DIP	DUCTILE IRON PIPE
DBC	DIRECT BURIED CABLE
DUCT	BANK OF MULTIPLE PIPES
FDOT	FLORIDA DEPARTMENT OF TRANSPORTATION
HDPE	HIGH-DENSITY POLYETHYLENE
LT	LEFT
N/A	NOT APPLICABLE
PCCP	PRE-STRESSED CONCRETE CYLINDER PIPE
PP	PER PLANS
PSM	PROFESSIONAL SURVEYOR AND MAPPER
PVC	POLYVINYL CHLORIDE
RCP	REINFORCED CONCRETE PIPE
RT	RIGHT
SR	STATE ROAD
STL	STEEL PIPE
TC	TRAFFIC CONTROL
TH	TEST HOLE
UNK.	UNKNOWN
UTV	UTILITY VERIFICATION SHEET
VCP	VITRIFIED CLAY PIPE
Vvh	VERIFIED VERTICALLY & HORIZONTALLY

LIMITS: SR 25(US 27) MP 7.704 TO MP 11.747 (ALONG SR25 FROM STITT RANCH TO FLAGHOLE ROAD)

SURVEYOR'S CERTIFICATION

I HEREBY CERTIFY THIS SPECIFIC PURPOSE SURVEY WAS MADE FOR THE PURPOSE OF SURVEYING, REFERENCING, DESCRIBING AND MAPPING THE UTILITY VACUUM EXCAVATIONS, AS MARKED ON THE SURFACE FOR THE TRANSPORTATION FACILITY DEPICTED HEREON AND THAT SAID SURVEY WAS DONE UNDER MY RESPONSIBLE CHARGE AND MEETS THE STANDARDS OF PRACTICE SET FORTH BY THE FLORIDA BOARD OF PROFESSIONAL SURVEYORS AND MAPPERS IN CHAPTER 5J-17 FLORIDA ADMINISTRATIVE CODE PURSUANT TO SECTION 472.027 FLORIDA STATUTES. THIS MAP CONSISTING OF SHEET 01-04 IS A TRUE, ACCURATE AND COMPLETE DEPICTION OF THE RESULTS OF A FIELD SURVEY PERFORMED UNDER MY DIRECTION AND COMPLETED OCTOBER 13, 2023

SURVEYOR: JAY SCAGLIOLA

PSM NUMBER: 5066


PRINTED COPIES OF THIS SHEET ARE NOT CONSIDERED SIGNED AND SEALED AND THE SIGNATURE MUST BE VERIFIED ON ANY ELECTRONIC COPIES. THE ABOVE NAMED PROFESSIONAL SURVEYOR AND MAPPER SHALL BE RESPONSIBLE FOR THE FOLLOWING SHEETS IN ACCORDANCE WITH RULE 5J-17.062, F.A.C.

SHEET NO.

UTV1-UTV4

SHEET DESCRIPTION

VERIFIED UTILITY LOCATE SHEET

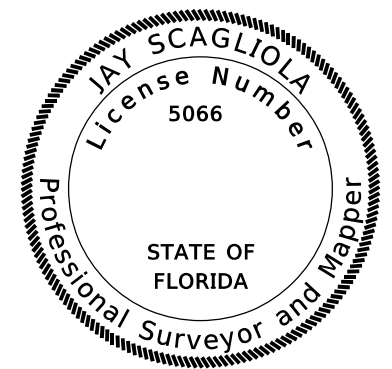

1/22/2024 9:52:32 AM bbussard C:\Worksets\FDOT\20-0146.012\Survey\SBVHRD01.dgn

THE OFFICIAL RECORD OF THIS SHEET IS THE ELECTRONIC FILE DIGITALLY SIGNED AND SEALED UNDER RULE 5J-17.062, F.A.C.

REVISIONS				PROFESSIONAL SURVEYOR and MAPPER	STATE OF FLORIDA DEPARTMENT OF TRANSPORTATION			SHEET NO.
DATE	DESCRIPTION	DATE	DESCRIPTION		ROAD NO.	COUNTY	FINANCIAL PROJECT ID	
				JAY SCAGLIOLA, PSM LICENSE NUMBER 5066 DRMP INC. 6853 SW 18TH ST, SUITE 310 BOCA RATON, FL 33433	SR 25	HENDRY	448938-1-52-01	UTV-1

VERIFIED UTILITY LOCATE

SPECIFIC PURPOSE SURVEY VERIFIED UTILITY LOCATE SHEET

SUMMARY OF VERIFIED UTILITIES

Vvh #	UTILITY DESCRIPTION (Owner, type)	SIZE	MATERIALS	STATIONS DERIVED FROM \mathbb{B} SR25(US27) (TYP.)			EXISTING GROUND ELEVATION	TOP ELEVATION	COMMENTS
				STATION	OFFSET	LT/RT			
15	CENTURY LINK/LUMEN, BURIED TELEPHONE	2" / 0.5"	CONDUIT CASING/DBC	287+20.58	53.02	LT	20.5	15.4	
16	CENTURY LINK/LUMEN, BURIED TELEPHONE	1"	DBC	287+19.05	12.15	RT	20.1	14.8	
17	EXPLORATORY, NO UTILITY FOUND	N/A	N/A	286+81.95	87.28	RT	19.2	N/A	REQUESTED WATER LINE DUG 1'x2'x 5' DEEP PROBED TO ±10' NO UTILITY FOUND
18	CENTURY LINK/LUMEN, BURIED FIBER OPTIC	(3)2"	PEP	286+82.79	85.71	RT	19.1	14.9	
19	SOUTH SHORE WATER ASSOCIATION, WATER MAIN	6"	PVC	288+74.25	91.19	RT	18.3	14.9	
20	CENTURY LINK/LUMEN, BURIED FIBER OPTIC	2"	PEP	288+72.96	101.81	RT	16.4	13.6	
21	EXPLORATORY, NO UTILITY FOUND	N/A	N/A	288+72.96	101.81	RT	16.4	N/A	DUG TO 5'. PROBED TO ±10' NO UTILITY FOUND
22	CENTURY LINK/LUMEN, BURIED TELEPHONE	0.5"	DBC	292+17.45	79.99	LT	18.2	16.7	
23	CENTURY LINK/LUMEN, BURIED TELEPHONE	2" / 0.5"	CONDUIT CASING/DBC	292+24.99	57.62	LT	19.6	13.9	
24	CENTURY LINK/LUMEN BURIED TELEPHONE	UNK	UNK	292+26.50	18.36	LT	20.8	11.7	DEBRIS AT LOCATION UNABLE TO EXPOSE OR CONFIRM UTILITY DUE TO DEPTH
25	EXPLORATORY, NO UTILITY FOUND	N/A	N/A	292+27.99	84.51	RT	19.2	N/A	REQUESTED TELEPHONE DUG 1'x2'x5' DEEP PROBED TO ±10' NO UTILITY FOUND
26	EXPLORATORY, NO UTILITY FOUND	N/A	N/A	292+27.74	86.21	RT	19.2	N/A	REQUESTED FIBER OPTIC DUG 1'x2'x5' DEEP PROBED TO ±7' NO UTILITY FOUND
27	EXPLORATORY, NO UTILITY FOUND	N/A	N/A	297+04.98	97.57	RT	17.8	N/A	REQUESTED FIBER OPTIC DUG 1'x4'x5' DEEP PROBED TO ±10' NO UTILITY FOUND
28	SOUTH SHORE WATER ASSOCIATION, WATER MAIN	6"	PVC	298+68.97	93.19	RT	17.9	15.1	
29	CENTURY LINK/LUMEN, BURIED TELEPHONE	1"	DBC	304+07.89	99.91	RT	17.4	14.7	
30	EXPLORATORY, NO UTILITY FOUND	N/A	N/A	303+68.83	26.47	RT	19.2	N/A	PERFORMED TEST HOLE 6'x6'x5' DEEP PROBED TO ±10' NO UTILITY FOUND
31	EXPLORATORY, NO UTILITY FOUND	N/A	N/A	303+68.83	26.47	RT	19.2	N/A	PERFORMED TEST HOLE 6'x6'x5' DEEP PROBED TO ±10' NO UTILITY FOUND
32	EXPLORATORY, NO UTILITY FOUND	N/A	N/A	303+68.83	26.47	RT	19.2	N/A	PERFORMED TEST HOLE 6'x6'x5' DEEP PROBED TO ±10' NO UTILITY FOUND
33	EXPLORATORY, NO UTILITY FOUND	N/A	N/A	303+68.72	26.41	RT	19.5	N/A	PERFORMED TEST HOLE 6'x6'x5' DEEP PROBED TO ±10' NO UTILITY FOUND
34	FLORIDA CITY GAS/FP&L, GAS MAIN	6"	STEEL	312+03.79	76.03	RT	20.1	16.1	COATED STEEL
35	CENTURY LINK/LUMEN, BURIED FIBER OPTIC	(4)2"	PEP	312+03.06	79.41	RT	20.1	15.5	
36	EXPLORATORY, NO UTILITY FOUND	N/A	N/A	317+01.64	81.27	RT	20.0	N/A	PERFORMED TEST HOLE ON REQUESTED FIBER OPTIC DUG 1'x4'x6' DEEP PROBED TO ±10' NO UTILITY FOUND
37	EXPLORATORY, NO UTILITY FOUND	N/A	N/A	311+31.46	22.20	RT	18.7	N/A	PERFORMED TEST HOLE 1'x3'x5' DEEP PROBED TO ±10' NO UTILITY FOUND
38	EXPLORATORY, NO UTILITY FOUND	N/A	N/A	311+44.12	21.47	RT	18.5	N/A	PERFORMED TEST HOLE 1'x3'x5' DEEP PROBED TO ±10' NO UTILITY FOUND
39	VVH 39 NOT PERFORMED	N/A	N/A	N/A	N/A	N/A	N/A	N/A	DID NOT PERFORM HOLE BASED ON NO GPR READING
40	EXPLORATORY, NO UTILITY FOUND	N/A	N/A	318+93.93	59.67	RT	18.8	N/A	PERFORMED TEST HOLE 3'x1'x5' DEEP ON REQUESTED TELEPHONE PROBED TO ±10' NO UTILITY FOUND
41	CENTURY LINK/LUMEN, BURIED FIBER OPTIC	(4)2"	PEP	318+95.74	79.48	RT	20.1	16.0	
42	CENTURY LINK/LUMEN, BURIED FIBER OPTIC	(4)2"	PEP	319+11.68	79.59	RT	20.2	16.0	
43	EXPLORATORY, NO UTILITY FOUND	N/A	N/A	328+99.10	81.33	RT	19.7	N/A	PERFORMED TEST HOLE 1'x4'x6' DEEP ON REQUESTED FIBER OPTIC PROBED TO ±10' NO UTILITY FOUND
44	FLORIDA CITY GAS/FP&L, GAS MAIN	6"	STEEL	328+98.82	75.04	RT	19.9	15.8	COATED STEEL
45	CENTURY LINK/LUMEN, BURIED FIBER OPTIC	(4)2"	PEP	332+32.02	78.34	RT	20.2	15.7	
46	CENTURY LINK/LUMEN, BURIED FIBER OPTIC	(4)2"	PEP	336+98.83	79.80	RT	19.8	15.3	
47	CENTURY LINK/LUMEN, BURIED ELECTRIC	2"	PVC	346+43.33	17.82	LT	20.6	18.8	
48	SOUTH SHORE WATER ASSOCIATION, WATER MAIN	6"	PVC	347+05.47	90.08	RT	19.5	16.5	
49	SOUTH SHORE WATER ASSOCIATION, WATER MAIN	6"	PVC	346+76.23	91.62	RT	19.1	14.8	
50	EXPLORATORY, NO UTILITY FOUND	N/A	N/A	352+60.72	6.01	LT	19.4	N/A	TEST HOLE PERFORMED 3'x3'5' DEEP PROBED TO ±10' NO UTILITY FOUND
51	EXPLORATORY, NO UTILITY FOUND	N/A	N/A	352+60.72	6.01	LT	19.4	N/A	TEST HOLE PERFORMED 3'x3'5' DEEP PROBED TO ±10' NO UTILITY FOUND

1/22/2024 9:48:51 AM bbussard C:\Worksets\FDOT\2020-01-46\012_Survey\SBVHRD02.dgn

THE OFFICIAL RECORD OF THIS SHEET IS THE ELECTRONIC FILE DIGITALLY SIGNED AND SEALED UNDER RULE 5J-17.062, F.A.C.

REVISIONS				PROFESSIONAL SURVEYOR and MAPPER		STATE OF FLORIDA DEPARTMENT OF TRANSPORTATION			VERIFIED UTILITY LOCATE	SHEET NO.
DATE	DESCRIPTION	DATE	DESCRIPTION	JAY SCAGLIOLA, PSM LICENSE NUMBER 5066 DRMP INC. 6853 SW 18TH ST, SUITE 310 BOCA RATON, FL 33433		ROAD NO.	COUNTY	FINANCIAL PROJECT ID		UTV-2
						SR 25	HENDRY	448938-1-52-01		

SPECIFIC PURPOSE SURVEY VERIFIED UTILITY LOCATE SHEET

SUMMARY OF VERIFIED UTILITIES

Vvh #	UTILITY DESCRIPTION (Owner, type)	SIZE	MATERIALS	STATIONS DERIVED FROM § SR25(US27) (TYP.)			EXISTING GROUND ELEVATION	TOP ELEVATION	COMMENTS
				STATION	OFFSET	LT/RT			
52	EXPLORATORY, NO UTILITY FOUND	N/A	N/A	352+60.72	6.01	LT	19.4	N/A	TEST HOLE PERFORMED 3'x3'5'DEEP PROBED TO ±10' NO UTILITY FOUND
53	EXPLORATORY, NO UTILITY FOUND	N/A	N/A	352+60.72	6.01	LT	19.4	N/A	TEST HOLE PERFORMED 3'x3'5'DEEP PROBED TO ±10' NO UTILITY FOUND
54	CENTURY LINK/LUMEN, BURIED FIBER OPTIC	0.5"	DBC	354+00.53	89.72	RT	19.5	16.9	
54A	SOUTH SHORE WATER ASSOCIATION, WATER MAIN	6"	PVC	354+09.68	89.17	RT	19.7	15.9	
55	CENTURY LINK/LUMEN, BURIED FIBER OPTIC	(2)2"	DBC	354+10.24	90.74	RT	19.5	16.8	
56	CENTURY LINK/LUMEN, BURIED TELEPHONE	2"	PEP	361+64.38	51.22	LT	20.2	16.0	POSSIBLE FIBER OPTIC
57	CENTURY LINK/LUMEN, BURIED TELEPHONE	2"	DBC	362+22.21	59.19	LT	20.6	17.6	
58	EXPLORATORY, NO UTILITY FOUND	N/A	N/A	361+63.06	9.59	RT	20.2	N/A	PERFORMED TEST HOLE ON REQUESTED TELEPHONE DUG TO ± 8.3' HIT ROCK NO UTILITY FOUND
59	EXPLORATORY, NO UTILITY FOUND	N/A	N/A	362+79.27	9.67	RT	20.6	N/A	PERFORMED TEST HOLE ON REQUESTED FIBER OPTIC DUG TO ±5' HIT ROCK
60	SOUTH SHORE WATER ASSOCIATION, WATER MAIN	4"	PVC	362+92.79	11.72	RT	20.8	17.4	
61	EXPLORATORY, NO UTILITY FOUND	N/A	N/A	361+54.91	82.49	RT	19.9	N/A	PERFORMED TEST HOLE 1'x3'x6' DEEP, GAS REQUESTED PROBED TO ±10' NO UTILITY FOUND
62	CENTURY LINK/LUMEN, BURIED FIBER OPTIC	(4)2"	PEP	362+79.46	82.33	RT	19.8	15.8	
63	EXPLORATORY, NO UTILITY FOUND	N/A	N/A	362+83.27	71.96	LT	19.8	N/A	PERFORMED TEST HOLE ON REQUESTED FIBER OPTIC PROBED ±10' NO UTILITY FOUND
64	CENTURY LINK/LUMEN, BURIED TELEPHONE	2"	DBC	362+92.03	58.97	LT	20.1	17.5	
65	EXPLORATORY, NO UTILITY FOUND	N/A	N/A	365+26.24	80.45	RT	20.3	N/A	PERFORMED 3.5'x1'x5' DEED PROBED TO ±10' NO UTILITY FOUND
66	CENTURY LINK/LUMEN, BURIED FIBER OPTIC	1"	DBC	365+28.61	87.04	RT	19.9	16.3	
66A	SOUTH SHORE WATER ASSOCIATION, WATER MAIN	6"	PVC	365+24.64	87.99	RT	19.9	16.0	
67	FLORIDA CITY GAS/FP&L, GAS MAIN	6"	STEEL	373+04.52	79.71	RT	20.7	13.1	COATED STEEL
68	CENTURY LINK/LUMEN, BURIED FIBER OPTIC	(4)2"	PEP	373+05.83	86.41	RT	20.2	14.9	
68A	SOUTH SHORE WATER ASSOCIATION, WATER MAIN	6"	PVC	373+04.62	89.85	RT	19.7	15.9	
69	CENTURY LINK/LUMEN, BURIED FIBER OPTIC	(4)2"	PEP	375+66.03	84.29	RT	19.3	14.9	
70	CENTURY LINK/LUMEN, BURIED FIBER OPTIC	1"	DBC	379+14.73	86.72	RT	20.4	16.9	
71	SOUTH SHORE WATER ASSOCIATION, WATER MAIN	6"	PVC	379+44.11	88.34	RT	20.2	16.5	
72	CENTURY LINK/LUMEN, BURIED TELEPHONE	0.5"	DBC	388+75.31	59.20	RT	22.5	19.3	
73	EXPLORATORY, NO UTILITY FOUND	N/A	N/A	388+12.79	76.65	RT	20.6	N/A	PERFORMED TEST HOLE 1'x4'x5' DEEP ON REQUESTED GAS PROBED TO ±10' NO UTILITY FOUND
74	SOUTH SHORE WATER ASSOCIATION, WATER MAIN	6"	PVC	388+17.49	86.64	RT	20.3	17.1	
75	CENTURY LINK/LUMEN, BURIED FIBER OPTIC	(4)2"	PEP	395+29.94	81.43	RT	20.6	16.1	
76	SOUTH SHORE WATER ASSOCIATION, WATER MAIN	6"	PVC	395+25.77	86.93	RT	20.3	15.7	
77	FLORIDA CITY GAS/FP&L, GAS MAIN	6"	STEEL	403+03.63	82.80	RT	20.5	12.9	COATED STEEL
78	SOUTH SHORE WATER ASSOCIATION, WATER MAIN	6"	PVC	403+04.12	85.87	RT	20.4	16.8	
79	CENTURY LINK/LUMEN, BURIED FIBER OPTIC	(4)2"	PEP	411+02.06	81.24	RT	20.1	15.5	
80	SOUTH SHORE WATER ASSOCIATION, WATER MAIN	6"	PVC	409+78.40	90.21	RT	19.7	16.7	
80A	CENTURY LINK/LUMEN, BURIED FIBER OPTIC	1"	DBC	409+78.27	87.67	RT	20.1	17.1	
81	SOUTH SHORE WATER ASSOCIATION, WATER MAIN	6"	PVC	414+21.70	82.04	RT	20.5	16.0	
82	EXPLORATORY, NO UTILITY FOUND	N/A	N/A	416+00.64	84.98	RT	19.5	N/A	PERFORMED TEST HOLE 1'x3'x5' DEEP PROBED TO ±10' NO UTILITY FOUND
83	CENTURY LINK/LUMEN, BURIED FIBER OPTIC	1"	DBC	416+00.44	90.60	RT	19.4	16.2	
83A	SOUTH SHORE WATER ASSOCIATION, WATER MAIN	6"	PVC	415+99.33	96.41	RT	18.9	15.7	
84	CENTURY LINK/LUMEN, BURIED FIBER OPTIC	1"	DBC	415+99.65	98.61	RT	19.0	17.6	
85	EXPLORATORY, NO UTILITY FOUND	N/A	N/A	416+05.90	98.95	RT	18.6	15.4	FOUND FIBER OPTIC WARNING TAPE, DUG 1X3X5 TRENCH NO UTILITY FOUND
86	CENTURY LINK/LUMEN, BURIED FIBER OPTIC	(4)2"	PEP	423+56.45	82.55	RT	19.7	15.8	
87	CENTURY LINK/LUMEN, BURIED FIBER OPTIC	(2)2"	DBC	424+01.88	88.51	RT	18.8	14.8	
87A	SOUTH SHORE WATER ASSOCIATION, WATER MAIN	6"	PVC	423+56.15	97.21	RT	18.9	15.7	
88	CENTURY LINK/LUMEN, BURIED FIBER OPTIC	1"	DBC	424+01.34	93.98	RT	18.9	14.7	
89	CENTURY LINK/LUMEN, BURIED FIBER OPTIC	(4)2"	PEP	424+05.94	94.64	RT	18.7	14.8	
90	EXPLORATORY, NO UTILITY FOUND	N/A	N/A	424+02.92	80.49	RT	19.9	N/A	PERFORMED TEST HOLE 1'x 6' ON REQUESTED GAS MAIN PROBED TO ±10' NO UTILITY FOUND
91	EXPLORATORY, NO UTILITY FOUND	N/A	N/A	432+00.83	80.22	RT	19.6	N/A	PERFORMED TEST HOLE 1'x 6'x5' DEEP ON REQUESTED GAS MAIN PROBED TO ±10' NO UTILITY FOUND
92	CENTURY LINK/LUMEN, BURIED FIBER OPTIC	(4)2"	PEP	432+00.83	82.85	RT	19.3	16.1	

REVISIONS				PROFESSIONAL SURVEYOR and MAPPER	STATE OF FLORIDA DEPARTMENT OF TRANSPORTATION			SHEET NO.
DATE	DESCRIPTION	DATE	DESCRIPTION		ROAD NO.	COUNTY	FINANCIAL PROJECT ID	
				JAY SCAGLIOLA, PSM LICENSE NUMBER 5066 DRMP INC. 6853 SW 18TH ST, SUITE 310 BOCA RATON, FL 33433	SR 25	HENDRY	448938-1-52-01	VERIFIED UTILITY LOCATE
								UTV-3

1/22/2024 9:41:47 AM bbussard
C:\Work\sets\FDOT\2020-01-46-012\Survey\SBV\HRD03.dgn

THE OFFICIAL RECORD OF THIS SHEET IS THE ELECTRONIC FILE DIGITALLY SIGNED AND SEALED UNDER RULE 5J-17.062, F.A.C.

SPECIFIC PURPOSE SURVEY VERIFIED UTILITY LOCATE SHEET

SUMMARY OF VERIFIED UTILITIES

Vvh #	UTILITY DESCRIPTION (Owner, type)	SIZE	MATERIALS	STATIONS DERIVED FROM § SR25(US27) (TYP.)			EXISTING GROUND ELEVATION	TOP ELEVATION	COMMENTS
				STATION	OFFSET	LT/RT			
93	CENTURY LINK/LUMEN, BURIED FIBER OPTIC	1"	DBC	432+00.90	90.40	RT	18.6	16.4	
94	EXPLORATORY, NO UTILITY FOUND	N/A	N/A	432+00.96	93.69	RT	18.5	N/A	PERFORMED TEST HOLE 1'x 3'x5' DEEP ON REQUESTED FIBER OPTIC PROBED TO ±10' NO UTILITY FOUND
95	CENTURY LINK/LUMEN, BURIED FIBER OPTIC	(2)1"	DBC	432+00.82	95.99	RT	18.7	15.6	
96	EXPLORATORY, NO UTILITY FOUND	N/A	N/A	439+98.59	80.85	RT	20.0	N/A	PERFORMED TEST HOLE 1'x 2.5'x5' DEEP ON REQUESTED GAS MAIN PROBED TO ±10' NO UTILITY FOUND
97	CENTURY LINK/LUMEN, BURIED FIBER OPTIC	(2)2"	PEP	440+01.70	84.20	RT	19.4	15.6	
98	CENTURY LINK/LUMEN, BURIED FIBER OPTIC	2"	DBC	439+97.75	90.11	RT	19.0	16.2	
99	EXPLORATORY, NO UTILITY FOUND	N/A	N/A	439+98.02	94.75	RT	18.9	N/A	PERFORMED TEST HOLE 1'x 3'x6'DEEP ON REQUESTED FIBER OPTIC PROBED TO ±10' NO UTILITY FOUND
100	CENTURY LINK/LUMEN, BURIED FIBER OPTIC	(2)1"	DBC	439+97.90	95.62	RT	18.7	15.7	
101	F.D.O.T., BURIED ELECTRIC	2"	PVC	443+43.33	60.26	RT	22.0	18.5	
101A	F.D.O.T., BURIED ELECTRIC	2"	PVC	443+52.92	60.49	RT	21.7	19.0	
102	F.D.O.T., BURIED ELECTRIC	2"	PVC	444+89.66	58.83	RT	21.7	18.8	BURIED ELECTRIC FOUND IN 6'x6'5' DEEP SLOT TRENCH
103	EXPLORATORY, NO UTILITY FOUND	N/A	N/A	444+89.66	58.83	RT	21.7	N/A	TEST HOLES 102-105 PERFORMED 6'x6'x5' DEEP SLOT TRENCH PROBED TO ± 10' NO UTILITIES FOUND IN TEST HOLES 103-105
104	EXPLORATORY, NO UTILITY FOUND	N/A	N/A	444+89.66	58.83	RT	21.7	N/A	
105	EXPLORATORY, NO UTILITY FOUND	N/A	N/A	444+89.66	58.83	RT	21.7	N/A	

1/24/2024 10:58:36 AM bbussard
C:\work\sets\FDOT\2020-01-46.012\Survey\SBVHRD04.dgn

THE OFFICIAL RECORD OF THIS SHEET IS THE ELECTRONIC FILE DIGITALLY SIGNED AND SEALED UNDER RULE 5J-17.062, F.A.C.

REVISIONS				PROFESSIONAL SURVEYOR and MAPPER	STATE OF FLORIDA DEPARTMENT OF TRANSPORTATION			SHEET NO.
DATE	DESCRIPTION	DATE	DESCRIPTION		ROAD NO.	COUNTY	FINANCIAL PROJECT ID	
				JAY SCAGOLIA, PSM LICENSE NUMBER 5066 DRMP INC. 6853 SW 18TH ST, SUITE 310 BOCA RATON, FL 33433	SR 25	HENDRY	448938-1-52-01	VERIFIED UTILITY LOCATE
								UTV-4