

SPECIFIC PURPOSE SURVEY VERIFIED UTILITY LOCATE SHEET

SUMMARY OF VERIFIED UTILITIES

Vvh #	UTILITY DESCRIPTION (Owner, type)	SIZE	MATERIALS	STATIONS DERIVED FROM SR 15 (US 441) AT 28TH STREET SAFETY IMPROVEMENTS			EXISTING GROUND ELEVATION	TOP ELEVATION	COMMENTS
				STATION	OFFSET	LT/RT			
TH 1	CENTURYLINK, BURIED TELEPHONE	UNKNOWN	UNKNOWN	712+28.20	53.30	R	19.31	12.10	BURIED TELEPHONE LOCATED WITH AIR PROBES. NO SIZE OR MATERIAL DUE TO DEPTH (7.2')
TH 2	OKEECHOBEE COUNTY, BURIED ELECTRIC (TC/SL)	2"	PVC	712+49.95	55.98	R	18.93	17.23	DEPTH 1.7'
TH 2A	OKEECHOBEE COUNTY, BURIED ELECTRIC (TC/SL)	2"	PVC	712+49.77	52.44	R	18.96	17.46	DEPTH 1.5'
TH 3	NO UTILITY FOUND	NA	NA	712+62.23	70.01	R	18.68	NA	CROSS TRENCH DUG AND SCAN, NO UTILITY FOUND
TH 4	NO UTILITY FOUND	NA	NA	712+56.57	101.85	R	19.23	NA	CROSS TRENCH DUG AND SCAN, NO UTILITY FOUND
TH 5	COMCAST, BURIED CABLE TELEVISION	2"	WHITE PVC	712+67.81	48.44	L	19.23	16.63	BURIED CABLE TELEVISION, DEPTH 2.6'. WATER LINE MARKED BY OTHERS, PROBED TO 10', NO UTILITY FOUND
TH 6	NO UTILITY FOUND	NA	NA	712+81.26	65.07	L	19.38	NA	CROSS TRENCH DUG AND SCAN, NO UTILITY FOUND
TH 7	FLA PUBLIC UTILITIES CO, BURIED GAS	4"	PEP	712+82.64	108.04	L	19.68	15.98'	BURIED GAS, DEPTH 3.7'
TH 7A	CENTURYLINK, BURIED CONCRETE DUCT BANK	UNKNOWN	CONCRETE DUCT	712+83.70	108.02	L	19.64	17.64'	BURIED CONCRETE DUCT BANK, DEPTH 2'. POSSIBLE BT
TH 7B	BURIED WATER IRRIGATION	1/2"	PVC	712+80.46	108.14	L	19.60	18.96	BURIED IRRIGATION, DEPTH 0.64'
TH 8	UNKNOWN	2"	PVC	713+33.16	65.93	L	19.68	16.88	POSSIBLE BURIED FORCE MAIN, DEPTH 2.8'
TH 8A	UNKNOWN	UNKNOWN	CORR. METAL PIPE	713+31.14	65.17	L	19.65	16.65	CORR. METAL PIPE, POSS. STORM SEWER, DEPTH 3.0'
TH 8B	UNKNOWN	1"	PVC	713+33.60	65.07	L	19.65	18.75	POSSIBLE IRRIGATION, DEPTH 0.9'
TH 9	UNKNOWN	2"	PVC	713+47.64	48.78	L	19.79	17.69	POSSIBLE BURIED TRAFFIC CONTROL, DEPTH 2.1'

SURVEYOR'S NOTES:

SUBSURFACE UTILITY ENGINEERING NOTES:

- OWNERSHIP IS BASED UPON OBSERVING ABOVE GROUND UTILITY FEATURES, SUNSHINE 811 DIG TICKET AND PROFESSIONAL JUDGEMENT. NO RECORDS RESEARCH WAS PERFORMED BY DRMP.

SURVEYOR'S NOTES:

- SURVEY OF UTILITIES WAS PERFORMED BY DRMP.
- VERTICAL INFORMATION IS RELATIVE TO NORTH AMERICAN VERTICAL DATUM OF 1988 (NAVD 88).
- BEARINGS AND COORDINATES ARE RELATIVE TO THE STATE PLANE COORDINATES FLORIDA EAST ZONE, NORTH AMERICAN DATUM OF 1983 (NAD 83) ADJUSTMENT 2011.
- STATION AND OFFSET DERIVED FROM THE BASELINE OF SURVEY OF SR 15 (US 441) AS PROVIDED BY FDOT PROJECT NETWORK CONTROL (PNC) FINANCIAL PROJECT ID 449656-1-32-01.
- PROJECT UNITS IN U.S SURVEY FEET
- THE SPECIFIC PURPOSE OF THIS SURVEY IS TO DETERMINE THE HORIZONTAL AND VERTICAL LOCATION OF VACUUM TEST HOLES AS MARKED ON THE SURFACE BY THE SUBSURFACE UTILITY ENGINEERING DEPARTMENT OF DRMP INC.
- DRMP PROJECT # 21-0887.006

LEGEND:

ACP	TRANSITE PIPE
⊕	BASELINE
⊙	CENTERLINE
CONC	CONCRETE COVERED UTILITY
CI	CAST IRON
CP	CONCRETE PIPE
DIP	DUCTILE IRON PIPE
DBC	DIRECT BURIED CABLE
DUCT	BANK OF MULTIPLE PIPES
FDOT	FLORIDA DEPARTMENT OF TRANSPORTATION
HDPE	HIGH-DENSITY POLYETHYLENE
LT	LEFT
NA	NOT APPLICABLE
PCCP	PRE-STRESSED CONCRETE CYLINDER PIPE
PEP	POLYETHYLENE PIPE
PP	PER PLANS
PSM	PROFESSIONAL SURVEYOR AND MAPPER
PVC	POLYVINYL CHLORIDE
RCP	REINFORCED CONCRETE PIPE
RT	RIGHT
SR	STATE ROAD
STL	STEEL PIPE
TC	TRAFFIC CONTROL
TH	TEST HOLE
UNK.	UNKNOWN
UTV	UTILITY VERIFICATION SHEET
VCP	VITRIFIED CLAY PIPE
VvH	VERIFIED VERTICALLY & HORIZONTALLY

LIMITS: SR 15 (US 441) AT 28TH STREET (MP INTERSECTION: 1.371)


SURVEYOR'S CERTIFICATION

I HEREBY CERTIFY THIS SPECIFIC PURPOSE SURVEY WAS MADE FOR THE PURPOSE OF SURVEYING, REFERENCING, DESCRIBING AND MAPPING THE UTILITY VACUUM EXCAVATIONS, AS MARKED ON THE SURFACE FOR THE TRANSPORTATION FACILITY DEPICTED HEREON AND THAT SAID SURVEY WAS DONE UNDER MY RESPONSIBLE CHARGE AND MEETS THE STANDARDS OF PRACTICE SET FORTH BY THE FLORIDA BOARD OF PROFESSIONAL SURVEYORS AND MAPPERS IN CHAPTER 5J-17 FLORIDA ADMINISTRATIVE CODE PURSUANT TO SECTION 472.027 FLORIDA STATUTES. THIS MAP CONSISTING OF SHEET 01 IS A TRUE, ACCURATE AND COMPLETE DEPICTION OF THE RESULTS OF A FIELD SURVEY PERFORMED UNDER MY DIRECTION AND COMPLETED NOVEMBER 1, 2023

SURVEYOR: JAY SCAGLIOLA

PSM NUMBER: LS5066

PRINTED COPIES OF THIS SHEET ARE NOT CONSIDERED SIGNED AND SEALED AND THE SIGNATURE MUST BE VERIFIED ON ANY ELECTRONIC COPIES. THE ABOVE NAMED PROFESSIONAL SURVEYOR AND MAPPER SHALL BE RESPONSIBLE FOR THE FOLLOWING SHEETS IN ACCORDANCE WITH RULE 5J-17.062, F.A.C.

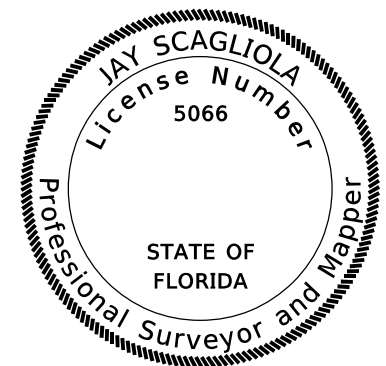

SHEET NO.

UTV1 & UTV2

SHEET DESCRIPTION

VERIFIED UTILITY LOCATE SHEET

REVISIONS				PROFESSIONAL SURVEYOR and MAPPER	STATE OF FLORIDA DEPARTMENT OF TRANSPORTATION			SHEET NO.
DATE	DESCRIPTION	DATE	DESCRIPTION		ROAD NO.	COUNTY	FINANCIAL PROJECT ID	
				JAY SCAGLIOLA PSM LICENSE NUMBER LS5066 DRMP INC. 6853 SW 18TH ST, SUITE 310 BOCA RATON, FL 33433	SR 15	OKEECHOBEE	449656-1-52-01	VERIFIED UTILITY LOCATE
								UTV1

THE OFFICIAL RECORD OF THIS SHEET IS THE ELECTRONIC FILE DIGITALLY SIGNED AND SEALED UNDER RULE 5J-17.062, F.A.C.

SPECIFIC PURPOSE SURVEY VERIFIED UTILITY LOCATE SHEET

SUMMARY OF VERIFIED UTILITIES

Vvh #	UTILITY DESCRIPTION (Owner, type)	SIZE	MATERIALS	STATIONS DERIVED FROM SR 15 (US 441) AT 28TH STREET SAFETY IMPROVEMENTS			EXISTING GROUND ELEVATION	TOP ELEVATION	COMMENTS
				STATION	OFFSET	LT/RT			
TH 9A	UNKNOWN	UNKNOWN	UNKNOWN	713+47.87	46.42	L	19.61	±11.2	POSSIBLE WATER MAIN MARKED BY OTHERS, NO VISUAL DUE TO DEPTH, DEPTH 8.4' PER AIR PROBE. FOUND BURIED WIRE PULL BOX 0.5' WEST OF TH 9
TH 10	OKEECHOBEE UTILITY AUTHORITY, BURIED FORCE MAIN	6"	PVC	714+00.19	47.27	R	19.36	15.81	
TH 11	OKEECHOBEE UTILITY AUTHORITY, BURIED FORCE MAIN	6"	WHITE PVC	713+60.02	47.94	R	19.23	16.03	BURIED FORCE MAIN, DEPTH 3.2'
TH 12	OKEECHOBEE COUNTY, BURIED ELECTRICAL (TRAFFIC CONTROL)	1"	PVC	713+47.88	66.74	R	18.75	17.35	BURIED ELECTRICAL, DEPTH 1.4'. FORCE MAIN MARKED BY OTHERS, NO UTILITY FOUND

REVISIONS				PROFESSIONAL SURVEYOR and MAPPER	STATE OF FLORIDA DEPARTMENT OF TRANSPORTATION			VERIFIED UTILITY LOCATE	SHEET NO.
DATE	DESCRIPTION	DATE	DESCRIPTION	JAY SCAGLIOLA PSM LICENSE NUMBER LS5066 DRMP INC. 6853 SW 18TH ST, SUITE 310 BOCA RATON, FL 33433	ROAD NO.	COUNTY	FINANCIAL PROJECT ID		UTV2
						SR 15	OKEECHOBEE		

THE OFFICIAL RECORD OF THIS SHEET IS THE ELECTRONIC FILE DIGITALLY SIGNED AND SEALED UNDER RULE 5J-17.062, F.A.C.