

SUMMARY OF VERIFIED UTILITIES									
Vvh #	UTILITY DESCRIPTION (Owner, type)	SIZE	MATERIALS	℄ and/or ℄			EXISTING GROUND ELEVATION	TOP ELEVATION	COMMENTS
				STATION	OFFSET	LT/RT			
TH2	CROWN CASTLE, FOC	2 1/2"	PVC	161+75.71	79.06	LT	9.35	2.45	NO COMMENT
TH2A	EXPLORATORY (NO UTILITY FOUND)	N/A	N/A	161+75.75	75.75	LT	9.68	N/A	NO COMMENT
TH6	CENTURY LINK, FOC	2"	PVC	163+52.86	103.02	RT	10.75	5.85	NO COMMENT
TH7	EXPLORATORY (NO UTILITY FOUND)	N/A	N/A	163+54.07	95.95	LT	9.24	N/A	NO COMMENT
TH8	CROWN CASTLE, FOC	(2) 2"	PVC	163+65.58	82.88	LT	9.83	8.33	NO COMMENT
TH8A	UNKNOWN	N/A	PVC	163+65.87	79.60	LT	10.01	5.76	NO COMMENT
TH9	SARASOTA COUNTY, BE	2'	PVC	163+68.49	14.83	RT	12.86	9.96	NO COMMENT
TH10	SARASOTA COUNTY, WM	10	DIP	163+70.37	84.54	RT	10.65	7.05	NO COMMENT
TH10A	EXPLORATORY (NO UTILITY FOUND)	N/A	N/A	163+72.15	87.11	RT	10.65	N/A	NO COMMENT
TH12	EXPLORATORY (NO UTILITY FOUND)	N/A	N/A	163+75.79	79.20	RT	10.69	N/A	NO COMMENT
TH13	TECO, GAS	4	PVC	165+84.70	79.58	LT	10.00	6.05	NO COMMENT
TH13A	BE	1.5	PVC	163+58.71	86.8	RT	9.70	7.6	NO COMMENT
TH13B	EXPLORATORY (NO UTILITY FOUND)	N/A	N/A	165+84.87	83.74	LT	9.52	N/A	NO COMMENT
TH20	EXPLORATORY (NO UTILITY FOUND)	N/A	N/A	163+50.14	122.66	RT	9.68	N/A	HIT WATER TABLE AT 3.0 FEET - GPR DEPTH IS 6.0 FEET
TH21	CITY, WATER MAIN	10"	DIP	163+50.93	122.51	RT	9.89	6.49'	HIT WATER TABLE AT 3.0 FEET
TH22	EXPLORATORY (NO UTILITY FOUND)	N/A	N/A	163+57.86	114.33	RT	9.99	N/A	HIT WATER TABLE AT 3.0 FEET - ELECTRONIC TRACER DEPTH IS 9.15 FEET
TH23	EXPLORATORY (NO UTILITY FOUND)	N/A	N/A	163+68.14	109.26	RT	9.55	N/A	HIT WATER TABLE AT 3.0 FEET - GPR AND ELECTRONIC TRACER SHOW DEPTH IS 7.0 FEET

SURVEYOR'S NOTES:

1. TYPE OF SURVEY: SPECIFIC PURPOSE SURVEY. THE SPECIFIC PURPOSE FOR THIS SURVEY WAS TO OBTAIN HORIZONTAL AND VERTICAL INFORMATION FOR THE VACUUM EXCAVATION TEST HOLES PERFORMED BY CIVILSURV DESIGN GROUP INC. SUBSURFACE UTILITY CREWS ALONG THIS CORRIDOR AS PER AMERICAN SOCIETY OF CIVIL ENGINEERS (ASCE) STANDARDS.

2. THIS TABLE OF VERIFIED UTILITIES SHEET INCLUDE THE VACUUM EXCAVATION TEST HOLES (VVHs) PERFORMED BY CIVILSURV DESIGN GROUP INC.

3. DATE OF SURVEY: SURVEY WORK WAS PERFORMED FROM SEPTEMBER 18, 2023 TO AUGUST 25, 2025.

4. COORDINATES REFER TO FLORIDA STATE PLANE COORDINATE SYSTEM, EAST ZONE, NORTH AMERICAN DATUM 1983 ADJUSTMENT OF 2011.

5. ELEVATIONS ARE SHOWN ON THIS TABLE OF VERIFIED UTILITIES ARE RELATED TO THE NORTH AMERICAN VERTICAL DATUM OF 1988 (NAVD 1988)

6. STATION AND OFFSET REFER TO BASELINE OF SURVEY AS DEPICTED ON ALIGNMENT FILE AS SHOWN ON ALGNRD01.DGN FILE PROVIDED.

7. UTILITY SIZE AND MATERIAL ARE PRODUCT OF FIELD OBSERVATION AND MAY DIFFER FROM EXISTING RECORDING INFORMATION AND AS-BUILTS DUE TO FIELD CONDITIONS & DEPTH.

8. UTILITIES DESCRIBED AS EXPLORATORY (CLEAR) WERE VACUUM EXCAVATED TO A DEPTH OF 5' & PROBED TO A DEPTH OF 7' UNLESS OTHERWISE NOTED ON THIS SHEET OR IN THE REPORTS.


9. PROJECT UNITS: US SURVEY FEET.

10. ADDITIONS OR DELETIONS TO SURVEY MAPS OR REPORTS BY OTHER THAN THE SIGNING PARTY OR PARTIES ARE PROHIBITED WITHOUT THE WRITTEN CONSENT.

11. OWNERSHIP IS BASED UPON OBSERVING VISIBLE ABOVE GROUND UTILITY FEATURES AND PROFESSIONAL JUDGEMENT. NO RECORDS RESEARCH WAS PERFORMED BY CIVILSURV DESIGN GROUP, INC.

LEGEND

<u>B</u>	=	BASELINE
<i>BE</i>	=	BURIED ELECTRIC
<u>C</u>	=	CENTERLINE
DIP	=	DUCTILE IRON PIPE
FOC	=	FIBER OPTIC CABLE
GPR	=	GROUND PENETRATING RADAR
LB	=	LICENSED BUSINESS
LT	=	LEFT
N/A	=	NOT APPLICABLE
PTSM	=	PROFESSIONAL SURVEYOR & MAPPER
PVC	=	POLYVINYL CHLORIDE PIPE
RT	=	RIGHT
SR	=	SANITARY
SR	=	STATE ROAD
SUE	=	SUBSURFACE UTILITY ENGINEERING
VVH	=	VERIFIED VERTICAL ELEVATION & HORIZONTAL LOCATION
WM	=	WATER MAIN
WI/	=	WATER

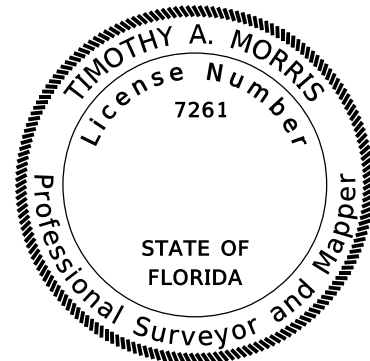

LIMITS: U.S. 41 AT GOLDEN GATE PARKWAY
SURVEYOR'S CERTIFICATION

I HEREBY CERTIFY THIS SPECIFIC PURPOSE SURVEY WAS MADE FOR THE PURPOSE OF SURVEYING, REFERENCING, DESCRIBING AND MAPPING THE VACUUM EXCAVATION TEST HOLES, AS MARKED ON THE SURFACE AND SURVEYED BY CIVLSURV DESIGN GROUP AND THAT TO THE BEST OF MY KNOWLEDGE MEETS THE STANDARDS OF PRACTICE SET FORTH BY THE FLORIDA BOARD OF PROFESSIONAL SURVEYORS AND MAPPERS IN CHAPTER 5J-17 FLORIDA ADMINISTRATIVE CODE PURSUANT TO SECTION 472.027 FLORIDA STATUTES. THIS MAP CONSISTING OF SHEET UTV-1 IS A TRUE, ACCURATE AND COMPLETED DEPICTION OF THE RESULTS OF A FIELD SURVEY PERFORMED UNDER MY DIRECTION AND COMPLETED ON AUGUST 25, 2025

THIS DOCUMENT HAS BEEN DIGITALLY SIGNED AND SEALED BY:
CIVILSURV DESIGN GROUP, INC.
2525 DRANE FIELD ROAD, SUITE 7
LAKELAND, FLORIDA 33178
CERTIFICATE OF AUTHORIZATION: LB 7805
SURVEYOR OF RECORD: TIMOTHY A. MORRIS, PSM, LICENSE NUMBER 7261

PRINTED COPIES OF THIS DOCUMENT ARE NOT CONSIDERED SIGNED AND SEALED.
THE SIGNATURE MUST BE VERIFIED ON THE ELECTRONIC DOCUMENTS.

THE ABOVE NAMED PROFESSIONAL SURVEYOR & MAPPER SHALL BE RESPONSIBLE FOR THE
FOLLOWING SHEETS IN ACCORDANCE WITH RULE 5J-17.062, F.A.C
NOT VALID WITHOUT ELECTRONIC SIGNATURE

INDEX OF SURVEY PLANS	
UTV-1	VERIFIED UTILITY LOCATE SHEETS

REVISIONS				PROFESSIONAL SURVEYOR AND MAPPER	STATE OF FLORIDA DEPARTMENT OF TRANSPORTATION			VERIFIED UTILITY LOCATE SHEET	SHEET NO.
DATE	DESCRIPTION	DATE	DESCRIPTION	TIMOTHY A. MORRIS, PSM LICENSE NUMBER: 7261 CIVILSURV DESIGN GROUP, INC. 2525 DRANE FIELD ROAD, SUITE 7 LAKELAND, FLORIDA 33812	ROAD NO.	COUNTY	FINANCIAL PROJECT ID		UTV-1
					U.S. 41	COLLIER	446451-1-32-01		